

MONUMENT 431


CERTIFICATE OF LOCATION OF FOUND MONUMENT

Center of Section 17, Township 29 North, Range 22 West, County of Ramsey, State of Minnesota.

At the corner location shown on the sketch

- On June 28, 2012 found a cast iron monument with top broken off. Tied monument for removal during road reconstruction.
- left monument as found
 raised/lowered monument
 removed monument (explain)
- On August 24, 2012 placed a 20 in. "RAMSEY COUNTY" cast iron monument within a cast iron manhole assembly.

SKETCH OF REFERENCE TIES

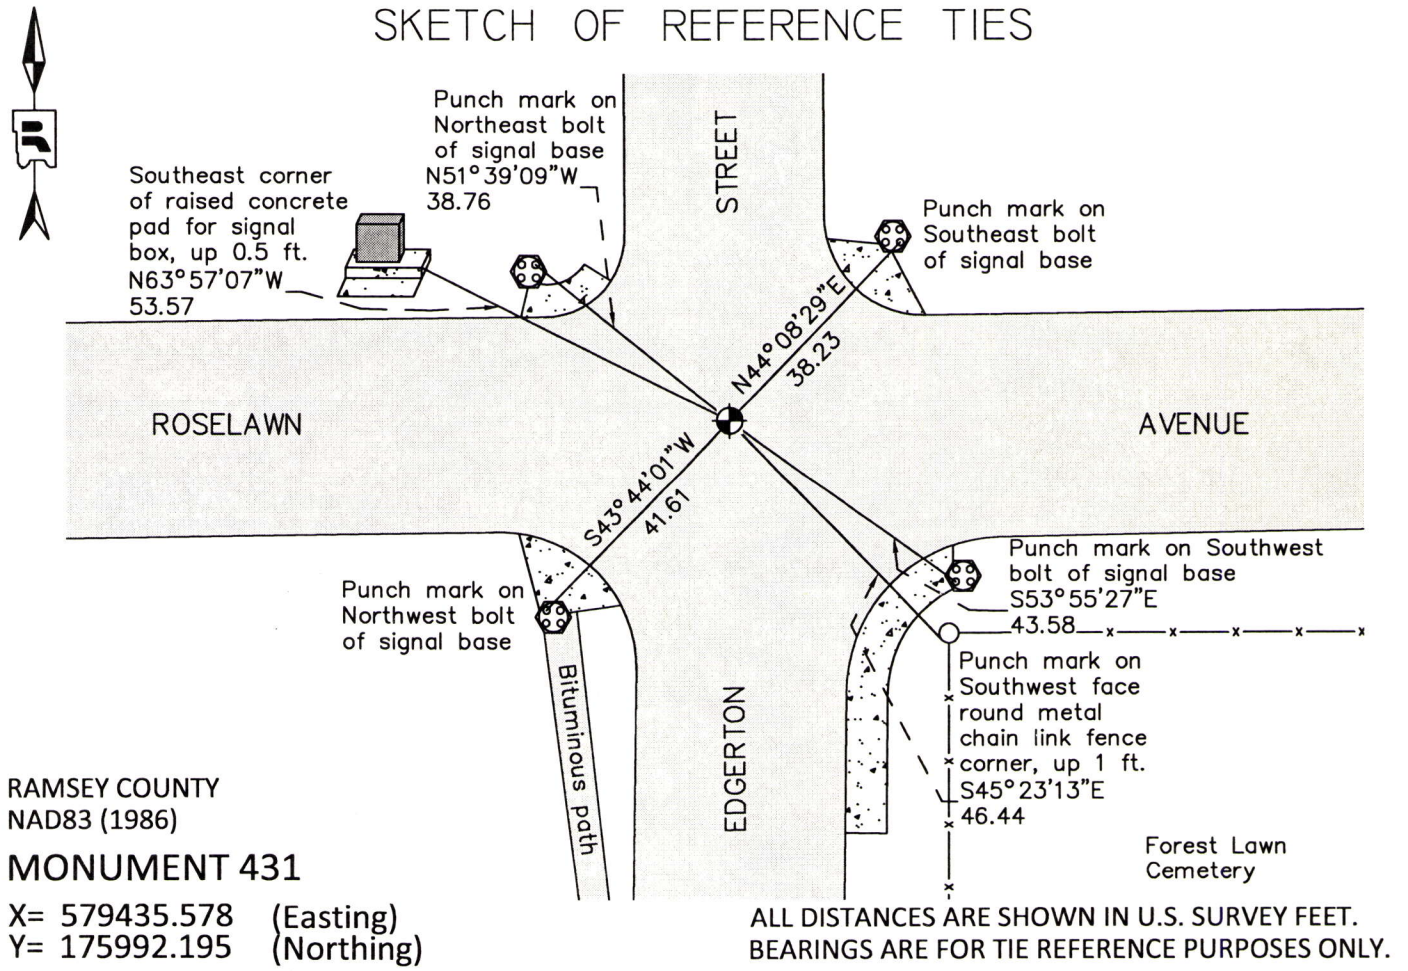

Statements of evidence relative to this corner are on the following page.

I hereby certify that this document was prepared by me or under my direct supervision and that I am a duly Licensed Land Surveyor under the laws of the State of Minnesota.

Daniel D. Baar 11-17-14
 Daniel D. Baar Date
 Minnesota License No. 45816

- County Surveyor Land Surveyor
 Deputy County Surveyor

OFFICE OF COUNTY SURVEYOR
 County of Ramsey

I hereby certify that this document was filed in the County Surveyor's office this 17th day of November, 20 14.

Craig W. Hinzman
 Craig W. Hinzman, L.S.
 Ramsey County Surveyor

MONUMENT 431

Center of Section 17, Township 29 North, Range 22 West

Fixed the Center of Section 17 by intersection, September 6, 1900.

Set monument, September, 1900.

Tied brass plug, October, 1955.

Found 1/4 in. diameter, 5 in. long brass rod; placed P.K. nails and dug down 3.5 ft. and found nothing, September 3, 1974.

Used old ties and placed a 20 in. cast iron monument, flush; road has approximately 2 in. of bituminous over concrete road; tied monument, September 20, 1974.

Removed 20 in. cast iron monument, June 15, 1990.

Placed a 20 in. cast iron monument, October 26, 1990.

Cemented top of monument, October 19, 1993.

Tied monument, July 8, 2002.

Retied monument, August 22, 2007.

Found cast iron monument with top broken off, checked local ties to center of shaft. Offset monument for removal during road reconstruction, June 28, 2012.

Set a 20 in. "Ramsey County" cast iron monument within a cast iron manhole assembly and tied, August 23, 2012.