

# CERTIFICATE OF LOCATION OF GOVERNMENT CORNER

Center Corner to Section 18 Township 29 N. Range 22 W. No. 2

STATE OF MINNESOTA,

County of Ramsey S.S.

I hereby certify that on the 19<sup>th</sup> day of June 1962,

that I, Charles O. Georgi, a Registered Land Surveyor, ~~County Surveyor,~~

~~County Highway Engineer,~~ <sup>reset</sup> found the center corner of Section 18, T 29 N, R 22 W.


which was evidenced by old ties

and I further certify that to perpetuate the location of such corner I did, at the exact location thereof, place a permanent marker consisting of cast iron monument

I further certify that I established 5 references or witness monuments consisting of ties to 2 House Foundations, 2 Power Poles and a guard post which reference or witness monuments are

located in the manner following.

- SW 103.30 Guard Post
  - SSE 41.46 Power Pole
  - ENE 37.15 Power Pole
  - NE 102.48 SW Cor. House Foundation
  - SE 92.18 NW Cor. House Foundation
- (C.I.M. flush with blacktop pave in center of intersection)

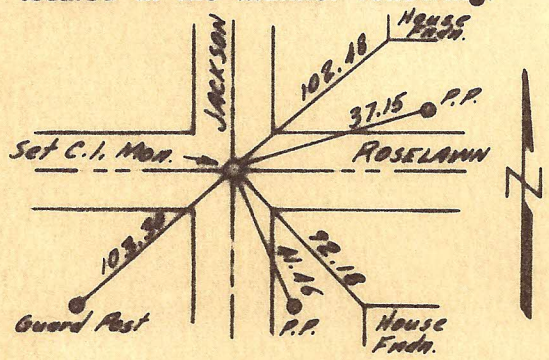

Dated at St. Paul, Minnesota, this 2<sup>nd</sup> day of August, 1962.

Charles O. Georgi  
~~County Surveyor, County Highway Engineer,~~  
 Registered Land Surveyor No. 3960

OFFICE OF THE REGISTER OF DEEDS

County of \_\_\_\_\_

I hereby certify that the within instrument was filed in this office for record on the \_\_\_\_\_ day of \_\_\_\_\_ A.D., 19\_\_\_\_.

\_\_\_\_\_  
 Register of Deeds  
 By \_\_\_\_\_, Deputy