

5 1/4 COR. SEC. 10-29-22

MANU. NO. 412

Found M.H. at location. Used Co. Hwy. ties to locate point. Placed P.K.'s and set East by witness man. 53 ft west and south on line.

Retied M.C.'s April 16, 1975.  
Removed West W.C. for const. 4-17-90  
Relocated positions (both mon) & retied. 10-91  
Replaced 412 S with W.C. (20" C.I.). 10-11-91  
Cemented in both man. 10-19-93  
Retied man. 4-10-03


TIED OUT WITNESS MONUMENTS FOR REMOVAL  
DURING ROAD RECONSTRUCTION 5-14-08

SET PK NAILS AT WITNESS MONUMENT LOCATIONS  
FROM TIES 9-22-08  
SET 20 IN. CAST IRON MONUMENT WITHIN A CAST  
IRON MANHOLE ASSEMBLY AT EACH CORNER  
POSITION 10-01-08

TIED MONUMENTS, 412 S 412 W. 6-24-09

412

SOUTH & WEST

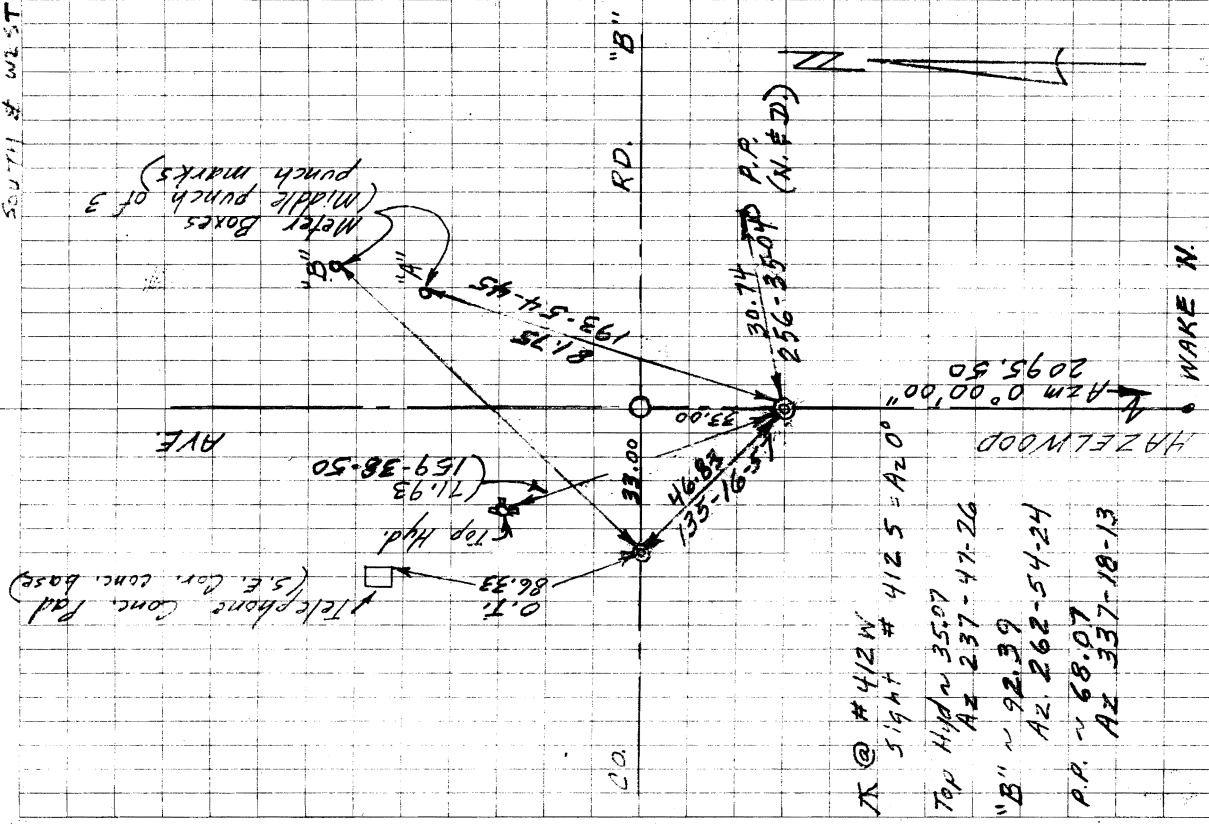

X @ #412W  
 5' 9" HT # 412 S - A20°  
 TOP HYD. ~ 35.07  
 AZ 237-47-26  
 "B" ~ 92.39  
 AZ 262-54-24  
 P.P. ~ 68.07  
 AZ 337-18-13