


APARTMENT OWNERSHIP NUMBER _____
CANABURY SQUARE
FLOOR PLANS
DECLARATION FILED AS DOCUMENT NO. _____ ON _____, 19__

I hereby certify that a survey was made by me under my direct supervision on the 28th day of August, 1974 for the property shown on this site plan drawn by others and that all locations and dimensions are correctly shown.

Donald W. Schmidt
 Registered Land Surveyor
 Minnesota Registration No. 10459


Subscribed and sworn to before me, a Notary Public, this 19th day of December, 1979.

Alan John Irwin
 Notary Public ANOKA County, MN
 My Commission Expires MAY 23, 1986

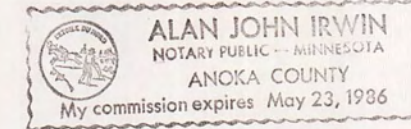

p. 8. 931
FILED
 DEC 10 1979

J. E. GOCKOWSKI, Clerk
 By *Eugene H. Gibbons*

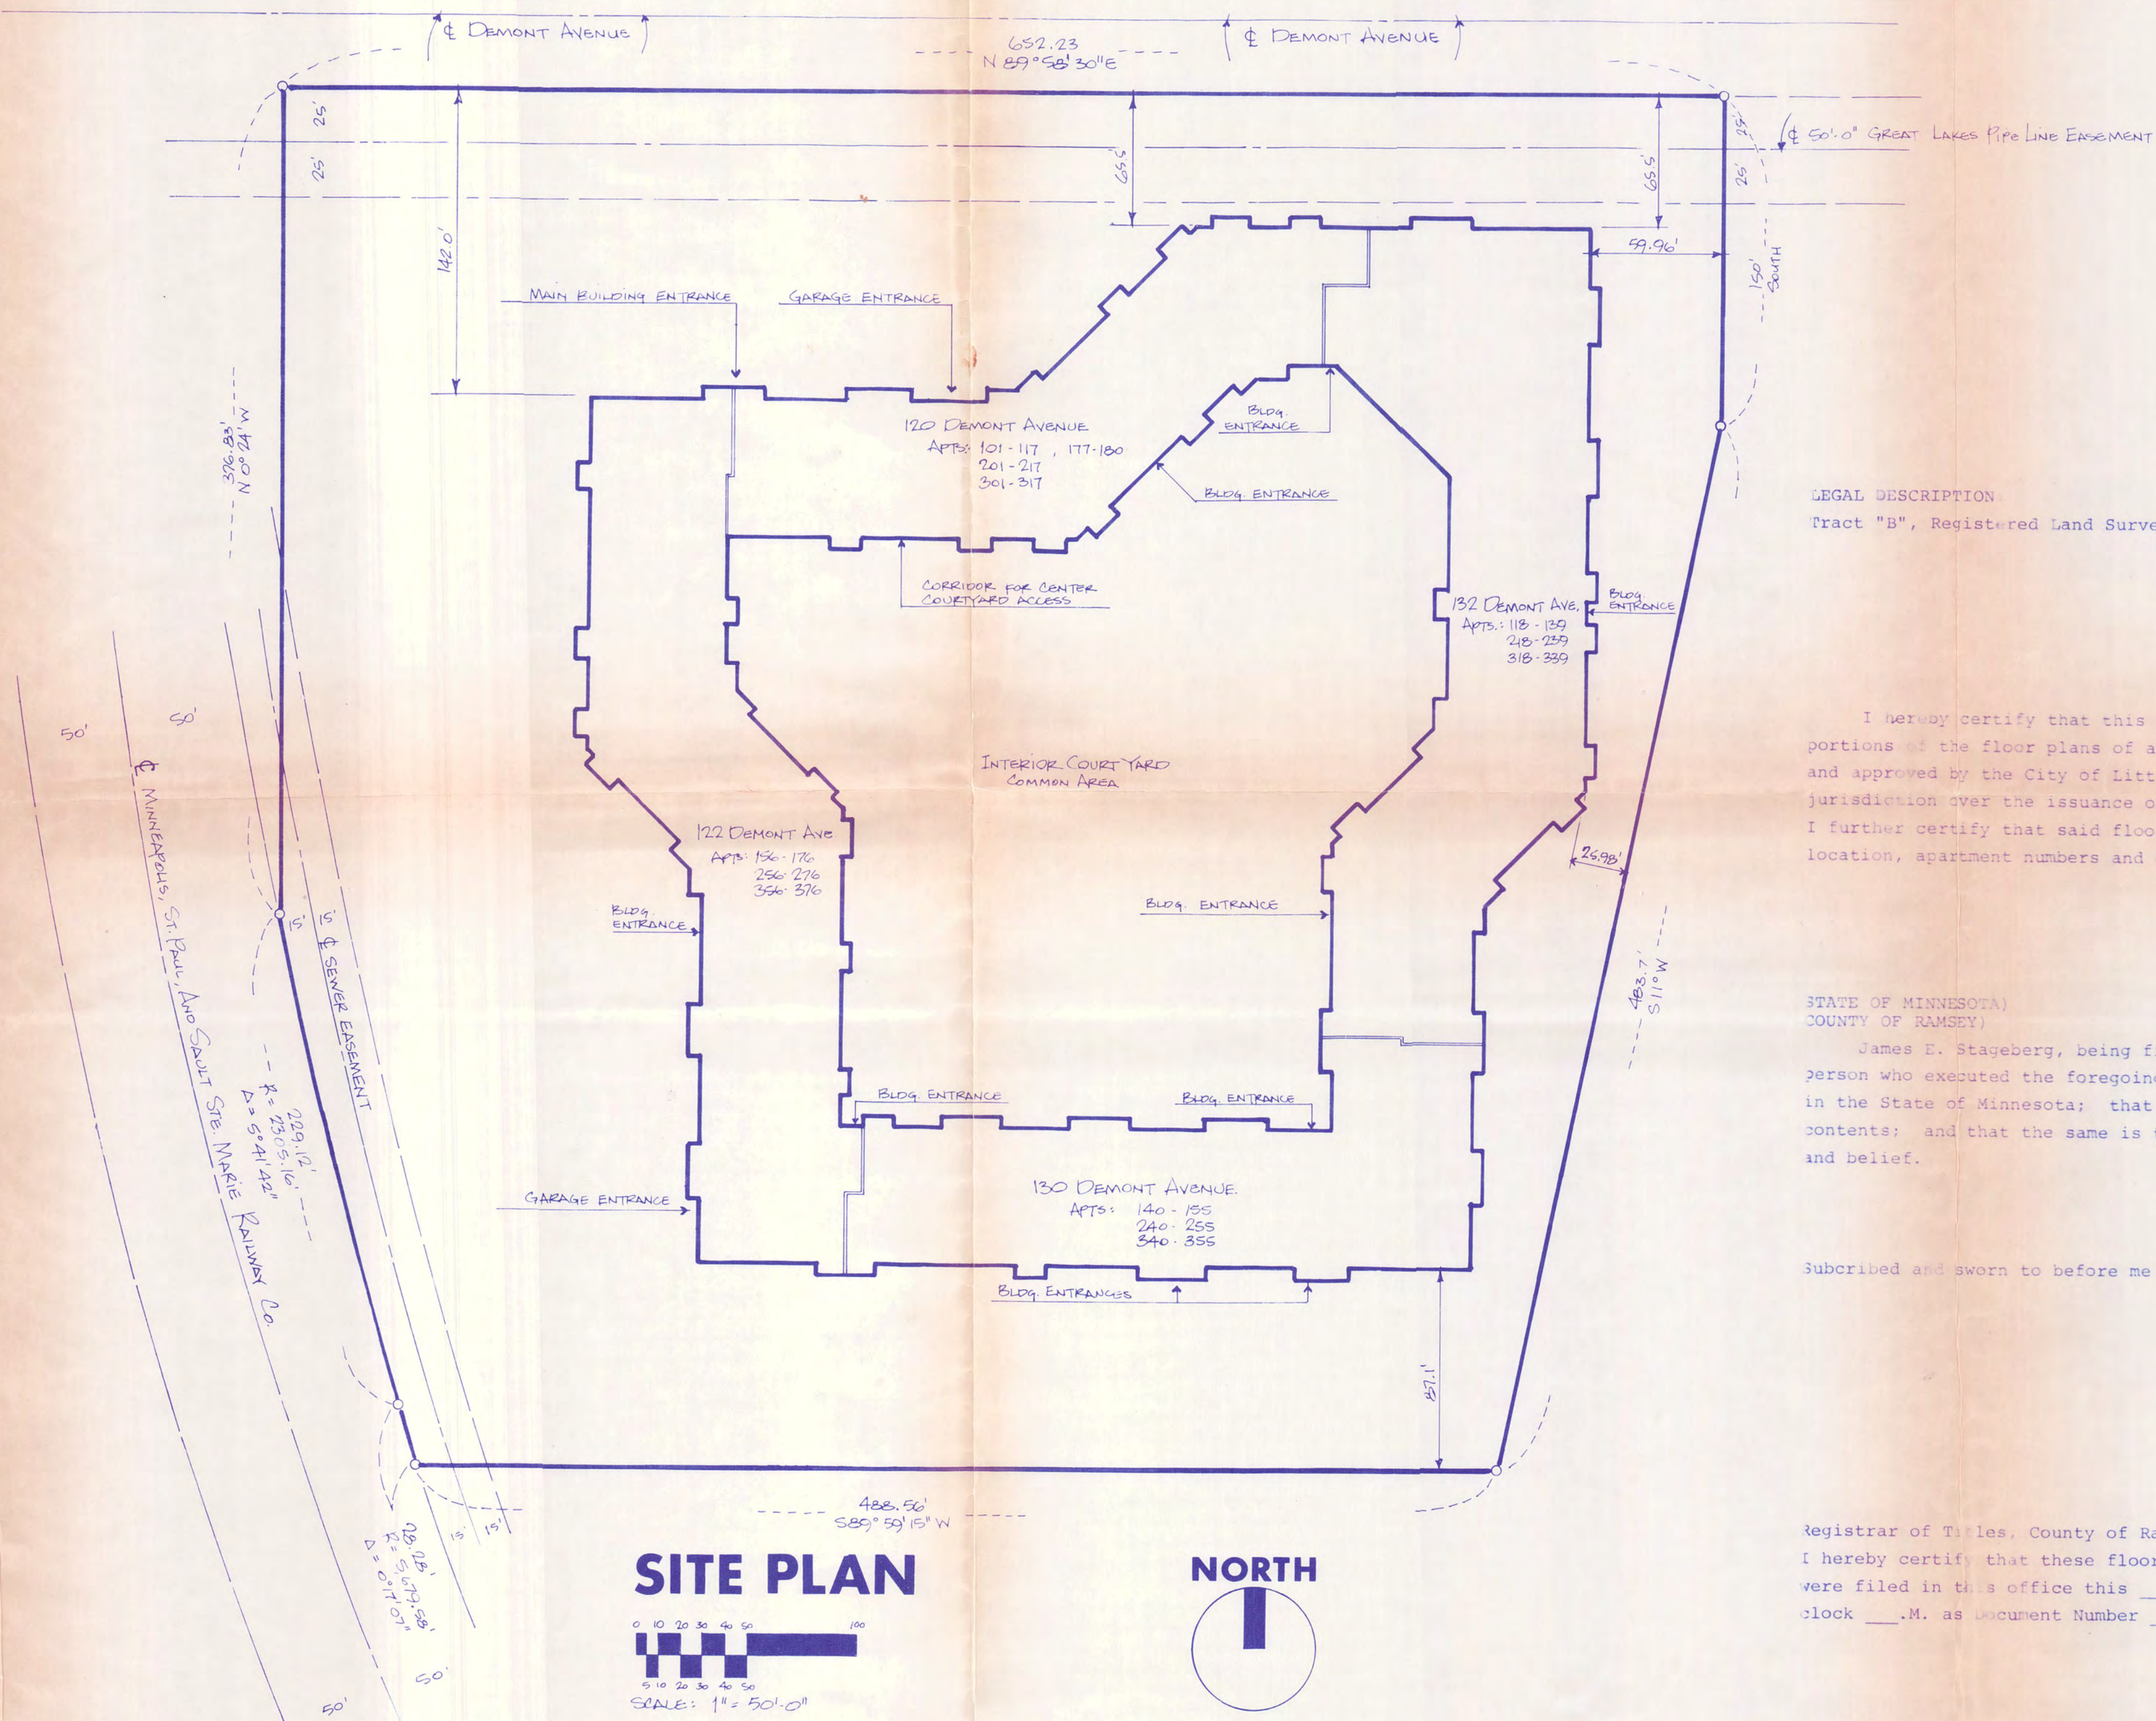

LEGAL DESCRIPTION
 Tract "B", Registered Land Survey No. 270, files of Registrar of Titles, County of Ramsey.

I hereby certify that this set of floor plans is an accurate copy of portions of the floor plans of a building named Canabury Square as filed with and approved by the City of Little Canada, Minnesota, the municipality having jurisdiction over the issuance of permits for the construction of said building. I further certify that said floor plans fully and accurately depict the layout, location, apartment numbers and dimensions of the apartments as built.

James E. Stageberg, Registered Architect
 Minnesota Registration No. _____

STATE OF MINNESOTA)
 COUNTY OF RAMSEY)
 James E. Stageberg, being first duly sworn, upon oath, says that he is the person who executed the foregoing certificate; that he is a registered architect in the State of Minnesota; that he has read said certificate and knows its contents; and that the same is true to the best of his knowledge, information and belief.

Subscribed and sworn to before me a Notary Public this _____ day of _____, 1979.
 Notary Public, _____ County, Minnesota
 My Commission Expires _____

Registrar of Titles, County of Ramsey, State of Minnesota
 I hereby certify that these floor plans of APARTMENT OWNERSHIP NUMBER _____ were filed in this office this _____ day of _____, 19__ at ____ o'clock ____ M. as Document Number _____.

By _____ Deputy
 Eugene H. Gibbons,
 Registrar of Titles