

Certificate of Survey

From the office of
GEORGI-SCHMIDT & ASSOC. INC.

3092 No. Lexington Ave., Roseville, Mn. 55113

LAND SURVEYING

483-4408

I Hereby Certify that this plat shows a survey made by me of the property described on this plat, and that the corners are correctly placed as shown, and that all locations have been correctly shown.

Job Number: 981


Surveyed For Housing Authority

Date July 1981


Scale 1"=20'

MARK UP
NOT FINAL

By _____
REGISTERED LAND SURVEYOR

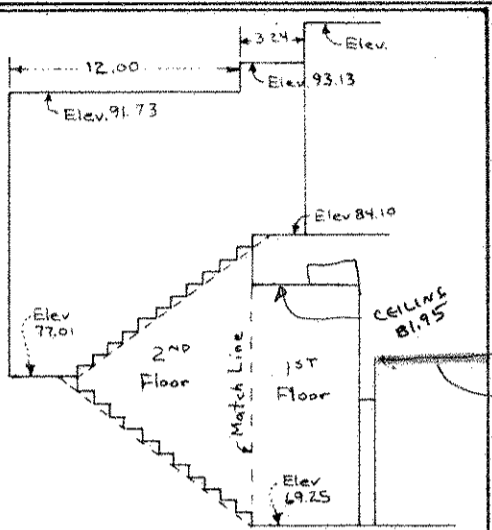


STAIRWAY ELEVATION
SCALE 1"=10'

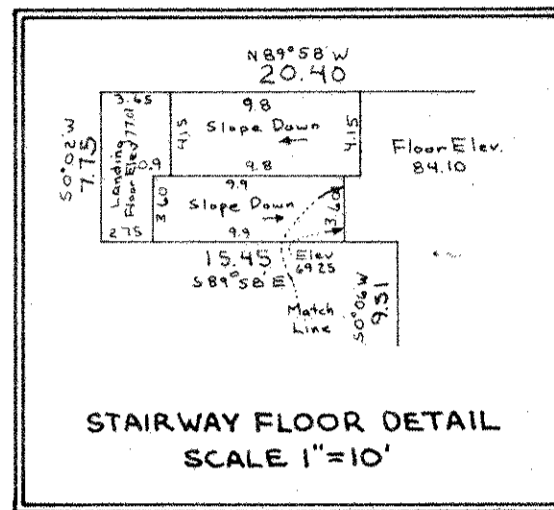


SIXTH

STREET

CEDAR STREET

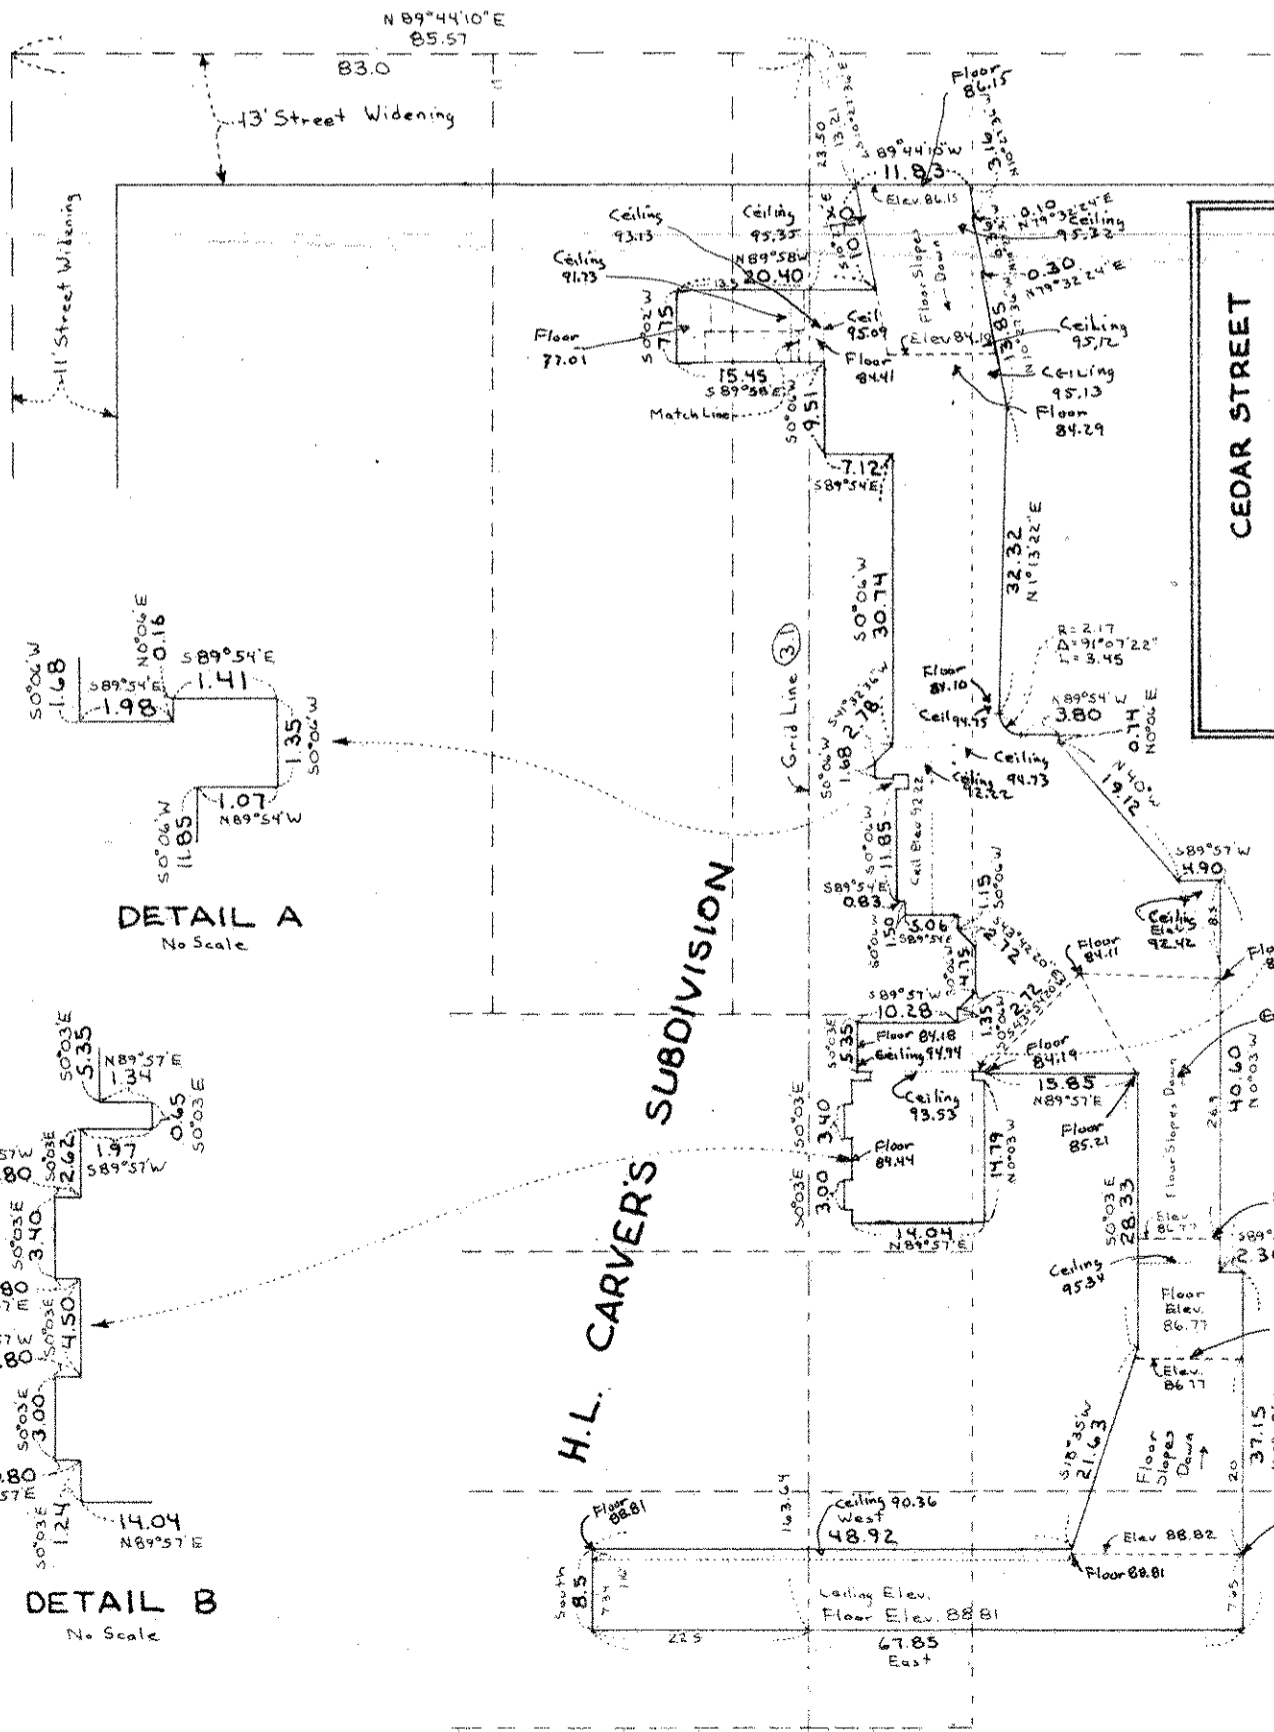

SECOND FLOOR
SCALE 1"=20'

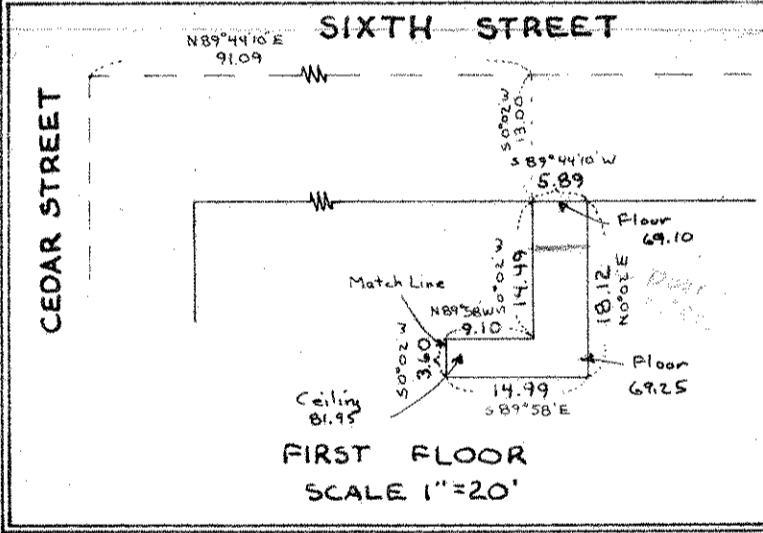

DETAIL A
No Scale

DETAIL C
No Scale

DETAIL B
No Scale