

LEGEND OF SYMBOLS	
	CABLE TRAY
	CONDUIT - INPLACE
	CONDUIT - F&I
	CONDUIT FIBER ONLY - INPLACE
	CONDUIT FIBER ONLY - F&I
	DIRECT BURIED COMMUNICATION CABLE - INPLACE
	DIRECT BURIED COMMUNICATION CABLE - F&I
	DIRECT BURIED POWER CABLE - INPLACE
	DIRECT BURIED POWER CABLE - F&I
	LOOP DETECTOR (SPECIFY) - (SPECIFY)
	FLASHER - INPLACE
	FLASHER - F&I
	FLASHING BEACON - F&I
	FOUNDATION INPLACE, GATE ARM - F&I
	FOUNDATION F&I, GATE ARM - F&I
	GATE ARM - INPLACE
	GUARDRAIL END TREATMENT (SPECIFY)
	GUARDRAIL (PLATE BEAM) - (SPECIFY)
	HANDHOLE - INPLACE
	HANDHOLE - F&I
	JUNCTION BOX OR CONDULET - INPLACE
	JUNCTION BOX OR CONDULET - F&I
	LANE ARROW
	OVERHEAD SIGN - INPLACE
	OVERHEAD SIGN - F&I
	PAD (SPECIFY) - INPLACE
	PAD (SPECIFY) - F&I
	PEDESTAL - INPLACE
	PEDESTAL - F&I

LEGEND OF SYMBOLS	
	RAMP CONTROL SIGNAL (DESIGN ONE-WAY) - INPLACE
	RAMP CONTROL SIGNAL (DESIGN ONE-WAY) - F&I
	RAMP CONTROL SIGNAL (DESIGN TWO-WAY) - INPLACE
	RAMP CONTROL SIGNAL (DESIGN TWO-WAY) - F&I
	RAMP CONTROL SIGNAL (DESIGN ONE-WAY)(SCREW IN BASE) - INPLACE
	RAMP CONTROL SIGNAL (DESIGN ONE-WAY)(SCREW IN BASE) - F&I
	RAMP CONTROL SIGNAL (DESIGN TWO-WAY)(SCREW IN BASE) - INPLACE
	RAMP CONTROL SIGNAL (DESIGN TWO-WAY)(SCREW IN BASE) - F&I
	SHELTER (TMS) - INPLACE
	SHELTER (TMS) - F&I
	SIGN (TYPE A OR D) - (SPECIFY)
	SIGN (TYPE C) - (SPECIFY)
	SIGN (TYPE CMS) - (SPECIFY)
	SIGNAL FACE - INPLACE
	SIGNAL FACE - F&I
	SPLICE CABINET (SPECIFY) - (SPECIFY)
	SPLICE VAULT (FIBER OPTIC) - (SPECIFY)
	TELEVISION CAMERA (CCTV) - (SPECIFY)
	WOOD POLE - F&I
	WOOD POLE - INPLACE
	WOOD POLE F&I, SERVICE INSTALLATION - F&I
	WOOD POLE INPLACE, SERVICE INSTALLATION - F&I
	WOOD POLE INPLACE, SERVICE INSTALLATION - INPLACE
	FIBER PATCHING SHELTER - F&I
	OUTDOOR FIBER SPLICE ENCLOSURE - F&I
	PULL VAULT
	ELECTRICAL SERVICE
	TRANSFORMER

I HEREBY CERTIFY THAT SHEETS TM1 THROUGH TM13 OF THIS PLAN WERE PREPARED BY ME OR UNDER MY DIRECT SUPERVISION AND THAT I AM A DULY LICENSED PROFESSIONAL ENGINEER UNDER THE LAWS OF THE STATE OF MINNESOTA.

*Leonard E. Palek, Jr.*  
 LEONARD E. PALEK, JR.  
 DATE Jan. 4, 2006 LIC. NO. 41525  
 DESIGNER Scott Coozenoy

REV. NO.	DATE: / /
REV. NO.	DATE: / /

CERTIFIED BY *Leonard E. Palek, Jr.* LIC. NO. 41525 DEC 30 2005  
 LICENSED PROFESSIONAL ENGINEER

STATE PROJ. NO. 6284-137 (TH 35W) SHEET NO. TM1 OF TM26 SHEETS

2-16-06 TMS COMPONENTS

**BB**

TABULATION OF ESTIMATED QUANTITIES - SP 6284-137			
ITEM	NOTES	UNIT	ESTIMATED QUANTITY
REMOVE BD-4 CABINET FOUNDATION		EACH	1
REMOVE CABINET FOUNDATION		EACH	1
SALVAGE BD-4 CABINET		EACH	1
SALVAGE CHANGEABLE MESSAGE SIGN		EACH	1
SALVAGE FIBEROPTIC SPLICE VAULT	3	EACH	1
SALVAGE CABINET	2	EACH	1
CABINET FOUNDATION		EACH	1
PEDESTAL FOUNDATION	1	EACH	1
SERVICE FOUNDATION		EACH	2
HANDHOLE TYPE-PVC METAL COVER		EACH	4
FIBEROPTIC SPLICE VAULT		EACH	1
OUTDOOR FIBER SPLICE ENCLOSURE		EACH	1
BURIED CABLE SIGN		EACH	8
1.5" NON-METALLIC CONDUIT		LIN FT	2780
2" NON-METALLIC CONDUIT		LIN FT	670
TELEPHONE CABLE 12 PR NO 19		LIN FT	800
POWER CABLE 1 CONDUCTOR NO 6		LIN FT	1500
CMS CONTROL CABLE 7.5 PAIR COND NO 24		LIN FT	175
FIBEROPTIC TRUNK CABLE 12MM-18SM		LIN FT	1800
LOOP DETECTOR SPLICE		EACH	1
INSTALL CABINET		EACH	1
SERVICE CABINET		EACH	2

TABULATION OF ESTIMATED QUANTITIES - SP 6284-137			
ITEM	NOTES	UNIT	ESTIMATED QUANTITY
FIBER OPTIC CABLE TESTING		LUMP SUM	1
FIBER OPTIC PIGTAIL TERMINATION		EACH	2
FIBER OPTIC CABLE SPLICING		EACH	2
INSTALL BD-4 CABINET		EACH	1
INSTALL CHANGEABLE MESSAGE SIGN		EACH	1
1.5" BORED CONDUIT		LIN FT	220
ARMORED FIBER OPTIC PIGTAIL CABLE 6SM		LIN FT	725
CONCRETE FOOTINGS (TYPE OH SPREAD)		CU YD	22
STRUCT STEEL-POSTS FOR OH SIGNS (DESIGN B)		POUND	6148
STRUCT STEEL-TRUSSES FOR OH SIGNS (DESIGN B)	(P)	POUND	8705
STRUCT STEEL-WLKWY SUPPORTS FOR OH SIGNS (DESIGN B)	(P)	POUND	198
STRUCT STEEL-WLKWY GRATING FOR OH SIGNS (DESIGN B)	(P)	POUND	360

- 1 BD-4 PEDESTAL FOUNDATION
- 2 CMS CONTROLLER CABINET
- 3 INCLUDES OUTDOOR FIBER SPLICE ENCLOSURE

TABULATION OF ESTIMATED QUANTITIES *2-16-06*

REV. NO.	DATE: / /
REV. NO.	DATE: / /



CERTIFIED BY *Leonard C. Palko* LIC.NO. 41525 DEC 30 2005  
 LICENSED PROFESSIONAL ENGINEER

STATE PROJ. NO. 6284-137 (TH 35W) SHEET NO. TM2 OF TM26 SHEETS

- ① INPLACE 1-FO CABLE (12MM, 18SM) & 1-12/PR NO.19
- ② INPLACE 1-FO CABLE (12MM, 18SM) & 1-12/PR NO.19  
HAND DIG SUFFICIENT CABLE LENGTH TO SEVER AND ROUTE CABLES TO SPLICE VAULT AND TO BD-4
- ③ F&I BD-4 FOUNDATION  
INSTALL SALVAGED BD-4
- ④ F&I FO SPLICE VAULT & OUTDOOR FIBER SPLICE ENCL.  
F&I FO CABLE SPLICING
- ⑤ F&I 1.5" NMC & 1-12/PR NO.19  
F&I 1.5" NMC & 1-FO CABLE (12MM, 18SM)
- ⑥ ABANDON INPLACE FO CABLE (12MM, 18SM) & 1-12/PR NO.19
- ⑦ F&I 1.5" NMC BORE & 1-12/PR NO.19  
F&I 1.5" NMC BORE & 1-FO CABLE (12MM, 18SM)  
NOTE: VERIFY BORED CONDUITS LOCATIONS-SEE ROADWAY AND BRIDGE PLANS FOR REMOVALS, INSTALLATIONS AND BRIDGE PILE WORK TO AVOID CONFLICTS.
- ⑧ SALVAGE INPLACE LED CMS & JB
- ⑨ SALVAGE INPLACE CMS CABINET & REMOVE FOUNDATION
- ⑩ ABANDON INPLACE 2" NMC, 3-1/C NO.6 & 1-7.5/PR NO.24
- ⑪ SALVAGE INPLACE FO SPLICE VAULT & OUTDOOR FIBER SPLICE ENCL.
- ⑫ SALVAGE INPLACE BD4  
REMOVE INPLACE BD4 FOUNDATION
- ⑬ ABANDON INPLACE 2" RSC & 3-1/C NO.4

- ⑭ ABANDON INPLACE 2" NMC, 1-6/PR NO.19 & 1-FO PIGTAIL
- ⑮ ABANDON INPLACE 1-12/PR NO.19 & 1-FO CABLE (12MM, 18SM)
- ⑯ INPLACE 334Z CAB (35W-30.8)  
REMOVE INPLACE FO PIGTAIL FROM CAB.
- ⑰ INPLACE 1-12/PR NO.19 & 1-FO CABLE (12MM, 18SM)  
HAND-DIG SUFFICIENT CABLE LENGTH TO SEVER AND ROUTE BOTH CABLES INTO INPLACE 334Z CABINET
- ⑱ INPLACE 1.5" RSC, 3-1/C NO.6 & 1-6/PR NO.19  
INPLACE 4" RSC, 1-3/C NO.4, 6-2/C NO.14, 1-6/PR NO.19, 1-FO PIGTAIL, 1-27/C NO.18, 3-1/C NO.10 & 1-RG11  
REMOVE 1-FO PIGTAIL  
F&I 1-12/PR NO.19
- ⑲ ABANDON INPLACE 2" RSC & 3-1/C NO.6
- ⑳ F&I 1.5" NMC & 1-12/PR NO.19
- ㉑ F&I 1.5" NMC & 1-FO CABLE (12MM, 18SM)
- ㉒ F&I 1.5" NMC BORE & 1-FO CABLE (12MM, 18SM)
- ㉓ INPLACE LOOP DETECTOR
- ㉔ SEVER INPLACE LOOP SPLICE  
F&I LOOP DETECTOR SPLICE
- ㉕ INPLACE 2" NMC & 1-2/C NO.14-PULL 2/C NO.14 TO HH10 FOR REINSTALLATION

- ㉖ REMOVE INPLACE 2" NMC & 2" RSC AS NECESSARY FOR BRIDGE RECONSTRUCTION-PULL 2/C NO.14 TO HH10 FOR REINSTALLATION  
F&I 2" NMC THRU RECONSTRUCTION AREA
- ㉗ INPLACE 1-FO CABLE (12MM, 18SM) & 1-12/PR NO.19
- ㉘ F&I 2" NMC & 3-1/C NO.6  
CONNECT TO INPLACE SERVICE EQUIP AT 334 CAB
- ㉙ F&I SERVICE EQUIP. FOUNDATION  
F&I TMS SERVICE CAB.  
COORDINATE POWER HOOKUP WITH XCEL

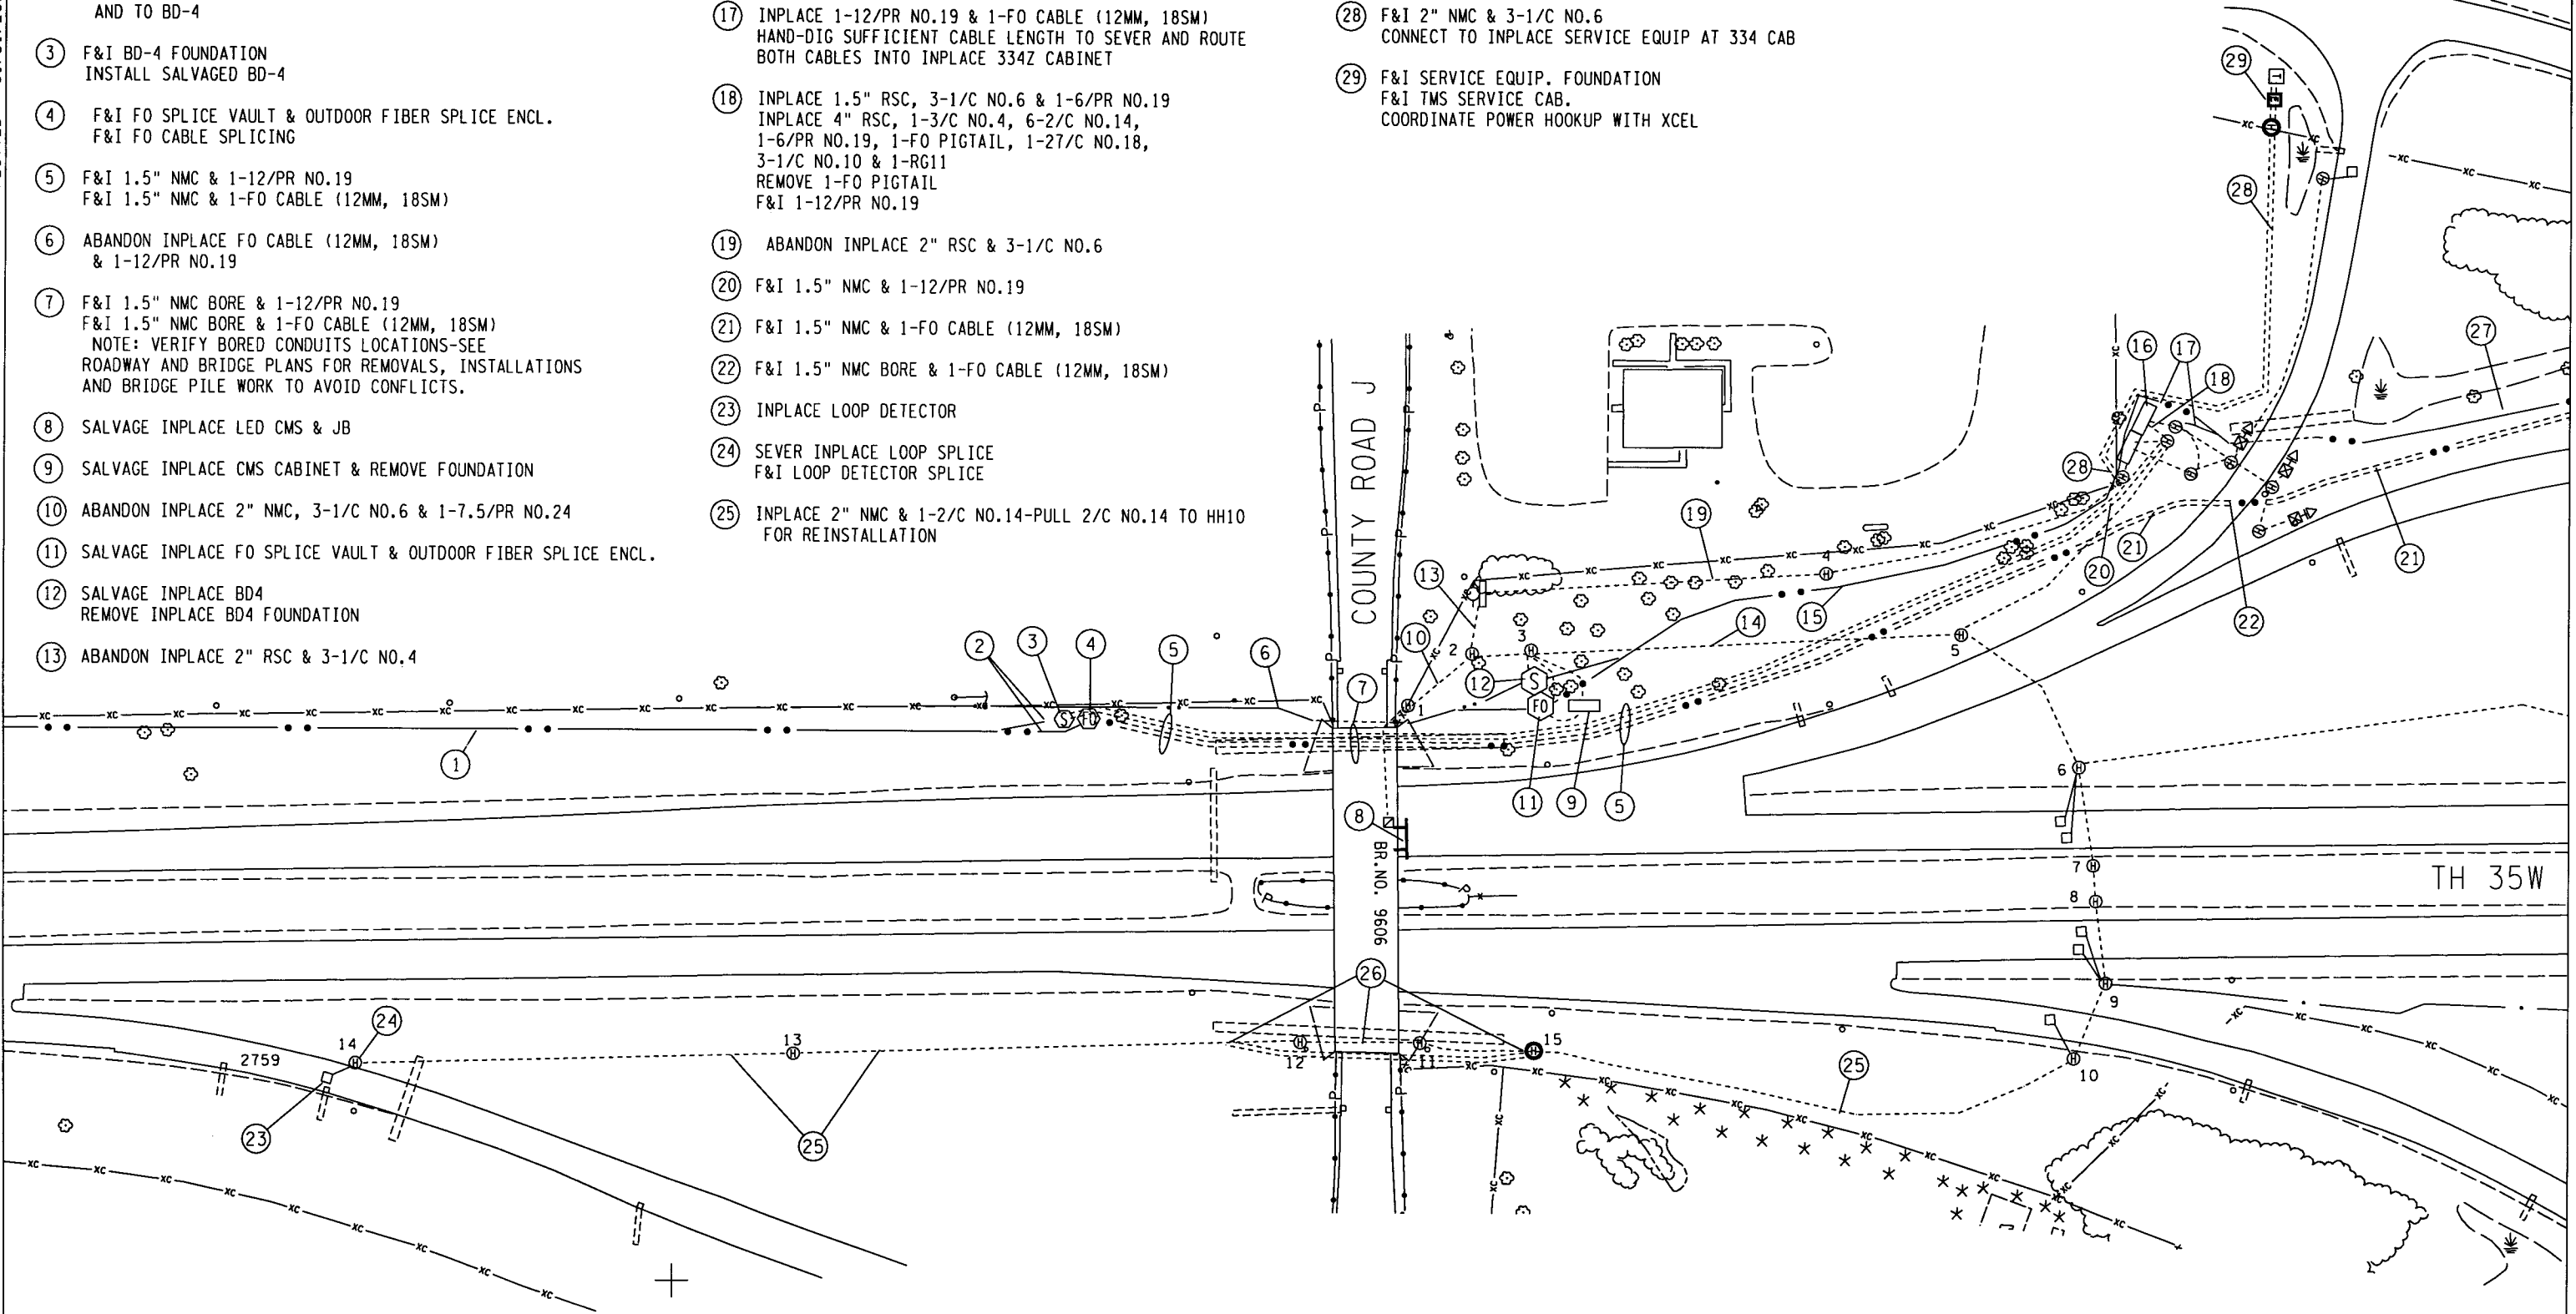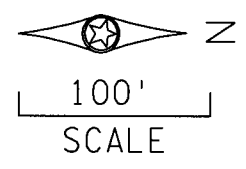

TRAFFIC MANAGEMENT SYSTEM  
 TH 35W AT CO. RD. J 2-16-06

REV. NO.	DATE: / /
REV. NO.	DATE: / /



CERTIFIED BY *Leonard E. Pahl* LIC. NO. 41525 DEC 30 2005  
 LICENSED PROFESSIONAL ENGINEER

STATE PROJ. NO. 6284-137 (TH 35W) SHEET NO. TM3 OF TM26 SHEETS

CooziSc0 MTM2KWF0043 TMS  
PLOTTED: 01/31/2006 08:00:12 AM

S:\TMC\MN\PRJ\0214-36\021436cor.d\shht2.dgn

- ① INPLACE 1-FO CABLE (12MM, 18SM) & 1-12/PR NO.19
- ② F&I 1.5" NMC & 1-FO CABLE (12MM, 18SM)
- ③ INPLACE FO SPLICE VAULT & OUTDOOR FIBER SPLICE ENCL. F&I FO CABLE SPLICING
- ④ F&I 1.5" NMC & 1-FO PIGTAIL (6SM)
- ⑤ F&I 334 FOUNDATION & SERVICE CABINET W/100A MAIN & 1-1/P 60A CB  
INSTALL SALVAGED CMS CONTROLLER CAB.
- ⑥ F&I 2" NMC, 3-1/C NO.6 & 1-7.5/PR NO.24
- ⑦ F&I SIGN BRIDGE (SEE SIGNING SHEETS)  
INSTALL LED CMS (OH XX-35W)  
F&I 2" RSC & 1-7.5/R FROM POST TO CMS  
F&I 2" RSC & 3-1/C NO.6 FROM POST TO CMS
- ⑧ F&I 3-1/C NO.6
- ⑨ F&I 2" NMC, 1-7.5/PR NO.24 & 1-FO PIGTAIL (6SM)  
F&I 2" NMC & 3-1/C NO.6
- ⑩ PROPOSED SOP (BY OTHERS) XCEL ENERGY
- ⑪ PROPOSED 120/240V TRANSFORMER (BY OTHERS) XCEL ENERGY

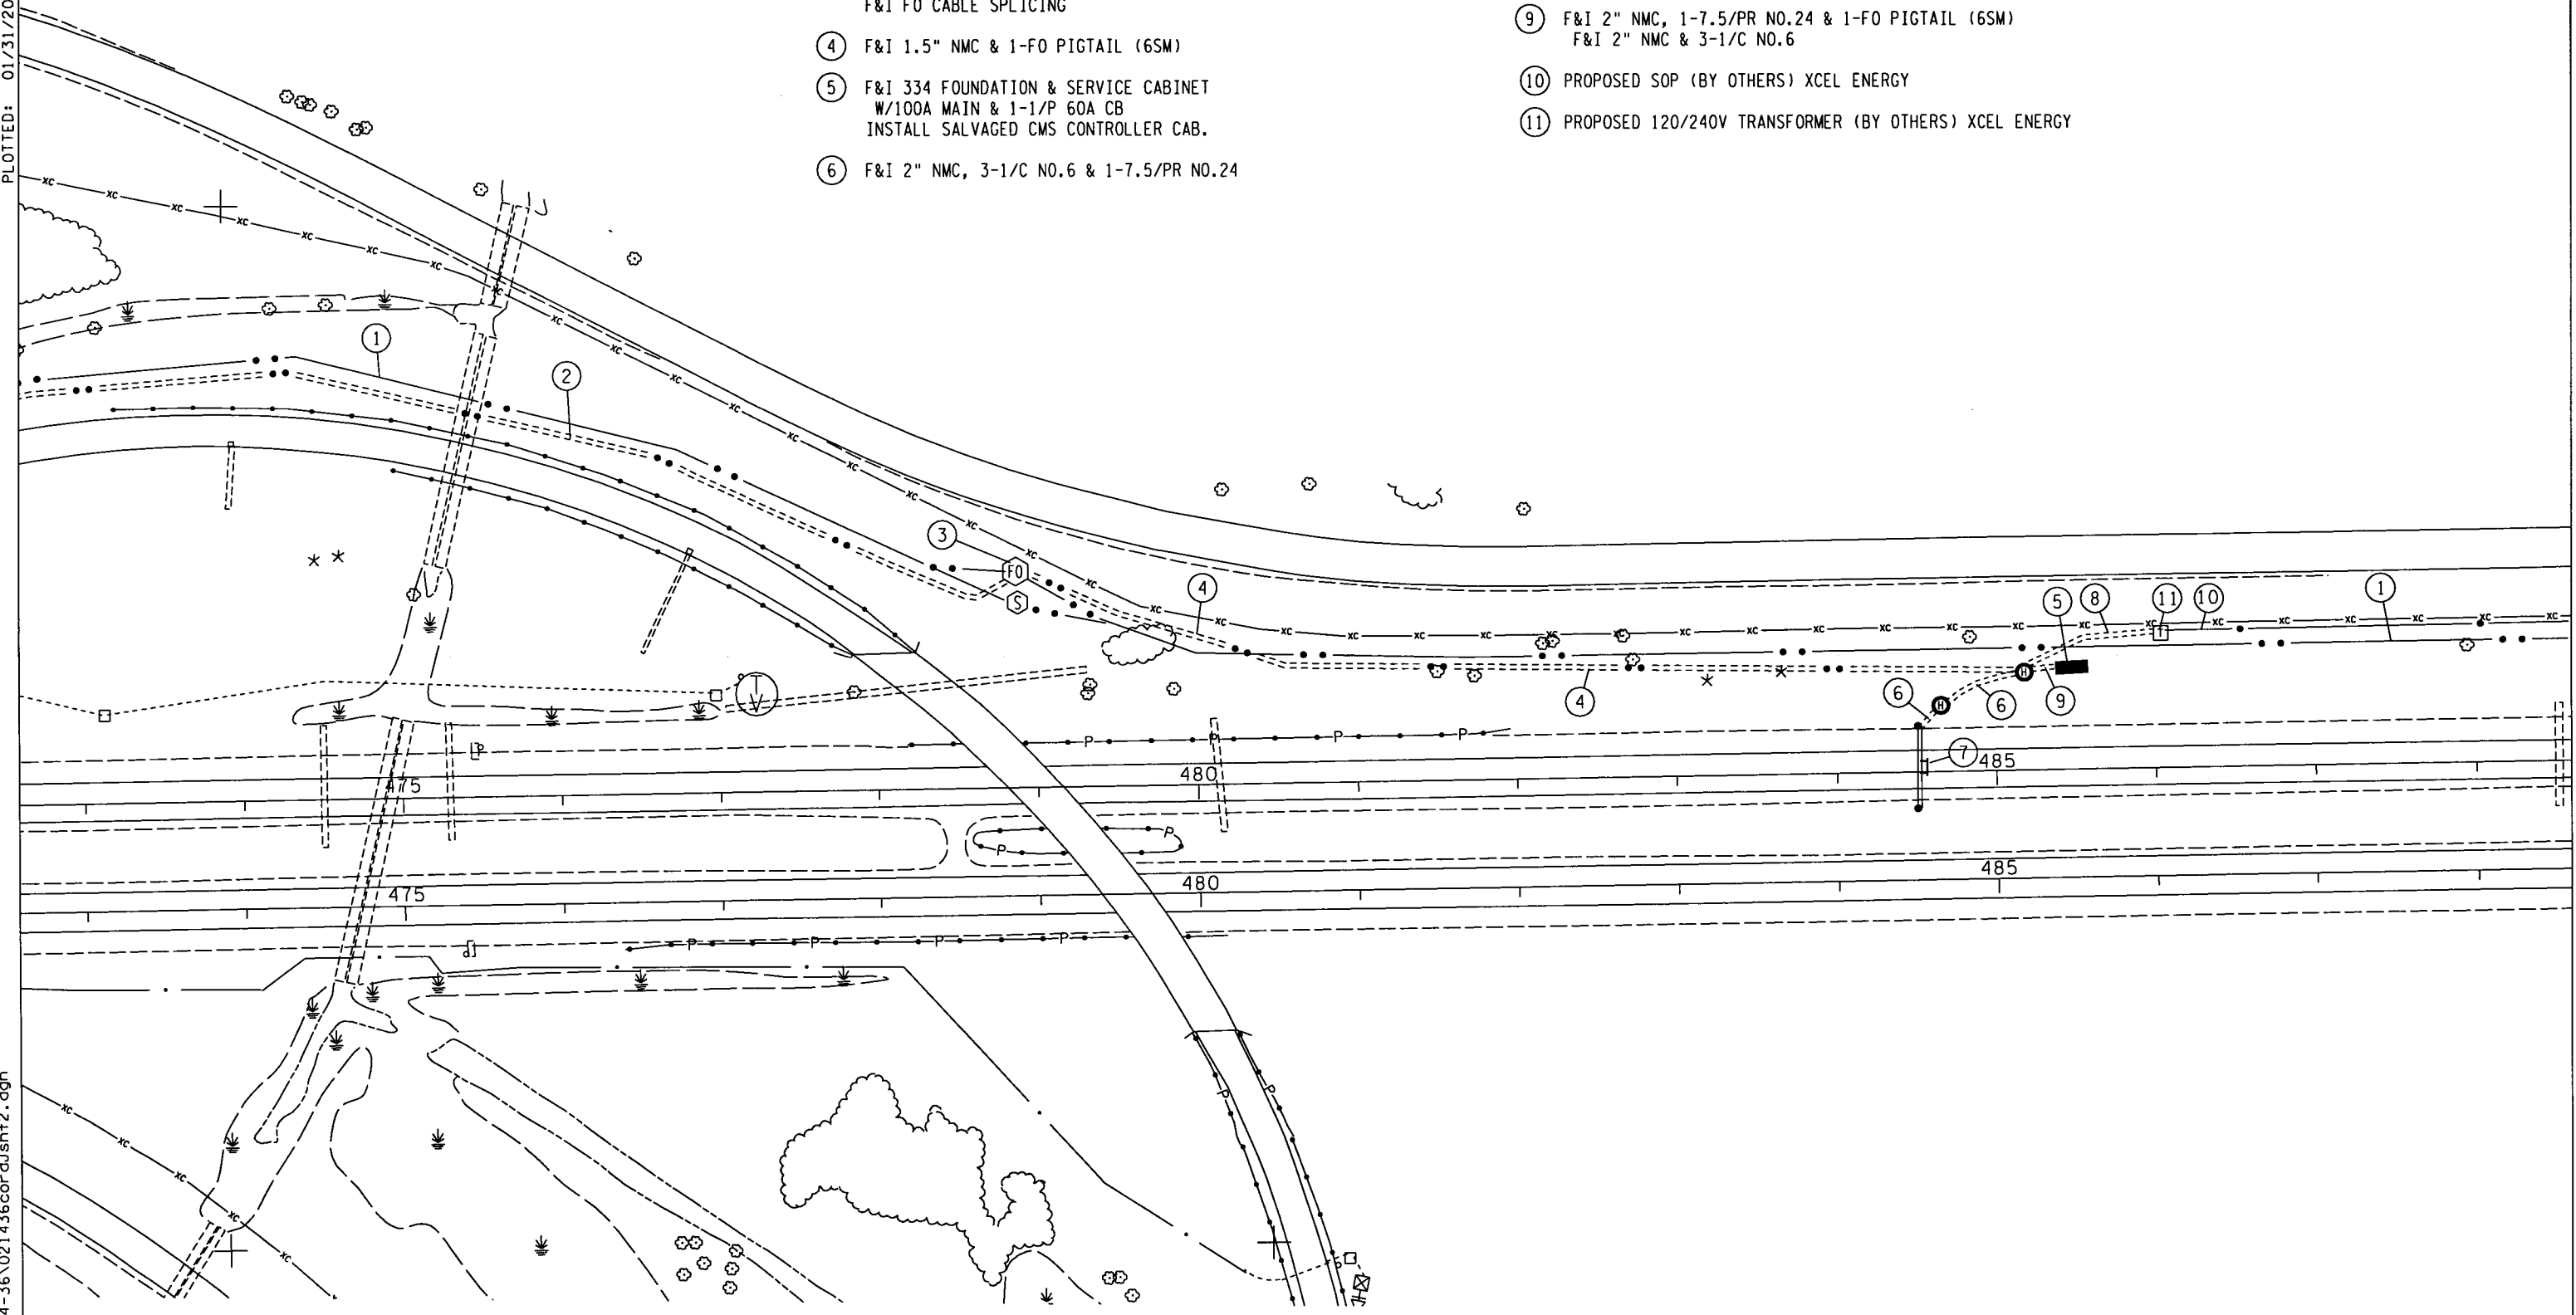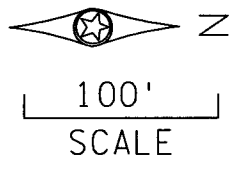


TRAFFIC MANAGEMENT SYSTEM  
TH 35W AT LAKE DRIVE 2-16-06

REV. NO.	DATE: / /
REV. NO.	DATE: / /

CERTIFIED BY *Leonard E. Palko* LIC.NO. 41525 DEC 30 2005  
LICENSED PROFESSIONAL ENGINEER

STATE PROJ. NO. 6284-137 (TH 35W) SHEET NO. TM4 OF TM26 SHEETS



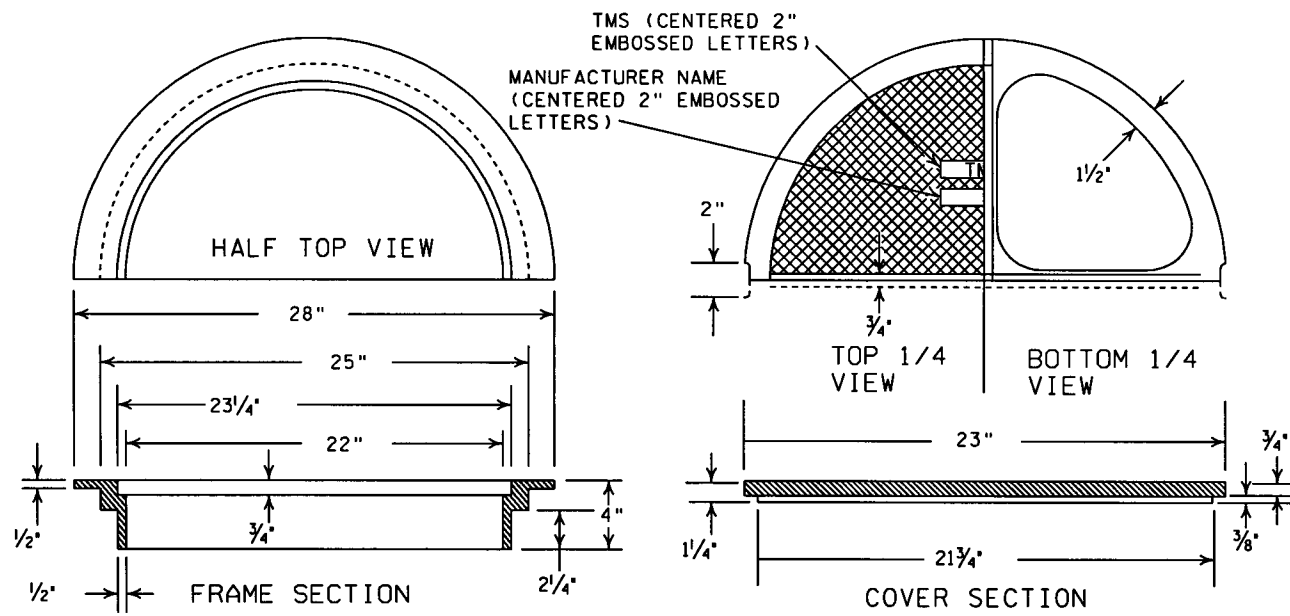


FRAME AND COVER CASTING

NOTE:  
 ALL CASTINGS ARE GRAY IRON PER  
 MN/DOT SPEC. 3321 CLASS 35B

LIGHT DUTY METAL COVER

USE APPROVED P.V.C.  
 CEMENT TO ATTACH  
 EXTENSION RING  
 TO HANDHOLE

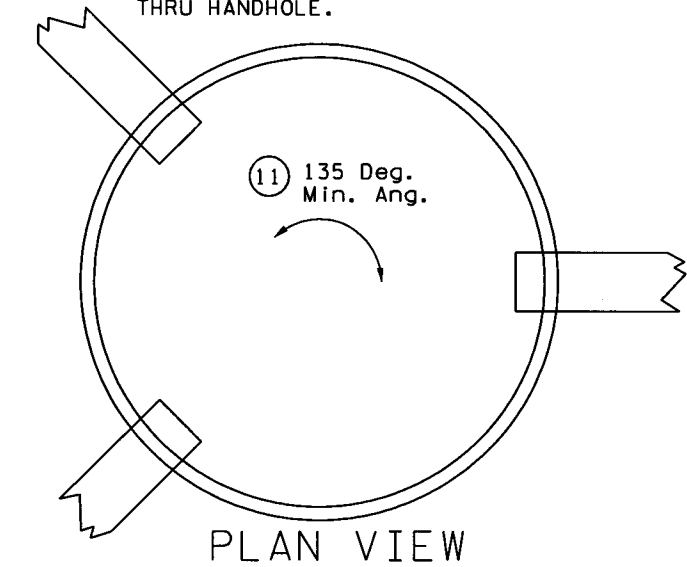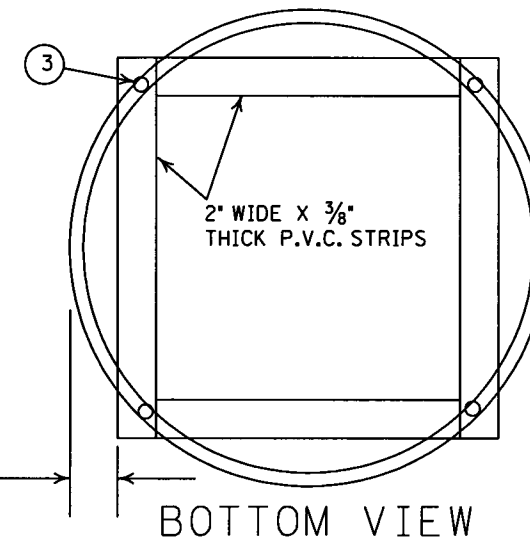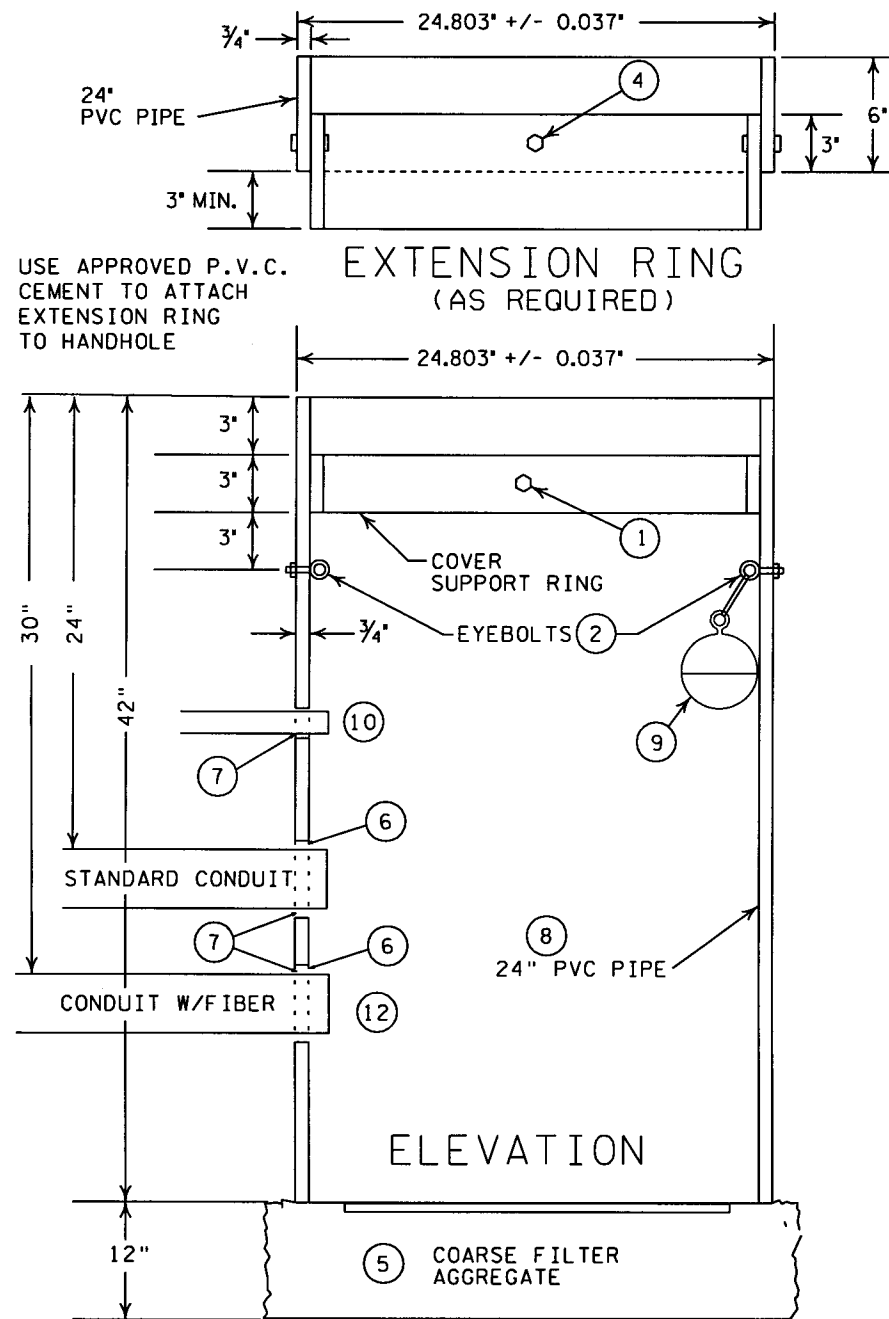

NOTES:





- ① ATTACH SPLIT 24" DIA. P.V.C. COVER SUPPORT RING WITH FOUR 3/8" DIA. X 2" LONG BOLTS AND NUTS AT 90° APART.
- ② TWO TYPE 2 SHOULDER EYEBOLTS, 3/8" DIA. X 1 1/4" SHANK LENGTH, WITH HEX. NUTS AT 180° APART (FOR LIFTING HANDHOLES AND SUPPORTING ELECTRICAL CABLES).
- ③ FOUR 1/4" X 1 1/4" LONG GALVANIZED LAG SCREWS.
- ④ ATTACH SPLIT 24" DIA. PVC EXTENSION RING WITH FOUR 3/8" DIA. X 2" LONG BOLTS AT 90° APART. THE BOLTS & NUTS COMPLY WITH MN/DOT 3391.2E, THE OTHER HARDWARE WITH 3392.
- ⑤ COMPACT COARSE FILTER AGGREGATE COMPLYING WITH MN/DOT 3149.2H TO A 12" DEPTH.
- ⑥ CONDUIT ENTRANCES IN THE BARREL ARE SIZED 1.0" LARGER THAN THE CONDUIT USED.
- ⑦ PLUG HANDHOLE AT CONDUIT INSTALLATION, PROVIDING A WATER TIGHT SEAL.
- ⑧ THE PVC PIPE COMPLIES WITH ASTM F 9T-1.
- ⑨ INSTALL ORANGE LOCATER BALL WITH TIE WRAP TO EYE BOLT
- ⑩ MINIMUM CONDUIT DEPTH FOR LOOP WIRES SHALL BE 1.5'.
- ⑪ INSTALL CONDUITS NO SHARPER THAN 135 DEG. FOR INSTALLATIONS OF CONDUIT WHERE FIBER WILL PASS THRU.
- ⑫ INSTALL CONDUITS WITH FIBER PASSING THRU AT 30" DEPTH THRU HANDHOLES. TRANSITION TO/FROM STANDARD 36" FIBER DEPTH OR PUSH DEPTH OUTSIDE HANDHOLES. NOTE: PROVIDE 36" CONDUIT STUB OUT FOR DIRECT BURIED FIBER PASSING THRU HANDHOLE.

REV. NO.	DATE: / /
REV. NO.	DATE: / /

CERTIFIED BY *Leonard E. Pahl* LIC. NO. 41525 DEC 30 2005  
 LICENSED PROFESSIONAL ENGINEER

STAND ALONE  
 SERVICE FOUNDATION  
 (SEE TMS SERVICE EQUIPMENT DETAIL)

① AFTER FOUNDATION AND CONDUITS ARE SET, FILL OPENING WITH SAND AND PLACE 1 INCH OF GROUT FLUSH WITH SURFACE OF FOUNDATION.

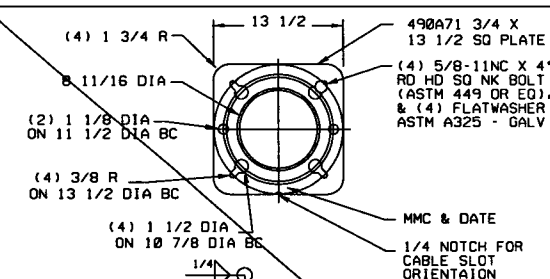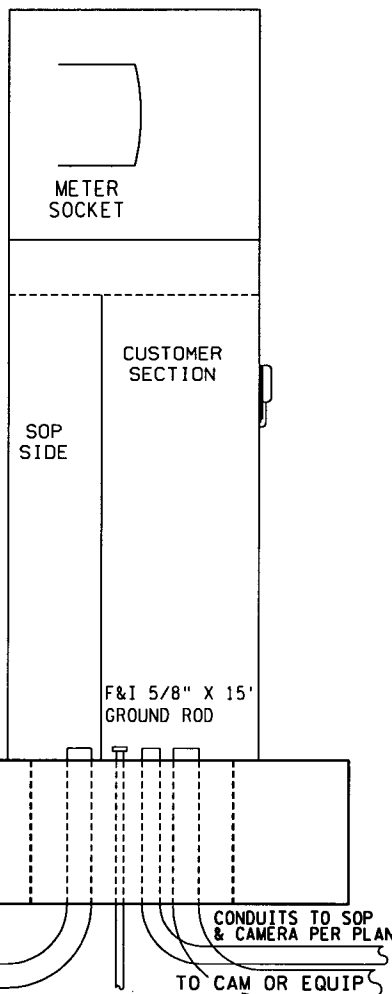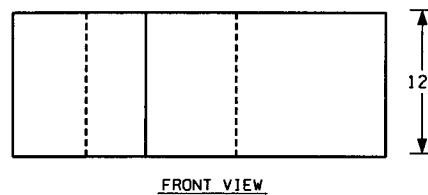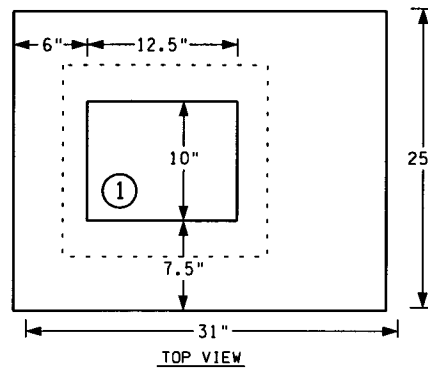

- NOTES:
1. PLATE MATERIAL - LOW CARBON STEEL 36,000 PSI MIN YIELD PER ASTM A36
  2. PIPE MATERIAL - 8" SCH 20 PIPE 35,000 PSI MIN YIELD PER ASTM 53 GRB
  3. ANCHOR BASE IS DESIGNED TO WITHSTAND 15,000 FT LBS OF INSTALLATION TORQUE
  4. ANCHOR BASE TO BE SHIPPED WITH HARDWARE BAGGED AND SECURED TO PIPE SHAFT
  5. ANCHOR BASE TO BE HOT DIP GALVANIZED PER ASTM A123

PART NO	QTY	DESCRIPTION
490A35-1		ANCHOR BASE WELDMENT
490A35		ANCHOR BASE W/HARDWARE

SCREW IN RAMP  
 CONTROL SIGNAL FOUNDATION  
 (SEE RAMP CONTROL SIGNAL DETAIL)

FLARE THE BOTTOM OF ONE TOOTH OUTWARD & THE OTHER TOOTH INWARD 1/4 TO 3/8 OF AN INCH

① AFTER FOUNDATION AND CONDUITS ARE SET, FILL OPENING WITH SAND AND PLACE 1 INCH OF GROUT FLUSH WITH SURFACE OF FOUNDATION.

5'x3'x1'  
 EQUIPMENT PAD  
 (TYP.)



3" SPACING  
 TYP.

TOP VIEW  
 NOT TO SCALE

FRONT VIEW  
 NOT TO SCALE


4" SPACING  
 (TYP.)

TYPICAL 334 SERIES  
 & CMS FOUNDATION  
 WITH SERVICE CABINET  
 (SEE CABINET INSTALLATION DETAIL)

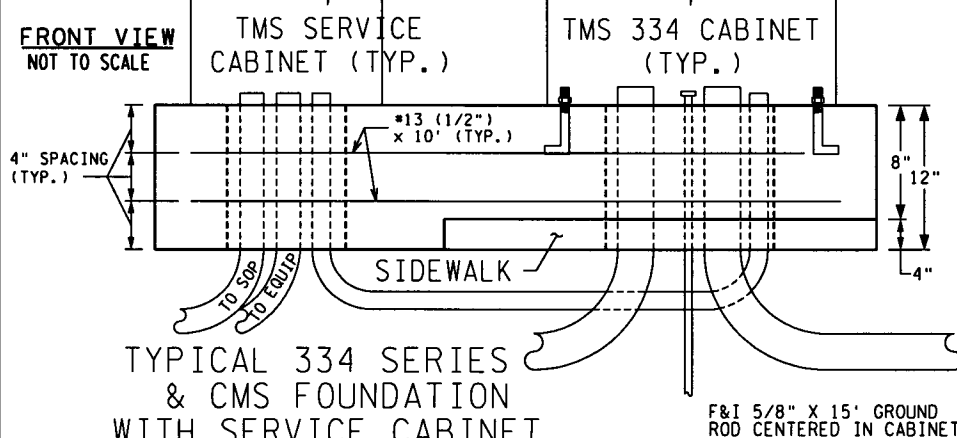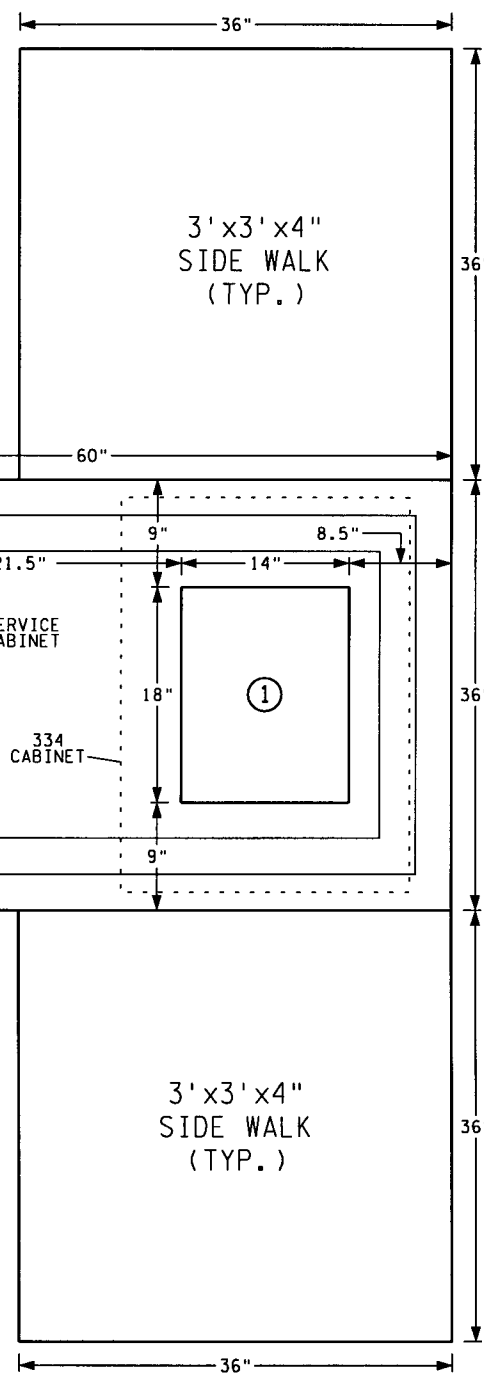

SEE STD. PLATE 8120 FOR  
 ANCHOR BOLT REQUIREMENTS

CENTER CONDUITS WITHIN BOLT PATTERN  
 2" MAX HEIGHT ABOVE FOUNDATION  
 INCLUDING BUSHING.

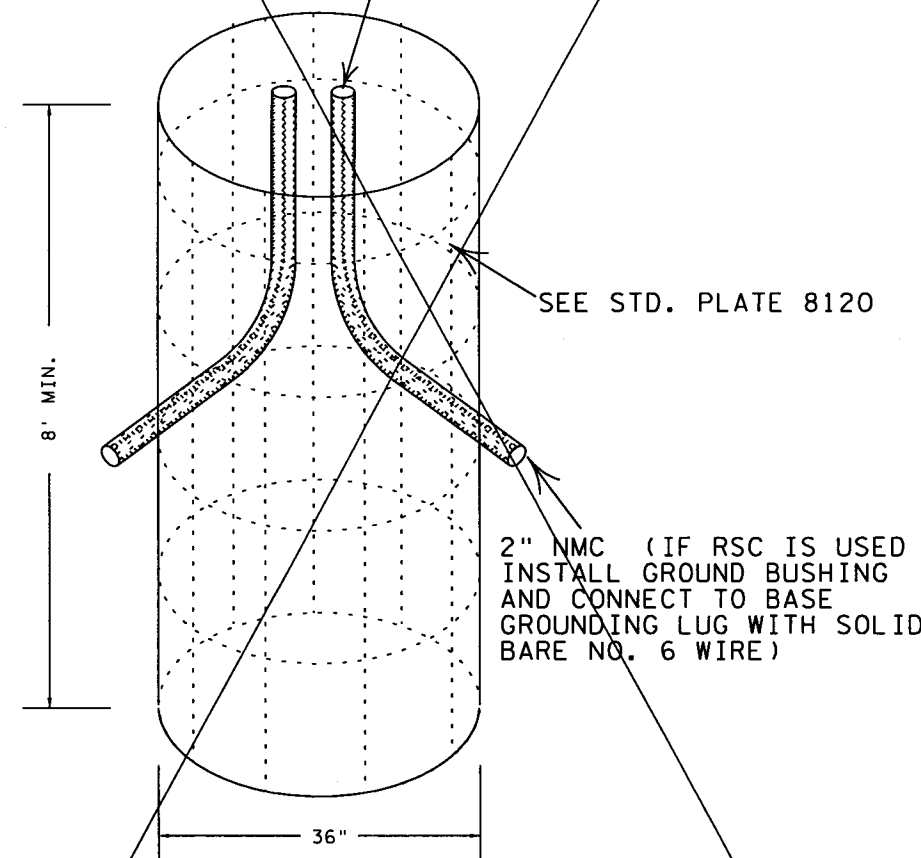

CCTV POLE FOUNDATION  
 (SEE CCTV INSTALLATION DETAIL)

TYPICAL FOUNDATION DETAILS

2-16-06

REV. NO.	DATE	DESCRIPTION


CERTIFIED BY *Leonard E. Palko* LIC. NO. 41525 DEC 30 2005  
 LICENSED PROFESSIONAL ENGINEER

STATE PROJ. NO. 6284-137 (TH 35W) SHEET NO. TM6 OF TM26 SHEETS

F&I SERVICE  
 EQUIPMENT AS  
 CALLED IN PLANS

INSTALL 334 CMS  
 CONTROL CABINET  
 (MNDOT PROVIDED)

1. F&I POWER CABLE FROM SOURCE OF POWER-TERMINATE AT TERMINAL BLOCK
2. F&I 3-1/C NO.6 TO CMS-TERMINATE AT EACH END
3. F&I 1-FO PIGTAIL-PLACE 1 LOOP OF PIGTAIL CABLE WITHIN CABINET-TERMINATE END & LAND IN PATCH PANEL
4. FIBER OPTIC PATCH CORDS (MNDOT PROVIDED & INSTALLED)
5. F&I 7.5/PR NO.24 TO CMS-CONNECTED BY CMS MANUFACTURER (PROVIDE 10' SLACK IN CABINET & 40' SLACK IN SIGN)
6. RS232 LINE (MNDOT PROVIDED & INSTALLED)
7. F&I 1-1/C NO.6 BARE GROUND WIRE-COAT CONNECTION WITH ANTI-OXIDIZING AGENT
8. INSTALL NEOPRENE GASKET (SUPPLIED BY MNDOT)
9. DATA LINK (MNDOT PROVIDED & INSTALLED)
10. F&I SHEATH GROUNDING UNIT (NORSCAN #2706)

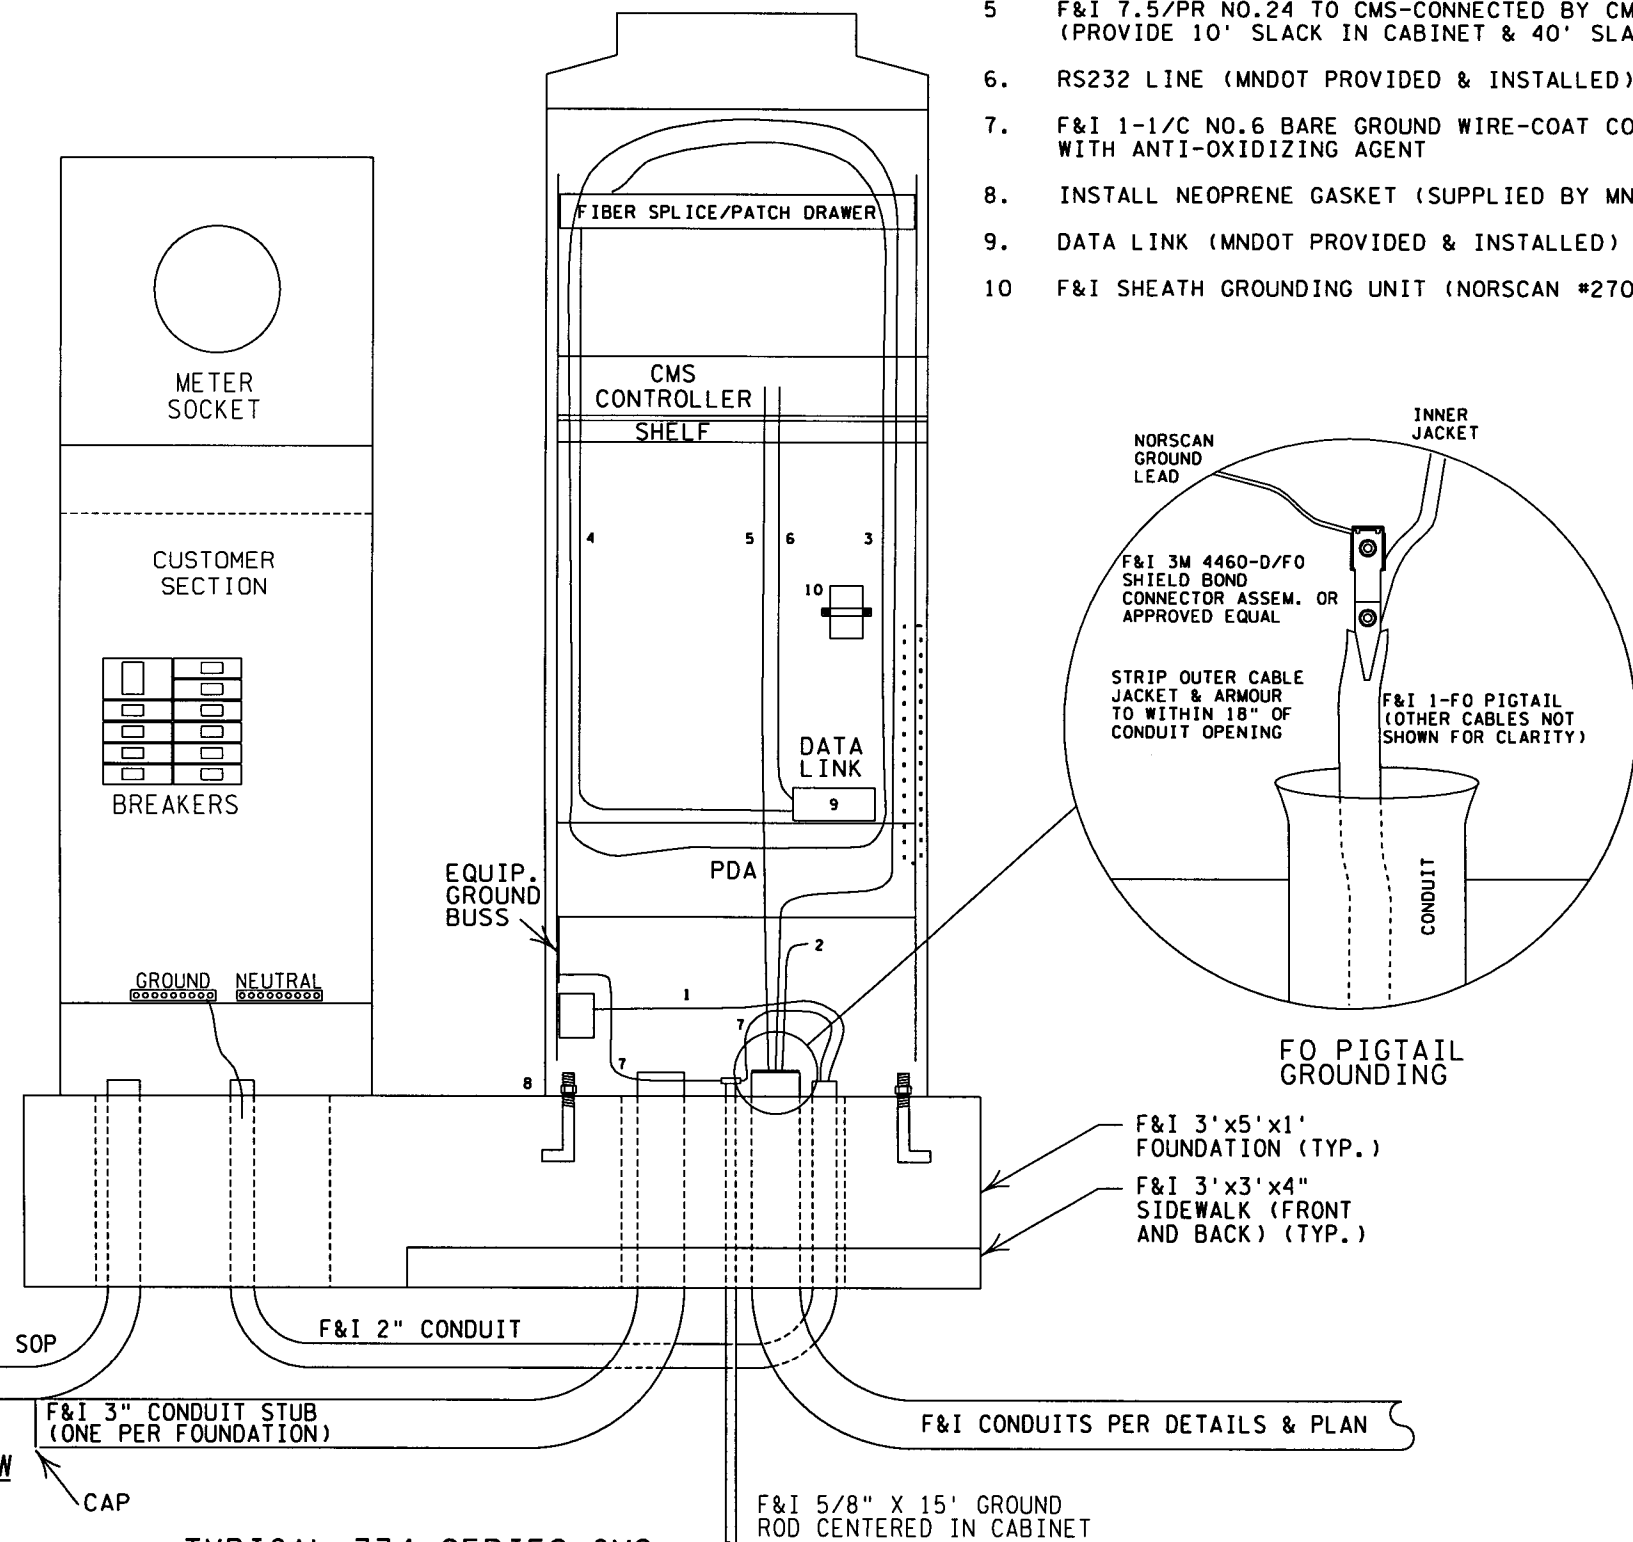


TYPICAL 334 SERIES CMS  
 CABINET INSTALLATION

FRONT VIEW  
 NOT TO SCALE

- MNDOT PROVIDED
1. TMS 334Z CONTROL CABINET INCLUDING:
    - A) CMS CONTROLLER
    - B) FIBER OPTIC PATCH PANEL
    - C) CB ENCL. & BREAKER INSIDE CABINET
    - D) NEOPRENE CAB. GASKET

- MNDOT PROVIDED & INSTALLED
1. FIBER OPTIC PATCH CORDS
  2. FO PIGTAIL & PATCH PANEL LABELS WITHIN CMS CABINET
  3. DATA LINK

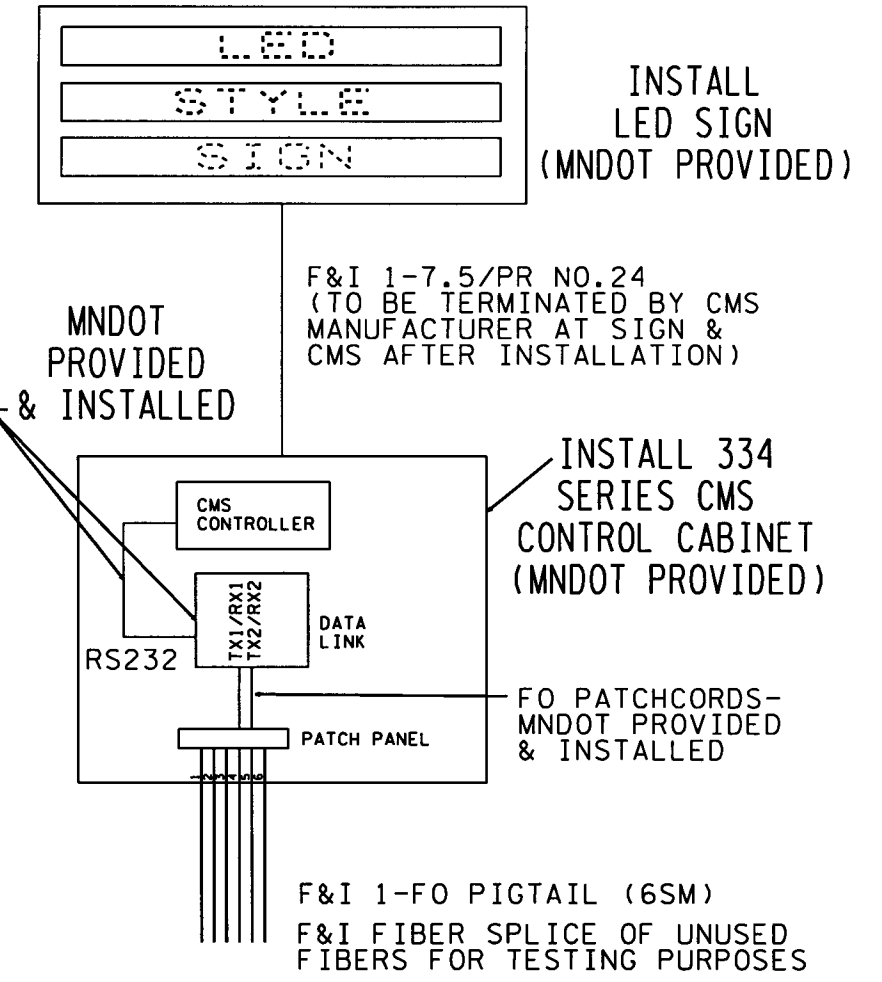

TYPICAL FIBER OPTIC CONTROLLED  
 CMS EQUIPMENT INSTALLATION




TYPICAL DMS CABINET INSTALLATION

REV. NO.	DATE: / /
REV. NO.	DATE: / /

STAINLESS STEEL COILING BRACKETS,  
 SIZED FOR 4" PIPE  
 & 8-3/8" IN HEIGHT (6 EACH).  
 PLACE 12" BELOW TOP OF PC RING.  
 FASTEN WITH SS HH BOLTS 5/8" X 4-1/2"  
 LONG AND SS "NYLOCK" STYLE LOCKNUT

COVER FEATURES

- \* 20845 LB WHEEL LOADING
- \* APPROX. WT. = 180 LBS.
- \* (2) 3/8"-16 X 3-1/2" LONG  
 SS HH BOLTS
- \* POLYMER CONCRETE  
 FRP CONSTRUCTION
- \* NON-SKID SURFACE
- \* IDENTIFICATION LOGO:  
 MNDOT FIBER

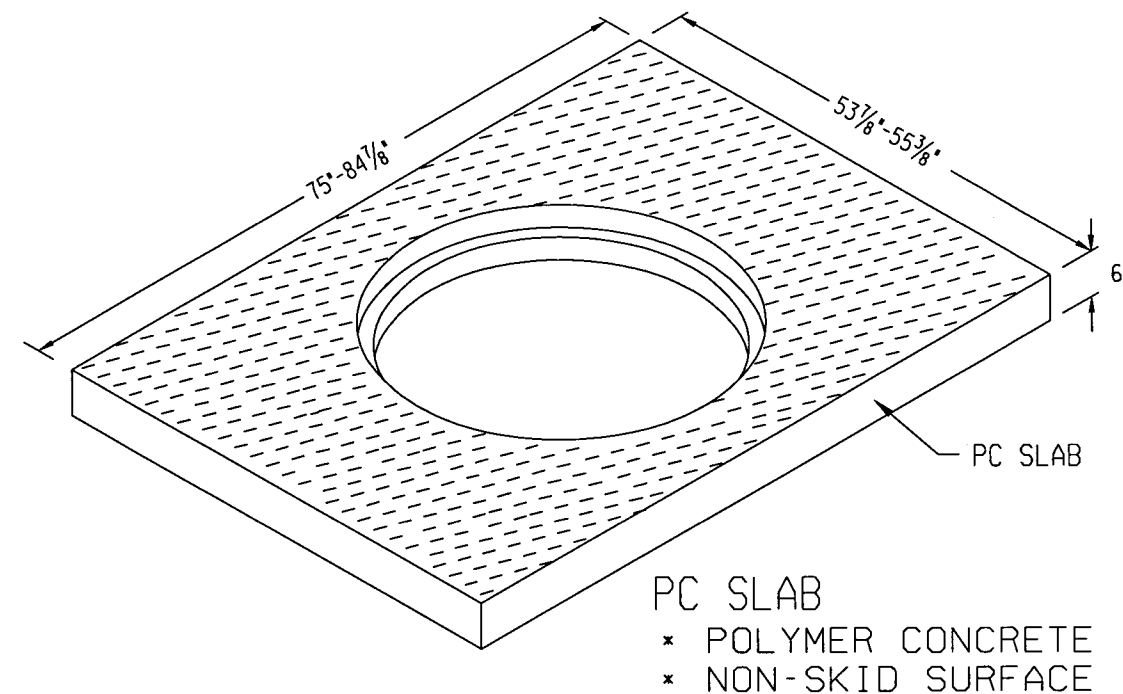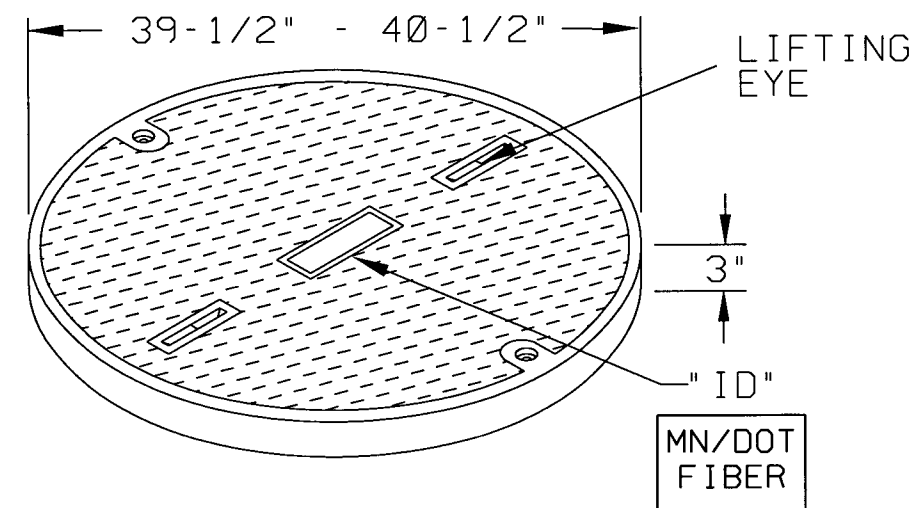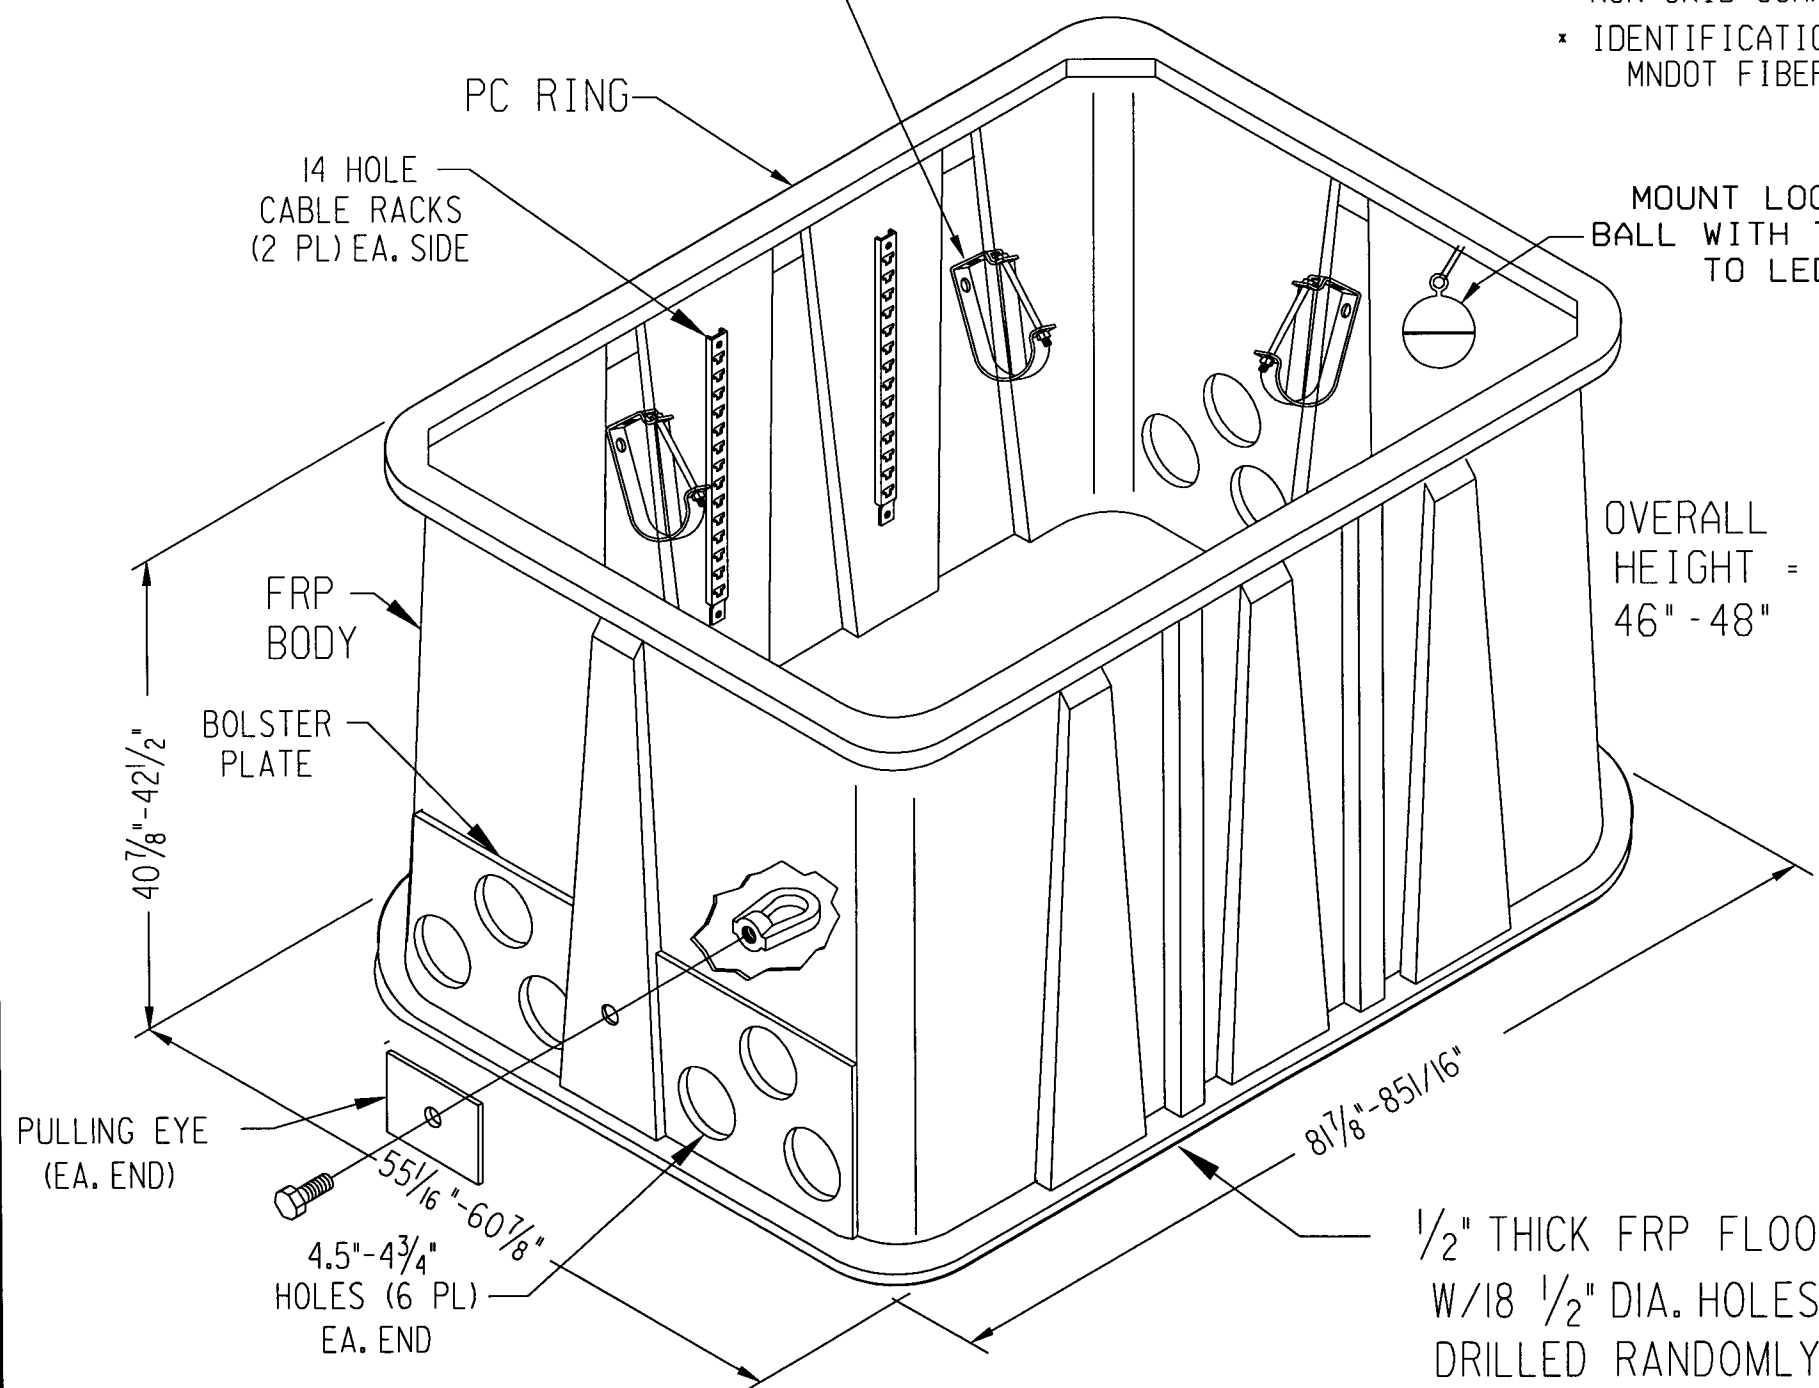

FRP VAULT FEATURES

- \* FIBERGLASS REINFORCED POLYMER  
 (FRP) CONSTRUCTION
- \* POLYMER CONCRETE RING

DRAWING NOT TO SCALE

\* ALL BOLTS STAINLESS STEEL


FIBER OPTIC SPLICE VAULT 2-16-06

REV. NO.	DATE: / /
REV. NO.	DATE: / /


CERTIFIED BY *Leonard E. Pahl* LIC. NO. 41525 DEC 30 2005  
 LICENSED PROFESSIONAL ENGINEER

STATE PROJ. NO. 6284-137 (TH 35W) SHEET NO. TM8 OF TM26 SHEETS



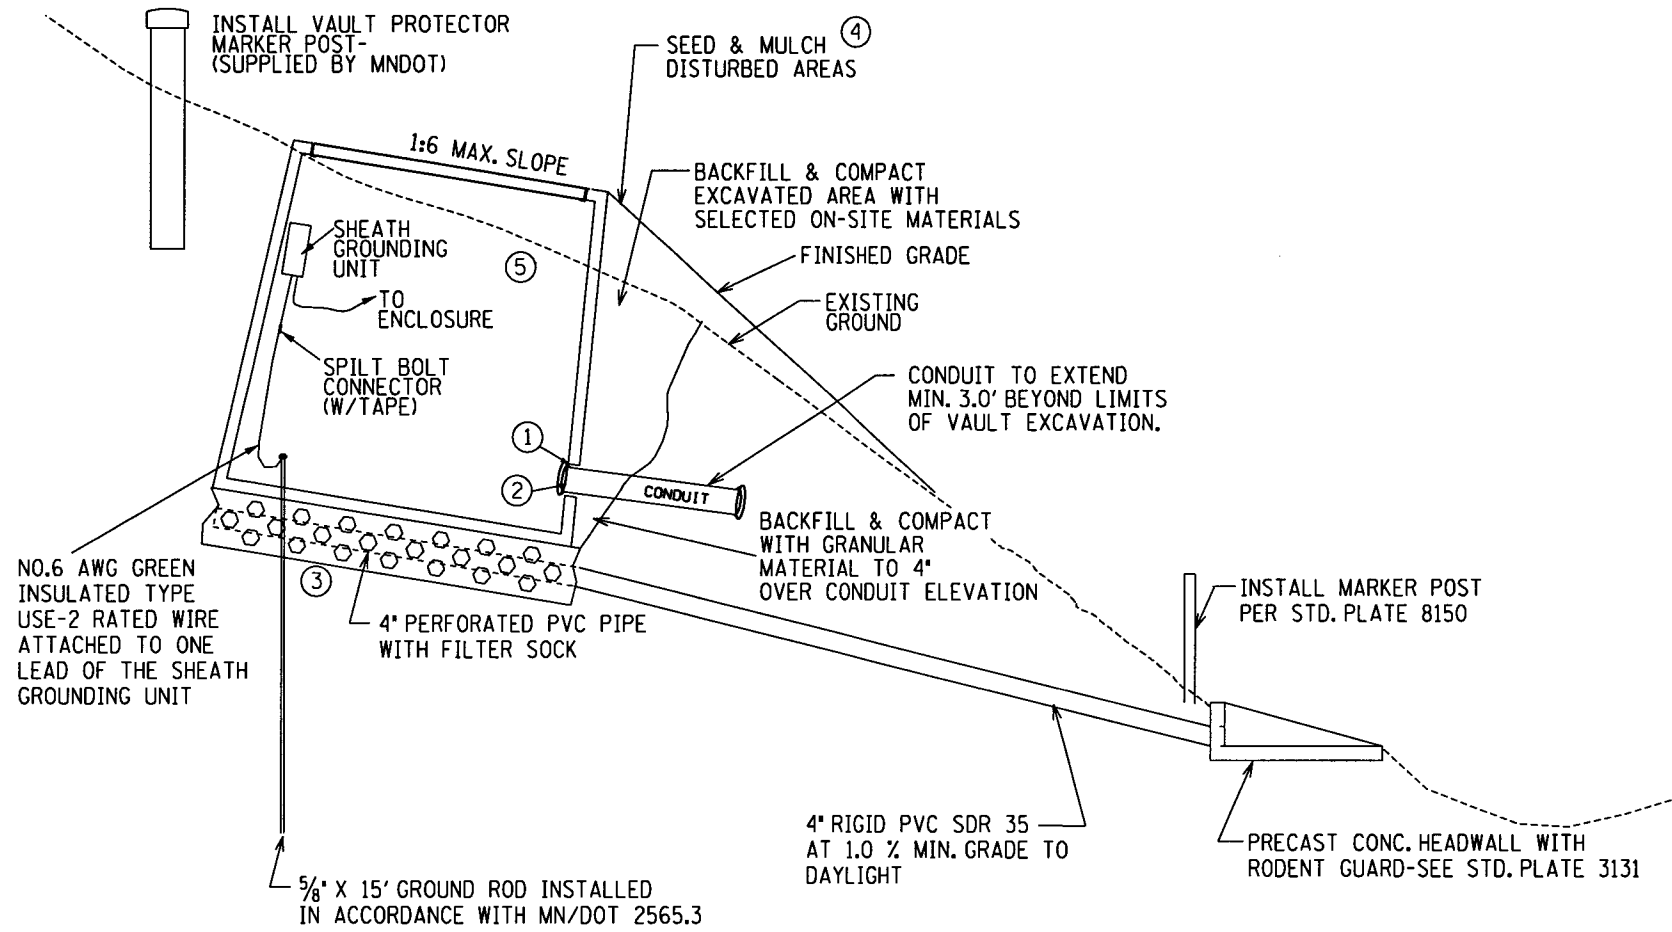


VAULT INSTALLATION & DRAINAGE SYSTEM (SLOPED AREAS)

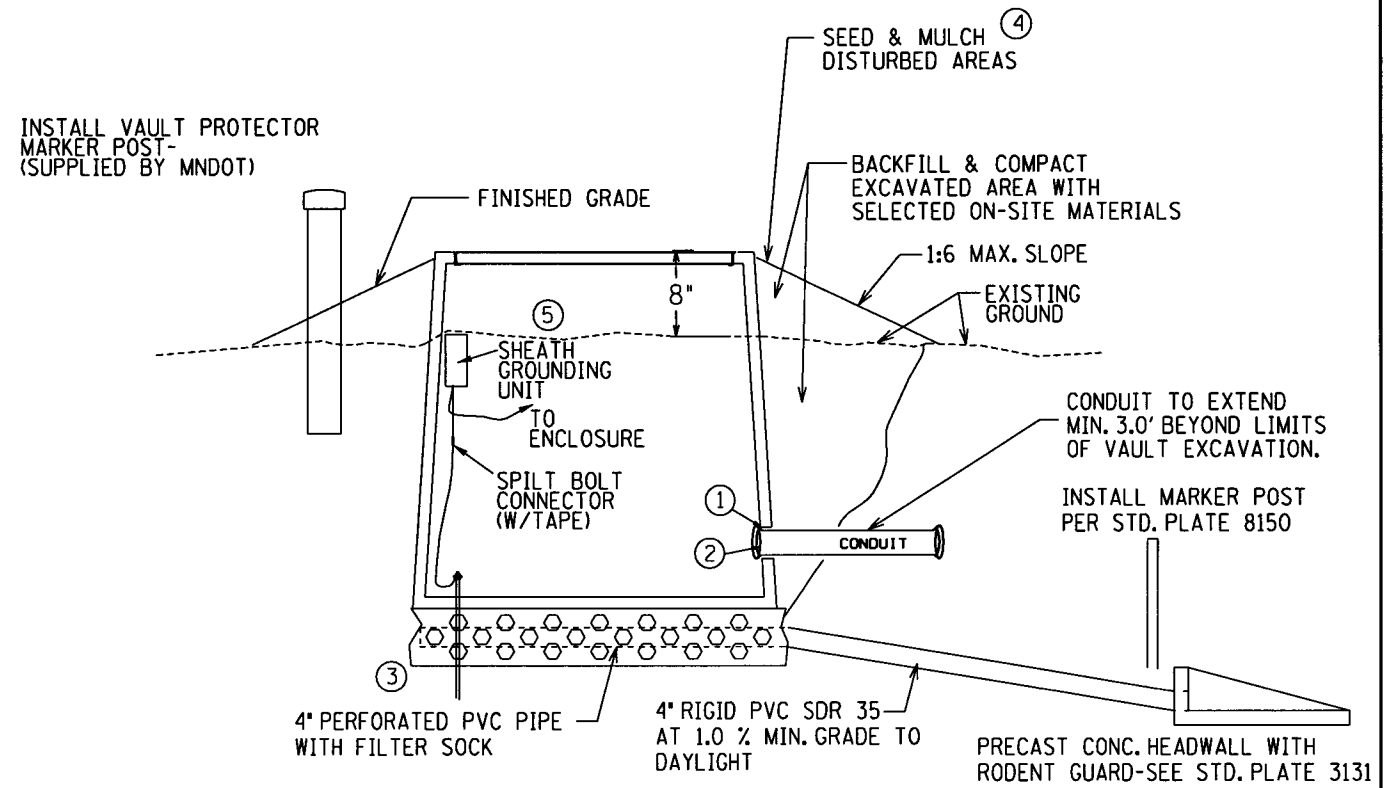

VAULT INSTALLATION & DRAINAGE SYSTEM (LEVEL GROUND AREAS)

COVER OPENING IN VAULT PC SLAB

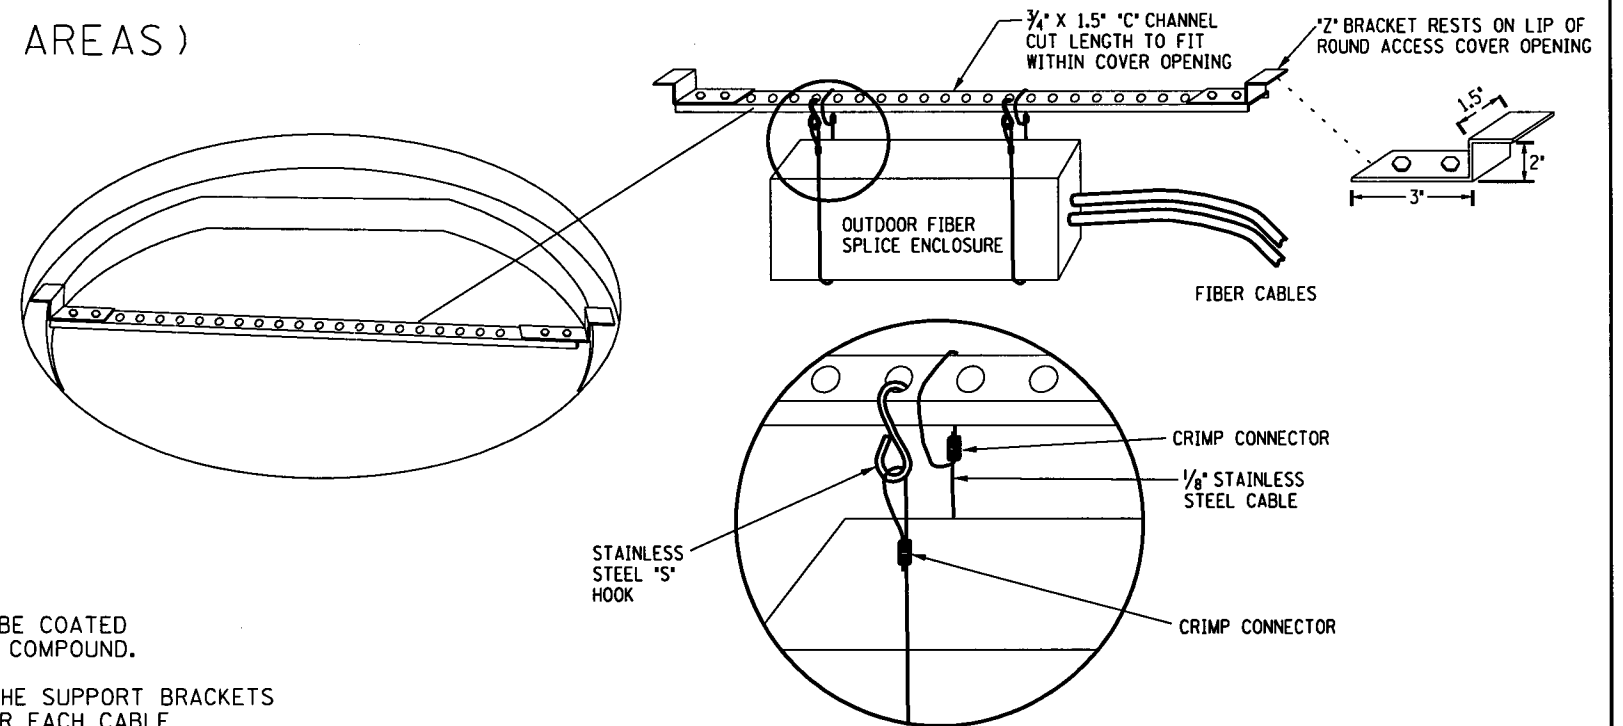

OUTDOOR FIBER SPLICE ENCLOSURE HANGER BRACKETING  
 SPLICE ENCLOSURE HANGER DETAIL

SPECIFIC NOTES

- ① OPENINGS FOR CONDUIT SHALL BE SEALED WITH MATERIAL COMPATIBLE SEALANT.
- ② PLUG CONDUIT OPENING WITH A DRAINABLE COMPOUND
- ③ INSTALL 1.0' COARSE FILTER AGGREGATE UNDER BASE COMPLYING WITH MN/DOT 3149.2H. INSTALL 4" PERFORATED PVC PIPE WITH FILTER SOCK TO PROVIDE DRAINAGE.
- ④ RESTORE DISTURBED AREAS WITH SEED MIXTURE 60B AND TYPE I MULCH PER MNDOT 2575.3
- ⑤ STRIP TOPSOIL FROM VAULT AND SLOPE AREAS PRIOR TO VAULT INSTALLATION

GENERAL NOTES

1. GROUND CONNECTIONS SHALL BE COATED WITH OXIDATION PROHIBITING COMPOUND.
2. CABLE SHALL ENTER BELOW THE SUPPORT BRACKETS WITH 50' OF EXTRA CABLE FOR EACH CABLE COILED AROUND INSIDE OF SUPPORT BRACKETS. CABLES SHALL BE CUT TO THE SAME LENGTH
3. ALL HARDWARE SHALL BE STAINLESS STEEL WITH EXCEPTION OF THE "C" CHANNEL MOUNTING BAR.
4. THE FRAME AND LID OF THE VAULT SHALL BE IN ACCORDANCE WITH AASHTO LOAD RATING H-10

FIBER OPTIC SPLICE VAULT INSTALLATION


2-16-06

REV. NO.	DATE: / /
REV. NO.	DATE: / /

CERTIFIED BY *Leonard E. Pakk* LIC. NO. 41525 DEC 30 2005  
 LICENSED PROFESSIONAL ENGINEER

STATE PROJ. NO. 6284-137 (TH 35W) SHEET NO. TM9 OF TM26 SHEETS

CUT & REMOVE DRAIN WIRE

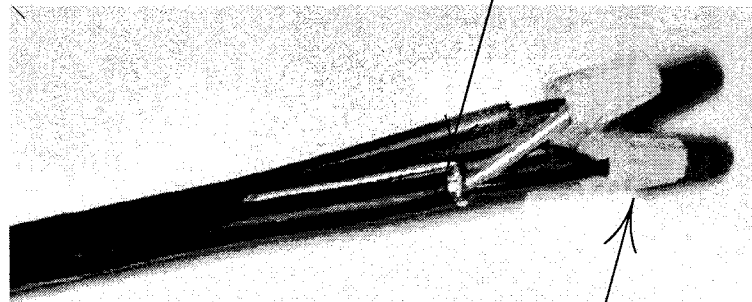

SOLDERED BUTT SPLICE IN WIRE NUT


TAPE WIRE TOGETHER BEFORE SPLICE



PLACE IN ENCAPSULATOR




PLACE WIRE NUT IN ONE END TO BLOCK OPENING

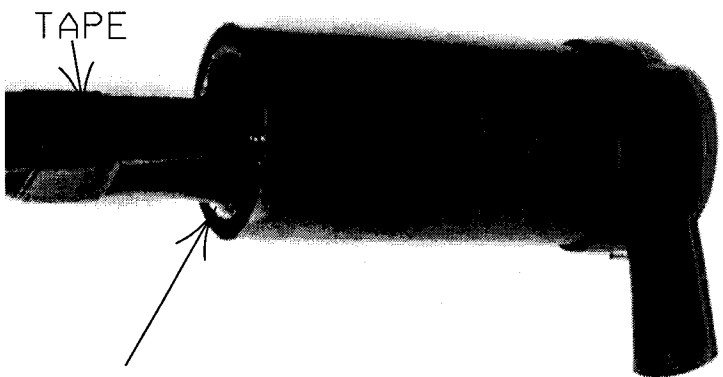


FILL ENCAPSULATOR COMPLETELY-ALLOW FINISHED SPLICE TO CURE SO EPOXY DOES NOT RUN OUT

LOOP DETECTOR SPLICE FOR SAWCUT AND PREFORMED LOOPS

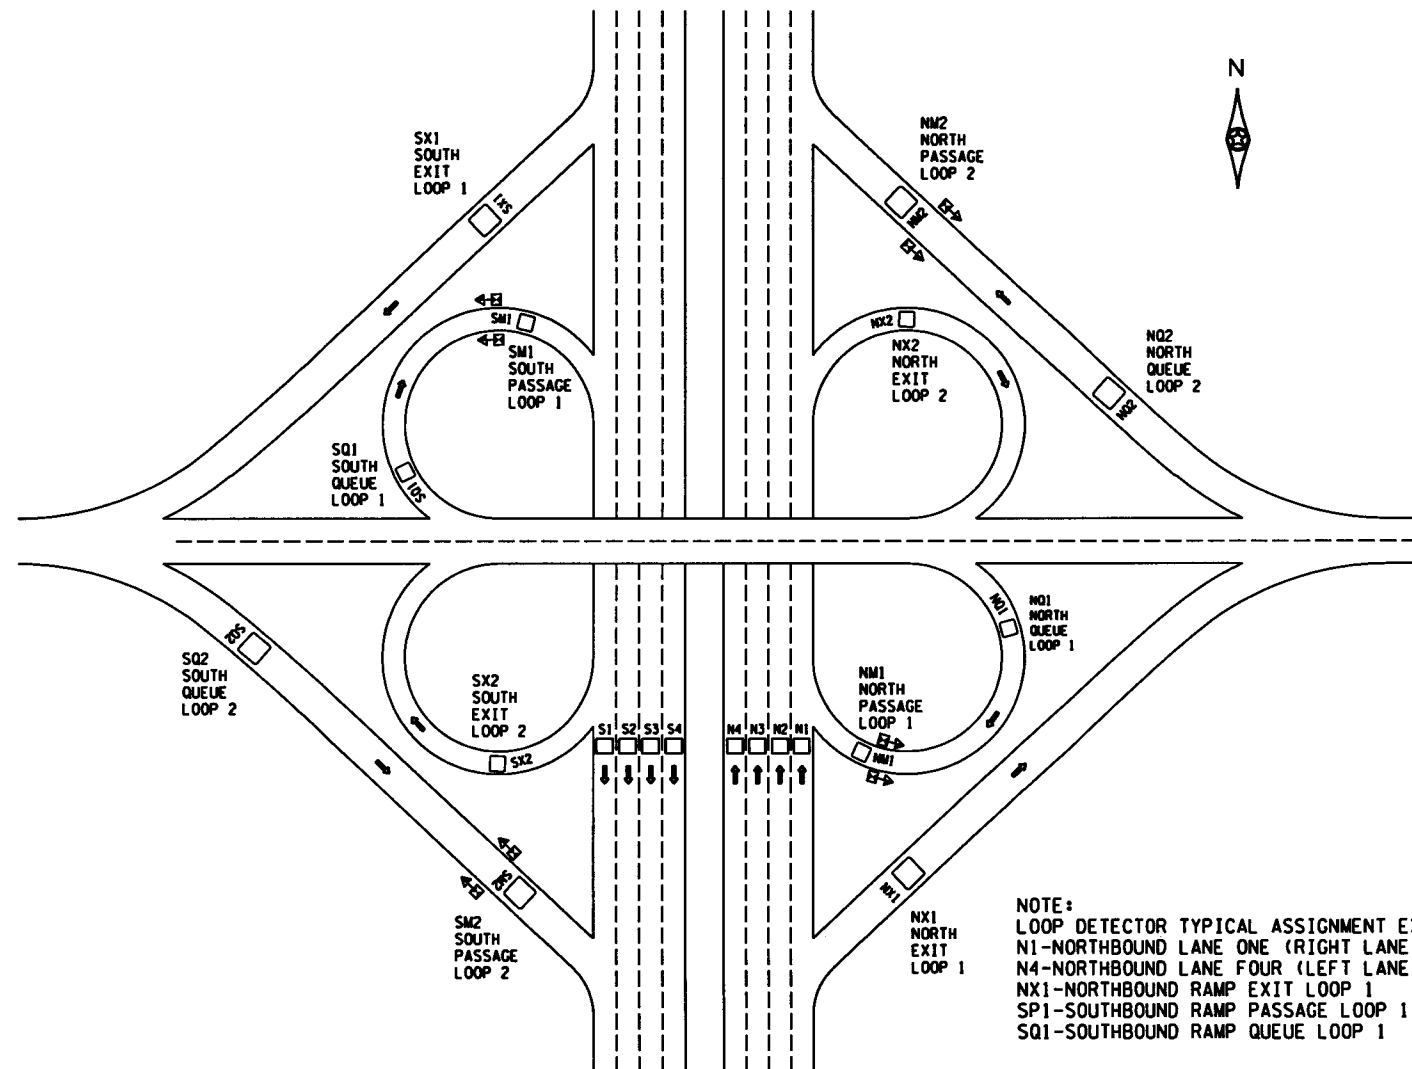

NOTE:  
 LOOP DETECTOR TYPICAL ASSIGNMENT EXAMPLES  
 N1-NORTHBOUND LANE ONE (RIGHT LANE) POSITION  
 N4-NORTHBOUND LANE FOUR (LEFT LANE) POSITION  
 NX1-NORTHBOUND RAMP EXIT LOOP 1  
 SP1-SOUTHBOUND RAMP PASSAGE LOOP 1  
 SQ1-SOUTHBOUND RAMP QUEUE LOOP 1

LOOP DETECTOR FUNCTION DESIGNATIONS



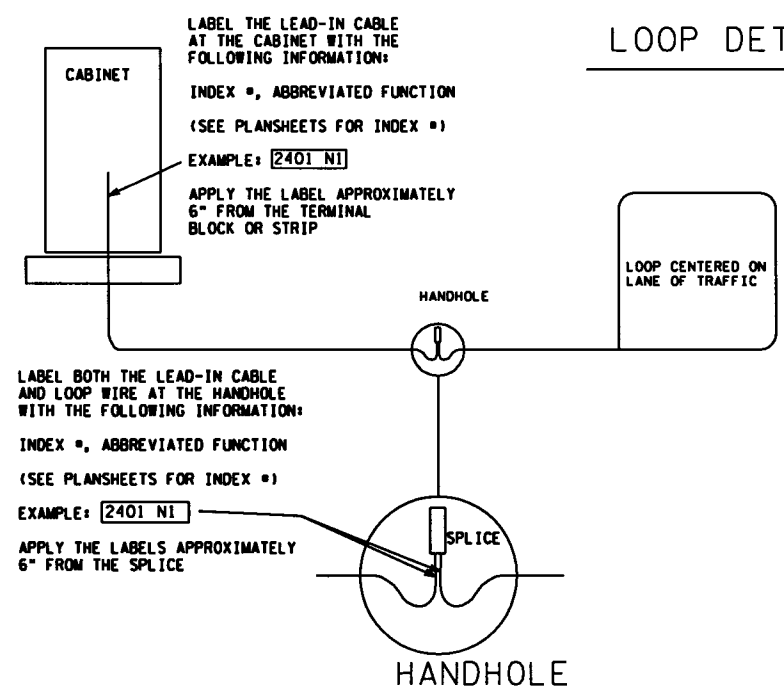


LOOP DETECTOR CABLE LABELING



REV. NO.	DATE: / /
REV. NO.	DATE: / /

CERTIFIED BY *Leonard E. Pahl* LIC. NO. 41525 DEC 30 2005  
 LICENSED PROFESSIONAL ENGINEER

STATE PROJ. NO. 6284-137 (TH 35W) SHEET NO. TM10 OF TM26 SHEETS

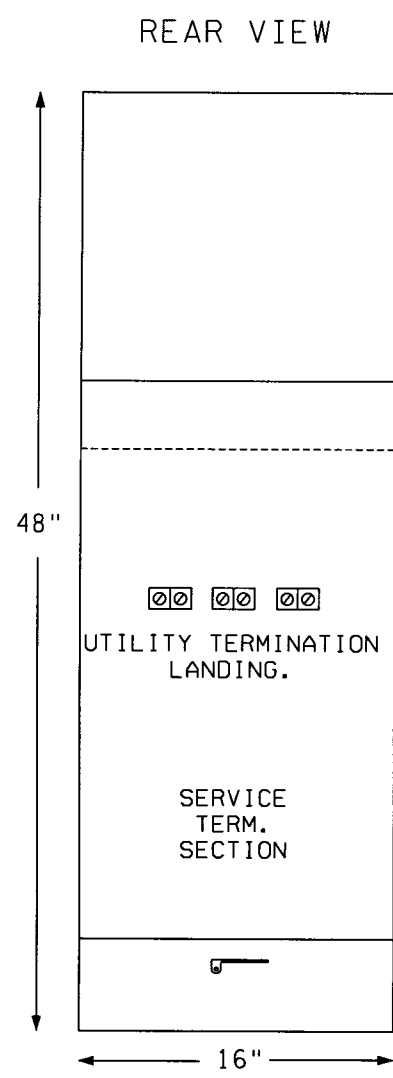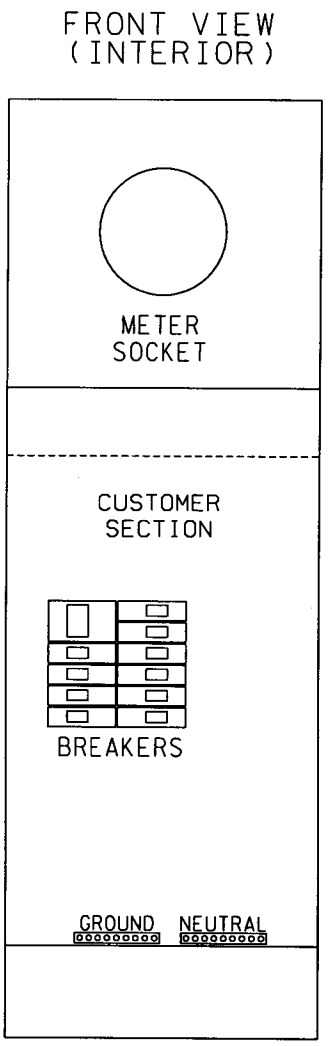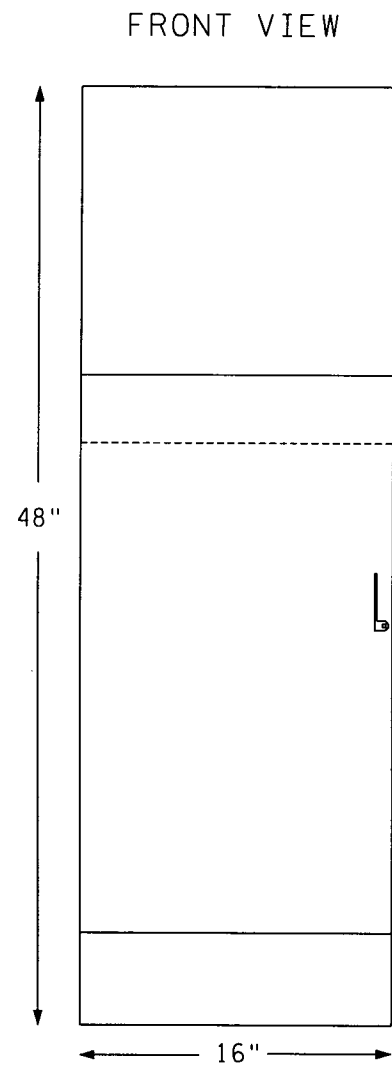

SIDE VIEW

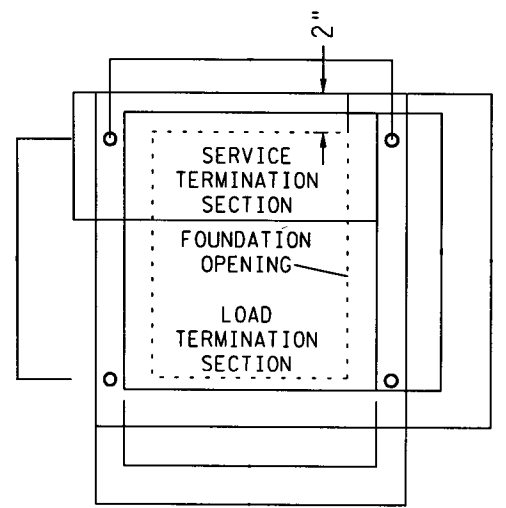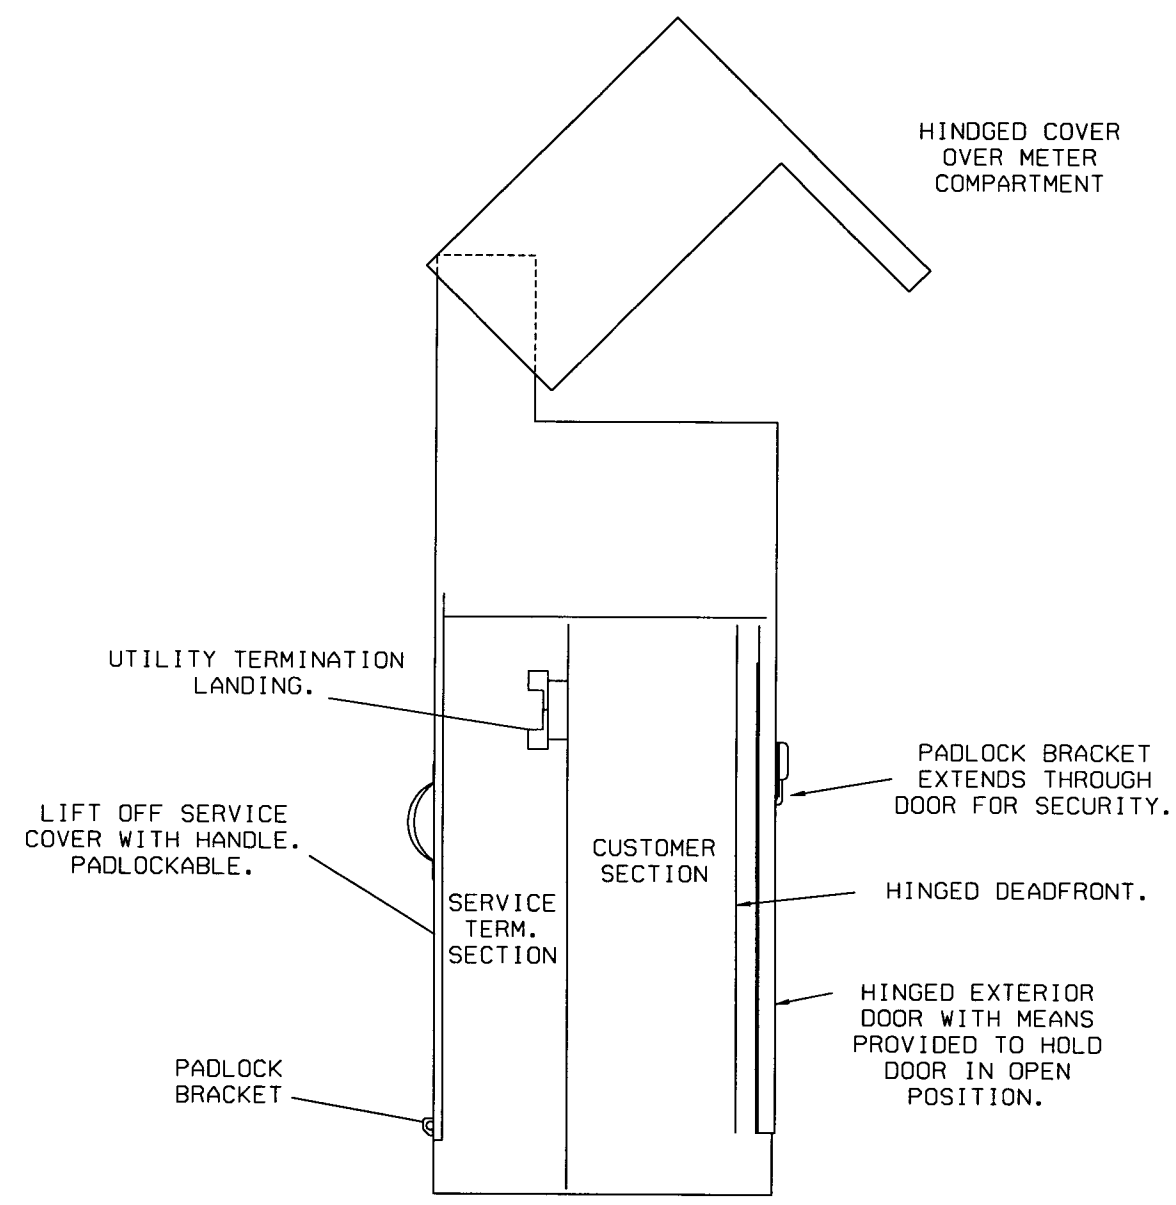

CABINET CONSTRUCTION:

- NEMA3R
- 1/8" ALUMINUM 5052-H32
- ANODIZED 1 HOUR CLEAR
- NEOPRENE GASKETED DOORS
- NON-CORRODING HARDWARE
- ETL LISTED IN ACCORDANCE W/UL508A

STANDARD TMS SERVICE CABINET SHALL COME EQUIPPED WITH 60A MAIN BREAKER, 1-30A CB & 1-20A CB WITH OPENINGS FOR 6 CIRCUITS TOTAL, UNLESS MODIFIED AT INDIVIDUAL LOCATIONS AS NOTED IN THE PLANS.

TMS SERVICE CABINET 2-76-06

REV. NO.	DATE: / /
REV. NO.	DATE: / /

CERTIFIED BY *Leonard E. Pahl* LIC.NO. 41525 DEC 30 2005  
 LICENSED PROFESSIONAL ENGINEER

STATE PROJ. NO. 6284-137 (TH 35W) SHEET NO. TM11 OF TM26 SHEETS

**CAUTION**

**BURIED  
FIBER OPTIC  
CABLE**  
BEFORE DIGGING  
CALL  
GOPHER STATE ONE CALL  
**(651)454-0002**



8" X 12" .75"R.

**CAUTION**  
BURIED  
FIBER OPTIC  
CABLE  
BEFORE DIGGING  
CALL  
GOPHER STATE ONE CALL  
**(651)454-0002**

8" X 12" .75"R.

**CAUTION**  
BURIED  
FIBER OPTIC  
CABLE  
BEFORE DIGGING  
CALL  
GOPHER STATE ONE CALL  
**(651)454-0002**

8" X 12" .75"R.

**CAUTION**  
BURIED  
FIBER OPTIC  
CABLE  
BEFORE DIGGING  
CALL  
GOPHER STATE ONE CALL  
**(651)454-0002**

8" X 12" .75"R.

**CAUTION**  
BURIED  
FIBER OPTIC  
CABLE  
BEFORE DIGGING  
CALL  
GOPHER STATE ONE CALL  
**(651)454-0002**


8" X 12" .75"R.

**CAUTION**  
BURIED  
FIBER OPTIC  
CABLE  
BEFORE DIGGING  
CALL  
GOPHER STATE ONE CALL  
**(651)454-0002**

8" X 12" .75"R.


**CAUTION**  
BURIED  
FIBER OPTIC  
CABLE  
BEFORE DIGGING  
CALL  
GOPHER STATE ONE CALL  
**(651)454-0002**

8" X 12" .75"R.

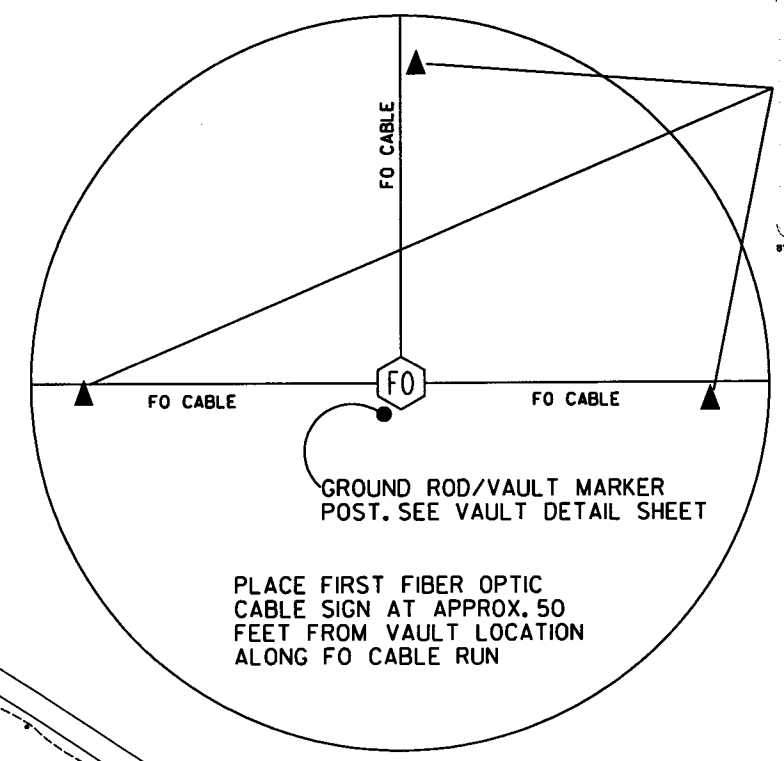

PLACE FIRST FIBER OPTIC  
CABLE SIGN AT APPROX. 50  
FEET FROM VAULT LOCATION  
ALONG FO CABLE RUN

TYPICAL SIGN DETAIL AT  
FIBER OPTIC SPLICE VAULT

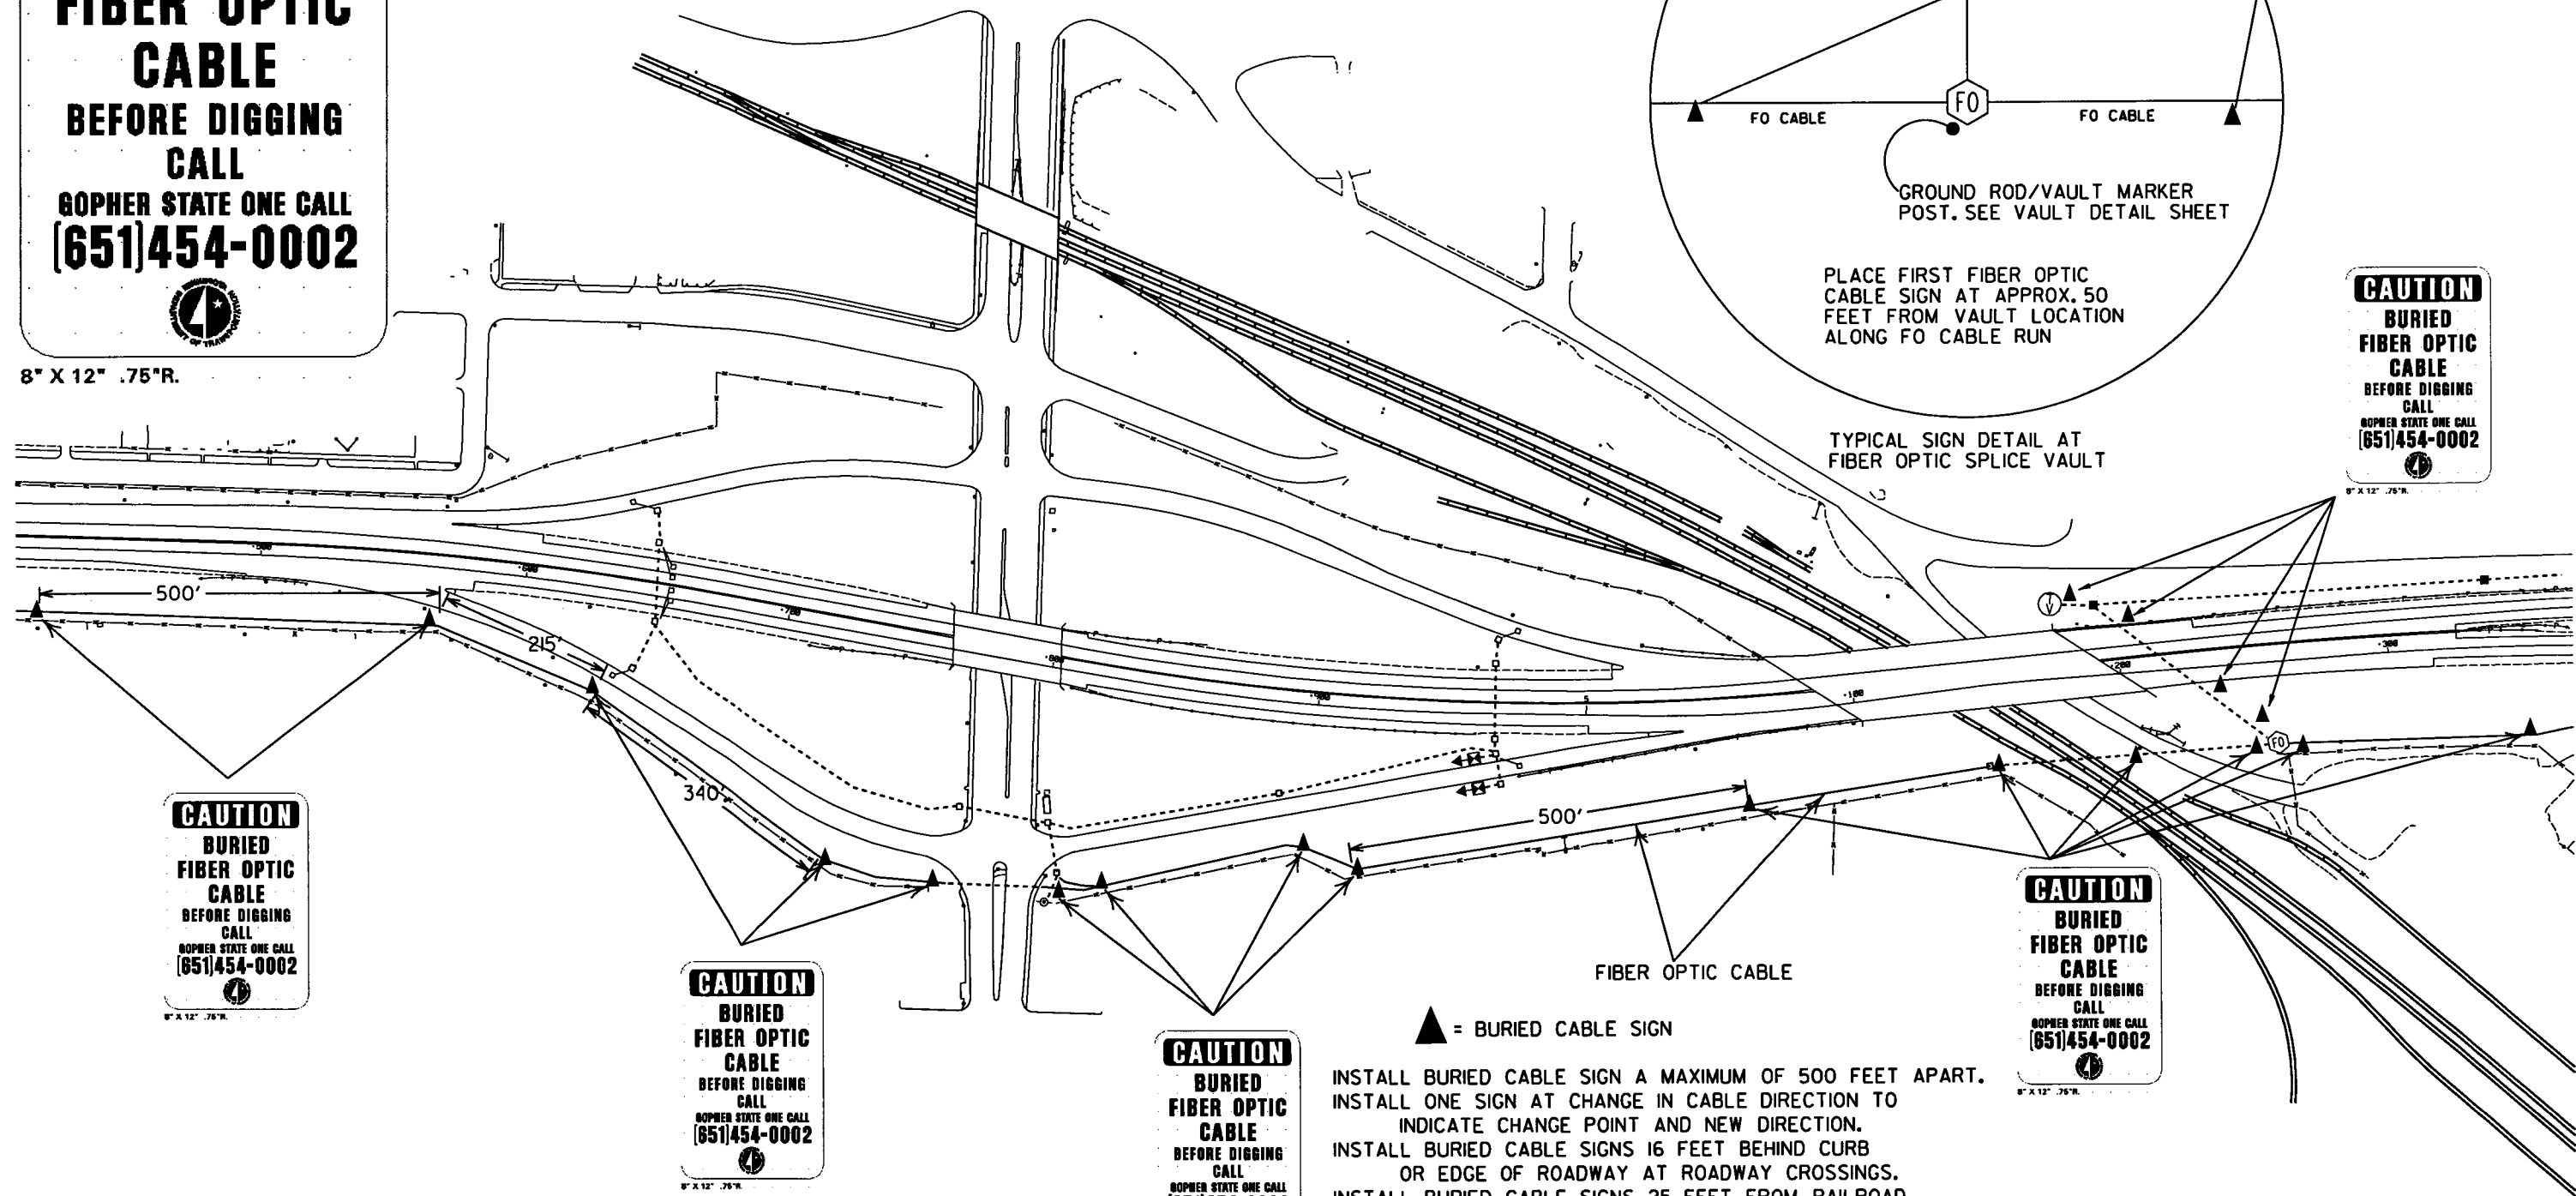

FIBER OPTIC CABLE

▲ = BURIED CABLE SIGN

- INSTALL BURIED CABLE SIGN A MAXIMUM OF 500 FEET APART.
- INSTALL ONE SIGN AT CHANGE IN CABLE DIRECTION TO INDICATE CHANGE POINT AND NEW DIRECTION.
- INSTALL BURIED CABLE SIGNS 16 FEET BEHIND CURB OR EDGE OF ROADWAY AT ROADWAY CROSSINGS.
- INSTALL BURIED CABLE SIGNS 25 FEET FROM RAILROAD OR AS DIRECTED IN CROSSING PERMIT.
- AT VAULT LOCATIONS MARKER POST IS PER VAULT DETAIL.
- INSTALL ADDITION BURIED CABLE SIGN IF UNABLE TO SEE FROM SIGN TO SIGN (THIS INCLUDES CHANGES IN ELEVATION).
- INSTALL BURIED CABLE SIGNS BETWEEN CABLE AND R/W FENCE, 3.0' FROM CABLE WITH SIGN PANEL PARALLEL TO BURIED CABLE

BURIED CABLE SIGN PLACEMENT TYPICAL 2-16-06

REV. NO.	DATE: / /
REV. NO.	DATE: / /


CERTIFIED BY *Leonard C. Pahl* LIC.NO. 41525 DEC 30 2005  
LICENSED PROFESSIONAL ENGINEER

STATE PROJ. NO. 6284-137 (TH 35W) SHEET NO. TM12 OF TM26 SHEETS

SEE SHELTER SHEET 12

SHEET 35W-22

REV. NO.	DATE: / /
REV. NO.	DATE: / /

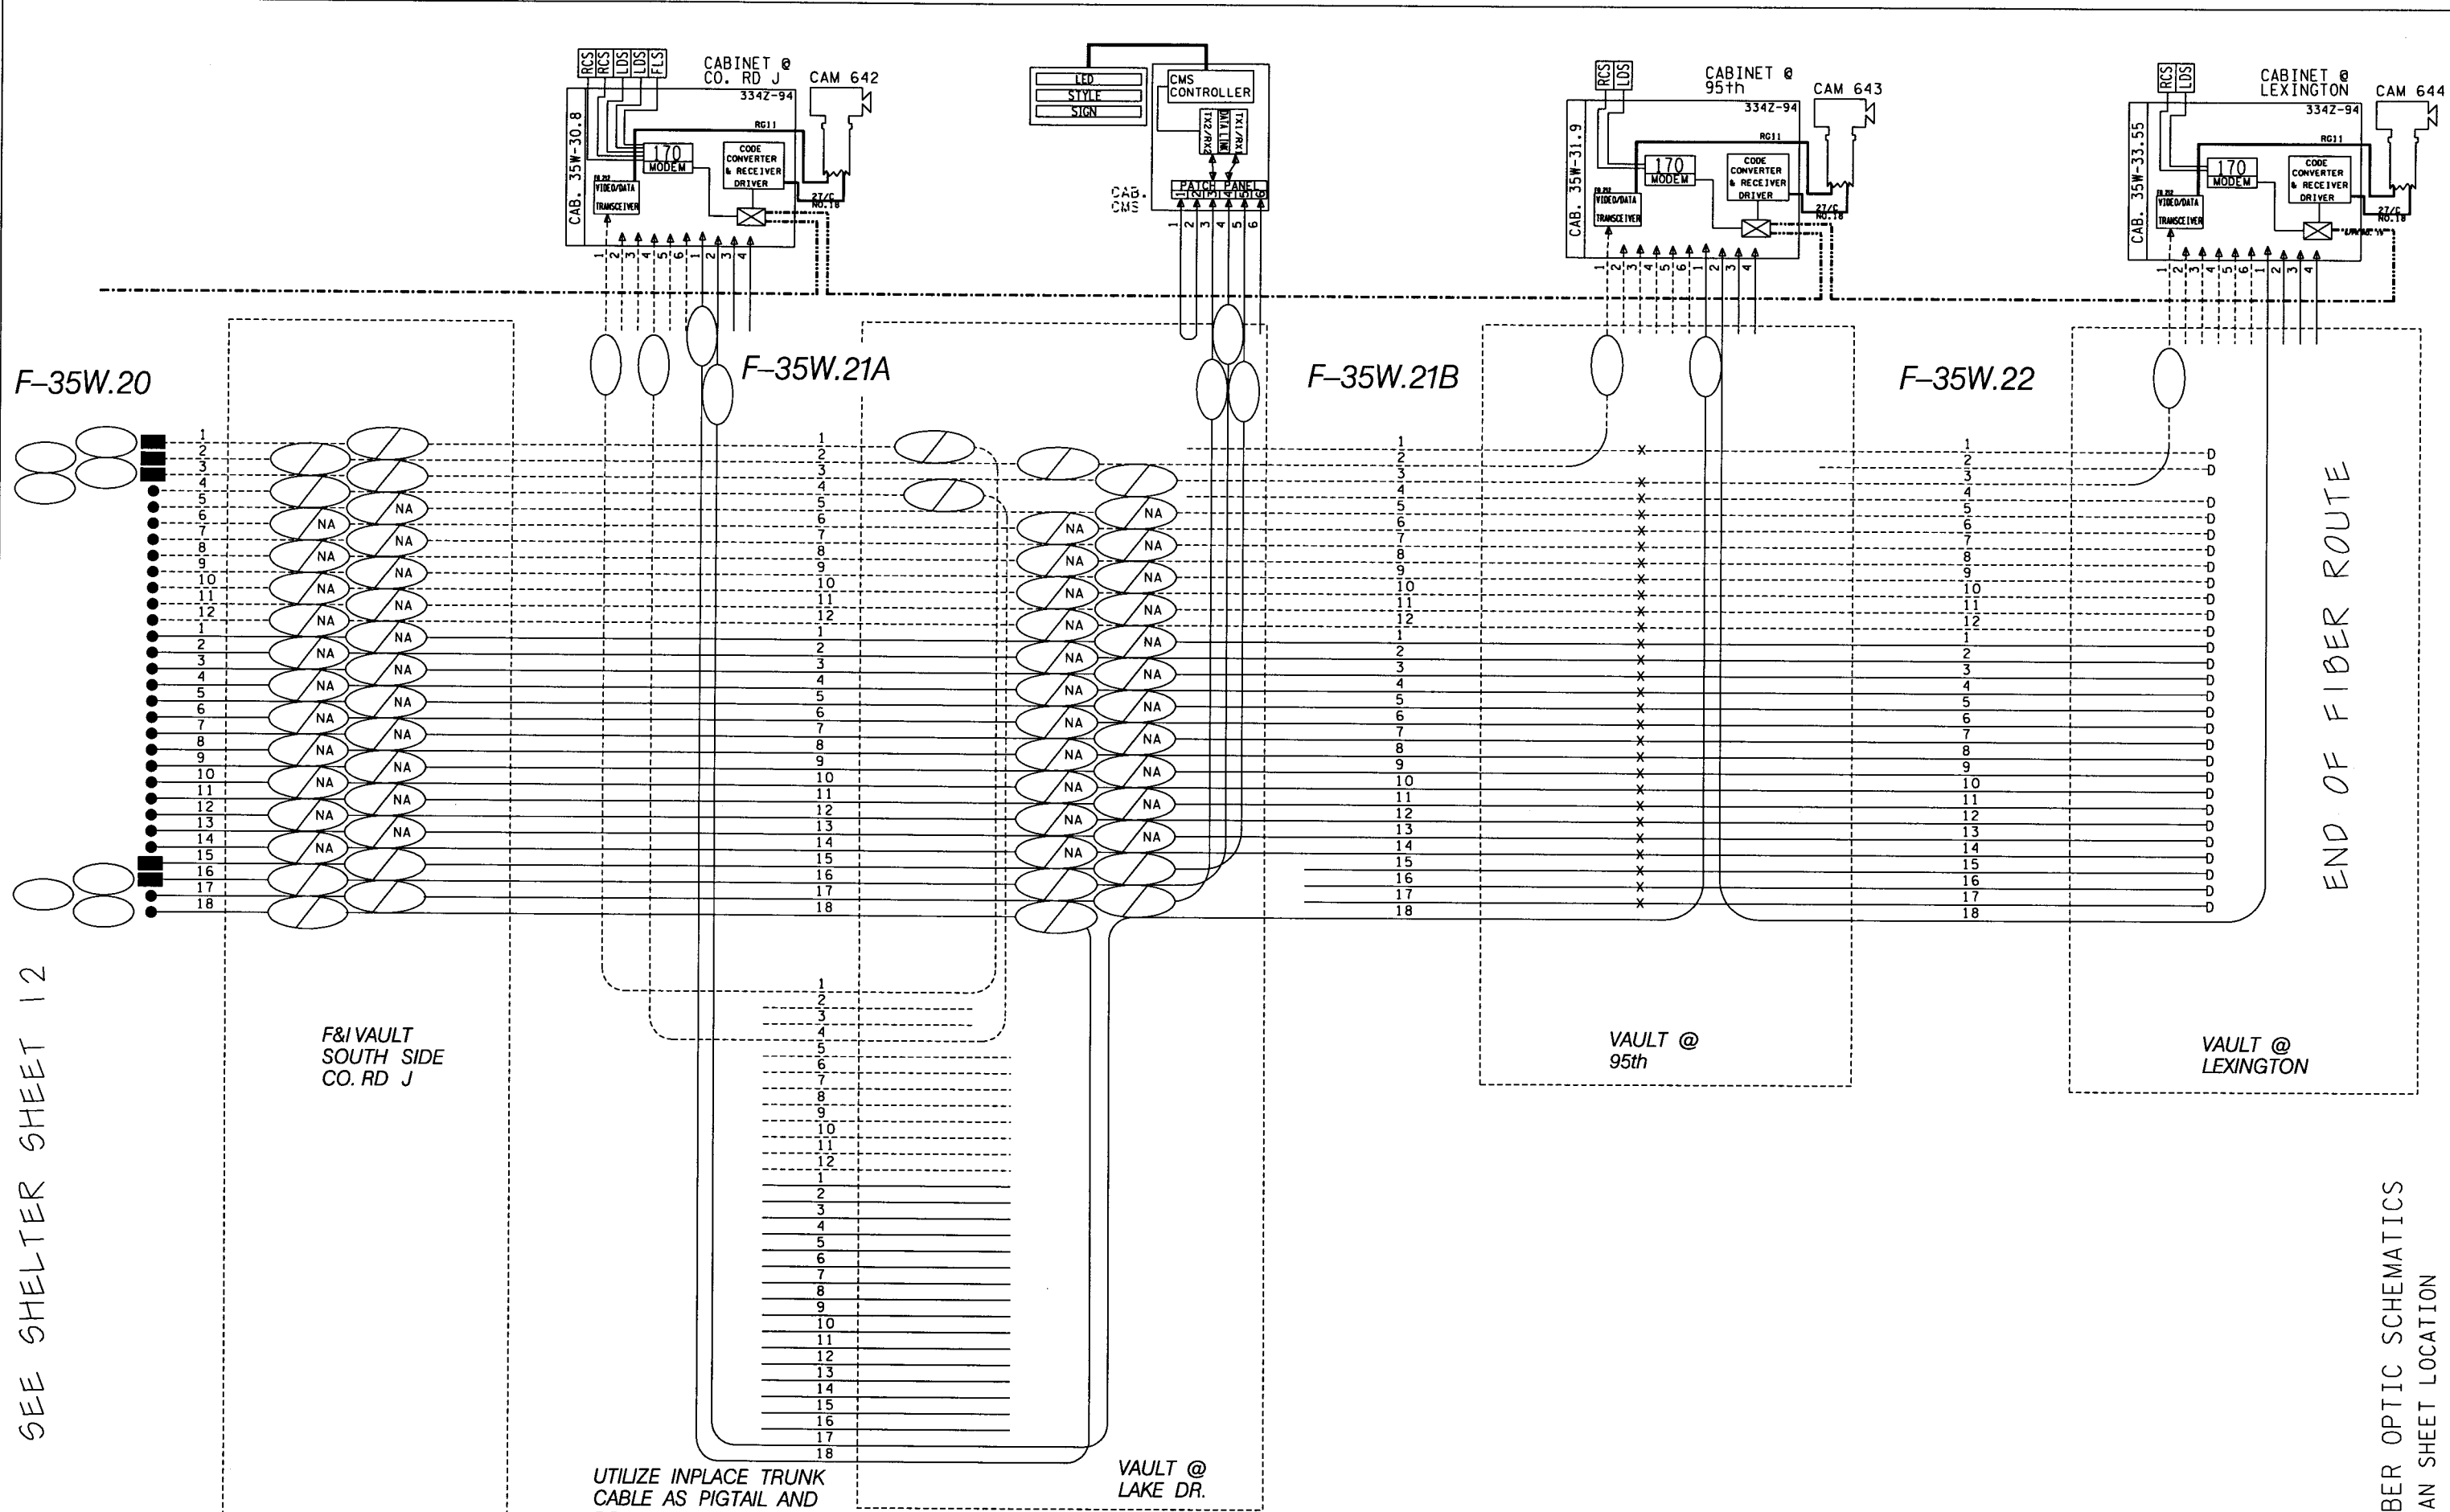

CERTIFIED BY *Leonard E. Palko* LIC. NO. 41525 DEC 30 2005

STATE PROJ. NO. 6284-137 (TH 35W) SHEET NO. TM13 OF TM26 SHEETS

2-16-06

FIBER OPTIC SCHEMATICS  
PLAN SHEET LOCATION

CC			
TABULATION OF SIGNING QUANTITIES			
SHEET NO.	ITEM	UNIT	SIGNING QUANTITIES
TM15	CONCRETE FOOTINGS (TYPE OH SPREAD)	CU. YD.	22
TM15	STRUCT. STEEL - POSTS FOR OH SIGNS (DESIGN B)	POUND	6148
TM15	STRUCT. STEEL - TRUSSES FOR OH SIGNS (DESIGN B)	POUND	8705 (P)
TM15	STRUCT. STEEL - WLKWAY. SUPPORTS FOR OH SIGNS (DESIGN B)	POUND	198 (P)
TM15	STRUCT. STEEL - WLKWAY. GRATING FOR OH SIGNS (DESIGN B)	POUND	360 (P)


I HEREBY CERTIFY THAT SHEETS TM14-TM26 OF THIS PLAN WERE PREPARED BY ME OR UNDER MY DIRECT SUPERVISION AND THAT I AM A DULY LICENSED PROFESSIONAL ENGINEER UNDER THE LAWS OF THE STATE OF MINNESOTA.

DATE 1/31/06 LIC. NO. 10502 ENGR. Michael B. Weiss  
MICHEAL B. WEISS

DESIGN SQUAD: RICK SUNSTROM

QUANTITIES

2-16-06

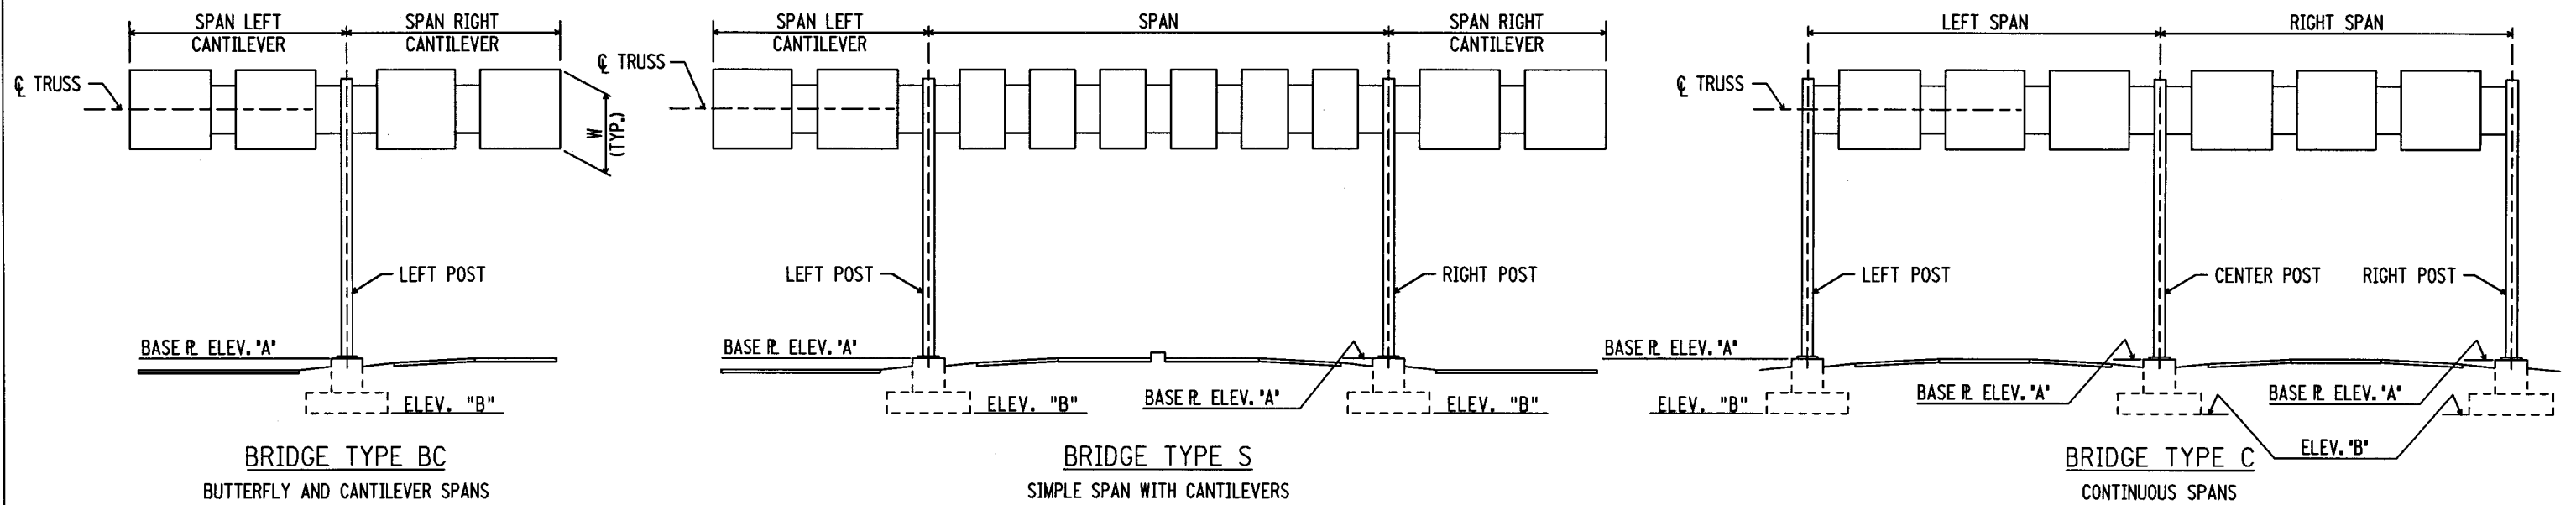

OVERHEAD SIGN STRUCTURE																
SIGN NO.	STATION	BRIDGE TYPE	TRUSS TYPE	SPAN LENGTHS				LOW STEEL ELEVATION SEE ST-1	LEFT POST			CENTER POST		RIGHT POST		
				LEFT CANT.	RIGHT CANT.	SPAN OR LEFT SPAN	RIGHT SPAN		ELEVATION (1)		TYPE	ELEVATION (1)		TYPE	ELEVATION (1)	
									A	B		A	B		A	B
OH 364-35W	480+00 SB	S	A			63'-6"		117.33	98.95	93.18	1			99.13	91.79	1E

TABULATION OF OVERHEAD SIGN STRUCTURE QUANTITIES (2)						
SIGN NO.			OH 364-35W			TOTALS
STRUCT. STEEL POSTS	LBS.		6148			6148
STRUCT. STEEL TRUSSES	LBS.		8705 (3)			8705
STRUCT. STEEL WALKWAY SUPPORTS	LBS.		198			198
STRUCT. STEEL WALKWAY GRATING	LBS.		360			360
STRUCT. STEEL PANEL MTG. POSTS	LBS.					
CONCRETE FOOTINGS (SPREAD)	CU. YD.		22.5			22.5

**SPECIFIC NOTES:**

- (1) Center line elevation = 100.00.
- (2) Based on tabulated elevations and dimensions. Revise if necessary using quantity tables on ST-2.
- (3) Includes mounting angles and stanchion.

**GENERAL NOTES:**

1. The subscript E on the post type denotes the post which has the hand hole and provisions for grounding, i.e. post type 3E.
2. Tabulated elevations and dimensions are approximate only. Fabrication dependent on these elevations and dimensions shall not be started until the Engineer has made final determination of them in the field.
3. Left and right designations are shown looking in direction of traffic flow. When two directions of traffic are spanned the designations are shown looking up stationing.
4. See sheets TM19-TM25 for details.
5. See sheet TM26 for cross section.

**OH SIGN DATA SHEET**

(DESIGN B)


2-16-06

CERTIFIED BY *Michael B. Wesad* LIC. NO. 10502  
LICENSED PROFESSIONAL ENGINEER

State Proj. No. 6284-137

Sheet No. TM15 of TM26 Sheets

BLAINE

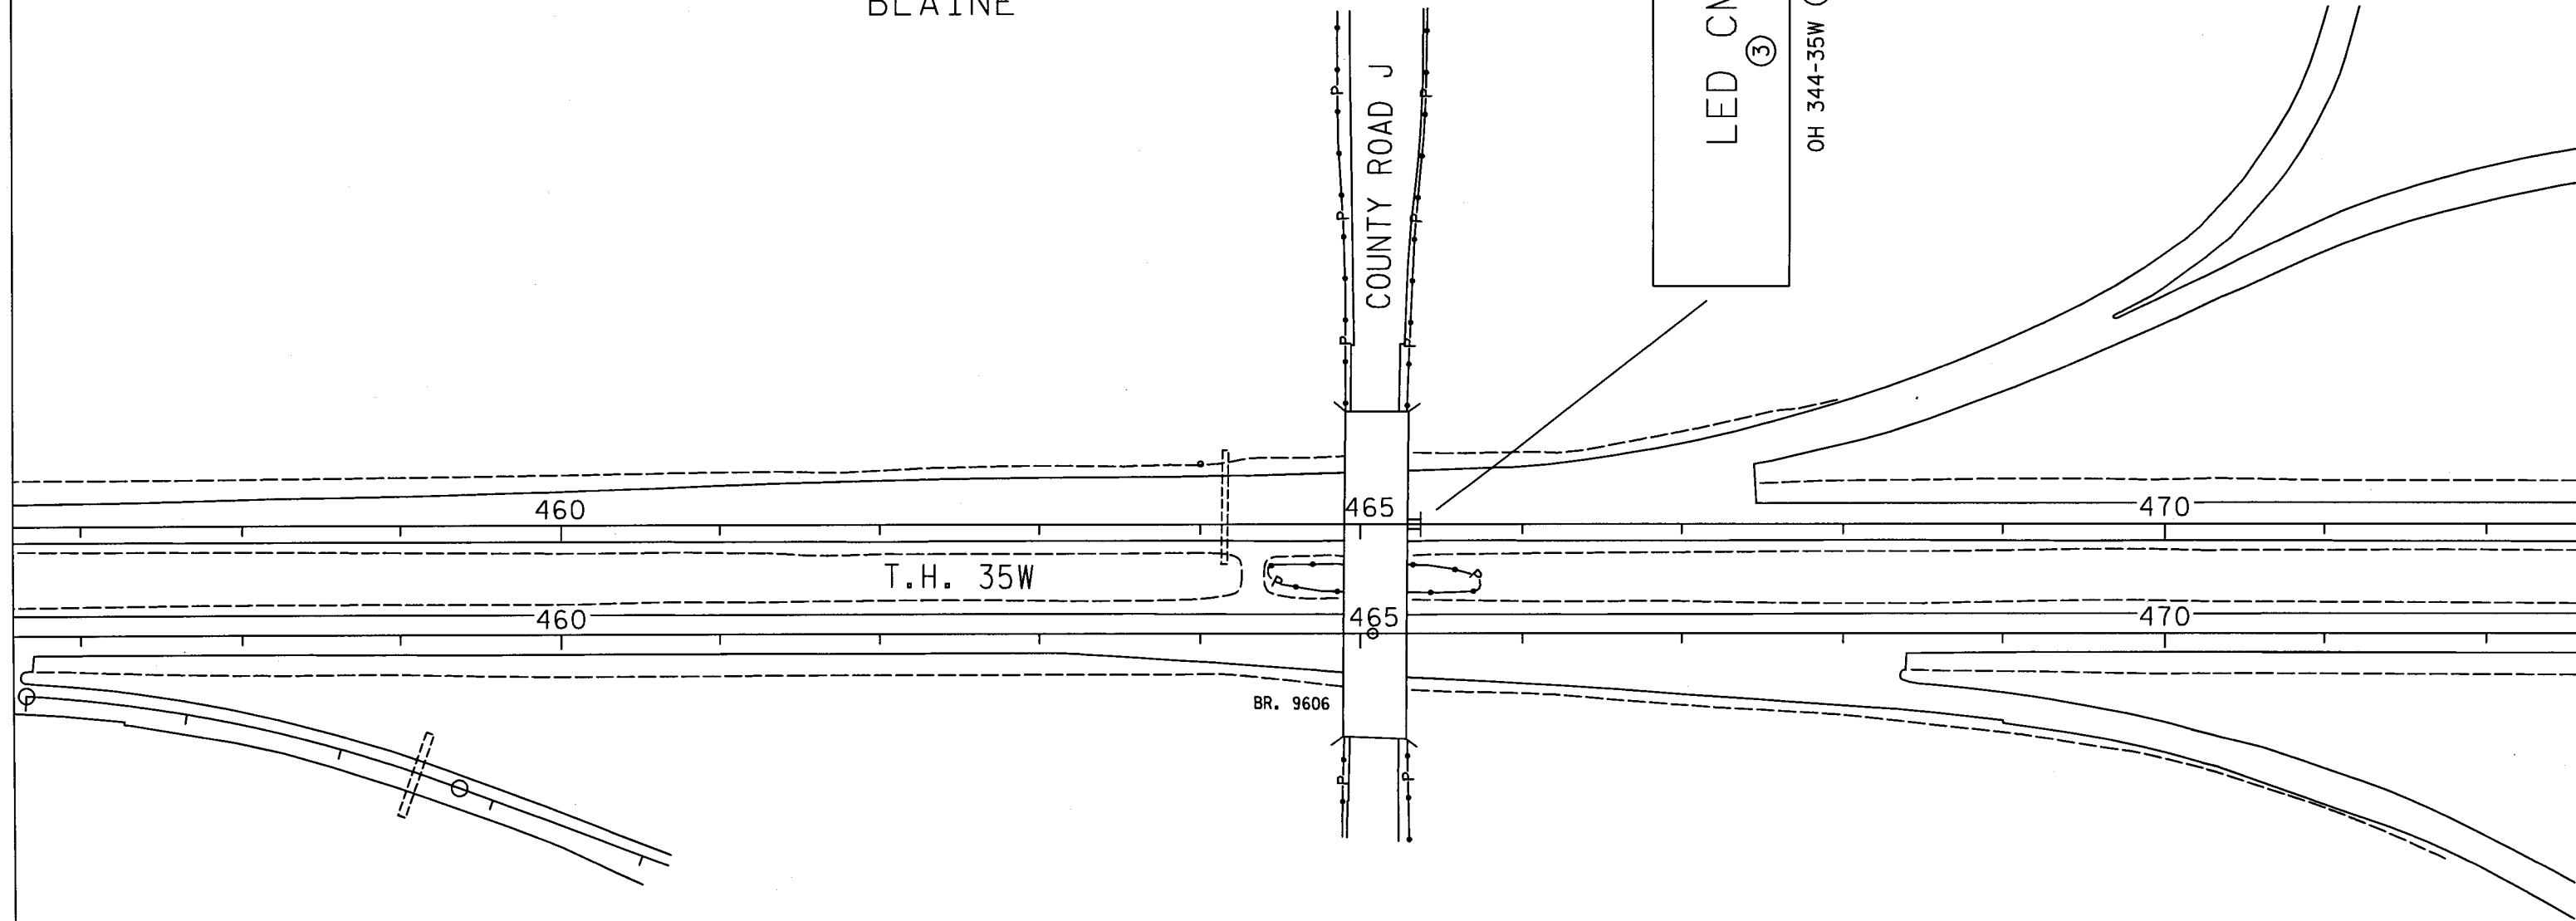

LED\_CMS<sup>③</sup>  
OH 344-35W<sup>②</sup>

NOTES:

- ② Inplace
- ③ See TMC portion of plan

ROADWAY LAYOUT  
T.H. 35W STA. 456+60 - 472+60

2-16-06

CERTIFIED BY *Michael B. Weis* LIC. NO. 10502  
LICENSED PROFESSIONAL ENGINEER

State Proj. No. 6284-137

Sheet No. TM16 of TM26 Sheets






BLAINE

LED CMS  
③

OH 364-35W ①

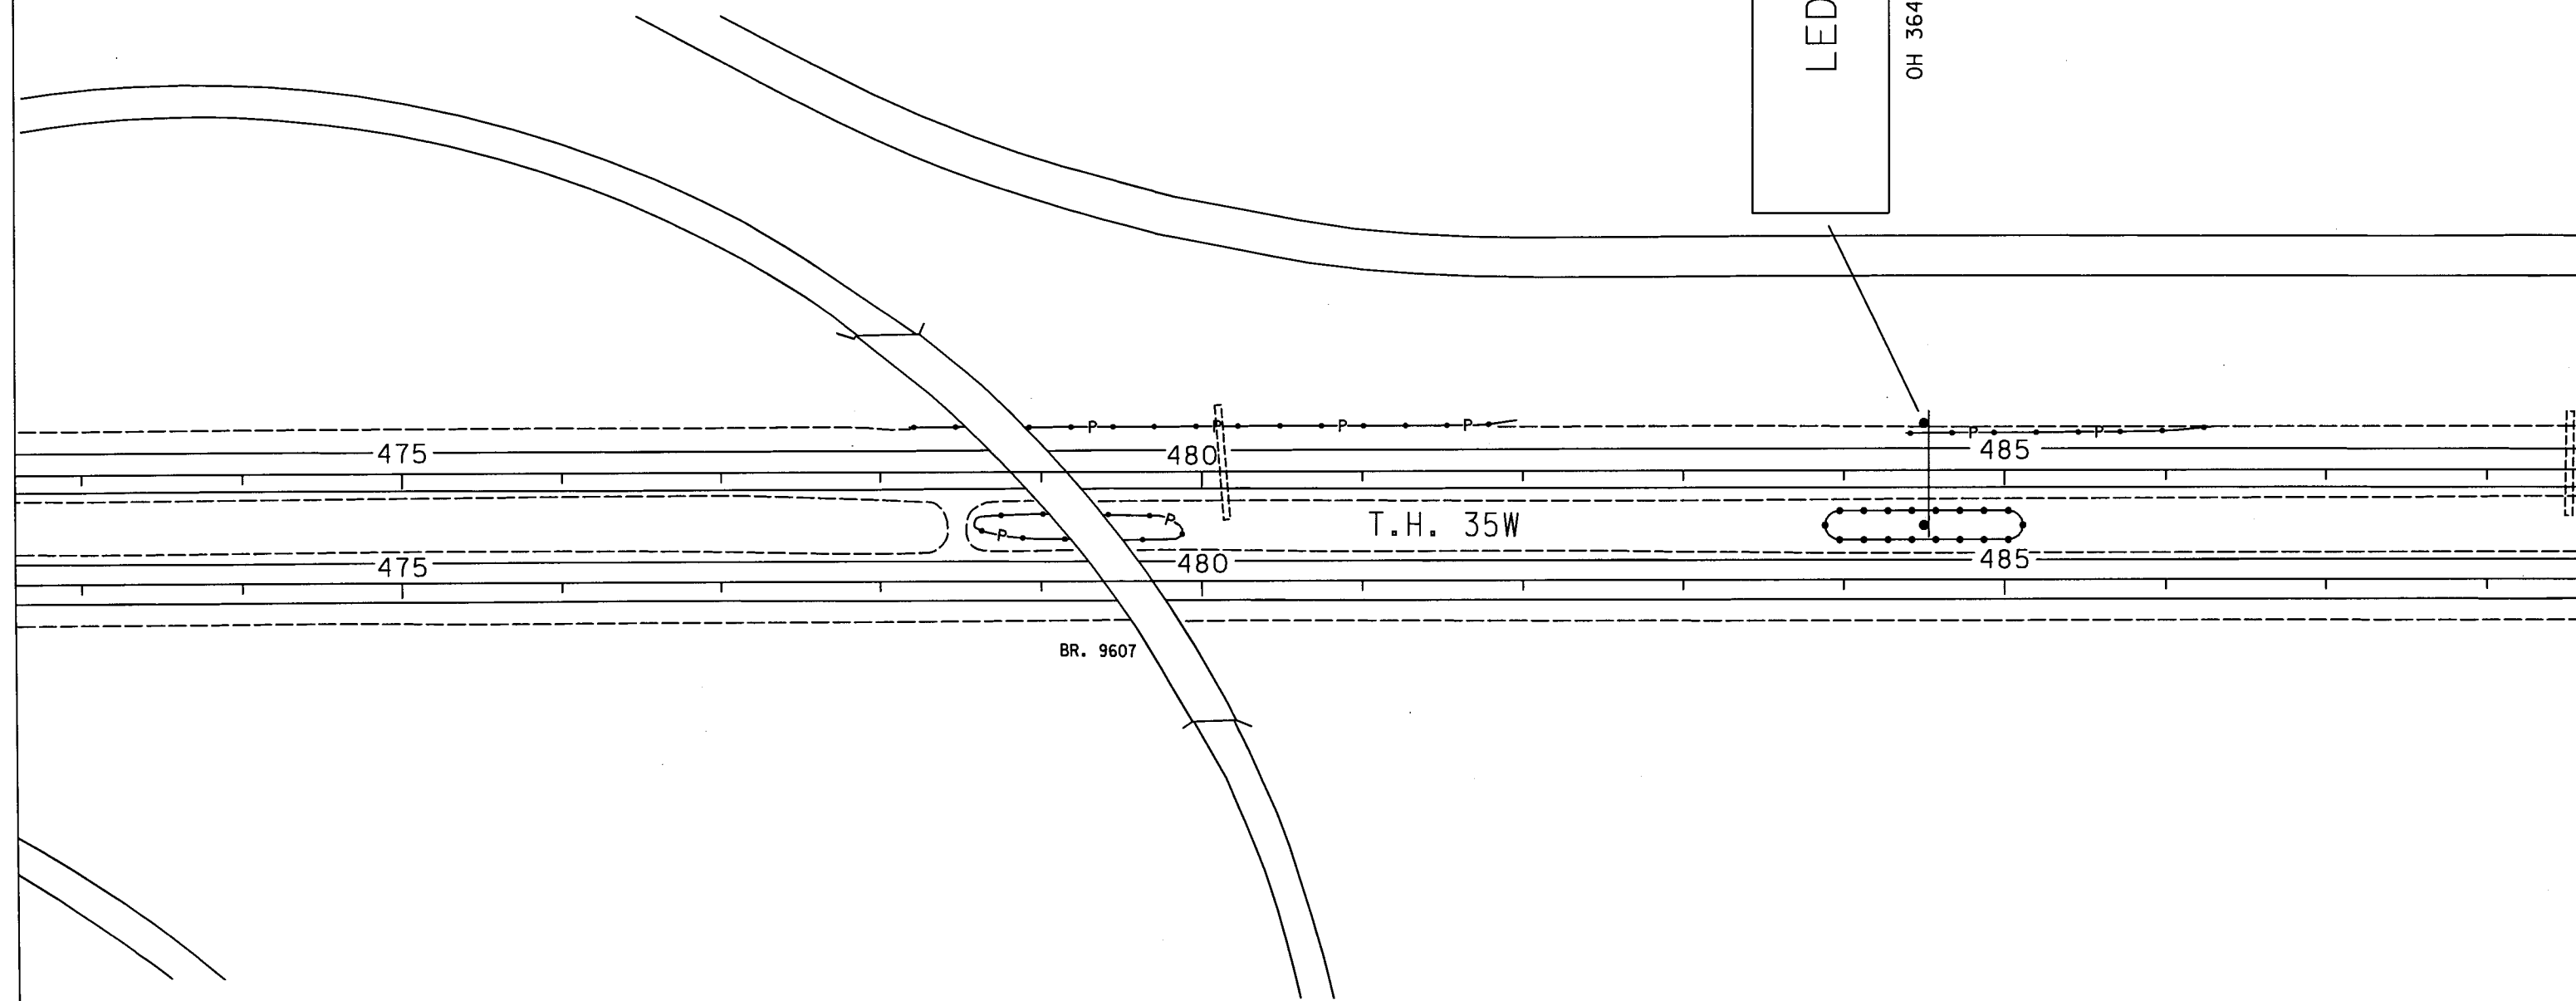

NOTES:

- ① F. & I.
- ③ See TMC portion of plan


ROADWAY LAYOUT  
T.H. 35W STA. 472+60 - 488+60

2-16-06

CERTIFIED BY *Michael B. Wesad* LIC. NO. 10502  
LICENSED PROFESSIONAL ENGINEER

State Proj. No. 6284-137


Sheet No. TM17 of TM26 Sheets

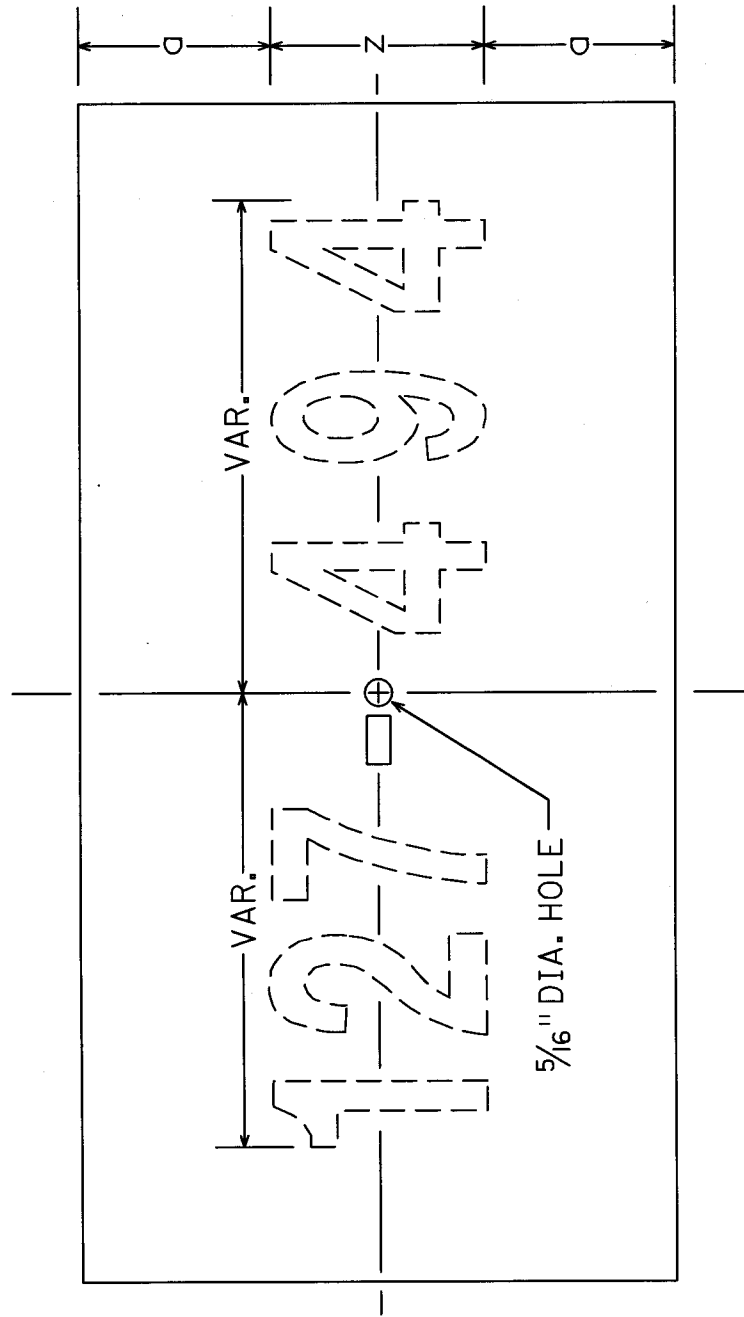

SIZE	12x6
DIMENSION	
RADIUS	
MARGIN	
BORDER	2
a	
b	
c	
d	
e	
f	
g	
h	
i	
j	
k	
l	
m	
n	
o	
p	
q	
r	
s	
t	
u	
v	
w	
x	
y	
z	
PUNCH CODE	2-C




NOTES: 1) ALL DIMENSIONS AND SIZES SHOWN ARE IN INCHES.  
 2) USE APPROPRIATE NUMERALS.  
 3) PLATE MATERIAL - (MN/DOT 3352.2A1b).  
 4) GREEN BACKGROUND - (MN/DOT 3352.2A2b).  
 5) WHITE NUMERALS OR LETTERS - (MN/DOT 3352.2A2b).

STATE OF MINNESOTA  
 DEPARTMENT OF TRANSPORTATION  
 STANDARD SIGN DRAWING  
 OH SIGN IDENTIFICATION  
 PLATE

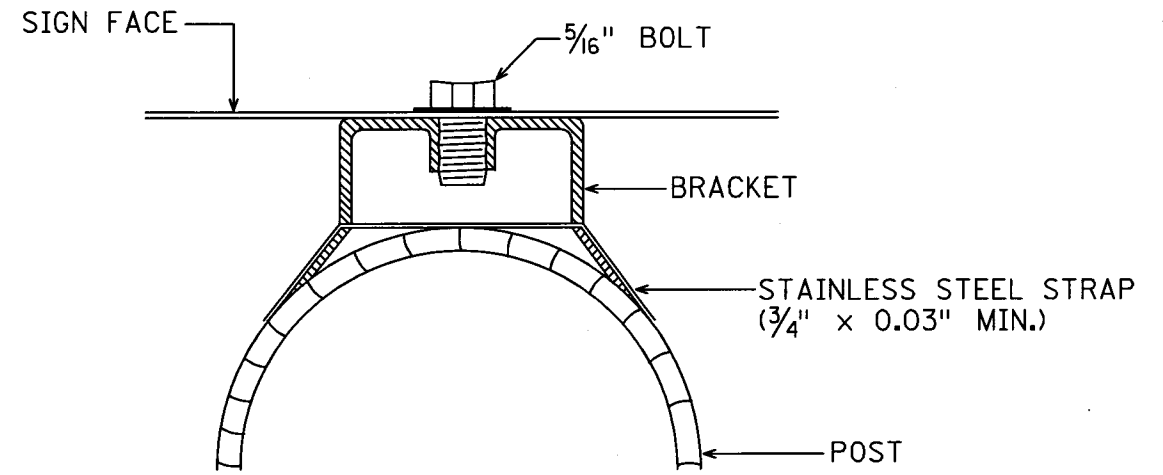

GALVANIZED OR STAINLESS  
 STEEL BRACKET, BOLT AND  
 WASHER.

STRAP MOUNTING DETAIL

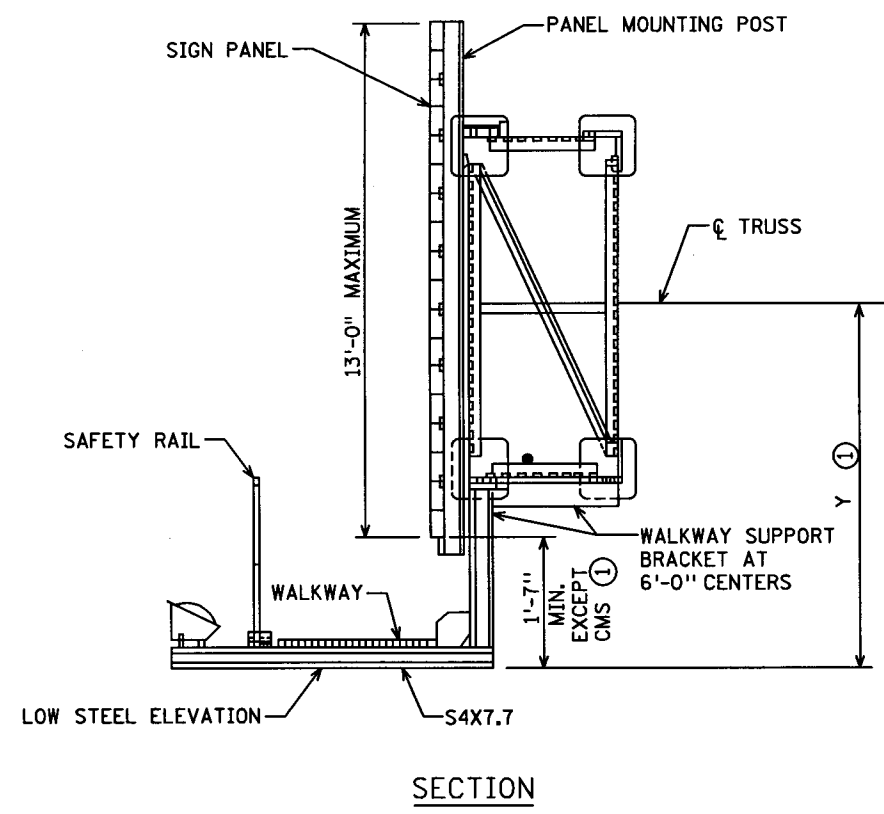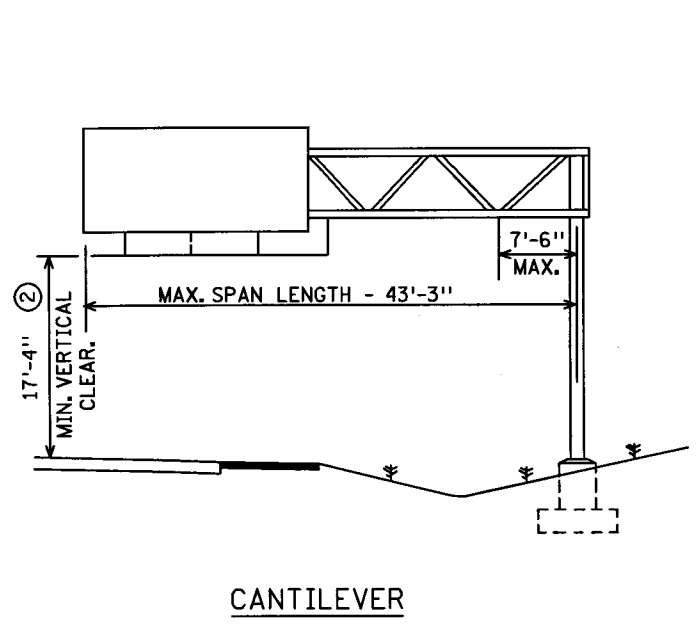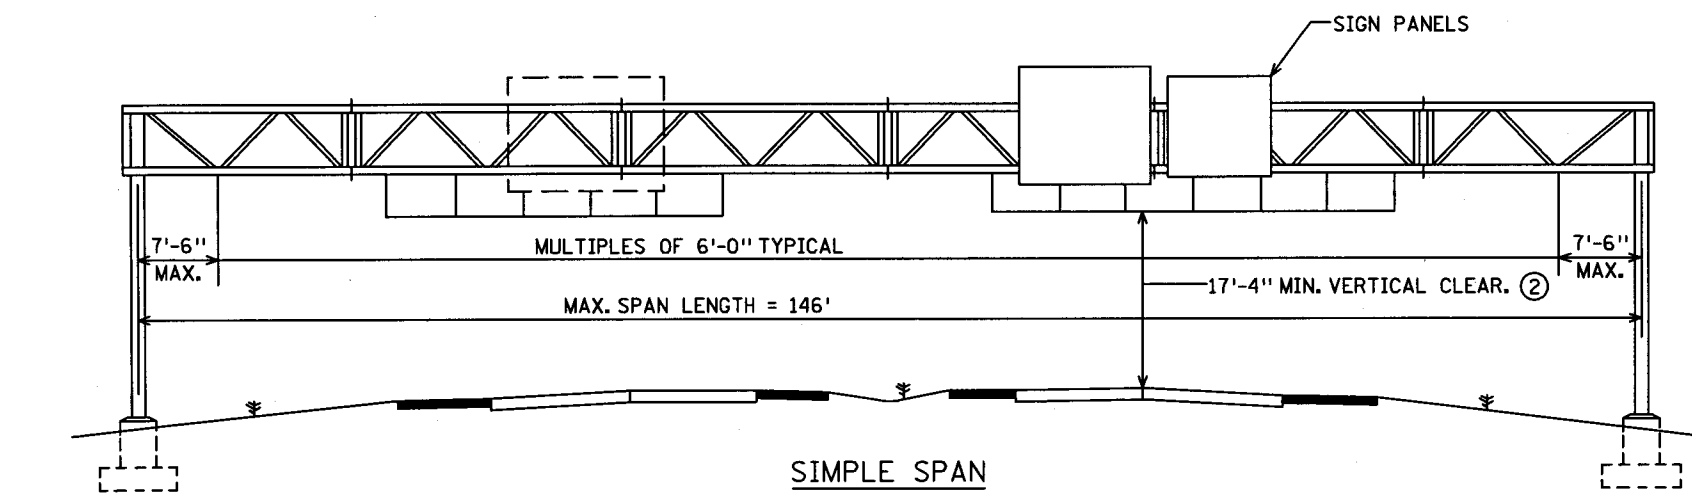

- SPECIFIC NOTES:**
- ① DIMENSION Y IS CONSTANT AND BASED ON THE DEEPEST SIGN PANEL ABOVE THAT WALKWAY. WHEN STANDARD SIGN PANEL(S) AND CMS ARE MOUNTED ON THE SAME SPAN, DIMENSION Y SHALL BE GOVERNED BY THE CMS.
  - ② MINIMUM CLEARANCE WILL BE MEASURED FROM THE HIGHEST ELEVATION OF PAVEMENT, SHOULDERS, AND MOUNTABLE CURBS, OR IF INSURMOUNTABLE CURBS ARE USED, THE HIGHEST ELEVATION BETWEEN CURB LINES.

**GENERAL NOTES:**

**DESIGN SPECIFICATIONS:**  
 TRUSS, POST, & HARDWARE:  
 AASHTO STANDARD SPECIFICATIONS FOR STRUCTURAL SUPPORTS FOR HIGHWAY SIGNS, LUMINAIRES AND TRAFFIC SIGNALS DATED 1999.

**LOADING:**  
 WIND LOAD 90 M.P.H. NORMAL TO SIGN FACE IN COMBINATION WITH OTHER LOADS OUTLINED IN THE DESIGN SPECIFICATIONS.

**UNIT STRESSES:**  
 CONCRETE----- F<sub>c</sub> = 1,600 PSI  
 REINFORCEMENT STEEL----- F<sub>s</sub> = 24,000 PSI  
 FOOTING SOIL PRESSURE----- 1-1/4 TONS PER SQ. FT.

**MATERIALS:**  
 STRUCTURAL STEEL (EXCEPT POST, TUBES)- Mn/DOT 3306  
 POST STEEL----- VARIES  
 HIGH STRENGTH BOLTS----- Mn/DOT 3391.2B  
 ANCHOR RODS----- Mn/DOT 3385  
 CASTINGS----- Mn/DOT 3322  
 REINFORCEMENT  
 BARS----- Mn/DOT 3301  
 SPIRAL----- Mn/DOT 3305 NO SPLICES  
 WALKWAY GRATING----- FEDERAL SPECIFICATIONS RR-G-661b, TYPE 1, STEEL  
 CONCRETE----- Mn/DOT 2461 (MIX 3Y43)

**FINISH:**  
 ALL COMPONENTS SHALL BE GALVANIZED AFTER FABRICATION EXCEPT REINFORCEMENT BARS, LOWER PORTION OF ANCHOR RODS, ALUMINUM, AND OTHER NON FERROUS INCIDENTALS. GALVANIZING SHALL CONFORM TO Mn/DOT 3392 OR Mn/DOT 3394 AS APPLICABLE. BEARING SURFACES MUST BE SMOOTH.

**FABRICATION:**  
 FABRICATION OF STRUCTURAL METALS SHALL BE IN ACCORDANCE WITH Mn/DOT 2471, Mn/DOT 2564 AND THE APPLICABLE SPECIAL PROVISIONS. ALL WELDING TO BE CONTINUOUS. ALL CONTACT SURFACES MUST BE COMPLETELY SEALED.

**INSPECTION:**  
 INSPECTION BEFORE AND AFTER GALVANIZING PER Mn/DOT 1511 AND Mn/DOT 2471.

**INDEX OF STANDARD SIGN DRAWINGS**

DRAWING	TITLE
ST-1	GENERAL ELEVATION AND NOTES
ST-2	CAMBER, POST IDENTIFICATION AND ESTIMATED QUANTITIES
ST-3	FOUNDATIONS AND ANCHOR RODS
ST-4	TRUSS/POST CONNECTION & BASEPLATE
ST-5	SIGN TRUSS DETAILS - TYPE A
ST-6	SIGN TRUSS DETAILS - TYPE B
ST-7	SIGN TRUSS DETAILS - TYPE C
ST-8	WALKWAY DETAILS
ST-9	FOLDING HANDRAIL
ST-10	SIGN PANEL AND PANEL MOUNTING POST DETAILS
ST-11	ELECTRICAL DETAILS
ST-12	ELECTRICAL DETAILS
ST-13	ELECTRICAL DETAILS (CMS SIGNS)

SIGN HEIGHT	Y ①	
6'-6"	4'-4"	CMS (NEW LED)
7'-0"	4'-7"	
7'-6"	4'-10"	CMS (LED)
8'-0"	5'-1"	
8'-6"	5'-4"	CMS (DRUM)
9'-0"	5'-7"	
9'-6"	5'-10"	
10'-0"	6'-1"	
10'-6"	6'-4"	
11'-0"	6'-7"	
11'-6"	6'-10"	
12'-0"	7'-1"	
12'-6"	7'-4"	
13'-0"	7'-7"	

STANDARD OVERHEAD SIGN SUPPORTS  
 INTERIM DESIGN B


GENERAL ELEVATIONS  
 AND NOTES

DRAWING ST-1

**SIMPLE SPAN**

SIMPLE SPAN TRUSS CAMBER												
SPAN	40	50	60	70	80	90	100	110	120	130	140	150
CAMBER	1/4	7/16	5/8	13/16	1 1/16	1 3/8	1 11/16	2	2 3/8	2 13/16	3 1/4	3 3/4
DL DEFLECTION	0	1/16	1/8	1/4	3/8	9/16	1 1/8	1 3/4	2 1/8	2 11/16	3 1/8	3 5/8
RESIDUAL CAMBER	1/4	3/8	9/16	1 1/16	1 3/16	1	1 1/8	1 3/16	1 1/4	1 5/16	1 3/8	1 1/2

NOTE:  
CAMBER AND DEFLECTIONS SHOWN ARE AT Q SPAN.  
THE DEFLECTIONS AND CAMBER AT THE QUARTER  
POINTS SHALL BE APPROXIMATELY 75% OF THESE  
VALUES.

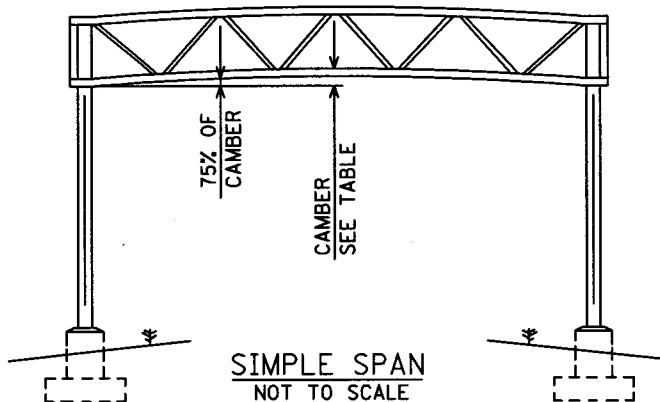

TRUSS QUANTITIES		
USE LENGTH FROM Q POST WHEN CALCULATING TOTAL WEIGHTS.		
TRUSS TYPE A	TRUSS TYPE B	TRUSS TYPE C
123 LBS./FT.	168 LBS./FT.	196 LBS./FT.


PANEL MOUNTING POST QUANTITIES INCLUDES MOUNTING ANGLES	
PANEL HEIGHT	WEIGHT/POST
6'-6"	70
7'-0"	74
7'-6"	78
8'-0"	82
8'-6"	86
9'-0"	90
9'-6"	93
10'-0"	97
10'-6"	101
11'-0"	105
11'-6"	160
12'-0"	166
12'-6"	172
13'-0"	178

**CANTILEVER SPAN**

CANTILEVER SPAN TRUSS CAMBER					
SPAN	15'	20'	30'	40'	45'
CAMBER	1/8	1/4	5/8	1 1/16	1 1/4
DL DEFLECTION	0	0	1/16	3/16	1/4
RESIDUAL CAMBER	1/8	1/4	9/16	7/8	1

NOTE:  
CAMBER AND DEFLECTIONS SHOWN ARE SHOWN AT  
END OF CANTILEVER.

WHEN ERECTING CANTILEVER TRUSSES, THE POSTS  
SHALL BE SET 1/8" PER FOOT OUT OF PLUMB TO  
COMPENSATE FOR THE BENDING OF THE POSTS.

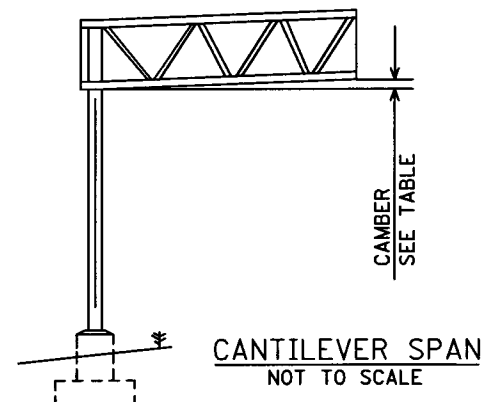

WALKWAY SUPPORT QUANTITIES			
USE MAXIMUM PANEL HEIGHT ON SPAN TO CALCULATE QUANTITIES. WHEN CONVENTIONAL SIGN PANEL(S) AND CMS ARE MOUNTED ON THE SAME SPAN, QUANTITIES SHALL BE GOVERNED BY THE CMS.			
PANEL HEIGHT	TRUSS TYPE (WEIGHT/SUPPORT)		
	A	B	C
CMS (NEW LED)			
6'-6"	99	105	113
7'-0"	101	107	115
7'-6"	103	109	117
CMS (LED)			
8'-0"	105	111	119
8'-6"	107	113	121
CMS (DRUM)			
9'-0"	109	115	123
9'-6"	111	117	125
10'-0"	113	119	127
10'-6"	115	121	129
11'-0"	135	142	151
11'-6"	138	144	153
12'-0"	141	147	156
12'-6"	143	150	159
13'-0"	146	153	162

FOR FOUNDATION QUANTITIES SEE DRAWING ST-3

TABLE 1 - POST IDENTIFICATION					
POST IDENTIFICATION NUMBER	BASEPLATE DESIGN	PERMISSIBLE PIPE SECTIONS			
		MIN. YIELD=35 KSI		MIN. YIELD=42 KSI	
		OUTSIDE DIAMETER (INCH)	WALL THICKNESS (INCH)	OUTSIDE DIAMETER (INCH)	WALL THICKNESS (INCH)
1	A	N.A.	N.A.	18	0.250
2	A	18	0.375	18	0.312
3	A	18	0.500	18	0.375
4	A	18	0.562	18	0.500
5	B	18	0.938	18	0.750
6	B	20	0.594	20	0.500
7	B	N.A.	N.A.	20	0.812

WALL THICKNESS IS MINIMUM, THINNER WALLS WILL NOT BE APPROVED

WALKWAY WEIGHTS:  
1. USE 3'-4 3/4" WIDE GRATING @ 44 LBS/FT.  
2. WEIGHT INCLUDES HANDRAIL (12 LBS/FT.) AND FIXTURE  
MOUNTING CHANNELS (4 LBS/FT.).

**POST IDENTIFICATION NOTES:**

POST MATERIAL SHALL CONFORM TO ONE OF THE FOLLOWING SPECIFICATIONS:  
ASTM A709, GRADE 36  
ASTM A53, GRADE B  
API 5L, GRADES B, X42, X46, X52, X56, X60, X65

CONTRACTOR SHALL DEMONSTRATE THAT THE POST MATERIAL MEETS THE REQUIREMENTS  
OF ONE OF THE ABOVE CITED SPECIFICATIONS AND THE MINIMUM YIELD STRENGTH.

NO SPLICES OF ANY KIND WILL BE PERMITTED IN POSTS INTENDED FOR USE IN CANTILEVER  
TYPE STRUCTURES (BRIDGE TYPE BC).

ONE OF TWO POSTS FOR SIMPLE SPAN STRUCTURES (BRIDGE TYPE S) MAY INCORPORATE ONE  
WELDED CIRCUMFERENTIAL BUTT SPLICE CONFORMING TO AWS D1.1 DETAIL B-U2 IN THE  
UPPER 1/3 OF ITS LENGTH. BACK UP RINGS FOR THESE WELDED SPLICES SHALL BE  
COMMERCIAL PRODUCTS. BUTT WELDS REQUIRE RADIOGRAPHIC INSPECTION (Mn/DOT 2471.3).

ALL RADIOGRAPHIC INSPECTIONS AND MAGNETIC PARTICLE TESTING REPORTS AND  
RADIOGRAPHIC FILMS SHALL BECOME THE PROPERTY OF THE DEPARTMENT.


SEE DRAWING ST-4 FOR BASEPLATE DETAILS.

POST QUANTITIES					
QUANTITIES INCLUDE ANCHORAGE ASSEMBLY AND TRUSS CONNECTION PLATES. PAY LENGTH OF POSTS IS FROM THE BOTTOM OF THE BASE PLATE (ELEV. A) TO THE TOP OF THE TRUSS. POST QUANTITIES ARE BASED ON GRADE 42 STEEL. NO ADJUSTMENTS WILL BE MADE IN THE QUANTITIES FOR THE USE OF GRADE 35 STEEL POSTS.					
POST TYPE	CANTILEVER		SIMPLE SPAN		
	TRUSS TYPE A	TRUSS TYPE B	TRUSS TYPE A	TRUSS TYPE B	TRUSS TYPE C
1	1880+47 LBS/FT	2470+47 LBS/FT	1870+47 LBS/FT	1890+47 LBS/FT	1915+47 LBS/FT
2	1880+59 LBS/FT	2470+59 LBS/FT	1870+59 LBS/FT	1890+59 LBS/FT	1915+59 LBS/FT
3	1880+71 LBS/FT	2470+71 LBS/FT	1870+71 LBS/FT	1890+71 LBS/FT	1915+71 LBS/FT
4	1880+94 LBS/FT	2470+94 LBS/FT	1870+94 LBS/FT	1890+94 LBS/FT	1915+94 LBS/FT
5	1910+138 LBS/FT	2500+138 LBS/FT	2460+138 LBS/FT	2480+138 LBS/FT	2505+138 LBS/FT
6	N/A	2500+104 LBS/FT	N/A	2545+104 LBS/FT	2570+104 LBS/FT
7	N/A	2500+167 LBS/FT	N/A	2545+167 LBS/FT	2570+167 LBS/FT

STANDARD OVERHEAD SIGN SUPPORTS  
INTERIM DESIGN B


CAMBER, POST IDENTIFICATION  
AND ESTIMATED QUANTITIES

DRAWING ST-2

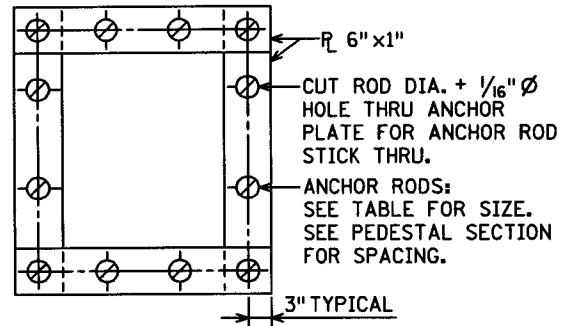


NOTE: ANCHOR PLATES SHOWN TYPICAL FOR ALL ANCHOR ROD SPACING.


ANCHOR PLATE PLAN

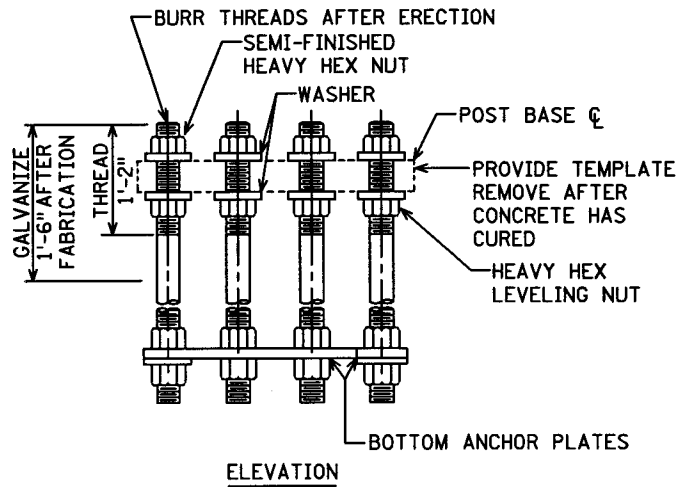

ANCHOR ROD DETAILS

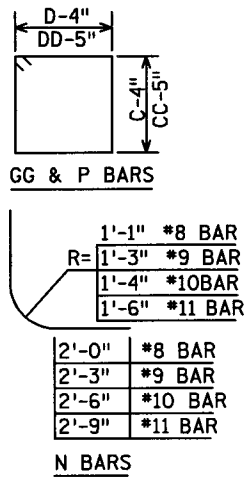

J, K, L, M, FF AND HH ARE STRAIGHT BARS  
BAR BENDING DIAGRAMS

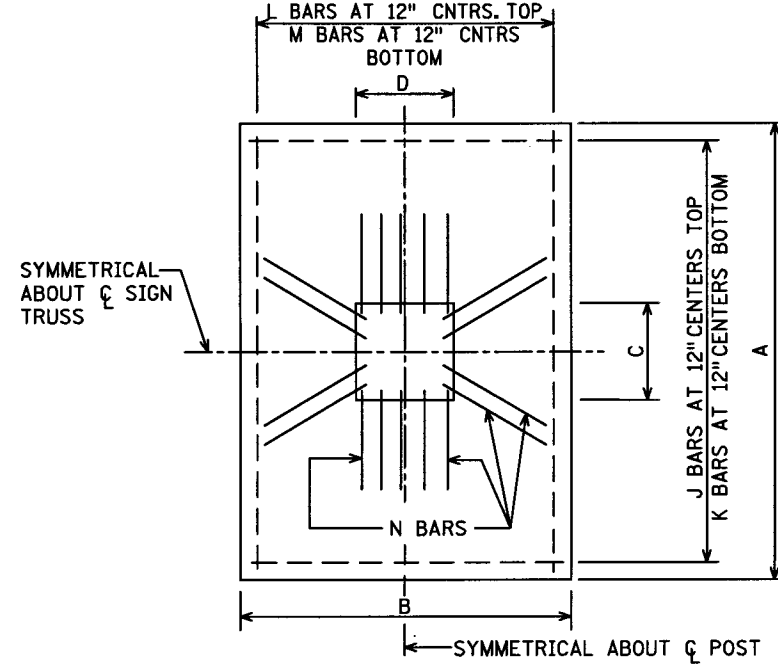

PLAN

ELEVATION  
SPREAD FOOTINGS


SPECIFIC NOTES:

- G IS IN FEET. ROUND UP TO WHOLE NUMBER. E.G.  $G=4.10/2G=8.2$  NO. REQ'D=9.
- G AND R ARE IN FEET.
- BEND AS REQUIRED TO FORM A CLOSED LOOP.
- FOR STRUCTURE STEEL SEE SPREAD FOOTING.
- MUST BE FORMED A MIN. OF 6" BELOW THE GROUND SURFACE. THE SOIL EXCAVATED FOR FORMING SHALL BE BACKFILLED AND TAMPED TO EQUIVALENT COMPACTION AS SURROUNDING MATERIAL.
- SPECIAL LARGE RADIUS BENDS ARE REQUIRED. SEE "BAR BENDING DIAGRAMS" FOR SIZES OF RADII.


GENERAL NOTES:

- SEE THE FORMAT SHEET FOR FOOTING LOCATIONS, POST DESIGNATIONS, TOP OF PEDESTAL ELEVATIONS AND BOTTOM OF FOOTING ELEVATIONS.
- ALL CONCRETE SHALL CONFORM TO CONCRETE MIX 3Y43 (MN/DOT 2461).
- ALL BAR DIMENSIONS ARE OUT TO OUT OF BARS.
- ALL SPREAD FOOTINGS HAVE AN ALLOWABLE DESIGN BEARING PRESSURE OF  $1\frac{1}{4}$  T PER SQUARE FOOT.
- DRILLED SHAFTS SHALL BE USED ONLY WHEN SPECIFIED IN THE CONTRACT PLANS.
- THE DRILLED SHAFTS HAVE AN ALLOWABLE DESIGN LATERAL BEARING PRESSURE OF 250 LBS. PER SQ. FT. PER FOOT OF DEPTH.
- UNLESS OTHERWISE NOTED, ALL REINFORCEMENT BARS SHALL BE EPOXY COATED IN ACCORDANCE WITH MN/DOT 3301. SPIRAL BARS AND J, K, L, & M BARS NEED NOT BE EPOXY COATED.
- THE FOLLOWING TORQUE VALUES SHALL BE USED WHEN INSTALLING ALL ANCHOR NUTS FOR OVERHEAD SIGN STRUCTURES:  
ANCHOR  
BOLT DIAMETER TORQUE (FT./LBS.)  
 $2\frac{1}{4}$ " 375  
 $2\frac{1}{2}$ " 450  
THE CONTRACTOR SHALL BURR THE THREADS OF THE ANCHOR BOLTS IN ACCORDANCE WITH MN/DOT 2402.3H AFTER TORQUEING NUTS.


NOTE (5): MUST BE FORMED A MINIMUM OF 6" BELOW THE GROUND SURFACE. THE EXCAVATED AREA FOR FORMING SHALL BE BACKFILLED AND TAMPED WITH EQUIVALENT TO SURROUNDING MATERIAL.

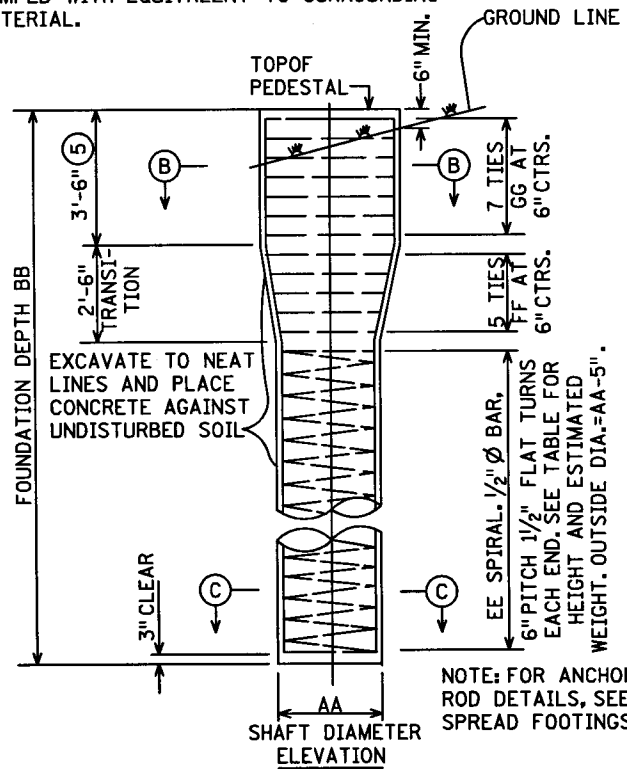


DRILLED SHAFT

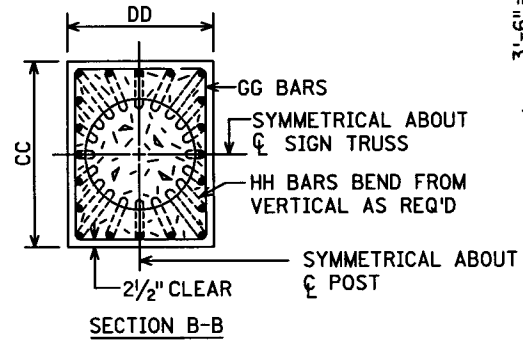


SECTION B-B

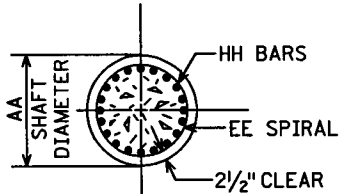

SECTION C-C

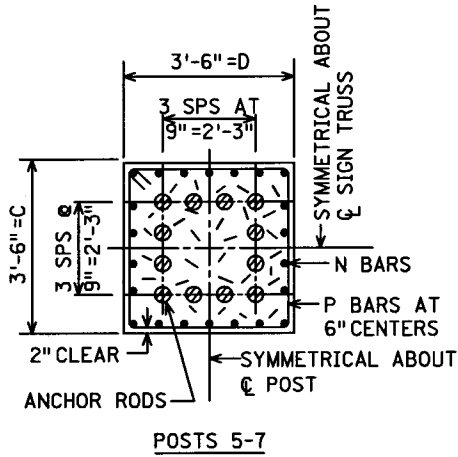


POSTS 5-7

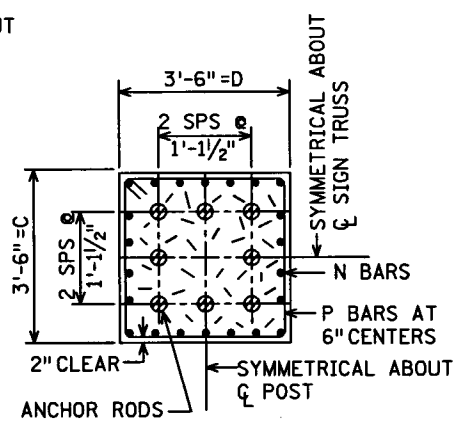

POSTS 1-4

PEDESTAL CROSS SECTIONS A-A

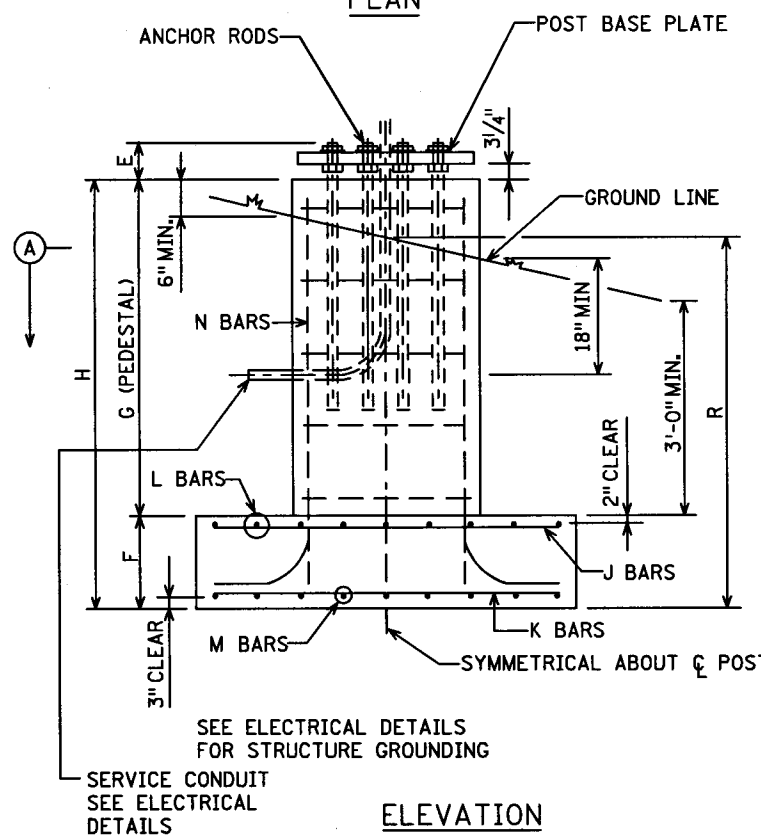

POST NO.	DIMENSIONS				REINFORCING BARS				ESTIMATED QUANTITIES (4)		SUMMARY OF ESTIMATED QUANTITIES			
	AA	BB	CC	DD	EE	FF (3)	GG	HH	CONCRETE CY	REIN STEEL LBS.	CONCRETE CY (2)	REIN. STEEL LBS. (2)	ANCH. ASSM. LBS	ST. EXC. C.Y. (2)
1-4	3'-0" Ø	23'-0"	3'-6"	3'-6"	16'-6" x 197 LBS.	5 #5 x 14'-1"	7 #5 x 14'-1"	20 #9 x 22'-7"	6.9	1910	9.3 + 0.46 G	945 + 98G	781	7.4 R
5-7	4'-0" Ø	29'-0"	4'-0"	4'-0"	22'-6" x 362 LBS.	5 #5 x 16'-1"	7 #5 x 16'-1"	24 #10 x 28'-7"	14.1	3490	16.7 + 0.46 G	2333 + 133G	1320	12.1 R

POST NO.	SPREAD FOOTINGS																										
	ANCHOR RODS		J REIN. BARS		K REIN. BARS		L REIN. BARS		M REIN. BARS		(6) N REIN. BARS		P REIN. BARS (1)														
	A	B	C	D	E	F	NO. REQ'D	DIA.	LENGTH	NO. REQ'D	SIZE	LENGTH	NO. REQ'D	SIZE	LENGTH	NO. REQ'D	SIZE	LENGTH	NO. REQ'D	SIZE	LENGTH						
1-4	14'-0"	9'-0"	3'-6"	3'-6"	8 1/2"	2'-0"	8	2 1/4"	3'-10 1/2"	14	#4	8'-6"	14	#6	8'-6"	10	#5	13'-6"	10	#7	13'-6"	20	#9	H + 2'-6"	2G	#5	14'-3"
5-7	18'-0"	12'-6"	3'-6"	3'-6"	9"	2'-0"	12	2 1/2"	4'-0"	19	#4	12'-0"	19	#6	12'-0"	13	#6	17'-6"	13	#10	17'-6"	24	#10	H + 2'-9"	2G	#5	14'-3"



STANDARD OVERHEAD SIGN SUPPORTS  
INTERIM DESIGN B

FOUNDATIONS AND  
ANCHOR RODS

DRAWING ST-3

2-16-06



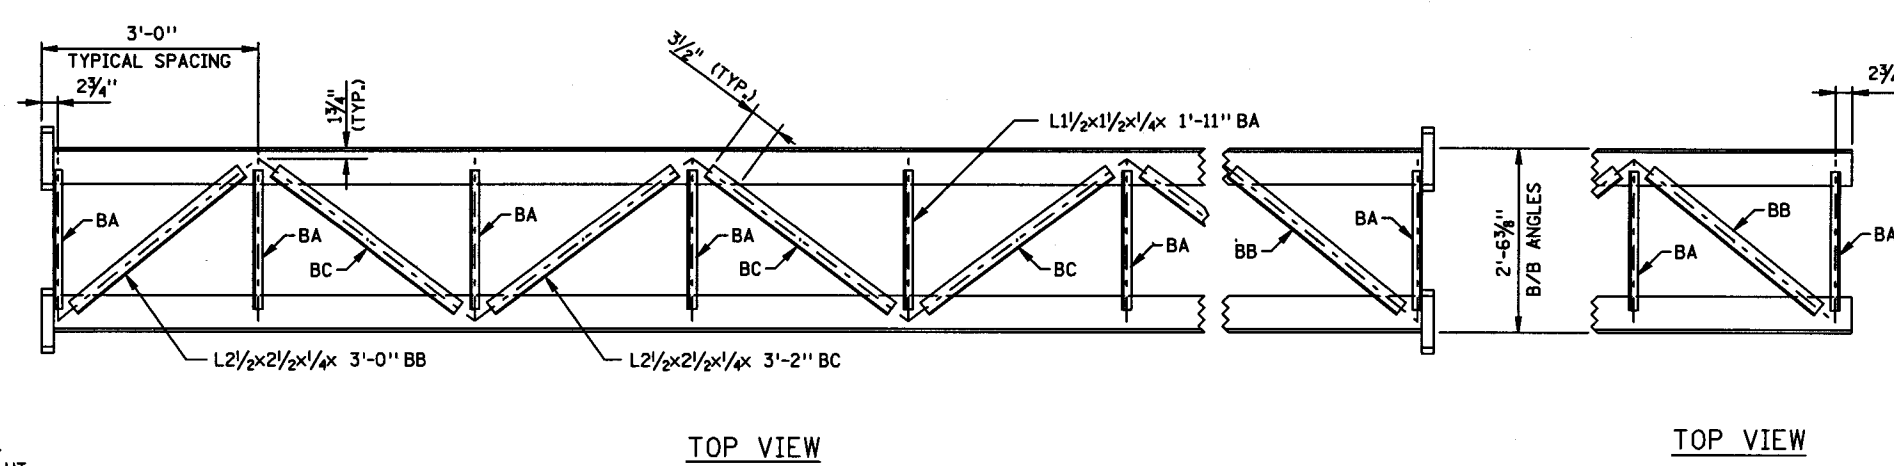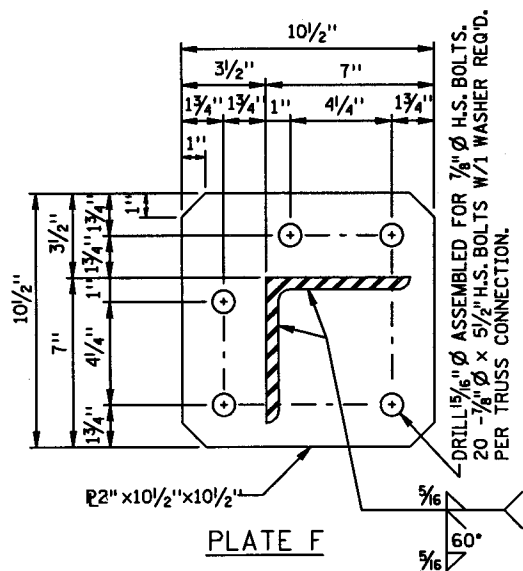

NOTES:

TRUSS SECTIONS SHALL BE MADE IN MULTIPLES OF 6'-0", EXCEPT THAT THE BRACING PANEL NEAREST EACH POST MAY VARY TO MAKE UP THE NEEDED SECTION LENGTH. WELDED CHORD SPLICES ARE NOT PERMITTED EXCEPT IN CANTILEVER TRUSSES AS NOTED BELOW.

CANTILEVER TRUSSES SHALL BE SUPPLIED AS A SINGLE UNIT WHENEVER POSSIBLE. WHEN CANTILEVER TRUSS LENGTH EXCEEDS 40'-0" CHORDS MAY BE SPLICED, AS SHOWN, IN THE END BRACING PANEL ONLY. CHORD SPLICE WELD SHALL BE COMPLETE PENETRATION, WITH 100% UT AND MT TESTING PER 2471.3M.

UNLESS OTHERWISE SHOWN, ALL WELDS SHALL BE 1/4" FILLET WELDS ALL AROUND.






BOLTED SPLICES SHALL NOT BE LOCATED BEHIND CMS SIGNS.

PROVIDE 2- 1/16" BRASS, STAINLESS STEEL OR GALVANIZED STEEL SHIMS AT EACH FLANGE TO BRING TRUSS INTO CORRECT CAMBER AND ALIGNMENT.

TRUSSES SHALL BE SHOP ASSEMBLED AND MATCH MARKED.


ALL VIEWS OF THE TRUSSES ARE DRAWN FROM THE INSIDE OF THE TRUSS LOOKING OUT.

SEE DRAWING ST-4 FOR POST CONNECTION DETAILS.

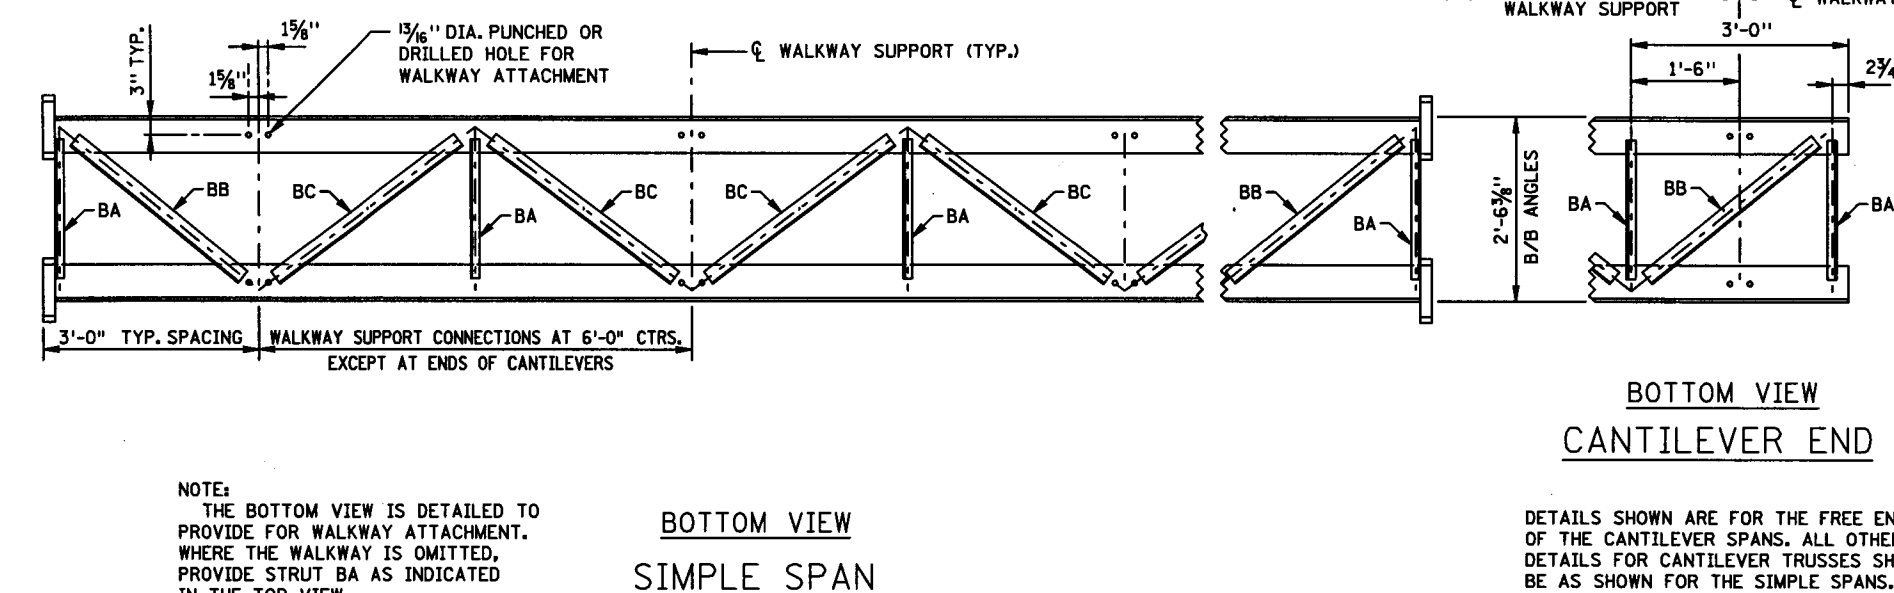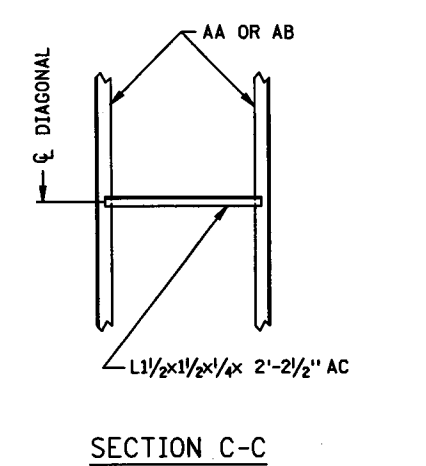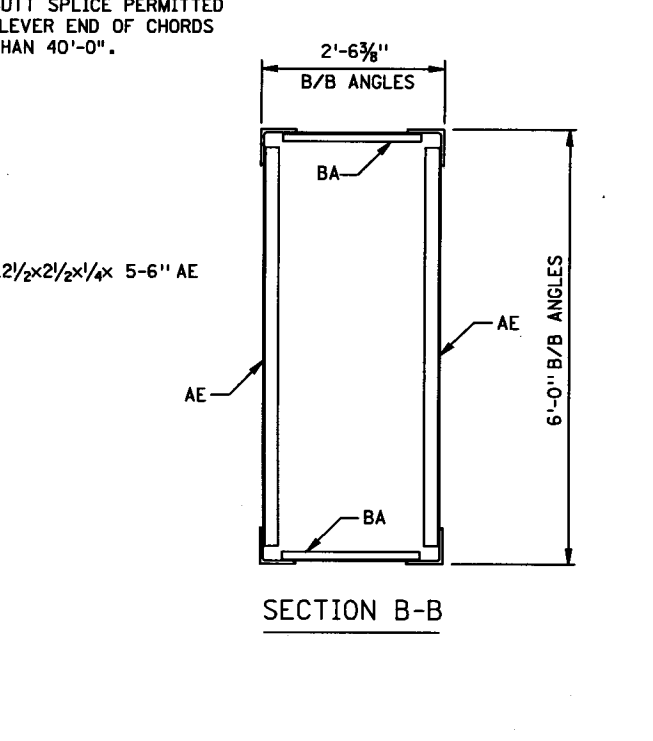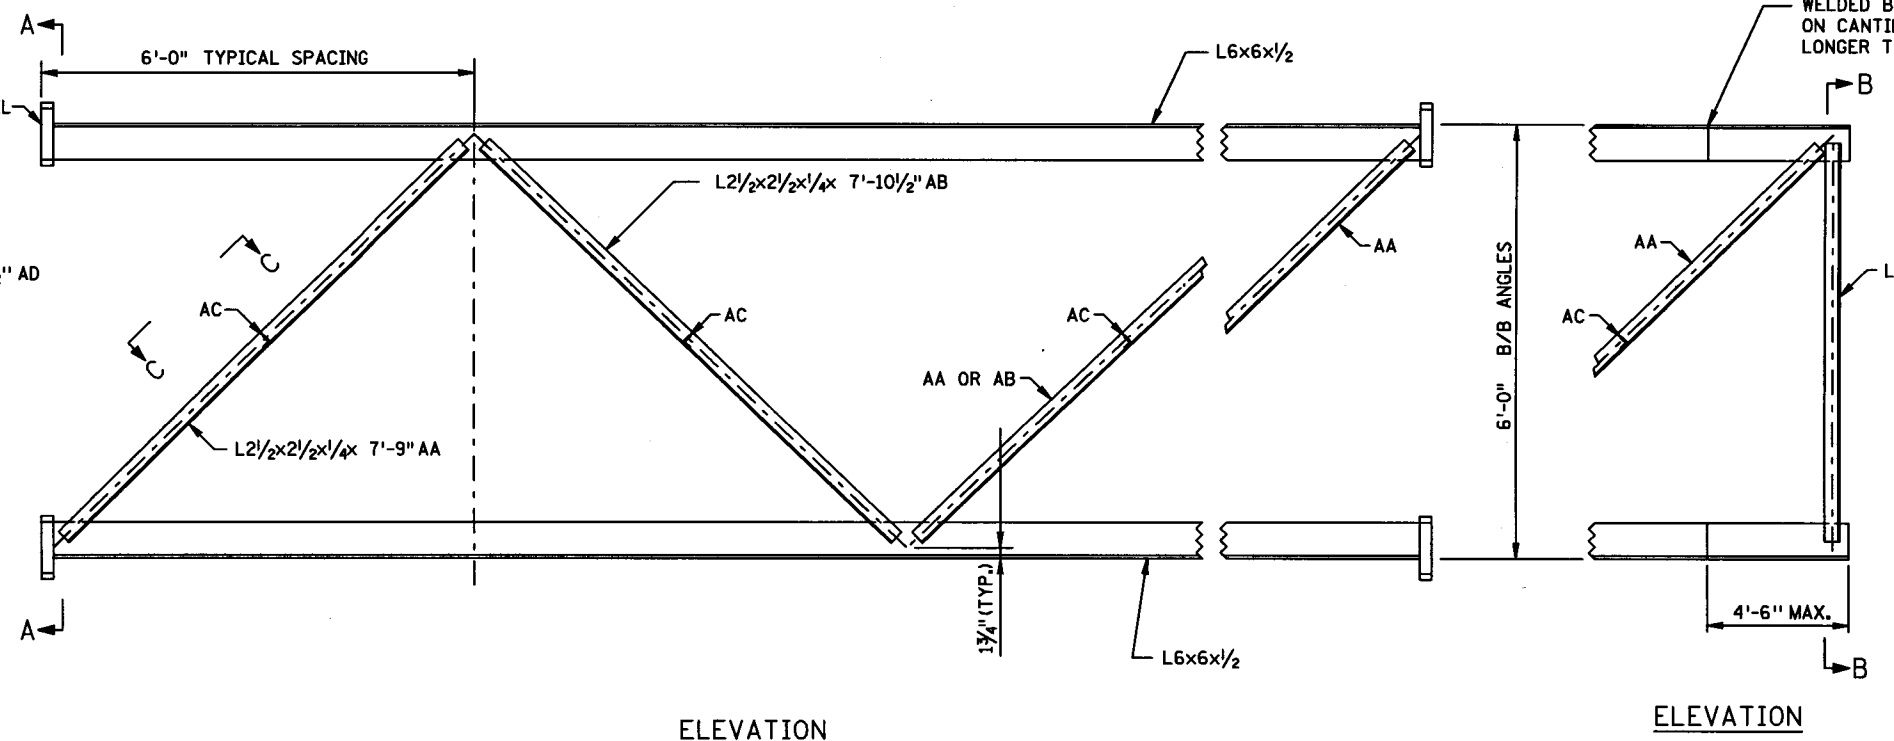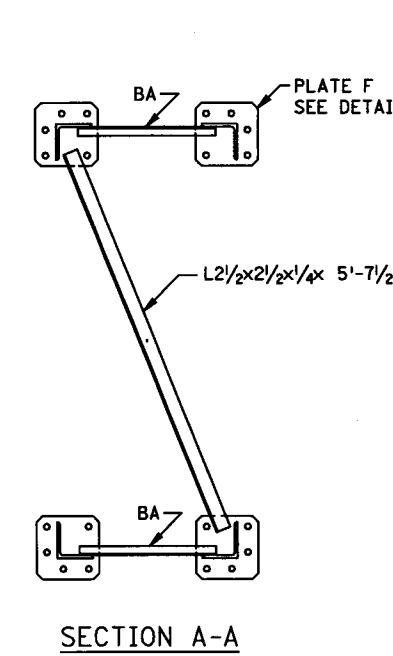


NOTE: THE BOTTOM VIEW IS DETAILED TO PROVIDE FOR WALKWAY ATTACHMENT. WHERE THE WALKWAY IS OMITTED, PROVIDE STRUT BA AS INDICATED IN THE TOP VIEW.

BOTTOM VIEW SIMPLE SPAN

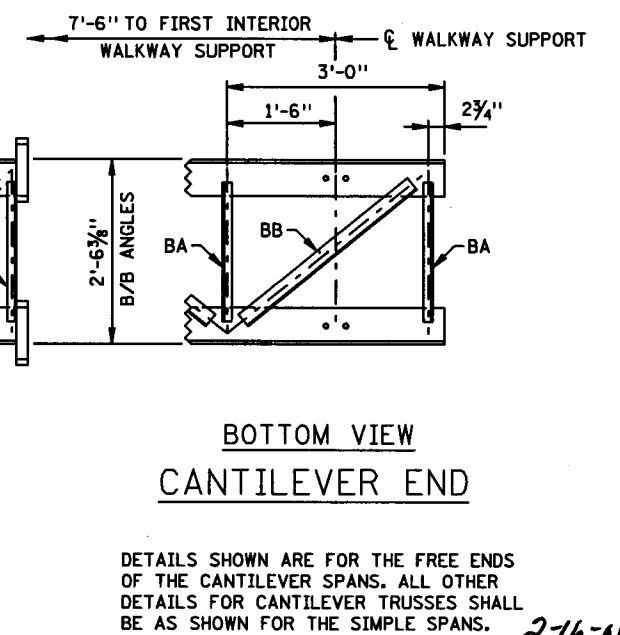

DETAILS SHOWN ARE FOR THE FREE ENDS OF THE CANTILEVER SPANS. ALL OTHER DETAILS FOR CANTILEVER TRUSSES SHALL BE AS SHOWN FOR THE SIMPLE SPANS.

STANDARD OVERHEAD SIGN SUPPORTS INTERIM DESIGN B
SIGN TRUSS DETAILS TRUSS TYPE A
DRAWING ST-5

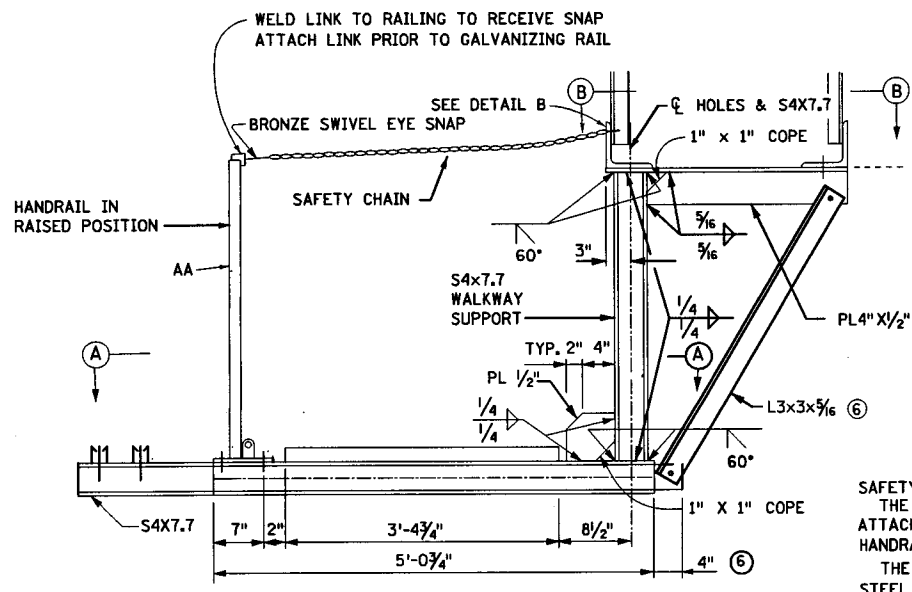


TYPICAL WALKWAY DETAILS

SIGN HEIGHT	X (1)
6'-6"	1'-0"
7'-0"	1'-3"
7'-6"	1'-6"
8'-0"	1'-9"
8'-6"	2'-0"
9'-0"	2'-3"
9'-6"	2'-6"
10'-0"	2'-9"
10'-6"	3'-0"
11'-0"	3'-3"
11'-6"	3'-6"
12'-0"	3'-9"
12'-6"	4'-0"
13'-0"	4'-3"

① SEE NOTE 1 ON DRAWING ST-1


**SAFETY CHAIN NOTES:**  
 THE SAFETY CHAIN SHALL BE ATTACHED AT EACH END OF THE HANDRAIL.  
 THE CHAIN SHALL BE 3/16" STAINLESS STEEL STRAIGHT LENGTH CHAIN WITH APPROXIMATELY 12 LINKS PER FOOT. THE CHAIN AND ITS CONNECTIONS SHALL HAVE A MINIMUM RATED WORK LOAD OF 700 LBS.

RAILING ELEVATION AT END OF CANTILEVER

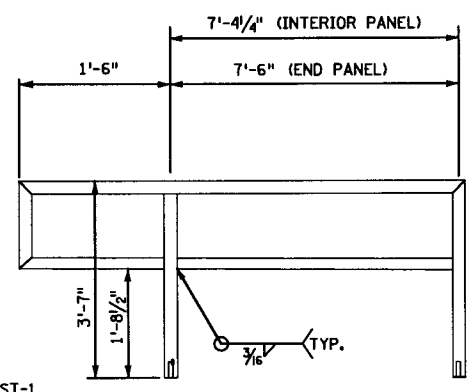


STRUCTURAL TUBING 1/2 X 1/2 X 3/16 (TYP.)

RAILING ELEVATION 6' PANEL

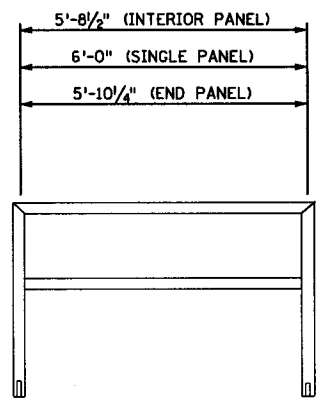


STRUCTURAL TUBING 1/2 X 1/2 X 3/16 (TYP.)


RAILING ELEVATION 12' PANEL

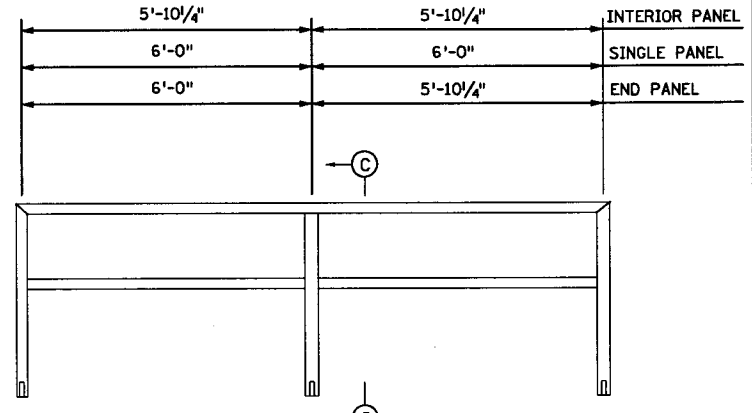


STRUCTURAL TUBING 1/2 X 1/2 X 3/16 (TYP.)

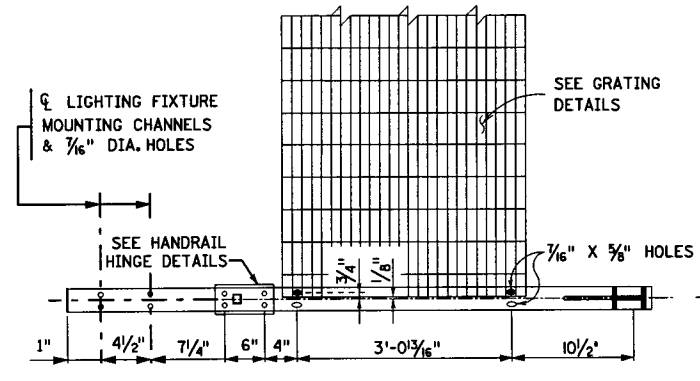


VIEW A-A

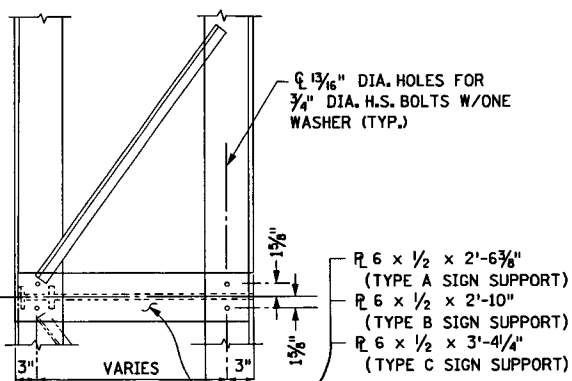


VIEW B-B

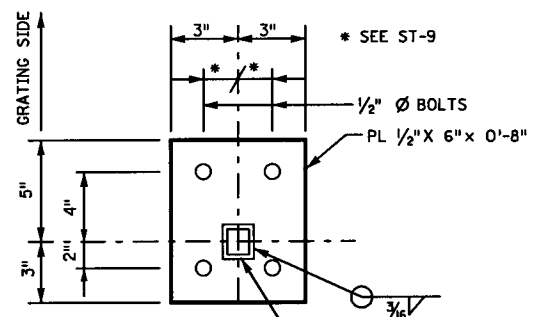


VIEW G-G  
 TS 1/2 X 1/2 X 3/16 POST  
 BASE PLATE  
 FIXED HANDRAIL POST

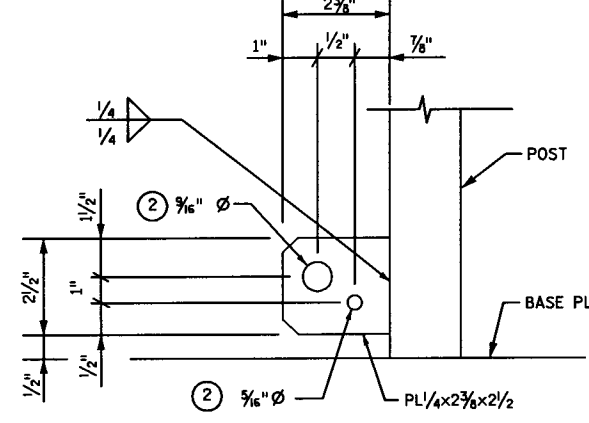


DETAIL "D"

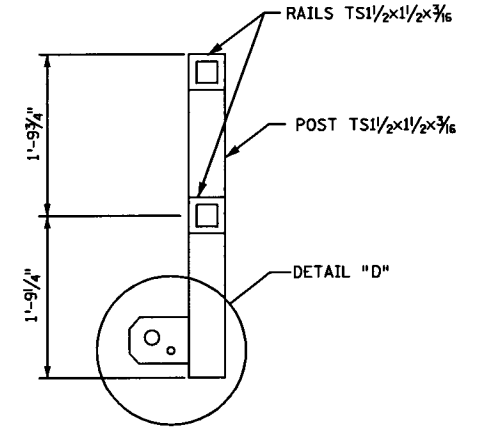


VIEW C-C  
 FOLDING HANDRAIL POST

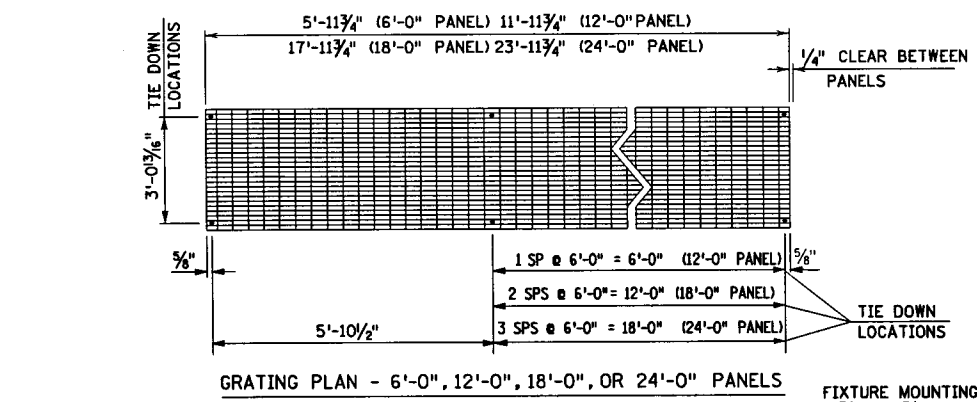


GRATING PLAN - 6'-0", 12'-0", 18'-0", OR 24'-0" PANELS

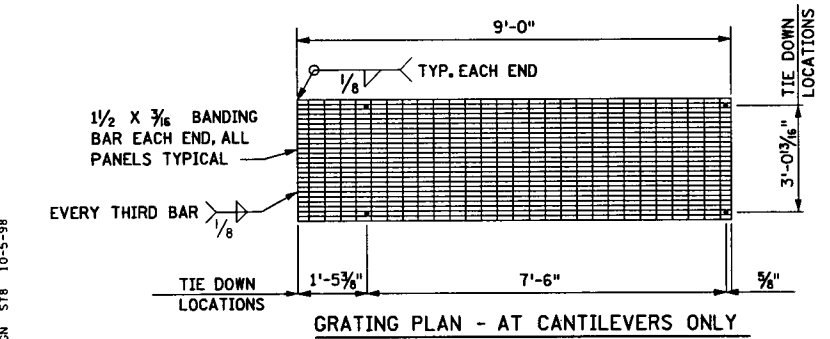

GRATING PLAN - AT CANTILEVERS ONLY

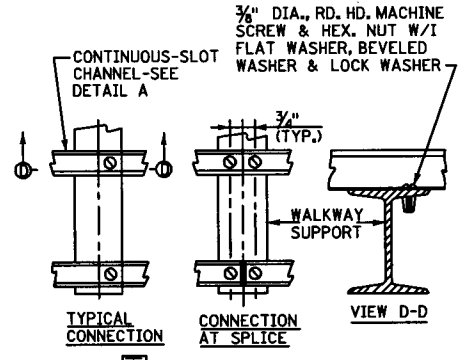


TYPICAL CONNECTION  
 CONNECTION AT SPLICE

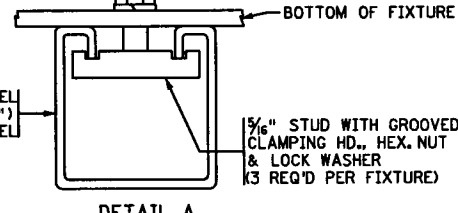


DETAIL A  
 FIXTURE MOUNTING DETAILS

**NOTE:**  
 ALL GRATING SHALL BE 3'-4 3/4" WIDE AND SHALL BE 1/2" X 3/16" SERRATED BEARING BARS AT 1 3/8" CENTERS WITH CROSS BARS AT 4" CENTERS. ATTACH GRATING AT EACH TIE DOWN LOCATION WITH A STAINLESS STEEL SADDLE ANCHOR DESIGNED FOR THIS SPECIFIC USE.


**FIXTURE MOUNTING CHANNEL NOTES:**  
 FIXTURE MOUNTING CHANNELS SHALL EXTEND THE FULL LENGTH OF THE WALKWAY AND SHALL BE CONTINUOUS OVER AS MANY WALKWAY SUPPORT SPANS AS PRACTICABLE CONSISTENT WITH EASE OF HANDLING AND ASSEMBLING. JOINTS IN THE CHANNELS SHALL BE CENTERED ON THE WALKWAY SUPPORTS WITH A MAX 1/8" GAP BETWEEN SECTIONS. CHANNELS SHALL HAVE A 1/4" DRAIN HOLE IN EACH WALKWAY SUPPORT SPAN.

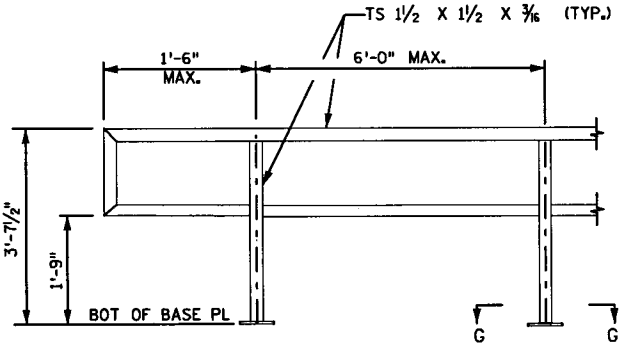

FIXED HANDRAIL FOR OH SIGN

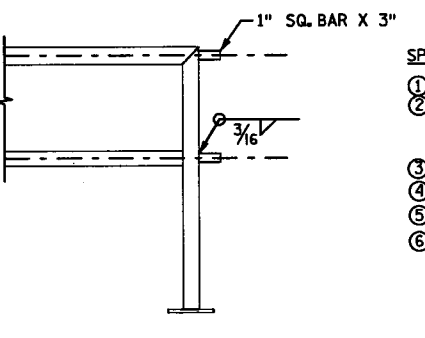

FIXED RAIL SPLICE DETAIL

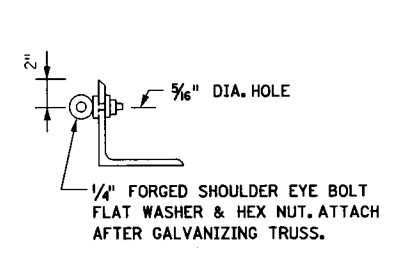

DETAIL B

**GENERAL NOTES:**  
 WALKWAY DETAILS SHOWN ARE TYPICAL FOR CANTILEVER AND SIMPLE SPAN SIGNS  
 WHEN THE FORMAT SHEET INDICATES THAT THE WALKWAY IS CONTINUOUS FROM ONE SPAN TO ANOTHER, THE CONTRACTOR SHALL BE RESPONSIBLE FOR DETERMINING THE SPECIAL LENGTH GRATING AND HANDRAIL PANELS REQUIRED.  
 FOLDING HANDRAIL PANELS ARE TO BE CONTINUOUS OVER A MAX. OF TWO WALKWAY SUPPORT SPANS. THE CONTRACTOR SHALL BE RESPONSIBLE FOR DETERMINING THE LENGTH OF GRATING AND HANDRAIL PANELS REQUIRED FOR BRIDGE MOUNTED SIGNS AND CANTILEVERS WHERE THE SPECIFIED LENGTH DOES NOT AGREE WITH THE DETAILS. PROVIDE ADEQUATE WEEP HOLES FOR HOT-DIP GALVANIZING.

- SPECIFIC NOTES:**
- SEE NOTE 1 ON DRAWING ST-1
  - REAM RAILING SUPPORT BOLT AND LOCKING PIN HOLES AFTER GALVANIZING TO ENSURE BOLT AND PIN FIT.
  - LED CMS
  - DRUM CMS
  - NEW LED CMS
  - USE FOR SIGN HEIGHTS OF 11'-0" OR GREATER. EXTEND S4x7.7 BY 4" AND COPE FLANGES.

STANDARD OVERHEAD SIGN SUPPORTS  
 INTERIM DESIGN B

WALKWAY DETAILS

DRAWING ST-8

ST.00N STB 10-5-98


REVISED 2/8/00

State Proj. No. 6284-137


Sheet No. TM24 of TM26 Sheets

2-16-06



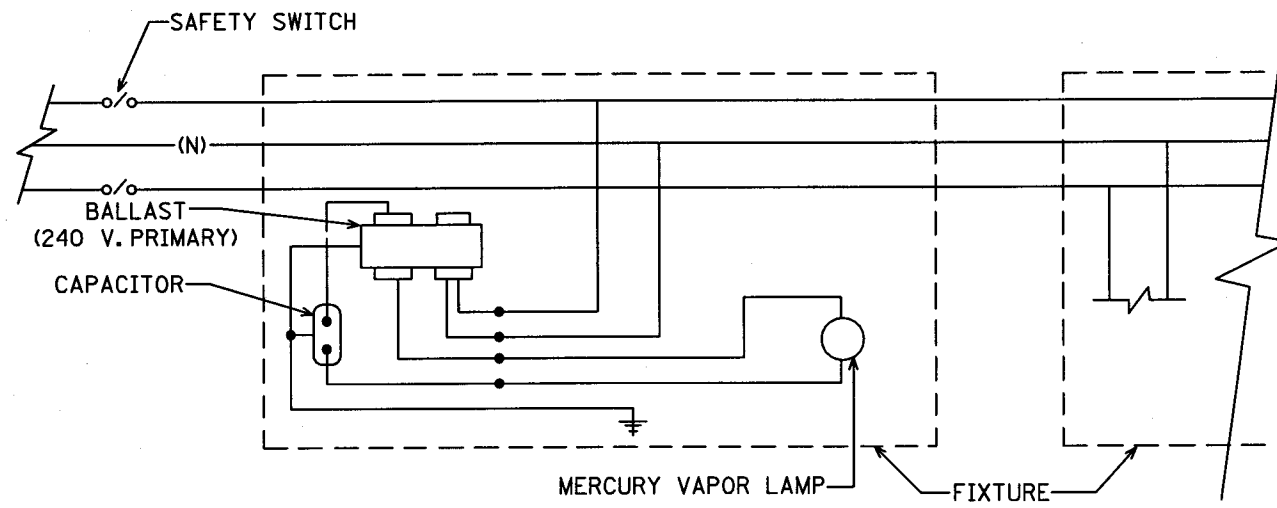


240/480 V. CIRCUIT

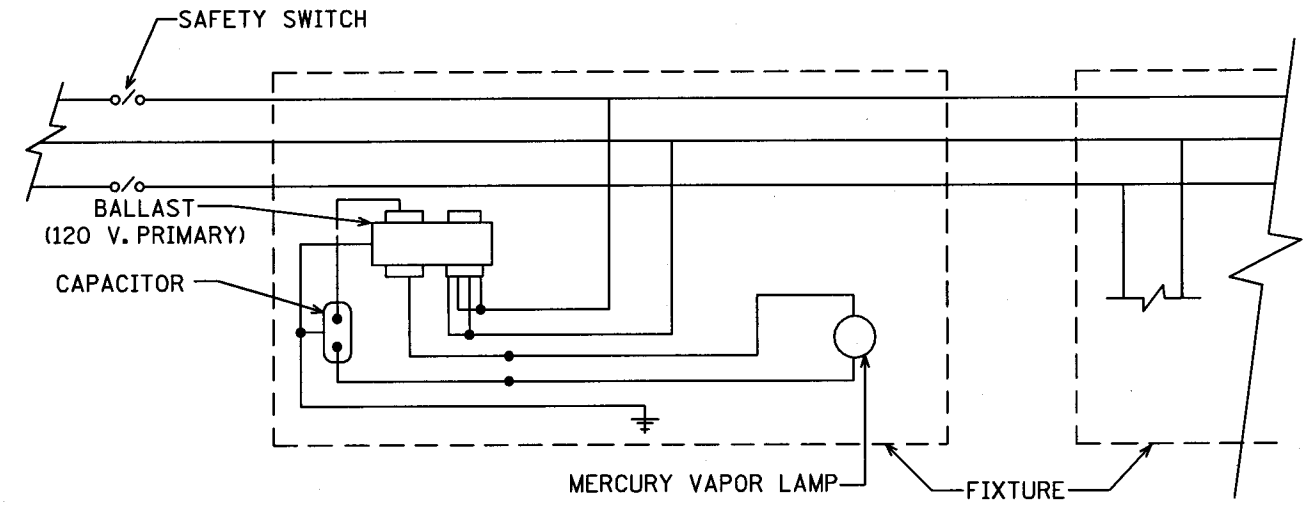

120/240 V. CIRCUIT

TYPICAL CIRCUIT DIAGRAMS

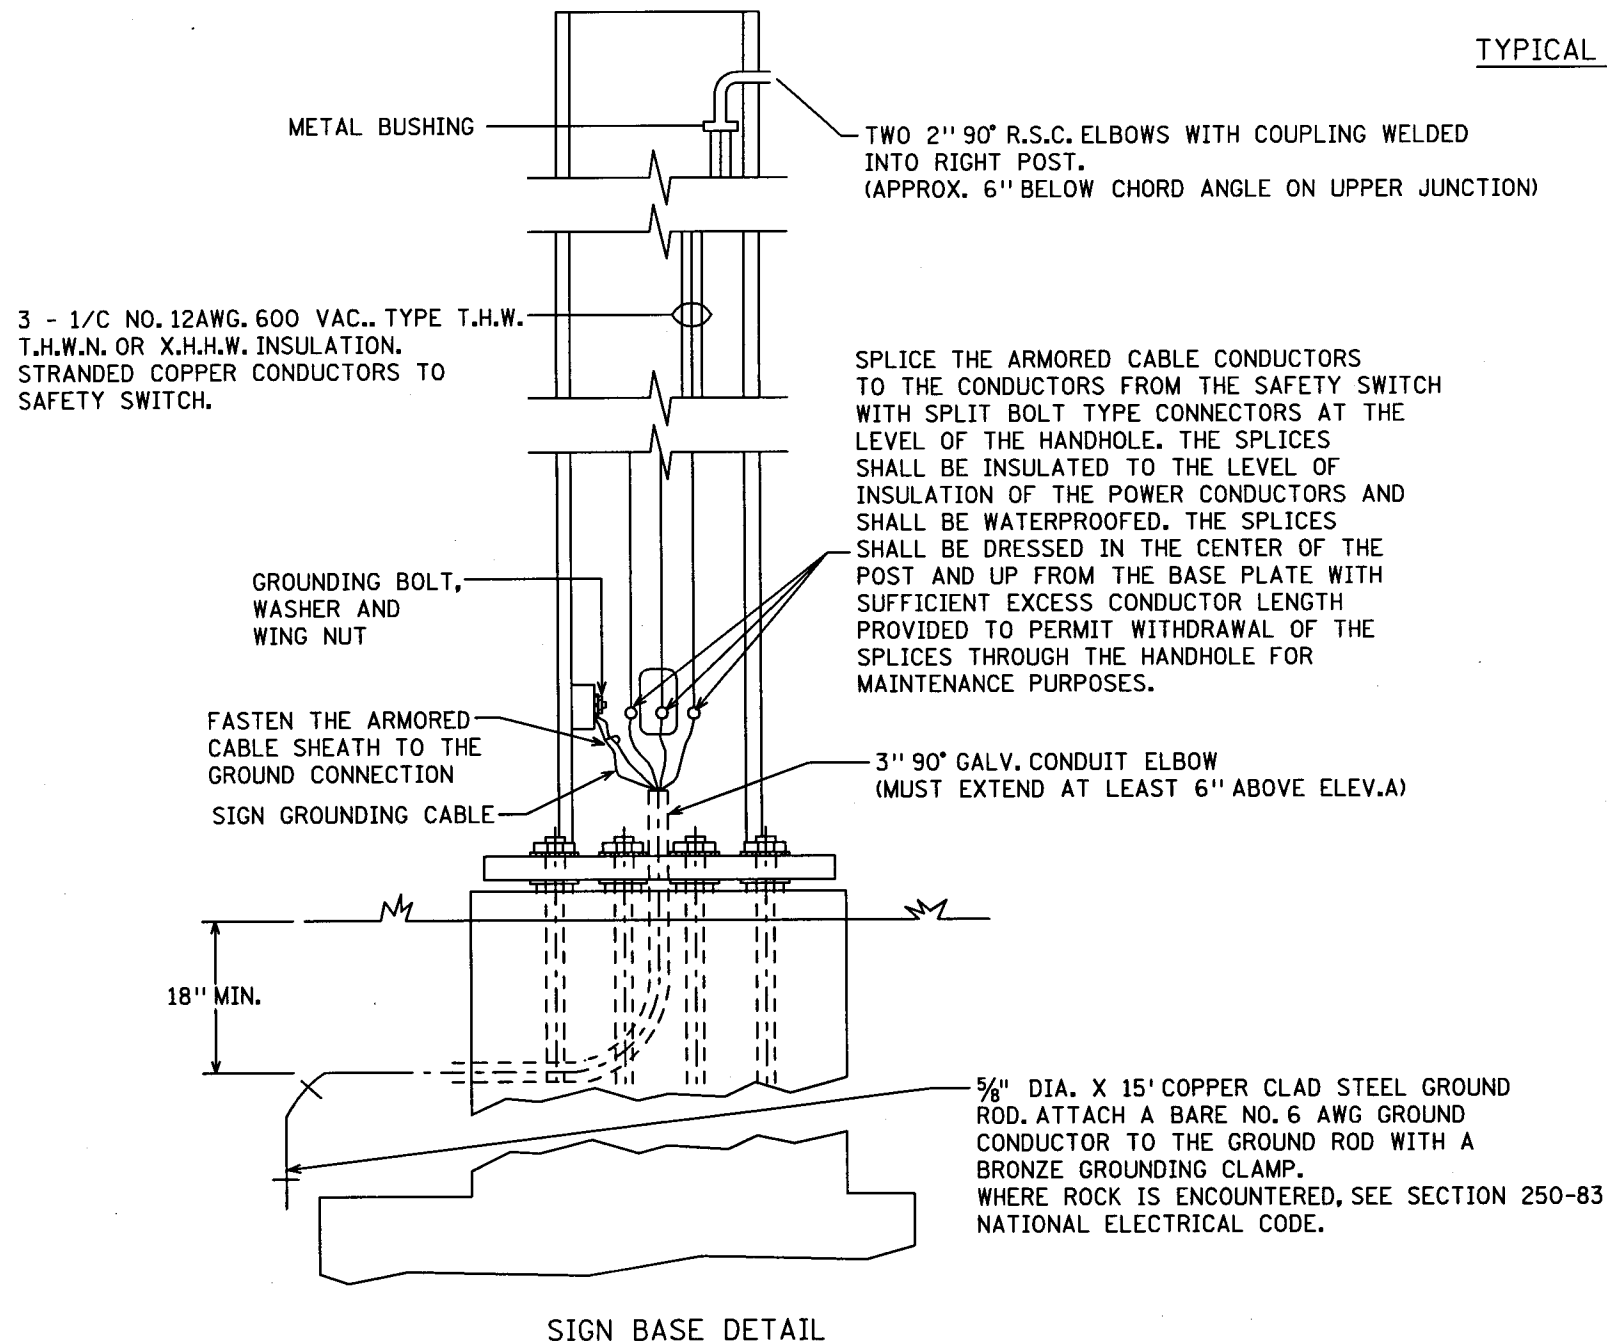

ELECTRICAL NOTES:

1. WHEN SIGN LIGHTING SYSTEMS HAVE BEEN COMPLETED, THE CONTRACTOR SHALL, WITHOUT FURTHER COMPENSATION, CONDUCT BURNING AND RESISTANCE TESTS FOR FINAL ACCEPTANCE. THE RESISTANCE TO GROUND OF EACH UNGROUNDED CONDUCTOR SHALL BE NOT LESS THAN 8 MEGOHMS.
2. ALL FITTINGS, HUBS, UNIONS, BUSHINGS, ETC. SHALL BE SUPPLIED AS PART OF CONDUIT, CONDUIT ENTERING SIGN POSTS SHALL HAVE INSULATED GROUNDING BUSHINGS INSTALLED BEFORE PULLING WIRE.
3. CONDUIT ON STRUCTURE SHALL BE SURFACED MOUNTED, STRAPPED AT EVERY ANGLE BRACE WITH U-BOLT TYPE CLAMPS.
4. SUCCESSIVE LIGHTING FIXTURES SHALL BE CONNECTED ON ALTERNATE SIDES OF THE 3-WIRE CIRCUIT.
5. THE CABLE SHEATH SHALL EXTEND AT LEAST 4" ABOVE THE TOP OF THE CONDUIT END AND THE TAPE ARMOR OF ARMORED CABLE SHALL BE CONNECTED TO THE GROUNDING BOLT IN THE SIGN POSTS.
6. WIRING FROM THE SAFETY SWITCH TO LIGHTING FIXTURES SHALL BE 1/C NO. 12 AWG AND SHALL BE RUN IN 3/4" R.S.C. ALL SPLICING SHALL BE ACCOMPLISHED WITH A WIRE NUT AND WATERPROOF COATING. ALL CONDUIT CONNECTIONS SHALL BE RAIN TIGHT.


STANDARD OVERHEAD SIGN SUPPORTS INTERIM DESIGN B
MODIFIED ELECTRICAL DETAILS
DRAWING ST-13

2-16-06

OH 366-35W  
 S.B. T.H. 35W  
 STA. 484+50


QUANTITIES

	<u>DESIGN</u>	<u>FINAL</u>
POST STEEL	6148 LBS	_____
TRUSS STEEL	8705 LBS	_____
WALKWAY SUPPORT STEEL	198 LBS	_____
WALKWAY GRATING STEEL	360 LBS	_____
PANEL MOUNTING POST STEEL	LBS	_____
CONCRETE (SHAFT) FOOTINGS	CU YDS	_____
CONCRETE (SPREAD) FOOTINGS	22.5 CU YDS	_____

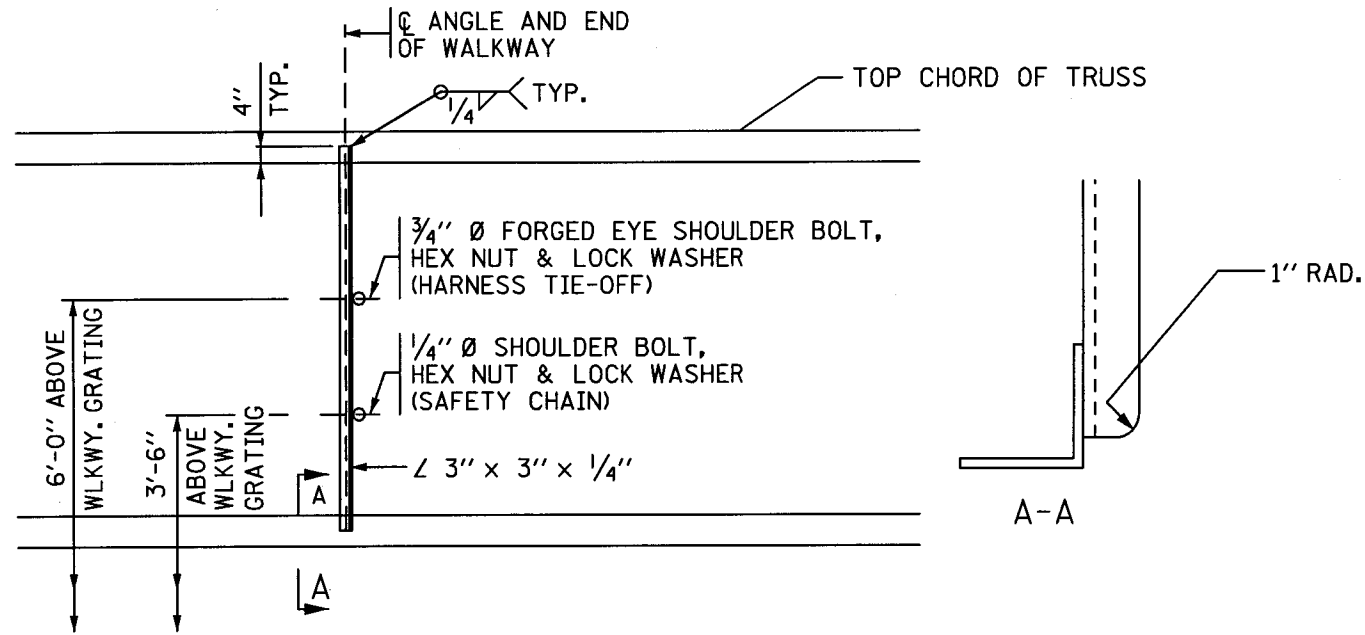

TIE OFF STANCHION FOR CMS TRUSS-MTD.

- NOTES:
1. "Y" DIMENSION = 4.33 FT.
  2. F. & I. TWO 6' x 6' x 3/8" x 29'-1" MOUNTING ANGLES AND ONE 3' x 3' x 1/4" x 5'-9" ANGLE FOR LED CMS.
  3. USE FIXED HANDRAIL, SEE WALKWAY DETAIL DRAWING ST-8.

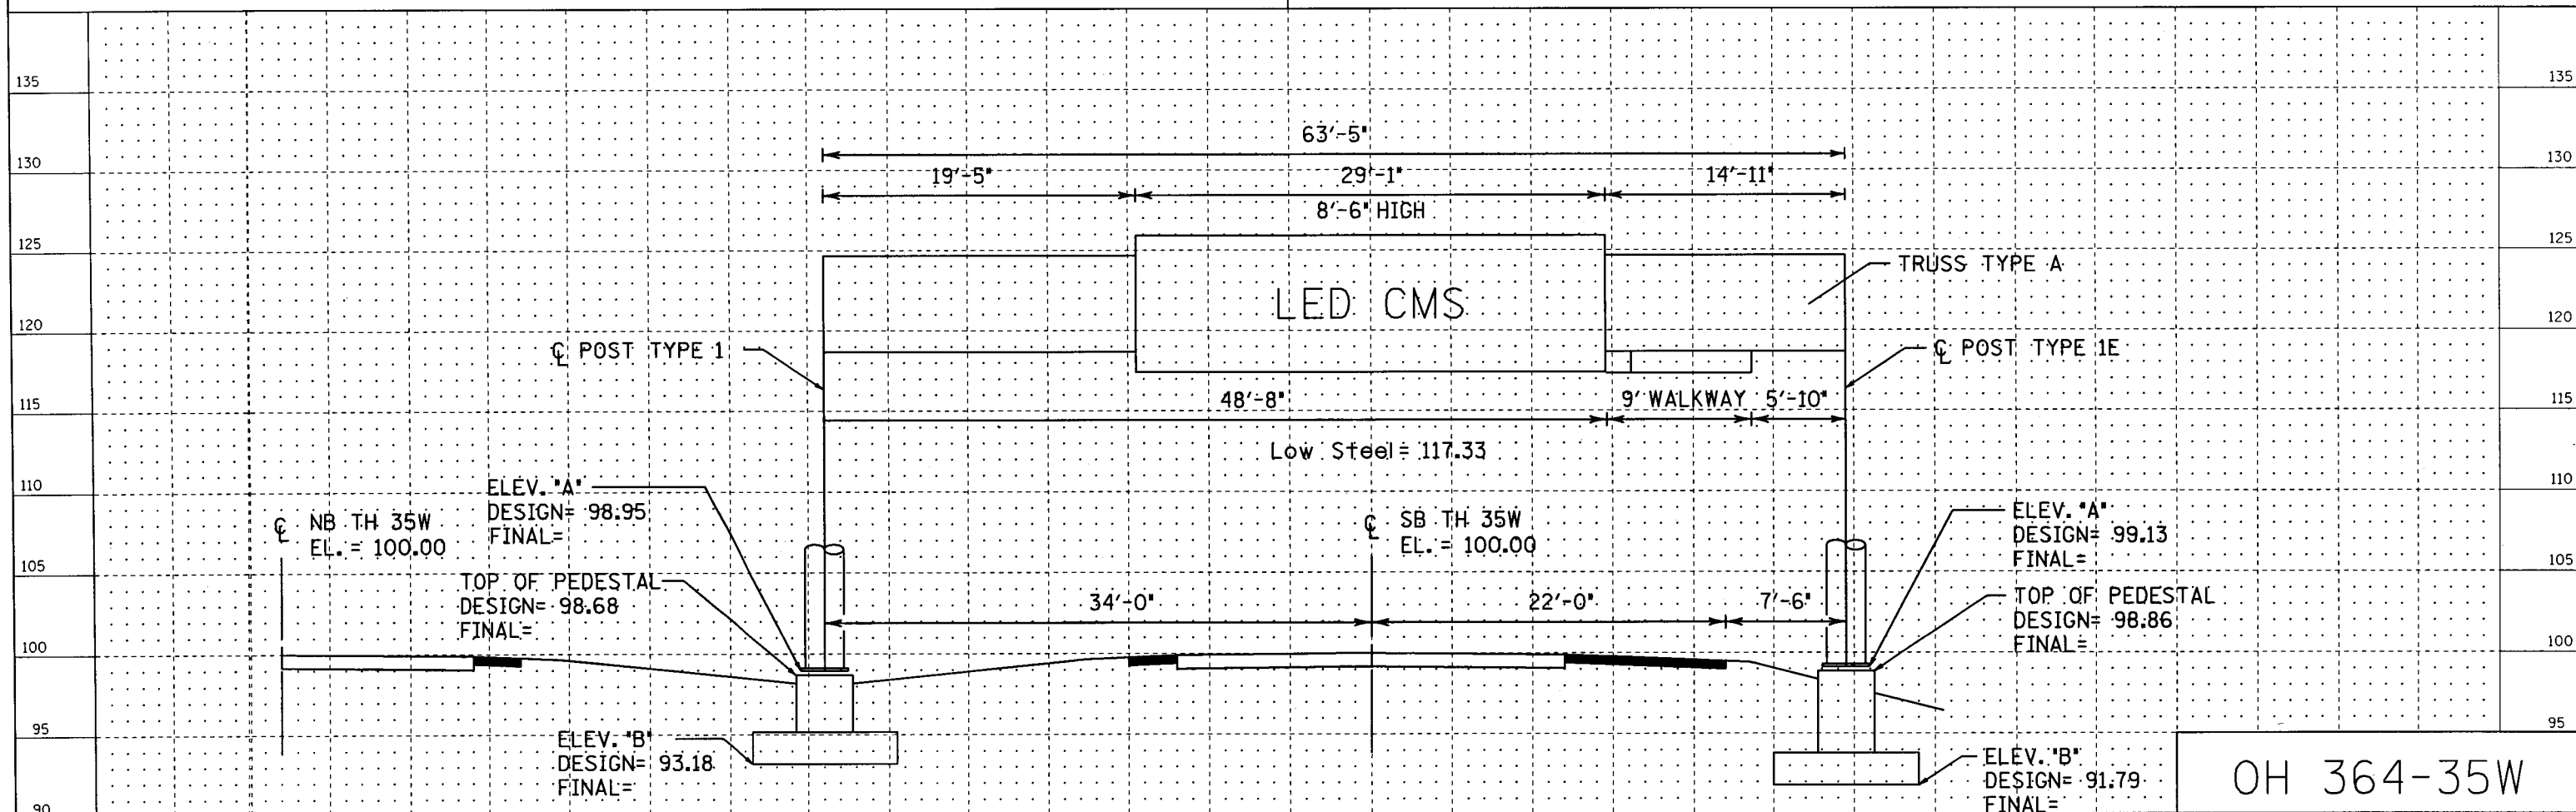


OH 364-35W

CERTIFIED BY *Michael B. Weis* LIC. NO. 10502  
LICENSED PROFESSIONAL ENGINEER


State Proj. No. 6284-137

Sheet No. TM26 of TM26 Sheets

216-06

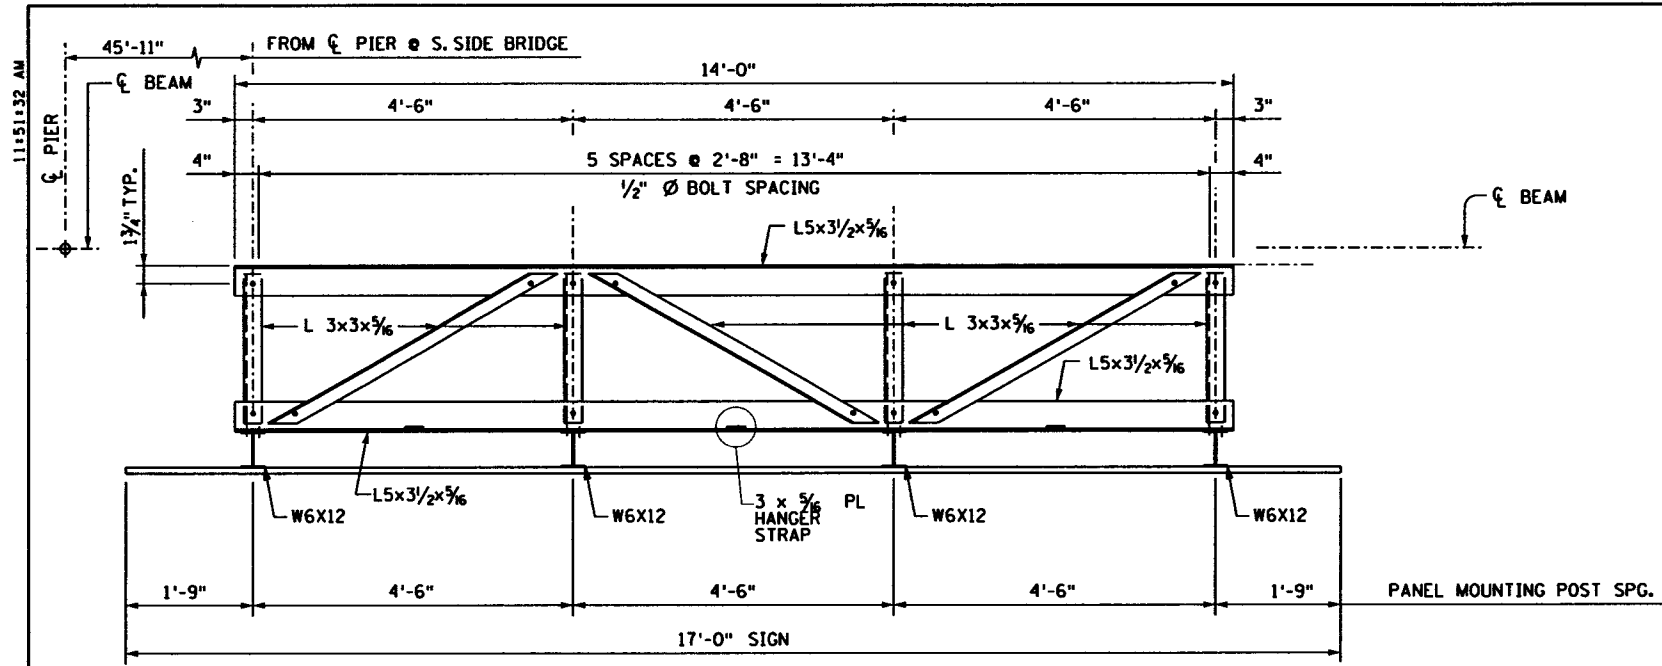


PLAN VIEW

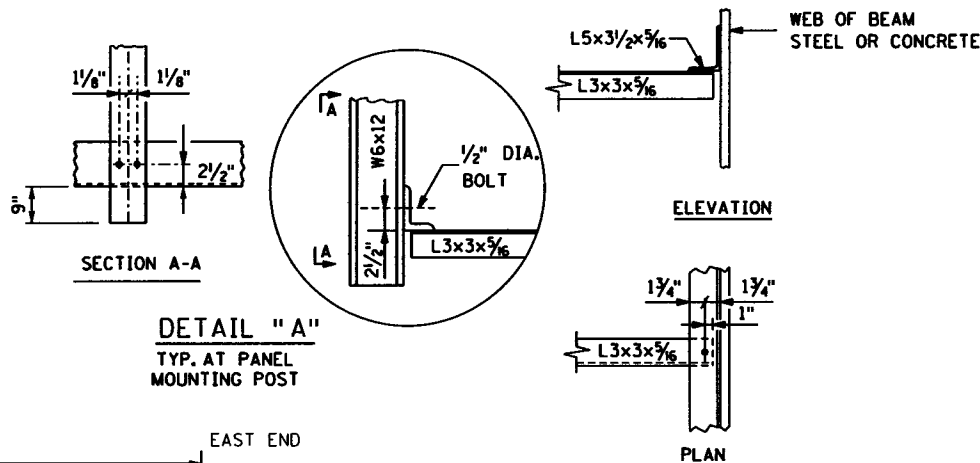


DETAIL "A"  
TYP. AT PANEL MOUNTING POST


DETAIL "B"

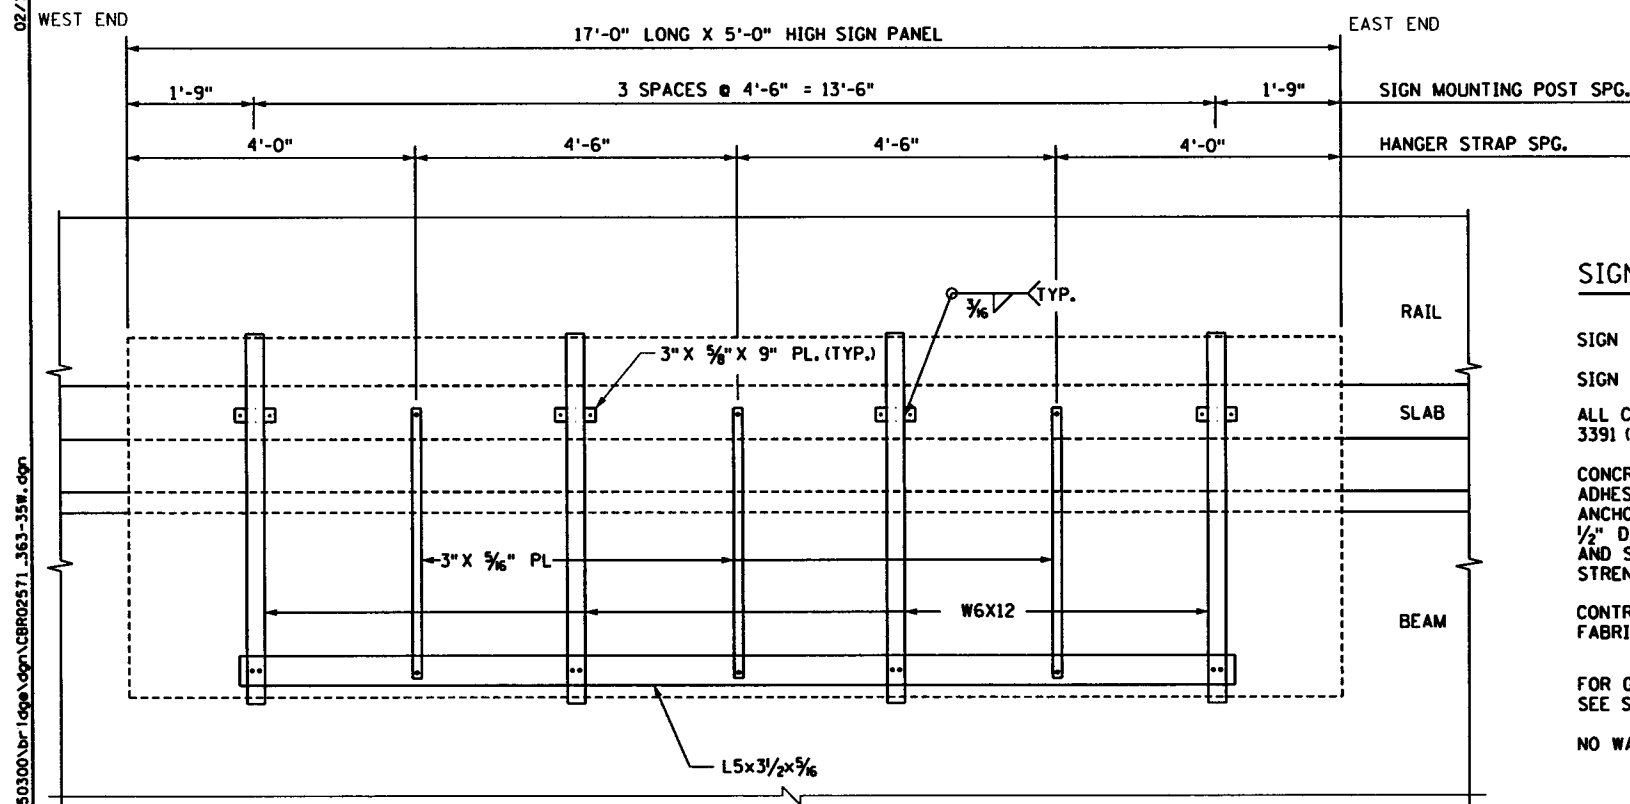

ELEVATION  
LOOKING NORTH @ BR. 02571

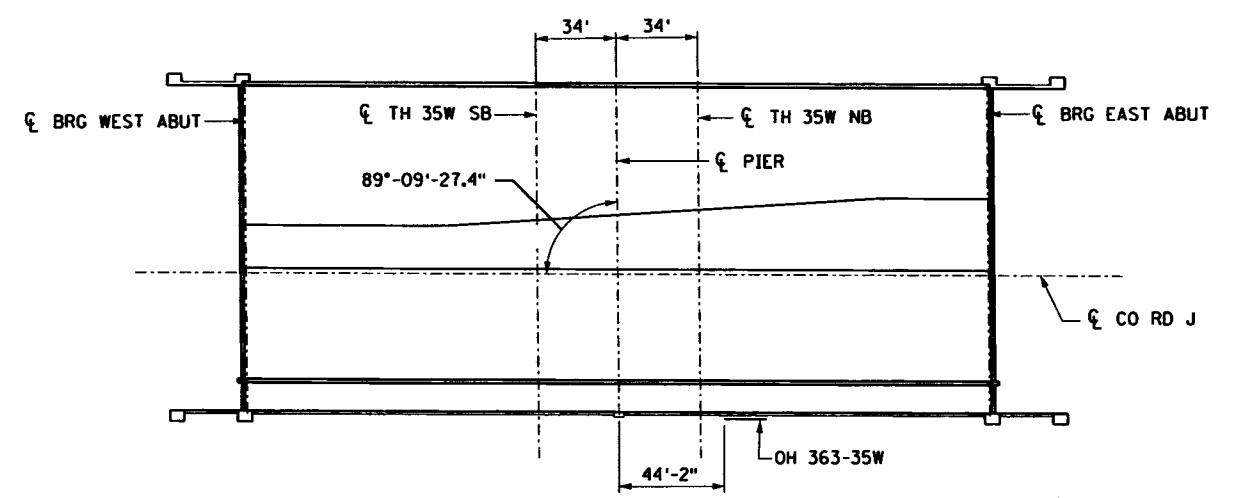

SIGN LOCATION OH 363-35W  
BR 02571 - TH 35 UNDER CO RD J  
IN ANOKA & RAMSEY COUNTY

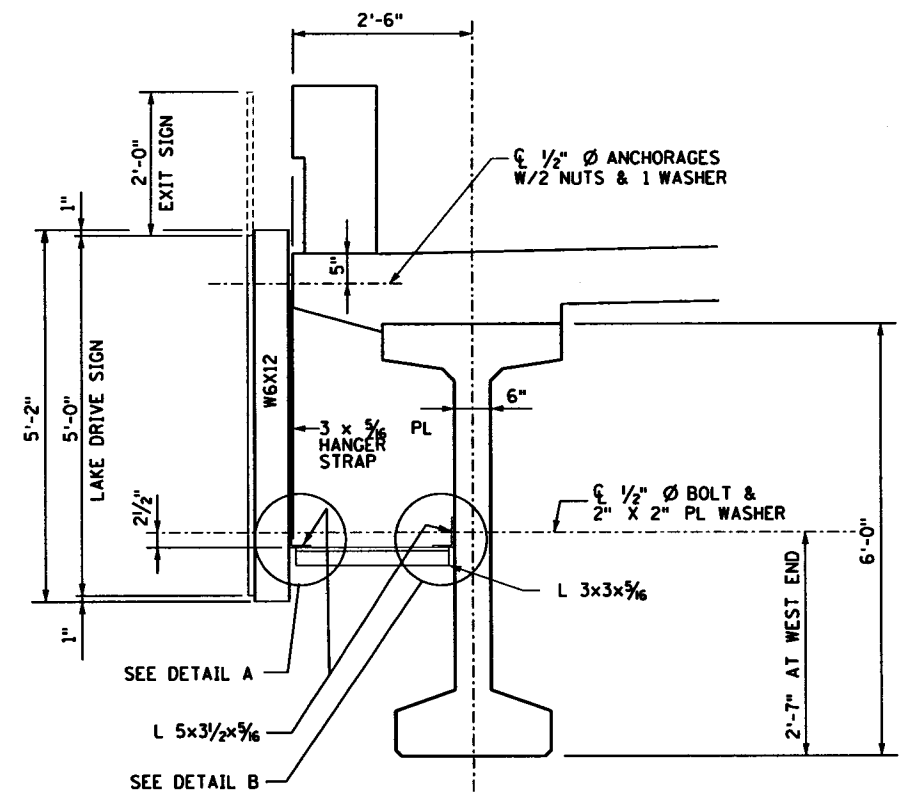


TYPICAL SECTION

SIGN NOTES

- SIGN SUPPORTS TO BE VERTICAL.
- SIGN TO BE PLACED IN A HORIZONTAL POSITION.
- ALL CONNECTIONS TO BE 1/2" DIA. BOLTS PER MN/DOT 3391 (A325), HOLES TO BE 5/16" DIA. EXCEPT AS NOTED.
- CONCRETE ANCHORAGES SHALL BE CHEMICAL ADHESIVE TYPE AS APPROVED BY THE ENGINEER. ANCHOR RODS, PER 3385 TYPE A, SHALL BE 1/2" DIA. WITH A MIN. EMBEDMENT DEPTH OF 4 1/2", AND SHALL HAVE A MIN. ULTIMATE PULL-OUT STRENGTH OF 8000#.
- CONTRACTOR SHALL VERIFY DIMENSIONS BEFORE FABRICATION.
- FOR GENERAL NOTES AND DETAILS NOT SHOWN SEE STANDARD SHEETS.
- NO WALKWAY REQUIRED.

TRUSS QUANTITY  
POUNDS 690

02/15/2006  
X:\PT\Remes\050300\br\cgr\dgn\CBR02571\_363-35W.dgn

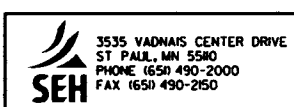

I hereby certify that this plan, specification, or report was prepared by me or under my direct supervision and that I am a duly Licensed Professional Engineer under the laws of the State of Minnesota.  
Signature: *John D. Steenberg* Date: 2-15-2006  
Printed Name: JOHN D. STEENERG Reg. No. 13865

TITLE:  
OVERHEAD SIGN DETAILS  
OH 363-35W

SP 6284-137 (TH35W=394)		DES: MAW	DR: MAW	APPROVED: 2-16-06	BRIDGE NO 02571
CHK: JDS	CHK: JDS	SHEET NO OH1 OF 1 SHEETS			