

MUNICIPALITY OF
ST. PAUL

ISSUED BY THE
MINNESOTA DEPARTMENT OF HIGHWAYS
IN COOPERATION WITH THE
U.S. DEPARTMENT OF TRANSPORTATION
FEDERAL HIGHWAY ADMINISTRATION
BUREAU OF PUBLIC ROADS
DATA OBTAINED AND MAP PREPARED BY THE
PLANNING AND PROGRAMMING DIVISION
OFFICE OF
TRANSPORTATION PLANNING

1968
BASIC DATA 1967







- ROAD SYSTEM DESIGNATIONS**
- INTERSTATE TRUNK HIGHWAY
 - U.S. NUMBERED TRUNK HIGHWAY
 - STATE NUMBERED TRUNK HIGHWAY
 - COUNTY STATE AID HIGHWAY
 - COUNTY ROAD
 - COUNTY STATE AID HIGHWAY IN ADJOINING COUNTY
 - COUNTY ROAD IN ADJOINING COUNTY

MUNICIPAL STATE AID STREET SYSTEM

LEGEND



- CORPORATE LIMITS
- COUNTY STATE AID HIGHWAY
- MUNICIPAL STATE AID STREET
- MUNICIPAL COUNTY STATE AID STREET
- COUNTY ROAD
- TRUNK HIGHWAY

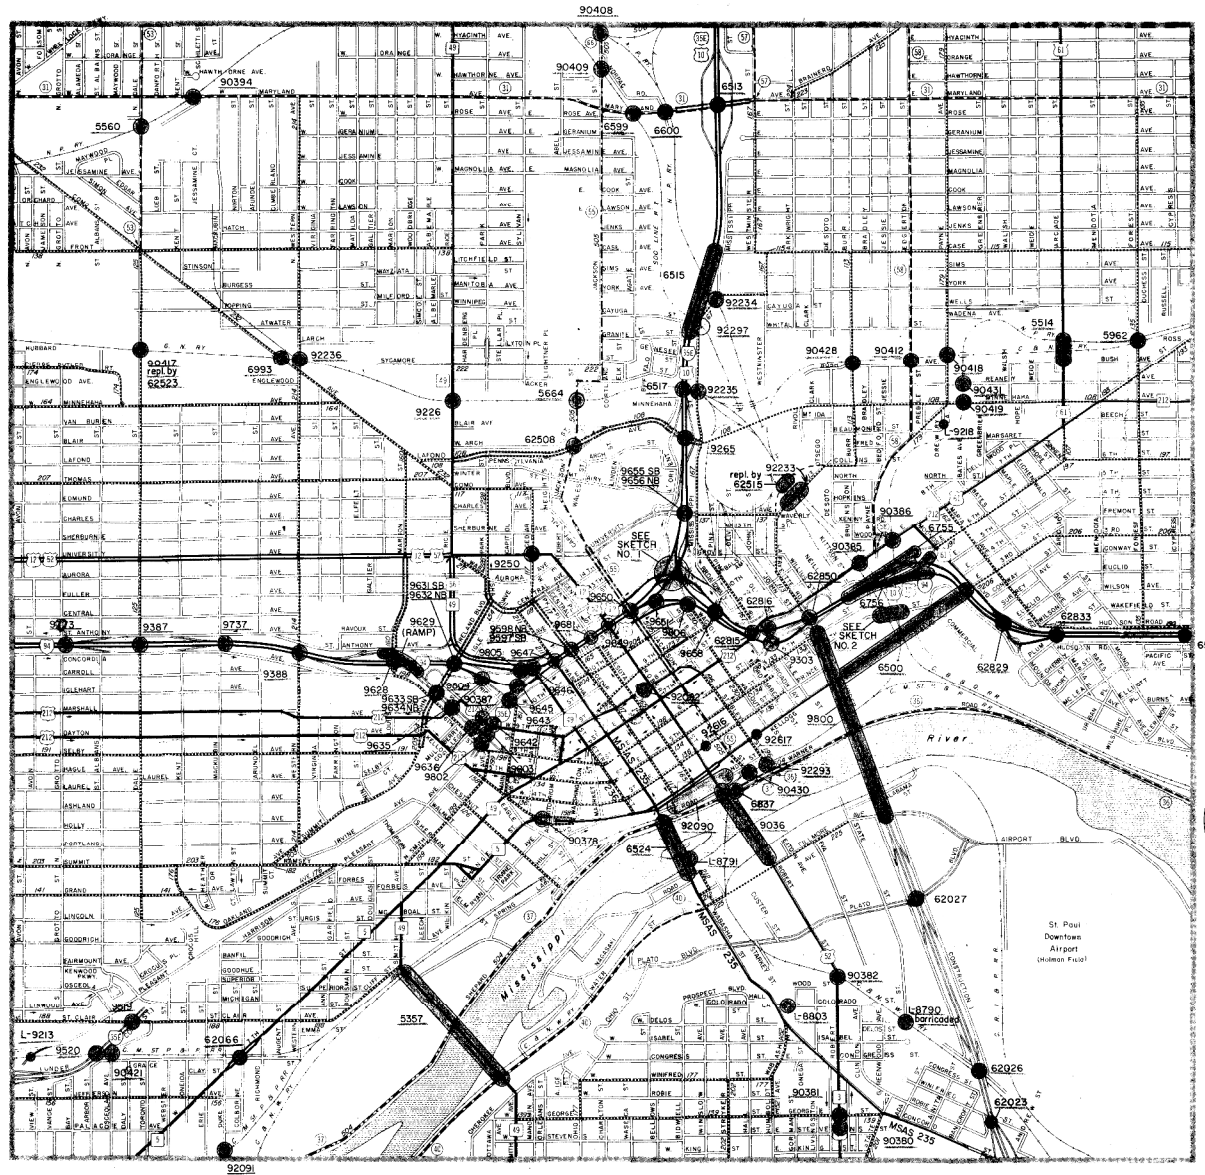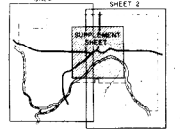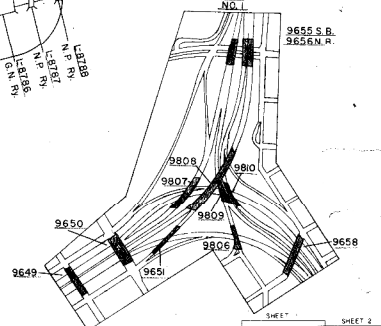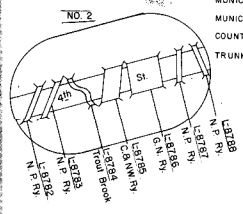

MUNICIPALITY OF
ST. PAUL

ISSUED BY THE
MINNESOTA DEPARTMENT OF HIGHWAYS
IN COOPERATION WITH THE
U. S. DEPARTMENT OF TRANSPORTATION
FEDERAL HIGHWAY ADMINISTRATION
BUREAU OF PUBLIC ROADS
PLANNING AND PROGRAMMING DIVISION
OFFICE OF
TRANSPORTATION PLANNING

 1968
BASE DATA
1967

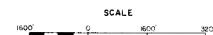



- ROAD SYSTEM DESIGNATIONS**
- INTERSTATE TRUNK HIGHWAY
 - U.S. NUMBERED TRUNK HIGHWAY
 - STATE NUMBERED TRUNK HIGHWAY
 - COUNTY STATE AID HIGHWAY
 - COUNTY ROAD
 - COUNTY STATE AID HIGHWAY IN ADJOINING COUNTY
 - COUNTY ROAD IN ADJOINING COUNTY

**MUNICIPAL STATE AID
STREET SYSTEM**


LEGEND

- CORPORATE LIMITS
- COUNTY STATE AID HIGHWAY
- MUNICIPAL STATE AID STREET
- MUNICIPAL COUNTY STATE AID STREET
- COUNTY ROAD
- TRUNK HIGHWAY

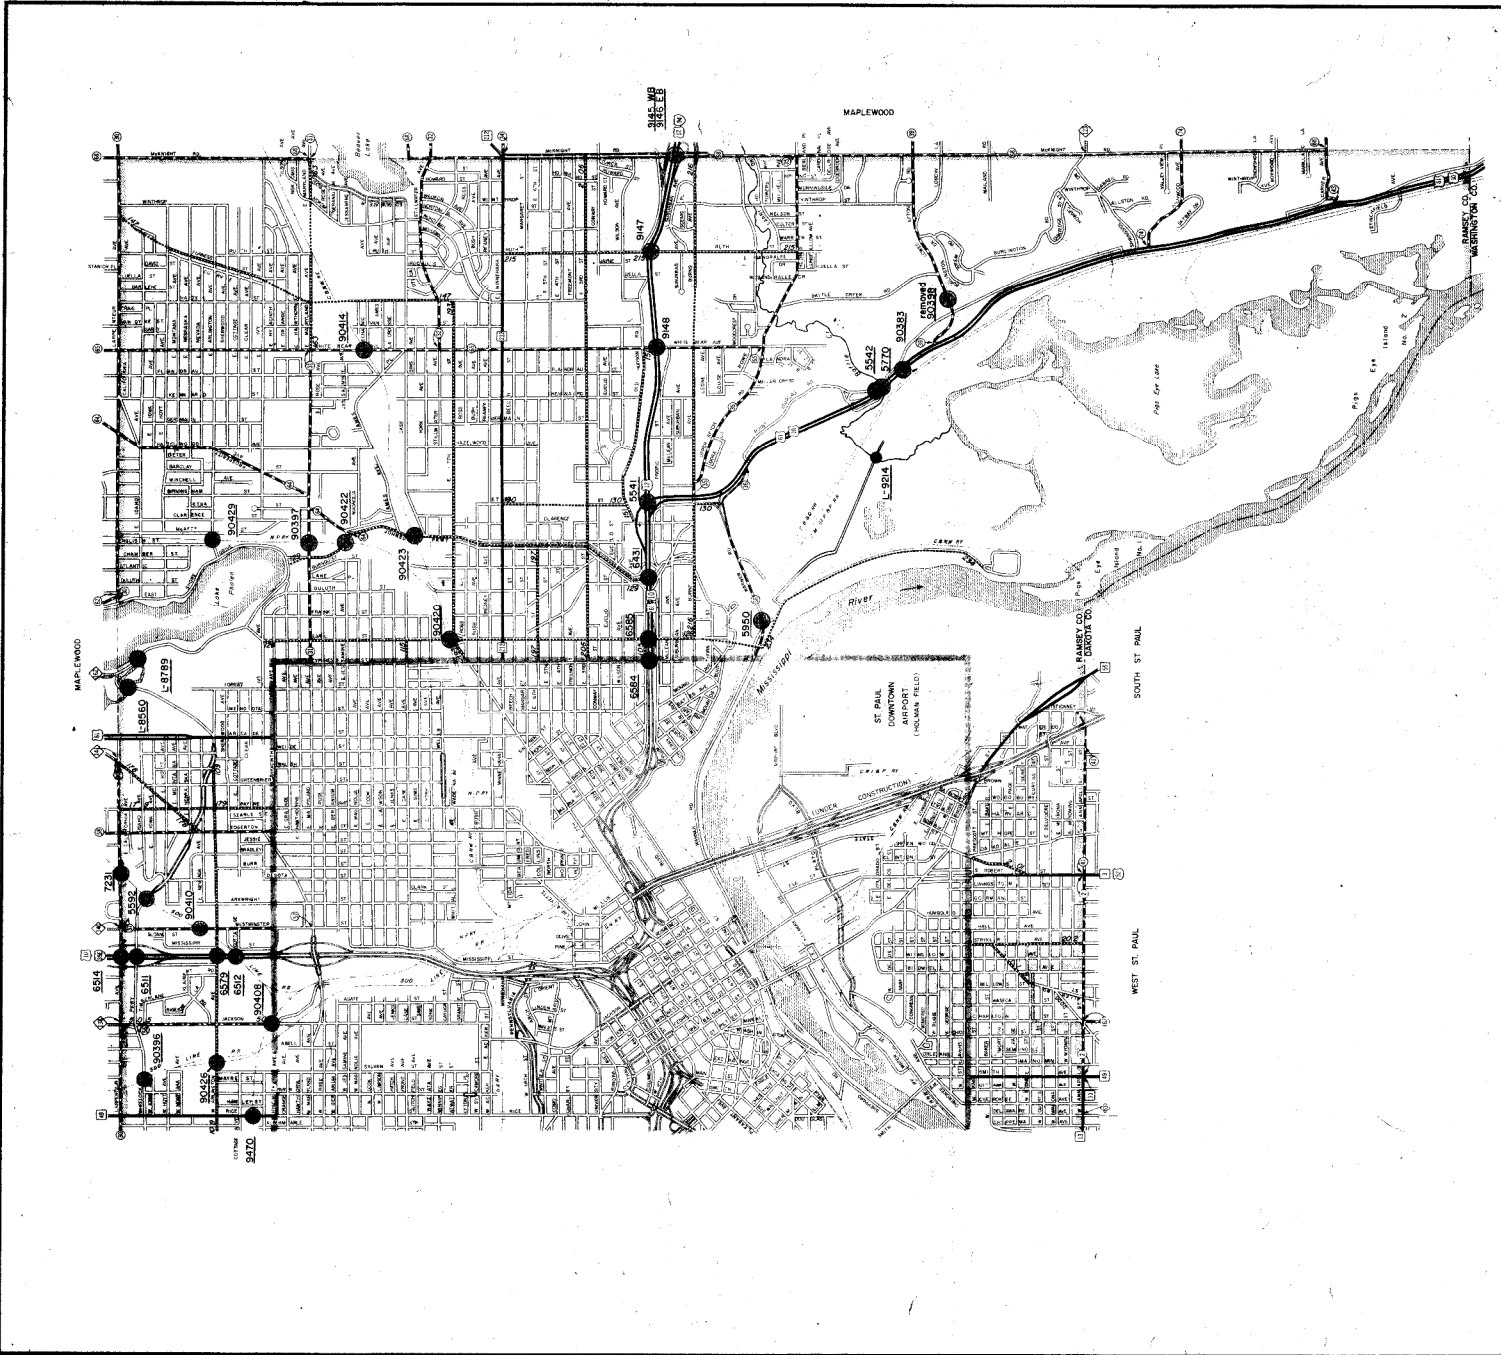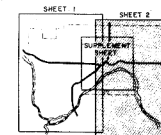

ISSUED BY THE
MINNESOTA DEPARTMENT OF HIGHWAYS
IN COOPERATION WITH THE
U.S. DEPARTMENT OF TRANSPORTATION
FEDERAL HIGHWAY ADMINISTRATION
BUREAU OF PUBLIC ROADS
DATA OBTAINED AND MAP PREPARED BY THE
PLANNING AND PROGRAMMING OFFICE OF
TRANSPORTATION PLANNING

1968
BASIC DATA
1967

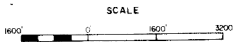


- ROAD SYSTEM DESIGNATIONS
- INTERSTATE TRUNK HIGHWAY
 - U.S. NUMBERED TRUNK HIGHWAY
 - STATE NUMBERED TRUNK HIGHWAY
 - COUNTY STATE AID HIGHWAY
 - COUNTY ROAD
 - COUNTY STATE AID HIGHWAY IN ADJOINING COUNTY
 - COUNTY ROAD IN ADJOINING COUNTY

MUNICIPAL STATE STREET SYSTEM

LEGEND

- CORPORATE LIMITS
- COUNTY STATE AID HIGHWAY
- MUNICIPAL STATE AID STREET
- MUNICIPAL COUNTY STATE AID STREET
- COUNTY ROAD
- TRUNK HIGHWAY

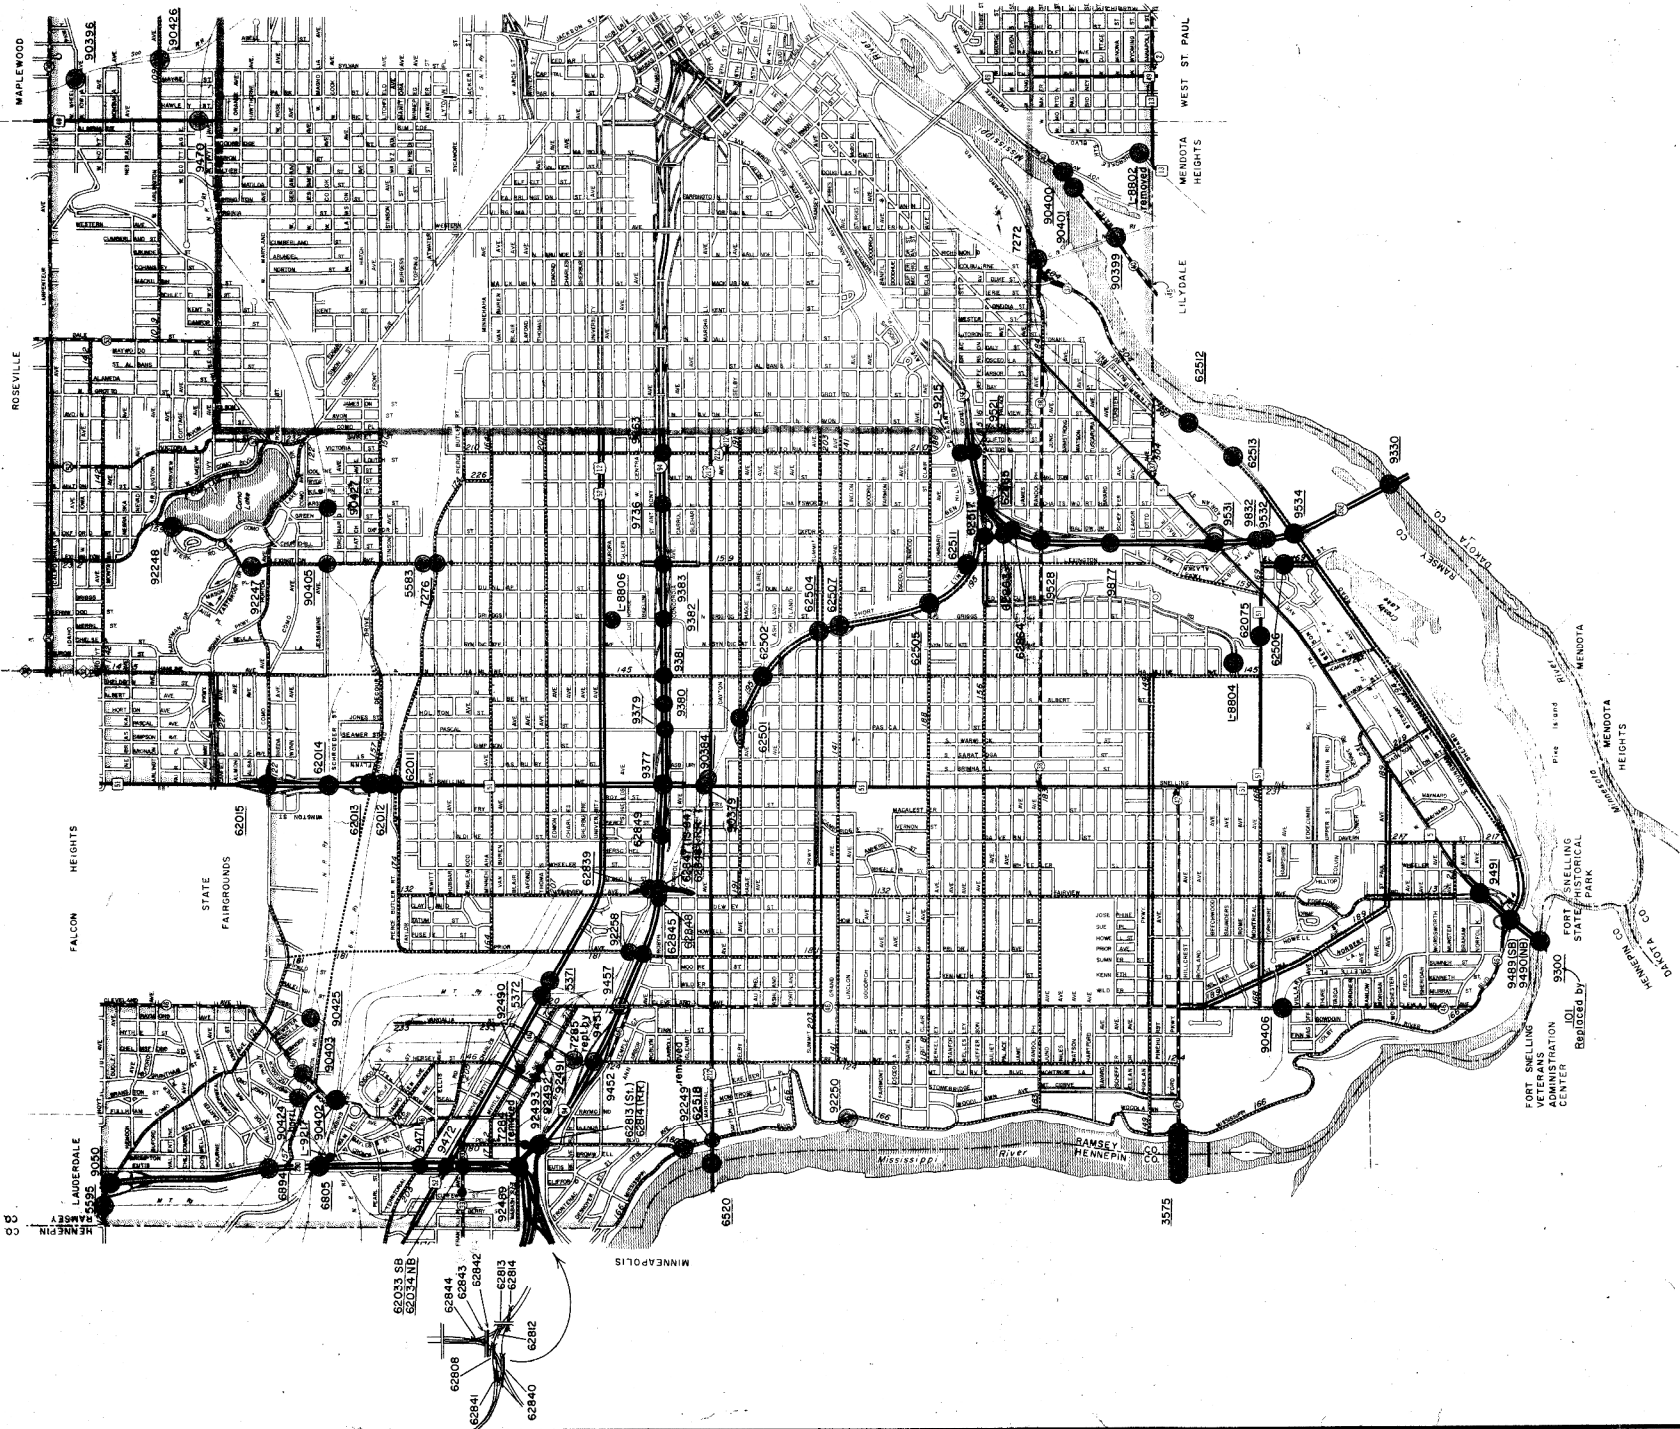

80

