





<p>GENERAL NOTES</p> <p>CONCRETE ALL CONCRETE SHALL CONFORM TO MN/DOT SPECIFICATION 2N61. ALL FOOTING CONCRETE SHALL BE 1A#3, ALL CONCRETE FOR C.I.P. CONCRETE PILES SHALL BE 1C62, ALL OTHER CONCRETE SHALL BE 3Y#3. THE EDGES OF CONCRETE ON ALL EXPOSED CONSTRUCTION SHALL BE FINISHED WITH A 3/4" CHAMFER UNLESS OTHERWISE NOTED. SEE SPECIAL PROVISIONS FOR RUSTICATION AND SPECIAL SURFACE FINISH.</p> <p>REINFORCEMENT BARS ALL REINFORCING BARS SHALL BE OF DEFORMED BILLET STEEL CONFORMING TO MN/DOT 3301. THE FIRST DIGIT OF A THREE-DIGIT BAR MARK, AND THE FIRST TWO DIGITS OF A FOUR-DIGIT BAR MARK, INDICATE THE BAR SIZE. ALL BENT BAR DIMENSIONS ARE GIVEN OUT-TO-OUT. ALL BARS OF A SERIES SHALL VARY BY A CONSTANT INCREMENT. THE SHORTEST AND THE LONGEST BAR LENGTHS OF A SERIES GROUP ARE TABULATED IN THE BAR LIST. REINFORCEMENT BARS SHALL BE SHIPPED TO THE JOB SITE IN BUNDLES WHICH ARE CLEARLY IDENTIFIED BY THE SPECIFIC LOCATION OF THE BARS, E.G., SOUTH ABUT., NORTH ABUT., ETC. BARS MARKED WITH THE SUFFIX "E" SHALL BE EPOXY COATED. THE CLEAR DISTANCE BETWEEN REINFORCEMENT BARS AND FACE OF CONCRETE SHALL BE 3" IN FOOTINGS, 2-3/4" AT THE FRONT FACE OF RUSTICATED WINGWALLS, AND 2" ELSEWHERE UNLESS OTHERWISE NOTED.</p> <p>STRUCTURAL STEEL DESIGN AND WORKMANSHIP SHALL CONFORM TO CURRENT A.R.E.A. SPECIFICATIONS FOR STEEL RAILWAY BRIDGES, EXCEPT AS MAY BE MODIFIED BY NOTES BELOW. ALL STRUCTURAL STEEL SHALL CONFORM TO MN/DOT 3309 EXCEPT FOR FLASHING, ANCHORAGES, EXPANSION DEVICES AND ITEMS NOTED OTHERWISE WHICH SHALL CONFORM TO MN/DOT 3306. PATTERN PLATE FOR WALKWAYS SHALL BE STRUCTURAL STEEL (3306) AND SHALL BE GALVANIZED IN ACCORDANCE WITH MN/DOT 3394. WEB PLATES SHALL BE FURNISHED IN AVAILABLE MILL LENGTHS WITH A MINIMUM NUMBER OF WEB SPLICES. THE LOCATION OF SPLICES SHALL BE SUBJECT TO THE APPROVAL OF THE ENGINEER, AND SHALL BE A MINIMUM OF 1'-0" FROM STIFFENERS AND 3'-0" FROM FLANGE SPLICES. STIFFENERS, FLOOR BEAMS AND GIRDER ENDS SHALL BE PERPENDICULAR TO GRADE. WELDING SHALL CONFORM TO THE LATEST A.W.S. STRUCTURAL WELDING CODE. ALL WELD METAL MUST BE EQUIVALENT TO BASE METAL IN STRENGTH, CORROSION RESISTANCE AND PAINTABILITY. ALL SHOP AND FIELD CONNECTIONS SHALL BE BOLTED USING 7/8" DIAMETER HIGH STRENGTH BOLTS CONFORMING TO ASTM A325 (TYPE 3) UNLESS OTHERWISE NOTED. BOLTS SHALL BE HEAVY SEMI-FINISHED STRUCTURAL BOLTS WITH HEAVY HEX NUT AND ONE HARDENED WASHER UNDER THE TURNED ELEMENT. HOLES FOR 7/8" DIAMETER H.S. BOLTS SHALL BE 15/16" DIAMETER UNLESS OTHERWISE NOTED. CAMBER DIAGRAM SHOWN IS FOR GIRDERS IN UNLOADED POSITION AND PROVIDES FOR ALL DEAD LOAD DEFLECTIONS INCLUDING TRACK AND BALLAST. SOLE PLATES AT BEARINGS TO BE INCLUDED IN WEIGHT OF STRUCTURAL STEEL MN/DOT 3309. WEB-TO-FLANGE WELDS AND BUTT-WELDED SPLICES FOR FLANGE AND WEB PLATES SHALL BE MADE BY THE SUBMERGED ARC AUTOMATIC WELDING PROCESS. ALL BUTT SPLICES SHALL BE FULL PENETRATION BUTT WELDS USING LOW HYDROGEN PROCESS AND SHALL BE GROUND FLUSH IN THE DIRECTION OF STRESS ON 4 SIDES. COPIES OF WELD TESTS SHALL BE SUBMITTED TO THE ENGINEER. ZINC RICH PAINT SYSTEM COLOR SHALL BE BROWN. SEE SPECIAL PROVISIONS. WEB, BOTTOM FLANGE, AND PORTIONS OF THE TOP FLANGE (AS NOTED ON THE PLANS) OF MAIN GIRDERS ARE "FRACTURE CRITICAL MEMBERS" AND ARE DESIGNATED ON THE PLANS BY THE NOTATION "FCM". THESE MEMBERS SHALL BE FABRICATED, TESTED AND INSPECTED IN ACCORDANCE WITH "FRACTURE CONTROL PLAN FOR FRACTURE CRITICAL MEMBERS." FROM THE CURRENT A.R.E.A. MANUAL FOR RAILWAY ENGINEERING.</p> <p>FULL ASSEMBLY REAMING WILL BE REQUIRED PER MN/DOT 2471.3E1F.</p>	<p>WATERPROOFING AND DAMPROOFING JOINT WATERPROOFING SHALL COMPLY WITH MN/DOT 2481. PLACE JOINT WATERPROOFING ON BACK OF ABUTMENT JOINTS AT AND ABOVE THE TOP OF FOOTING. THE BACK SURFACE OF ABUTMENTS AND WINGWALLS SHALL BE DAMPROOFED AS DESCRIBED IN THE SPECIAL PROVISIONS. SEE SH. 26 FOR UPPER LIMITS OF DAMPROOFING. THE SURFACE OF THE SUPERSTRUCTURE BALLAST PLATE AND SIDE RETAINER PLATES SHALL RECEIVE A WATERPROOF MEMBRANE AND PROTECTIVE COVER AS SHOWN ON SHEET 27 AND DESCRIBED IN THE SPECIAL PROVISIONS.</p> <p>DRAINAGE SYSTEM THE PRICE BID FOR THE DRAINAGE SYSTEM SHALL BE FOR THE COMPLETE SYSTEM FURNISHED AND INSTALLED. BOTTOM PLATES AND COVERS SHALL BE GALVANIZED ONLY. COLLARS, REDUCERS, DRAIN PIPES AND ALL CONNECTIONS TO BE GALVANIZED AND BITUMINOUS COATED AS DESCRIBED IN THE SPECIAL PROVISIONS.</p> <p>SUPERSTRUCTURE BRIDGE SEAT REINFORCEMENT SHALL BE CAREFULLY PLACED TO AVOID INTERFERENCE WITH DRILLING HOLES AND PLACING ANCHOR RODS. THE SUPERSTRUCTURE GIRDERS SHALL BE ERECTED IN FINAL POSITION PRIOR TO DRILLING HOLES FOR ANCHOR ROD PLACEMENT. QUANTITY SUMMARY FOR THE ABUTMENTS IS ON SHEET 13. QUANTITY SUMMARY FOR THE PIER IS ON SHEET 16.</p> <p>OPTIONAL FIELD SPLICE PAYMENT FOR STRUCTURAL STEEL WILL BE BASED ON WELDED SHOP FLANGE SPLICE.</p> <p>BEARING ASSEMBLIES THE POSITION OF THE EXPANSION BEARING ASSEMBLIES SHALL BE ADJUSTED SO THAT CENTERLINE OF THE ROCKER WEB WOULD BE VERTICAL AT 45°.</p> <p>LEGEND</p> <table style="margin-left: 20px; border-collapse: collapse;"> <tbody> <tr><td>(LLH)</td><td>DENOTES LONG LEG HORIZONTAL</td></tr> <tr><td>(SPS)</td><td>DENOTES SPACES</td></tr> <tr><td>(TYP)</td><td>DENOTES TYPICAL</td></tr> <tr><td>(EF)</td><td>DENOTES EACH FACE</td></tr> <tr><td>(FF)</td><td>DENOTES FAR FACE</td></tr> <tr><td>(NF)</td><td>DENOTES NEAR FACE</td></tr> <tr><td>(SER)</td><td>DENOTES SERIES</td></tr> <tr><td>(BMD)</td><td>DENOTES BEAM</td></tr> <tr><td>(CSC)</td><td>DENOTES COUNTERSUNK</td></tr> <tr><td>(EQ)</td><td>DENOTES EQUAL</td></tr> <tr><td>(OP)</td><td>DENOTES OPPOSITE HAND</td></tr> <tr><td>(WP)</td><td>DENOTES WORKING POINT</td></tr> <tr><td>(GIRD)</td><td>DENOTES GIRDER</td></tr> <tr><td>(T)</td><td>DENOTES TOP</td></tr> <tr><td>(B)</td><td>DENOTES BOTTOM</td></tr> </tbody> </table>	(LLH)	DENOTES LONG LEG HORIZONTAL	(SPS)	DENOTES SPACES	(TYP)	DENOTES TYPICAL	(EF)	DENOTES EACH FACE	(FF)	DENOTES FAR FACE	(NF)	DENOTES NEAR FACE	(SER)	DENOTES SERIES	(BMD)	DENOTES BEAM	(CSC)	DENOTES COUNTERSUNK	(EQ)	DENOTES EQUAL	(OP)	DENOTES OPPOSITE HAND	(WP)	DENOTES WORKING POINT	(GIRD)	DENOTES GIRDER	(T)	DENOTES TOP	(B)	DENOTES BOTTOM	<p>SUGGESTED CONSTRUCTION SEQUENCE</p> <table style="width: 100%; border-collapse: collapse;"> <thead> <tr> <th style="text-align: center;">STEP</th> <th style="text-align: center;">ITEM</th> <th style="text-align: center;">RESPONSIBILITY</th> </tr> </thead> <tbody> <tr><td style="text-align: center;">1</td><td>GRADING FOR TRACK REALIGNMENT</td><td>CONTRACTOR</td></tr> <tr><td style="text-align: center;">2</td><td>TRACK REALIGNMENT AT NORTH ABUTMENT</td><td>RAILROAD CO.</td></tr> <tr><td style="text-align: center;">3</td><td>INSTALL SHEET PILE PROTECTION FOR TRACK AND EXISTING BRIDGE</td><td>CONTRACTOR</td></tr> <tr><td style="text-align: center;">4</td><td>REMOVE PORTION OF EAST WINGWALL OF EXISTING NORTH ABUTMENT TO ALLOW EXCAVATION FOR NEW ABUTMENT</td><td>CONTRACTOR</td></tr> <tr><td style="text-align: center;">5</td><td>EXCAVATION FOR NEW ABUTMENTS EXCEPT FOR NORTHWEST WINGWALL</td><td>CONTRACTOR</td></tr> <tr><td style="text-align: center;">6</td><td>DRIVING OF PILES AND CONSTRUCTION OF NEW ABUTMENTS AND WINGWALLS</td><td>CONTRACTOR</td></tr> <tr><td style="text-align: center;">7</td><td>RICE STREET CLOSING</td><td>CONTRACTOR</td></tr> <tr><td style="text-align: center;">8</td><td>EXCAVATION FOR PIER</td><td>CONTRACTOR</td></tr> <tr><td style="text-align: center;">9</td><td>DRIVING OF PILES AND CONSTRUCTION OF NEW PIER</td><td>CONTRACTOR</td></tr> <tr><td style="text-align: center;">10</td><td>ERCTION OF BRIDGE SUPERSTRUCTURE AND INSTALLATION OF MEMBRANE WATERPROOFING</td><td>CONTRACTOR</td></tr> <tr><td style="text-align: center;">11</td><td>CONSTRUCT EMBANKMENT FOR NEW TRACK</td><td>CONTRACTOR</td></tr> <tr><td style="text-align: center;">12</td><td>INSTALLATION OF BALLAST, TIES AND TRACK, TIE INTO EXISTING TRACK AND OPEN NEW BRIDGE TO TRAFFIC</td><td>RAILROAD CO.</td></tr> <tr><td style="text-align: center;">13</td><td>REMOVE TEMPORARY TRACK AND ABANDONED EXISTING TRACK</td><td>RAILROAD CO.</td></tr> <tr><td style="text-align: center;">14</td><td>DEMOLISH EXISTING STRUCTURE</td><td>CONTRACTOR</td></tr> <tr><td style="text-align: center;">15</td><td>COMPLETE PROJECT, RAILINGS, SIGNS, EARTHWORK, ETC.</td><td>CONTRACTOR</td></tr> </tbody> </table> <p>PREFORMED JOINT FILLER LIST</p> <table style="width: 100%; border-collapse: collapse;"> <thead> <tr> <th style="text-align: center;">TYPE</th> <th style="text-align: center;">NO.</th> <th style="text-align: center;">SIZE</th> <th style="text-align: center;">LOCATION</th> </tr> </thead> <tbody> <tr><td>BIT. FELT</td><td>2</td><td>10' x 9' x 15"</td><td>WALKPLATE AT ABUTMENTS (2 FROM 1)</td></tr> <tr><td>BIT. FELT</td><td>2</td><td>10' x 9' x 15"</td><td>WALKPLATE AT ABUTMENTS (2 FROM 1)</td></tr> <tr><td>CORK</td><td>1</td><td>1' x 6' x 25'-0"</td><td>E. WINGWALL, N. ABUT. (2 FROM 1)</td></tr> <tr><td>CORK</td><td>1</td><td>1' x 6' x 19'-6"</td><td>E. WINGWALL, N. ABUT. (2 FROM 1)</td></tr> <tr><td>CORK</td><td>1</td><td>1' x 6' x 22'-4"</td><td>N. WINGWALL, S. ABUT. (2 FROM 1)</td></tr> <tr><td>CORK</td><td>1</td><td>1' x 6' x 12'-6"</td><td>N. & S. WINGWALL (2 FROM 1)</td></tr> <tr><td>POLYETHYLENE FOAM</td><td>1</td><td>1/2" O.D. x 60'-0"</td><td>FIBER JOINT IN BALLAST PLATE</td></tr> </tbody> </table>	STEP	ITEM	RESPONSIBILITY	1	GRADING FOR TRACK REALIGNMENT	CONTRACTOR	2	TRACK REALIGNMENT AT NORTH ABUTMENT	RAILROAD CO.	3	INSTALL SHEET PILE PROTECTION FOR TRACK AND EXISTING BRIDGE	CONTRACTOR	4	REMOVE PORTION OF EAST WINGWALL OF EXISTING NORTH ABUTMENT TO ALLOW EXCAVATION FOR NEW ABUTMENT	CONTRACTOR	5	EXCAVATION FOR NEW ABUTMENTS EXCEPT FOR NORTHWEST WINGWALL	CONTRACTOR	6	DRIVING OF PILES AND CONSTRUCTION OF NEW ABUTMENTS AND WINGWALLS	CONTRACTOR	7	RICE STREET CLOSING	CONTRACTOR	8	EXCAVATION FOR PIER	CONTRACTOR	9	DRIVING OF PILES AND CONSTRUCTION OF NEW PIER	CONTRACTOR	10	ERCTION OF BRIDGE SUPERSTRUCTURE AND INSTALLATION OF MEMBRANE WATERPROOFING	CONTRACTOR	11	CONSTRUCT EMBANKMENT FOR NEW TRACK	CONTRACTOR	12	INSTALLATION OF BALLAST, TIES AND TRACK, TIE INTO EXISTING TRACK AND OPEN NEW BRIDGE TO TRAFFIC	RAILROAD CO.	13	REMOVE TEMPORARY TRACK AND ABANDONED EXISTING TRACK	RAILROAD CO.	14	DEMOLISH EXISTING STRUCTURE	CONTRACTOR	15	COMPLETE PROJECT, RAILINGS, SIGNS, EARTHWORK, ETC.	CONTRACTOR	TYPE	NO.	SIZE	LOCATION	BIT. FELT	2	10' x 9' x 15"	WALKPLATE AT ABUTMENTS (2 FROM 1)	BIT. FELT	2	10' x 9' x 15"	WALKPLATE AT ABUTMENTS (2 FROM 1)	CORK	1	1' x 6' x 25'-0"	E. WINGWALL, N. ABUT. (2 FROM 1)	CORK	1	1' x 6' x 19'-6"	E. WINGWALL, N. ABUT. (2 FROM 1)	CORK	1	1' x 6' x 22'-4"	N. WINGWALL, S. ABUT. (2 FROM 1)	CORK	1	1' x 6' x 12'-6"	N. & S. WINGWALL (2 FROM 1)	POLYETHYLENE FOAM	1	1/2" O.D. x 60'-0"	FIBER JOINT IN BALLAST PLATE	<p>STRESS TABLE</p> <p>DESIGN DATA FOR GIRDERS</p> <table style="width: 100%; border-collapse: collapse;"> <tr><td>LIVE LOAD: COOPERS E-80 WITH DIESEL IMPACT</td><td></td></tr> <tr><td>ASSUMED DEAD LOAD PER LINEAR FOOT OF GIRDER</td><td></td></tr> <tr><td>TRACK AND BALLAST</td><td>1196 LBS./FT.</td></tr> <tr><td>FLOOR</td><td>1410 LBS./FT.</td></tr> <tr><td>GIRDER</td><td>779 LBS./FT.</td></tr> <tr><td>TOTAL DEAD LOAD</td><td>3565 LBS./FT.</td></tr> </table> <p>PROPERTIES OF GIRDERS</p> <table style="width: 100%; border-collapse: collapse;"> <thead> <tr> <th style="text-align: left;">GROSS SECTION</th> <th style="text-align: left;">NET SECTION</th> </tr> </thead> <tbody> <tr><td>A = 229.00 in² (1)</td><td>A = 202.00 in² (1)</td></tr> <tr><td>A = 211.00 in² (2)</td><td>A = 184.00 in² (2)</td></tr> <tr><td>A = 180.00 in² (2)</td><td>A = 103.00 in² (2)</td></tr> <tr><td>I = 58,004 in⁴ (1)</td><td>I = 58,007 in⁴ (1)</td></tr> <tr><td>Y_T = 67.25 IN (1)</td><td>Y_T = 67.25 IN (1)</td></tr> <tr><td>Y_B = 67.25 IN (1)</td><td>Y_B = 67.25 IN (1)</td></tr> <tr><td>S_T = 9180 in³ (1)</td><td>S_T = 8641 in³ (1)</td></tr> <tr><td>S_B = 9180 in³ (1)</td><td>S = 8641 in³ (1)</td></tr> </tbody> </table> <p style="text-align: center;">(1) AT MID SPAN (2) AT SUPPORT</p> <p>MAXIMUM FORCES FOR GIRDERS</p> <table style="width: 100%; border-collapse: collapse;"> <thead> <tr> <th></th> <th style="text-align: center;">MAX. SHEAR (KIPS)</th> <th style="text-align: center;">MAX. MOMENT (KIP FT.)</th> </tr> </thead> <tbody> <tr><td>DEAD LOAD</td><td>209.10</td><td>7172.78</td></tr> <tr><td>E-80 LIVE LOAD</td><td>295.30</td><td>9217.74</td></tr> <tr><td>IMPACT</td><td>69.10</td><td>2186.98</td></tr> <tr><td>TOTAL</td><td>573.50</td><td>16547.47</td></tr> </tbody> </table> <p>MAXIMUM STRESSES FOR GIRDERS</p> <table style="width: 100%; border-collapse: collapse;"> <thead> <tr> <th></th> <th style="text-align: center;">SHEAR MOMENT (FLB)</th> <th style="text-align: center;">MOMENT (FLB)</th> </tr> </thead> <tbody> <tr><td>DEAD LOAD</td><td>1.61</td><td>9.40</td></tr> <tr><td>LIVE LOAD+IMPACT</td><td>2.60</td><td>14.80</td></tr> <tr><td>TOTAL (K.S.L.)</td><td>4.41</td><td>24.30</td></tr> <tr><td></td><td>25.76</td><td></td></tr> </tbody> </table> <p>DEFLECTIONS</p> <p style="text-align: center;">A (D.L.) = 1.40" A (L.L.+I) = 2.17" (ALLOWABLE = 2.65")</p> <p>MAXIMUM FORCES FOR FLOOR BEAMS</p> <table style="width: 100%; border-collapse: collapse;"> <thead> <tr> <th></th> <th style="text-align: center;">MAX. SHEAR (KIPS)</th> <th style="text-align: center;">MAX. MOMENT (KIP FT.)</th> </tr> </thead> <tbody> <tr><td>DEAD LOAD</td><td>6.45</td><td>37.30</td></tr> <tr><td>E-80 LIVE LOAD</td><td>23.00</td><td>285.76</td></tr> <tr><td>IMPACT</td><td>9.03</td><td>104.45</td></tr> <tr><td>TOTAL</td><td>37.48</td><td>407.81</td></tr> </tbody> </table> <p>MAXIMUM STRESSES FOR FLOOR BEAMS</p> <table style="width: 100%; border-collapse: collapse;"> <thead> <tr> <th></th> <th style="text-align: center;">SHEAR (K.S.L.)</th> <th style="text-align: center;">MOMENT (K.S.L.)</th> </tr> </thead> <tbody> <tr><td>DEAD LOAD</td><td>0.54</td><td>1.57</td></tr> <tr><td>LIVE LOAD+IMPACT</td><td>3.19</td><td>15.53</td></tr> <tr><td>TOTAL</td><td>3.72</td><td>17.10</td></tr> </tbody> </table> <p>MAX. FORCES FOR END FLOOR BEAMS</p> <table style="width: 100%; border-collapse: collapse;"> <thead> <tr> <th></th> <th style="text-align: center;">MAX. SHEAR (KIPS)</th> <th style="text-align: center;">MAX. MOMENT (KIP FT.)</th> </tr> </thead> <tbody> <tr><td>DEAD LOAD</td><td>17.34</td><td>30.46</td></tr> <tr><td>E-80 LIVE LOAD</td><td>103.09</td><td>306.55</td></tr> <tr><td>IMPACT</td><td>40.62</td><td>121.57</td></tr> <tr><td>TOTAL</td><td>161.05</td><td>438.58</td></tr> </tbody> </table> <p>MAX. STRESSES FOR END FLOOR BEAMS</p> <table style="width: 100%; border-collapse: collapse;"> <thead> <tr> <th></th> <th style="text-align: center;">SHEAR (K.S.L.)</th> <th style="text-align: center;">MOMENT (K.S.L.)</th> </tr> </thead> <tbody> <tr><td>DEAD LOAD</td><td>1.26</td><td>0.80</td></tr> <tr><td>LIVE LOAD+IMPACT</td><td>10.58</td><td>11.34</td></tr> <tr><td>TOTAL</td><td>11.84</td><td>12.14</td></tr> </tbody> </table>	LIVE LOAD: COOPERS E-80 WITH DIESEL IMPACT		ASSUMED DEAD LOAD PER LINEAR FOOT OF GIRDER		TRACK AND BALLAST	1196 LBS./FT.	FLOOR	1410 LBS./FT.	GIRDER	779 LBS./FT.	TOTAL DEAD LOAD	3565 LBS./FT.	GROSS SECTION	NET SECTION	A = 229.00 in ² (1)	A = 202.00 in ² (1)	A = 211.00 in ² (2)	A = 184.00 in ² (2)	A = 180.00 in ² (2)	A = 103.00 in ² (2)	I = 58,004 in ⁴ (1)	I = 58,007 in ⁴ (1)	Y _T = 67.25 IN (1)	Y _T = 67.25 IN (1)	Y _B = 67.25 IN (1)	Y _B = 67.25 IN (1)	S _T = 9180 in ³ (1)	S _T = 8641 in ³ (1)	S _B = 9180 in ³ (1)	S = 8641 in ³ (1)		MAX. SHEAR (KIPS)	MAX. MOMENT (KIP FT.)	DEAD LOAD	209.10	7172.78	E-80 LIVE LOAD	295.30	9217.74	IMPACT	69.10	2186.98	TOTAL	573.50	16547.47		SHEAR MOMENT (FLB)	MOMENT (FLB)	DEAD LOAD	1.61	9.40	LIVE LOAD+IMPACT	2.60	14.80	TOTAL (K.S.L.)	4.41	24.30		25.76			MAX. SHEAR (KIPS)	MAX. MOMENT (KIP FT.)	DEAD LOAD	6.45	37.30	E-80 LIVE LOAD	23.00	285.76	IMPACT	9.03	104.45	TOTAL	37.48	407.81		SHEAR (K.S.L.)	MOMENT (K.S.L.)	DEAD LOAD	0.54	1.57	LIVE LOAD+IMPACT	3.19	15.53	TOTAL	3.72	17.10		MAX. SHEAR (KIPS)	MAX. MOMENT (KIP FT.)	DEAD LOAD	17.34	30.46	E-80 LIVE LOAD	103.09	306.55	IMPACT	40.62	121.57	TOTAL	161.05	438.58		SHEAR (K.S.L.)	MOMENT (K.S.L.)	DEAD LOAD	1.26	0.80	LIVE LOAD+IMPACT	10.58	11.34	TOTAL	11.84	12.14
(LLH)	DENOTES LONG LEG HORIZONTAL																																																																																																																																																																																																																																		
(SPS)	DENOTES SPACES																																																																																																																																																																																																																																		
(TYP)	DENOTES TYPICAL																																																																																																																																																																																																																																		
(EF)	DENOTES EACH FACE																																																																																																																																																																																																																																		
(FF)	DENOTES FAR FACE																																																																																																																																																																																																																																		
(NF)	DENOTES NEAR FACE																																																																																																																																																																																																																																		
(SER)	DENOTES SERIES																																																																																																																																																																																																																																		
(BMD)	DENOTES BEAM																																																																																																																																																																																																																																		
(CSC)	DENOTES COUNTERSUNK																																																																																																																																																																																																																																		
(EQ)	DENOTES EQUAL																																																																																																																																																																																																																																		
(OP)	DENOTES OPPOSITE HAND																																																																																																																																																																																																																																		
(WP)	DENOTES WORKING POINT																																																																																																																																																																																																																																		
(GIRD)	DENOTES GIRDER																																																																																																																																																																																																																																		
(T)	DENOTES TOP																																																																																																																																																																																																																																		
(B)	DENOTES BOTTOM																																																																																																																																																																																																																																		
STEP	ITEM	RESPONSIBILITY																																																																																																																																																																																																																																	
1	GRADING FOR TRACK REALIGNMENT	CONTRACTOR																																																																																																																																																																																																																																	
2	TRACK REALIGNMENT AT NORTH ABUTMENT	RAILROAD CO.																																																																																																																																																																																																																																	
3	INSTALL SHEET PILE PROTECTION FOR TRACK AND EXISTING BRIDGE	CONTRACTOR																																																																																																																																																																																																																																	
4	REMOVE PORTION OF EAST WINGWALL OF EXISTING NORTH ABUTMENT TO ALLOW EXCAVATION FOR NEW ABUTMENT	CONTRACTOR																																																																																																																																																																																																																																	
5	EXCAVATION FOR NEW ABUTMENTS EXCEPT FOR NORTHWEST WINGWALL	CONTRACTOR																																																																																																																																																																																																																																	
6	DRIVING OF PILES AND CONSTRUCTION OF NEW ABUTMENTS AND WINGWALLS	CONTRACTOR																																																																																																																																																																																																																																	
7	RICE STREET CLOSING	CONTRACTOR																																																																																																																																																																																																																																	
8	EXCAVATION FOR PIER	CONTRACTOR																																																																																																																																																																																																																																	
9	DRIVING OF PILES AND CONSTRUCTION OF NEW PIER	CONTRACTOR																																																																																																																																																																																																																																	
10	ERCTION OF BRIDGE SUPERSTRUCTURE AND INSTALLATION OF MEMBRANE WATERPROOFING	CONTRACTOR																																																																																																																																																																																																																																	
11	CONSTRUCT EMBANKMENT FOR NEW TRACK	CONTRACTOR																																																																																																																																																																																																																																	
12	INSTALLATION OF BALLAST, TIES AND TRACK, TIE INTO EXISTING TRACK AND OPEN NEW BRIDGE TO TRAFFIC	RAILROAD CO.																																																																																																																																																																																																																																	
13	REMOVE TEMPORARY TRACK AND ABANDONED EXISTING TRACK	RAILROAD CO.																																																																																																																																																																																																																																	
14	DEMOLISH EXISTING STRUCTURE	CONTRACTOR																																																																																																																																																																																																																																	
15	COMPLETE PROJECT, RAILINGS, SIGNS, EARTHWORK, ETC.	CONTRACTOR																																																																																																																																																																																																																																	
TYPE	NO.	SIZE	LOCATION																																																																																																																																																																																																																																
BIT. FELT	2	10' x 9' x 15"	WALKPLATE AT ABUTMENTS (2 FROM 1)																																																																																																																																																																																																																																
BIT. FELT	2	10' x 9' x 15"	WALKPLATE AT ABUTMENTS (2 FROM 1)																																																																																																																																																																																																																																
CORK	1	1' x 6' x 25'-0"	E. WINGWALL, N. ABUT. (2 FROM 1)																																																																																																																																																																																																																																
CORK	1	1' x 6' x 19'-6"	E. WINGWALL, N. ABUT. (2 FROM 1)																																																																																																																																																																																																																																
CORK	1	1' x 6' x 22'-4"	N. WINGWALL, S. ABUT. (2 FROM 1)																																																																																																																																																																																																																																
CORK	1	1' x 6' x 12'-6"	N. & S. WINGWALL (2 FROM 1)																																																																																																																																																																																																																																
POLYETHYLENE FOAM	1	1/2" O.D. x 60'-0"	FIBER JOINT IN BALLAST PLATE																																																																																																																																																																																																																																
LIVE LOAD: COOPERS E-80 WITH DIESEL IMPACT																																																																																																																																																																																																																																			
ASSUMED DEAD LOAD PER LINEAR FOOT OF GIRDER																																																																																																																																																																																																																																			
TRACK AND BALLAST	1196 LBS./FT.																																																																																																																																																																																																																																		
FLOOR	1410 LBS./FT.																																																																																																																																																																																																																																		
GIRDER	779 LBS./FT.																																																																																																																																																																																																																																		
TOTAL DEAD LOAD	3565 LBS./FT.																																																																																																																																																																																																																																		
GROSS SECTION	NET SECTION																																																																																																																																																																																																																																		
A = 229.00 in ² (1)	A = 202.00 in ² (1)																																																																																																																																																																																																																																		
A = 211.00 in ² (2)	A = 184.00 in ² (2)																																																																																																																																																																																																																																		
A = 180.00 in ² (2)	A = 103.00 in ² (2)																																																																																																																																																																																																																																		
I = 58,004 in ⁴ (1)	I = 58,007 in ⁴ (1)																																																																																																																																																																																																																																		
Y _T = 67.25 IN (1)	Y _T = 67.25 IN (1)																																																																																																																																																																																																																																		
Y _B = 67.25 IN (1)	Y _B = 67.25 IN (1)																																																																																																																																																																																																																																		
S _T = 9180 in ³ (1)	S _T = 8641 in ³ (1)																																																																																																																																																																																																																																		
S _B = 9180 in ³ (1)	S = 8641 in ³ (1)																																																																																																																																																																																																																																		
	MAX. SHEAR (KIPS)	MAX. MOMENT (KIP FT.)																																																																																																																																																																																																																																	
DEAD LOAD	209.10	7172.78																																																																																																																																																																																																																																	
E-80 LIVE LOAD	295.30	9217.74																																																																																																																																																																																																																																	
IMPACT	69.10	2186.98																																																																																																																																																																																																																																	
TOTAL	573.50	16547.47																																																																																																																																																																																																																																	
	SHEAR MOMENT (FLB)	MOMENT (FLB)																																																																																																																																																																																																																																	
DEAD LOAD	1.61	9.40																																																																																																																																																																																																																																	
LIVE LOAD+IMPACT	2.60	14.80																																																																																																																																																																																																																																	
TOTAL (K.S.L.)	4.41	24.30																																																																																																																																																																																																																																	
	25.76																																																																																																																																																																																																																																		
	MAX. SHEAR (KIPS)	MAX. MOMENT (KIP FT.)																																																																																																																																																																																																																																	
DEAD LOAD	6.45	37.30																																																																																																																																																																																																																																	
E-80 LIVE LOAD	23.00	285.76																																																																																																																																																																																																																																	
IMPACT	9.03	104.45																																																																																																																																																																																																																																	
TOTAL	37.48	407.81																																																																																																																																																																																																																																	
	SHEAR (K.S.L.)	MOMENT (K.S.L.)																																																																																																																																																																																																																																	
DEAD LOAD	0.54	1.57																																																																																																																																																																																																																																	
LIVE LOAD+IMPACT	3.19	15.53																																																																																																																																																																																																																																	
TOTAL	3.72	17.10																																																																																																																																																																																																																																	
	MAX. SHEAR (KIPS)	MAX. MOMENT (KIP FT.)																																																																																																																																																																																																																																	
DEAD LOAD	17.34	30.46																																																																																																																																																																																																																																	
E-80 LIVE LOAD	103.09	306.55																																																																																																																																																																																																																																	
IMPACT	40.62	121.57																																																																																																																																																																																																																																	
TOTAL	161.05	438.58																																																																																																																																																																																																																																	
	SHEAR (K.S.L.)	MOMENT (K.S.L.)																																																																																																																																																																																																																																	
DEAD LOAD	1.26	0.80																																																																																																																																																																																																																																	
LIVE LOAD+IMPACT	10.58	11.34																																																																																																																																																																																																																																	
TOTAL	11.84	12.14																																																																																																																																																																																																																																	

TITLE GENERAL NOTES & STRESS TABLE	ISS: JFE	WK: MJA	APPROVED:	Bridge No.
	CS-K	CS-K	6-13-86	62032
Sheet No. 3 of 39 Sheets				

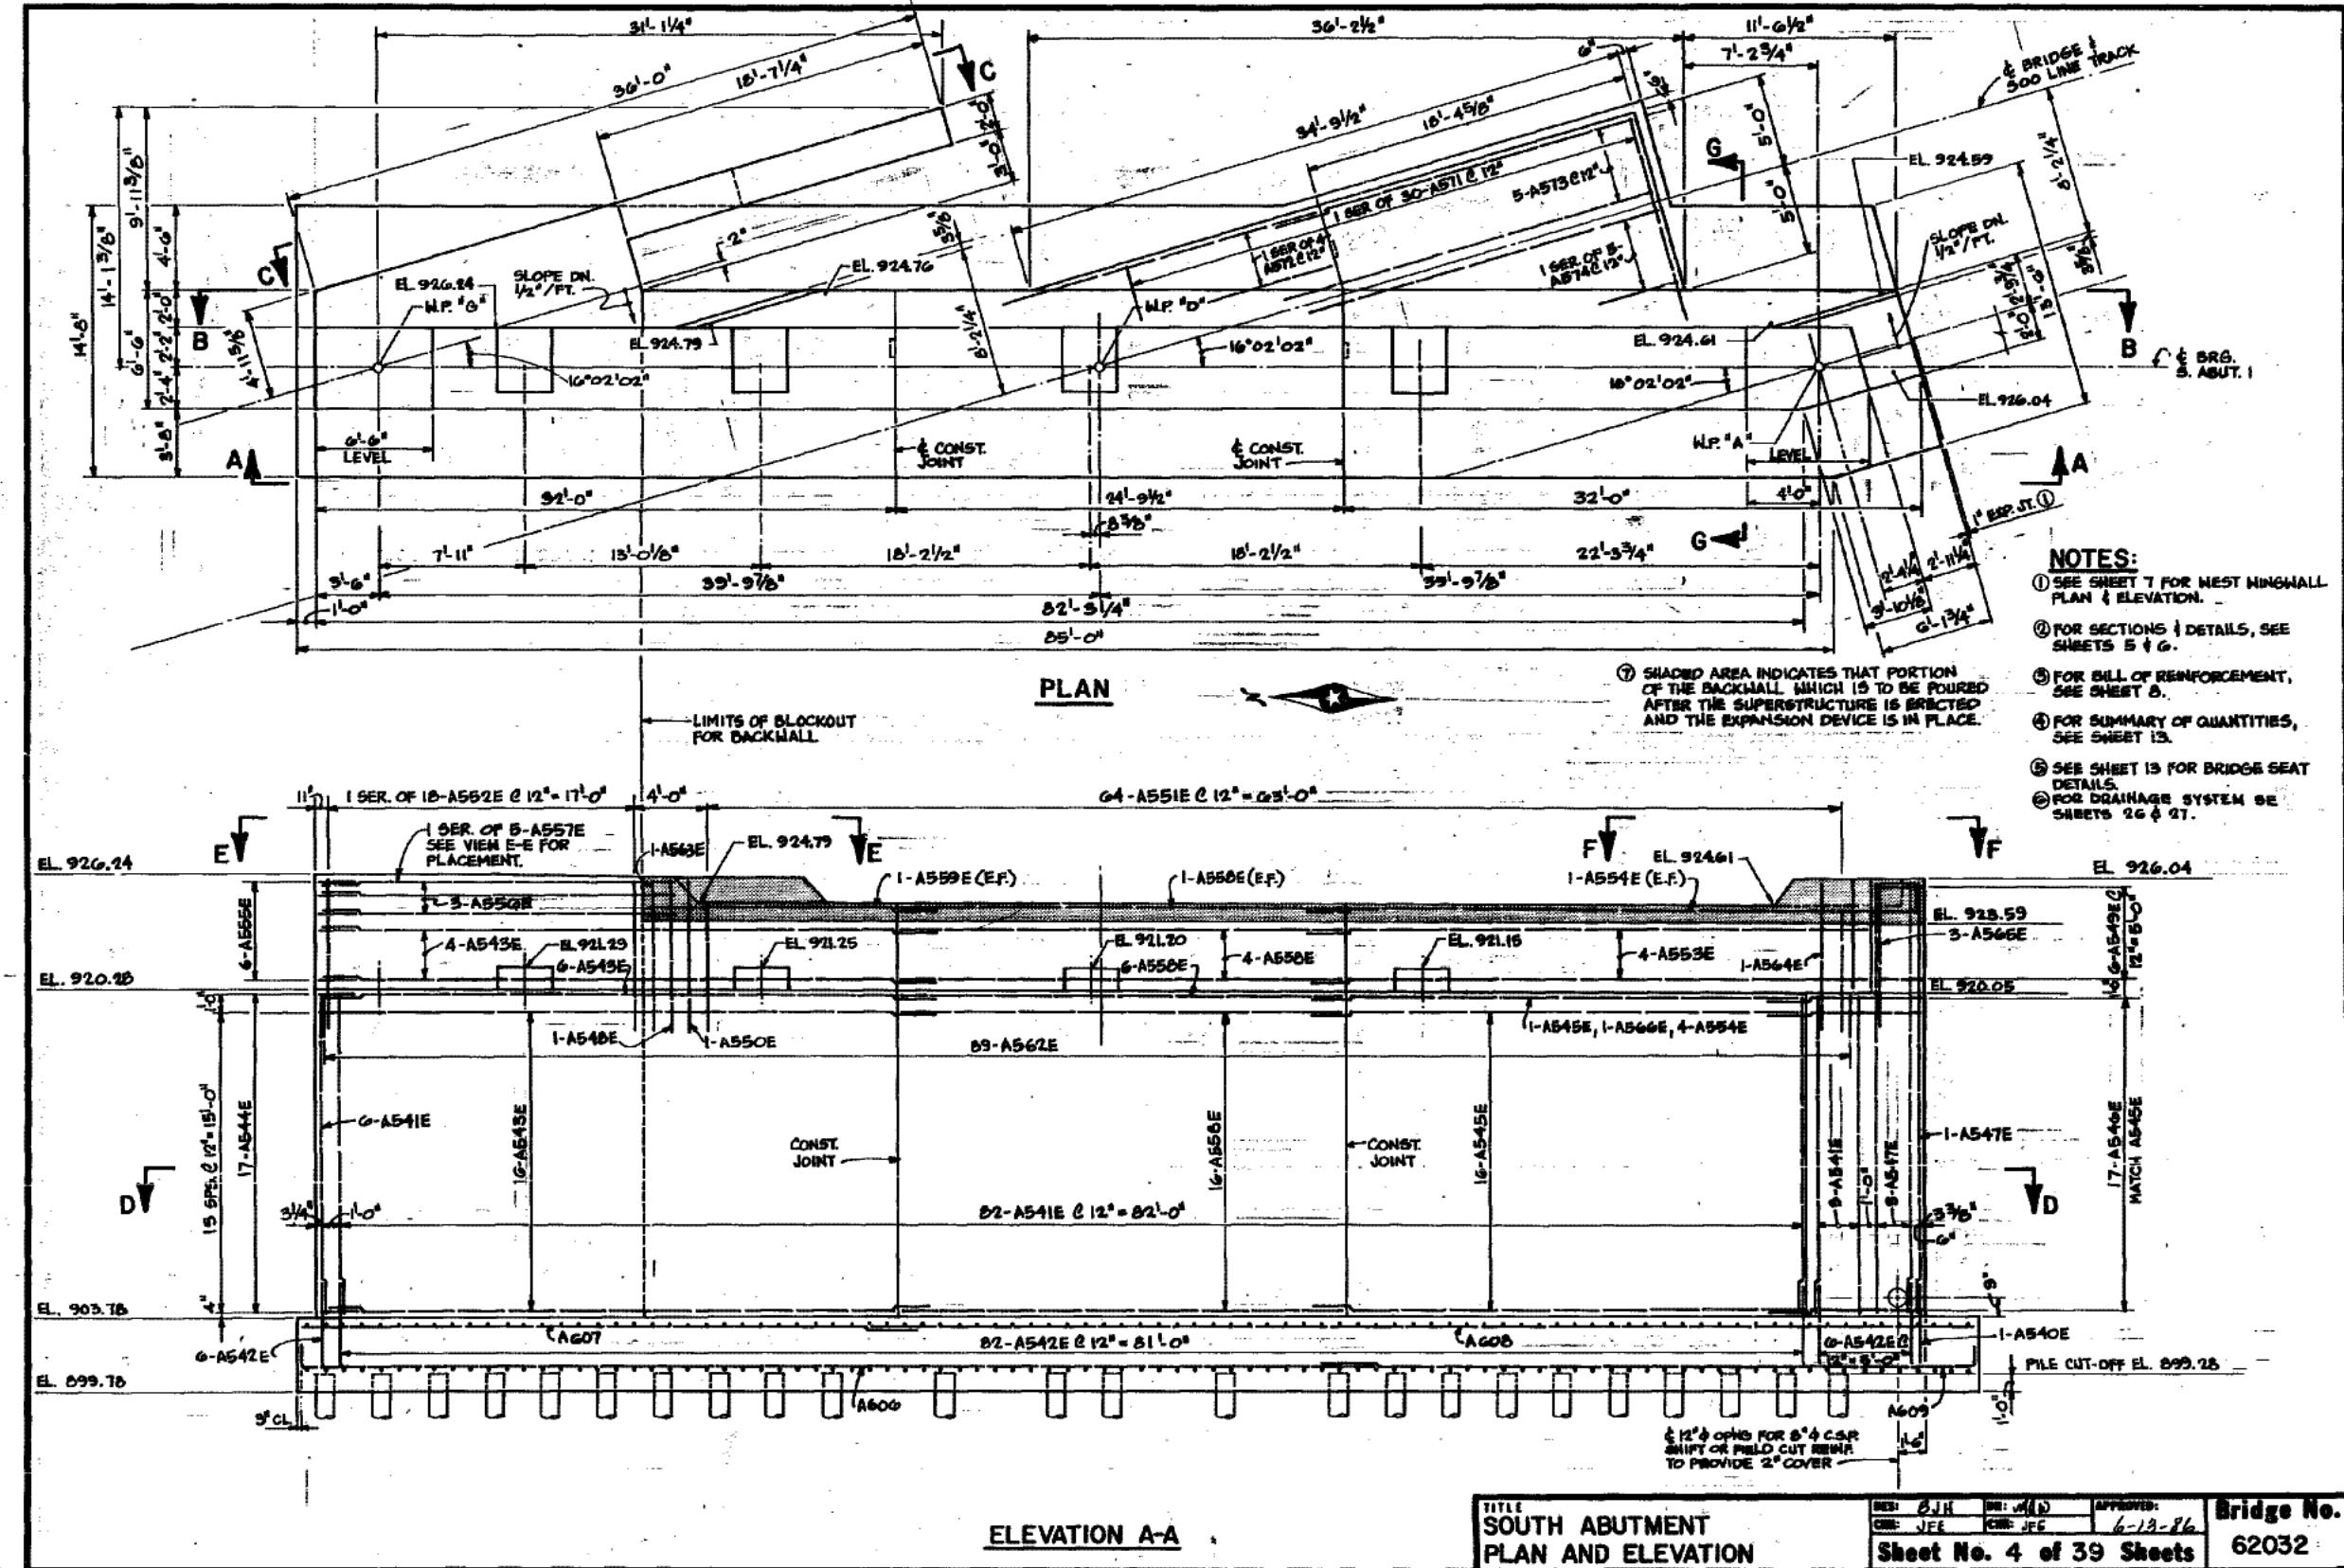

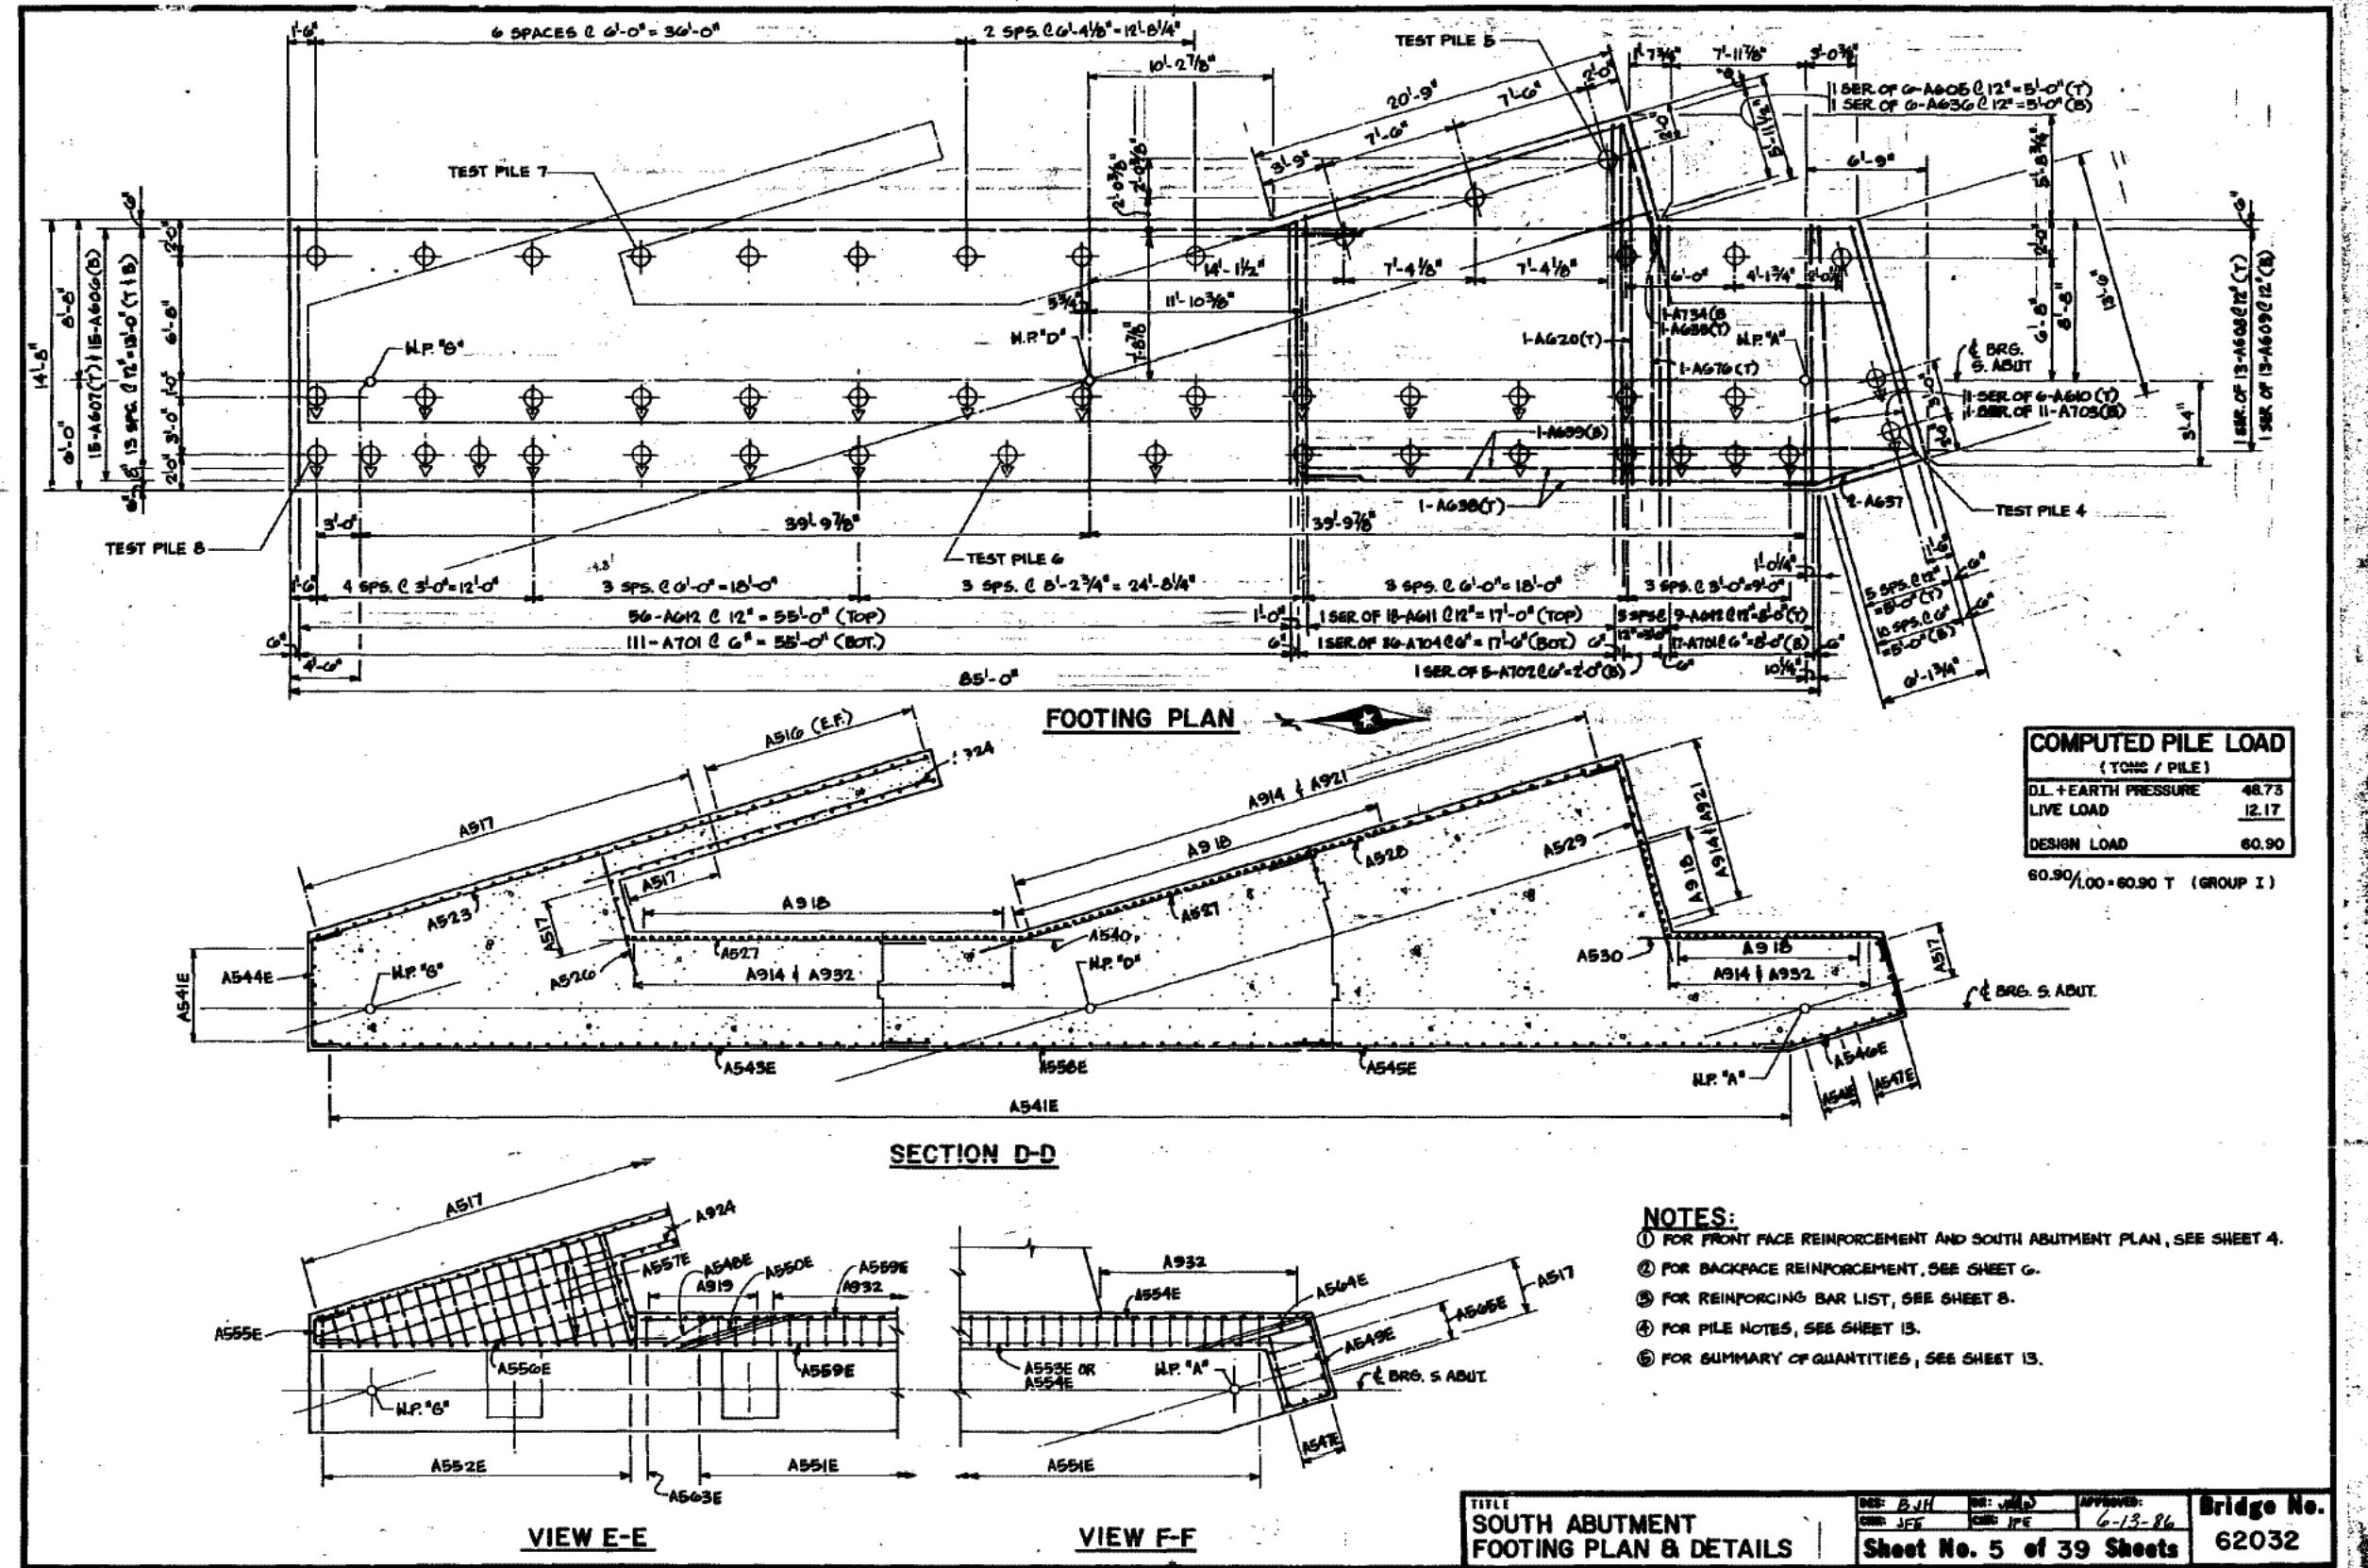

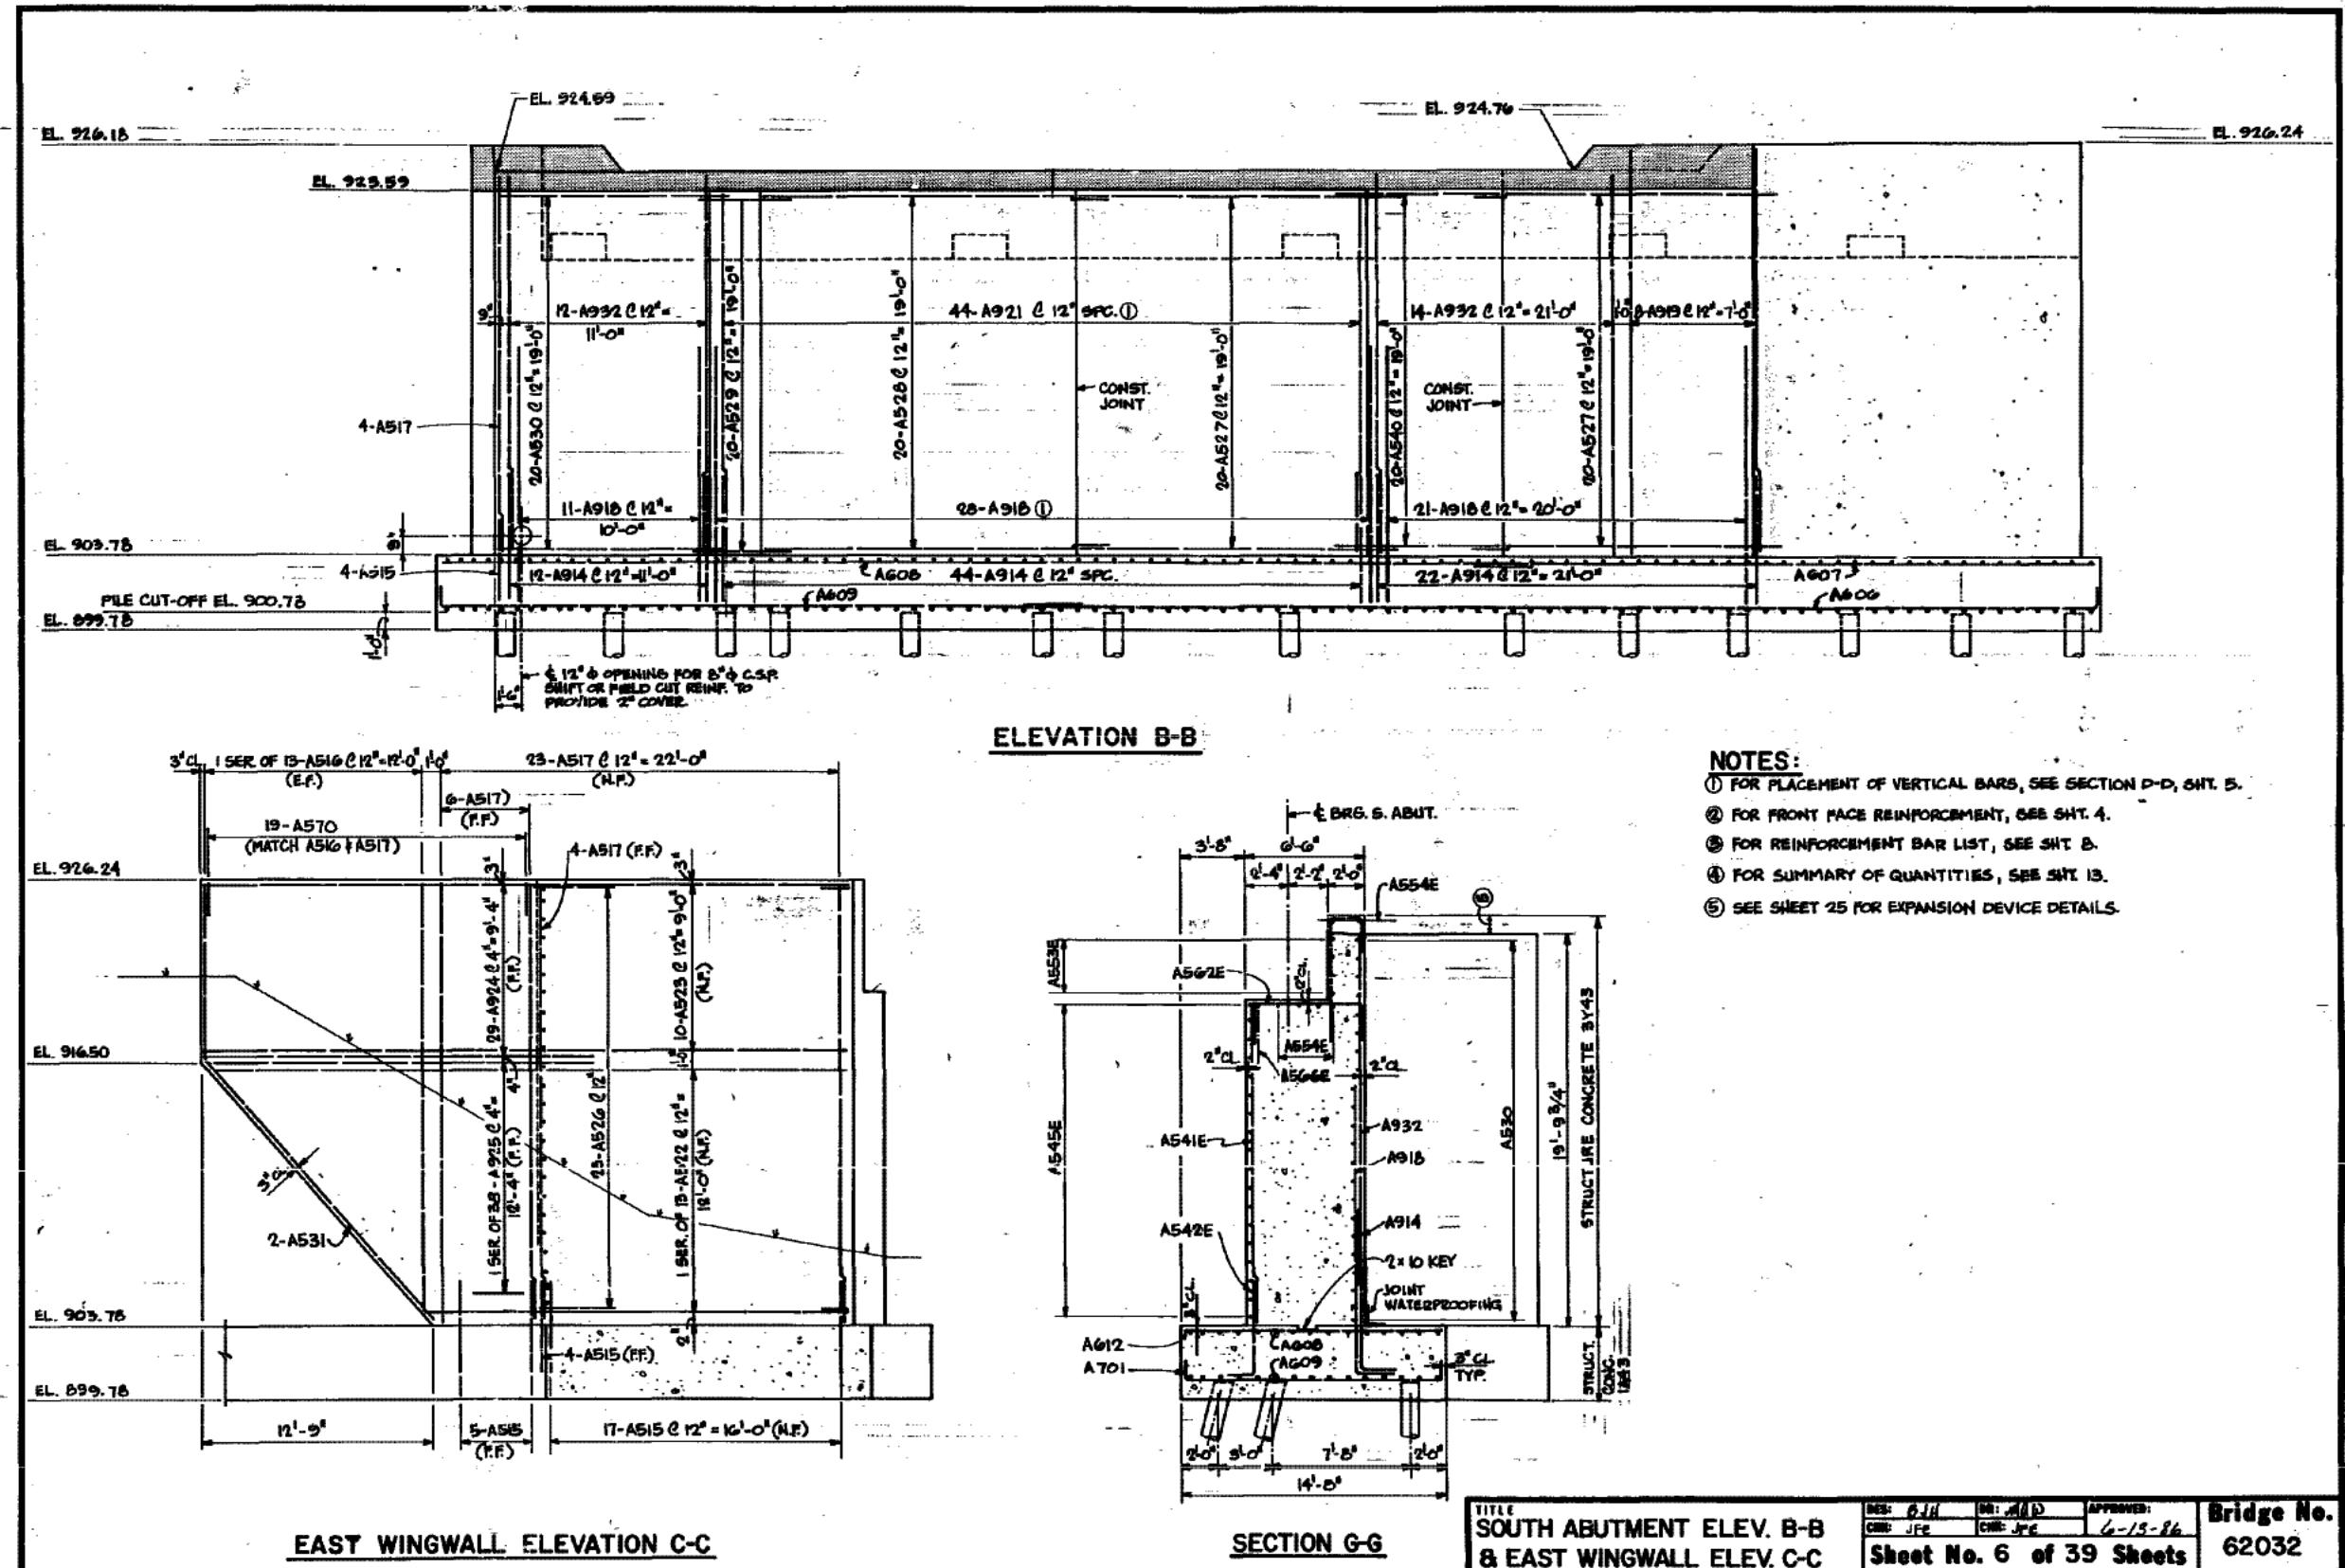

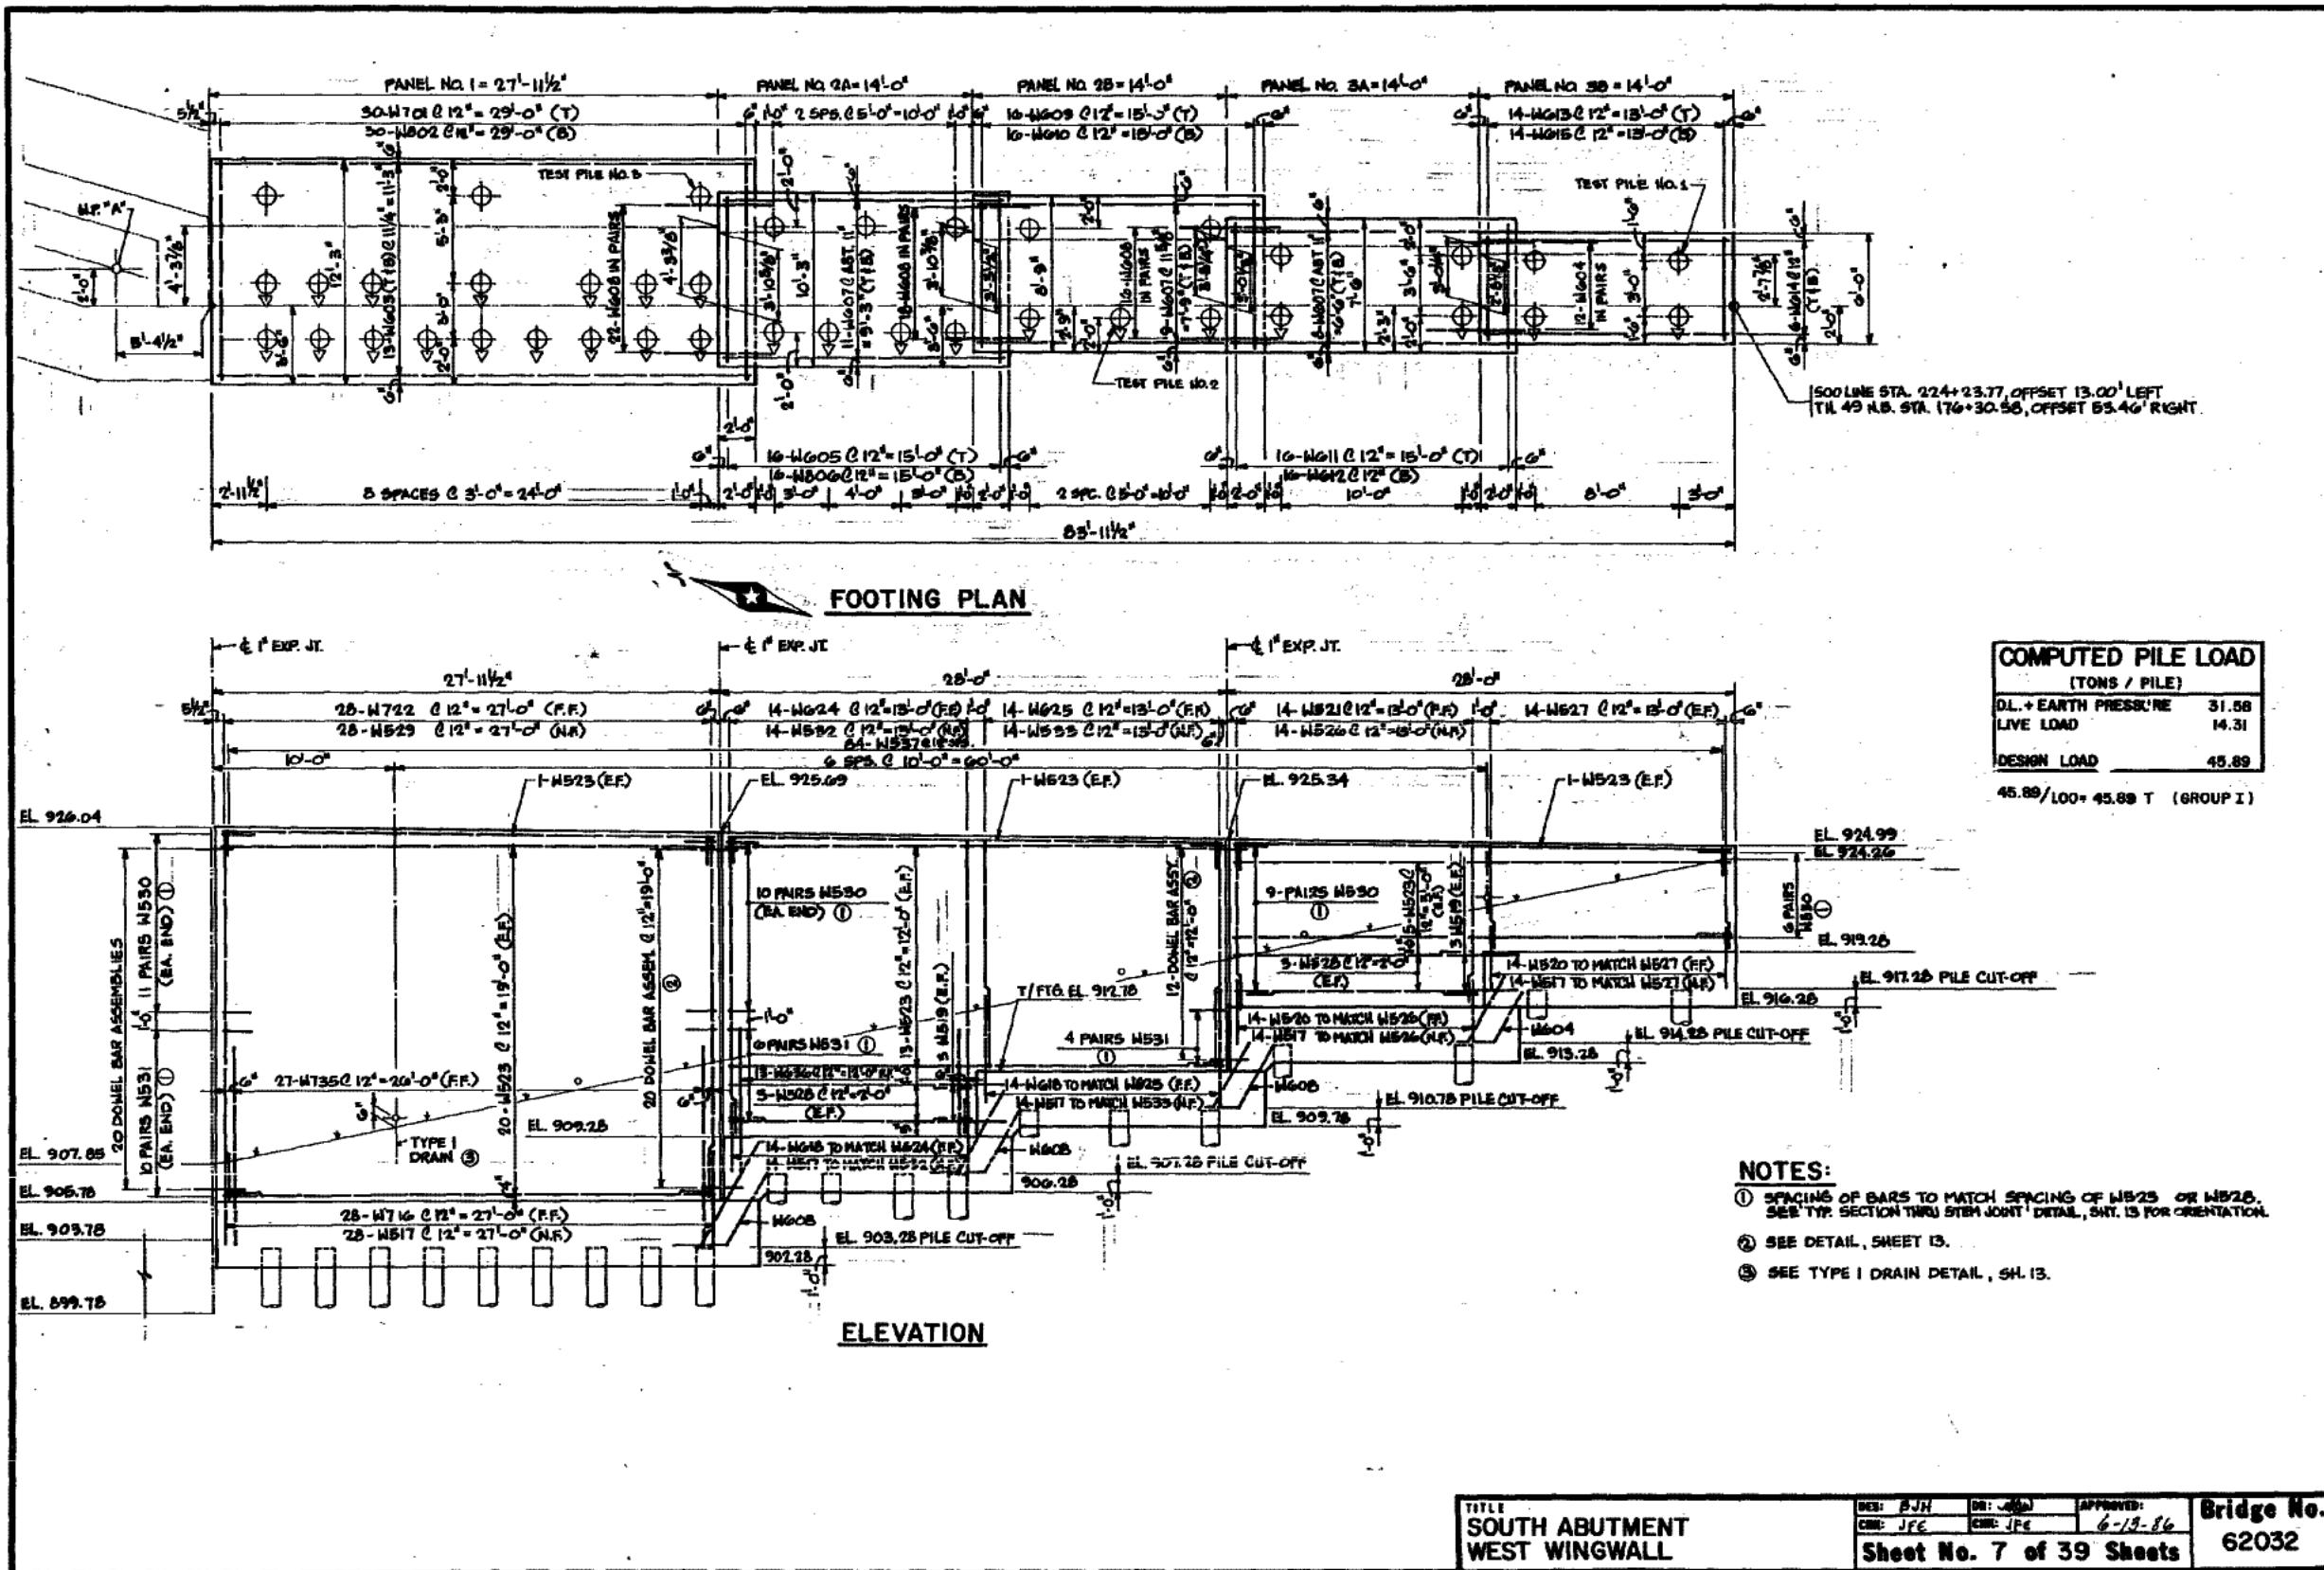



BAR	NO.	LENGTH	TYPE	DIMENSIONS				LOCATION				
				A	B	C	D					
SOUTH ABUTMENT UNCOATED BARS												
EPOXY COATED BARS												
A 701	128	16'- 6"	114	14'- 2"	17'- 2"			TRANS. FTG.				
A 702	1 SER	16'- 6"	114	14'- 2"	17'- 2"			TRANS. FTG.				
OF 5	22'- 2"	114	13'- 10"									
A 703	1 SER	16'- 2"	114	13'- 0"	17'- 2"			TRANS. FTG.				
OF 11	17'- 2"	114	14'- 0"									
A 704	1 SER	16'-11"	114	14'- 7"	17'- 2"			TRANS. FTG.				
OF 36	21'-10"	114	19'- 6"									
A 605	1 SER	6'- 0"	STR					LONG. FTG.				
OF 6	23'- 0"											
A 606	15	60'- 0"	111	59'- 0"	1'- 0"			LONG. FTG.				
A 607	15	60'- 0"	STR					LONG. FTG.				
A 608	1 SER	29'- 7"	STR					LONG. FTG.				
OF 13	33'- 4"											
A 609	1 SER	30'-10"	111	29'-10"				LONG. FTG.				
OF 13	34'- 6"	115	33'- 6	1'- 0"				LONG. FTG.				
A 610	1 SER	13'- 0"	STR					TRANS. FTG.				
OF 6	14'- 0"											
A 611	1 SER	14'- 8"	STR					TRANS. FTG.				
OF 18	19'- 6"											
A 612	65	14'- 2"	STR					TRANS. FTG.				
A 914	78	8'- 8"	111	7'- 1"	1'- 7"			FOOTING DOMELS				
A 515	30	4'- 7"	111	3'- 9"	0'-10"			FOOTING DOMELS				
A 516	2 SER	9'- 5"	STR					VERT. WINGMALL				
OF 13	21'- 7"											
A 517	37	22'- 0"	STR					VERT. BACKWALL				
A 918	60	14'- 8"	111	16'- 0"	1'- 7"			FOOTING DOMELS				
A 919	8	22'- 0"	STR					VERT. BACKWALL				
A 620	1	17'-10"	STR					FTG. TRANS.				
A 921	48	19'- 6"	STR					VERT. BACKWALL				
A 522	1 SER	23'- 4"	STR					HORIZ. W. WALL				
OF 13	35'- 0"											
A 523	10	35'- 8"	STR					HORIZ. W. WALL				
A 924	29	22'- 0"	STR					HORIZ. W. WALL				
A 925	1 SER	9'- 9"	STR					HORIZ. W. WALL				
OF 36	22'- 0"											
A 526	23	6'- 0"	STR					HORIZ. BACKWALL				
A 527	48	18'- 6"	STR					HORIZ. BACKWALL				
A 528	20	20'- 6"	STR					HORIZ. BACKWALL				
A 529	20	13'- 6"	111	11'- 0"	2'- 6"			HORIZ. BACKWALL				
A 530	20	16'- 0"	113	13'- 6"	2'- 6"	3-1/2		HORIZ. BACKWALL				
A 531	2	18'- 0"	STR					DIAGONAL W. W.				
A 932	26	20'- 6"	STR					VERT. BACKWALL				
A 534	1	9'- 2"	111	8'- 0"	1'- 2"			TRANS. FOOTING				
A 625	1	7'- 0"	STR					TRANS. FOOTING				
A 636	1 SER	7'- 0"	111	6'- 0"	1'- 0"			LONG. FOOTING				
OF 6	24'- 0"											
A 637	2	7'-11"	112	5'-10"	2'- 1"	3-1/4		LONG. FOOTING				
A 638	2	31'- 6"	STR					LONG. FOOTING				
A 639	2	32'- 8"	111	31'- 8"	1'- 0"			LONG. FOOTING				
A 540	20	10'- 0"	STR					HORIZ. WALL				
A 520	19	4'- 2"	114	1'- 8"	1'- 3"			W. WALL VERT.				
A 521	1 SER	3'- 0"	STR					MEDGE TOP				
OF 30	11'- 3"											
A 522	1 SER	7'- 6"	STR					MEDGE TOP				
OF 4	12'- 3"											
A 573	5	20'- 8"	STR					MEDGE TOP				
A 574	1 SER	6'- 6"	STR					MEDGE TOP				
OF 5	19'- 6"											
A 676	1	15'- 8"	STR					TRANS. FOOTING				


BAR	NO.	LENGTH	TYPE	DIMENSIONS				LOCATION				
				A	B	C	D					
SOUTH ABUTMENT EPOXY COATED BARS												
EPoxy Coated Bars												
A 541E	95	16'- 0"	STR					VERT. WALL				
A 520E	95	5'-10"	111	5'- 0"	0'-10"			FOOTING DOMEL				
A 542E	26	34'- 6"	STR					HORIZ. ABUT.				
A 544E	17	11'- 2"	117	6'- 2"	2'- 6"	2'- 6"	3-1/2	CORNER WALL				
A 545E	17	26'- 0"	STR					HORIZ. ABUT.				
A 546E	17	13'- 6"	116	6'- 7"	4'- 5"	2'- 6"	3-1/2	HORIZ. CORNER				
A 547E	4	22'- 2"	STR					VERT. ABUT.				
A 548E	1	12'-11"	115	3'- 5"	7'- 0"	2'- 6"		VERT. BACKWALL				
A 549E	6	10'- 6"	115	2'- 6"	4'- 0"			HORIZ. BACKWALL				
A 550E	1	15'- 8"	115	6'- 2"	7'- 0"	2'- 6"		VERT. BACKWALL				
A 551E	64	10'- 2"	115	1'- 8"	6'- 0"	2'- 6"		VERT. BACKWALL				
A 552E	1 SER	11'- 5"	115	1'- 11"	7'- 0"	2'- 6"		VERT. BACKWALL				
OF 18	15'-11"											
A 553E	8	31'- 4"	STR					HORIZ. BACKWALL				
A 554E	6	32'- 4"	STR					HORIZ. BACKWALL				
A 555E	6	6'- 7"	117	1'- 7"	2'- 6"	2'- 6"	3-1/2	CORNER				
A 556E	3	20'- 0"	STR					HORIZ. BACKWALL				
A 557E	1 SER	4'- 6"	STR					HORIZ.				
OF 5	17'- 0"											
A 558E	28	28'- 6"	STR					HORIZ.				
A 559E	2	16'- 0"	STR					HORIZ. BACKWALL				
A 562E	89	10'- 0"	114	6'- 0"	2'- 0"			ABUT. SEAT				
A 563E	1	11'- 2"	115	1'- 8"	7'- 0"	2'- 6"		BACKWALL VERT.				
A 564E	1	14'- 5"	115	4'-11"	7'- 0"	2'- 6"		BACKWALL VERT.				
A 565E	3	12'- 1"	115	2'- 7"	7'- 0"	2'- 6"		BACKWALL VERT.				
A 566E	1	29'- 3"	STR					SEAT HORIZ.				
A 590E	20	8'- 8"	114	2'- 8"	3'- 0"			ABUT. SEAT				
A 591E	16	10'- 3"	114	4'- 3"	3'- 0"			ABUT. SEAT				
OF 13	11'- 3"											
A 530	114	3'- 5"	111	1'- 9"	1'- 8"			END HORIZ.				
W 531	60	4'- 6"	111	1'- 9"	2'- 7"			END HORIZ.				
W 532	14	16'- 0"	STR					VERT. WALL				
W 533	16	12'- 4"	STR					VERT. WALL				
W 735	27	11'- 8"	110	1'- 2"	10'- 6"			DOMELS				
W 636	13	9'- 9"	110	1'- 0"	8'- 9"			DOMELS				
W 537	84	4'- 1"	117	1'- 7"	1'- 3"	1'- 3"	1-3/8	WALL TOP				


BAR	NO.	LENGTH	TYPE	DIMENSIONS				LOCATION
A	B	C	D					


<tbl_r cells="6" ix="1

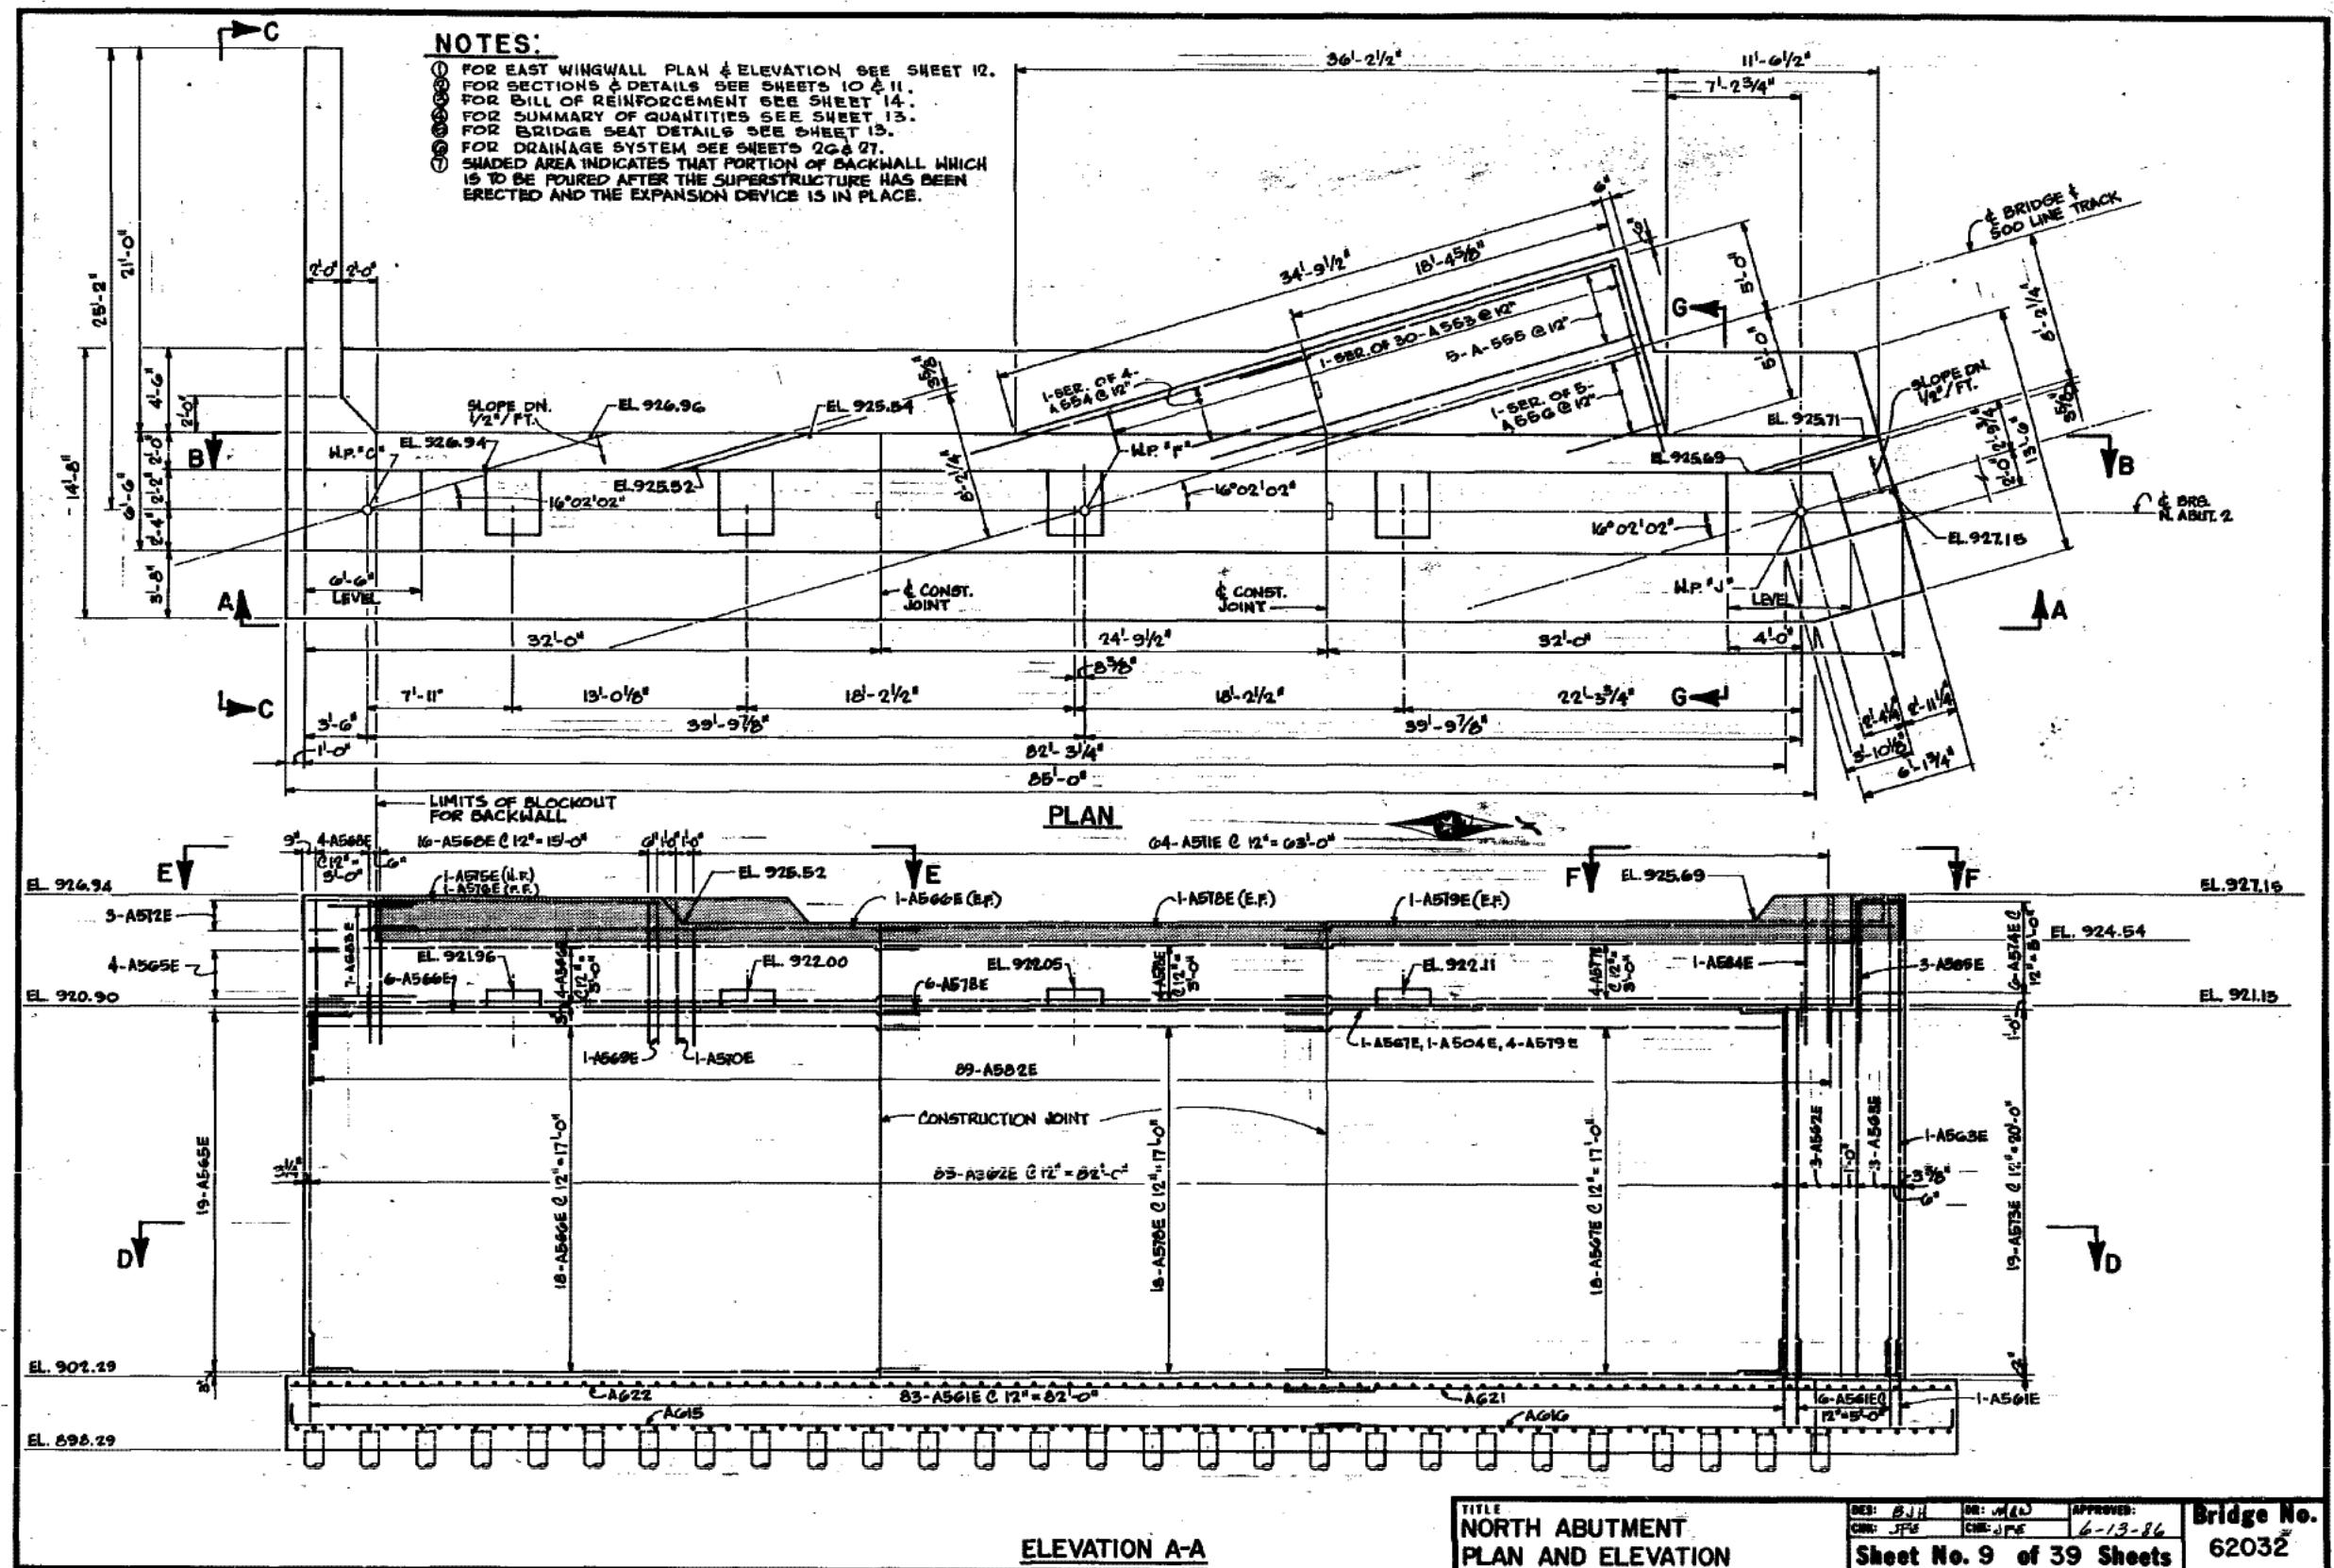

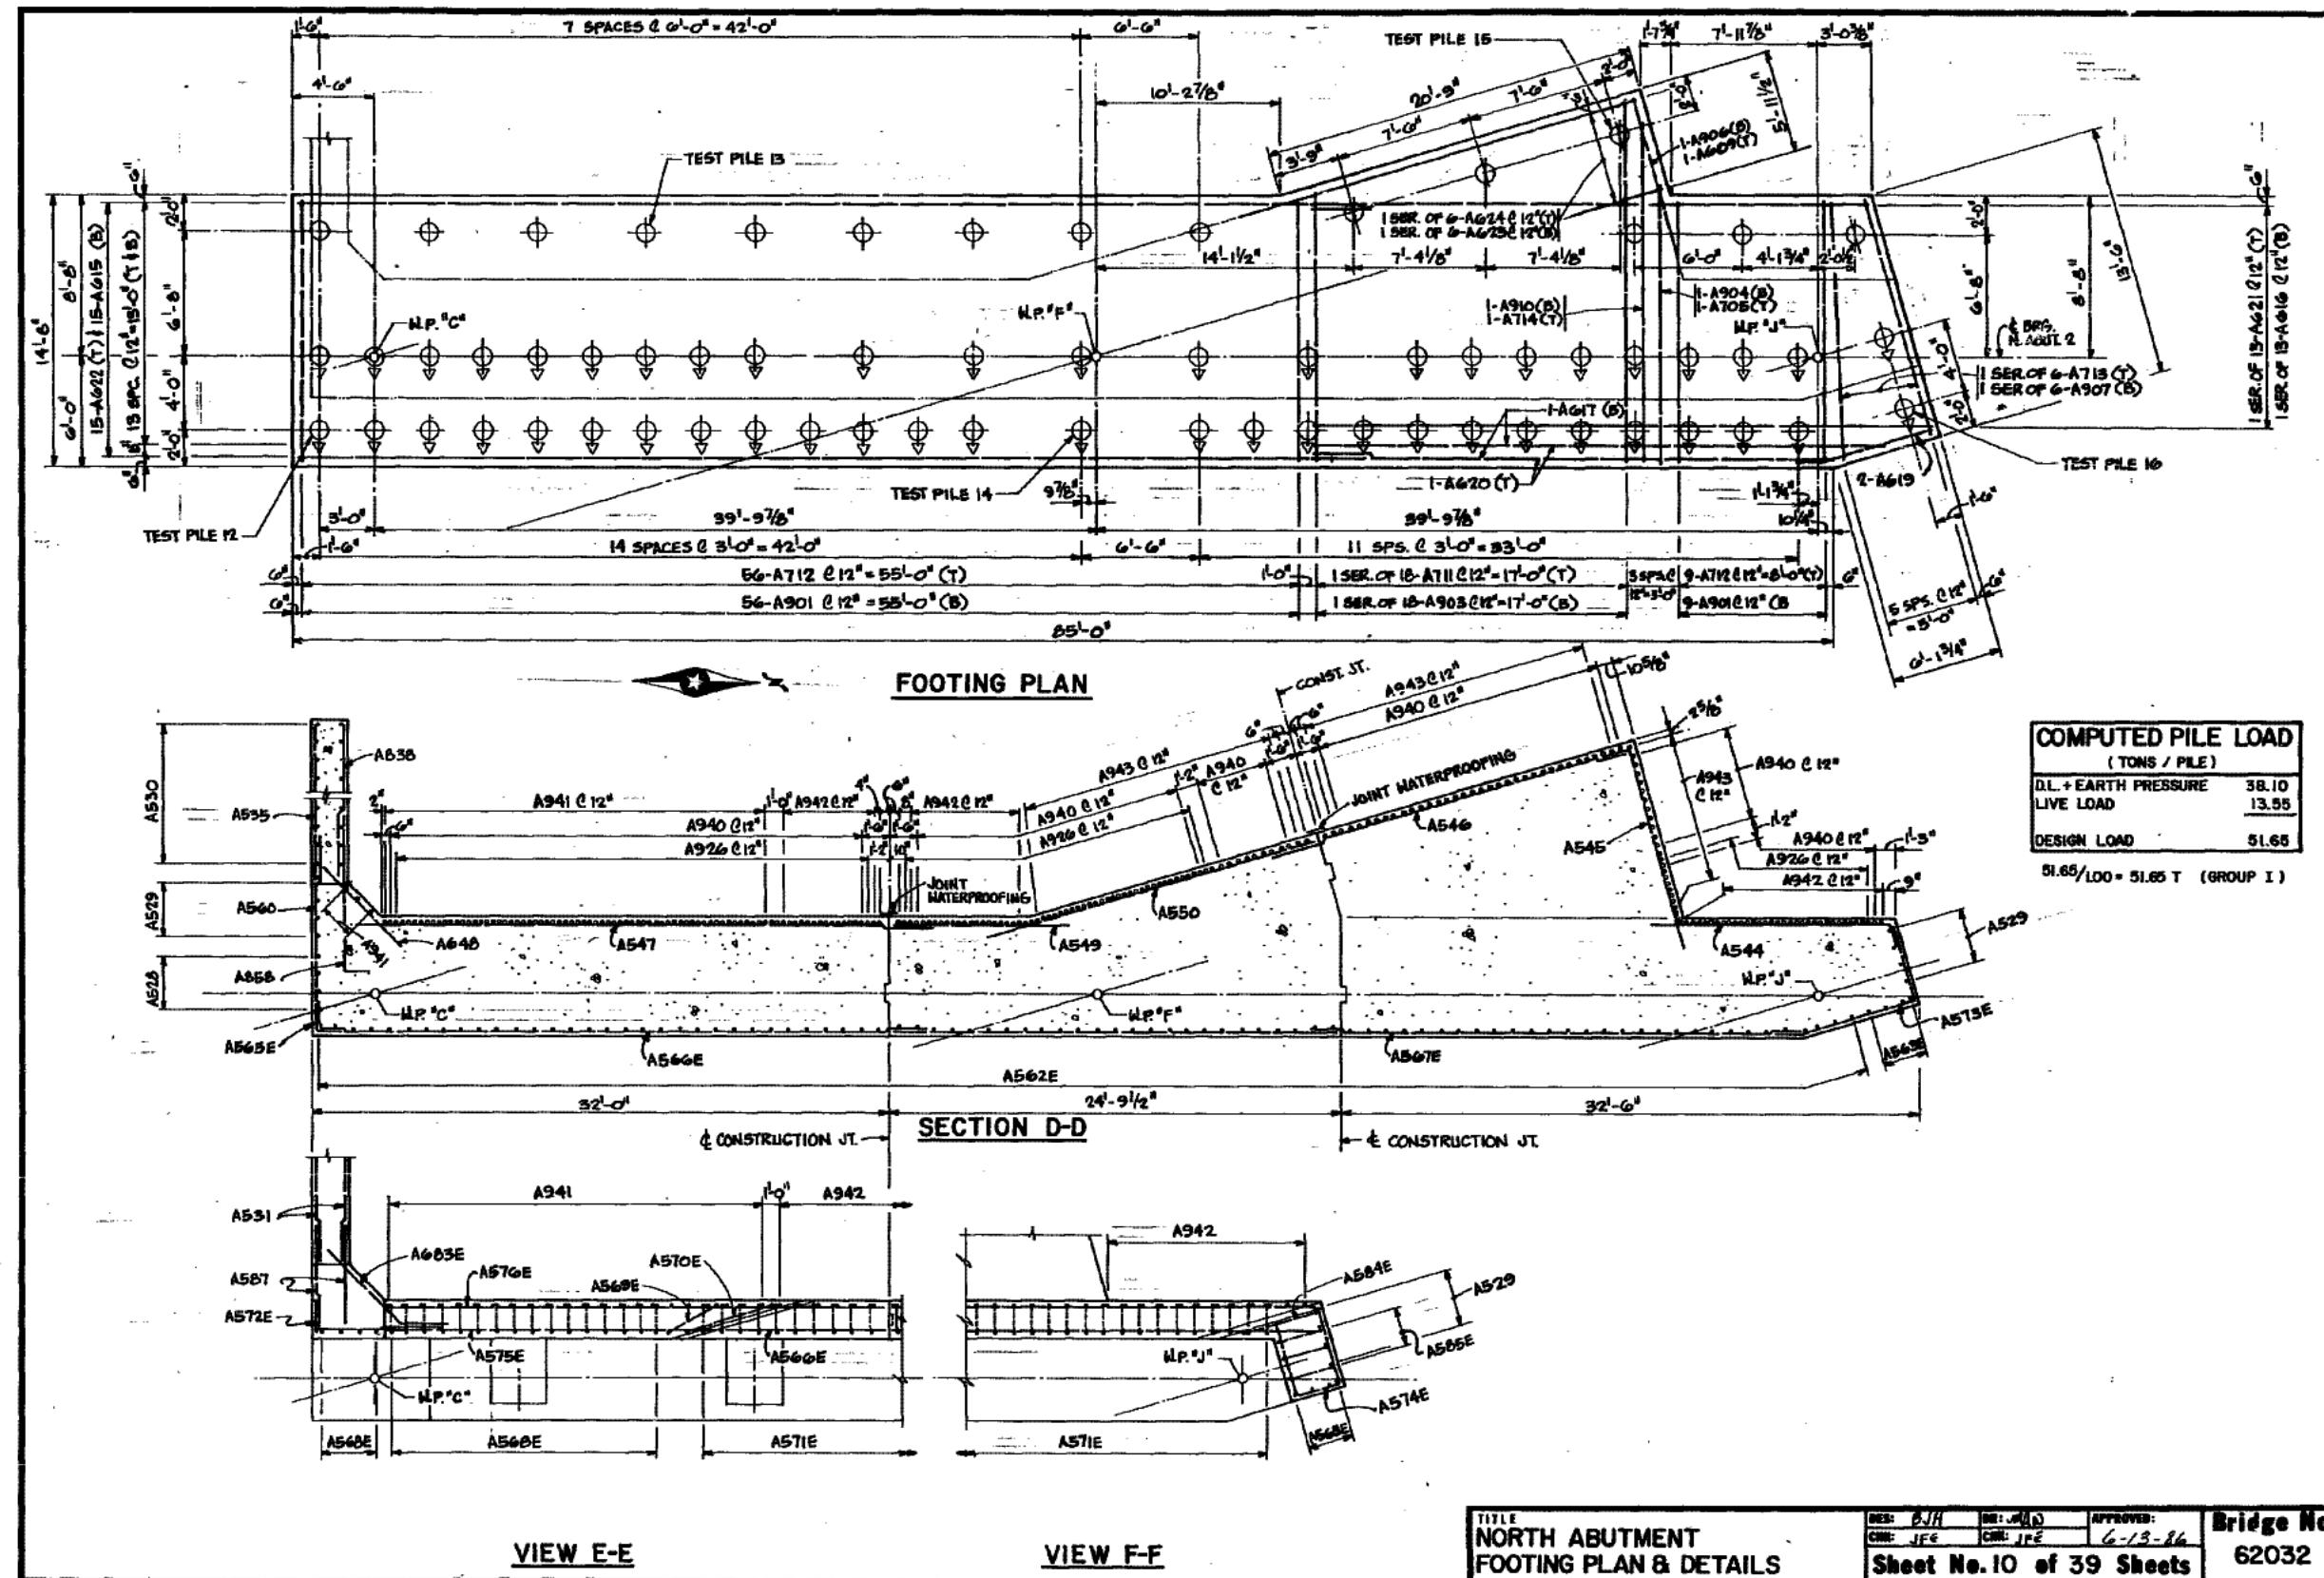


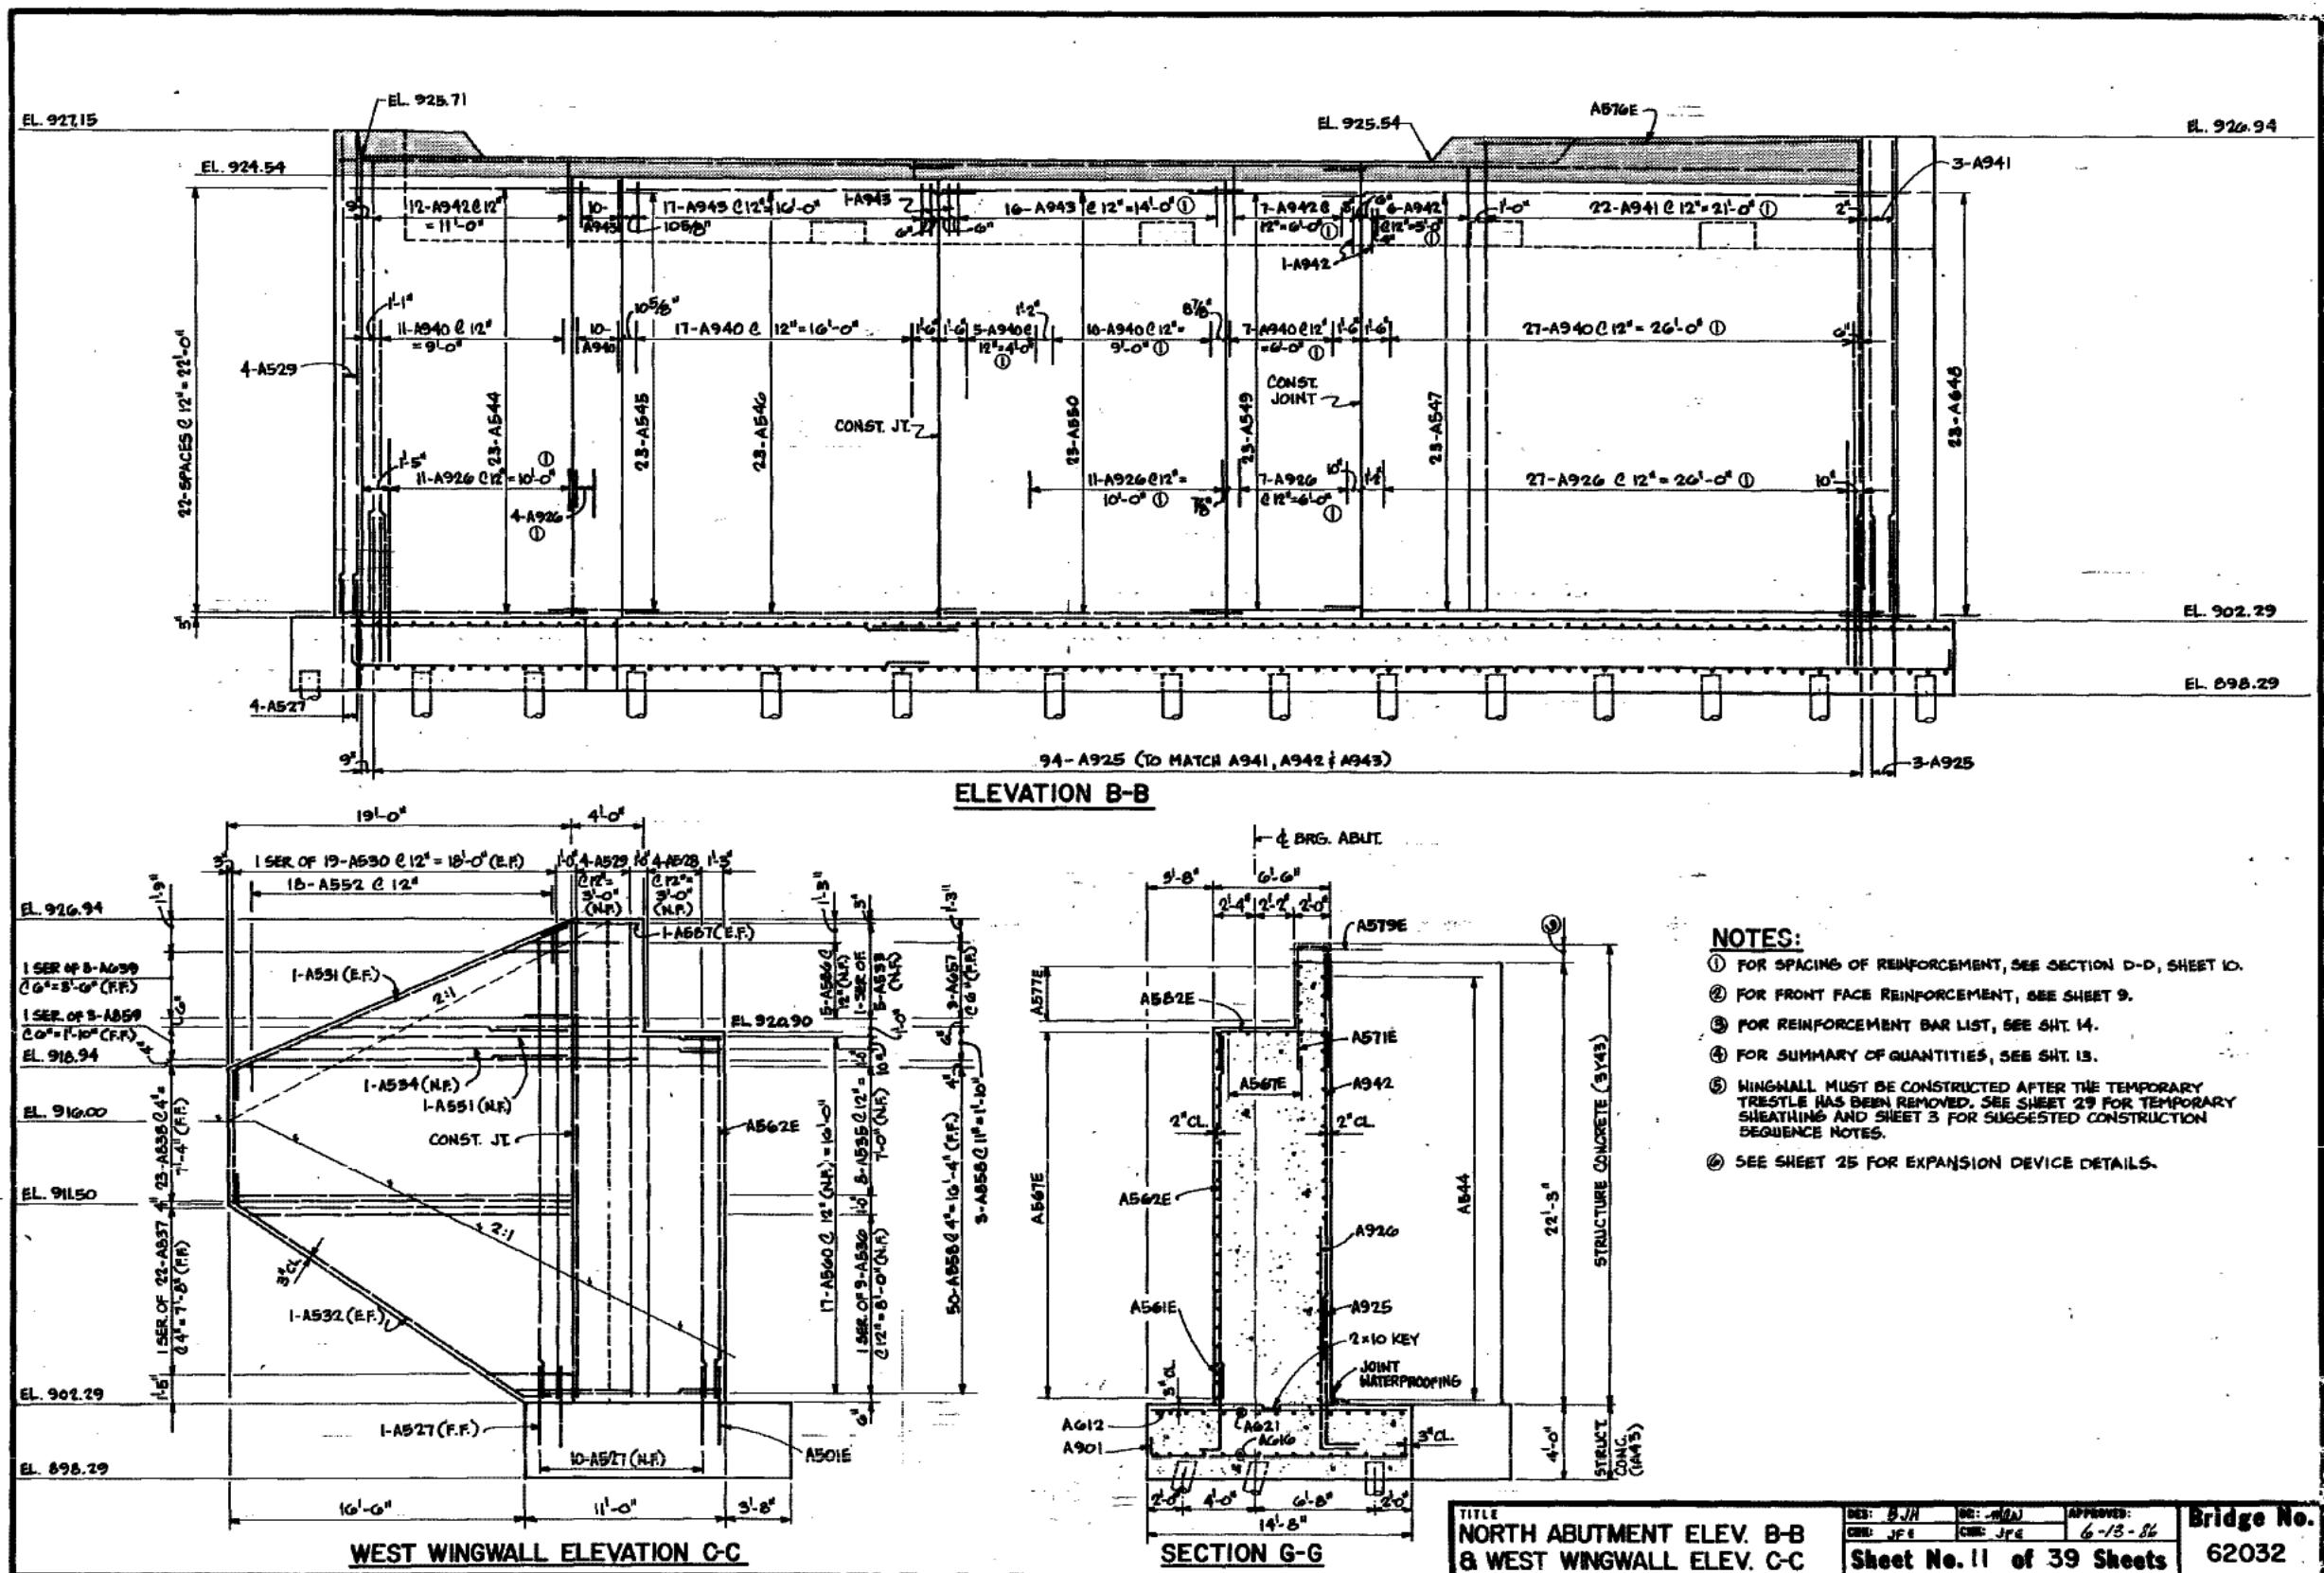

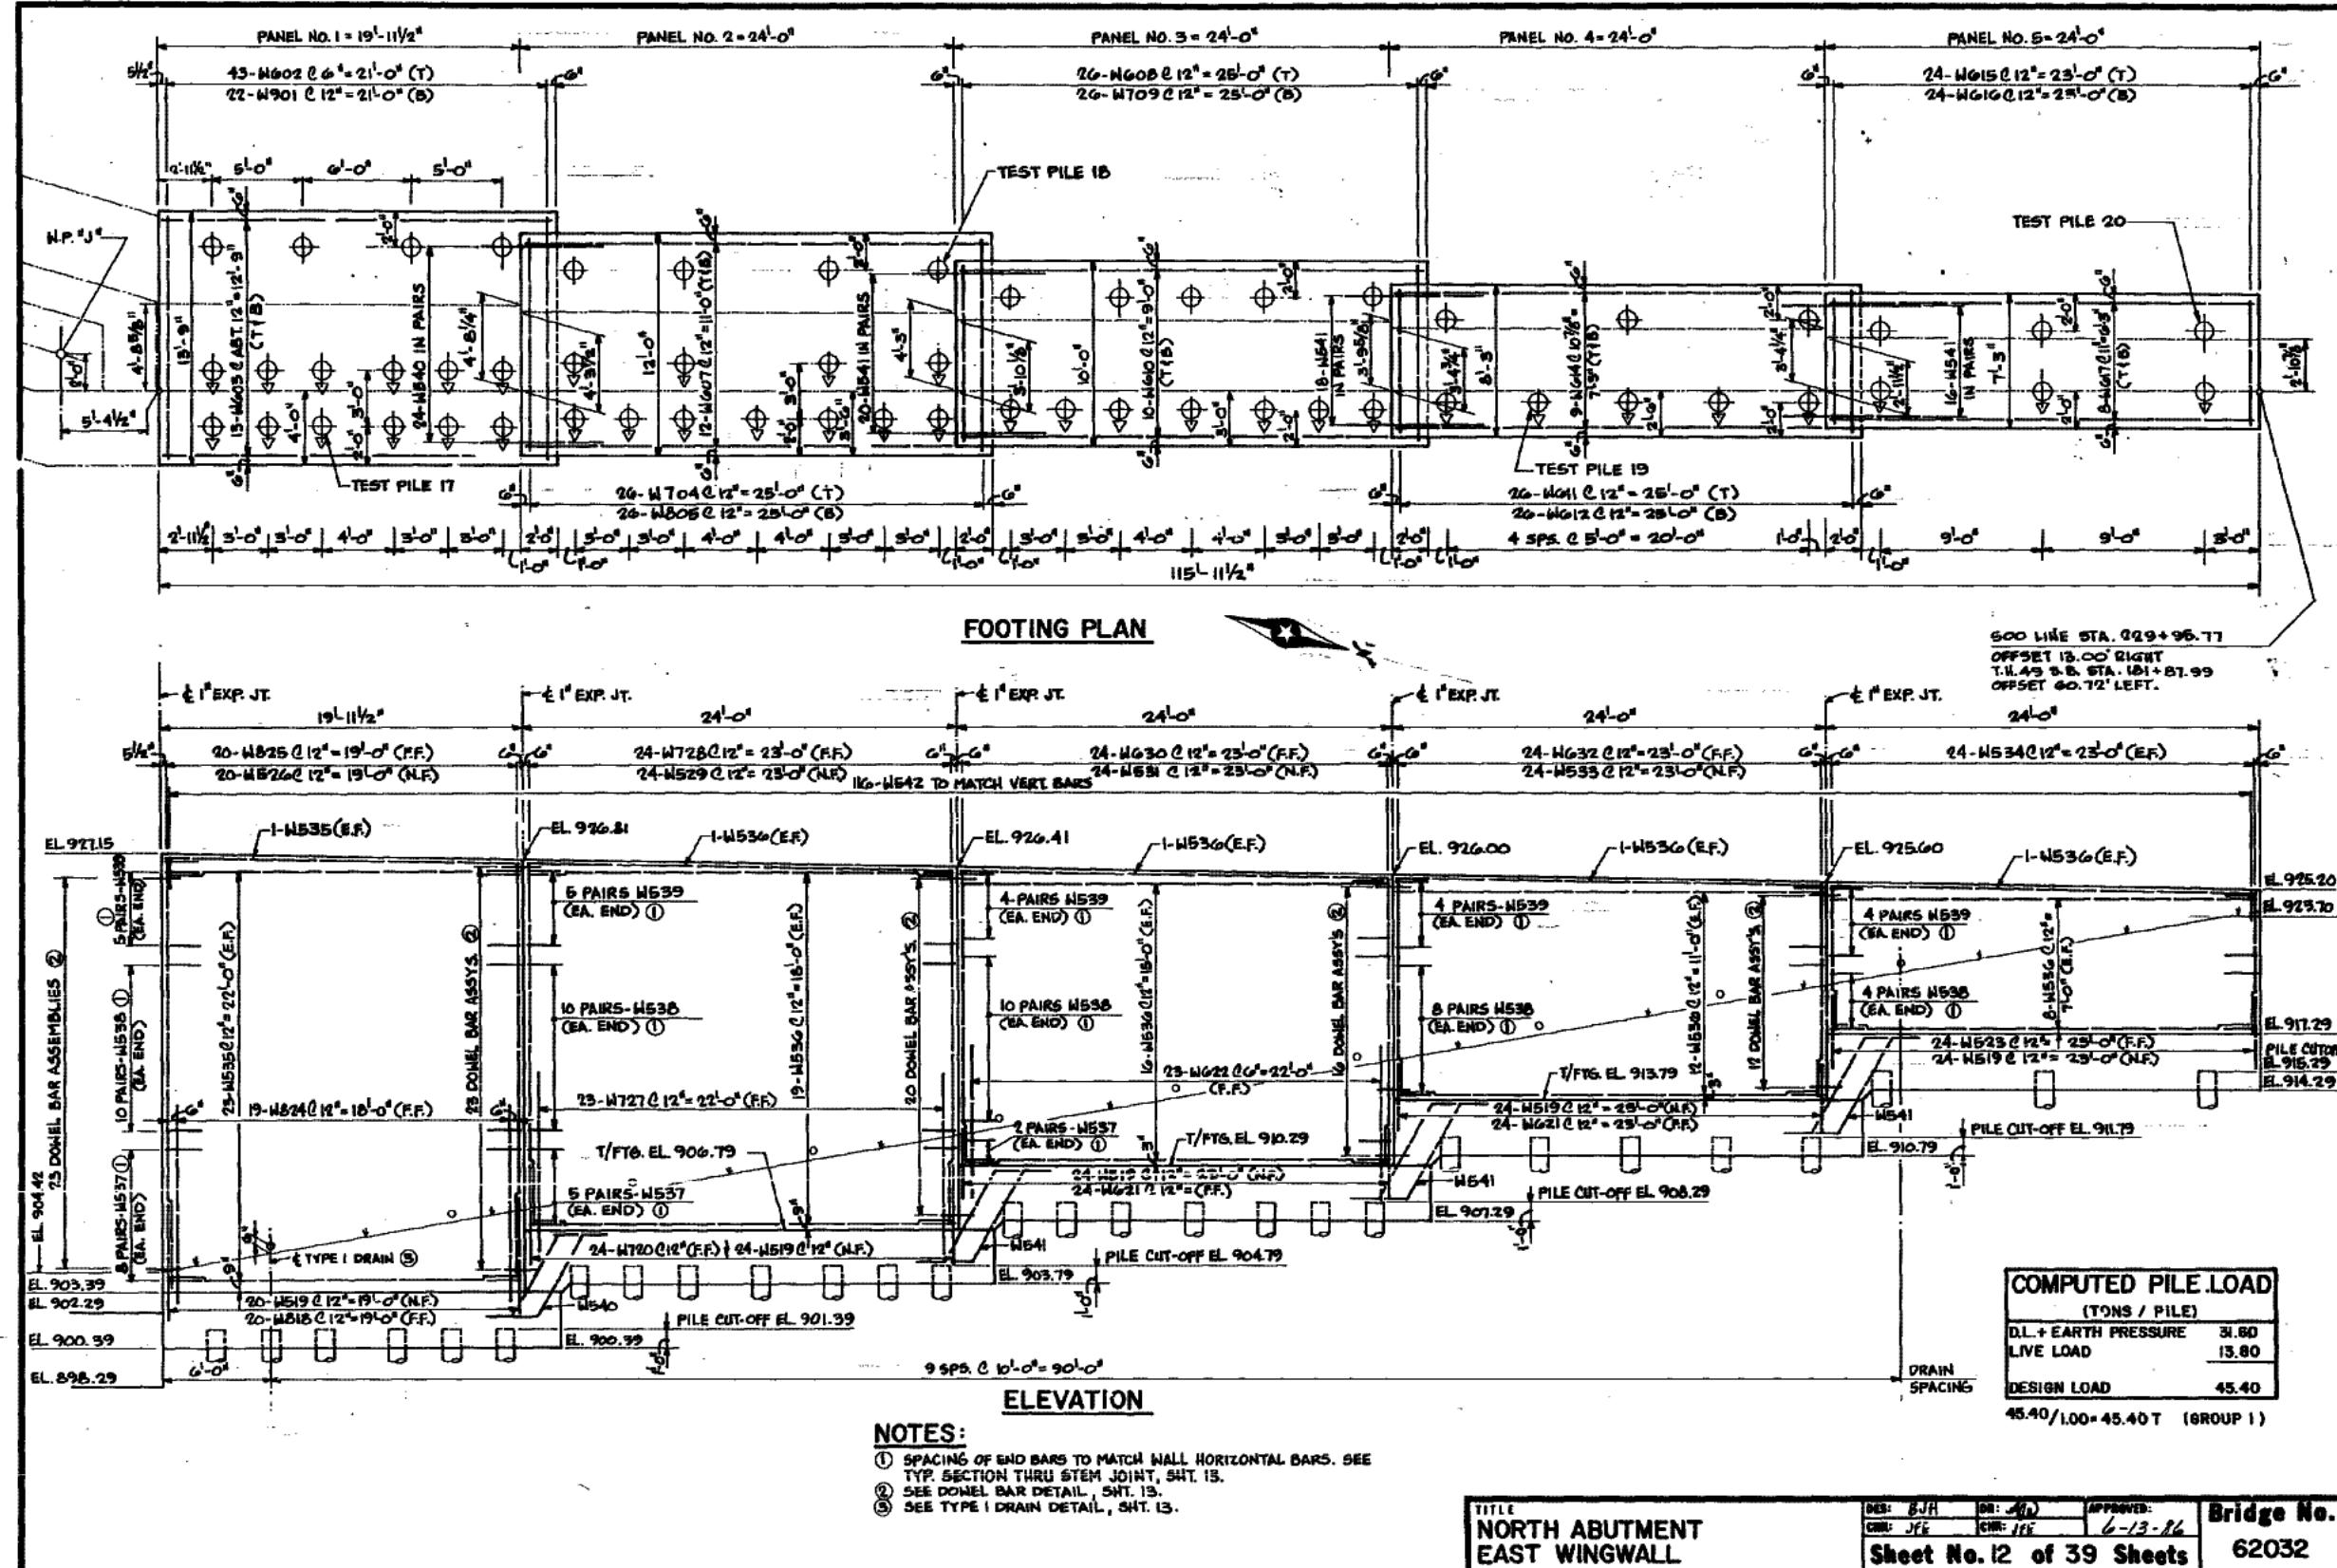


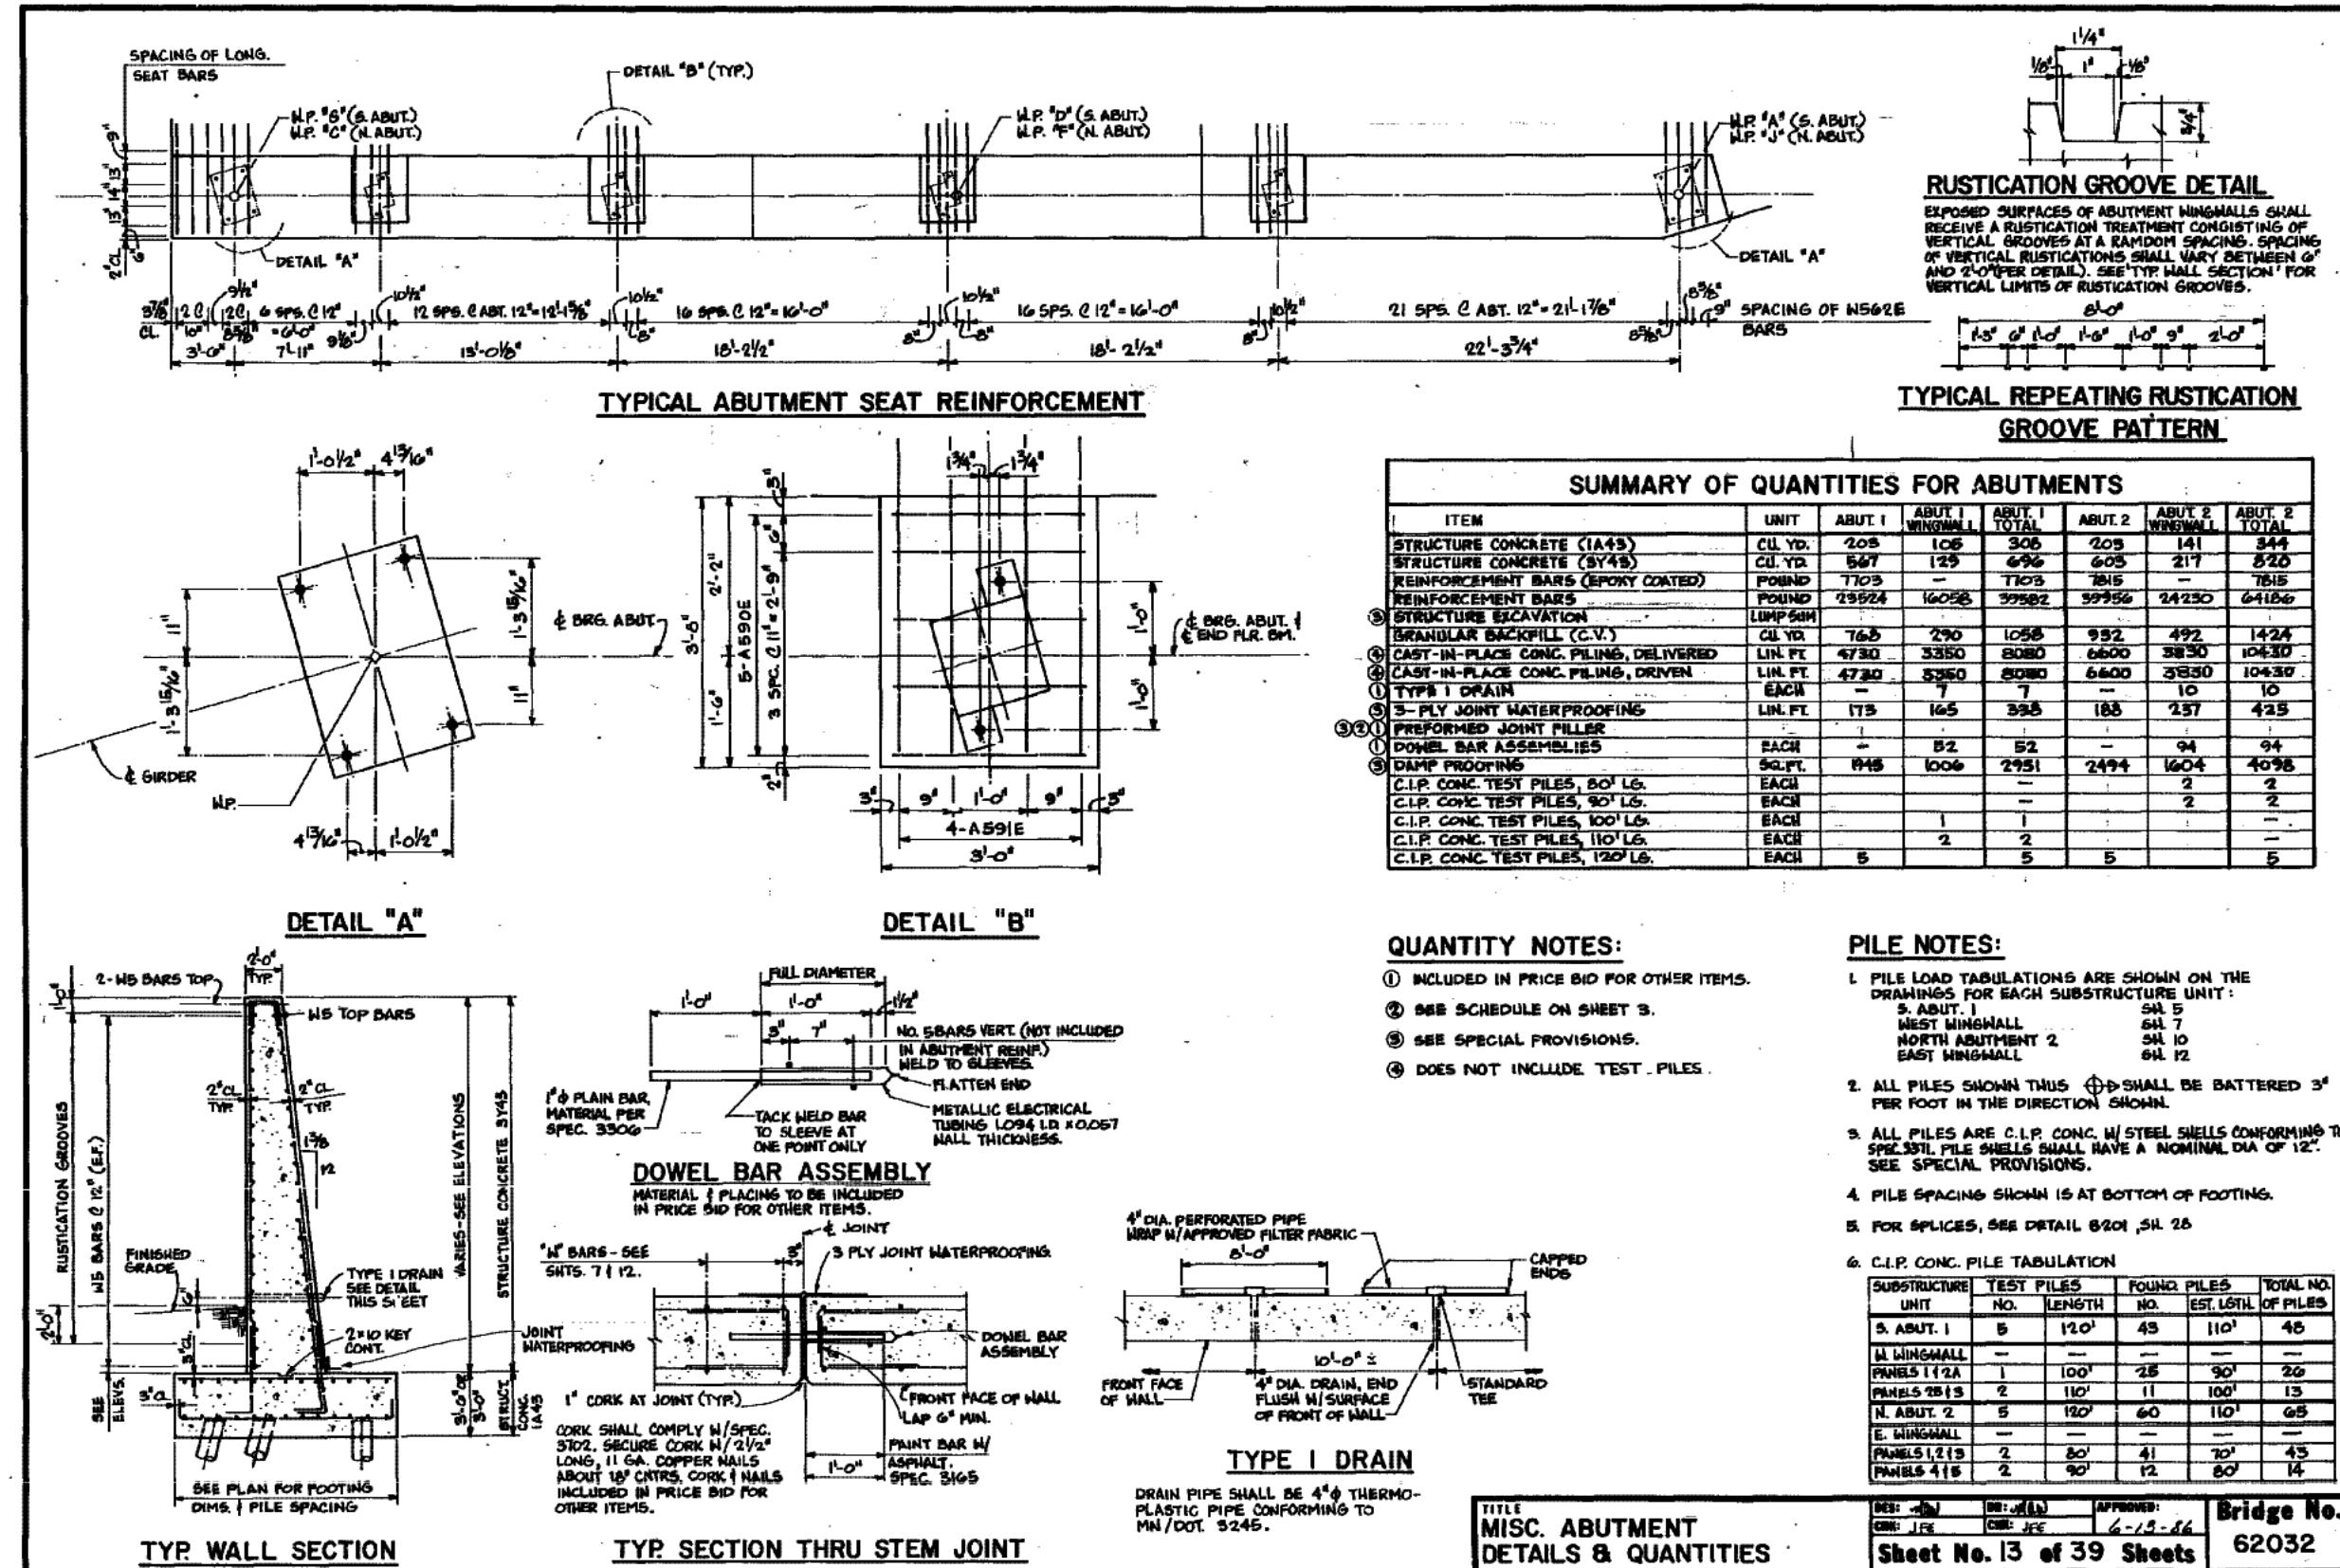

BAR	NO.	LENGTH	TYPE	DIMENSIONS				LOCATION				
				A	B	C	D					
NORTH ABUTMENT												
UNCOATED BARS												
A 901	67	17'- 4"	114	4'- 2"	1'- 7"			TRANS. FTG.				
A 903	1 SER	17'-10"	114	4'- 8"	1'- 7"			TRANS. FTG.				
OF 18	23'- 0"			13'-10"								
A 904	1	18'- 6"	114	5'- 8"	1'- 7"			TRANS. FTG.				
A 705	1	15'- 8"	STR					TRANS. FTG.				
A 906	1	9'- 7"	111	8'- 0"	1'- 7"			TRANS. FTG.				
A 907	1 SER	15'- 8"	114	2'- 6"	1'- 7"			TRANS. FTG.				
OF 6	17'- 2"			18'- 0"								
A 908	1	8'- 0"	STR					TRANS. FTG.				
A 910	1	22'- 0"	114	8'-10"	1'- 7"			TRANS. FTG.				
A 611	1 SER	14'- 8"	STR					TRANS. FTG.				
OF 18	19'-10"											
A 712	67	14'- 2"	STR					TRANS. FTG.				
A 713	1 SER	12'- 6"	STR					TRANS. FTG.				
OF 6	14'- 0"											
A 714	1	18'-10"	STR					TRANS. FTG.				
A 615	15	60'- 0"	111	59'- 0"	1'- 0"			LONGIT. FTG.				
A 616	1 SER	32'- 4"	111	51'- 4"	1'- 0"			LONGIT. FTG.				
OF 13	35'- 9"			34'- 9"								
A 617	2	35'- 0"	111	84'- 0"	1'- 0"			LONGIT. FTG.				
A 619	2	8'-10"	112	5'-10"	3'- 0"	3-1/4		LONGIT. FTG.				
A 620	2	33'- 0"	STR					LONGIT. FTG.				
A 621	1 SER	30'- 4"	STR					LONGIT. FTG.				
OF 13	33'- 9"											
A 622	15	60'- 0"	STR					LONGIT. FTG.				
A 623	1 SER	7'- 0"	111	6'- 0"	1'- 0"			LONGIT. FTG.				
OF 6	24'- 0"	STR	23'- 0"					LONGIT. FTG.				
A 624	1 SER	6'- 0"	STR					LONGIT. FTG.				
OF 6	23'- 0"											
A 925	94	9'- 0"	111	7'- 5"	1'- 7"			FTG. BOWELS				
A 926	60	11'- 7"	111	10'- 3"	1'- 4"			FTG. BOWELS				
A 527	16	4'-10"	111	4'- 0"	0'-10"			FOOTING BOWEL				
A 528	4	18'- 4"	STR					VERT. WALL				
A 529	8	24'- 5"	STR					VERT. WALL				
A 530	2 SER	7'- 1"	STR					VERT. WALL				
OF 19	28'- 1"											
A 531	2	22'- 4"	113	2'- 0"	20'- 4"	5		DIAG. WALL				
A 532	2	22'- 2"	118	2'- 0"	18'- 2"	2'- 0"	6-5/8	DIAG. WALL				
A 533	1 SER	2'- 6"	STR					HORIZ. WALL				
OF 5	12'- 0"											
A 534	1	16'- 6"	STR					HORIZ. WALL				
A 535	8	18'- 9"	STR					HORIZ. WALL				
A 536	1 SER	2'-10"	STR					HORIZ. WALL				
OF 9	17'- 2"											
A 837	1 SER	4'- 6"	STR					HORIZ. WALL				
OF 22	18'- 3"											
A 838	23	18'- 9"	STR					HORIZ. WALL				
A 639	1 SER	3'- 8"	STR					HORIZ. WALL				
OF 8	12'- 0"											
A 940	97	17'- 7"	111	16'- 0"	1'- 7"			FTG. BOWEL				
A 941	25	24'- 5"	STR					VERT. BACKWALL				
A 942	27	23'- 0"	STR					VERT. BACKWALL				
A 943	45	22'- 0"	STR					VERT. BACKWALL				
A 544	23	16'- 0"	113	13'- 6"	2'- 6"	3-1/2		HORIZ. BACKWALL				
A 545	23	13'- 6"	111	11'- 0"	2'- 6"			HORIZ. BACKWALL				
A 546	23	20'- 6"	STR					HORIZ. BACKWALL				
A 547	23	32'- 6"	STR					HORIZ. BACKWALL				
A 648	23	6'- 6"	STR					HORIZ. BACKWALL				
A 549	23	10'- 0"	STR					HORIZ. BACKWALL				
A 550	23	18'- 6"	STR					HORIZ. BACKWALL				
A 551	1	14'- 7"	STR					HORIZ. WALL				
A 552	18	5'- 0"	114	1'-54"	1'- 9"			TOP				
A 553	1 SER	3'- 0"	STR					WEDGE TOP				
OF 30	11'- 3"											
A 554	1 SER	7'- 6"	STR					WEDGE TOP				
OF 4	18'- 3"											
A 555	5	20'- 8"	STR					WEDGE TOP				
A 556	1 SER	6'- 6"	STR					WEDGE TOP				
OF 5	19'- 6"											
A 657	9	7'- 3"	111	6'- 3"	1'- 0"			W. WALL HORIZ.				
A 858	53	9'- 4"	111	8'- 0"	1'- 0"			W. WALL HORIZ.				
A 859	1 SER	13'- 2"	STR					W. WALL HORIZ.				
OF 3	17'- 7"											
A 560	17	10'- 1"	STR					W. WALL HORIZ.				
A 586	5	5'- 7"	STR					W. WALL HORIZ.				
A 587	2	5'- 4"	112	3'- 4"	2'- 0"			W. WALL HORIZ.				
NORTH ABUTMENT												
EPOXY COATED												
A 561E	90	5'-10"	111	5'- 0"	0'-10"			FOOTING DOME				
A 562E	86	18'- 5"	STR					VERT. WALL				
A 563E	4	24'- 6"	STR					VERT. WALL				
A 504E	1	29'- 3"	STR	24'- 6"				SEAT HORIZ.				
A 565E	23	4'- 0"	111	2'- 0"	2'- 0"			CORNER				
A 566E	28	34'- 3"	STR					HORIZ. WALL				
A 567E	19	28'- 0"						HORIZ. WALL				
A 568E	20	11'- 5"	115	1'- 8"	7'- 3"	2'- 6"		VERT. BACKWALL				
A 569E	4	12'-11"	115	3'- 5"	7'- 0"	2'- 6"		VERT. BACKWALL				
A 570E	1	15'- 8"	115	6'- 2"	7'- 0"	2'- 6"		VERT. BACKWALL				
A 571E	64	10'- 2"	115	1'- 8"	5'- 0"	2'- 6"		VERT. BACKWALL				
A 572E	3	6'- 9"	111	4'- 3"	2'- 6"			CORNER				
A 573E	19	13'- 6"	116	6'- 7"	4'- 5"	2'- 6"	3-1/2	HORIZ. CORNER				
A 524E	6	10'- 6"	114	2'- 6"	4'- 0"			BACKWALL				
A 575E	1	15'- 6"	STR					HORIZ. BACKWALL				
A 576E	1	21'- 0"	STR					HORIZ. BACKWALL				
A 577E	4	31'- 4"	STR					HORIZ. BACKWALL				
A 578E	30	24'- 6"	STR					HORIZ. WALL				
A 579E	6	32'- 4"	STR					HORIZ. BACKWALL				
A 683E	7	8'- 6"	112	2'- 0"	6'- 6"	12		FILLET				
A 584E	1	14'- 6"	115	8'-11"	7'- 0"	2'- 6"		BACKWALL VERT.				
A 585E	3	12'- 1"	115	2'- 7"	7'- 0"	2'- 6"		BACKWALL VERT.				
NORTH ABUTMENT EAST WINGWALL												
UNCOATED BARS												
W 901	22	16'- 5"	114	13'- 3"	1'- 7"			TRANS. FTG.				
W 502	43	13'- 3"	STR					TRANS. FTG.				
W 503	28	19'- 7"	STR					LONGIT. FTG.				
W 704	26	11'- 6"	STR					TRANS. FTG.				
W 805	26	13'-10"	114	11'- 6"	1'- 2"			TRANS. FTG.				
W 606	24	25										

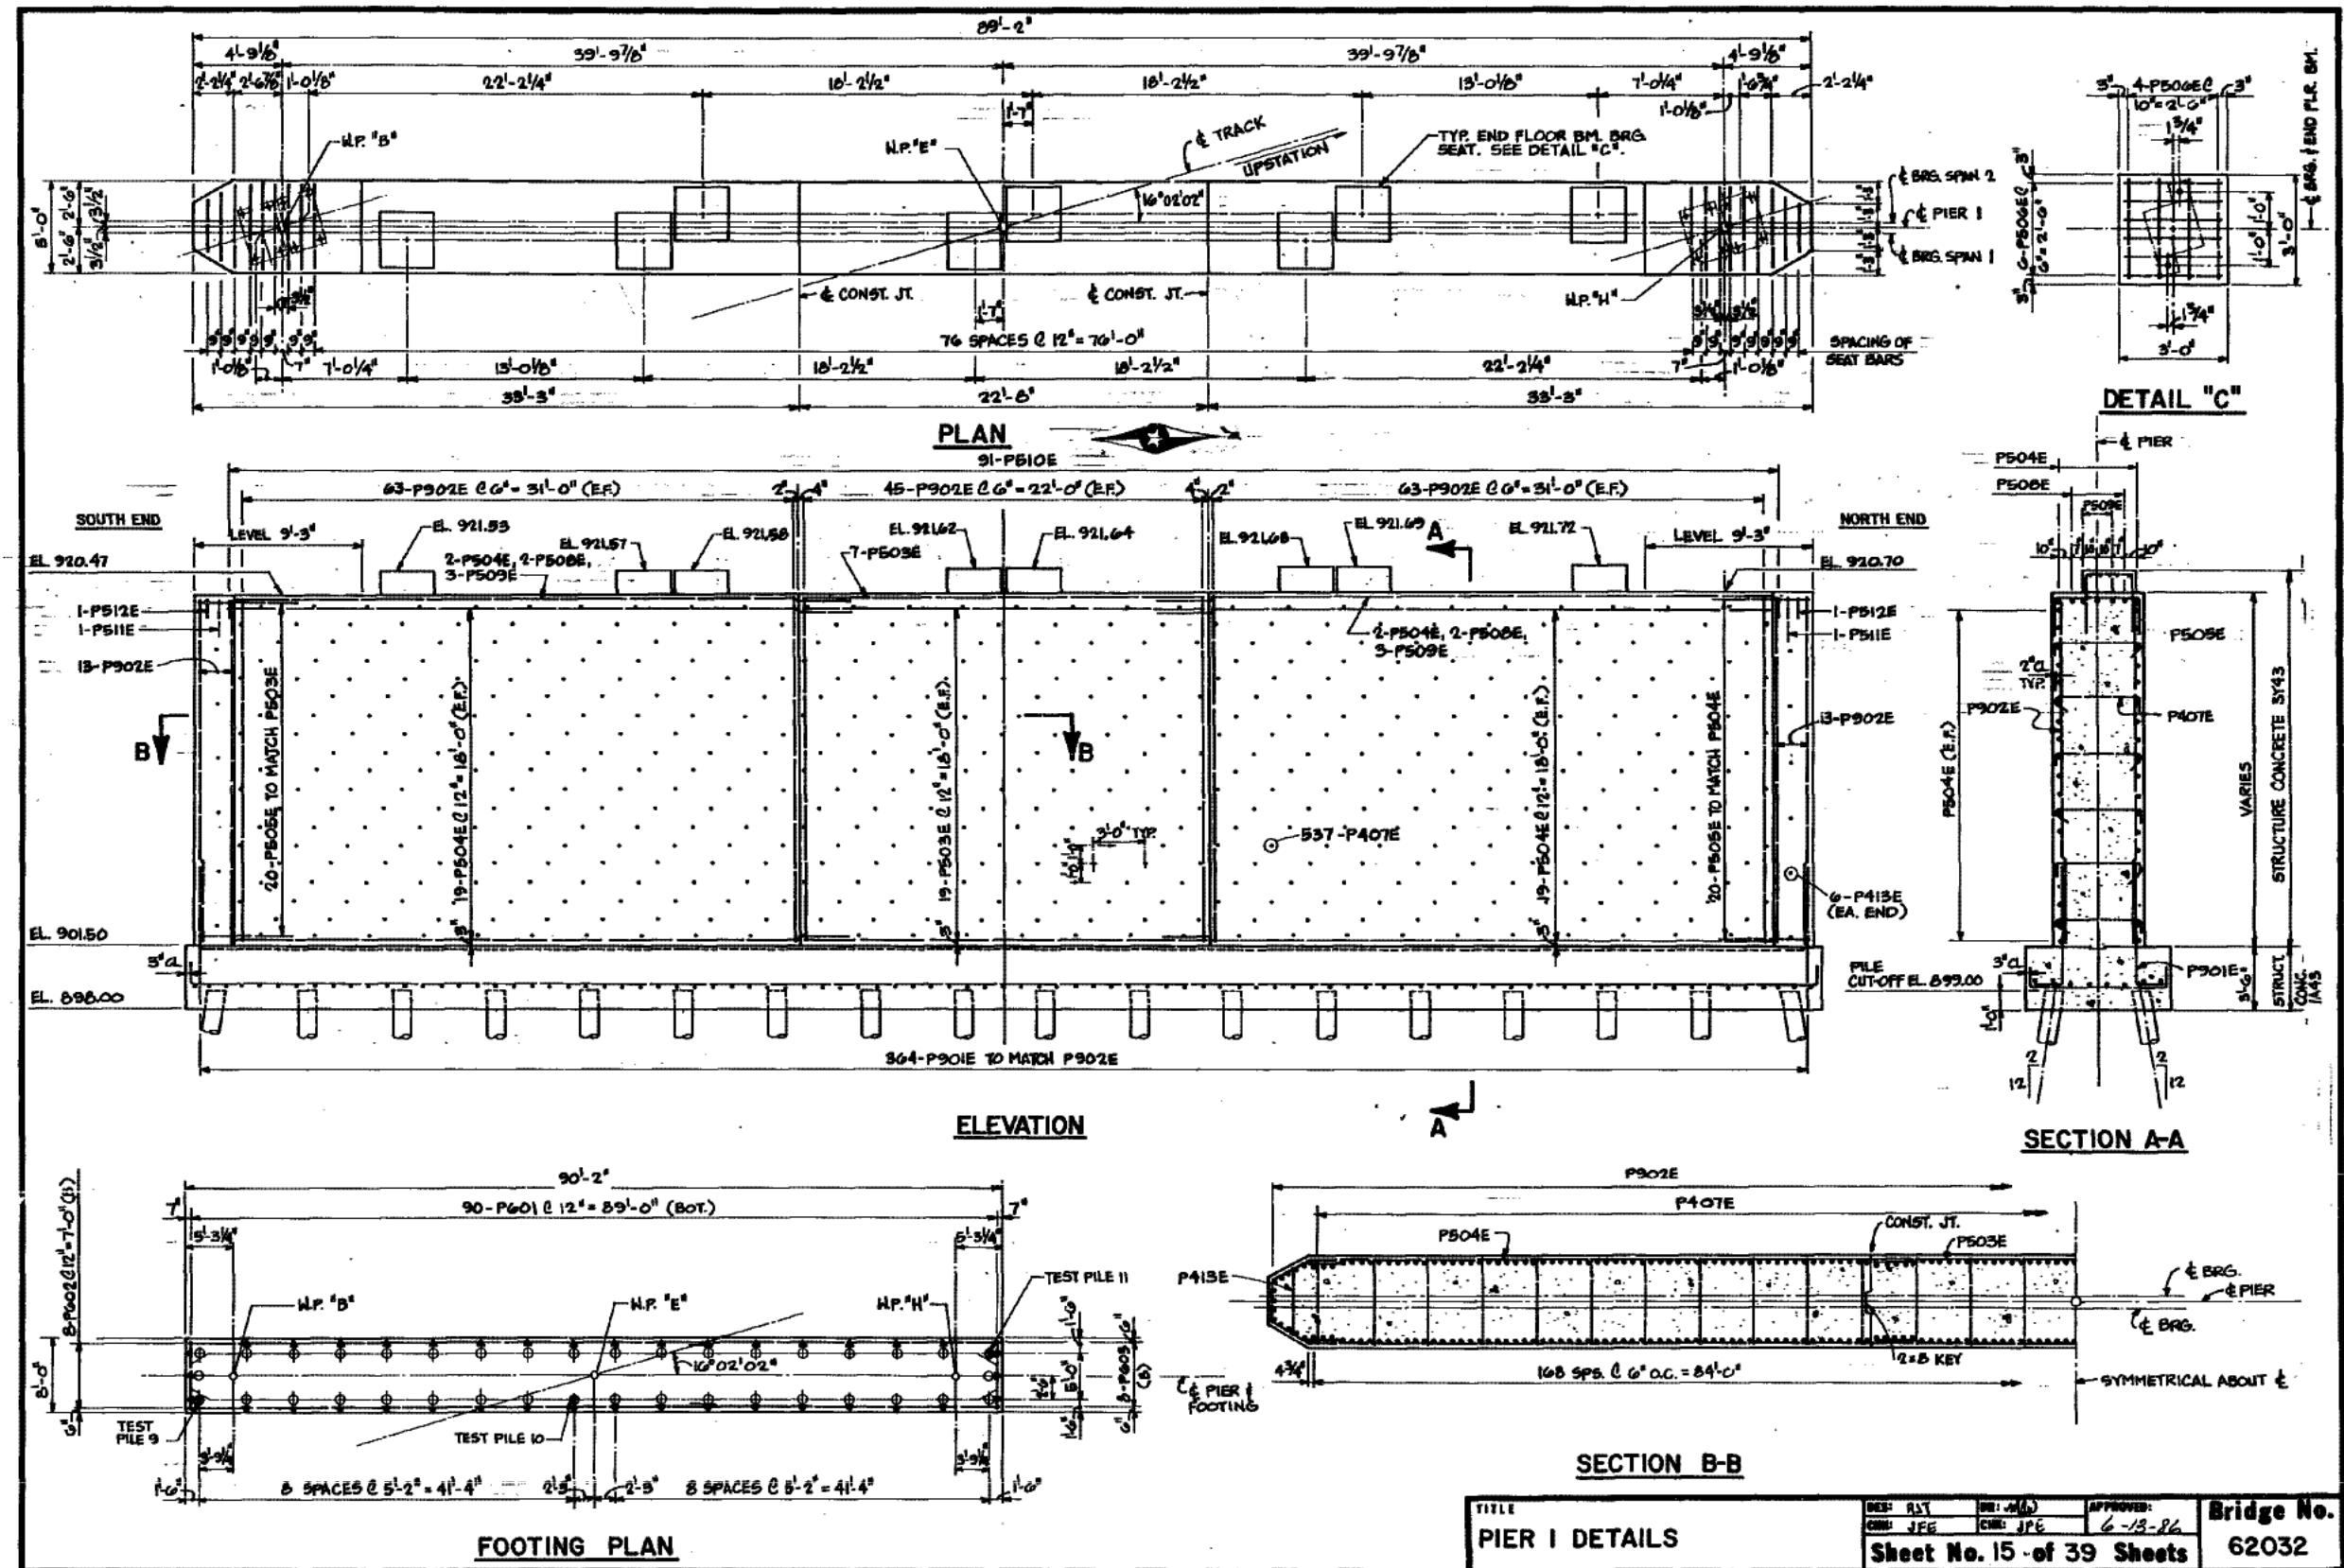

BAR	NO.	LENGTH	IN. FT.	DIMENSIONS				LOCATION				
				A	B	C	D					
PIER												
UNCOATED BARS												
P 601	90	9'- 6"		114	7'- 6"	1'- 0"		TRANS. FTG.				
P 602	8	60'- 0"		111	59'- 0"	1'- 0"		LONGIT. FTG.				
P 603	8	35'- 6"		111	32'- 6"	1'- 0"		LONGIT. FTG.				
EOXY COATED												
P 501E	364	8'- 5"		111	6'-10"	1'- 7"		FOOTING DOMELS				
P 502E	364	18'- 9"		STR				VERT. SHAFT				
P 503E	85	22'- 4"		STR				HORIZ. SHAFT				
P 504E	80	32'-10"		STR				HORIZ. SHAFT				
P 505E	40	10'-11"		201	2'- 3"	2'- 4"	2'- 0"	6-7/8 END HORIZ.				
P 506E	80	8'- 8"		114	2'- 8"	3'- 0"		BRG. SEAT				
P 507E	537	5'- 9"		107	4'- 8"			TIES SHAFT				
P 508E	4	34'- 4"		STR				BRG. SEAT				
P 509E	6	34'- 9"		STR				BRG. SEAT				
P 510E	89	7'- 2"		114	4'- 8"	1'- 3"		SEAT TRANS.				
P 511E	2	6'- 4"		114	3'-10"	1'- 3"		SEAT TRANS.				
P 512E	2	5'- 5"		114	2'-11"	1'- 3"		SEAT TRANS.				
P 413E	12	4'- 9"		107	3'-8"			TIES SHAFT				

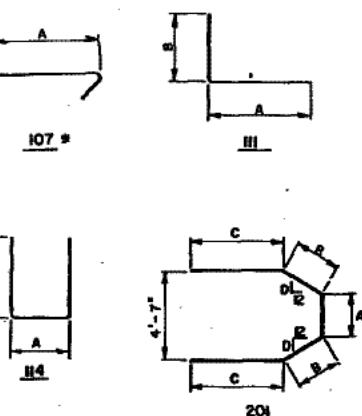BAR BENDING DIAGRAMS:

* BAR TYPE USES STANDARD STIRRUP AND TIE HOOKS.

NOTE:

BENT BAR DIMENSIONS GIVEN ARE OUT-TO-OUT. ACTUAL BAR LENGTHS SHALL BE DETERMINED BASED ON DETAIL DIMENSIONS SHOWN IN THE BAR BENDING DIAGRAMS. TOTAL BAR LENGTHS SHOWN ARE FOR USE IN COMPUTING REINFORCEMENT BAR WEIGHTS FOR PAYMENT ONLY.

SUMMARY OF QUANTITIES FOR PIERS

ITEM	UNIT	QUANTITY
STRUCTURE CONCRETE 1A43	CU. YD.	94
STRUCTURE CONCRETE 3Y43	CU. YD.	34
REINFORCEMENT BARS	POUND	2408
REINFORCEMENT BARS (EPOXY COATED)	POUND	41740
① C.I.P. CONCRETE PILING DELIVERED	LIN. FT.	4025
② C.I.P. CONCRETE PILING DRIVEN	LIN. FT.	4025
③ C.I.P. CONCRETE TEST PILES 120 FT. LG.	EACH	5
④ STRUCTURE EXCAVATION	LUMPSUM	

QUANTITY NOTES:

⑤ SEE SPECIAL PROVISIONS


⑥ DOES NOT INCLUDE TEST PILES.

PILE NOTES:


PILE SPACING SHOWN IS AT BOTTOM OF FOOTING.
PILE TO HAVE A NOMINAL DIAM. OF 12".
3 12" CAST IN PLACE CONC. TEST PILES 120 LONG.
35 12" CAST IN PLACE CONC. TEST PILES EST. LENGTH
105".
36 12" CAST IN PLACE CONC. PILES REQ'D FOR PIER.
PILES MARKED TO BE BATTERED 2" PER
FT. IN DIRECTION SHOWN OR AS DIRECTED BY THE
ENGINEER IN THE FIELD.


COMPUTED PILE LOAD (TONS / PILE)	
D.L.	34.90
LIVE LOAD	19.70
OVERTURNING	17.90
DESIGN LOAD	72.50


72.50/1.25 = 56 TONS AREA GR. III

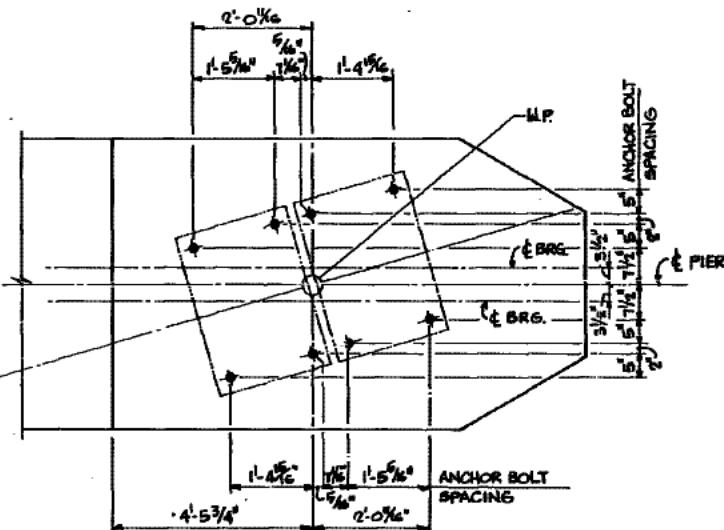
**ANCHOR BOLT LAYOUT FOR
FIXED BRG. ASSYS. AT PIER****PIER BAR LIST & QUANTITIES**


Date: 5/17 Draw: Jim R/rd/sig Approved:
Chk: J/P/S Chk: J/P/S 6-18-86 Bridge No.
Sheet No. 16 of 39 Sheets 62032

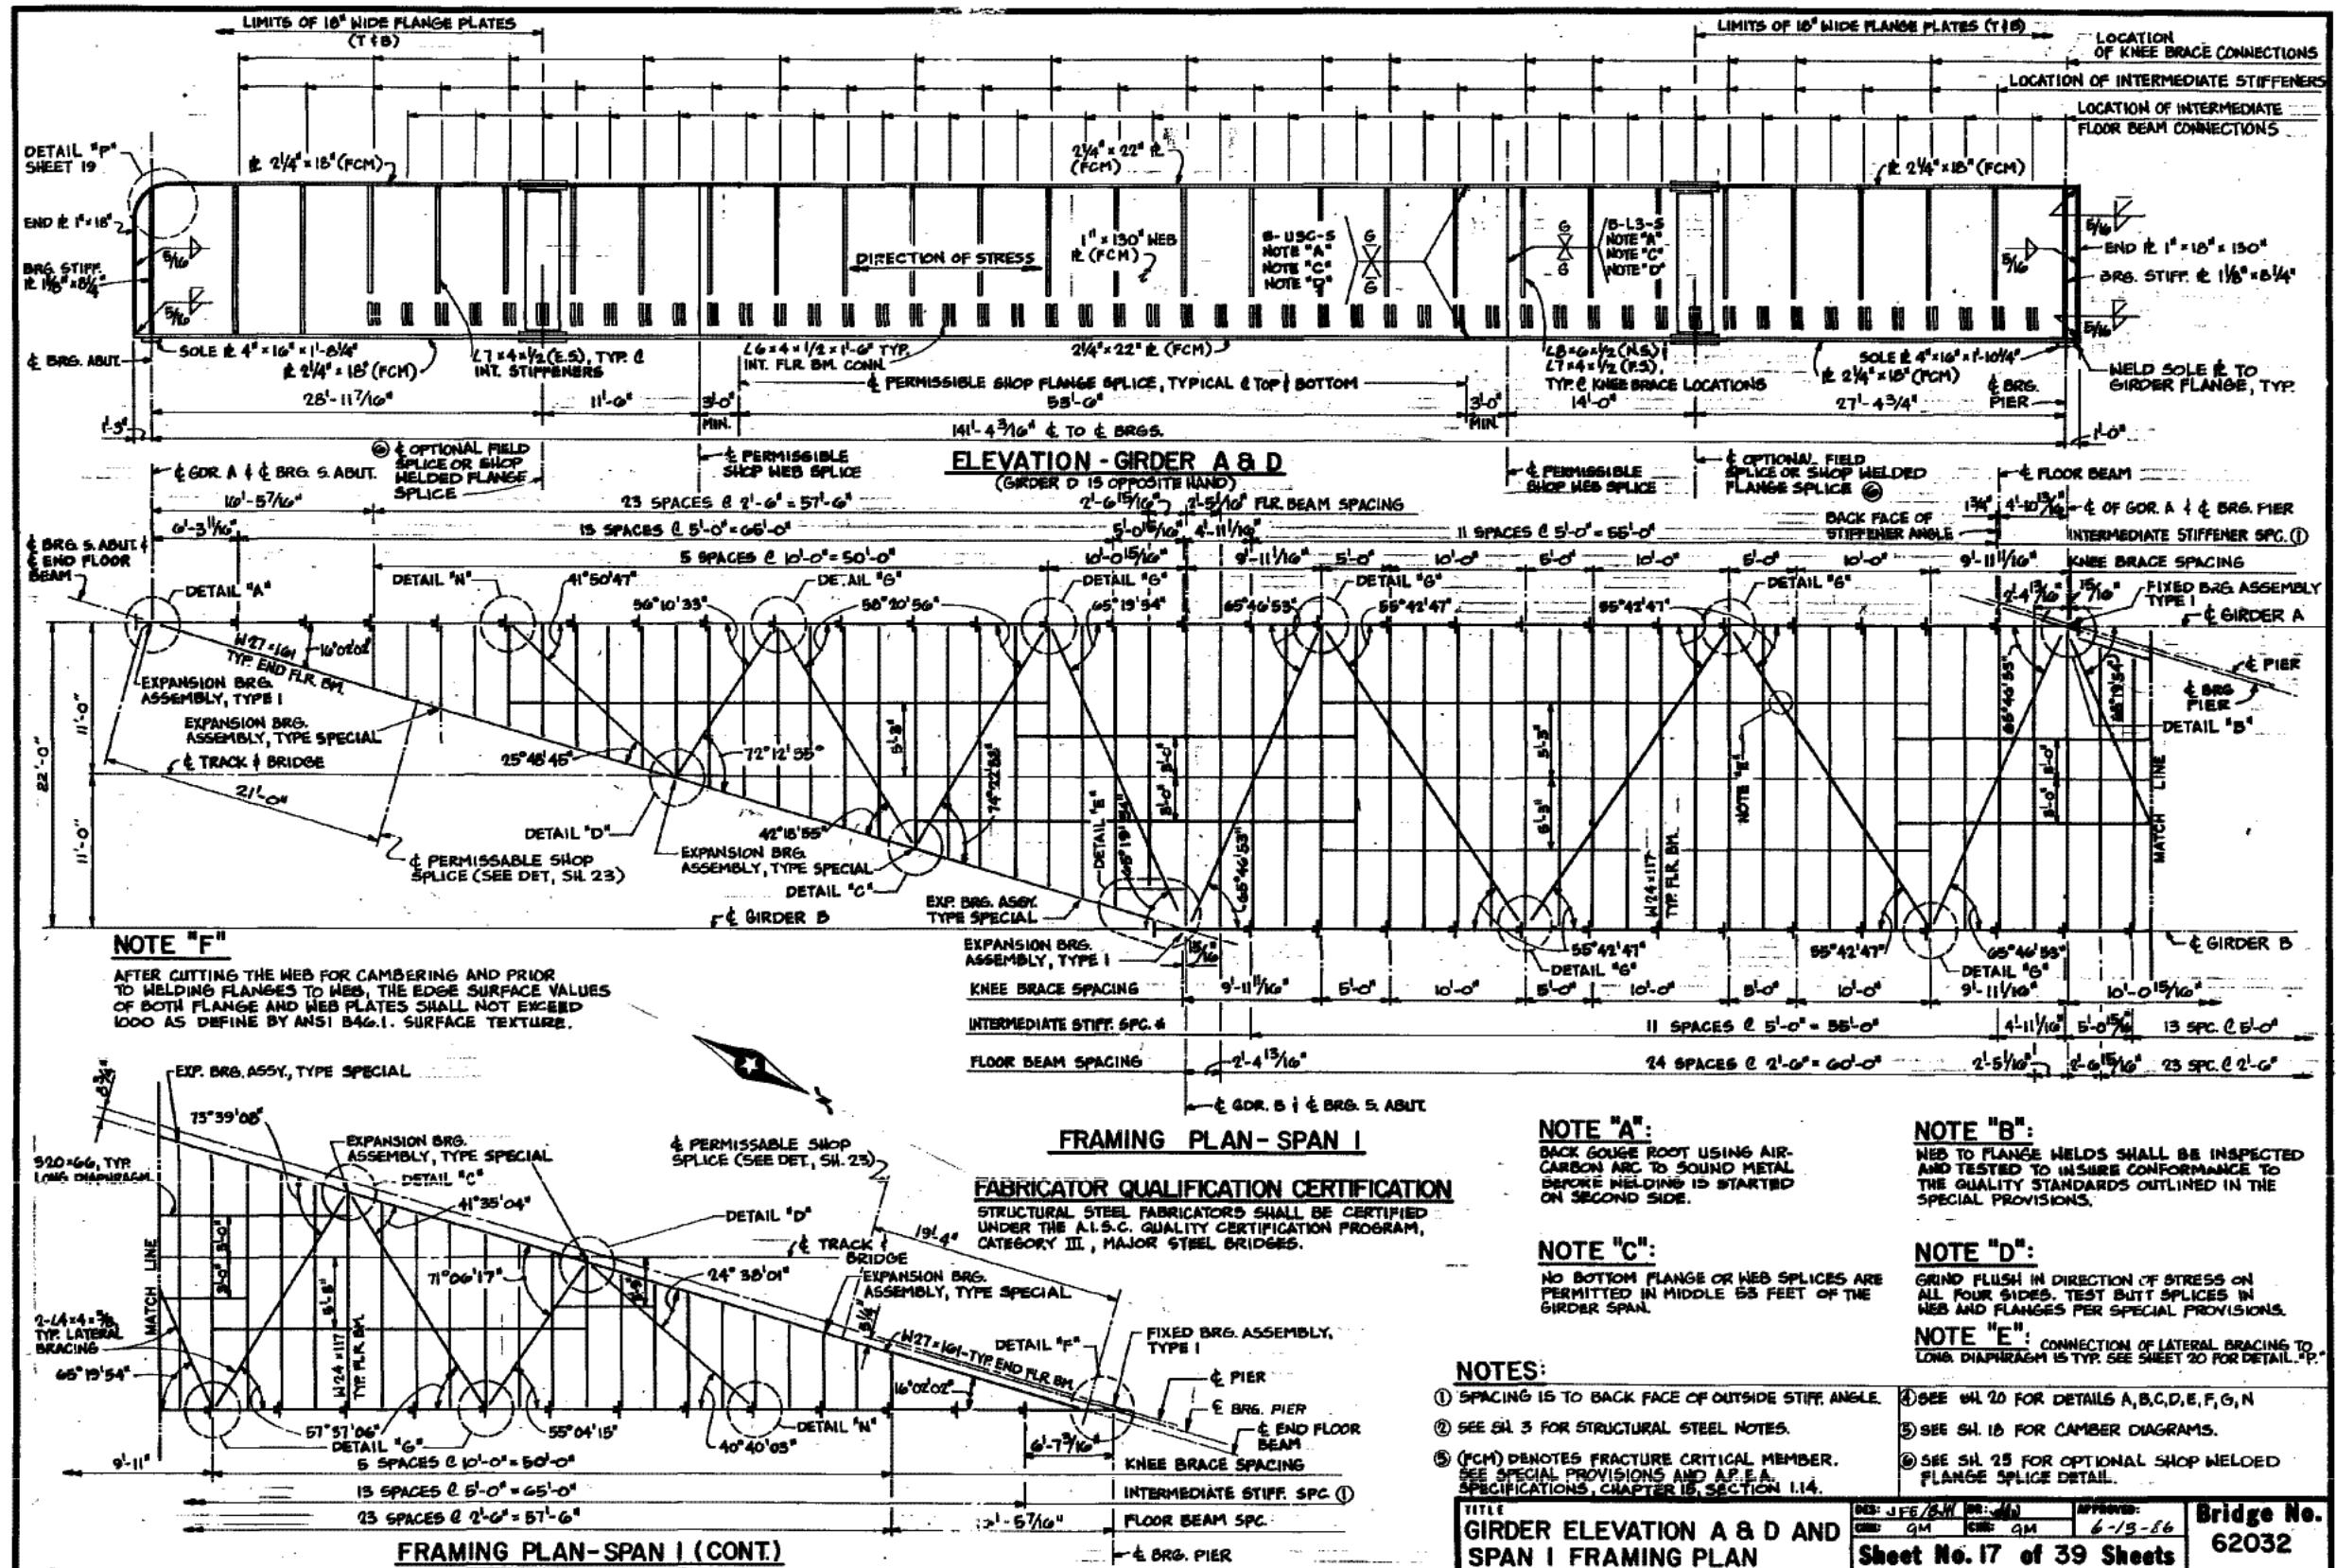

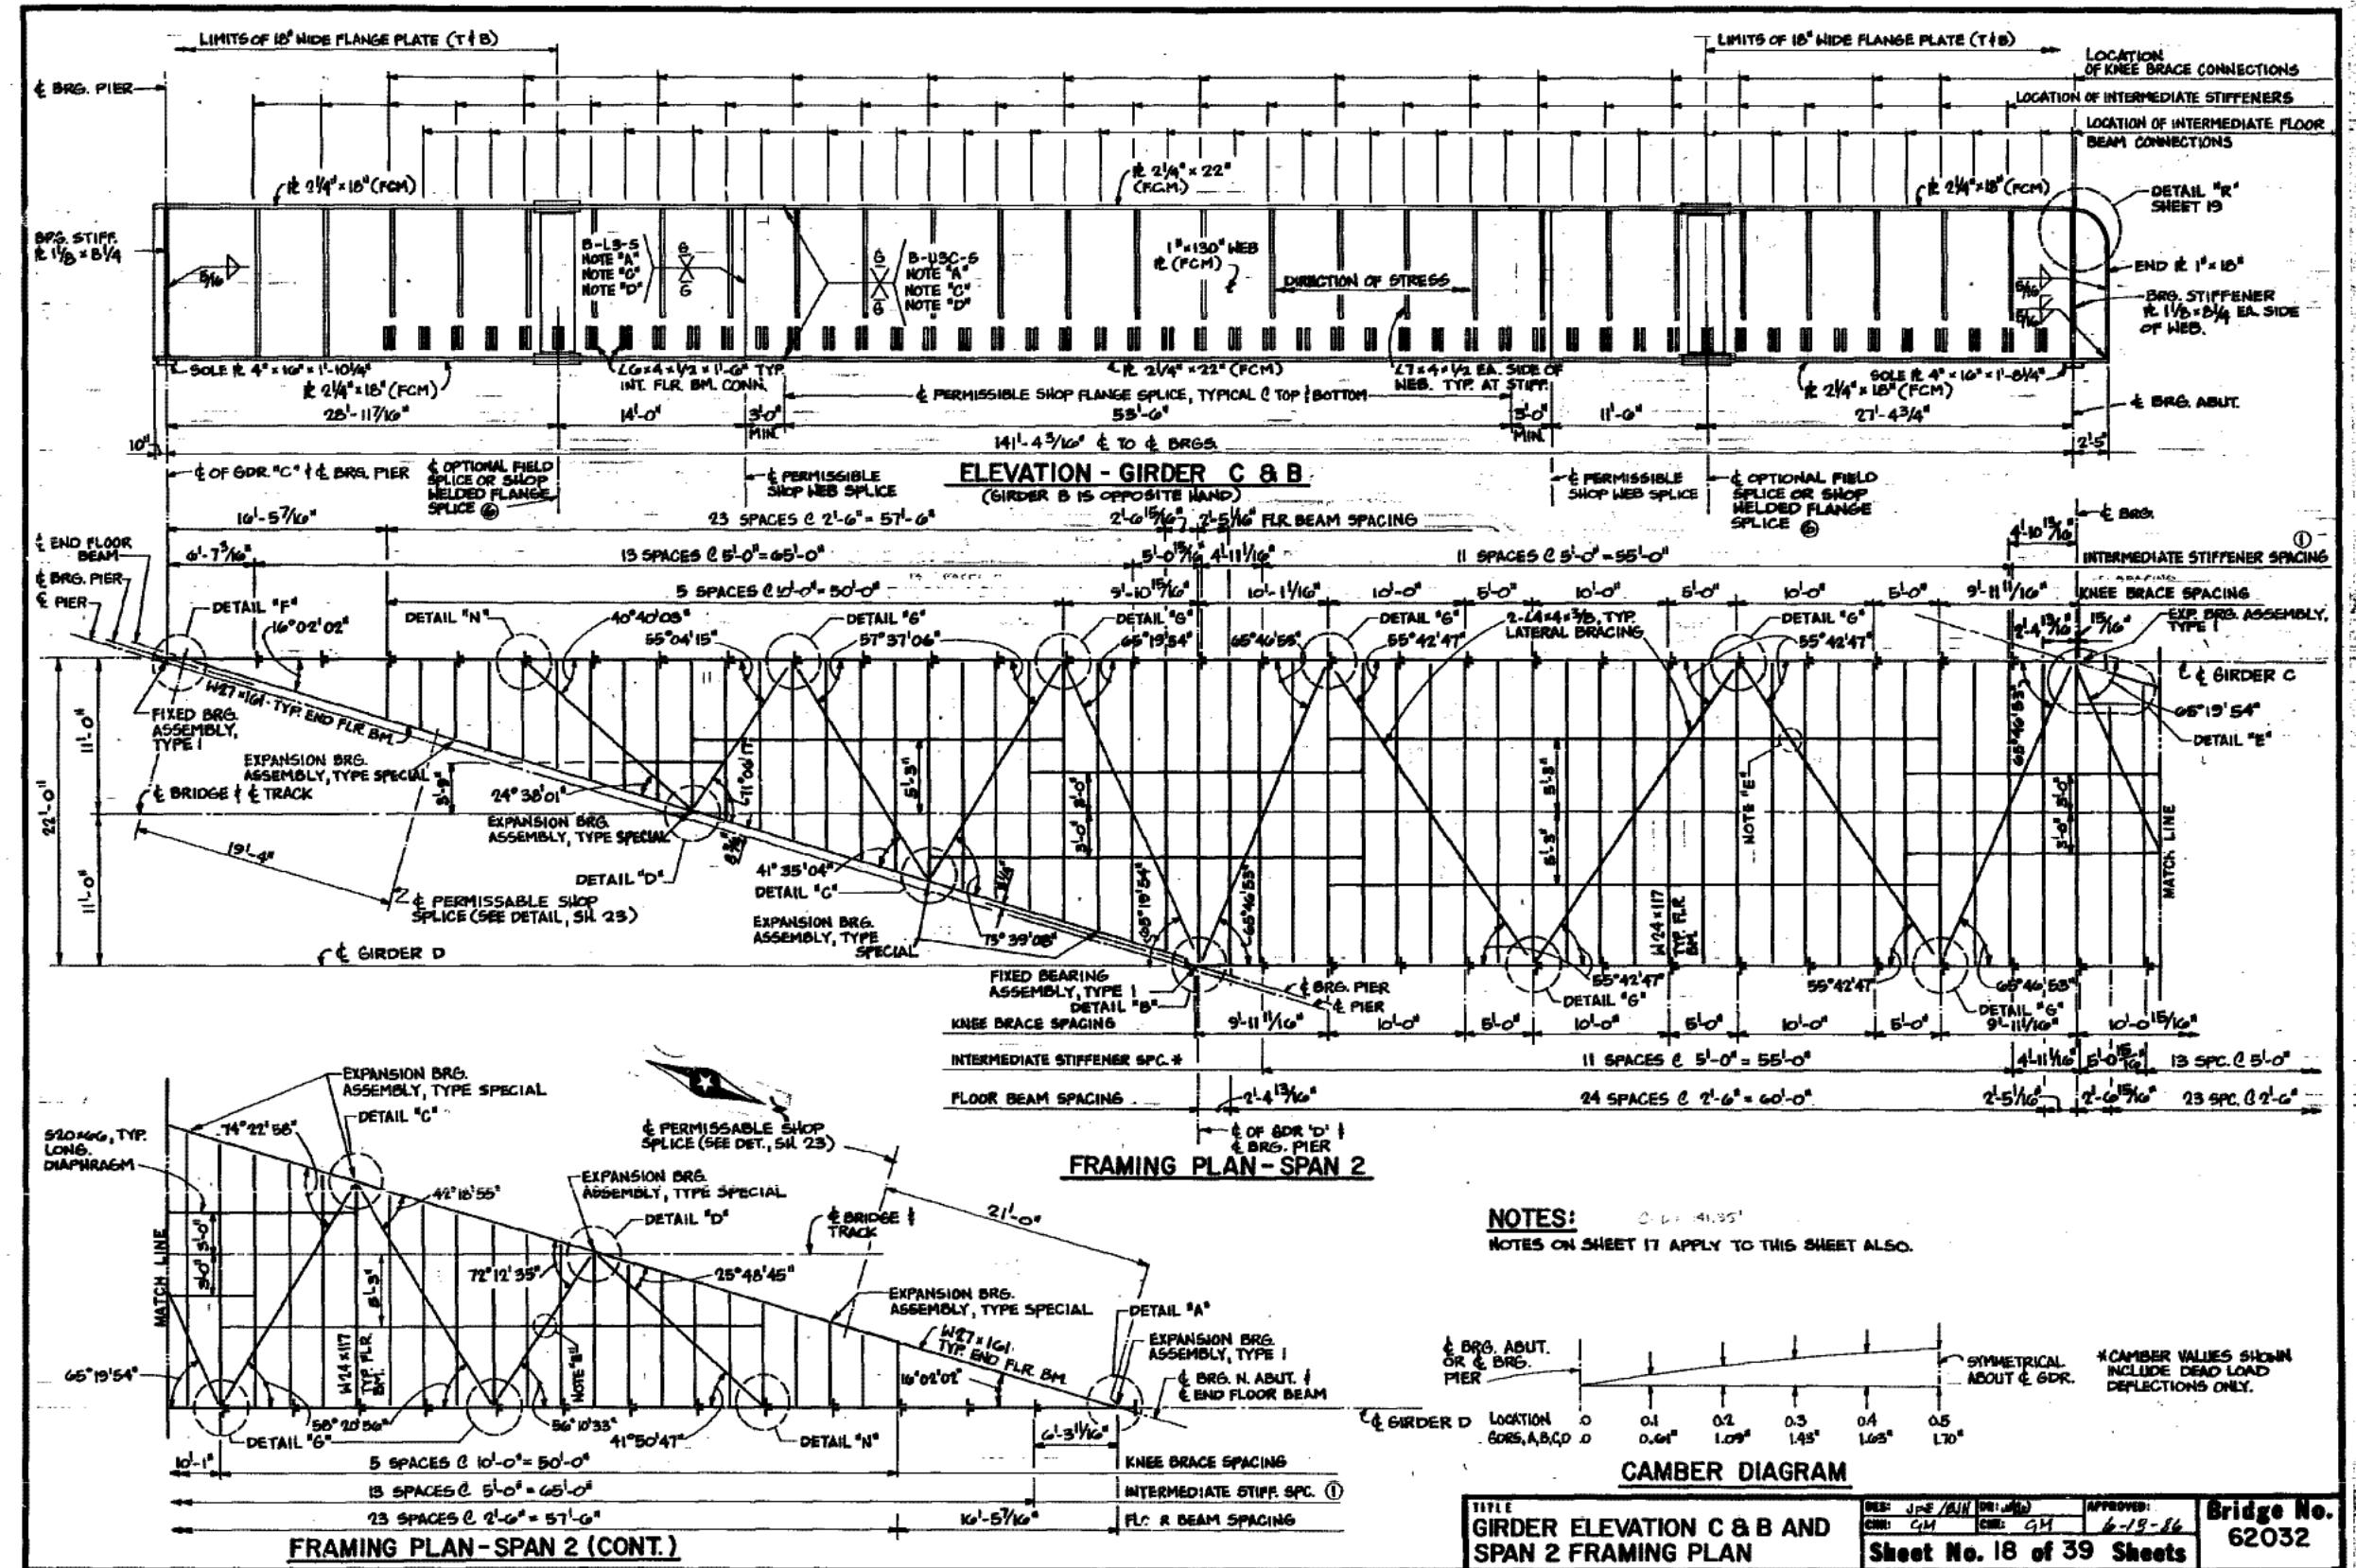


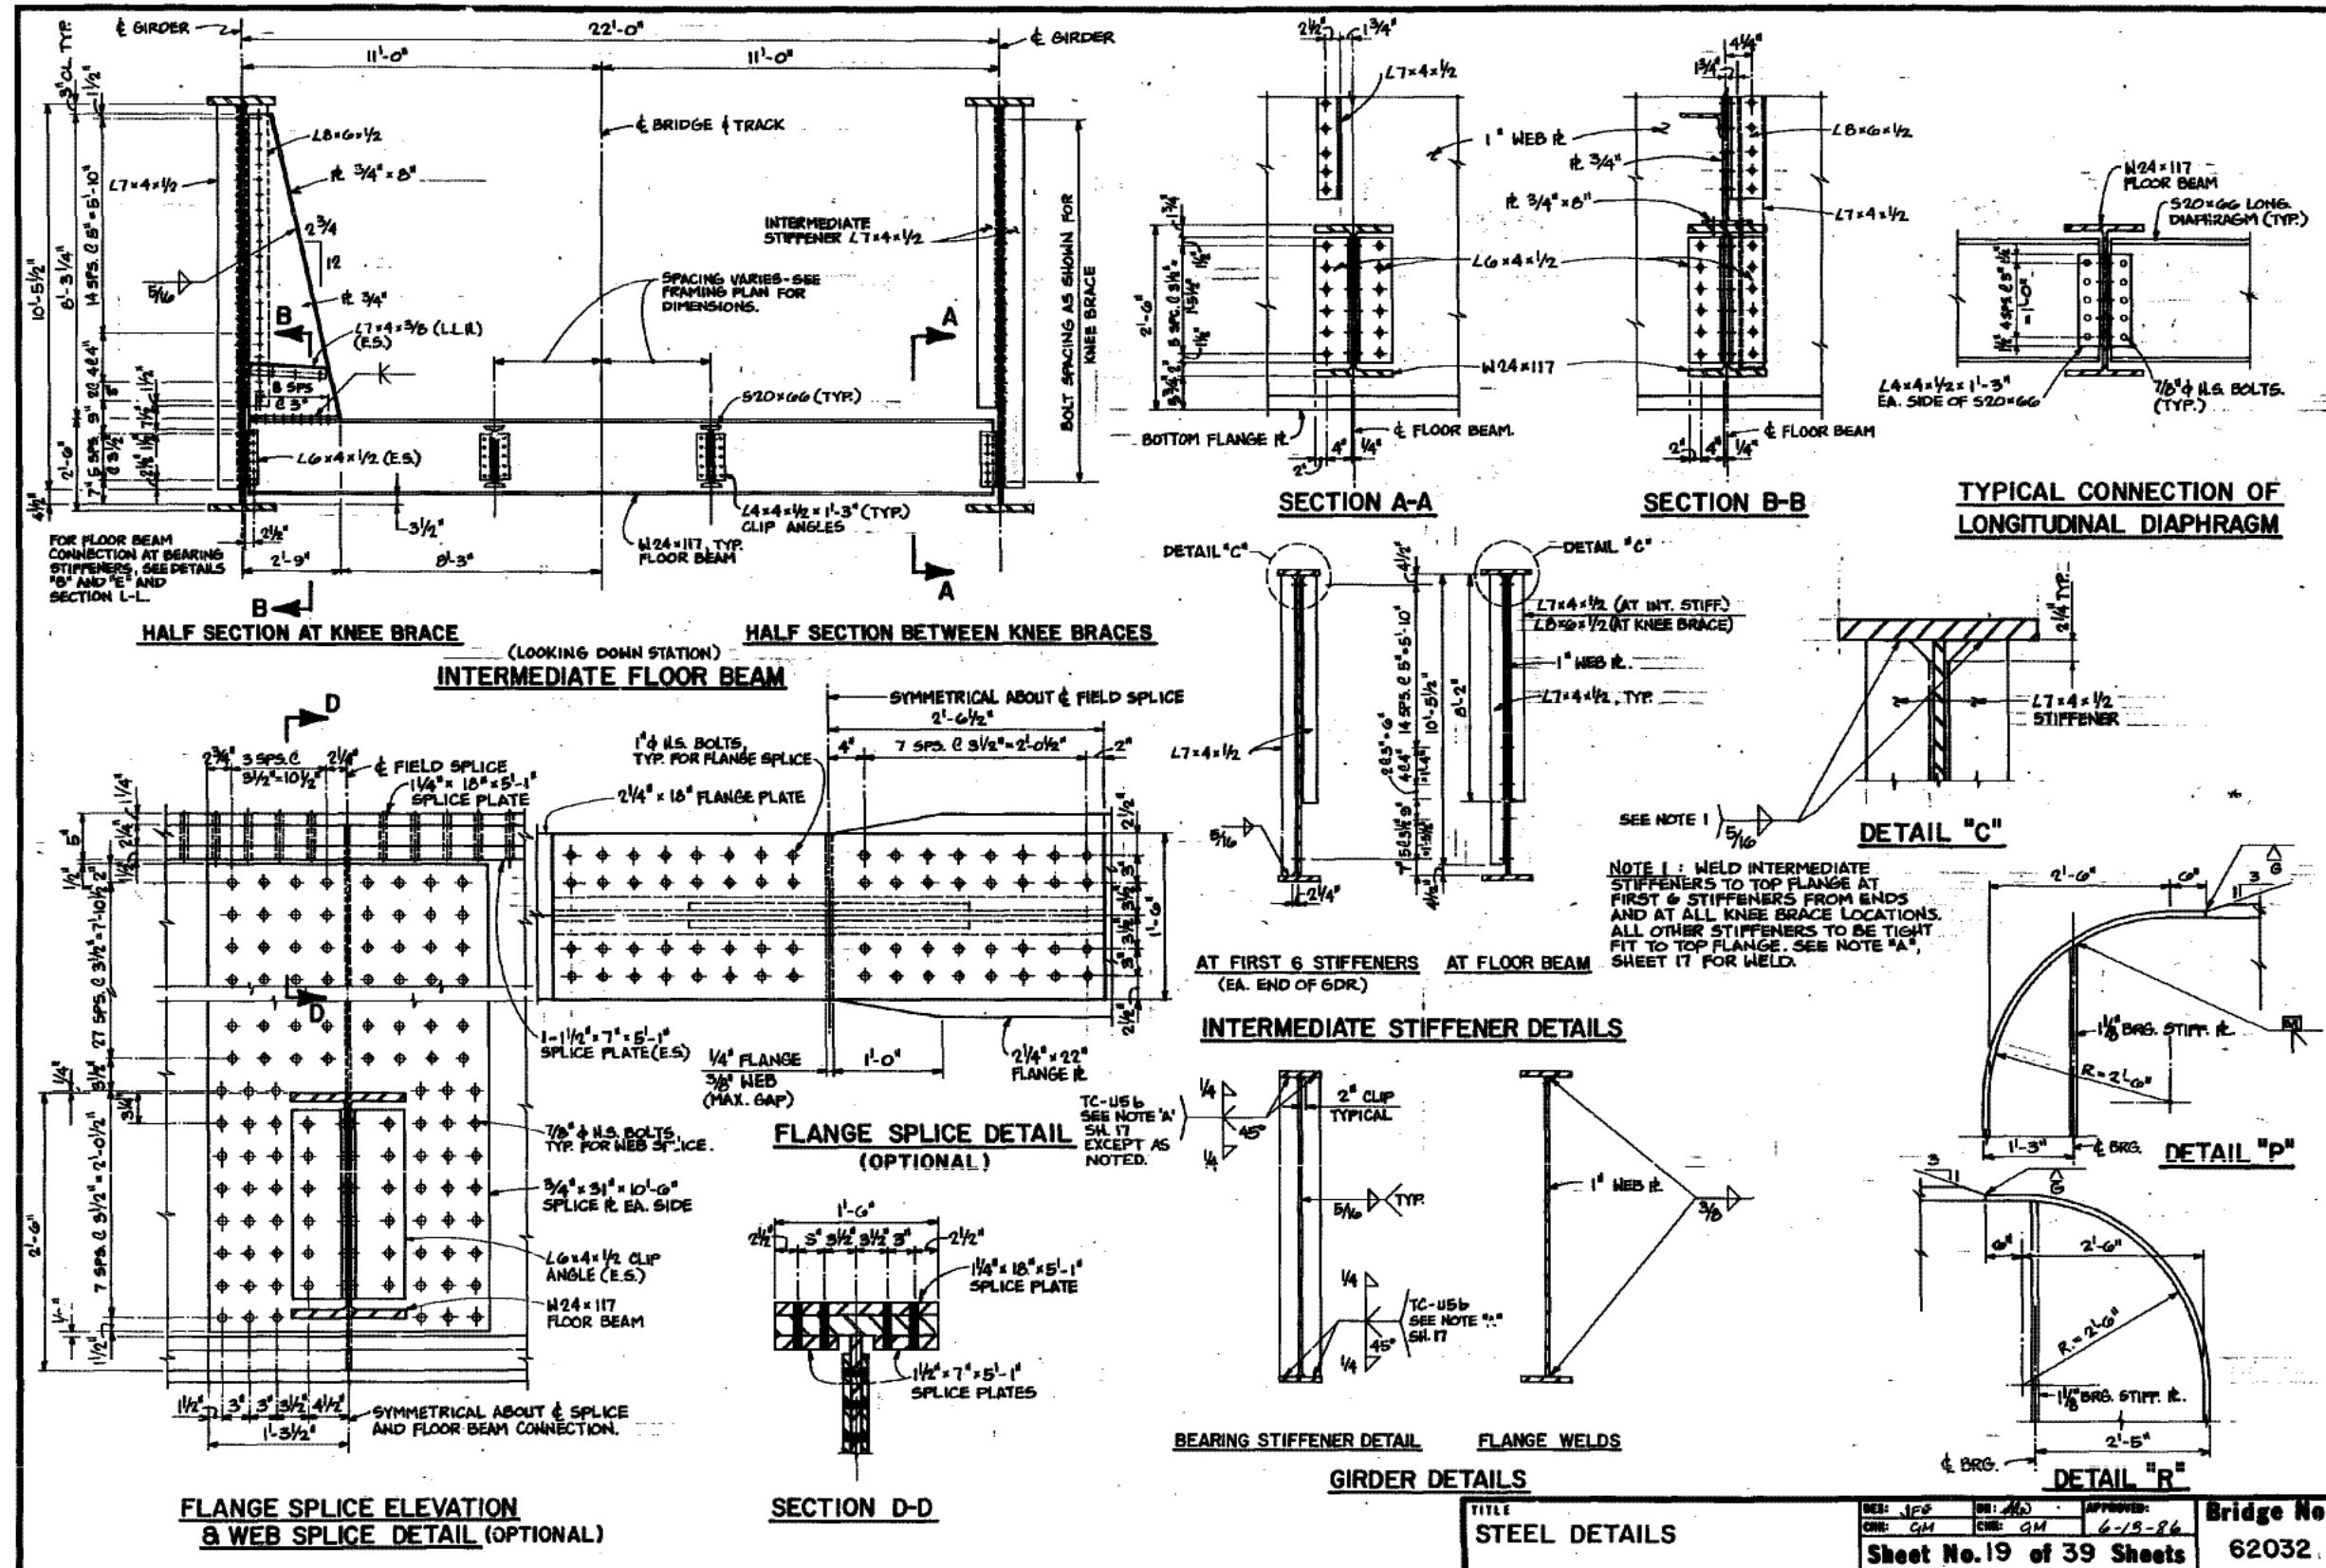


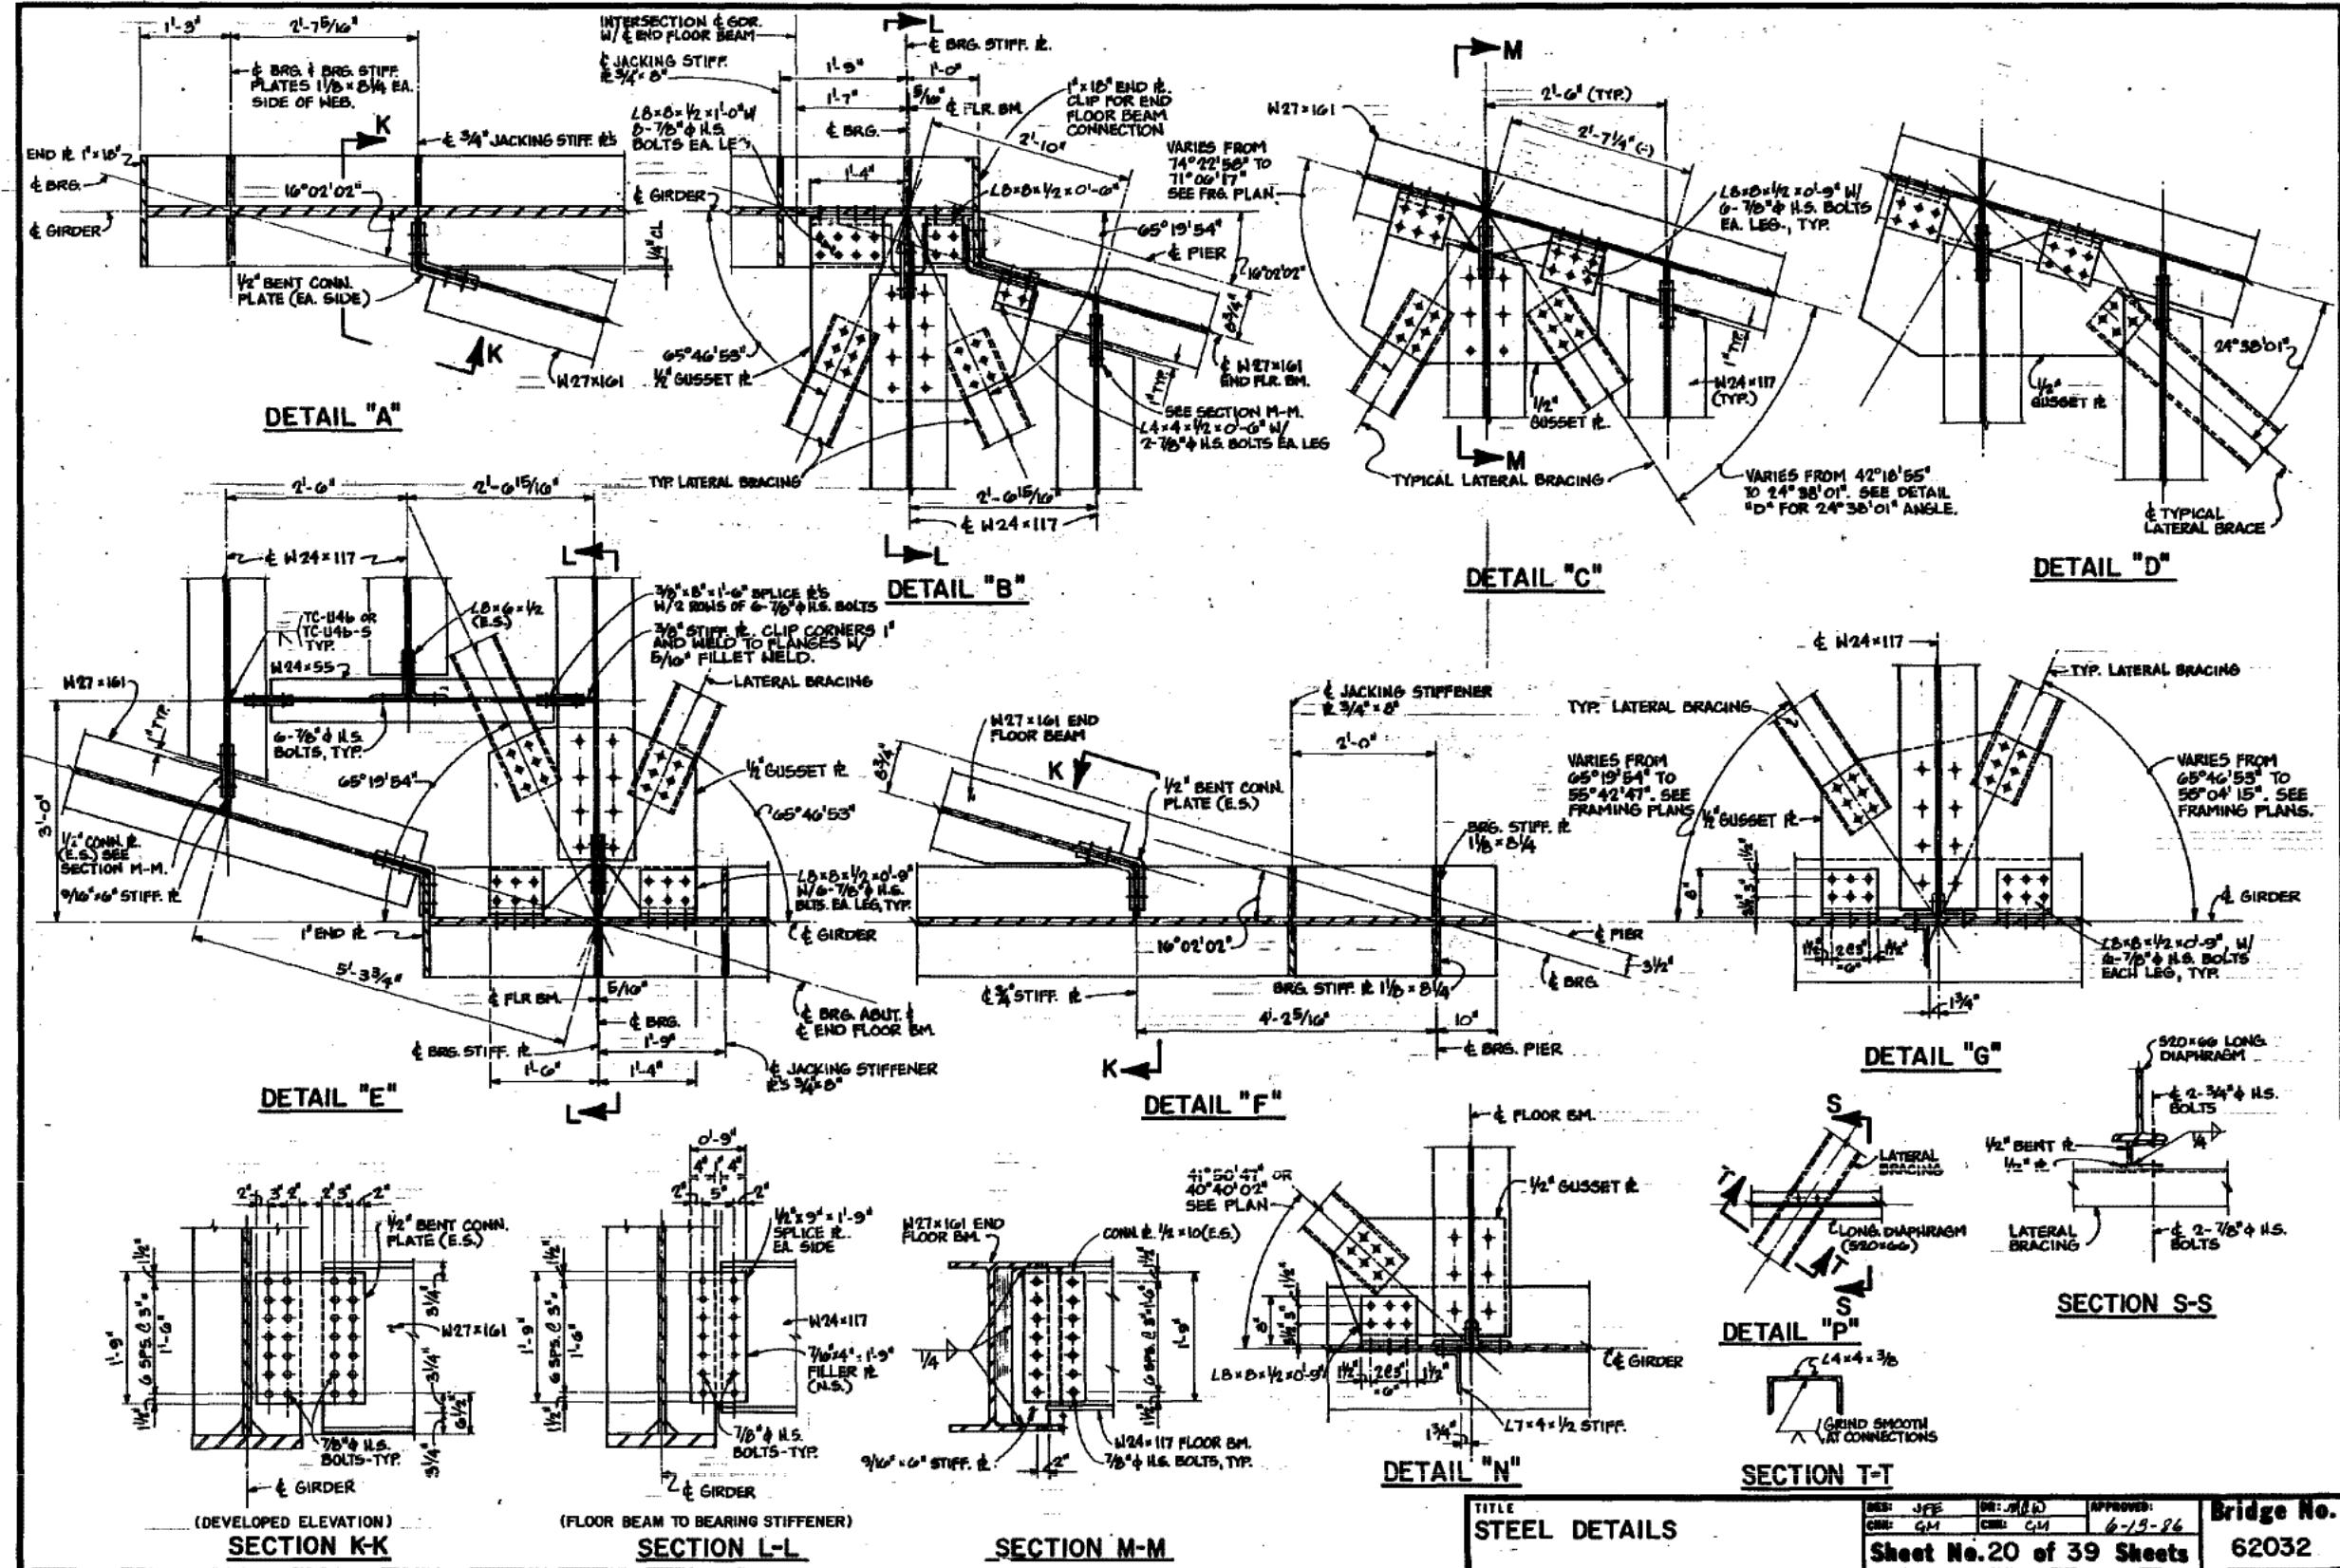


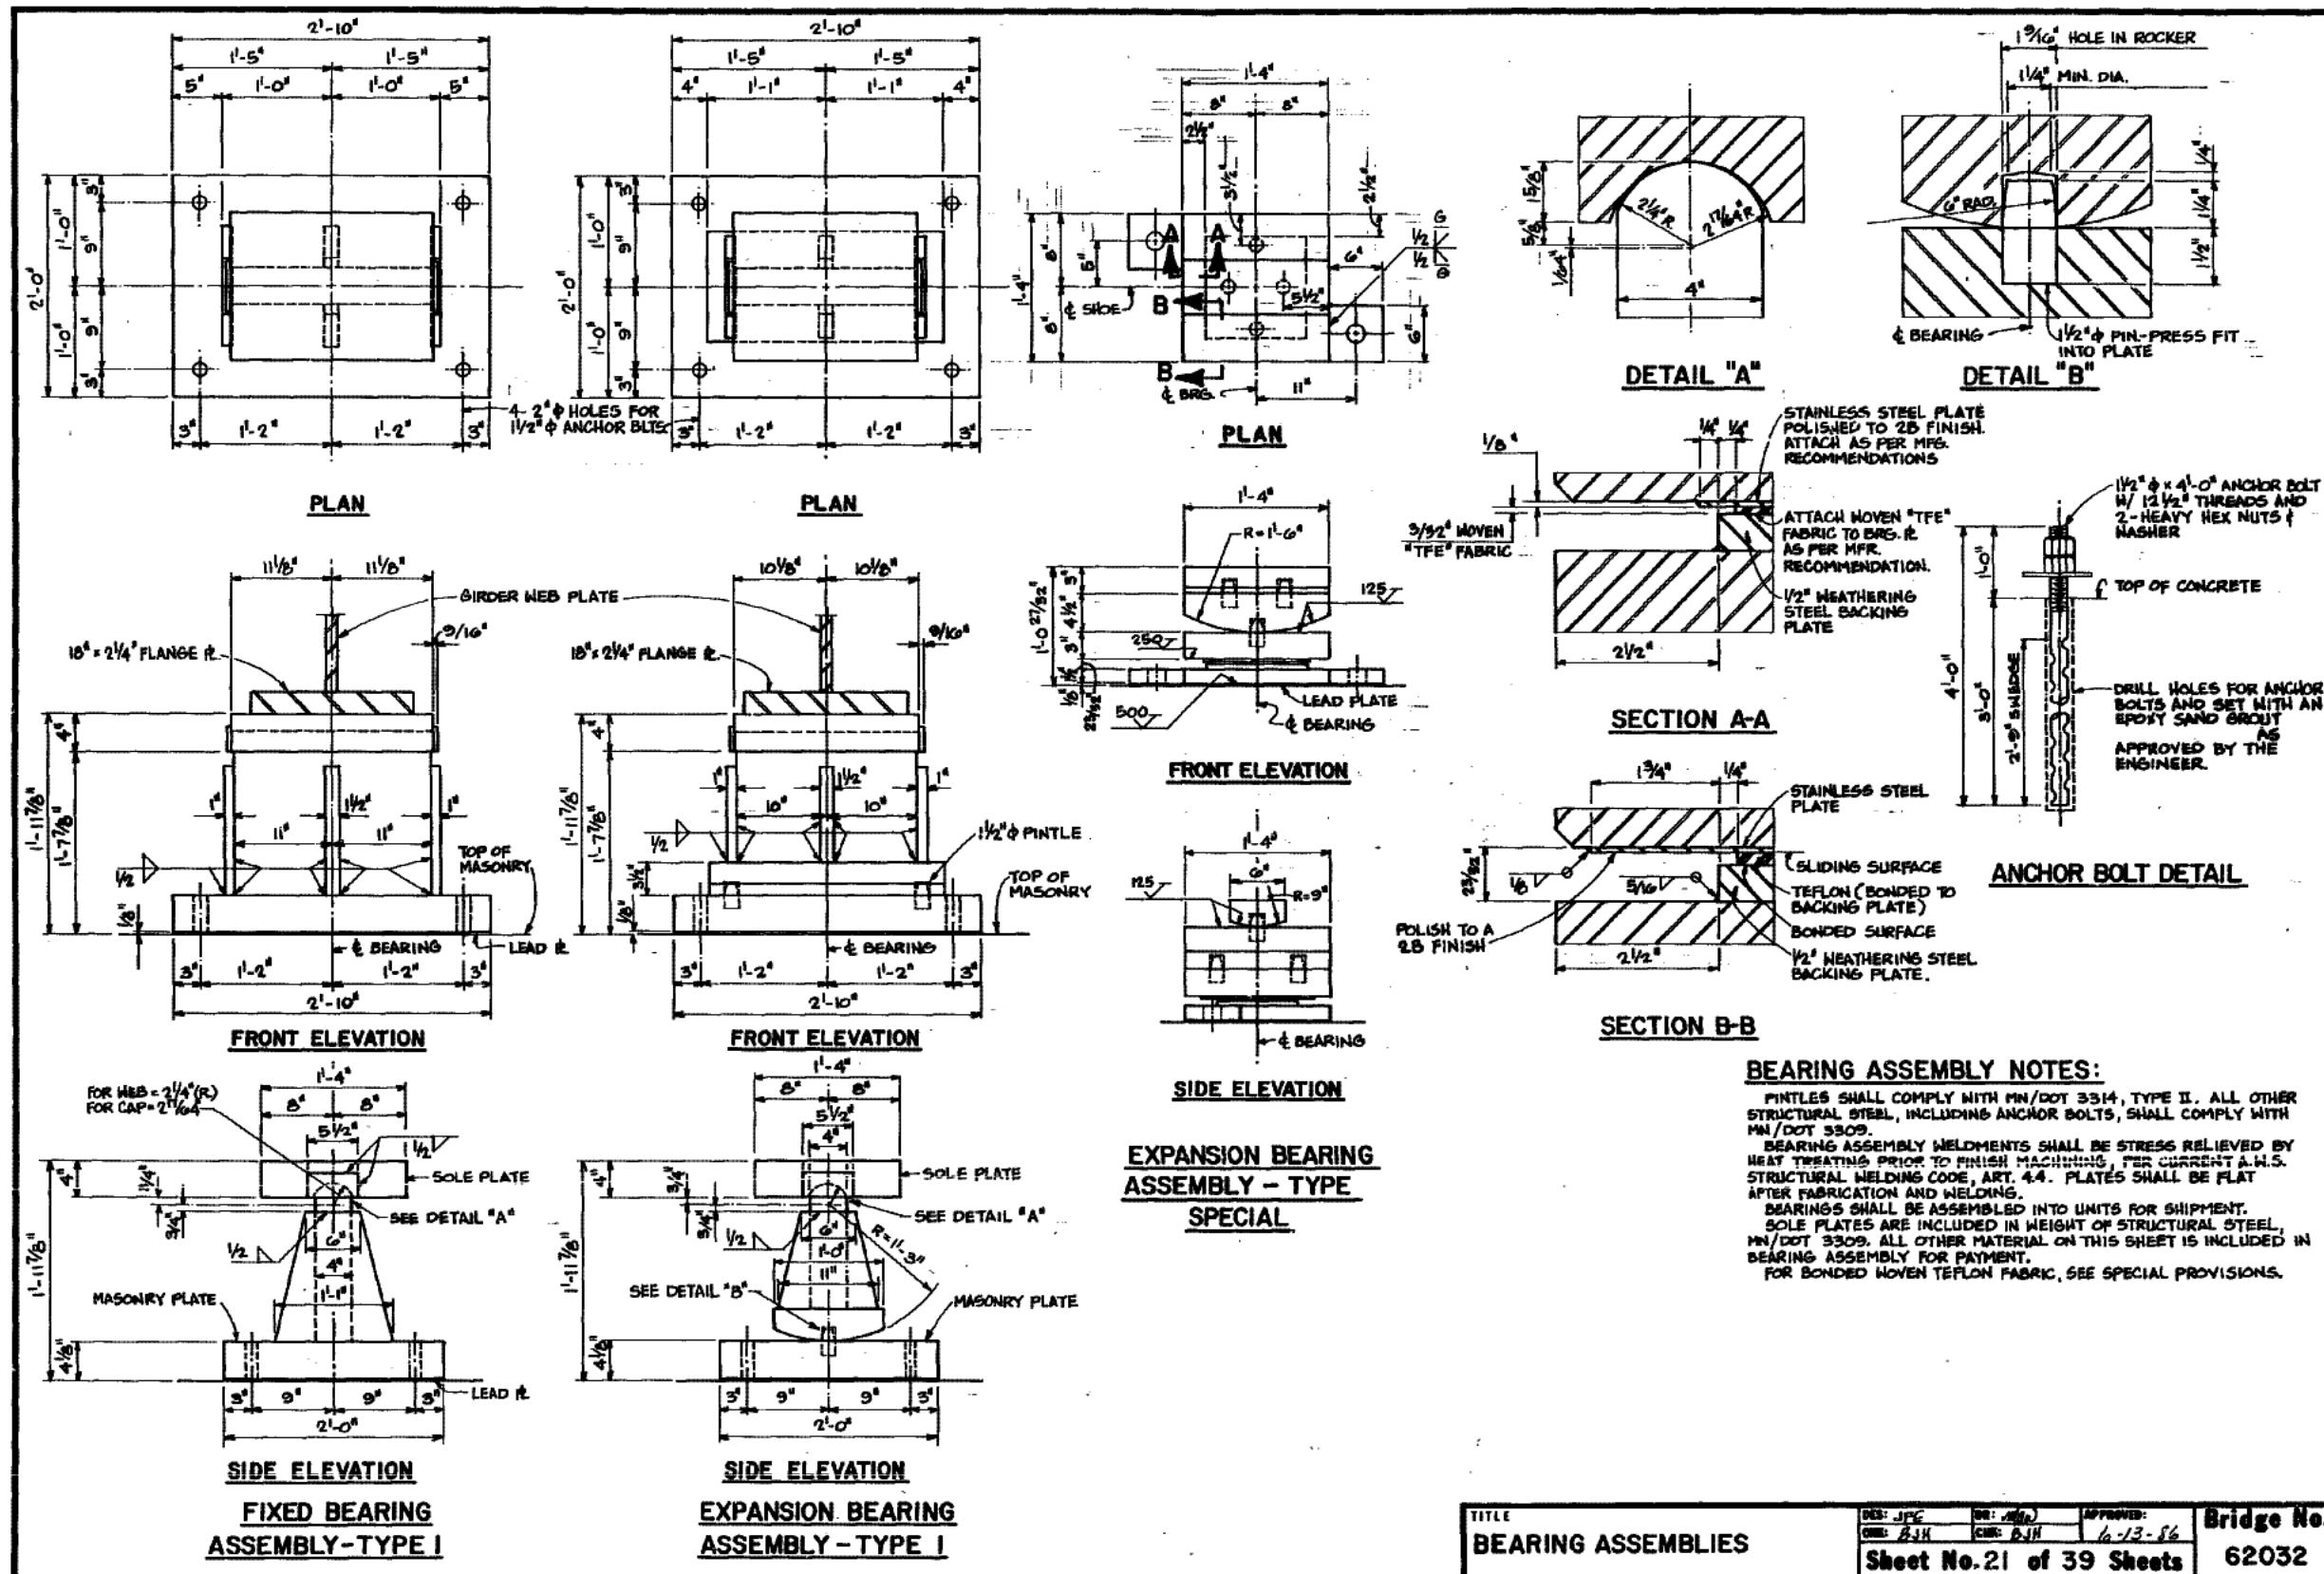



TITLE BEARING ASSEMBLIES	DES: JFG CDE: BJK	DR: ADA CDE: BJK	APPROVED: 10-13-86	Bridge No. 62032
Sheet No. 21 of 39 Sheets				

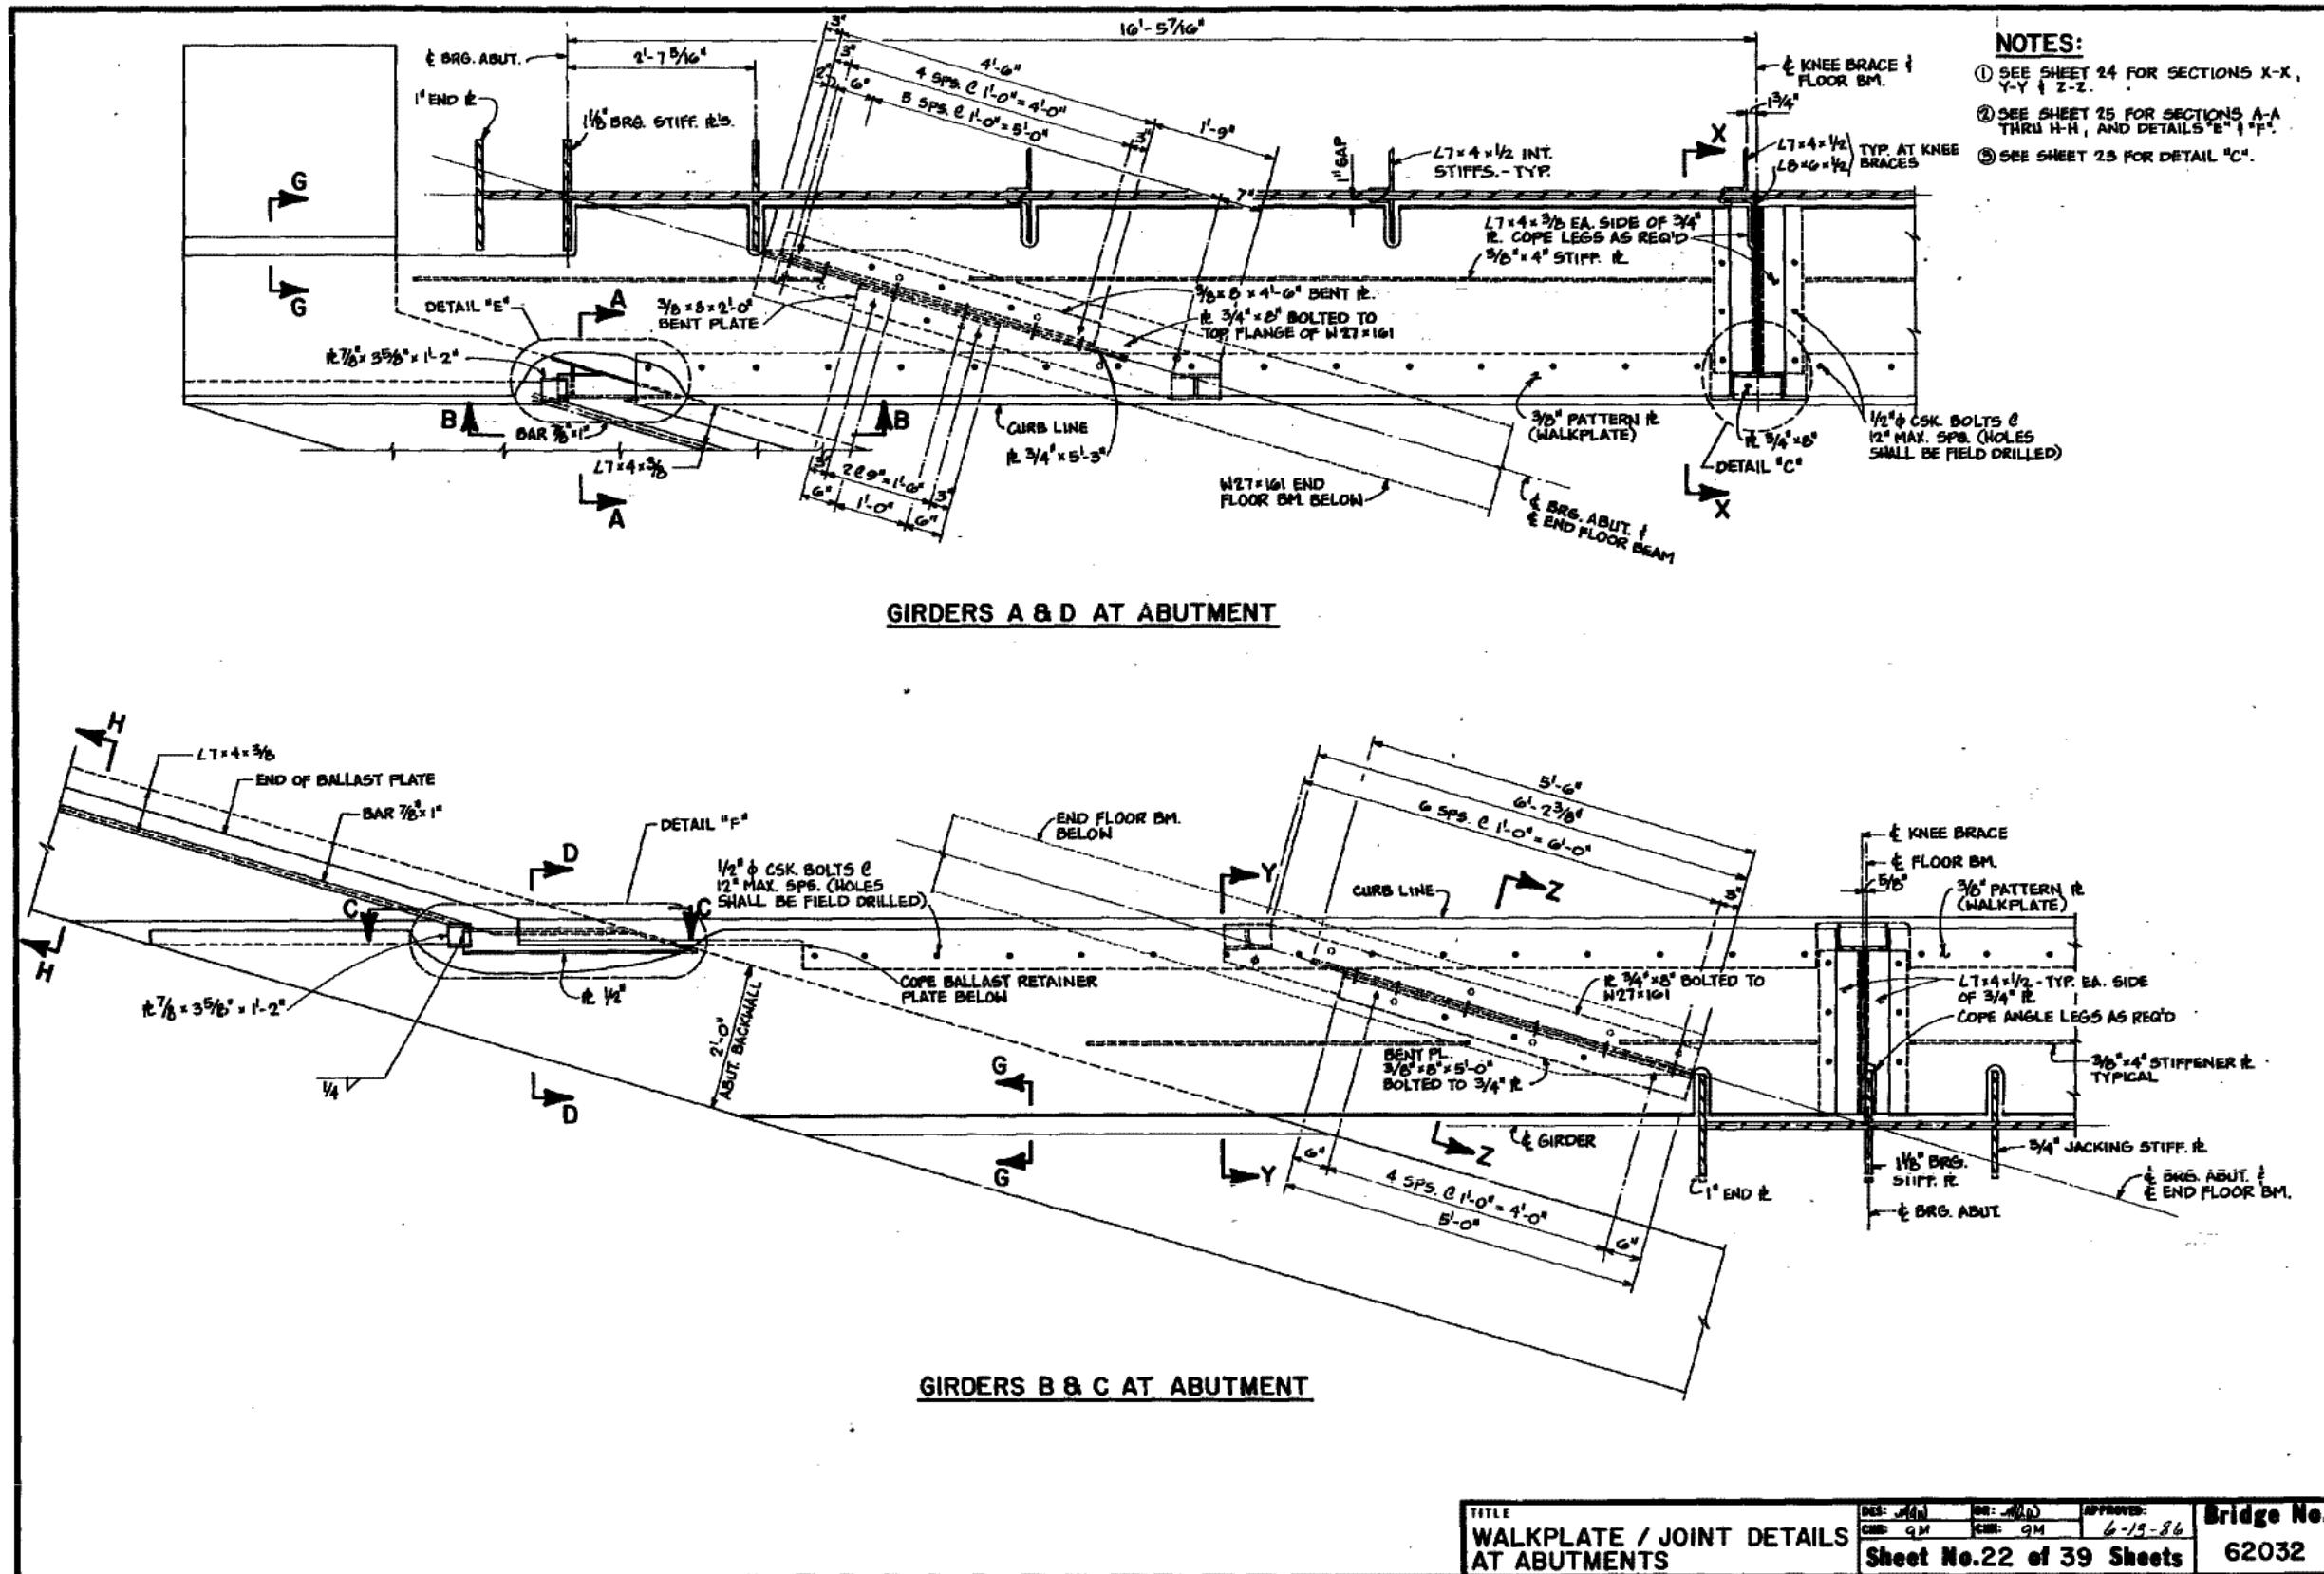



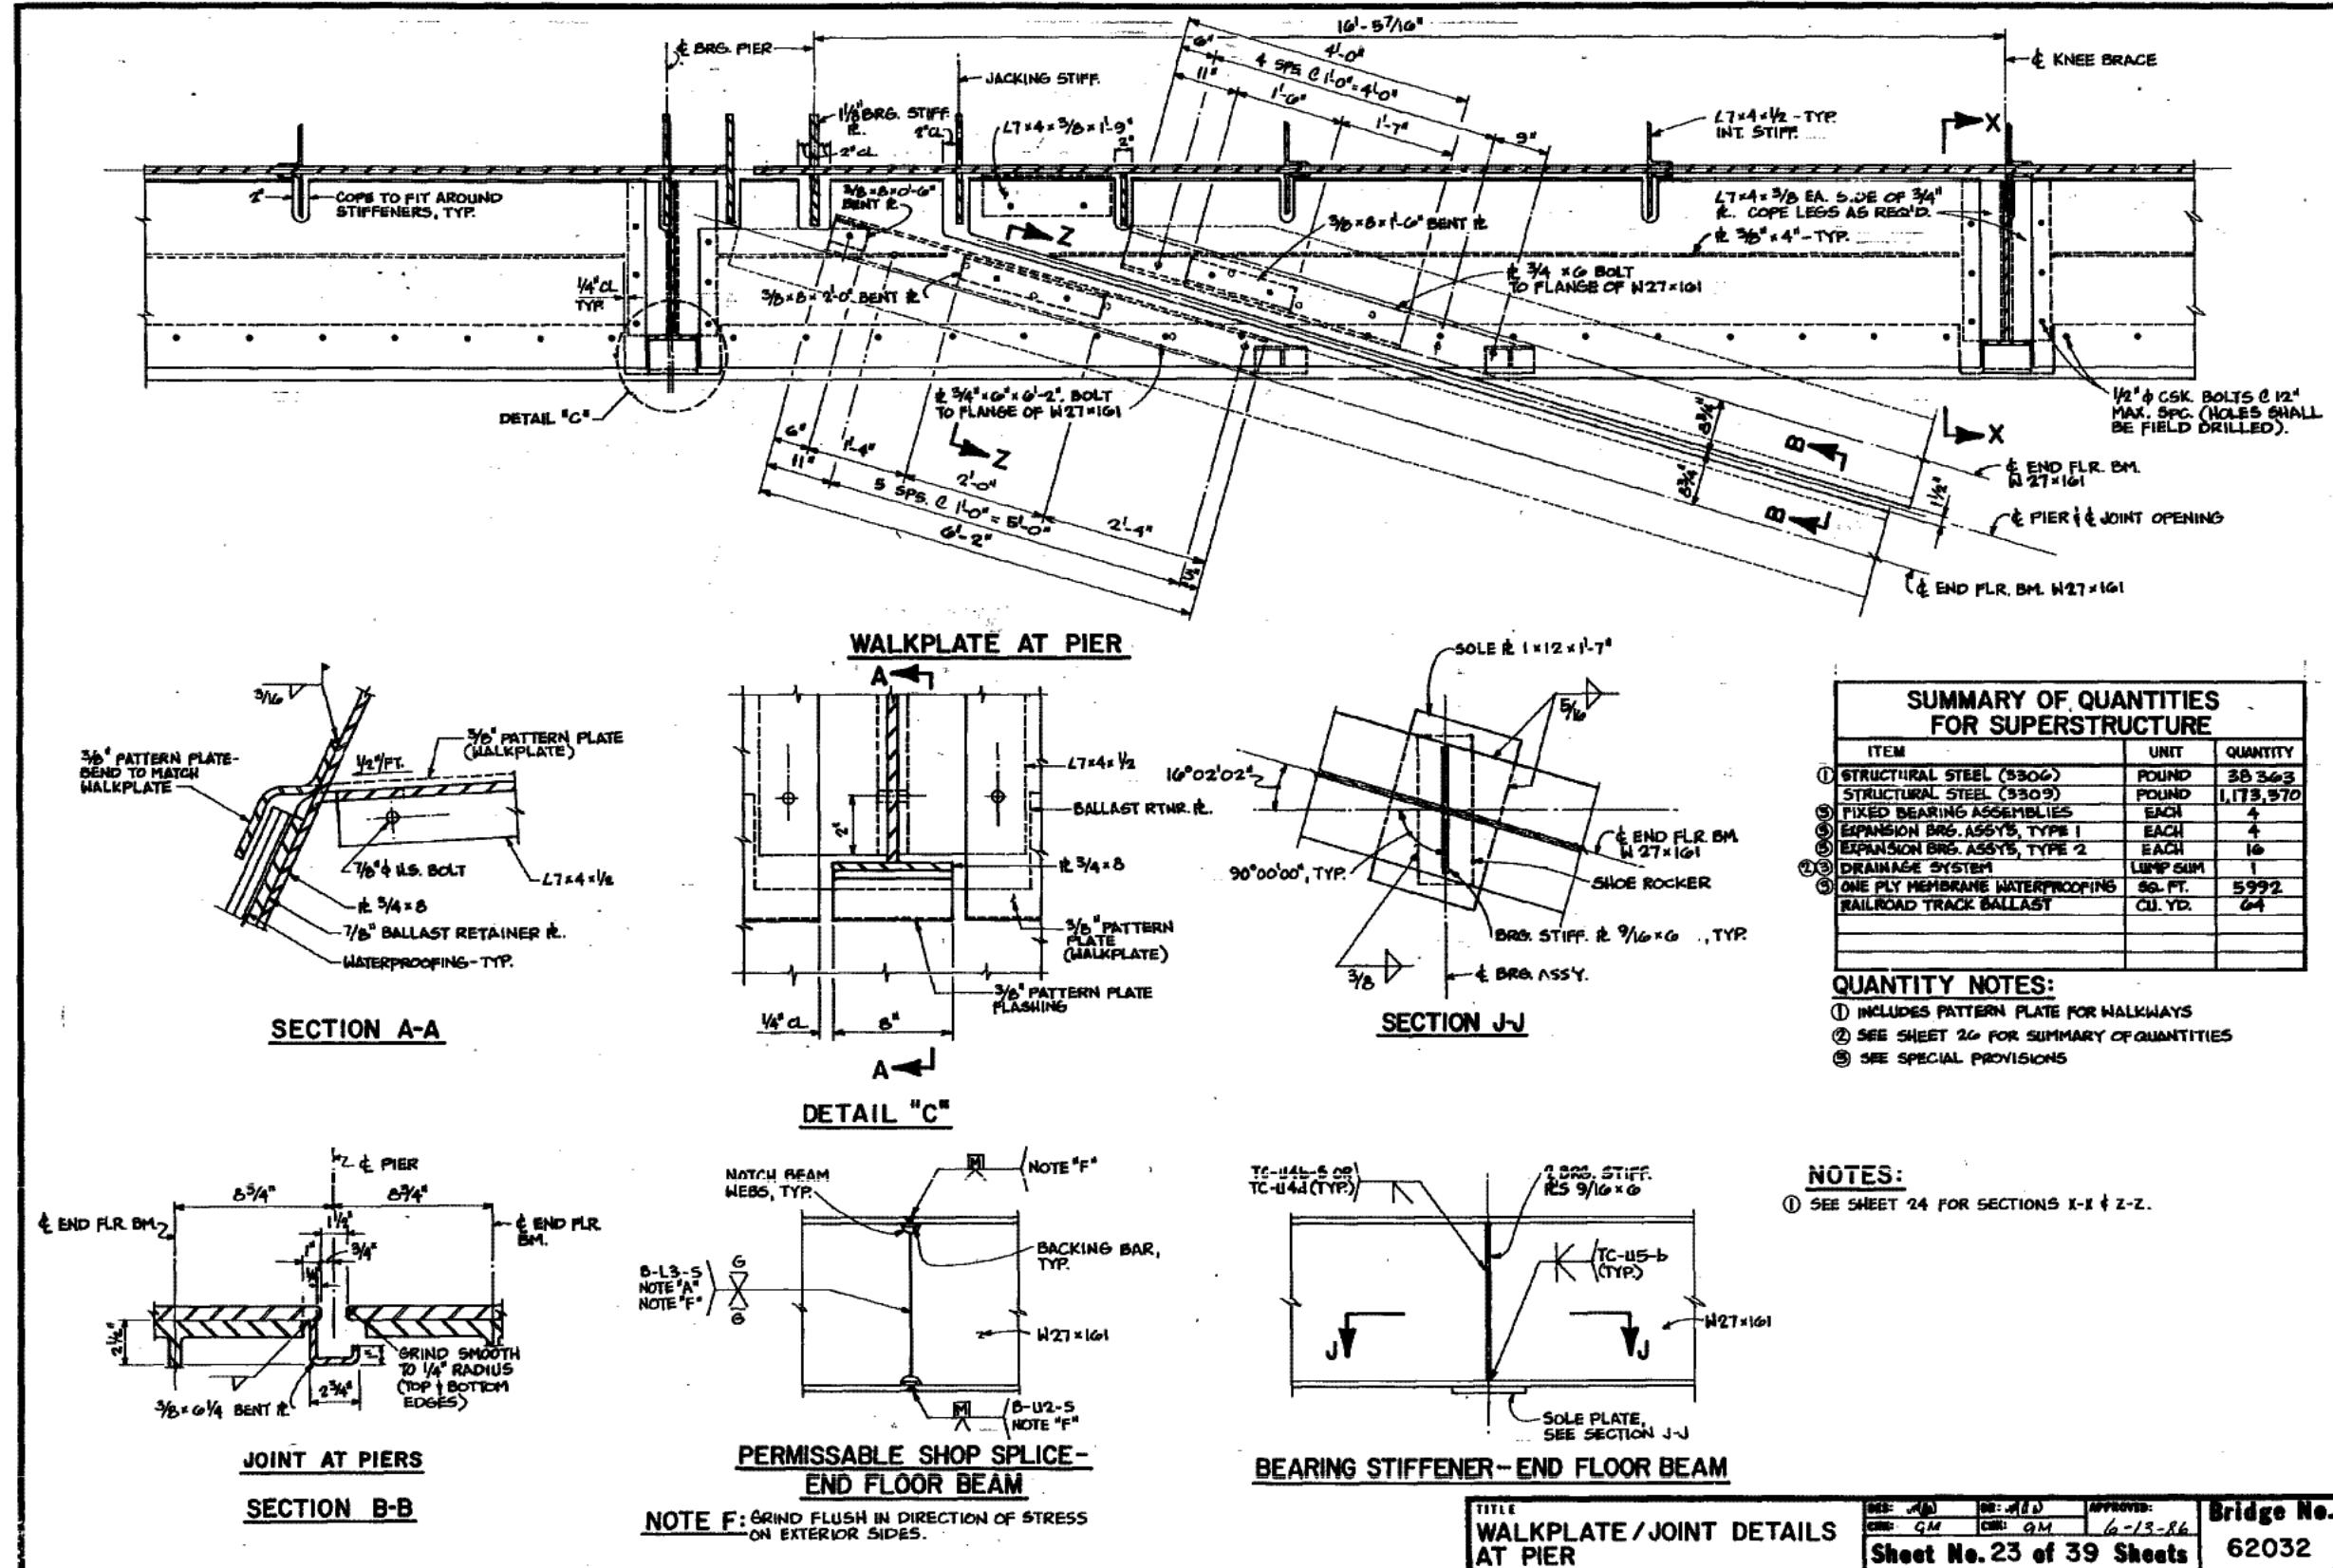


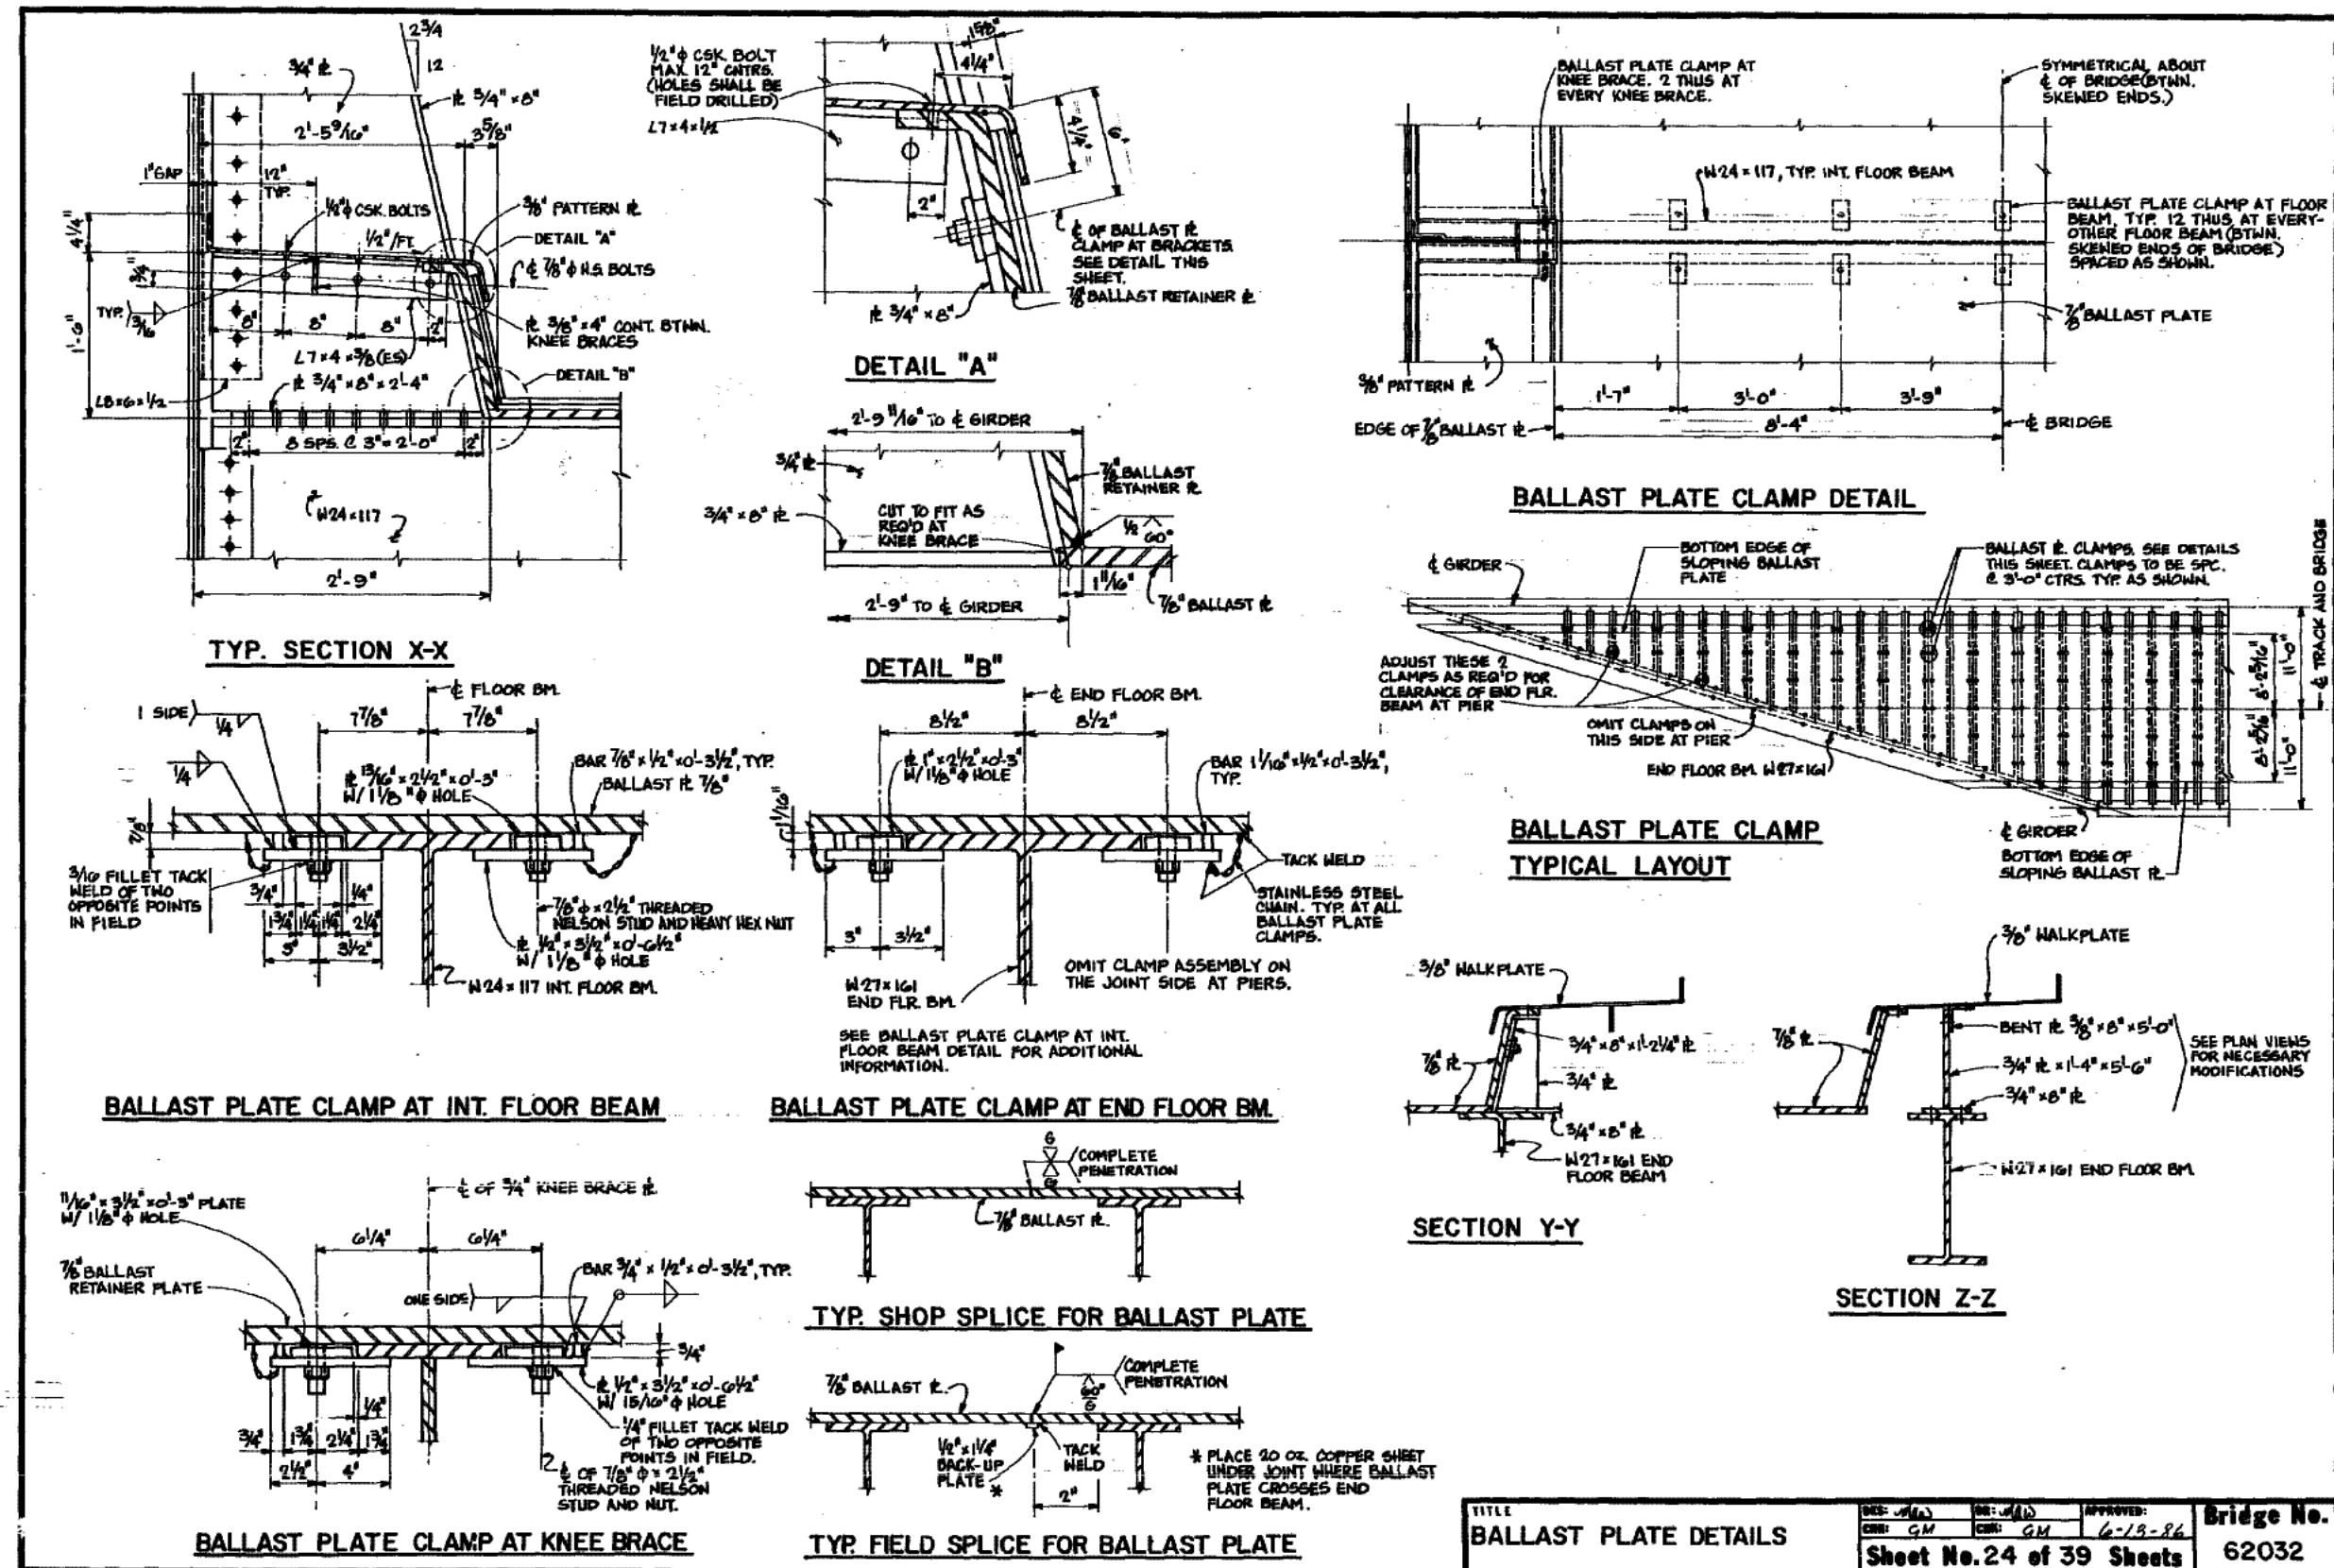


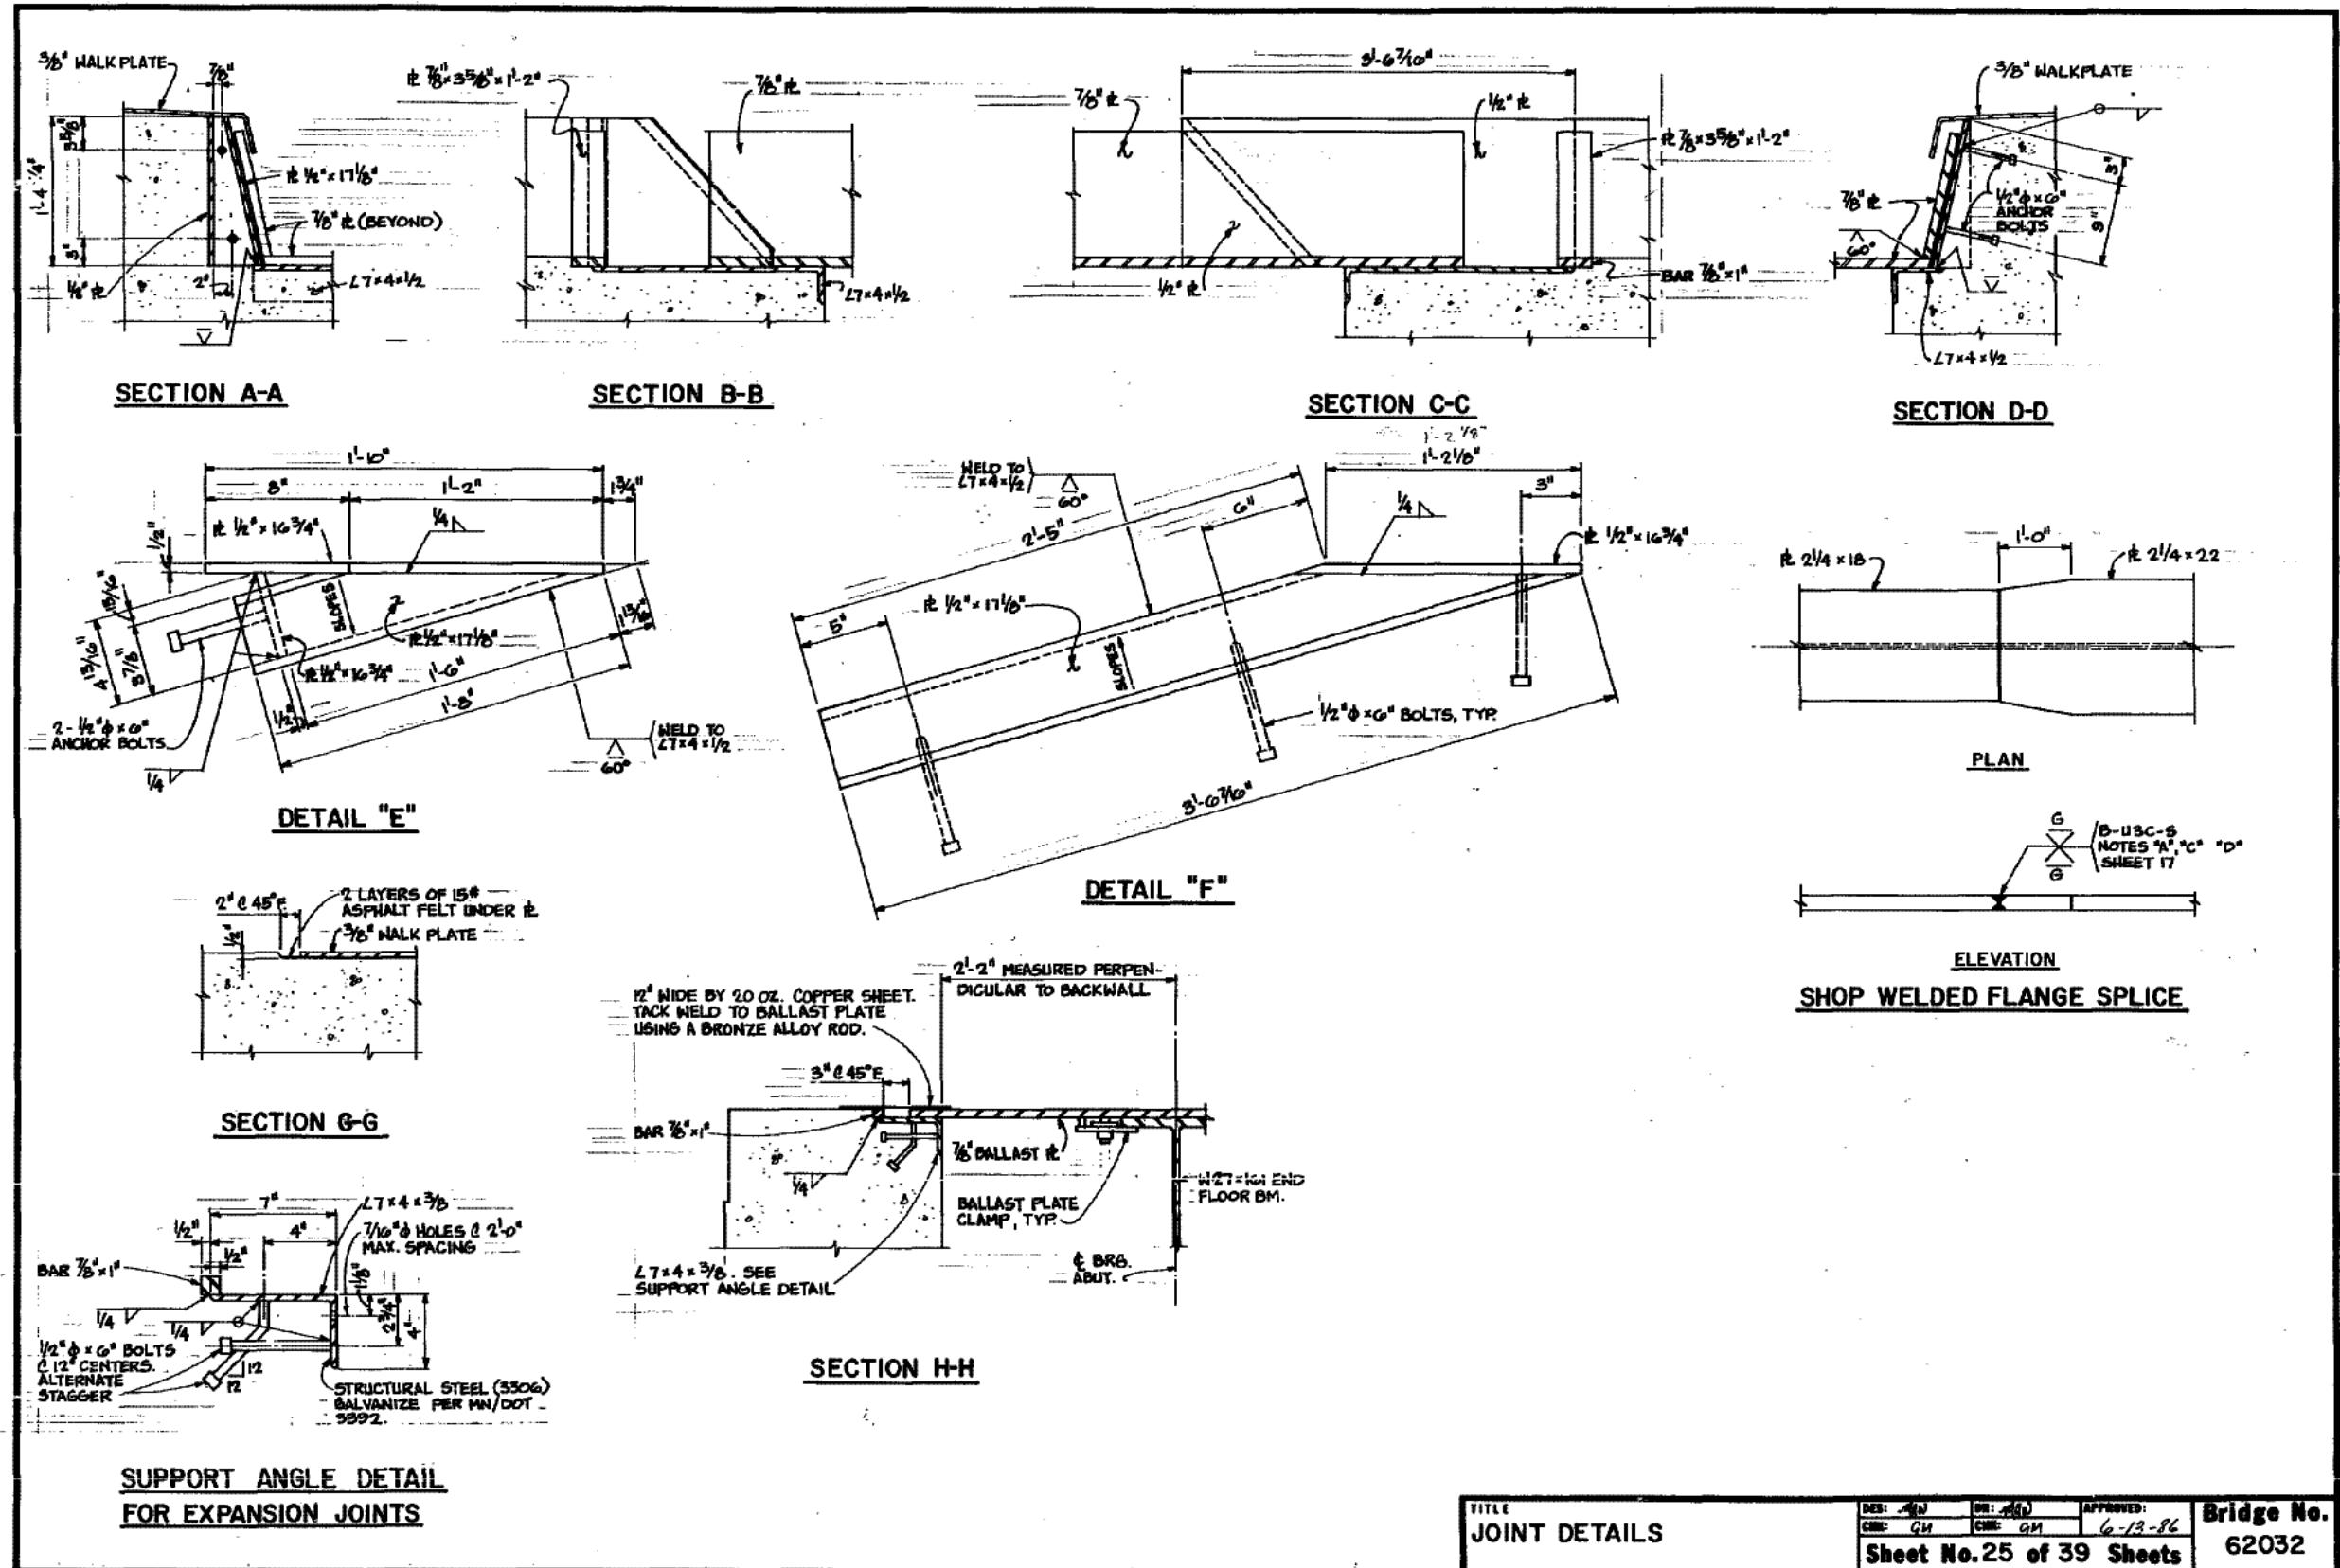


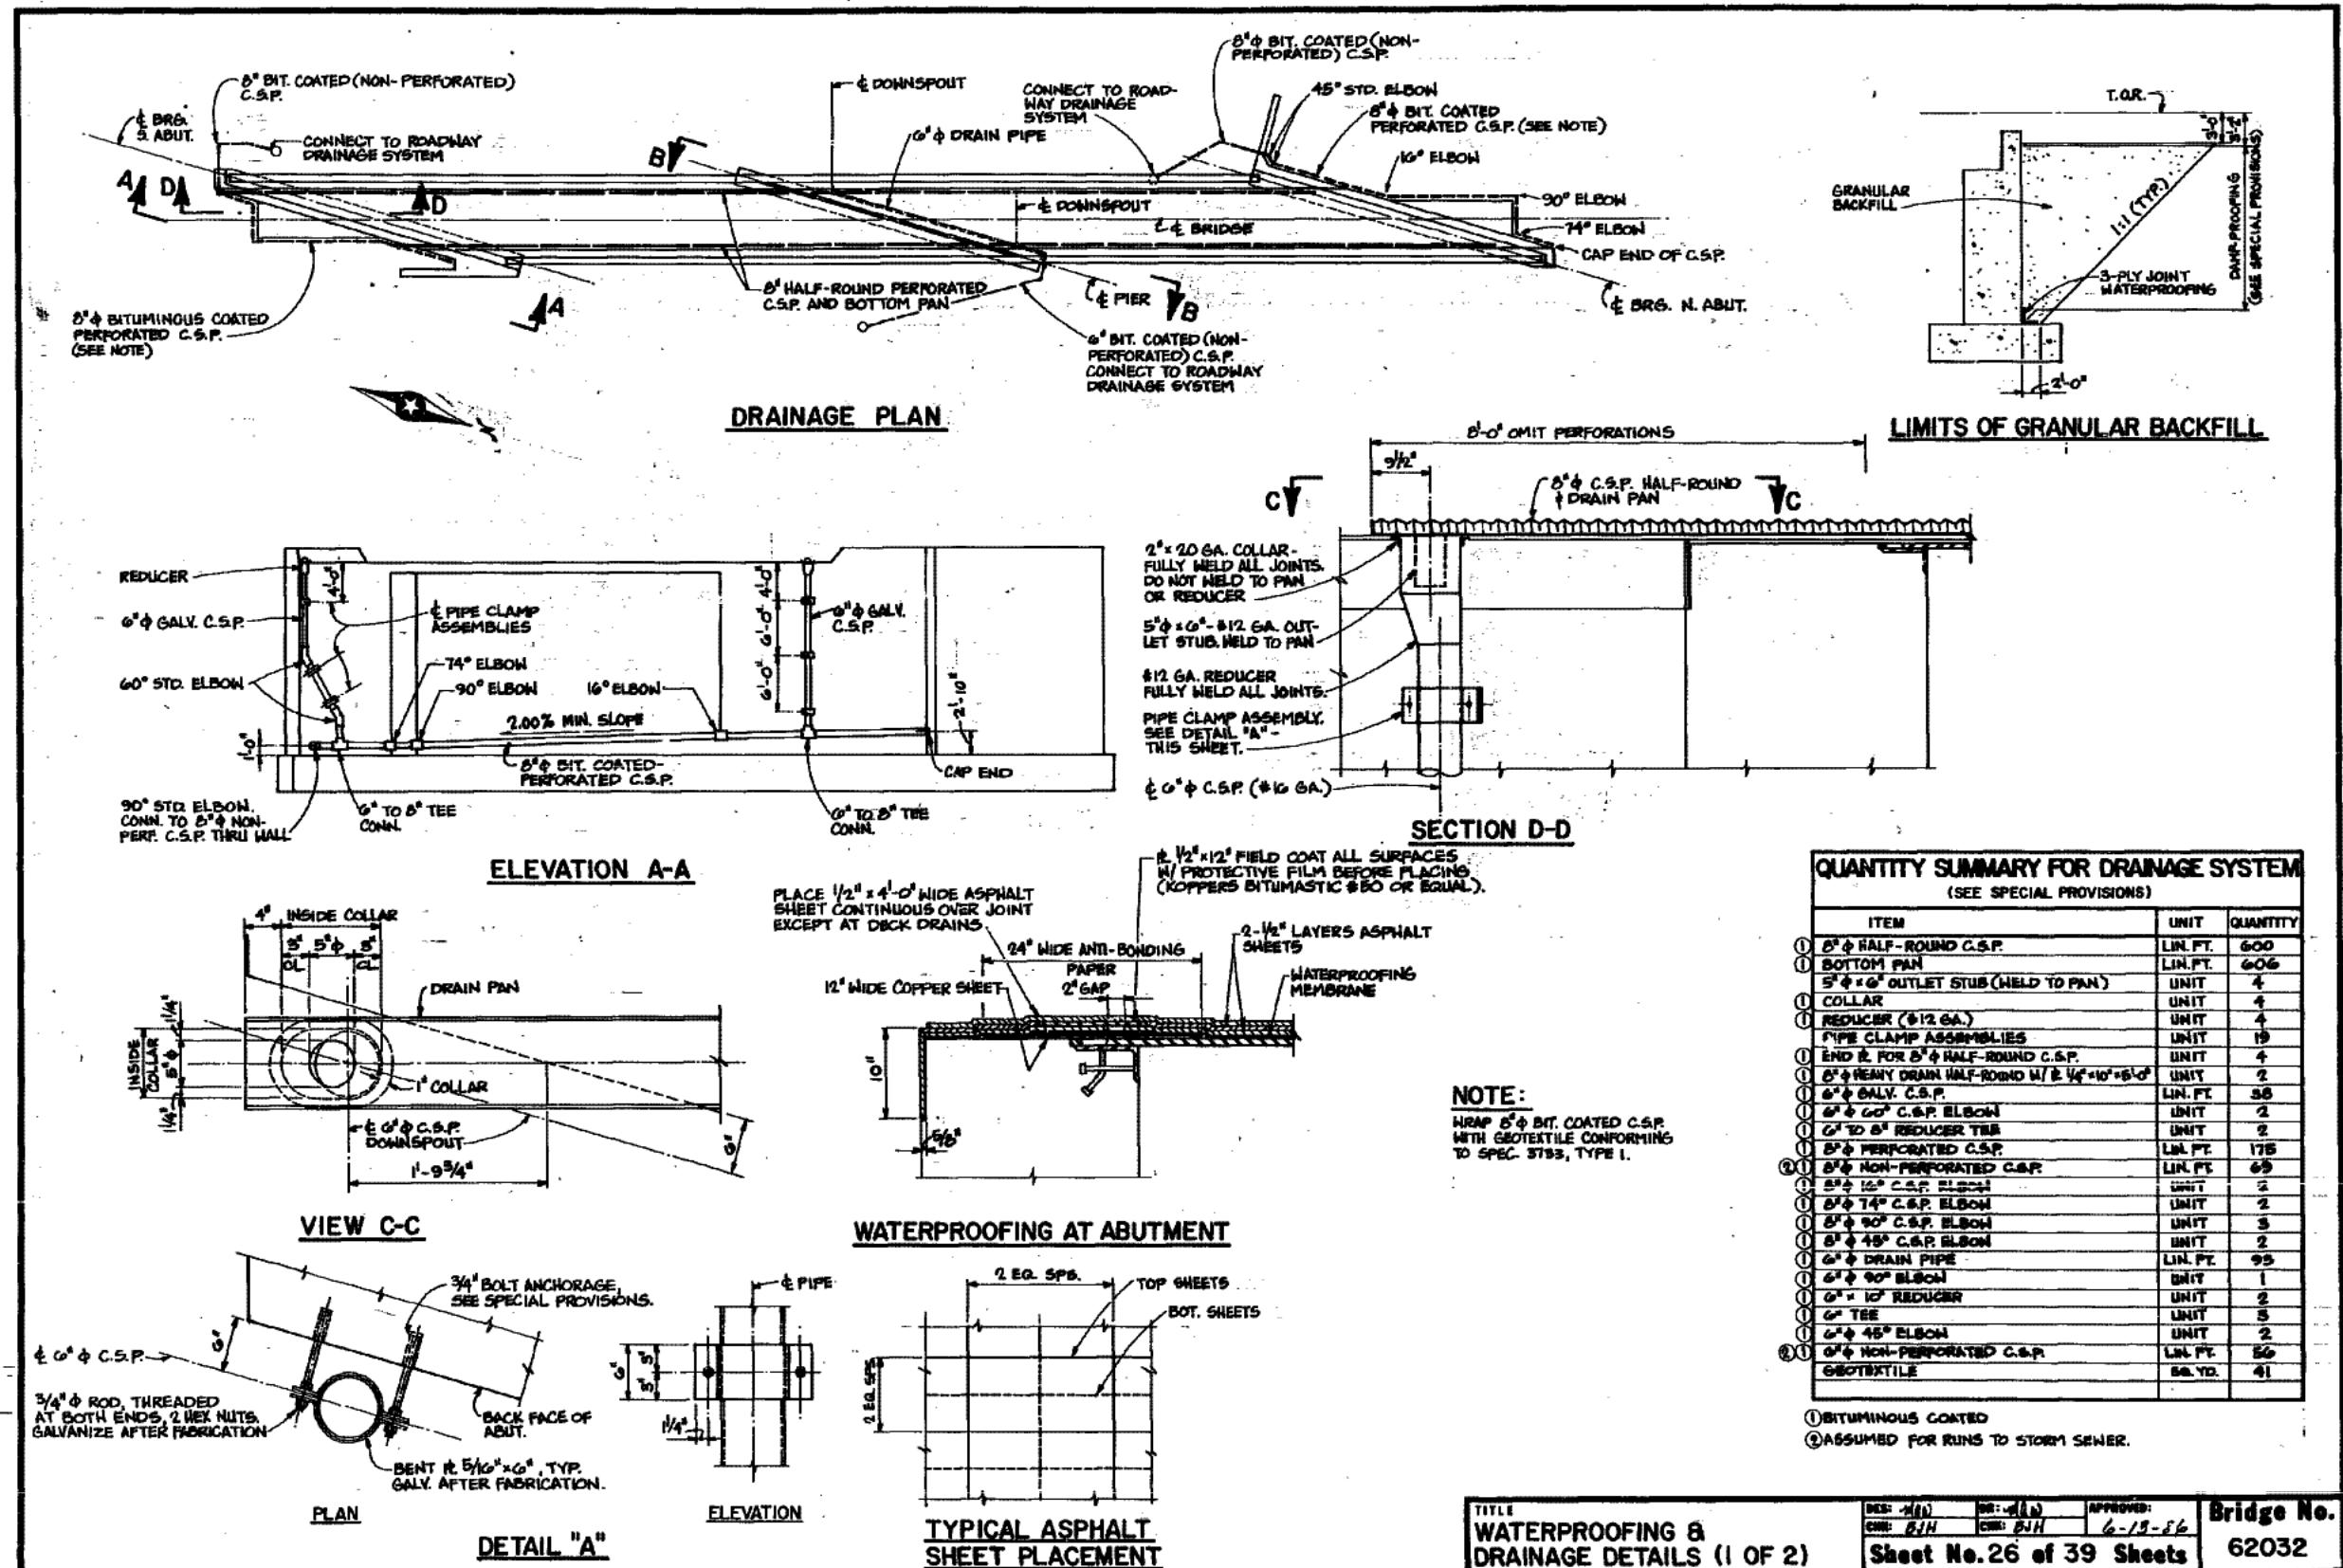


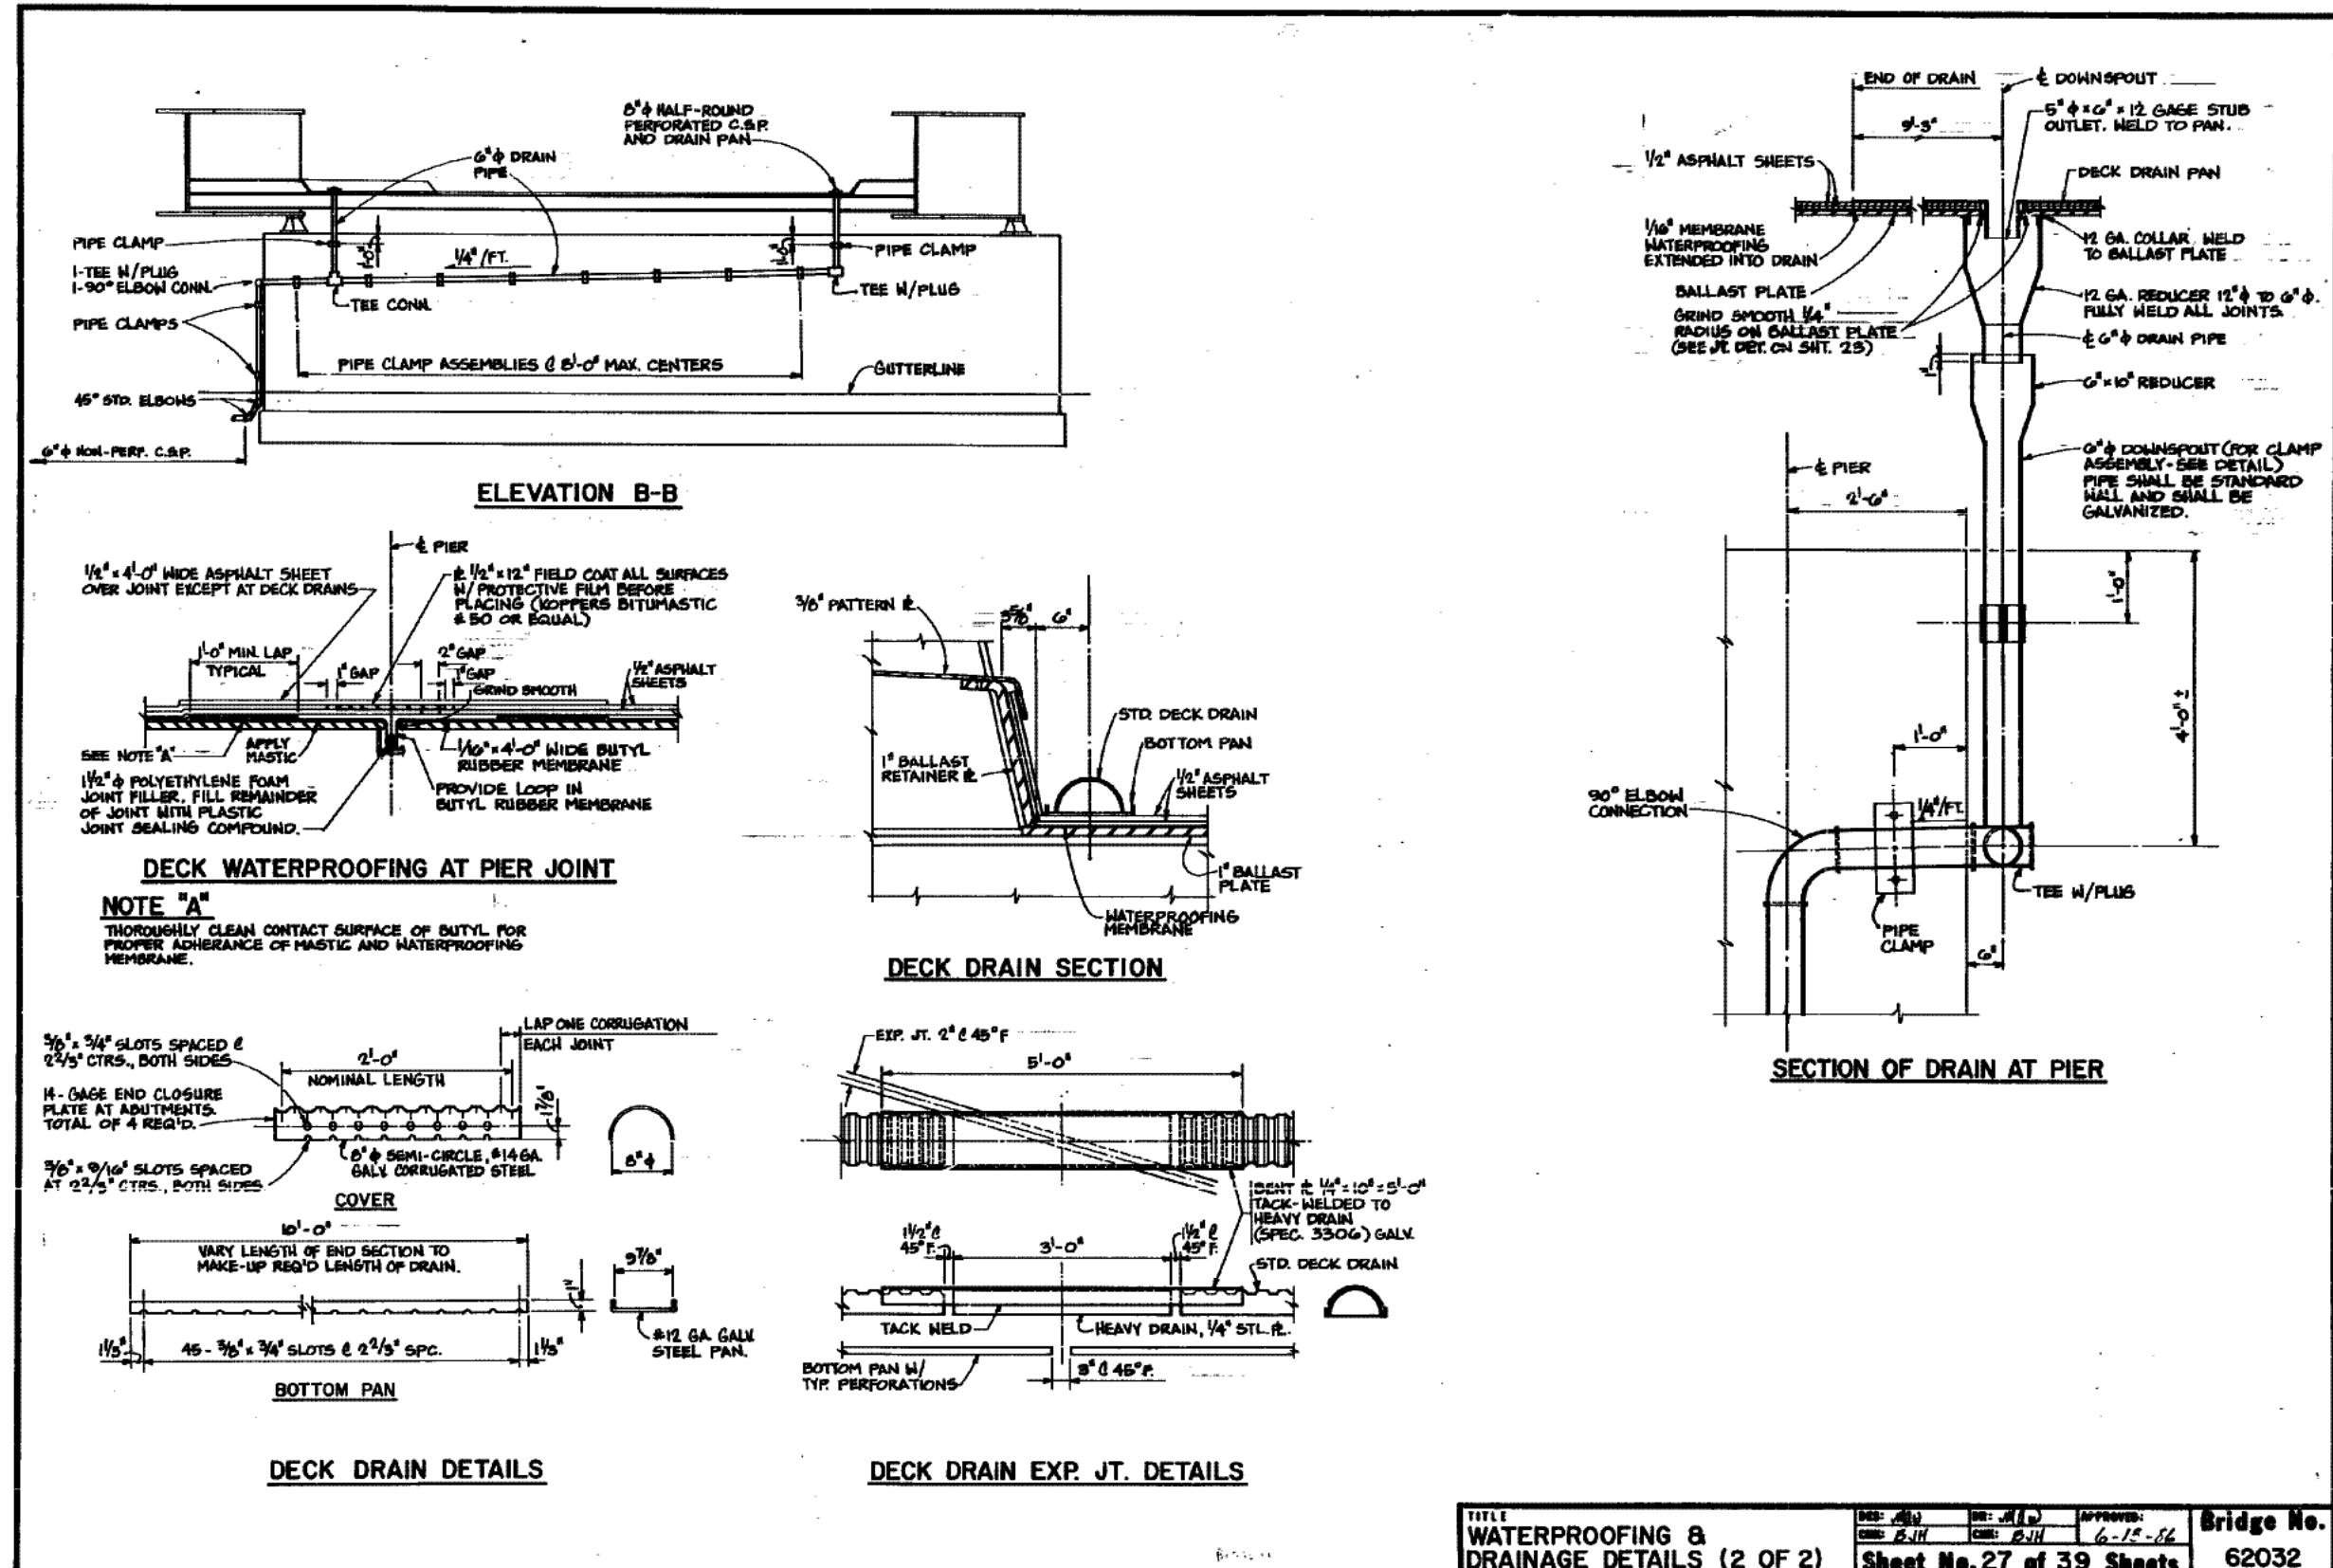


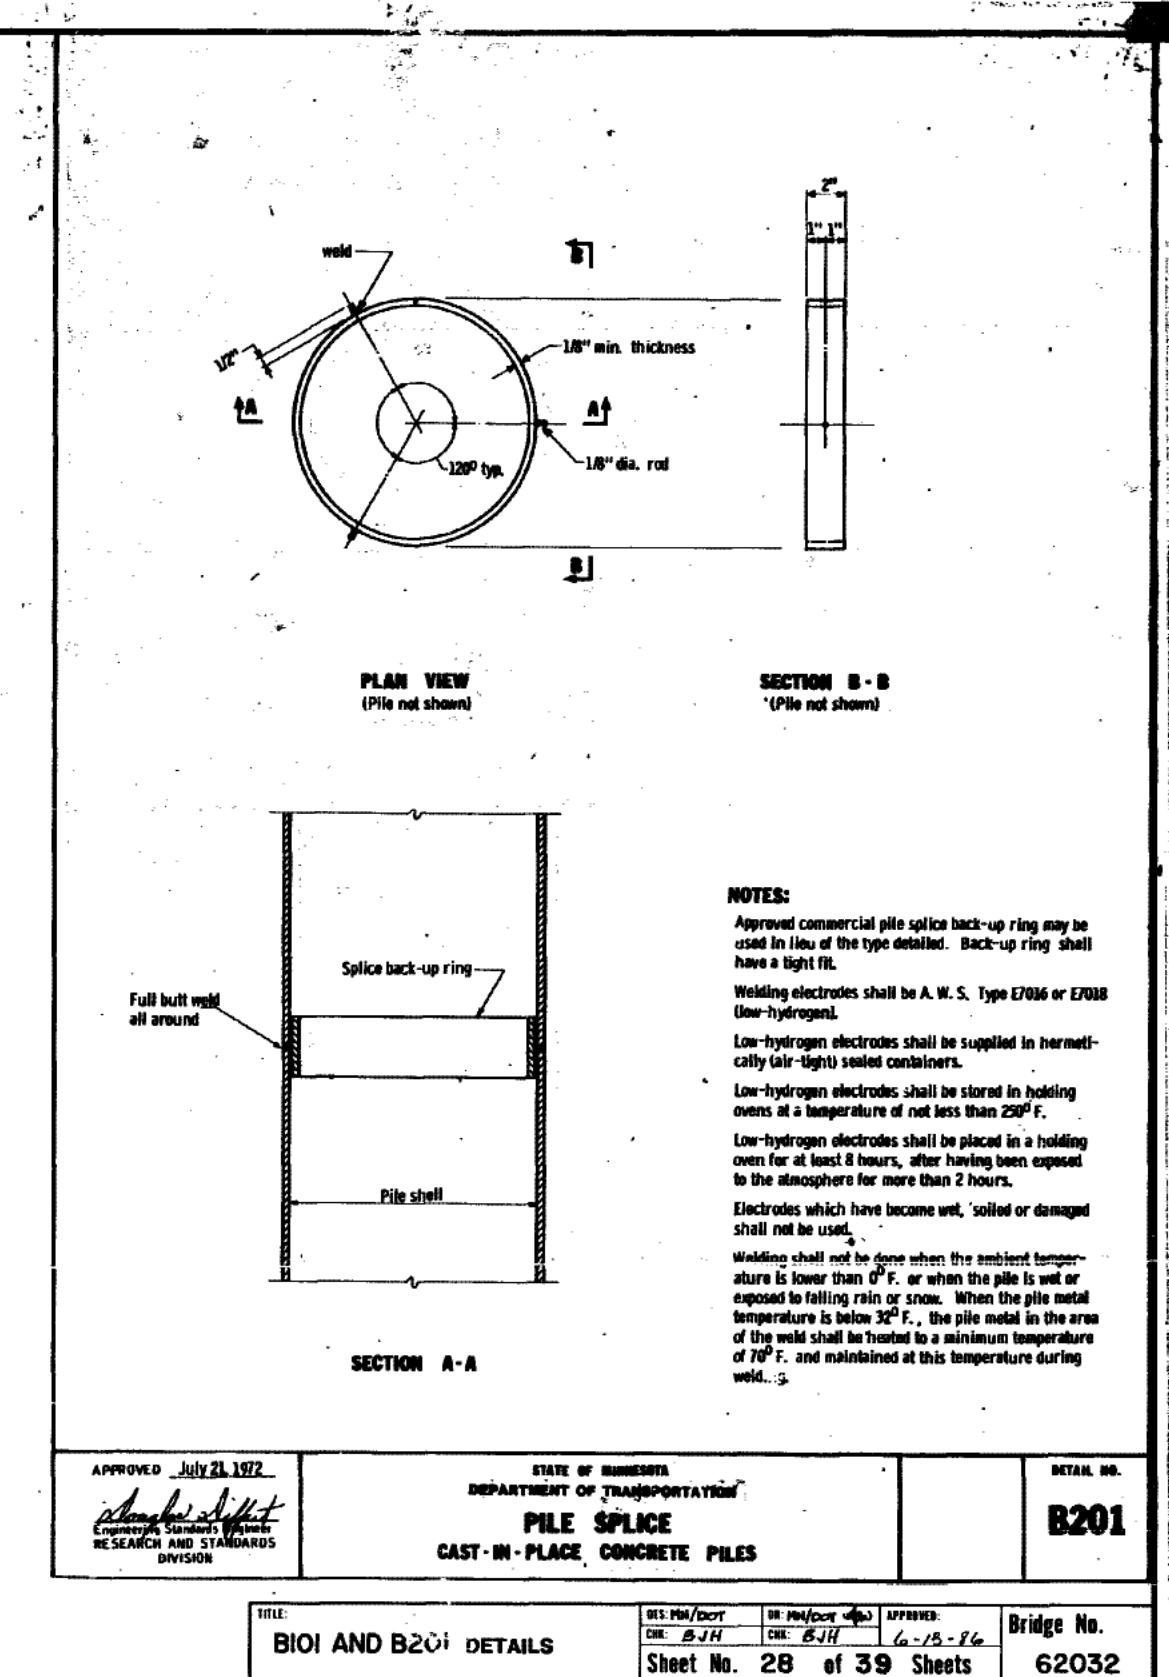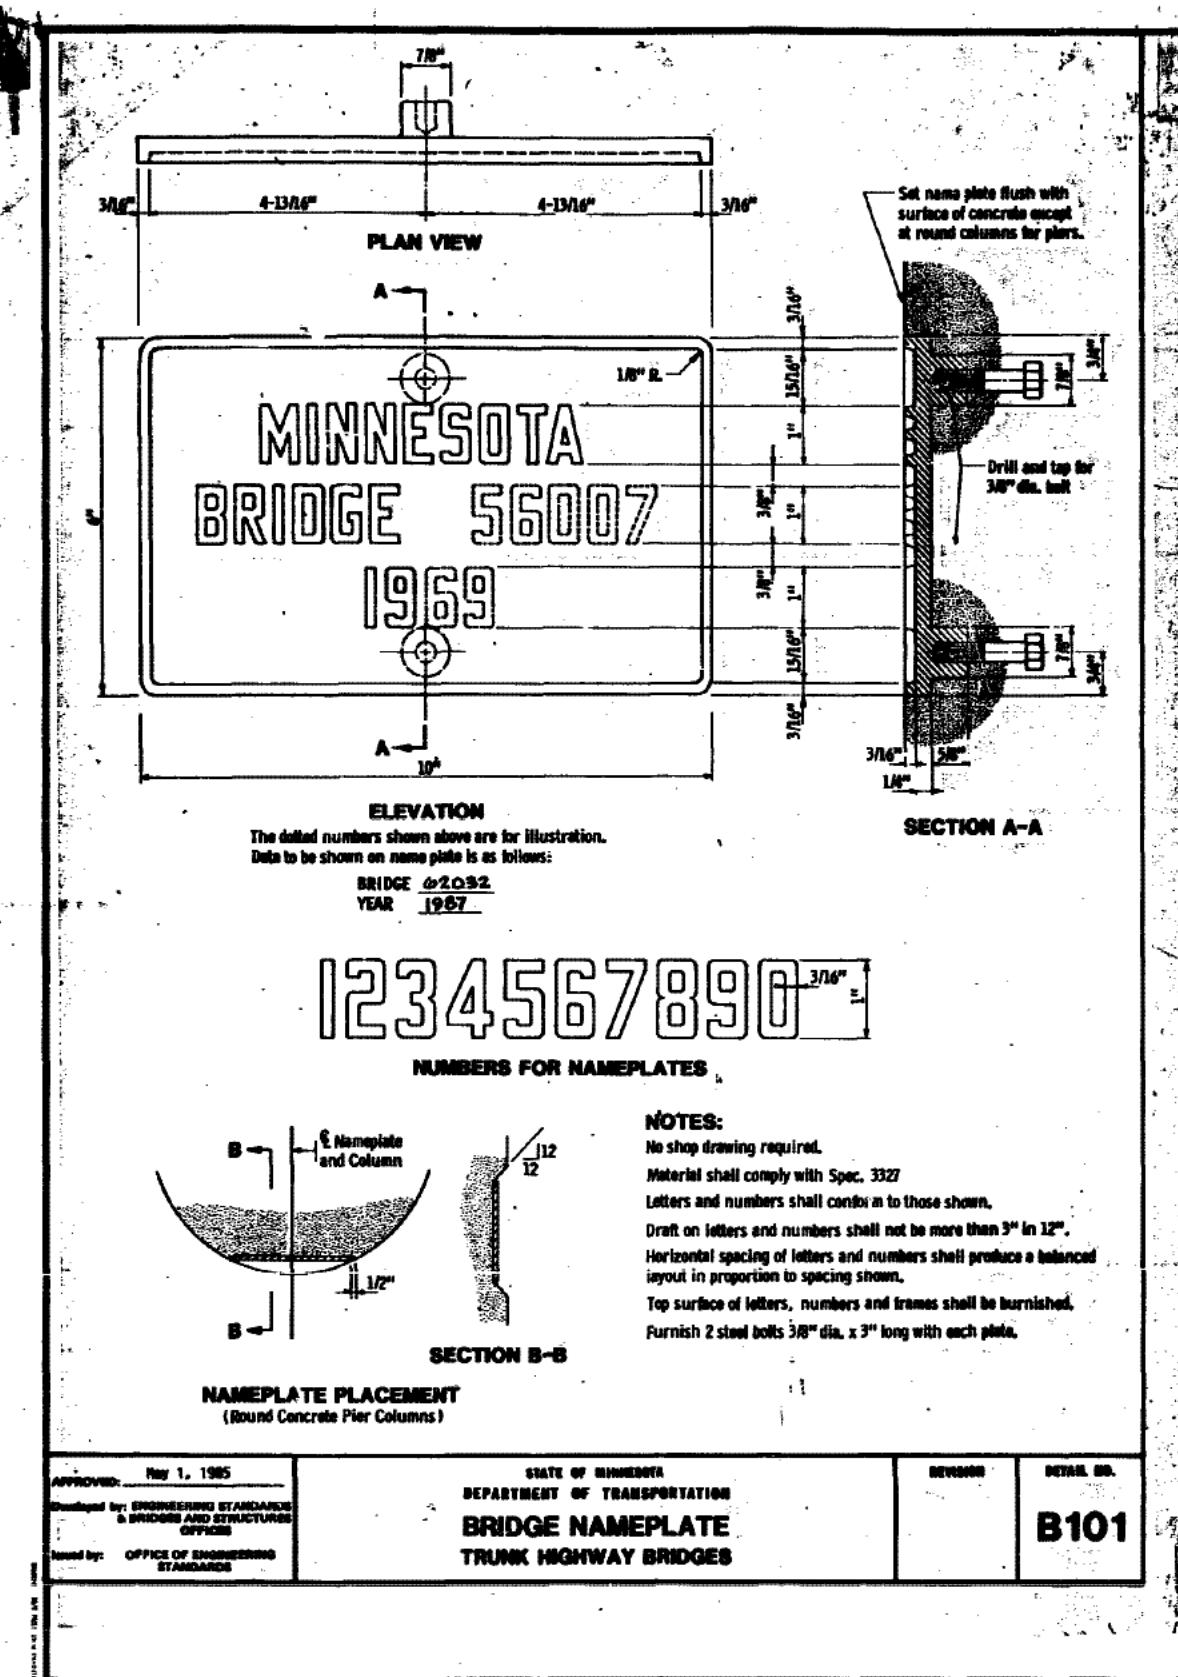


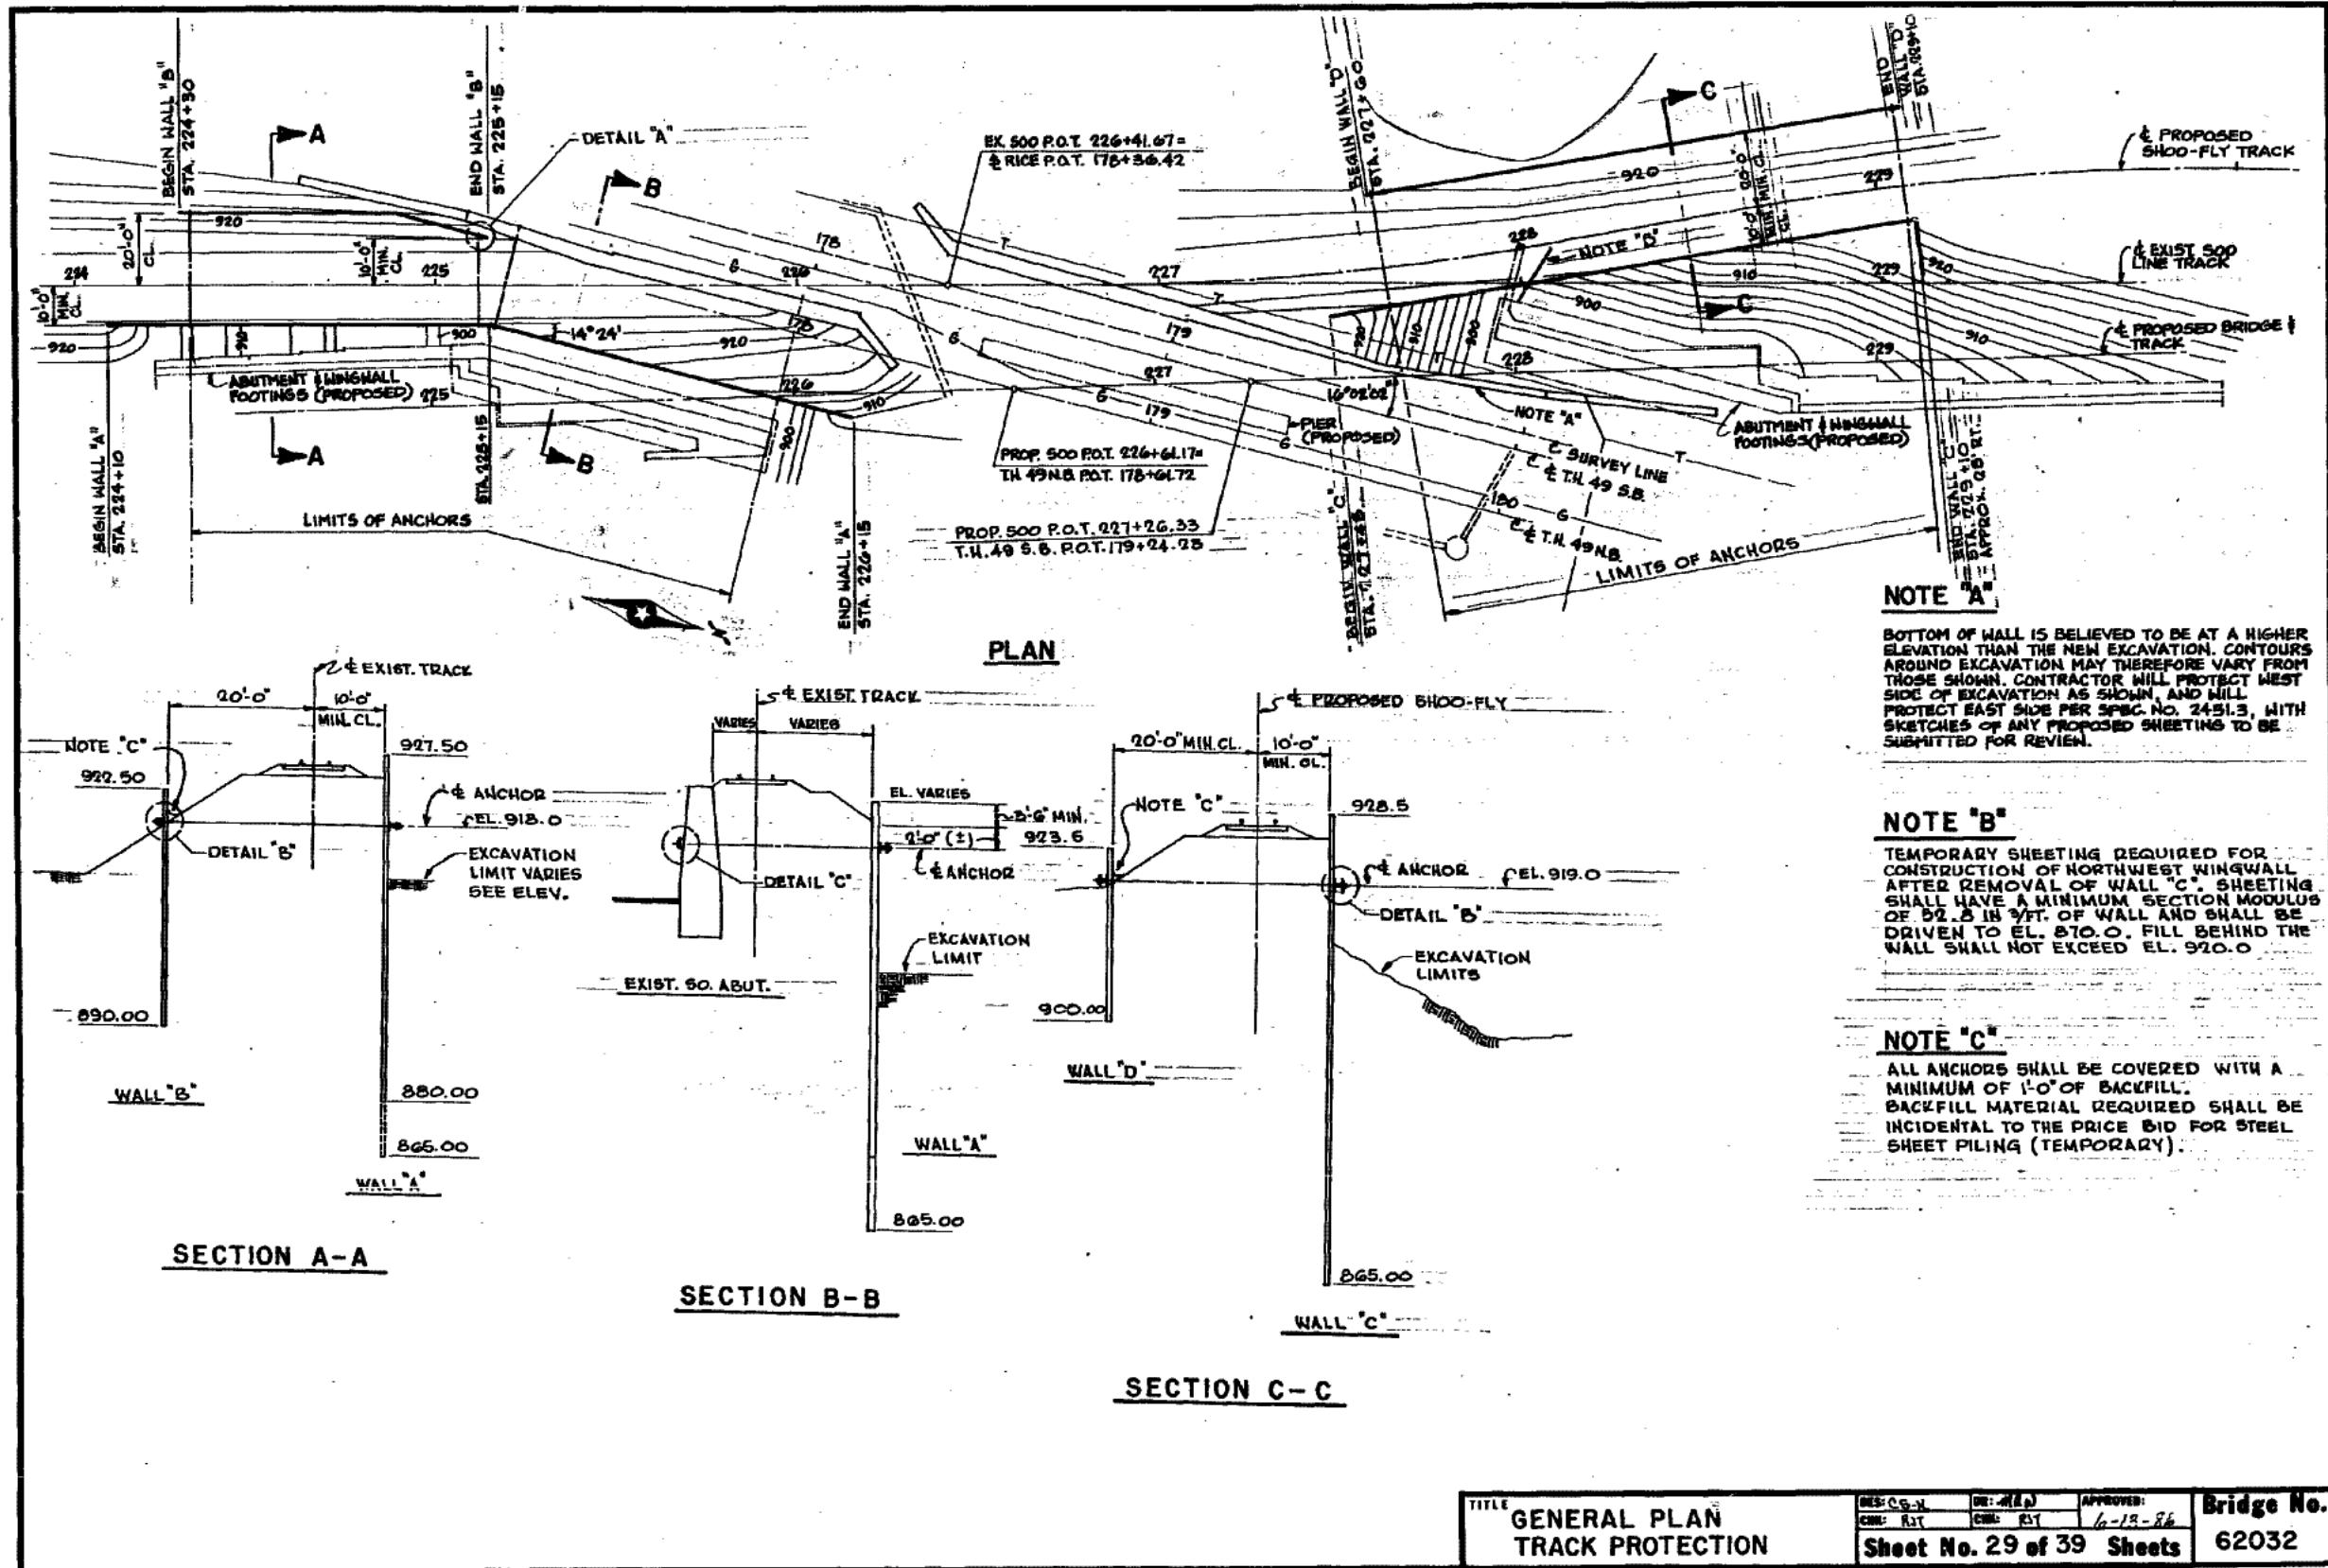


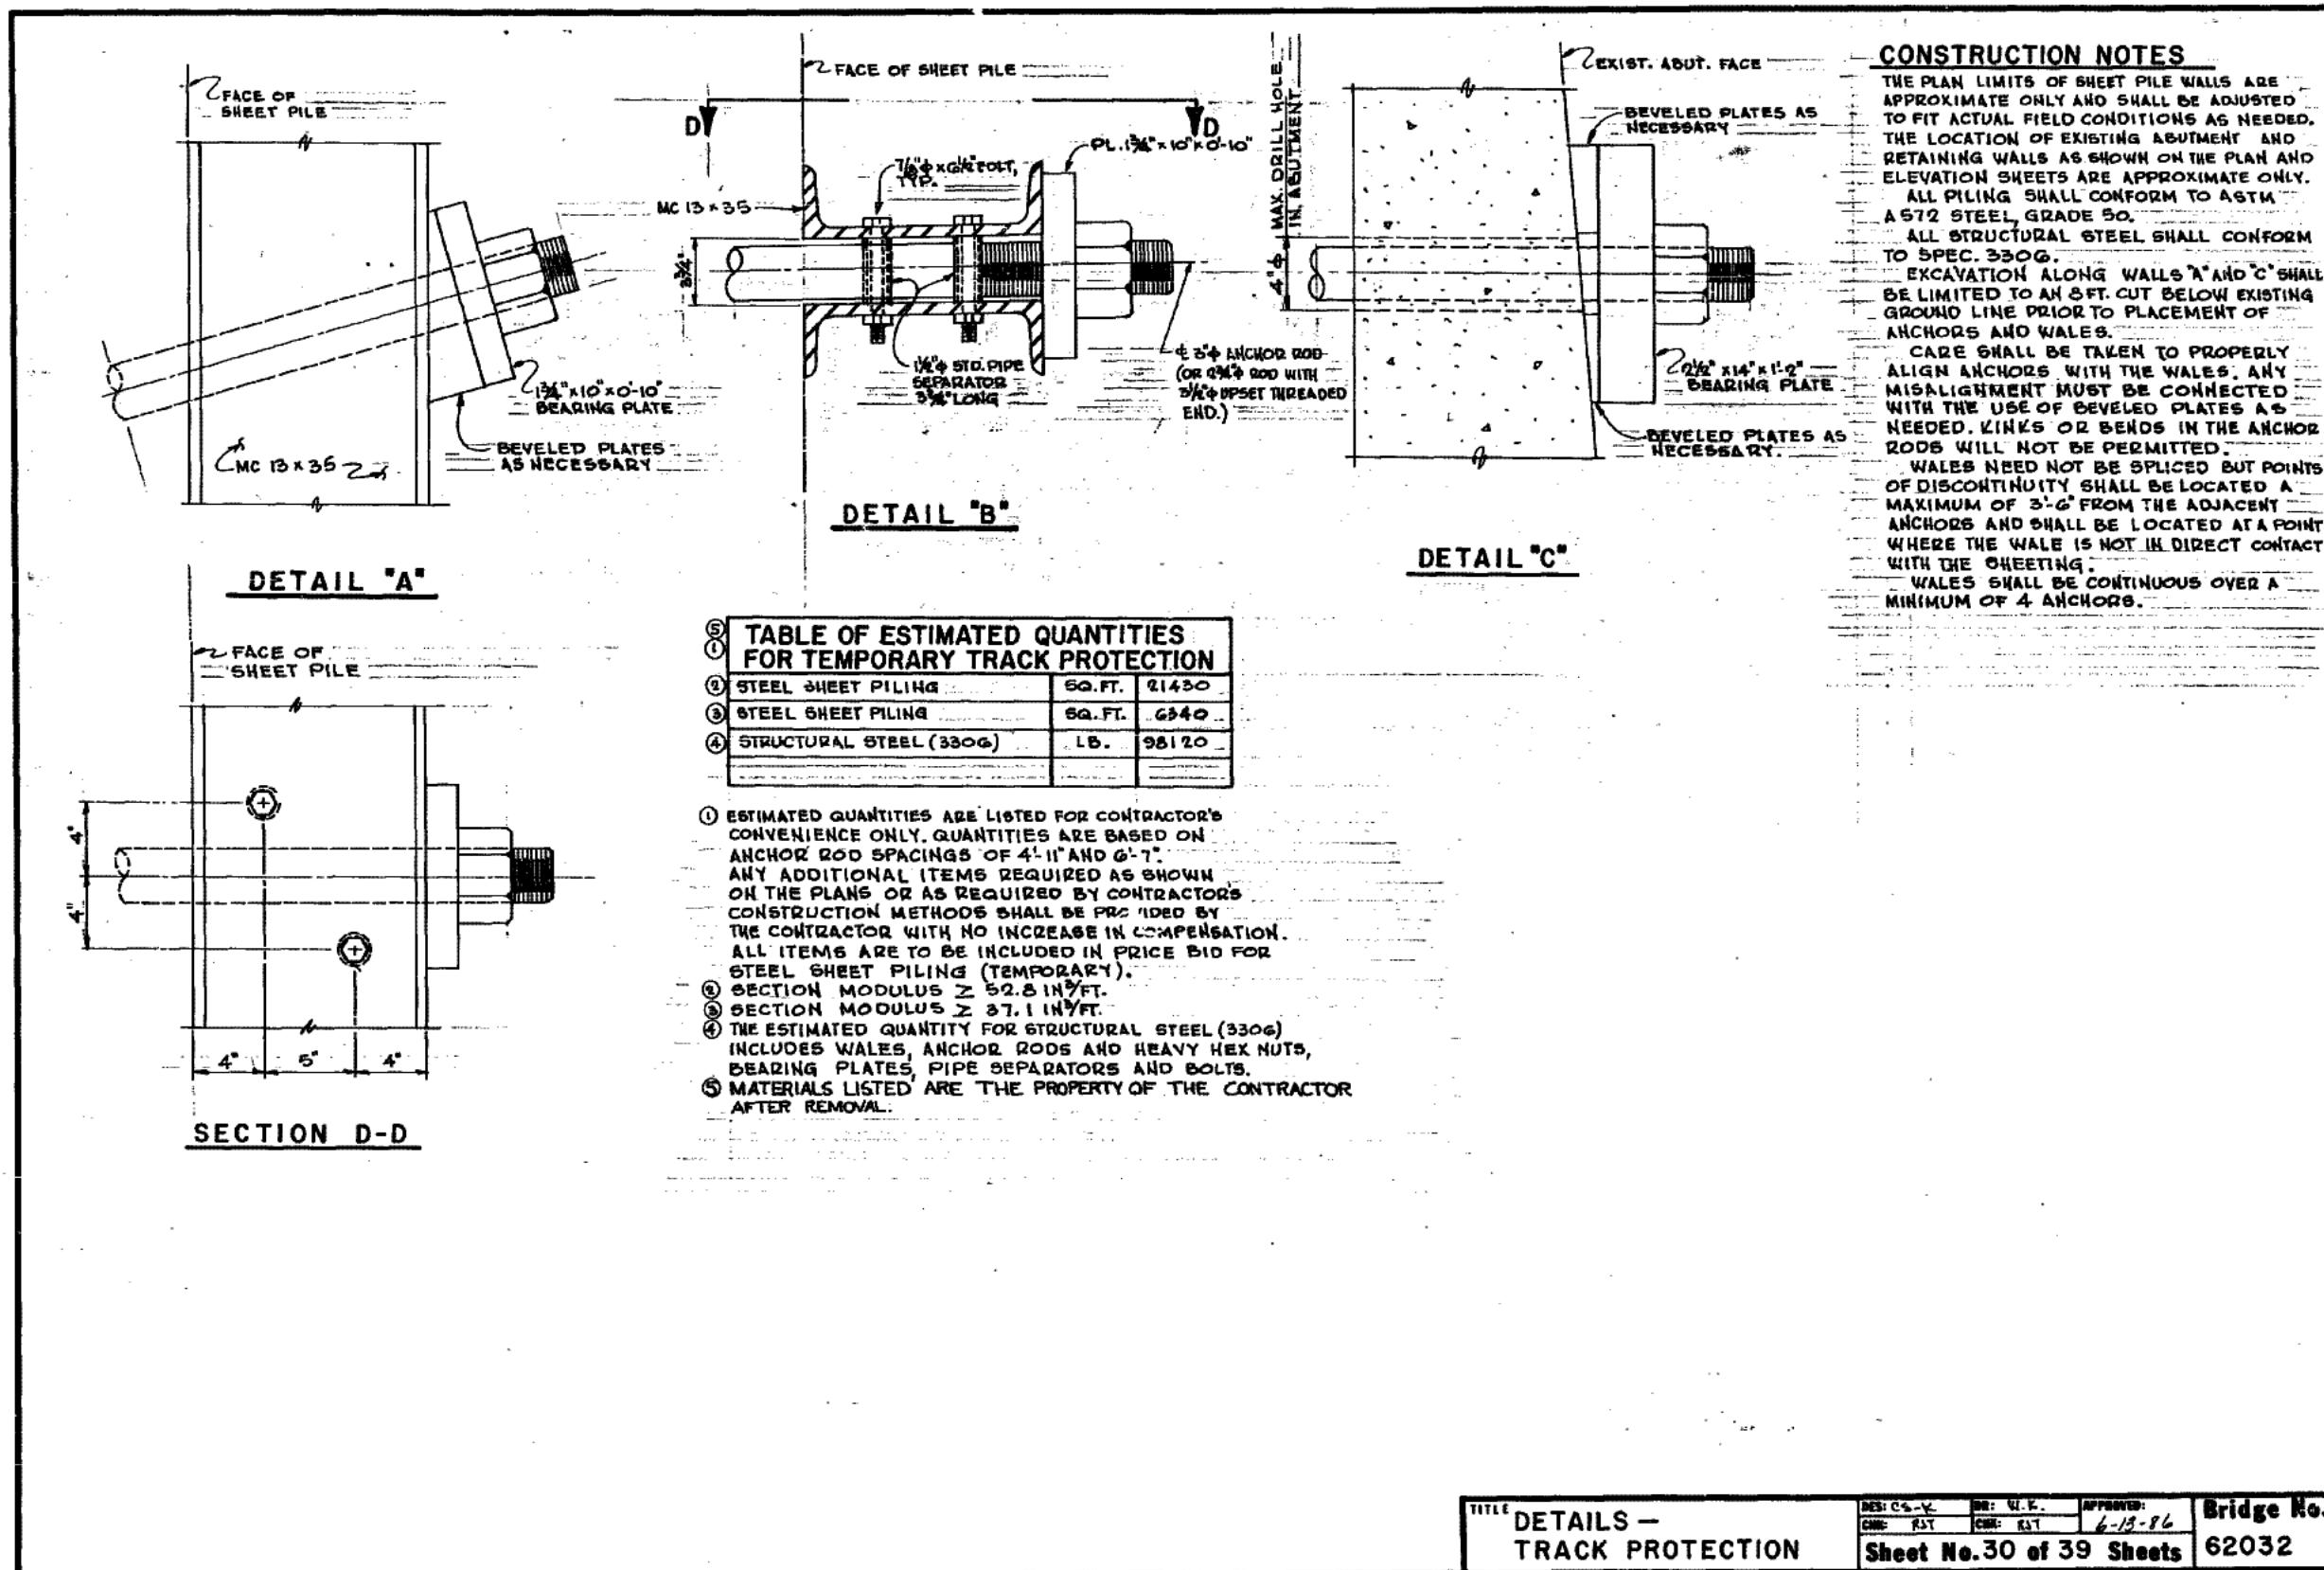

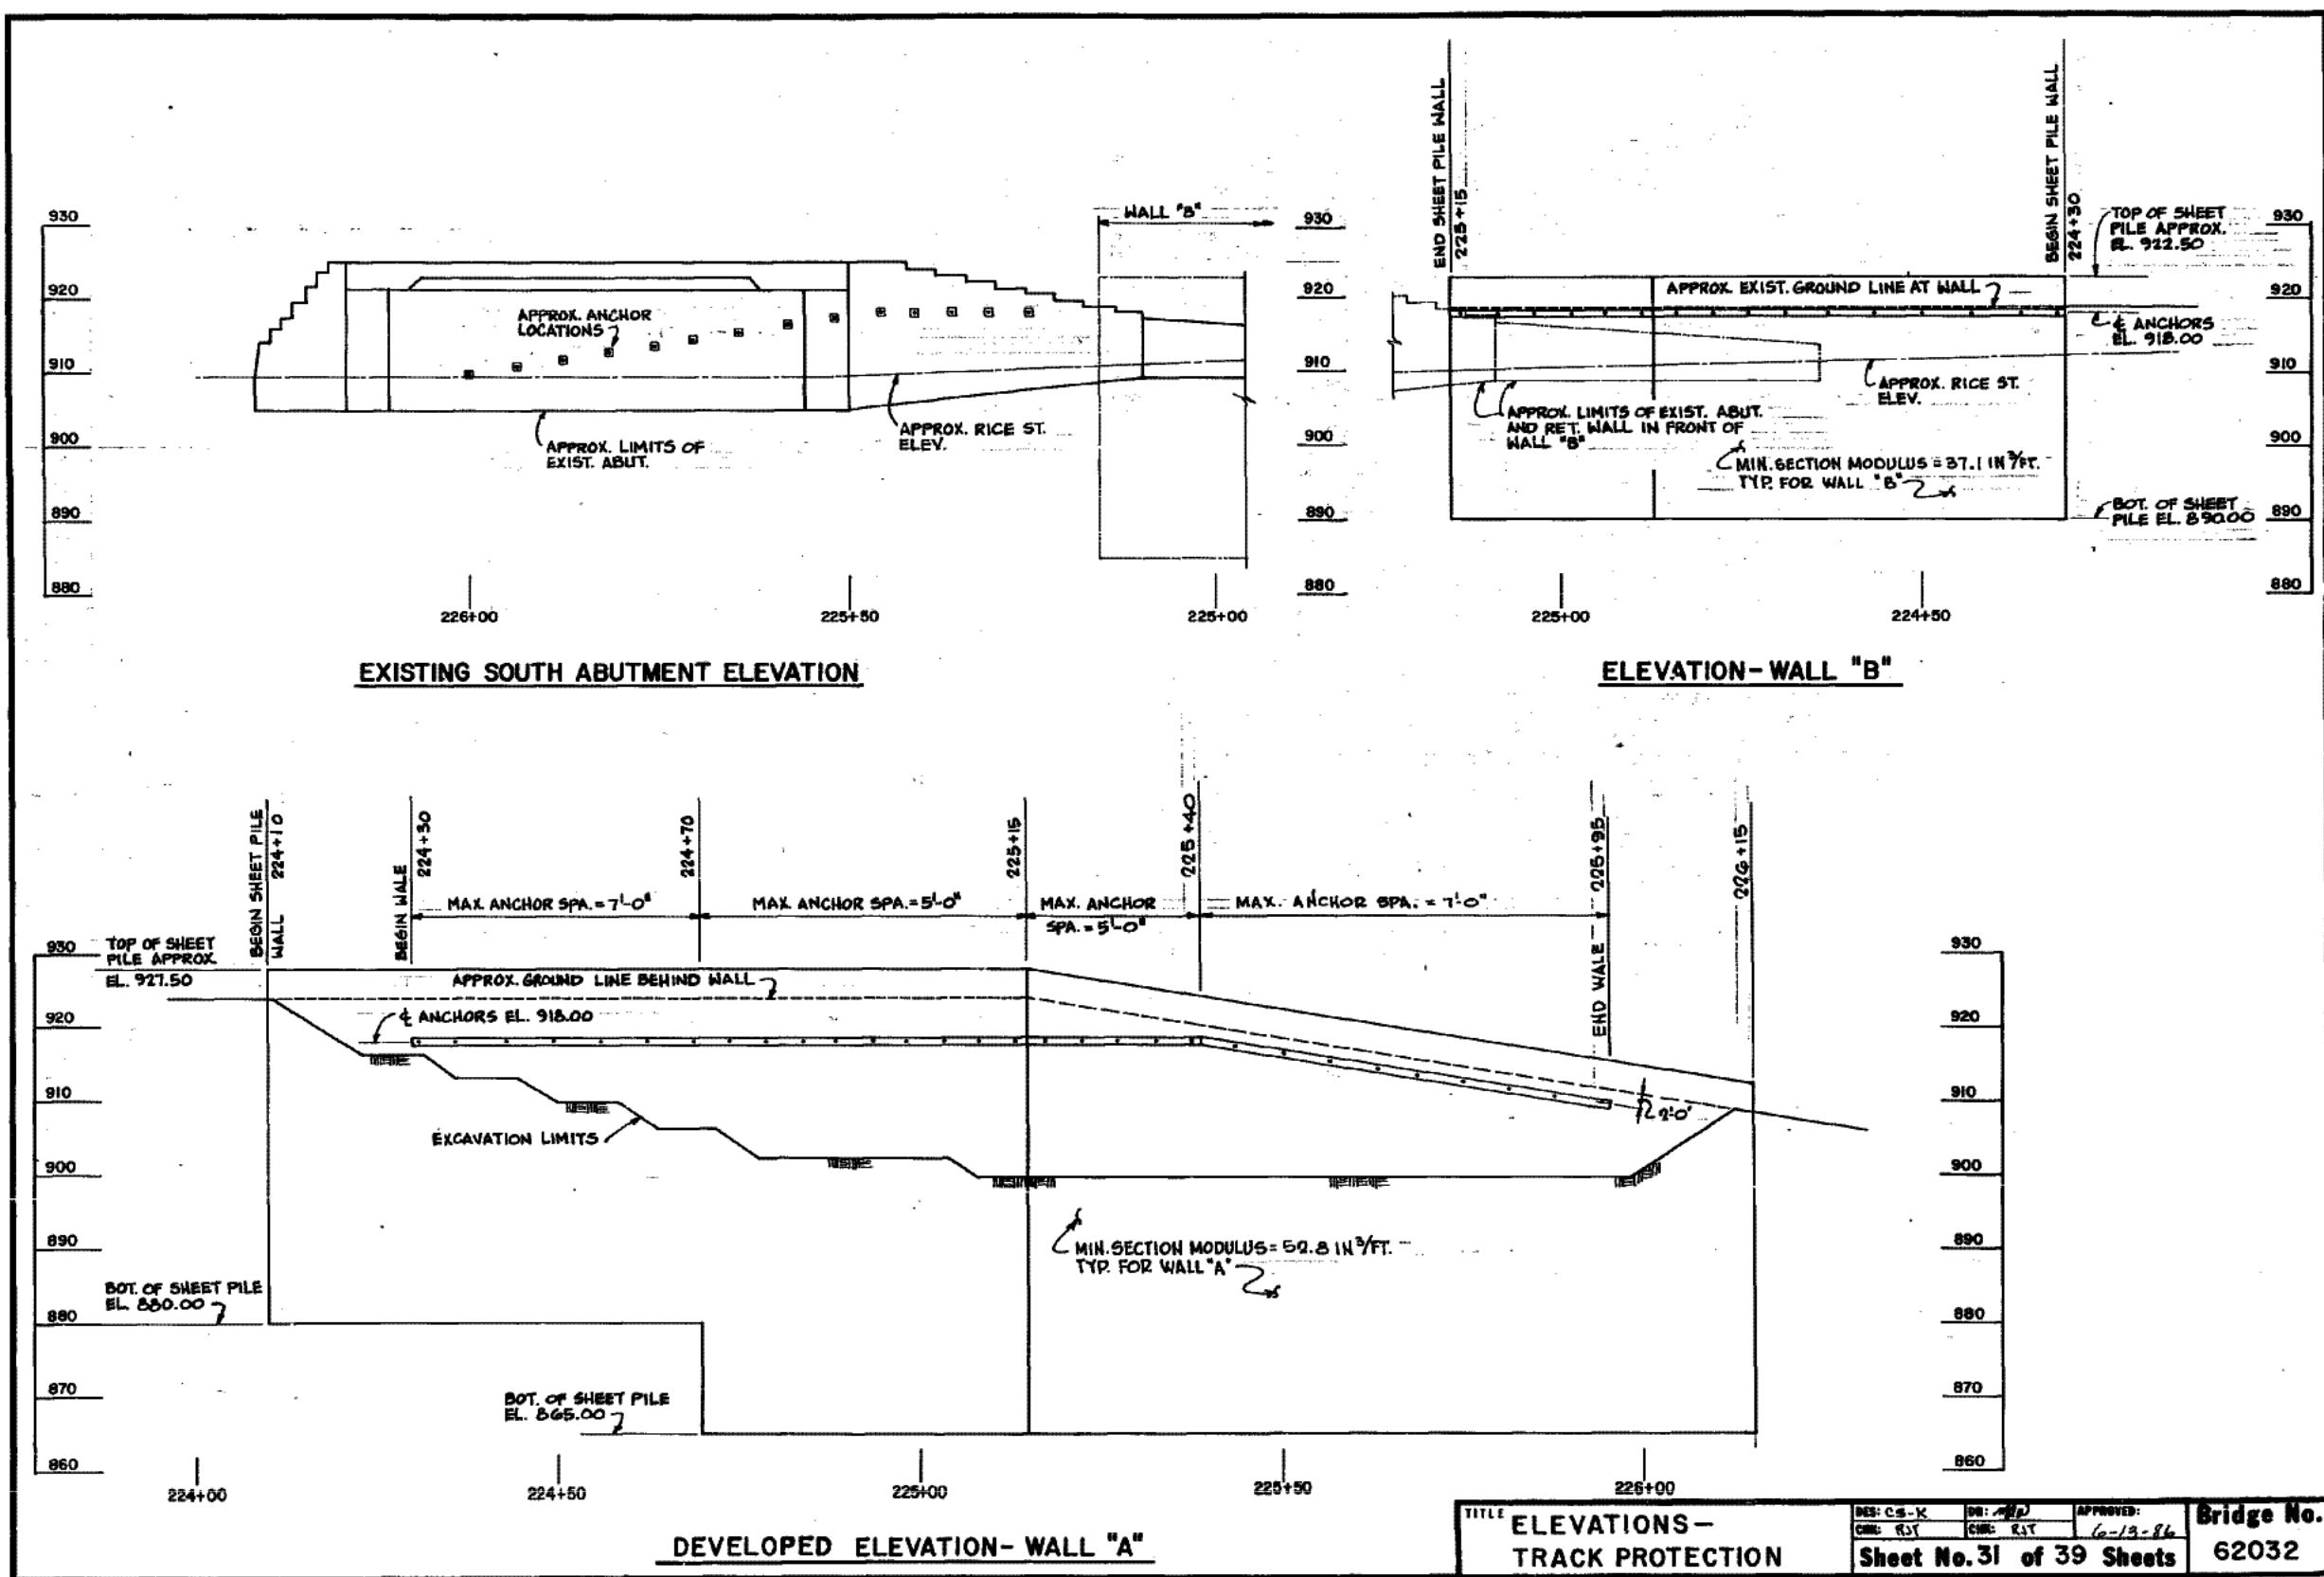

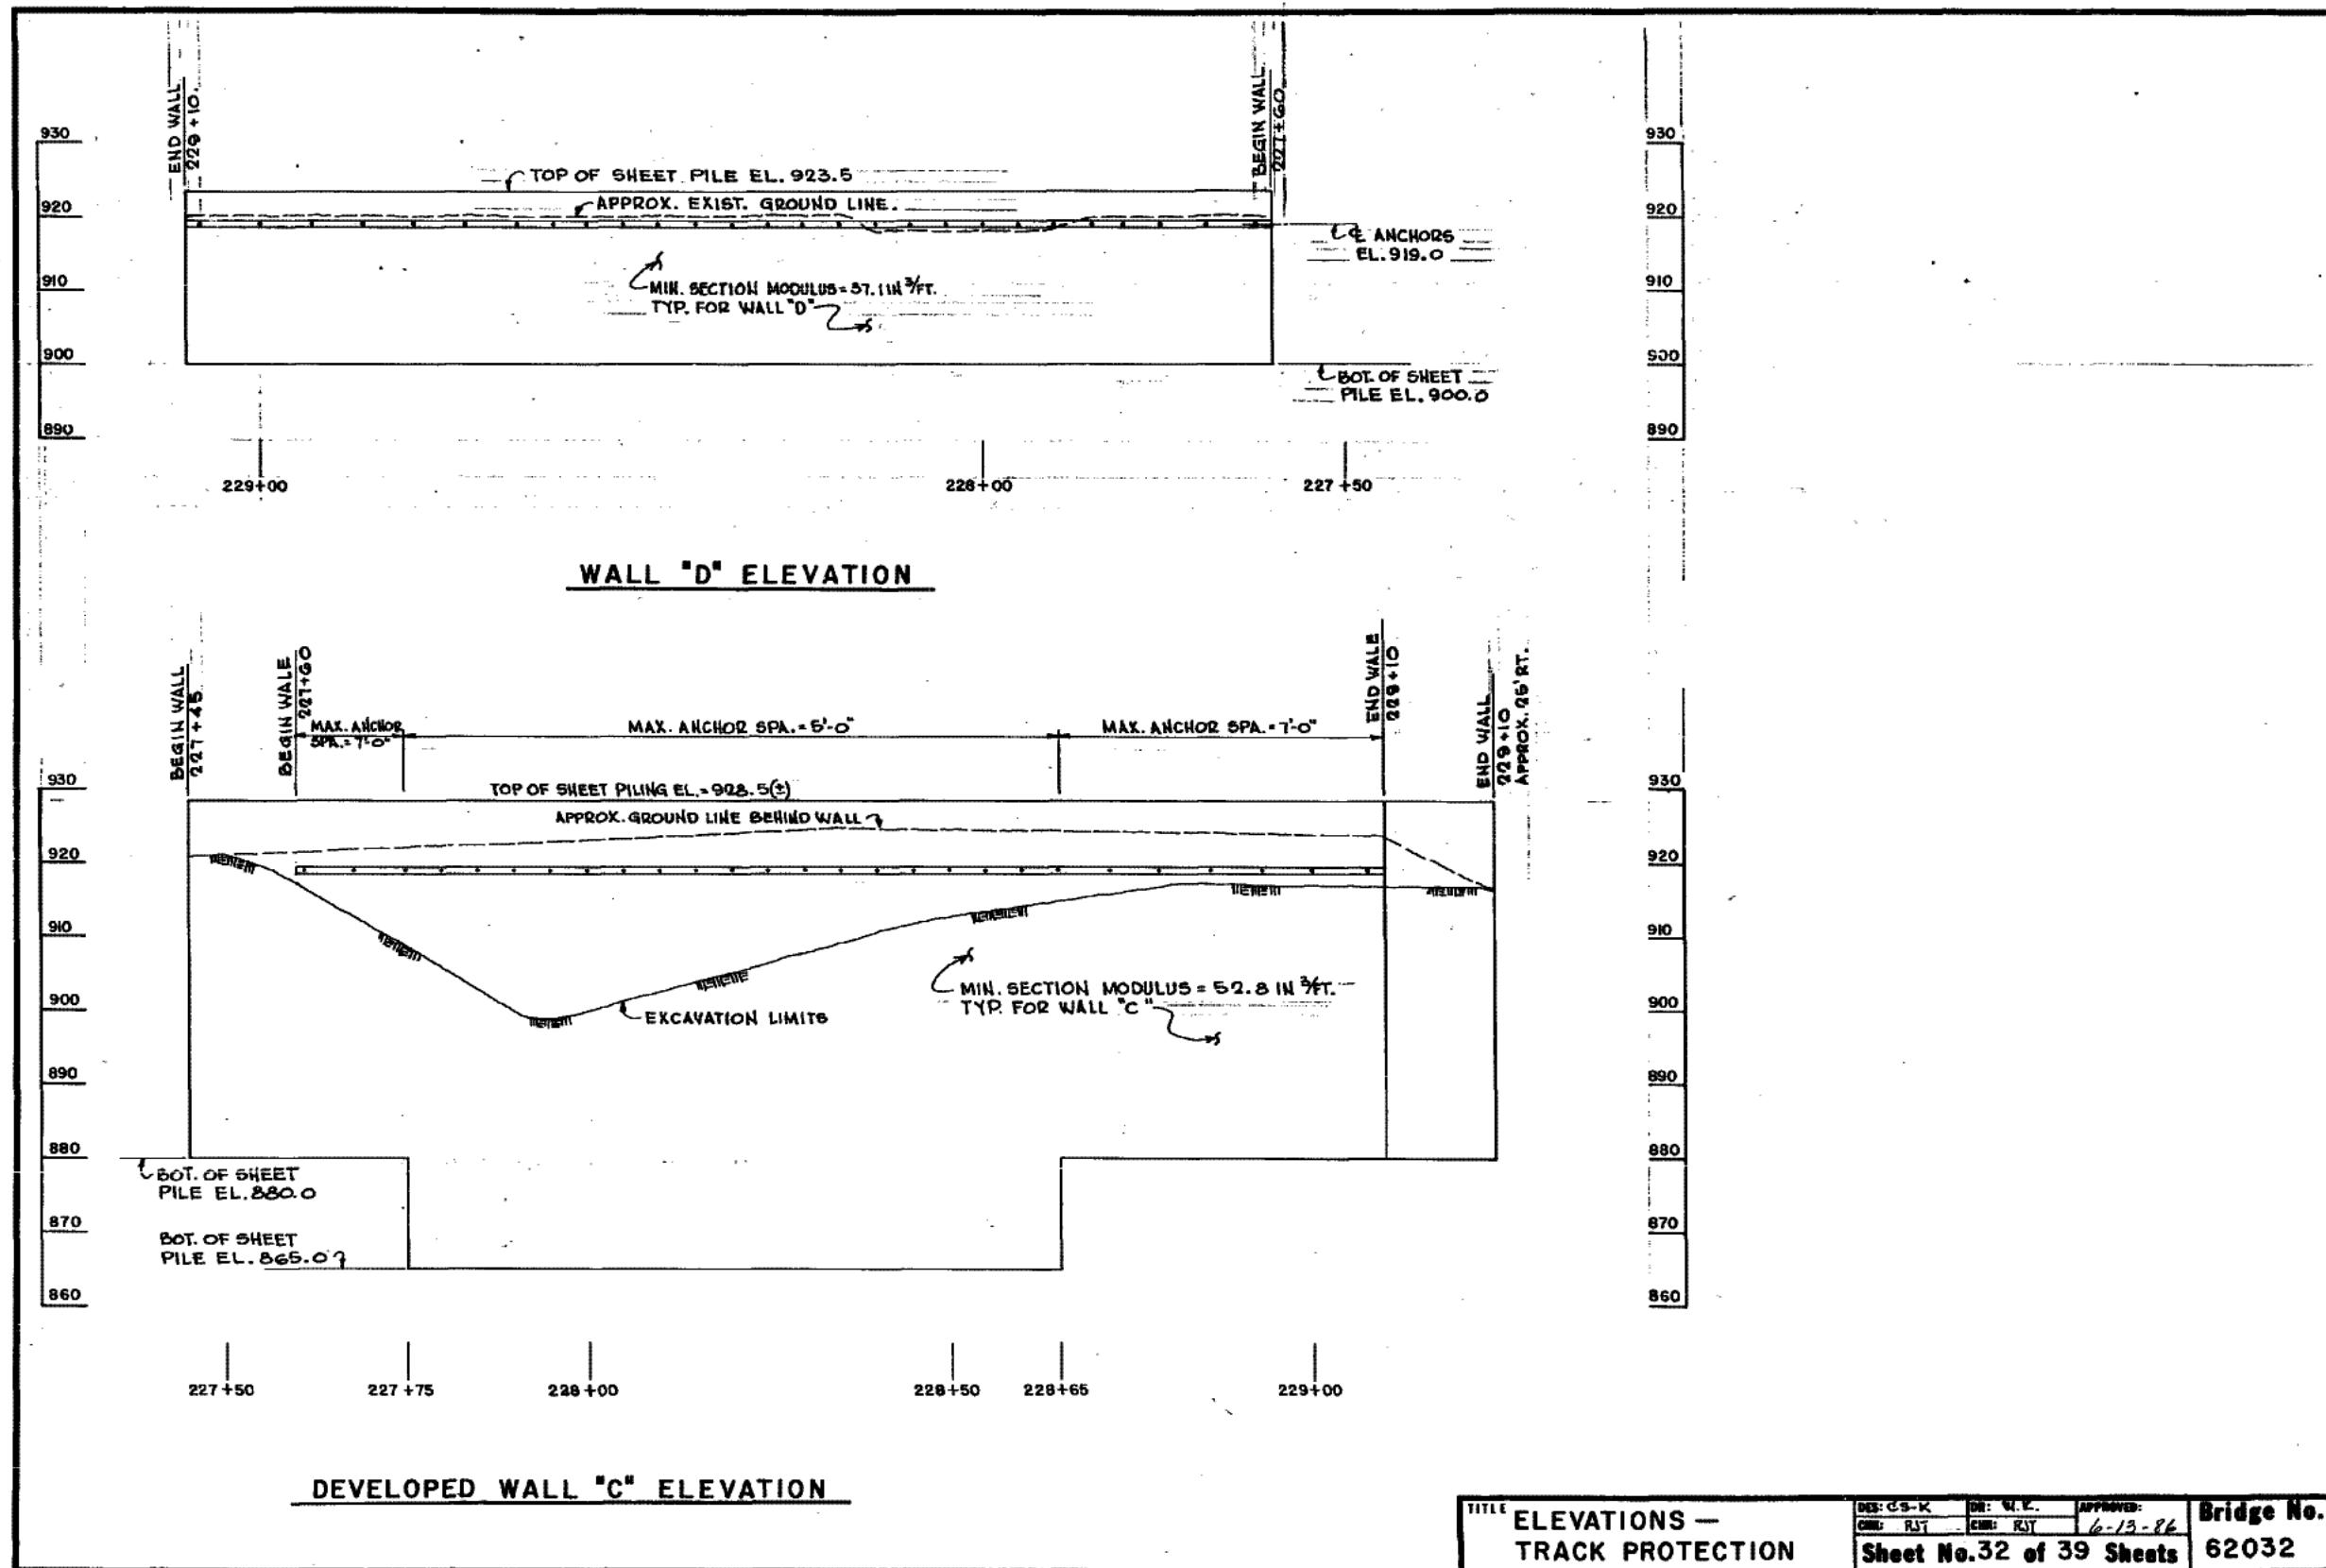

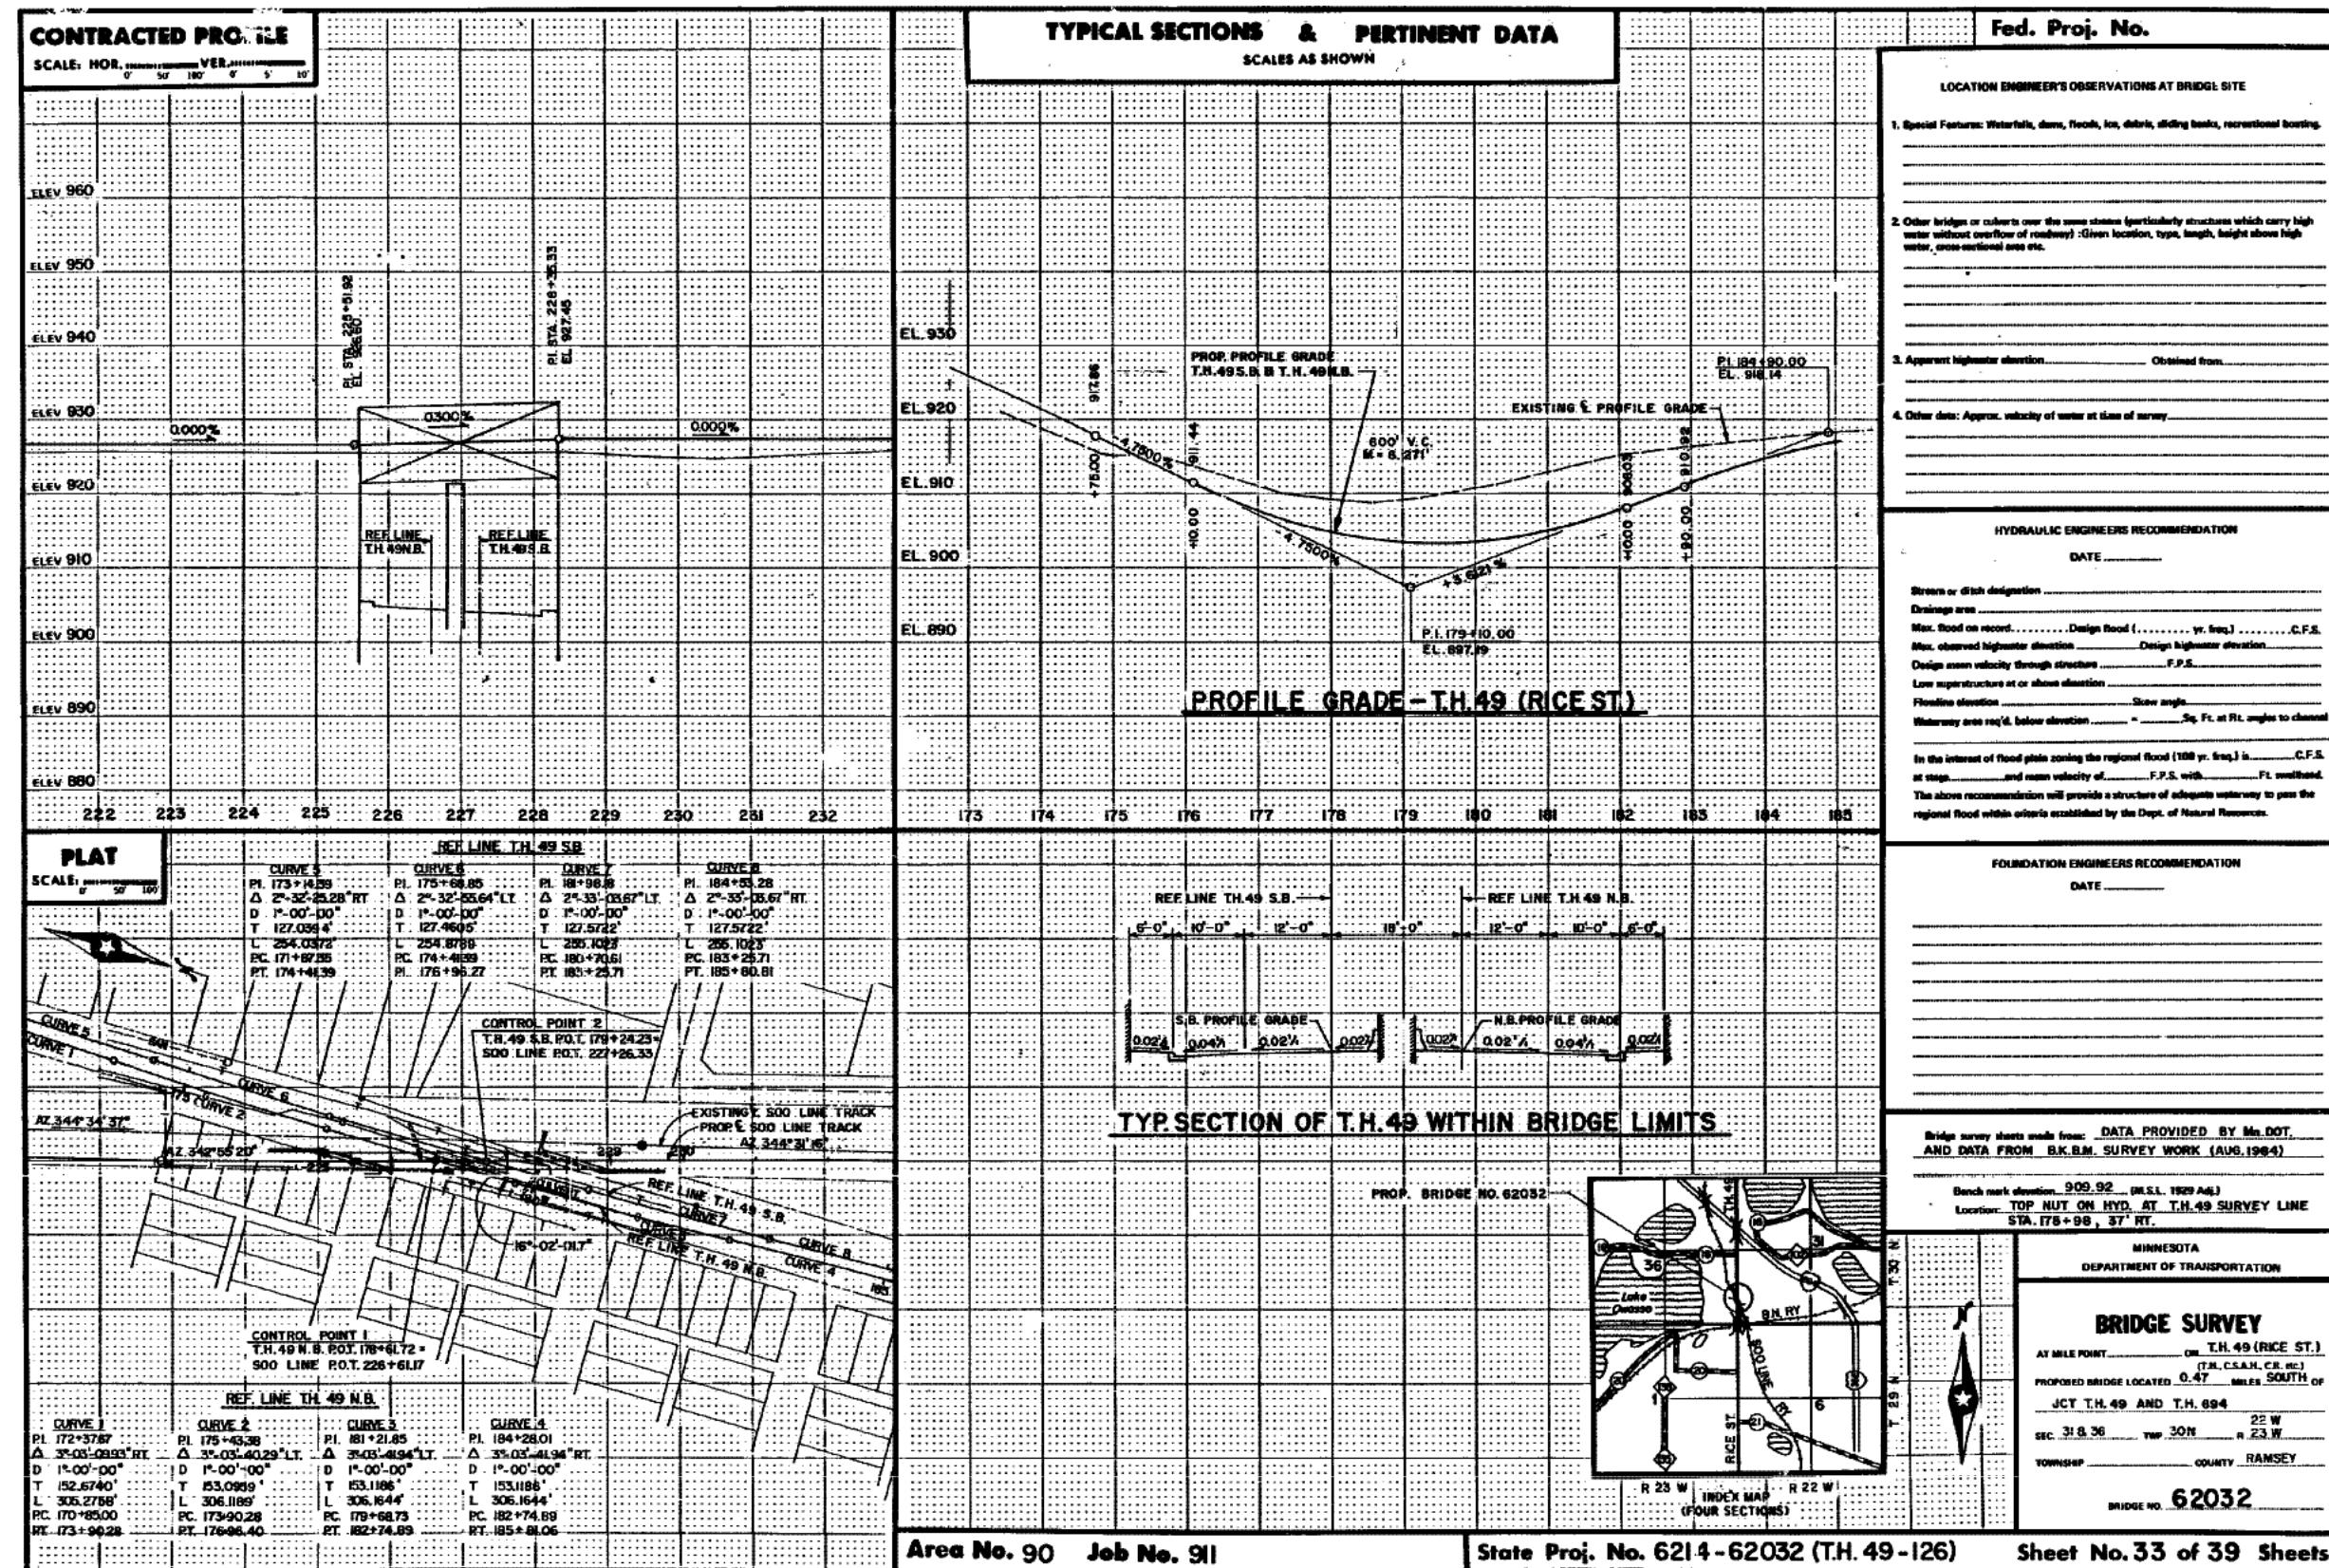

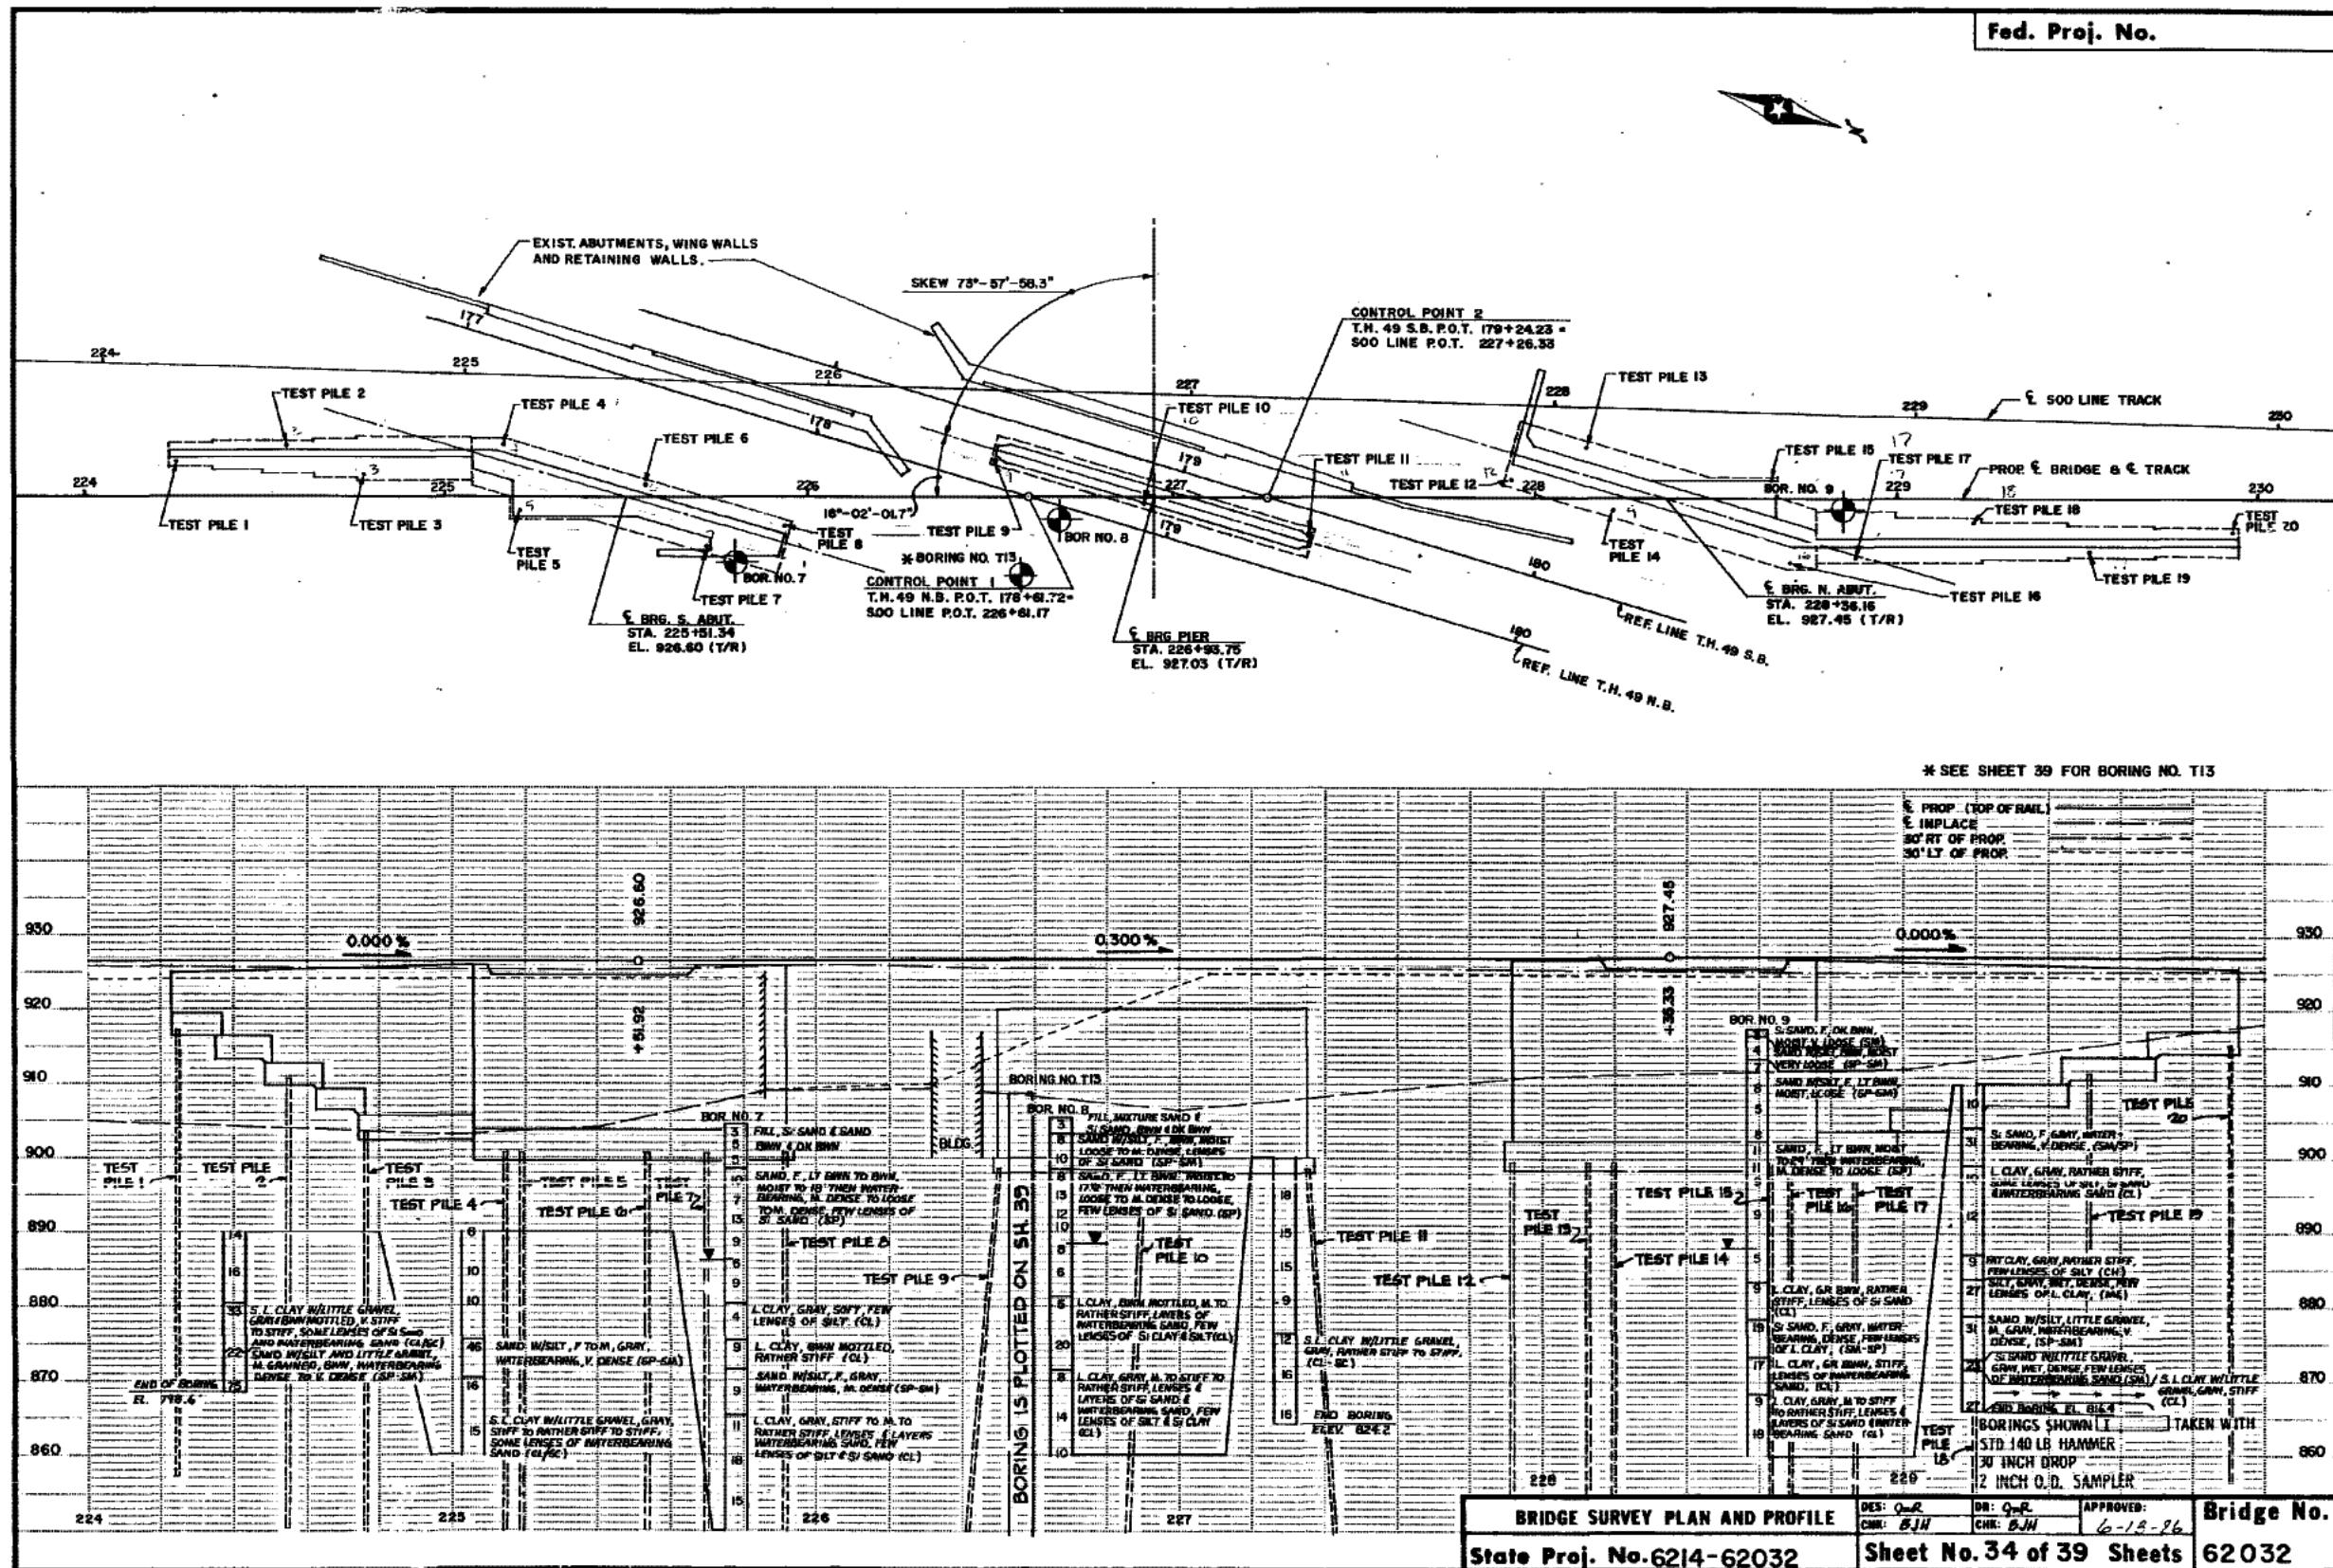

LOG OF TEST BORING											
JOB NO. 120-12463			VERTICAL SCALE 1" = 4'			BORING NO. 7					
PROJECT PROPOSED BRIDGE & ROADWAY IMPROVEMENTS, RICE STREET, LITTLE CANADA, MN											
DEPTH IN FEET	DESCRIPTION OF MATERIAL		GEOLOGIC ORIGIN	N	WL	SAMPLE NO	TYPE	W	D	LL %	O _d
5	FILL, MIXTURE OF SILTY SAND AND SAND, brown and dark brown		FILL	3		1	SB				
6	SAND, fine grained, light brown to brown, moist to 18' then waterbearing, medium dense to loose to medium dense, a few lenses of silty sand (SP)		COARSE ALLUVIUM	5		2	SB				
10				10		4	SB				
13				7		5	SB				
9				9		7	SB				
6				6		8	SB				
9				9		9	SB				
24	LEAN CLAY, gray, soft, a few lenses of silt (CL)		FINE ALLUVIUM	4	10	SB	27	97	*31		
29	LEAN CLAY, brown mottled, rather stiff (CL)										
30	Continued on next page										
	*Estimated dry density										

LOG OF TEST BORING											
JOB NO. 120-12463			VERTICAL SCALE 1" = 4'			BORING NO. 7 (con't)					
PROJECT PROPOSED BRIDGE & ROADWAY IMPROVEMENTS, RICE STREET, LITTLE CANADA, MN											
DEPTH IN FEET	DESCRIPTION OF MATERIAL		GEOLOGIC ORIGIN	N	WL	SAMPLE NO	TYPE	W	D	LL %	O _d
30	LEAN CLAY (con't) (CL)		FINE ALLUVIUM (con't)	9		11	SB				
33	SAND W/SILT, fine grained, gray, waterbearing, medium dense (SP-SM)		COARSE ALLUVIUM	9		12	SB				
39	LEAN CLAY, gray, stiff to medium to rather stiff, lenses and layers of waterbearing sand, a few lenses of silt and silty sand (CL)		FINE ALLUVIUM	11		13	SB				
60	Continued on next page										

LOG OF TEST BORING											
JOB NO. 120-12463			VERTICAL SCALE 1" = 4'			BORING NO. 7 (con't)					
PROJECT PROPOSED BRIDGE & ROADWAY IMPROVEMENTS, RICE STREET, LITTLE CANADA, MN											
DEPTH IN FEET	DESCRIPTION OF MATERIAL		GEOLOGIC ORIGIN	N	WL	SAMPLE NO	TYPE	W	D	LL %	O _d
60	LEAN CLAY (con't) (CL)		FINE ALLUVIUM (con't)	10		17	SB				
69	SAND W/SILT, fine to medium grained, gray, waterbearing, very dense (SP-SM)		COARSE ALLUVIUM	46		19	SB				
74	SANDY LEAN CLAY W/A LITTLE GRAVEL, gray, stiff to rather stiff to stiff, some lenses of waterbearing sand (CL/SC)		TILL	16		20	SB				
90	Continued on next page										

*Estimated dry density

*Estimated dry density

TITLE: TEST BORING LOGS

DES: S.E.C. CON: GUL	DIS: S.E.C. CON: B.H.	APPROVED: 6-13-86	Bridge No. 62032
Sheet No. 35 of 39 Sheets			

LOG OF TEST BORING										
JOB NO. 120-12463		VERTICAL SCALE 1" = 4'		BORING NO. 7 (con't)						
PROJECT PROPOSED BRIDGE & ROADWAY IMPROVEMENTS, RICE STREET, LITTLE CANADA, MN										
DEPTH IN FEET	DESCRIPTION OF MATERIAL	GEOLOGIC ORIGIN	N	WL	SAMPLE	LABORATORY TESTS	W	D	LL PL	
90	SANDY LEAN CLAY W/A LITTLE GRAVEL (con't) (CL-SC)	TILL (con't)	16	23	SB					
94	SANDY LEAN CLAY W/A LITTLE GRAVEL, gray and brown mottled, very stiff to stiff, some lenses of silty sand and waterbearing sand (CL/SC)		33	24	SB					
100	SAND W/SILT AND A LITTLE GRAVEL, medium grained, brown, waterbearing, dense to very dense (SP-SM)	COARSE ALLUVIUM	22	25	SB					
106	End of Boring		75	26	SB					
WATER LEVEL MEASUREMENTS					START 11-7-84	COMPLETE 11-8-84				
DATE	TIME	SAMPLED DEPTH	CASING DEPTH	CASE-IN DEPTH	BURIED DEPTHS	WATER LEVEL	METHOD HSA 0' - 19½' DM 19½' - 10½'			2:00
11-7	3:10	21'	19½'	"	"	18'				
11-8	2:00	106'	19½'	"	"	NMR				
11-8	2:45	106'	None	"	"	NMR				
CREW CHIEF Kulhanek										
TEST BORING LOGS							REF: S.E.C. REC: S.E.C. APPROVED:	Bridge No.		
							CHG: 62 CCH: 614 6-13-86	62032		
							Sheet No. 36 of 39 Sheets			

LOG OF TEST BORING											
JOB NO. 120-12463 VERTICAL SCALE 1" = 4' BORING NO. 8			PROJECT: PROPOSED BRIDGE & ROADWAY IMPROVEMENTS, RICE STREET, LITTLE CANADA, MN			DEPTH IN FEET			DESCRIPTION OF MATERIAL		
			N	WL	SAMPLE NO.	TYPE	W	D	LL	PL	DU
2	FILL, MIXTURE OF SAND AND SILTY SAND, brown and dark brown	FILL	3	1	SB						
7	SAND W/SILT, fine grained, brown, moist, loose to medium dense, lenses of silty sand (SP-SM)	COARSE ALLUVIUM	8	2	SB						
10			10	3	SB						
13	SAND, fine grained, light brown, moist to 17½' then waterbearing, loose to medium dense to loose, a few lenses of silty sand (SP)	MA	8	4	SB						
12			12	6	SB						
10			10	7	SB						
8			8	8	SB						
6			6	9	SB	NSR					
24	LEAN CLAY, brown mottled, medium to rather stiff, layers of waterbearing sand, a few lenses of silty clay and silt (CL)	FINE ALLUVIUM	5	10	SB	24	101				
30	Continued on next page										
	*Estimated dry density										

LOG OF TEST BORING											
JOB NO. 120-12463 VERTICAL SCALE 1" = 4' BORING NO. 8 (cont)			PROJECT: PROPOSED BRIDGE & ROADWAY IMPROVEMENTS, RICE STREET, LITTLE CANADA, MN			DEPTH IN FEET			DESCRIPTION OF MATERIAL		
			N	WL	SAMPLE NO.	TYPE	W	D	LL	PL	DU
30	LEAN CLAY (cont) (CL)	FINE ALLUVIUM (cont)	20	11	SB						
34	LEAN CLAY, gray, medium to stiff to rather stiff, lenses and layers of silty sand and waterbearing sand, a few lenses of silt and silty clay (CL)	MA	8	12	SB	NSR					
14			14	13	SB						
10			10	14	SB	27	97				
18			18	15	SB						
15			15	16	SB						
60	Continued on next page										
	*Estimated dry density										

LOG OF TEST BORING											
JOB NO. 120-12463 VERTICAL SCALE 1" = 4' BORING NO. 8 (cont)			PROJECT: PROPOSED BRIDGE & ROADWAY IMPROVEMENTS, RICE STREET, LITTLE CANADA, MN			DEPTH IN FEET			DESCRIPTION OF MATERIAL		
			N	WL	SAMPLE NO.	TYPE	W	D	LL	PL	DU
60	LEAN CLAY (cont) (CL)	FINE ALLUVIUM (cont)	15	17	SB						
69	SANDY LEAN CLAY W/A LITTLE GRAVEL, gray, rather stiff to stiff (CL/SC)	TILL	9	18	SB						
12			12	19	SB						
16			16	20	SB						
16			16	21	SB						
81	End of Boring										

WATER LEVEL MEASUREMENTS											
DATE	TIME	SAMPLED DEPTH	CARDING DEPTH	FORWARD DEPTH	BAKED DEPTH	WATER LEVEL	START 11-6-84	COMPLETE 11-7-84	METHOD: IISA G-19½'	12:15	
11-6	9:00	21'	19½'	"	"	17½'			DM 19½' - 79½'		
11-7	12:15	81'	19½'	"	"	NMR					
11-7	1:40	81'	None	"	"	NMR					
						"					

TEST BORING LOGS											
DESIGN S.E.C.	DESIGN S.E.C.	APPROVED:	Bridge No.								
CHIEF: AmR	CHIEF: BJH	6-13-86	62032								
Sheet No. 37 of 39 Sheets											

LOG OF TEST BORING												
JOB NO. 120-12463		VERTICAL SCALE 1" = 4'		BORING NO. 9								
PROJECT PROPOSED BRIDGE & ROADWAY IMPROVEMENTS, RICE STREET, LITTLE CANADA, MN												
DEPTH IN FEET	SURFACE ELEVATION ft	DESCRIPTION OF MATERIAL	GEOLOGIC ORIGIN	N	WL	SAMPLE NO.	TYPE	LABORATORY TESTS	W	D	$\frac{1}{2}$ FL	On
1	517.4	SILTY SAND, fine grained, dark brown, moist, very loose (SM)	TOPSOIL	3		1	SB					
		SAND W/SILT, brown, moist, very loose (SP-SM)	COARSE ALLUVIUM	4		2	SB					
4		SAND W/SILT, fine grained, light brown, moist, loose (SP-SM)		7		3	SB					
				8		4	SB					
				5		5	SB					
				8		6	SB					
15		SAND, fine grained, light brown, moist to 29' then waterbearing, medium dense to loose (SP)		11		7	SB					
				11		8	SB					
				9		9	SB					
				9		10	SB					
				9		11	SB					
30		Continued on next page										

LOG OF TEST BORING												
JOB NO. 120-12463		VERTICAL SCALE 1" = 4'		BORING NO. 9 (cont'd)								
PROJECT PROPOSED BRIDGE & ROADWAY IMPROVEMENTS, RICE STREET, LITTLE CANADA, MN												
DEPTH IN FEET	SURFACE ELEVATION ft	DESCRIPTION OF MATERIAL	GEOLOGIC ORIGIN	N	WL	SAMPLE NO.	TYPE	LABORATORY TESTS	W	D	$\frac{1}{2}$ FL	On
30		SAND (cont'd) (SP)	COARSE ALLUVIUM (cont'd)	5		12	SB					
34		LEAN CLAY, grayish brown, rather stiff, lenses of silty sand (CL)	FINE ALLUVIUM	9		13	SB					
39		SILTY SAND, fine grained, gray, waterbearing, dense, a few lenses of lean clay (SM/SP)	COARSE ALLUVIUM	19		14	SB					
44		LEAN CLAY, grayish brown, stiff, lenses of waterbearing sand (CL)	FINE ALLUVIUM	17		15	SB					
49		LEAN CLAY, gray, medium to stiff to rather stiff, lenses and layers of silty sand and waterbearing sand (CL)		9		16	SB	27	97	*		
60		Continued on next page										

*Estimated dry density

LOG OF TEST BORING												
JOB NO. 120-12463		VERTICAL SCALE 1" = 4'		BORING NO. 9 (cont'd)								
PROJECT PROPOSED BRIDGE & ROADWAY IMPROVEMENTS, RICE STREET, LITTLE CANADA, MN												
DEPTH IN FEET	SURFACE ELEVATION ft	DESCRIPTION OF MATERIAL	GEOLOGIC ORIGIN	N	WL	SAMPLE NO.	TYPE	LABORATORY TESTS	W	D	$\frac{1}{2}$ FL	On
60		LEAN CLAY (cont'd) (CL)	FINE ALLUVIUM	10		16	SB					
63		SILTY SAND, fine grained, gray, waterbearing, very dense (SM/SP)	COARSE ALLUVIUM	31		19	SB					
68		LEAN CLAY, gray, rather stiff, some lenses of silt, silty sand and waterbearing sand (CL)	FINE ALLUVIUM	10		20	SB					
80		FAT CLAY, gray, rather stiff, a few lenses of silt (CH)		12		21	SB					
83		SILT, gray, wet, dense, a few lenses of lean clay (ML)		9		22	SB	39	*	82	99	33
88		SAND W/SILT AND A LITTLE (See #1) (SP-SM)	COARSE ALLUVIUM	27		23	SB					
90		Continued on next page										
		#1 - GRAVEL, medium grained, gray, waterbearing, very dense (SP-SM)										
		*Estimated dry density										

Sheet No. 38 of 39 Sheets

BRIDGE 62032 (1986)

LOG OF TEST BORING												
JOB NO.	120-12463	VERTICAL SCALE	1" = 4'	BORING NO.	9 (cont'd)							
PROJECT	PROPOSED BRIDGE & ROADWAY IMPROVEMENTS, RICE STREET, LITTLE CANADA, MINN.											
DEPTH IN FEET	DESCRIPTION OF MATERIAL	GEOLOGIC ORIGIN	N	W	HO	TYPE	W	D	LL	PL	Oe	
90	SAND W/SILT AND A LITTLE GRAVEL (cont'd) (SP-SM)	COARSE ALLUVIUM (cont'd)	31		24	SB						
94	SILTY SAND W/A LITTLE GRAVEL, (See #1) (SM)				25	SB						
95	SANDY LEAN CLAY W/A LITTLE GRAVEL, gray, stiff (CL)	TILL	23		26	SB						
101	End of Boring #1 - gray, wet, dense, a few lenses of waterbearing sand (SM)		27		27	SB	NSR					
WATER LEVEL MEASUREMENTS										11-5-84	11-6-84	
DATE	TIME	SAMPLED DEPTH	CASING DEPTH	CORE-IN DEPTH	BAILED DEPTH	WATER LEVEL	START				COMPLETED	
11-6	8:45	31'	29 1/2'	"	29'	METHO HSA 0' - 29'	12:40					
11-6	12:40	101'	29 1/2'	"	"	DN 29 1/2' - 99 1/2'						
11-6	2:50	101'	None	"	"	MNR						
CREW CHIEF										Kulhanek		
SOIL EXPLORATION CORP.										ST. PAUL, MN 55101		
SERIAL NO. 07-014												

EL. 905.70

900	SI. ORG. LFS, BWN - LT. BWN DAMP TO 4'
890	
880	
BORING NO. T13

TITLE		REQ. S.E.C.	REQ. S.E.C.	APPROVED:	Bridge No.
TEST BORING LOGS		CHIEF: J.R.	CHIEF: B.H.	6-13-86	Bridge No. 62032
Sheet No. 39 of 39 Sheets					