

P.O.T. 9+18.40 ST. CROIX ST.
R.O.T. 27+02 N.W. FRONTAGE RD.

TRACY LITHOGRAPHERS INC.


Fed. Proj. No.

HORIZ. SCALE 1" = 50'
VERT. SCALE 1" = 10'


BEGIN M.S.A.P.-60-233-01
STA. 9+54.40

END M.S.A.P.-60-233-01
STA. 19+74.18

W B 36
S B 280
E B 280
E B 36

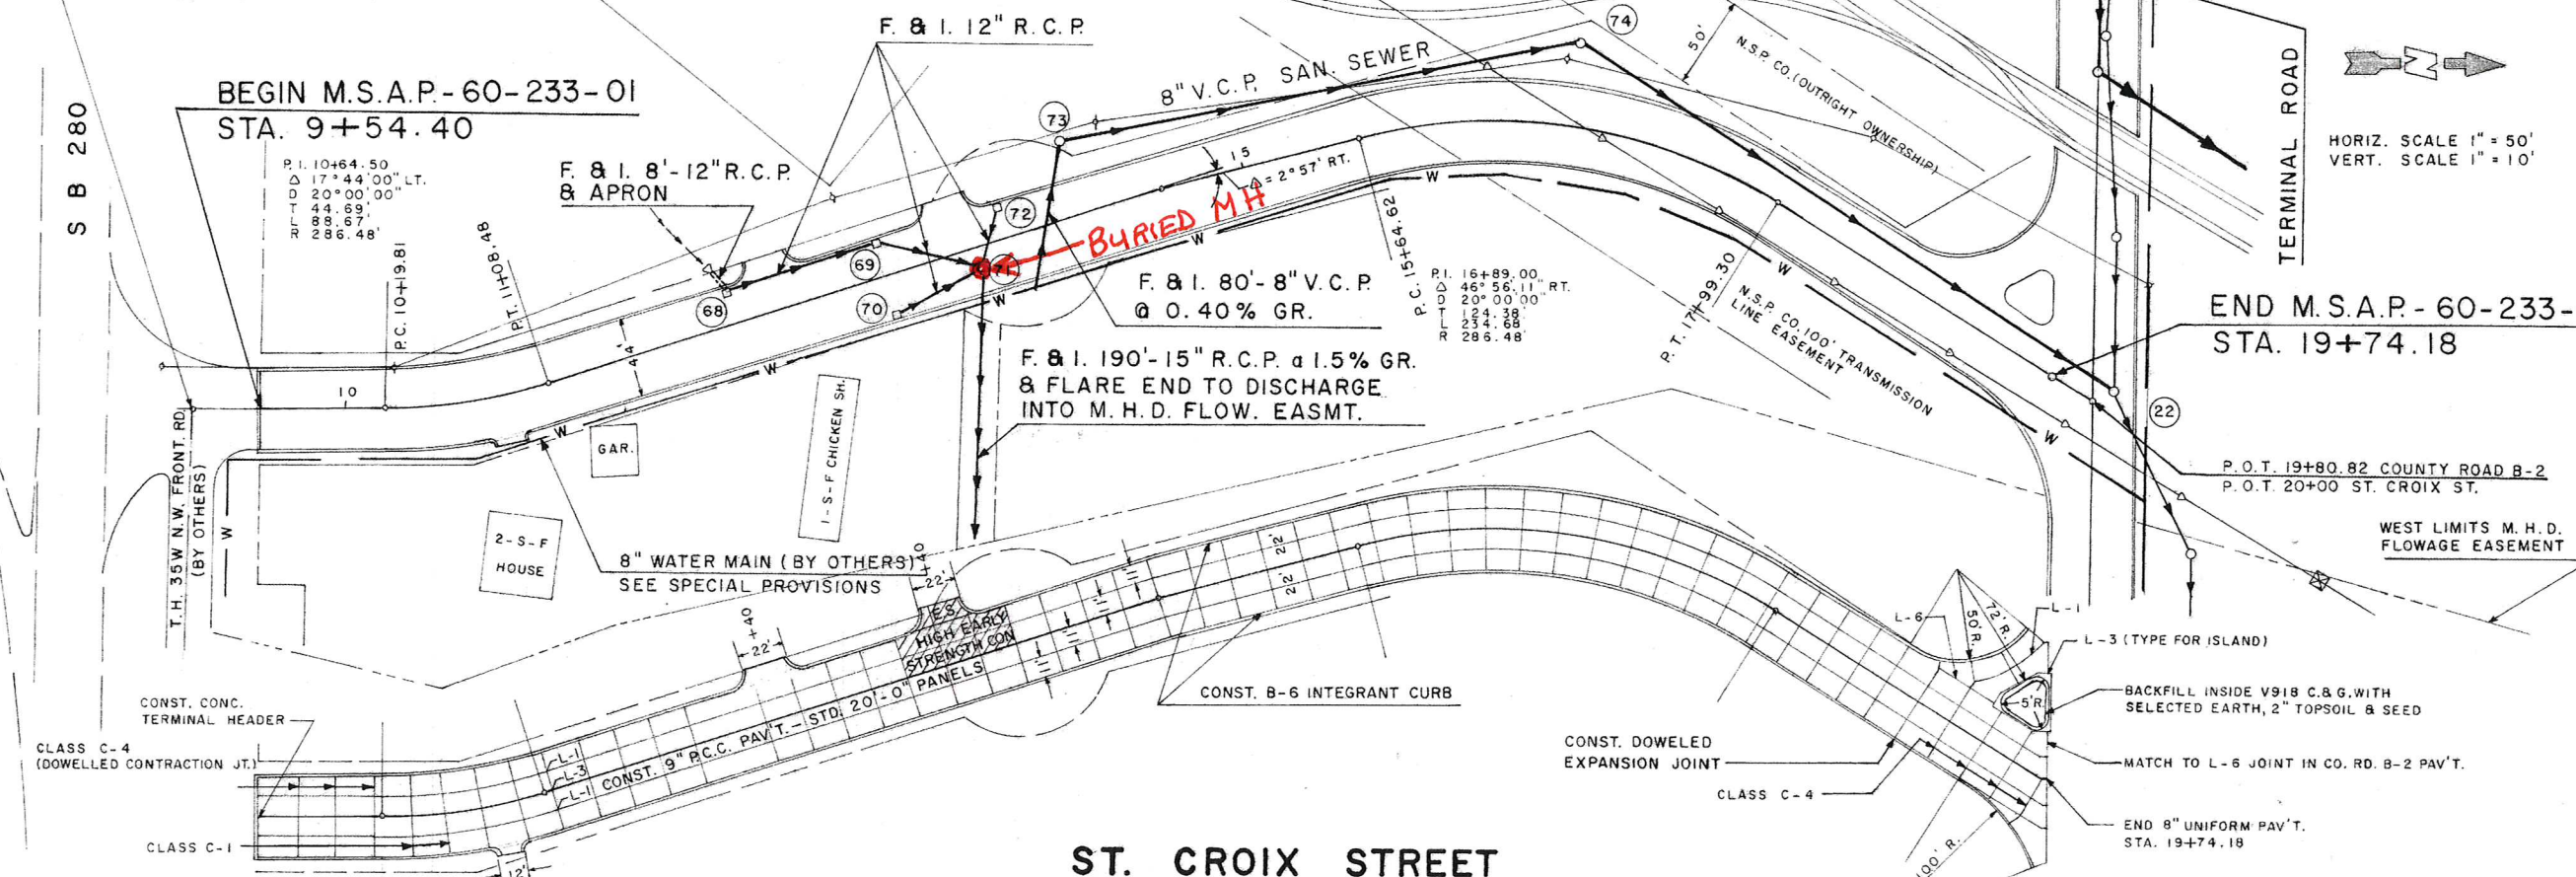

ST. CROIX STREET

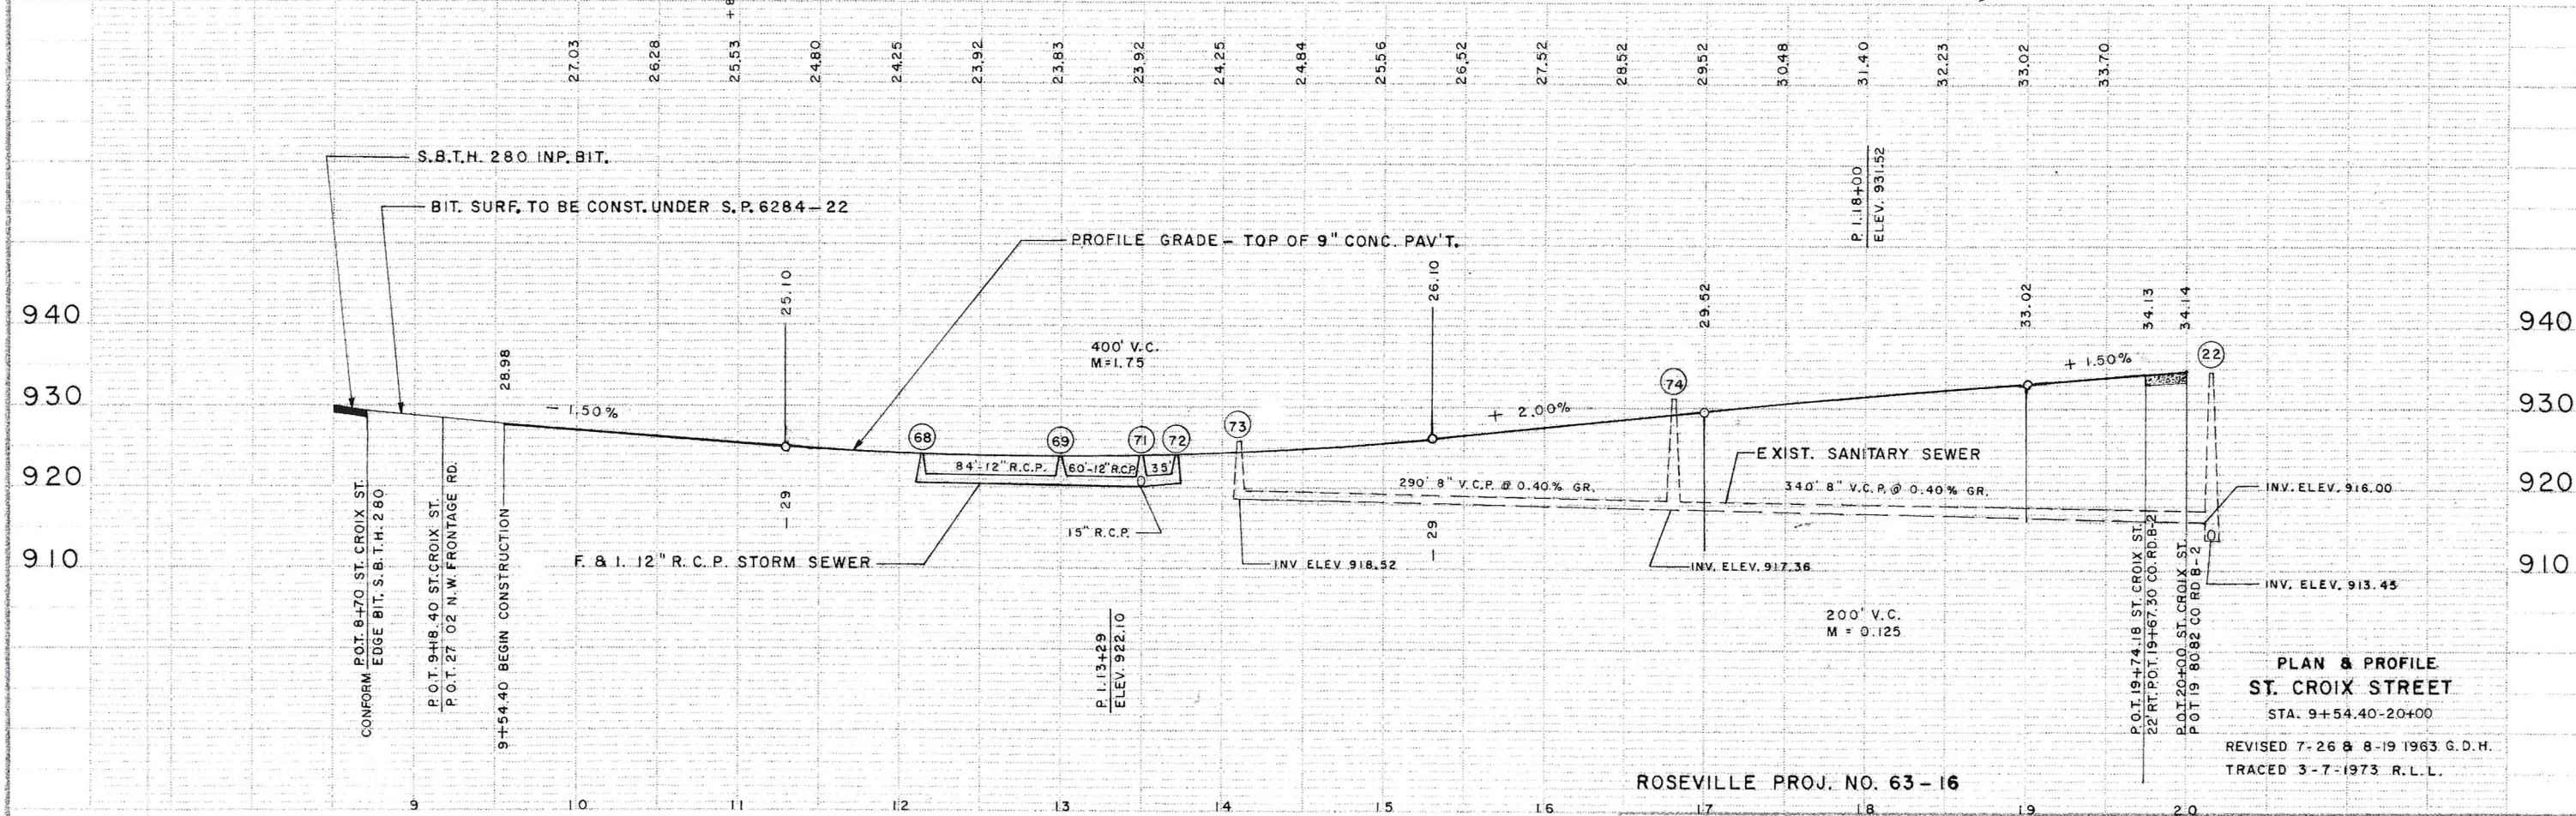

PLAN & PROFILE
ST. CROIX STREET
STA. 9+54.40-20+00

REVISED 7-26 & 8-19 1963 G.D.H.
TRACED 3-7-1973 R.L.L.

ROSEVILLE PROJ. NO. 63-16

State Proj. No.

M.S.A.P. 60-217-01
M.S.A.P. 60-219-01
M.S.A.P. 60-233-01

Sheet No. 24 of 28 Sheets

P-533 ST-103