


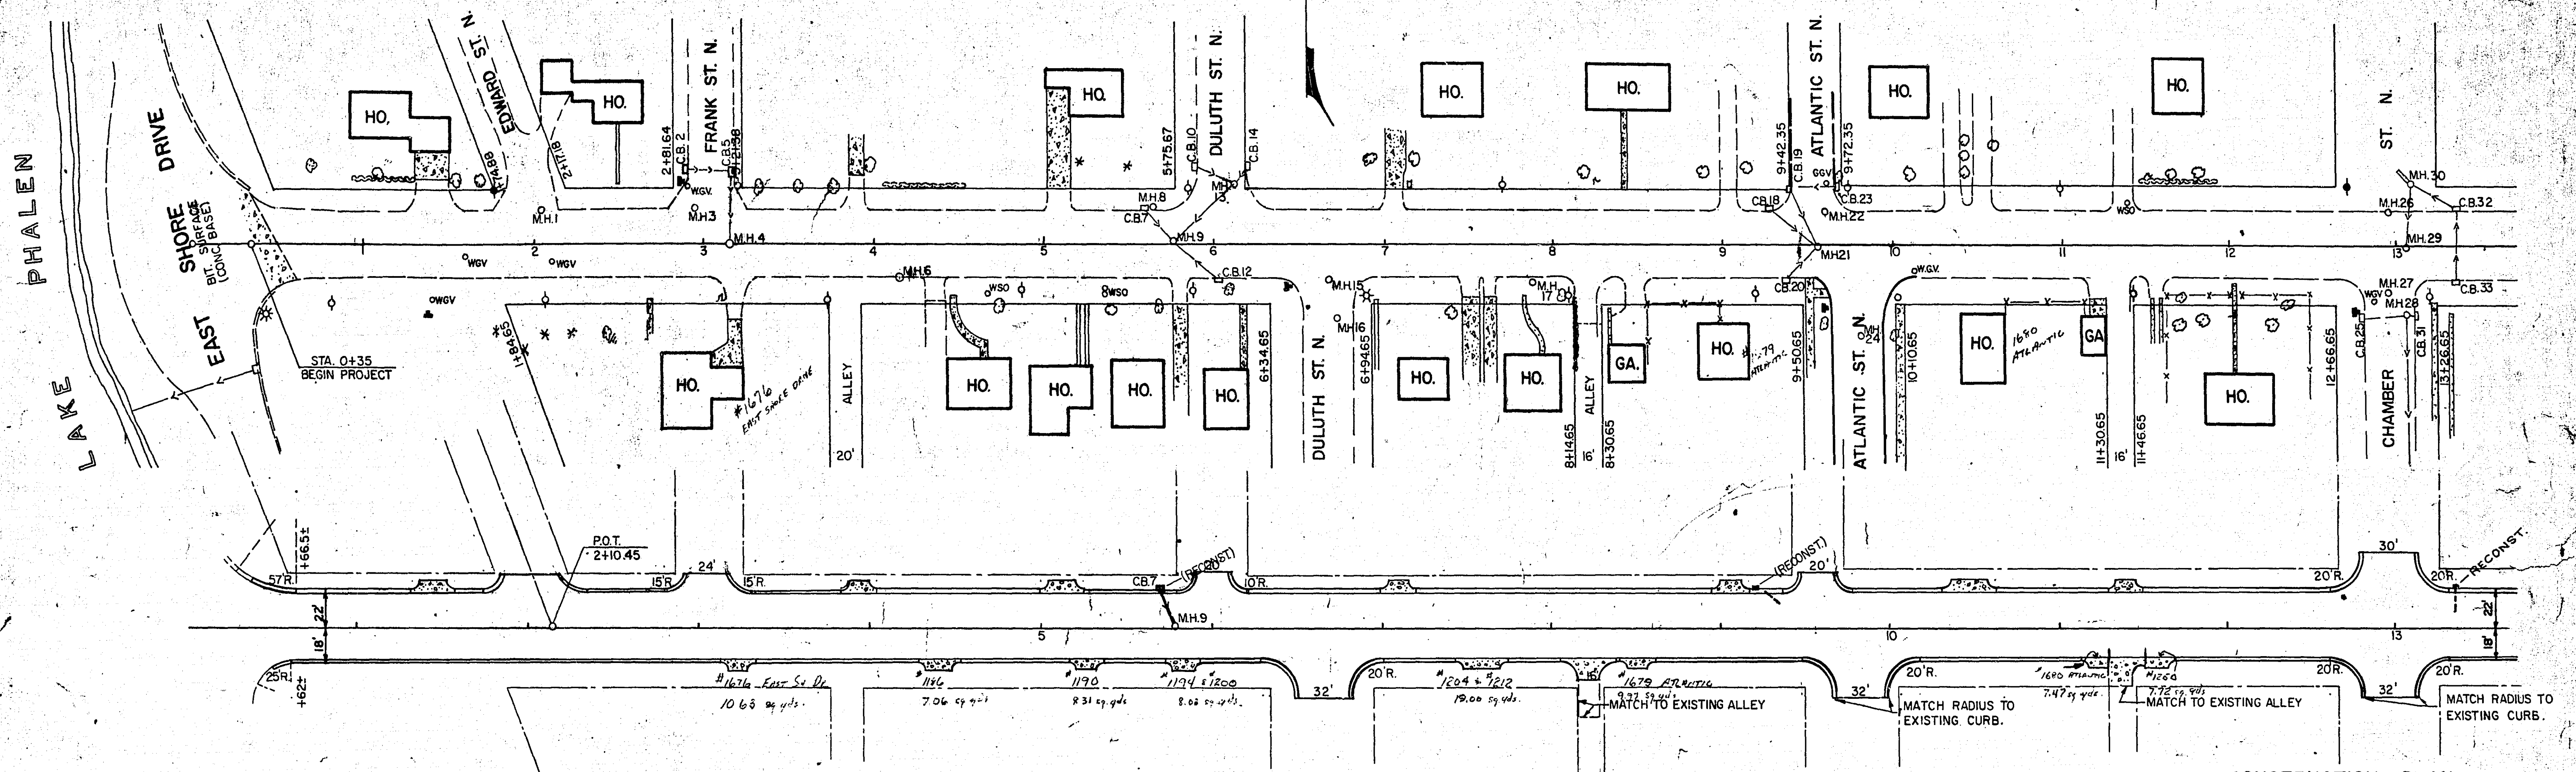



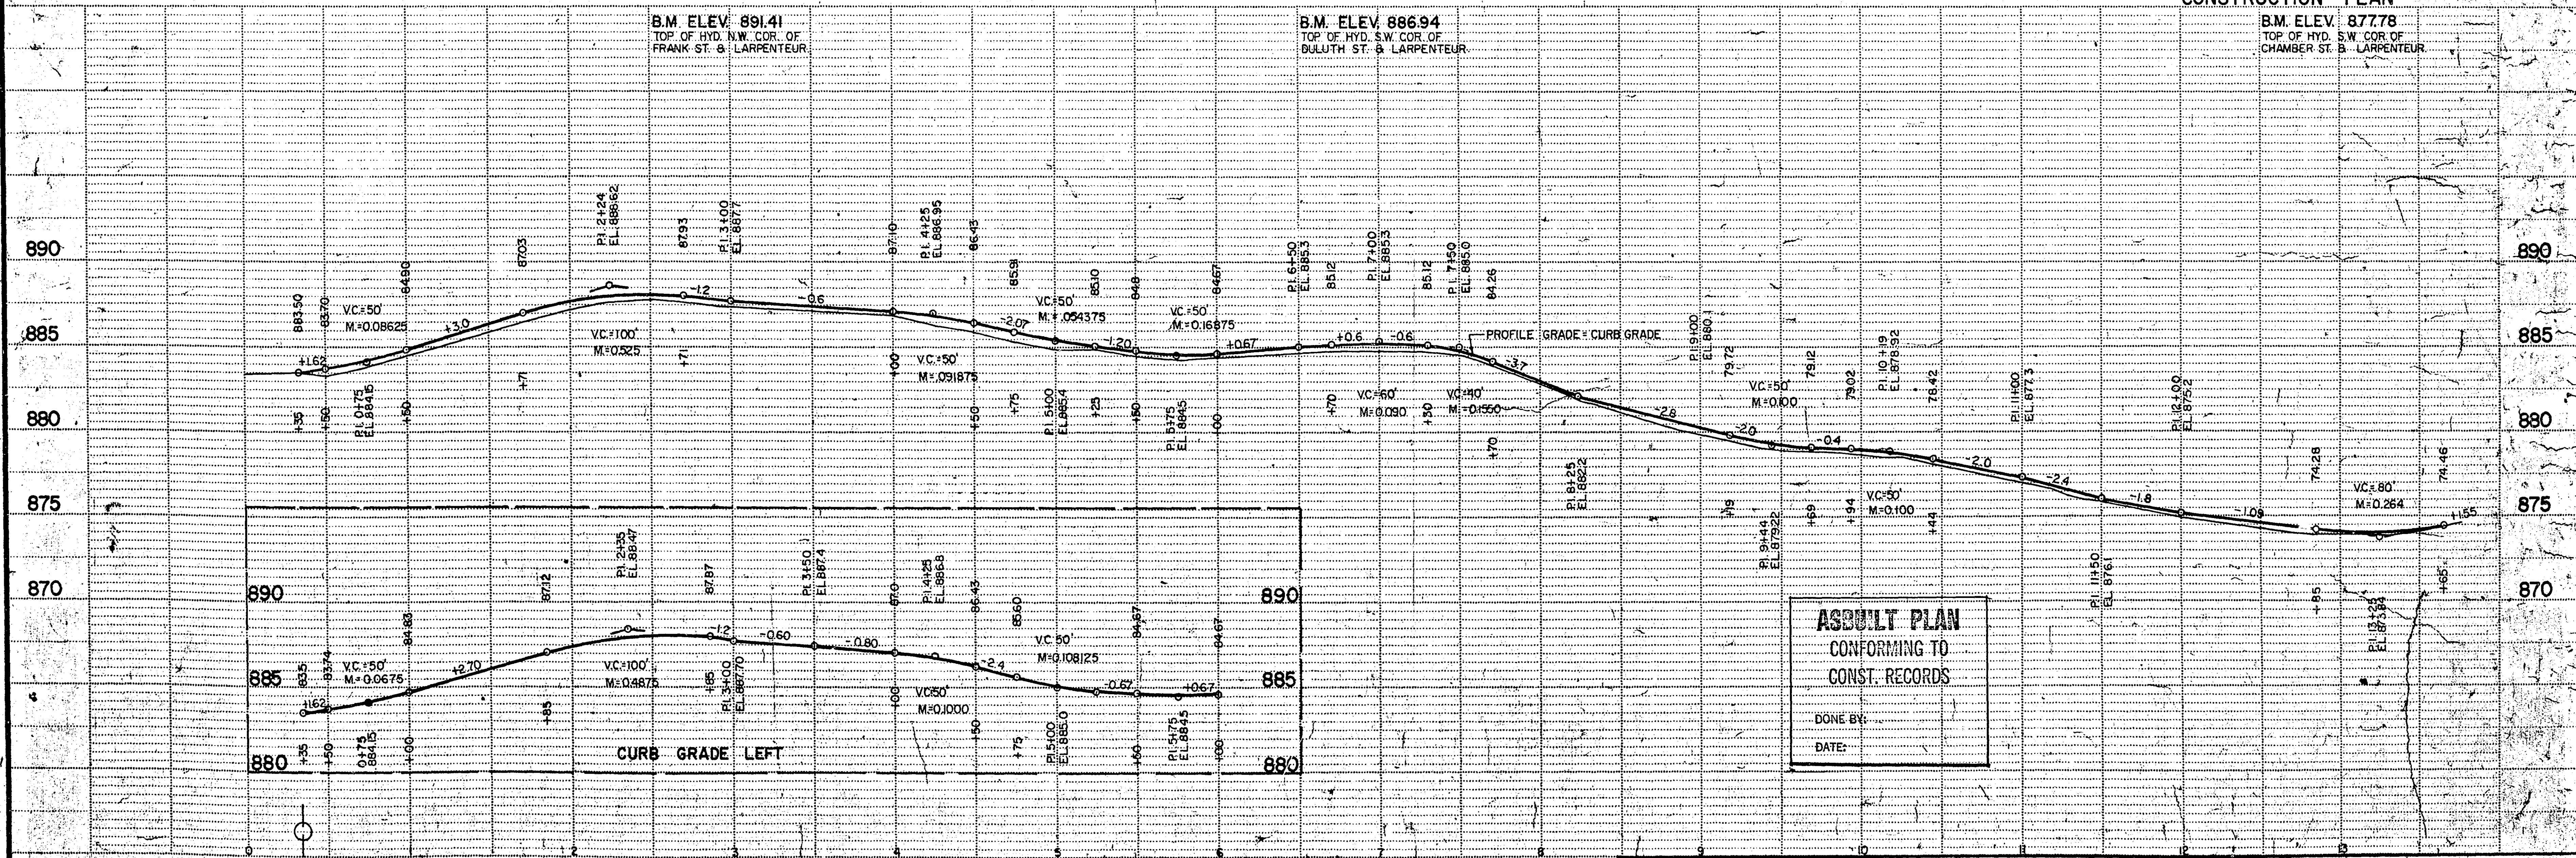


CONSTRUCTION PLAN

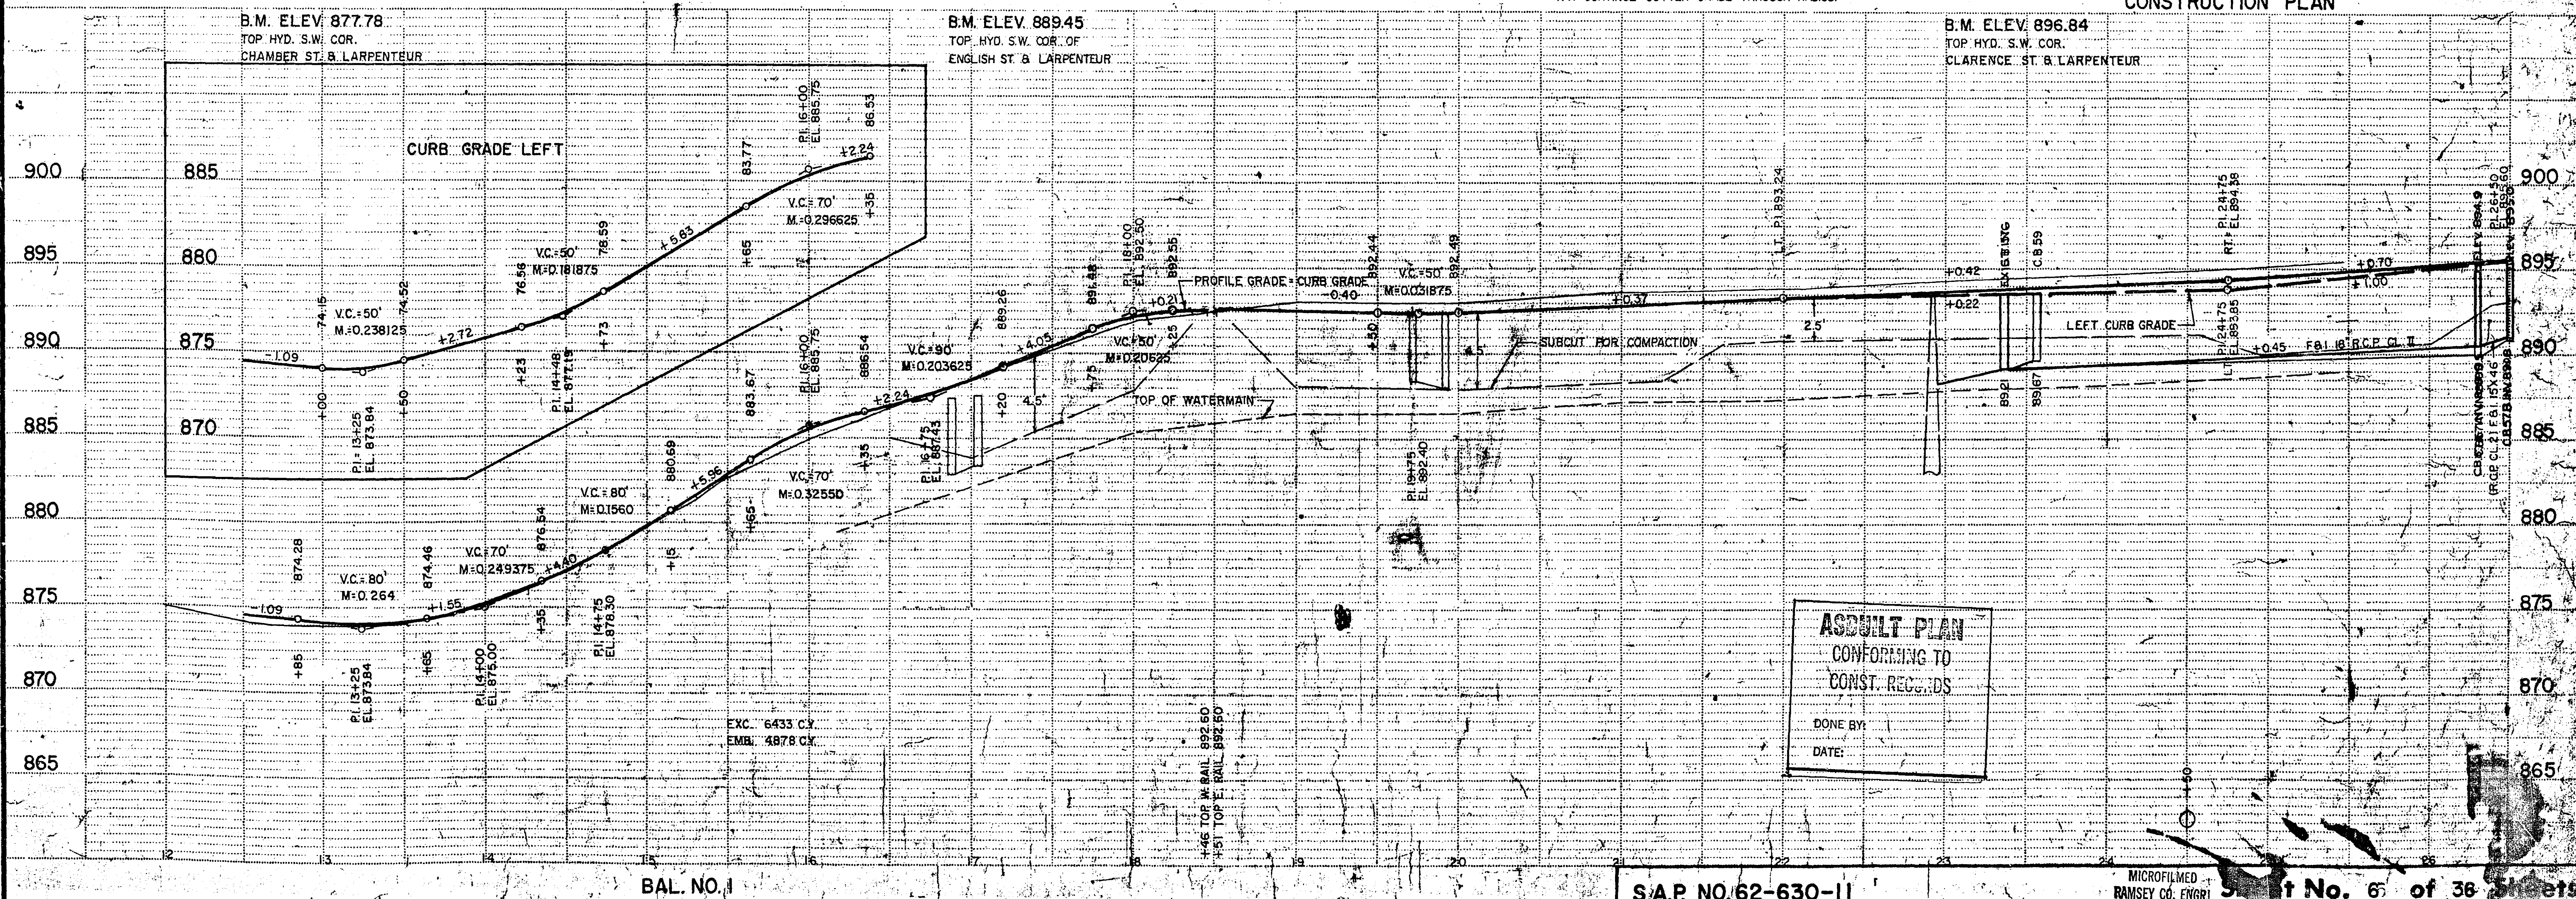

ASBUILT PLAN
CONFORMING TO
CONST. RECORDS
DONE BY:
DATE:

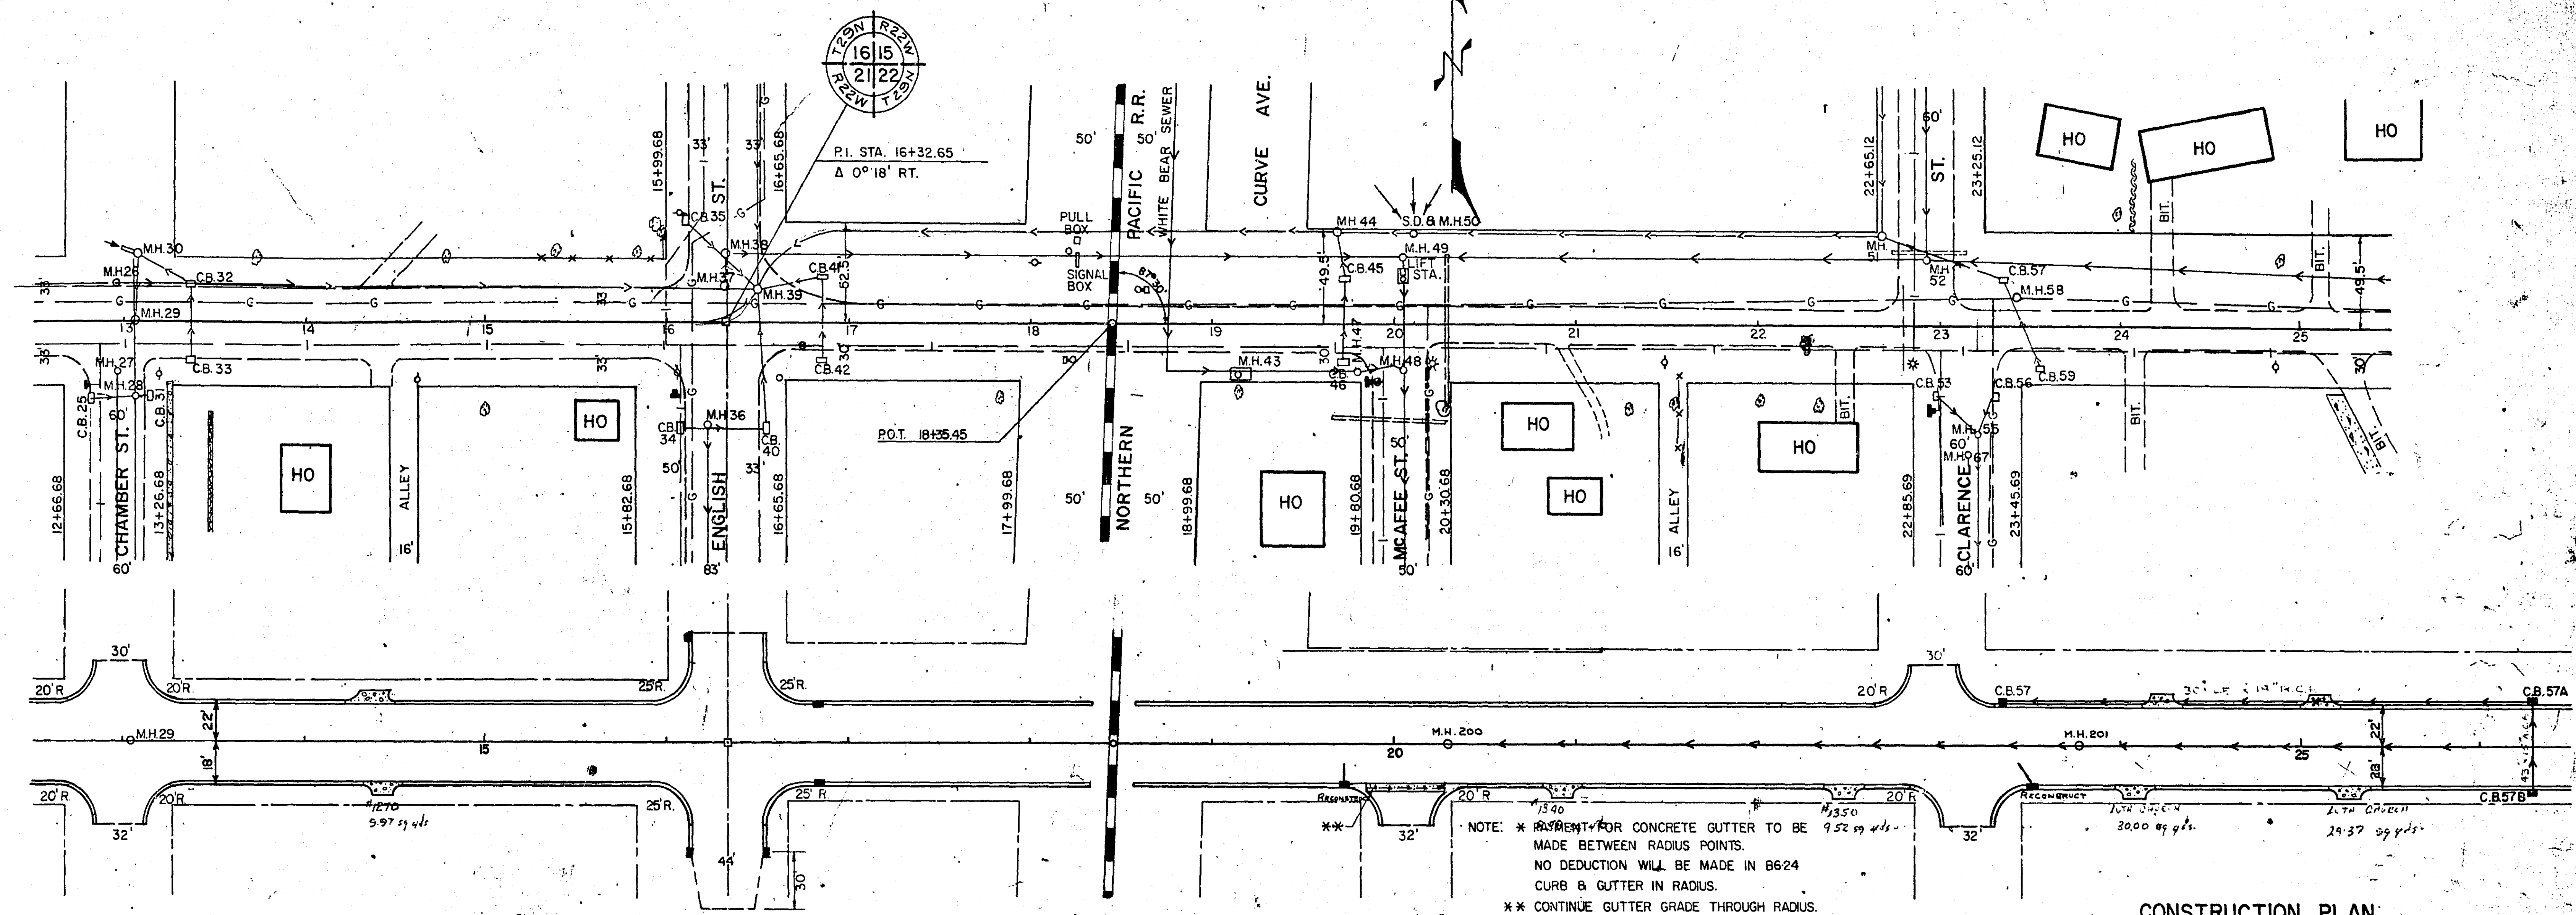


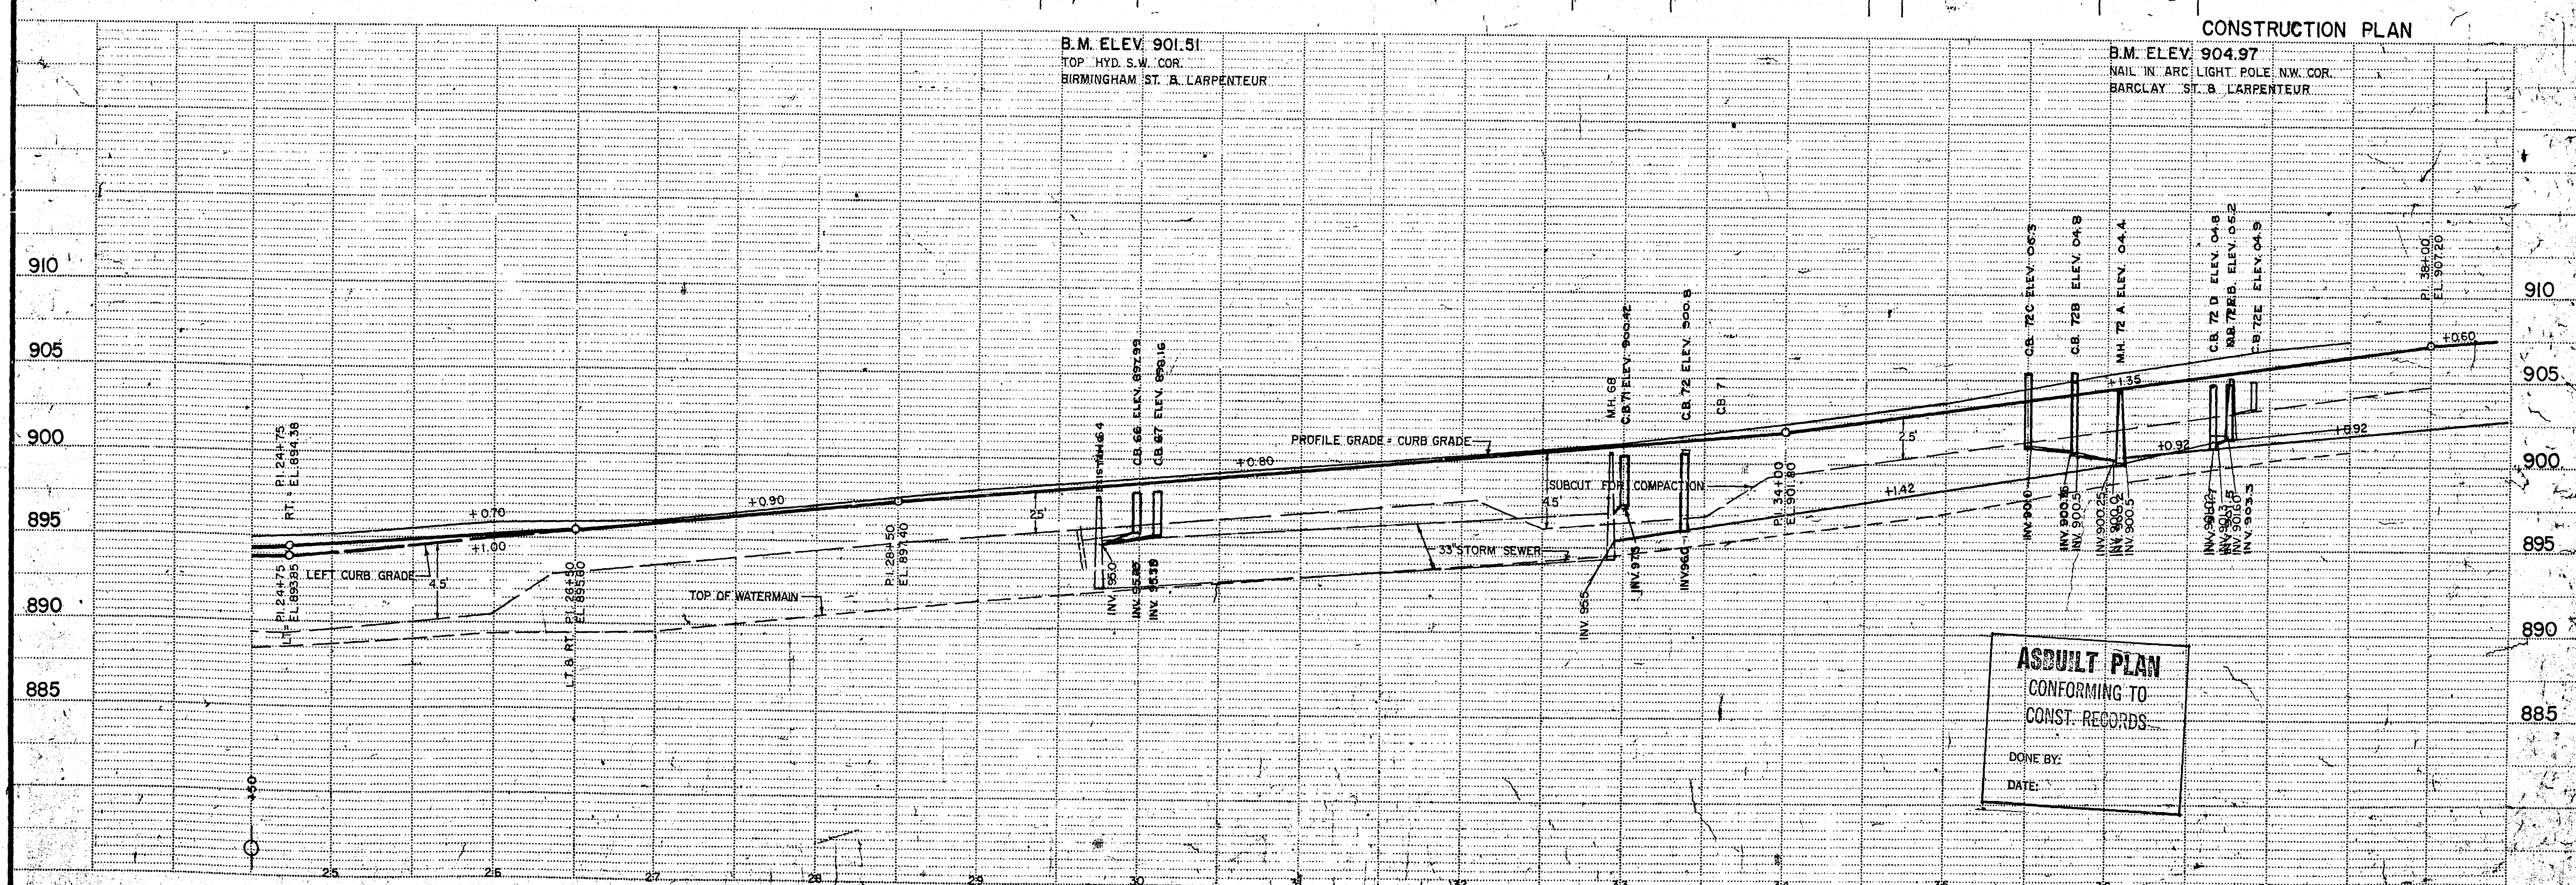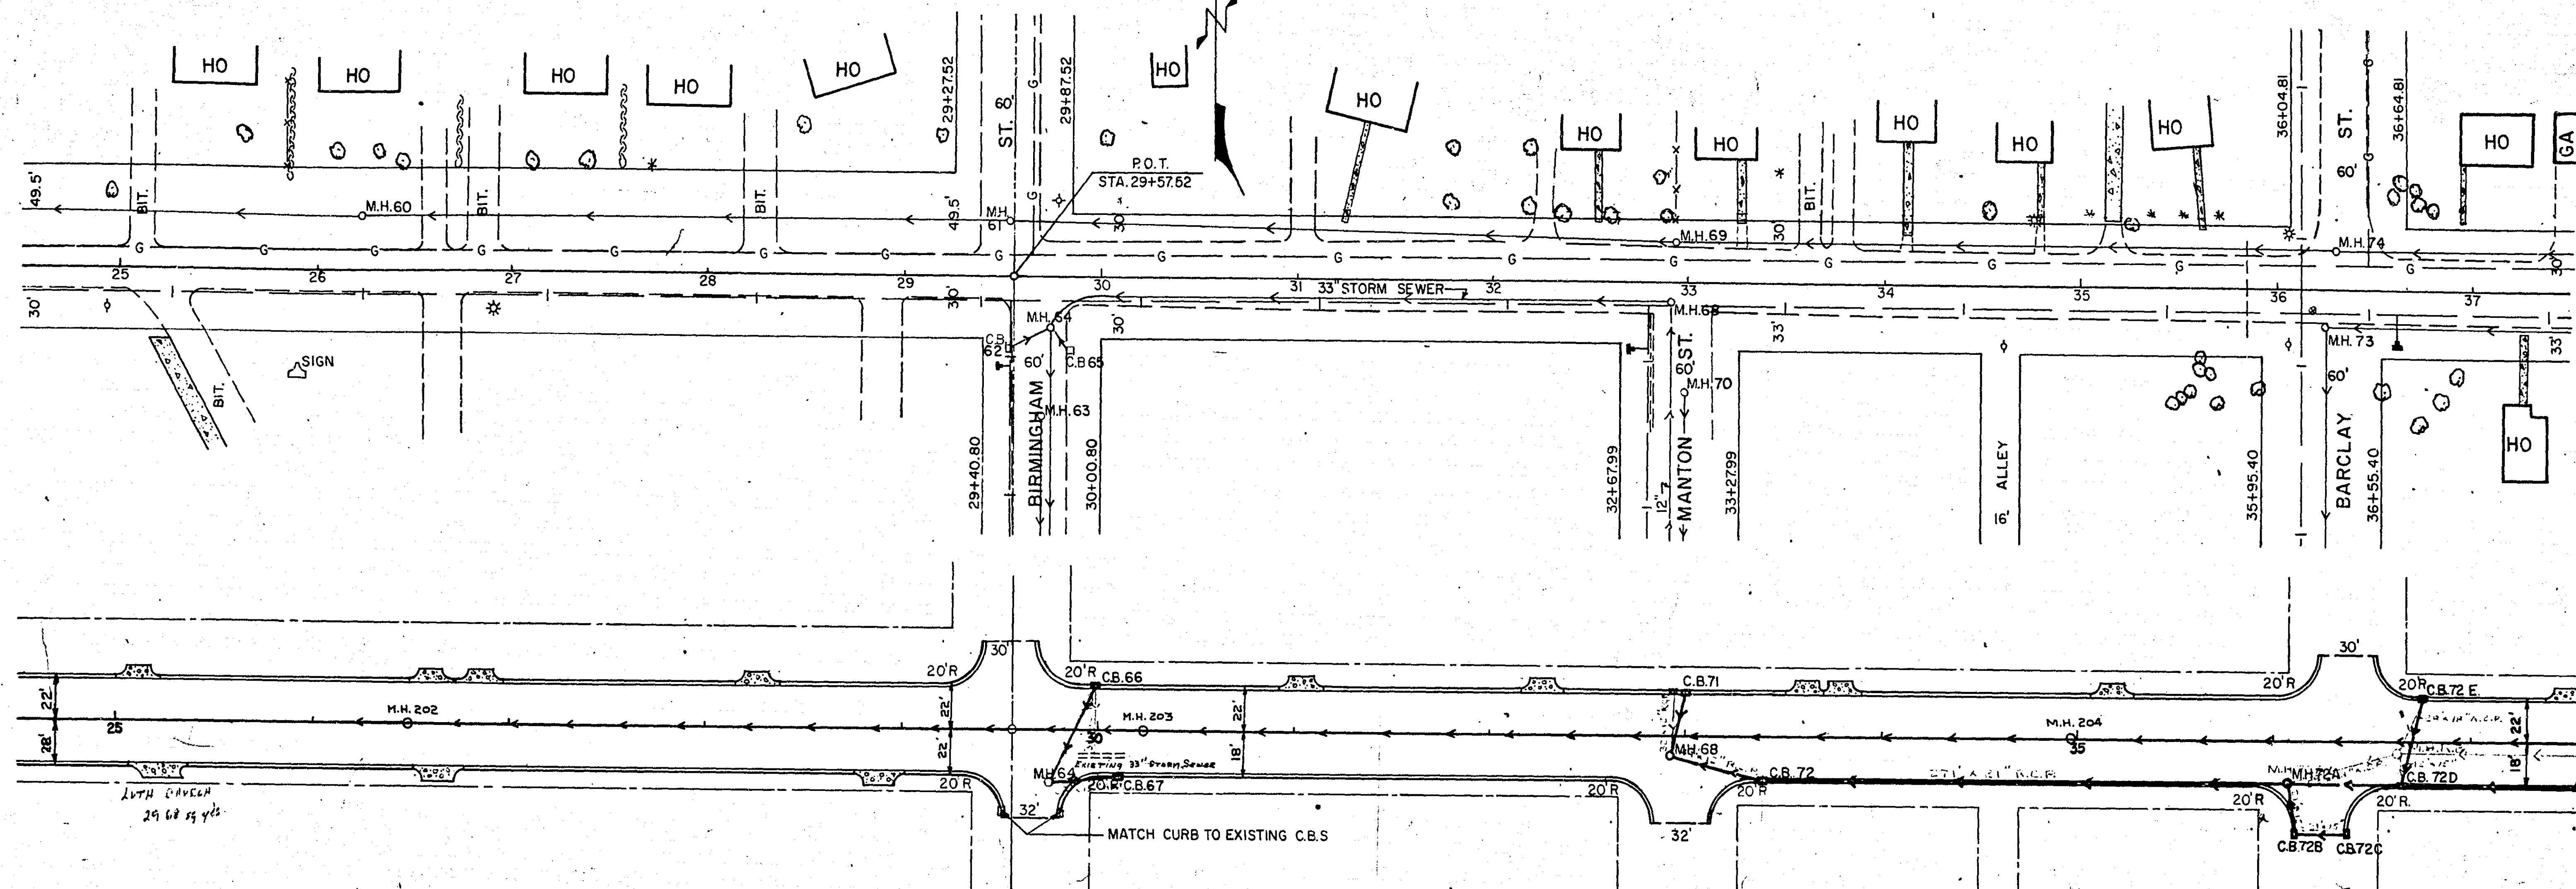

CONSTRUCTION PLAN


ASBUILT PLAN
CONFORMING TO
CONST. RECORDS

DONE BY: _____
DATE: _____

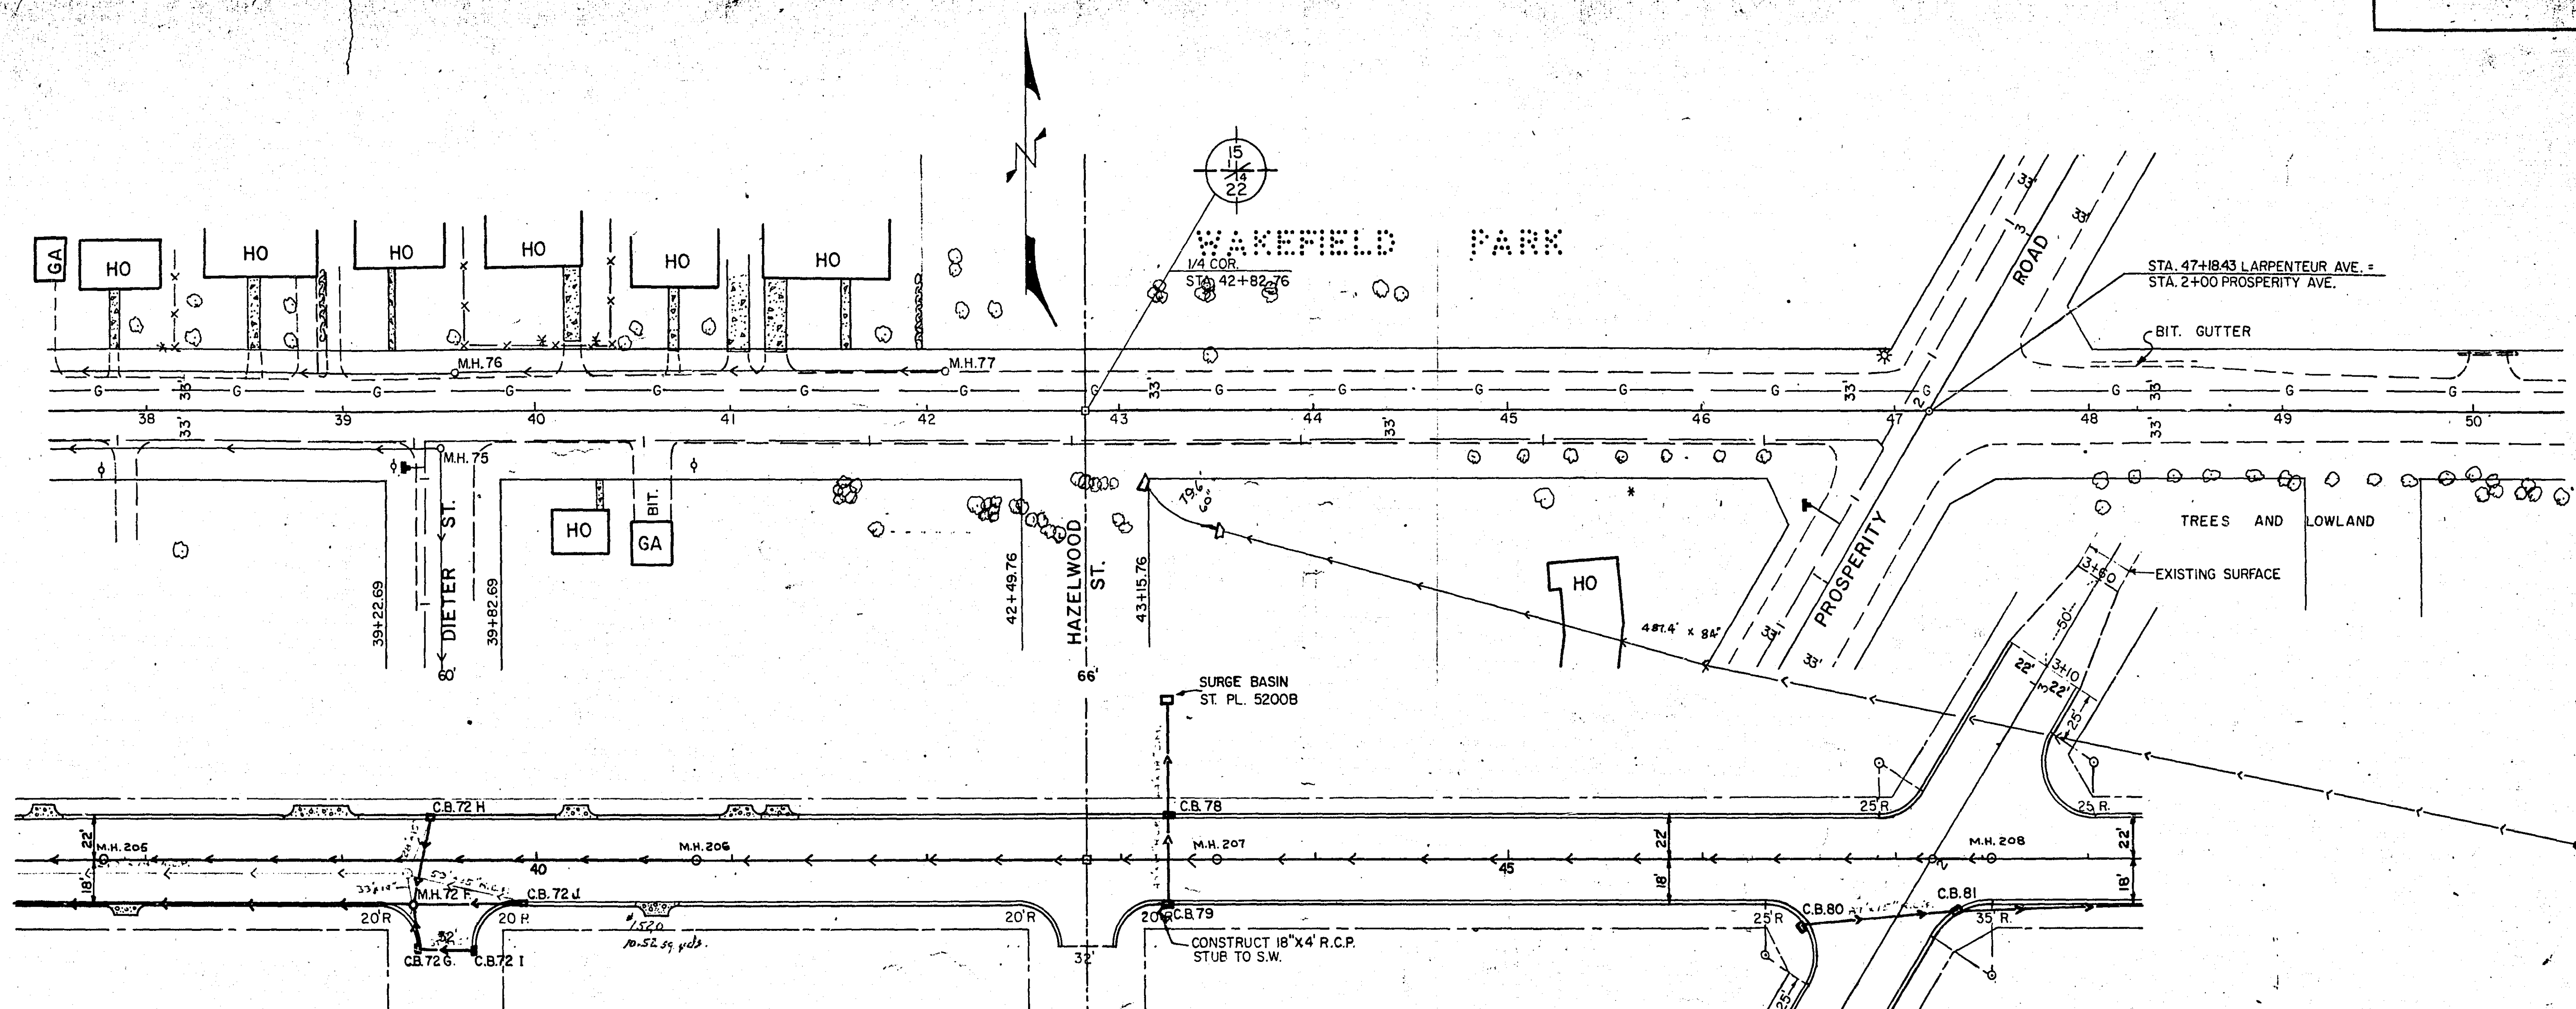


B.M. ELEV. 911.35
TOP HYD. S.W. COR.
DIETER ST. & LARPEUR

CONSTRUCTION PLAN
B.M. ELEV. 925.38
TOP HYD. S.W. COR.
PROSPERITY RD. & LARPEUR

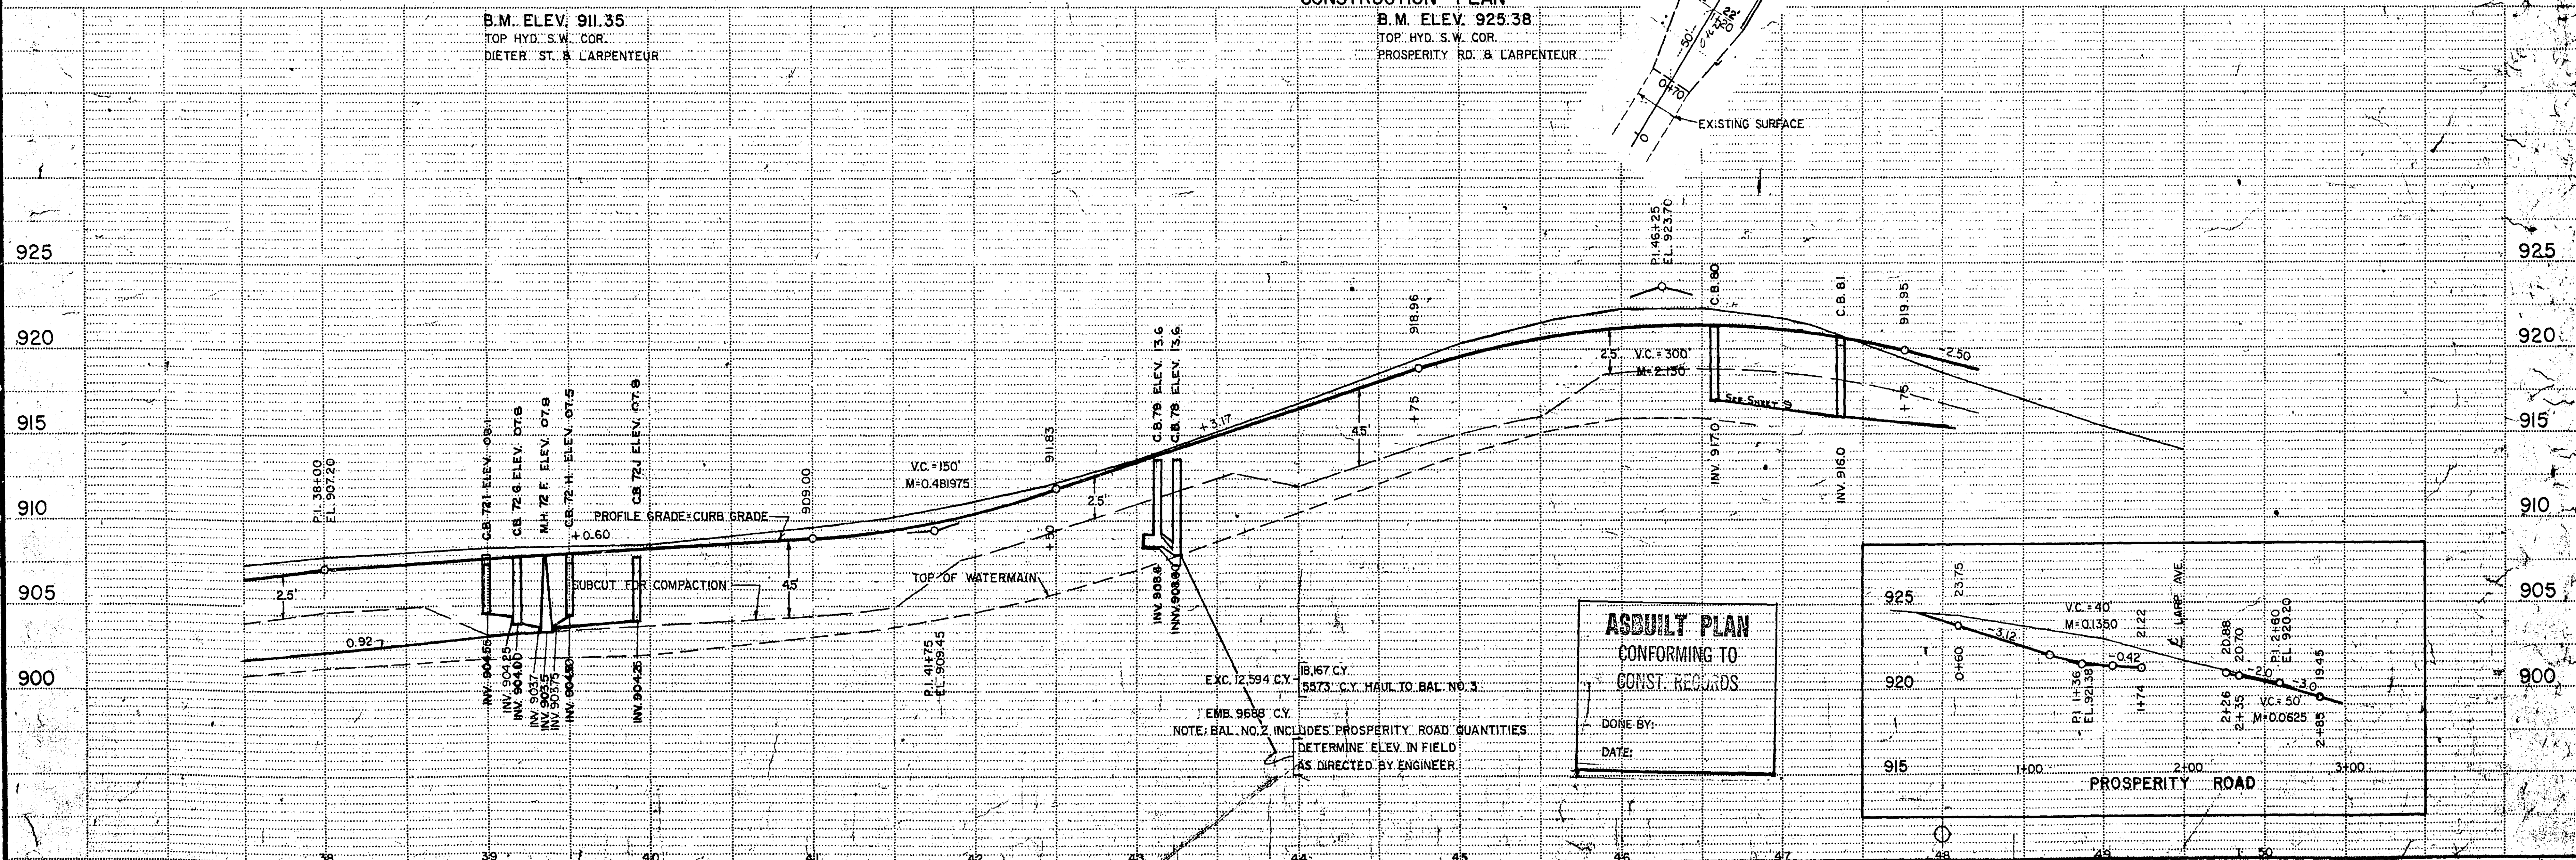

EXC. 12,594 C.Y.
EMB. 9688 C.Y.
NOTE: BAL. NO. 2 INCLUDES PROSPERITY ROAD QUANTITIES.
DETERMINE ELEV. IN FIELD
AS DIRECTED BY ENGINEER

ASBUILT PLAN
CONFORMING TO
CONST. RECORDS
DONE BY:
DATE:

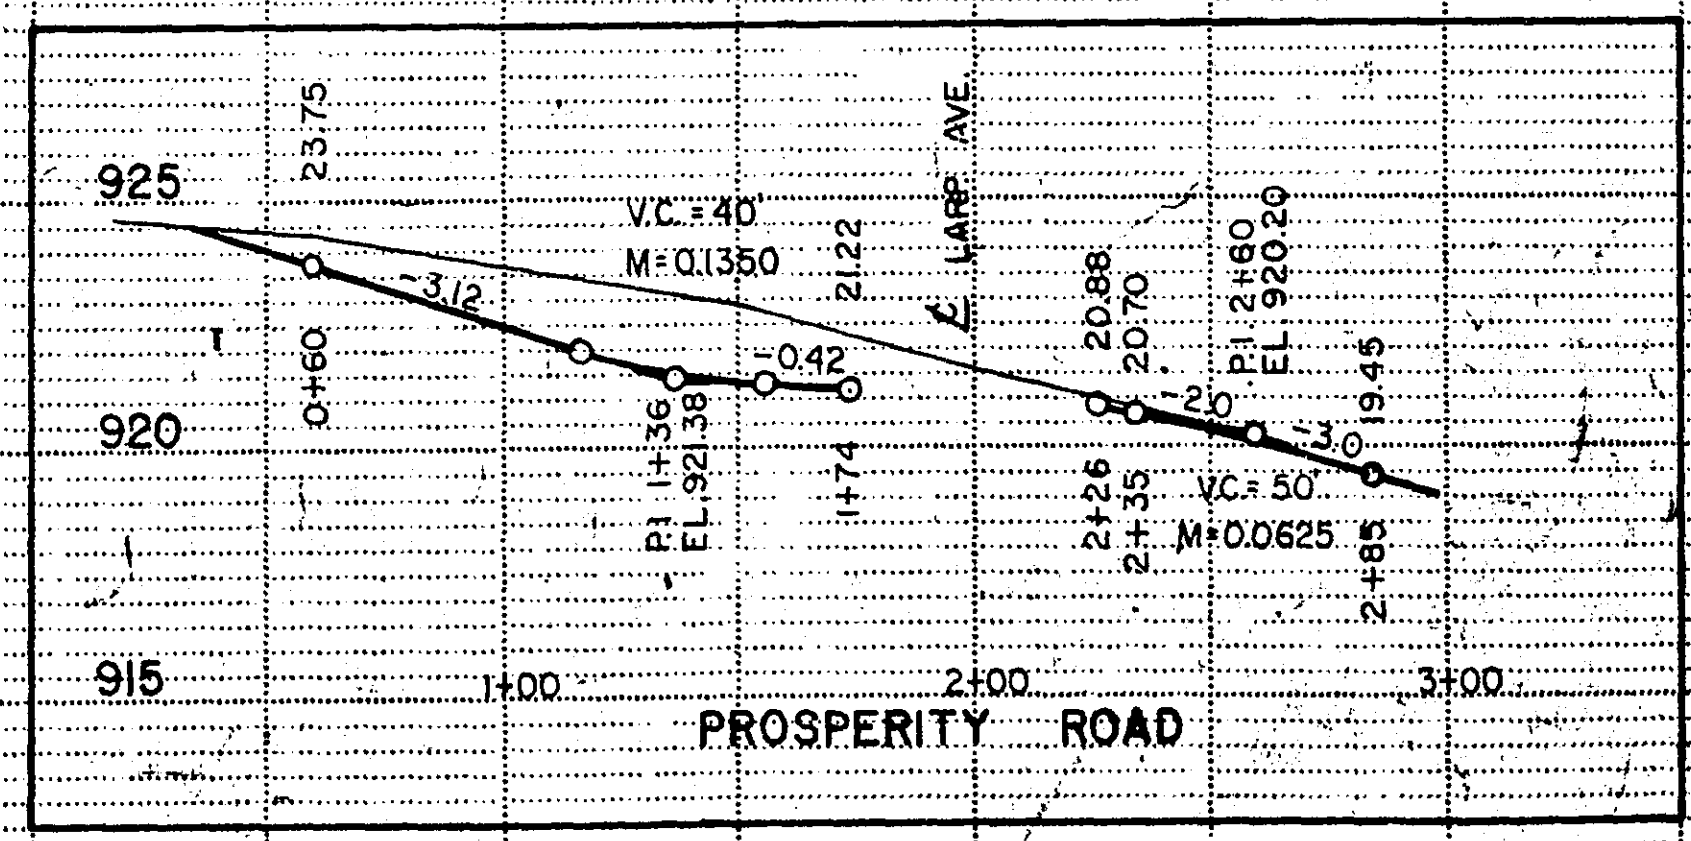


BAL. NO. 2


S.A.P. NO. 62-630-11

MICROFILMED
RAMSEY CO. ENGR. Sheet No. 8 of 36 Sheets

6878 18-103

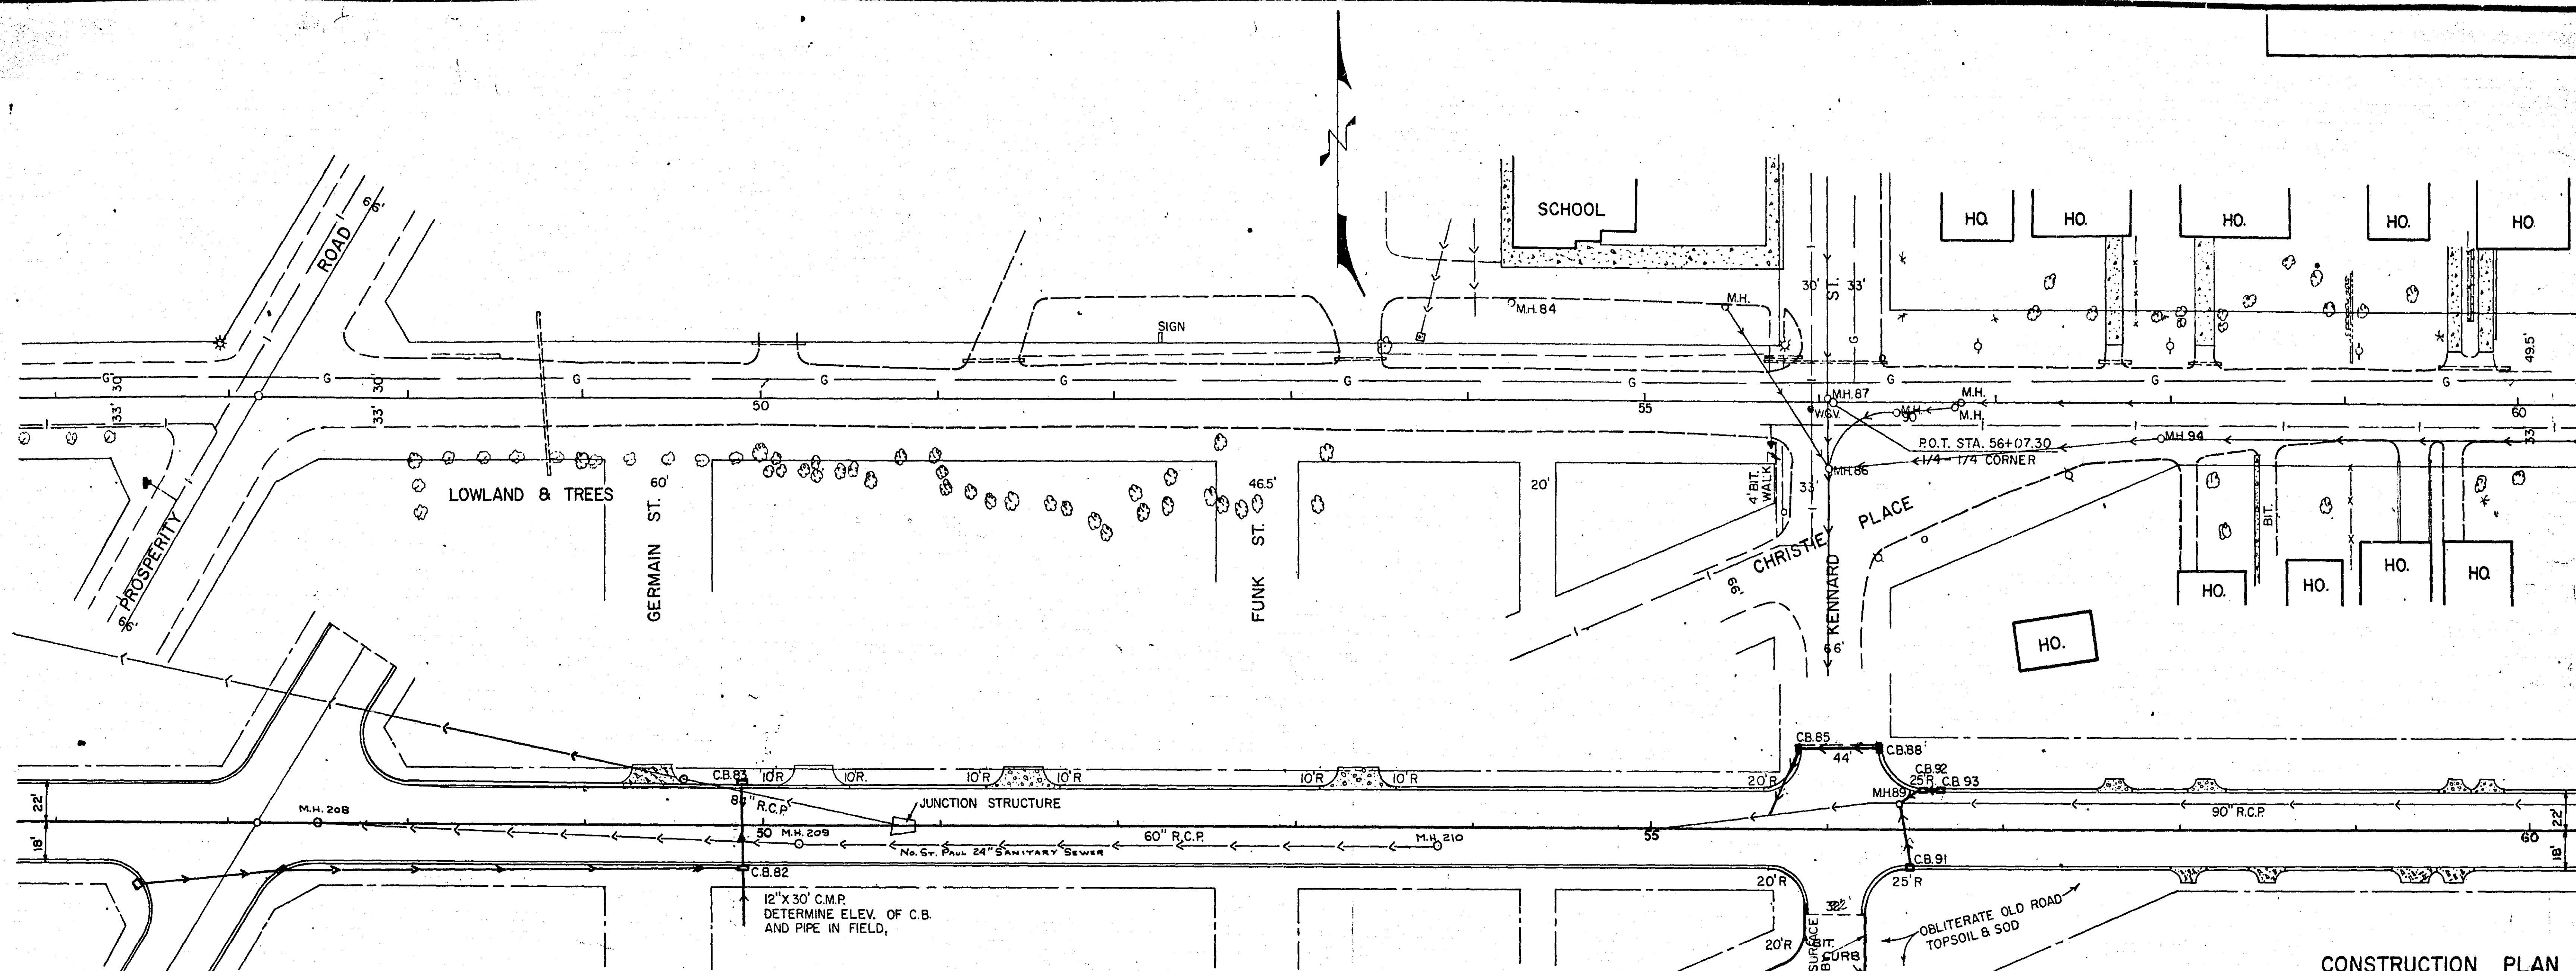

CONSTRUCTION PLAN

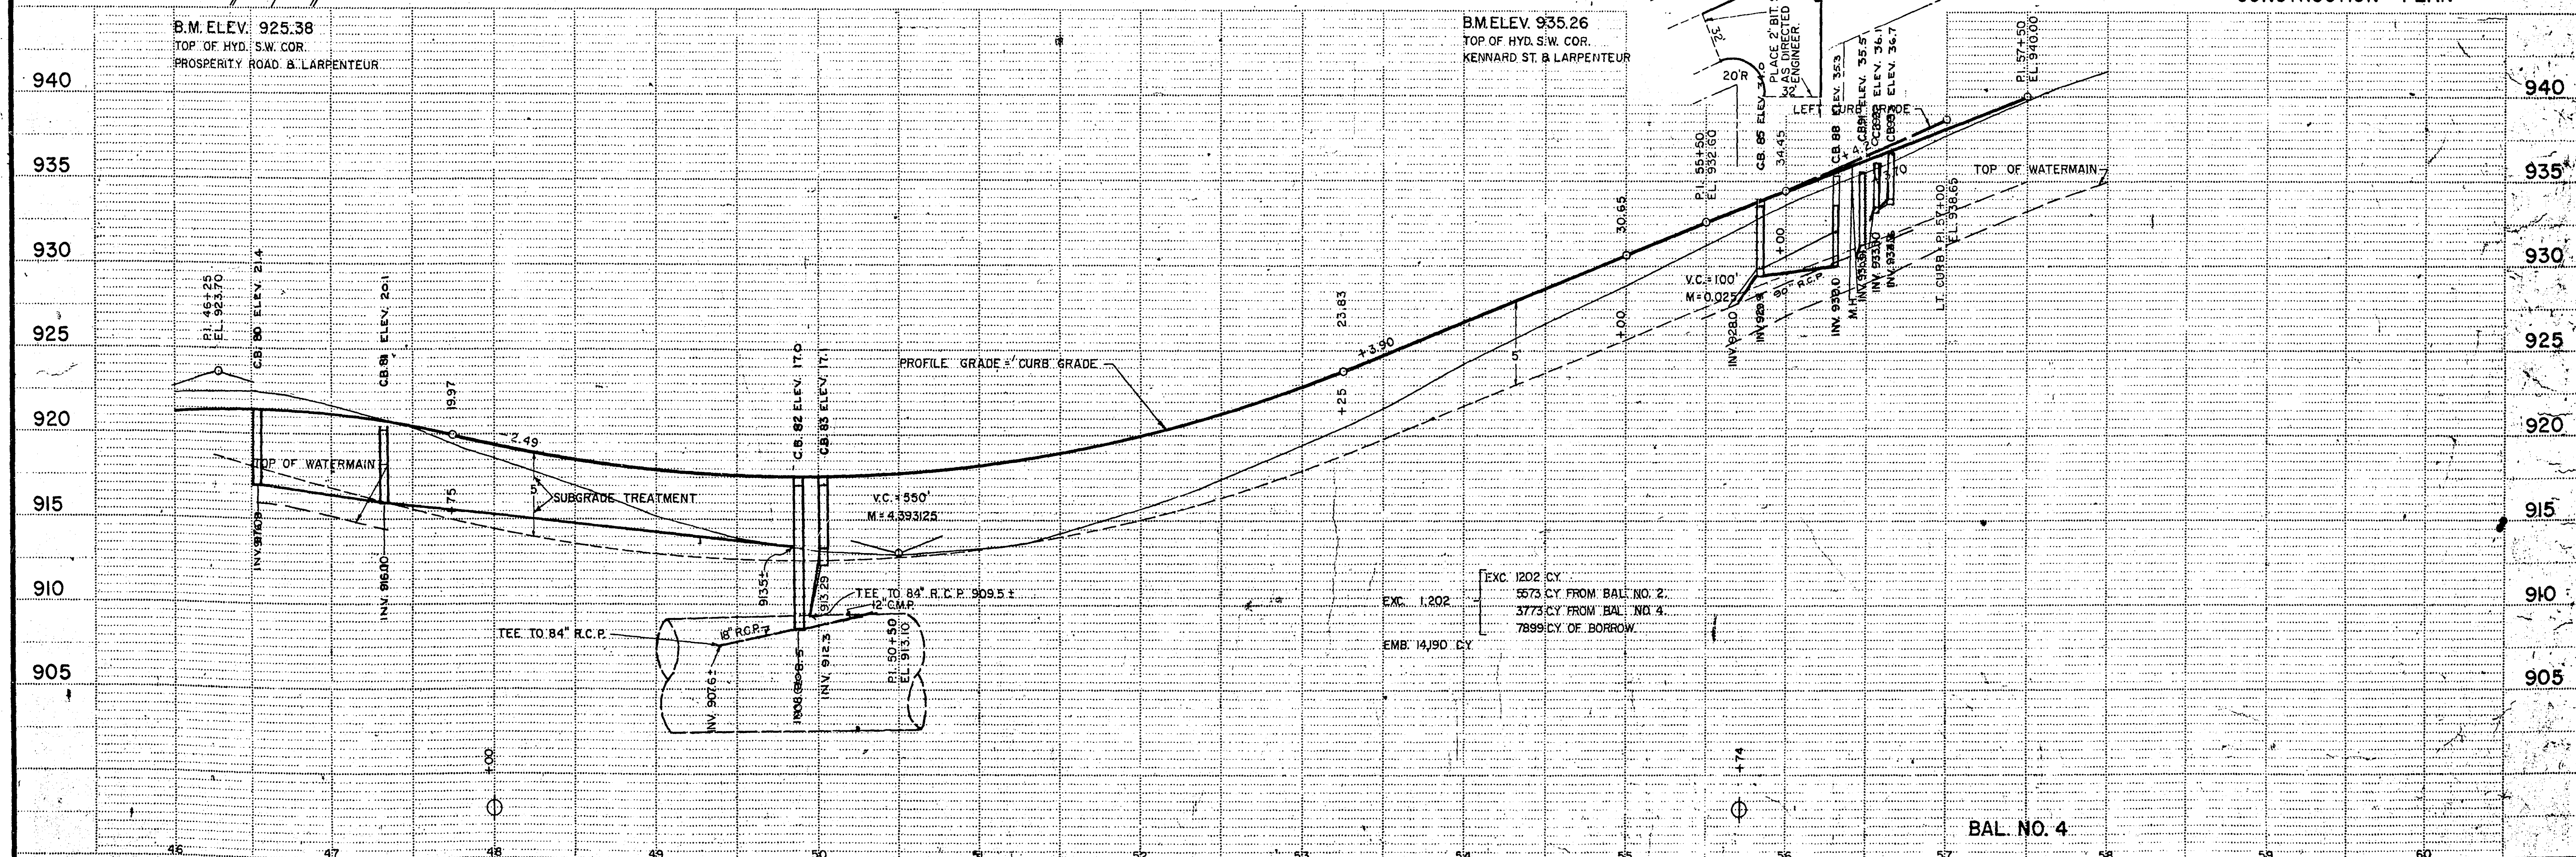

BAL. NO. 3

S.A.P. NO. 62-630-II

MICROFILMED
RAMSEY CO. ENGRS

Sheet No. 9 of 36 Sheets

687818/10

