


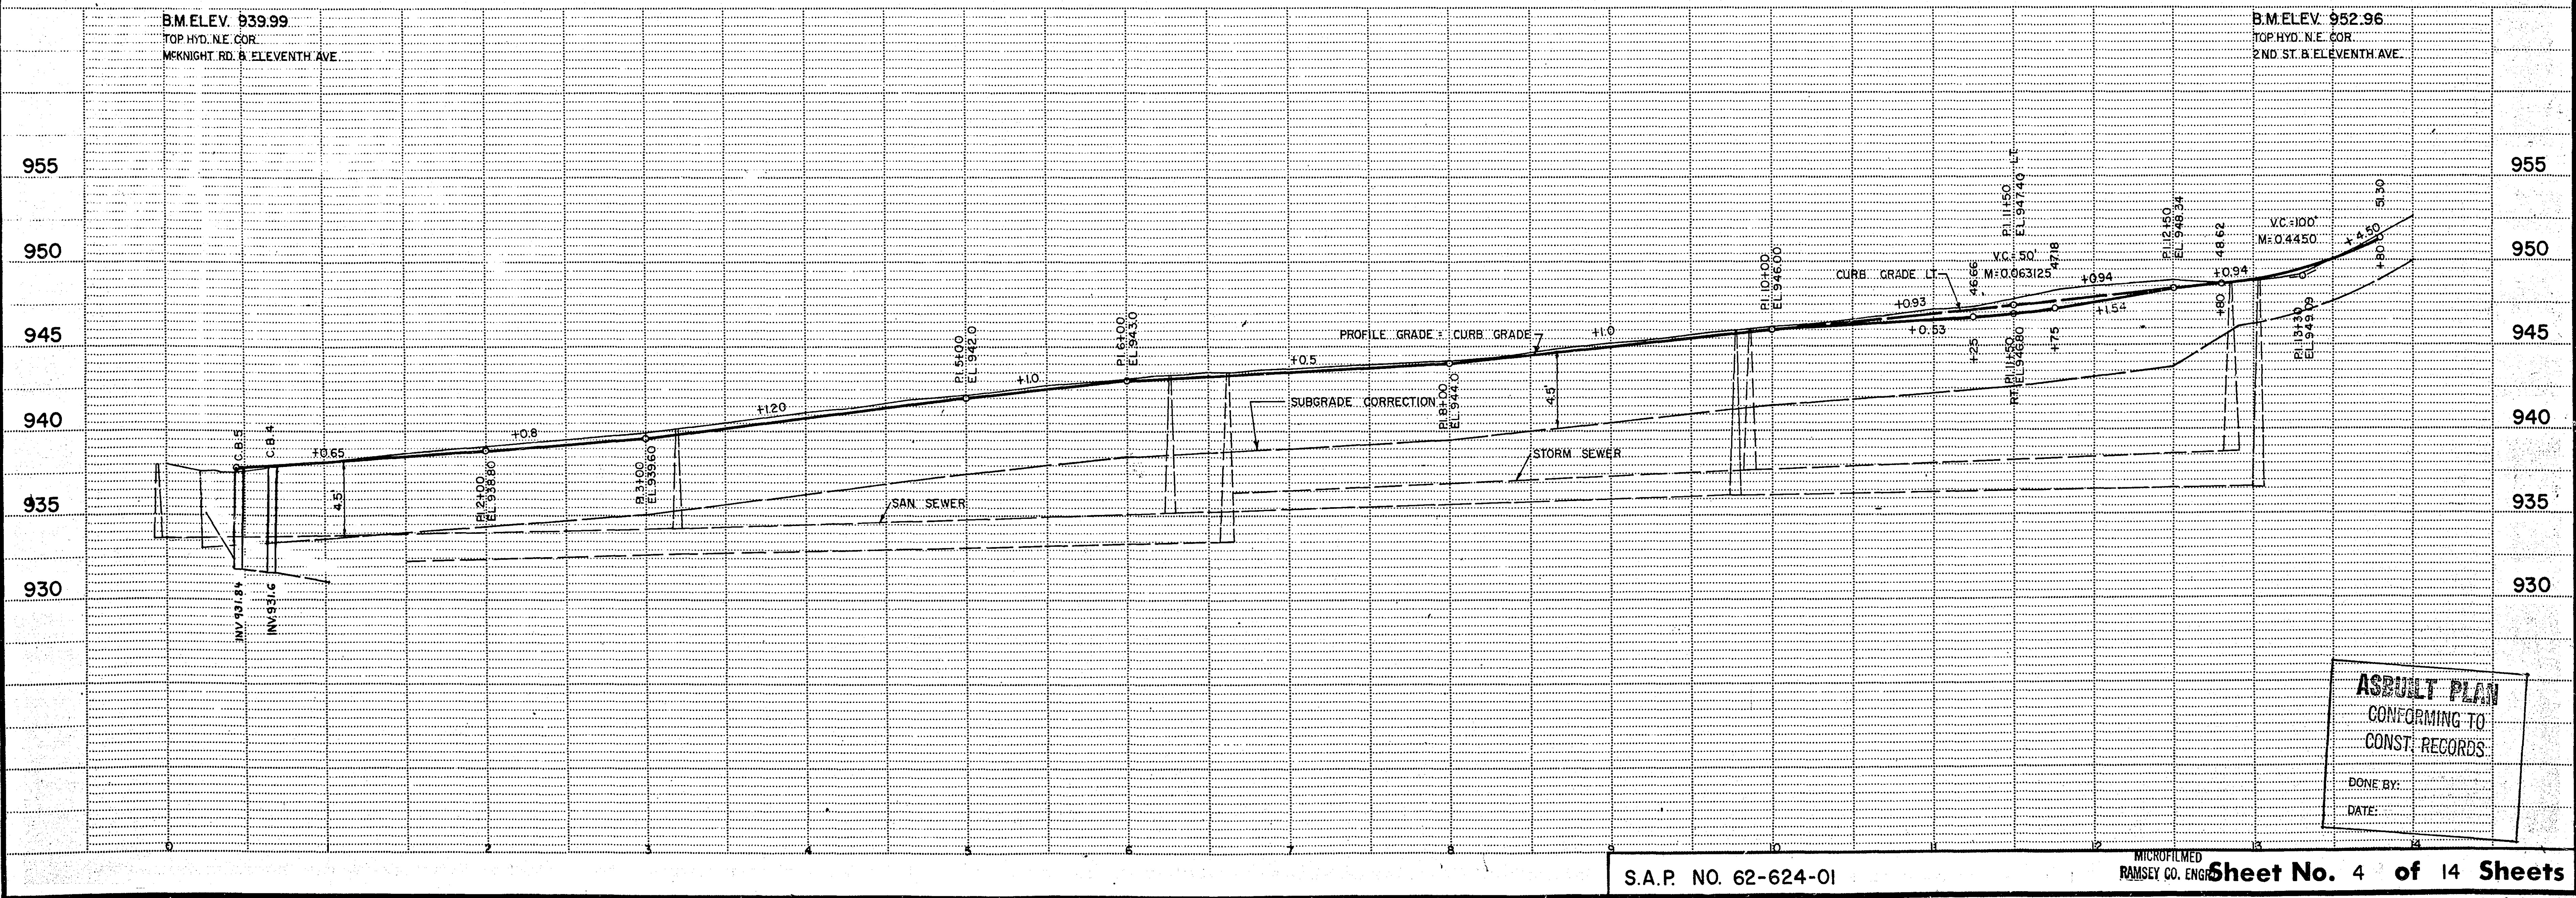
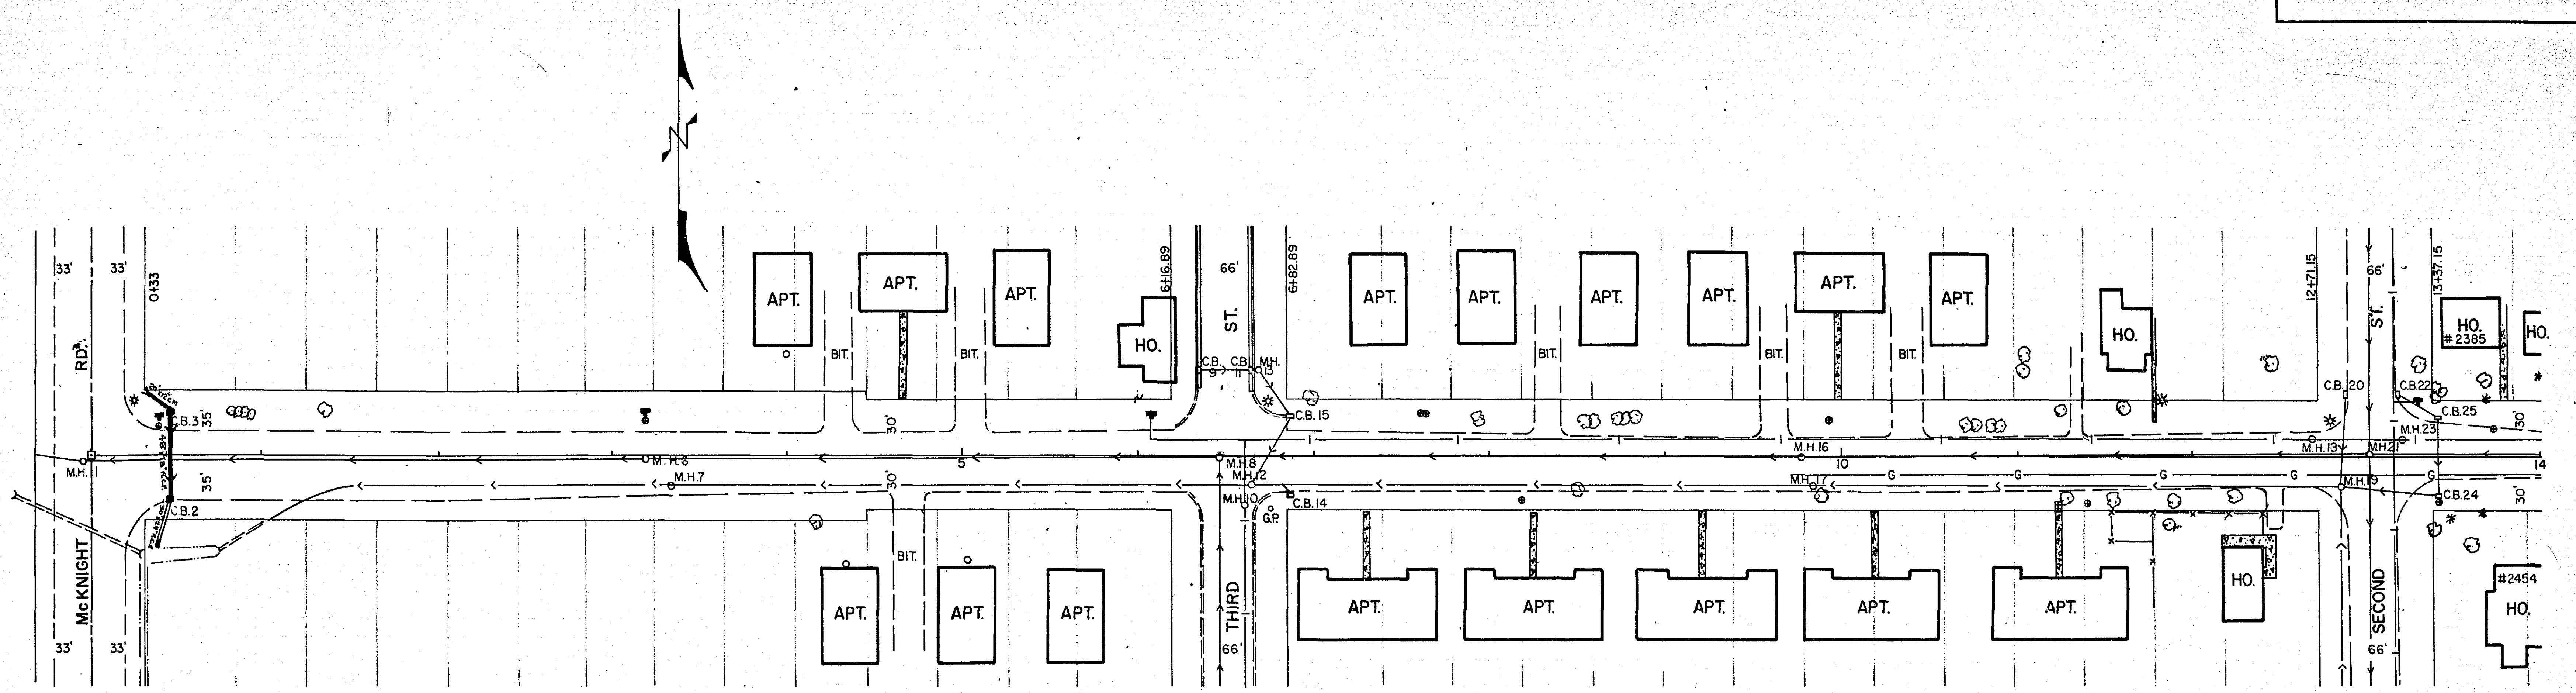


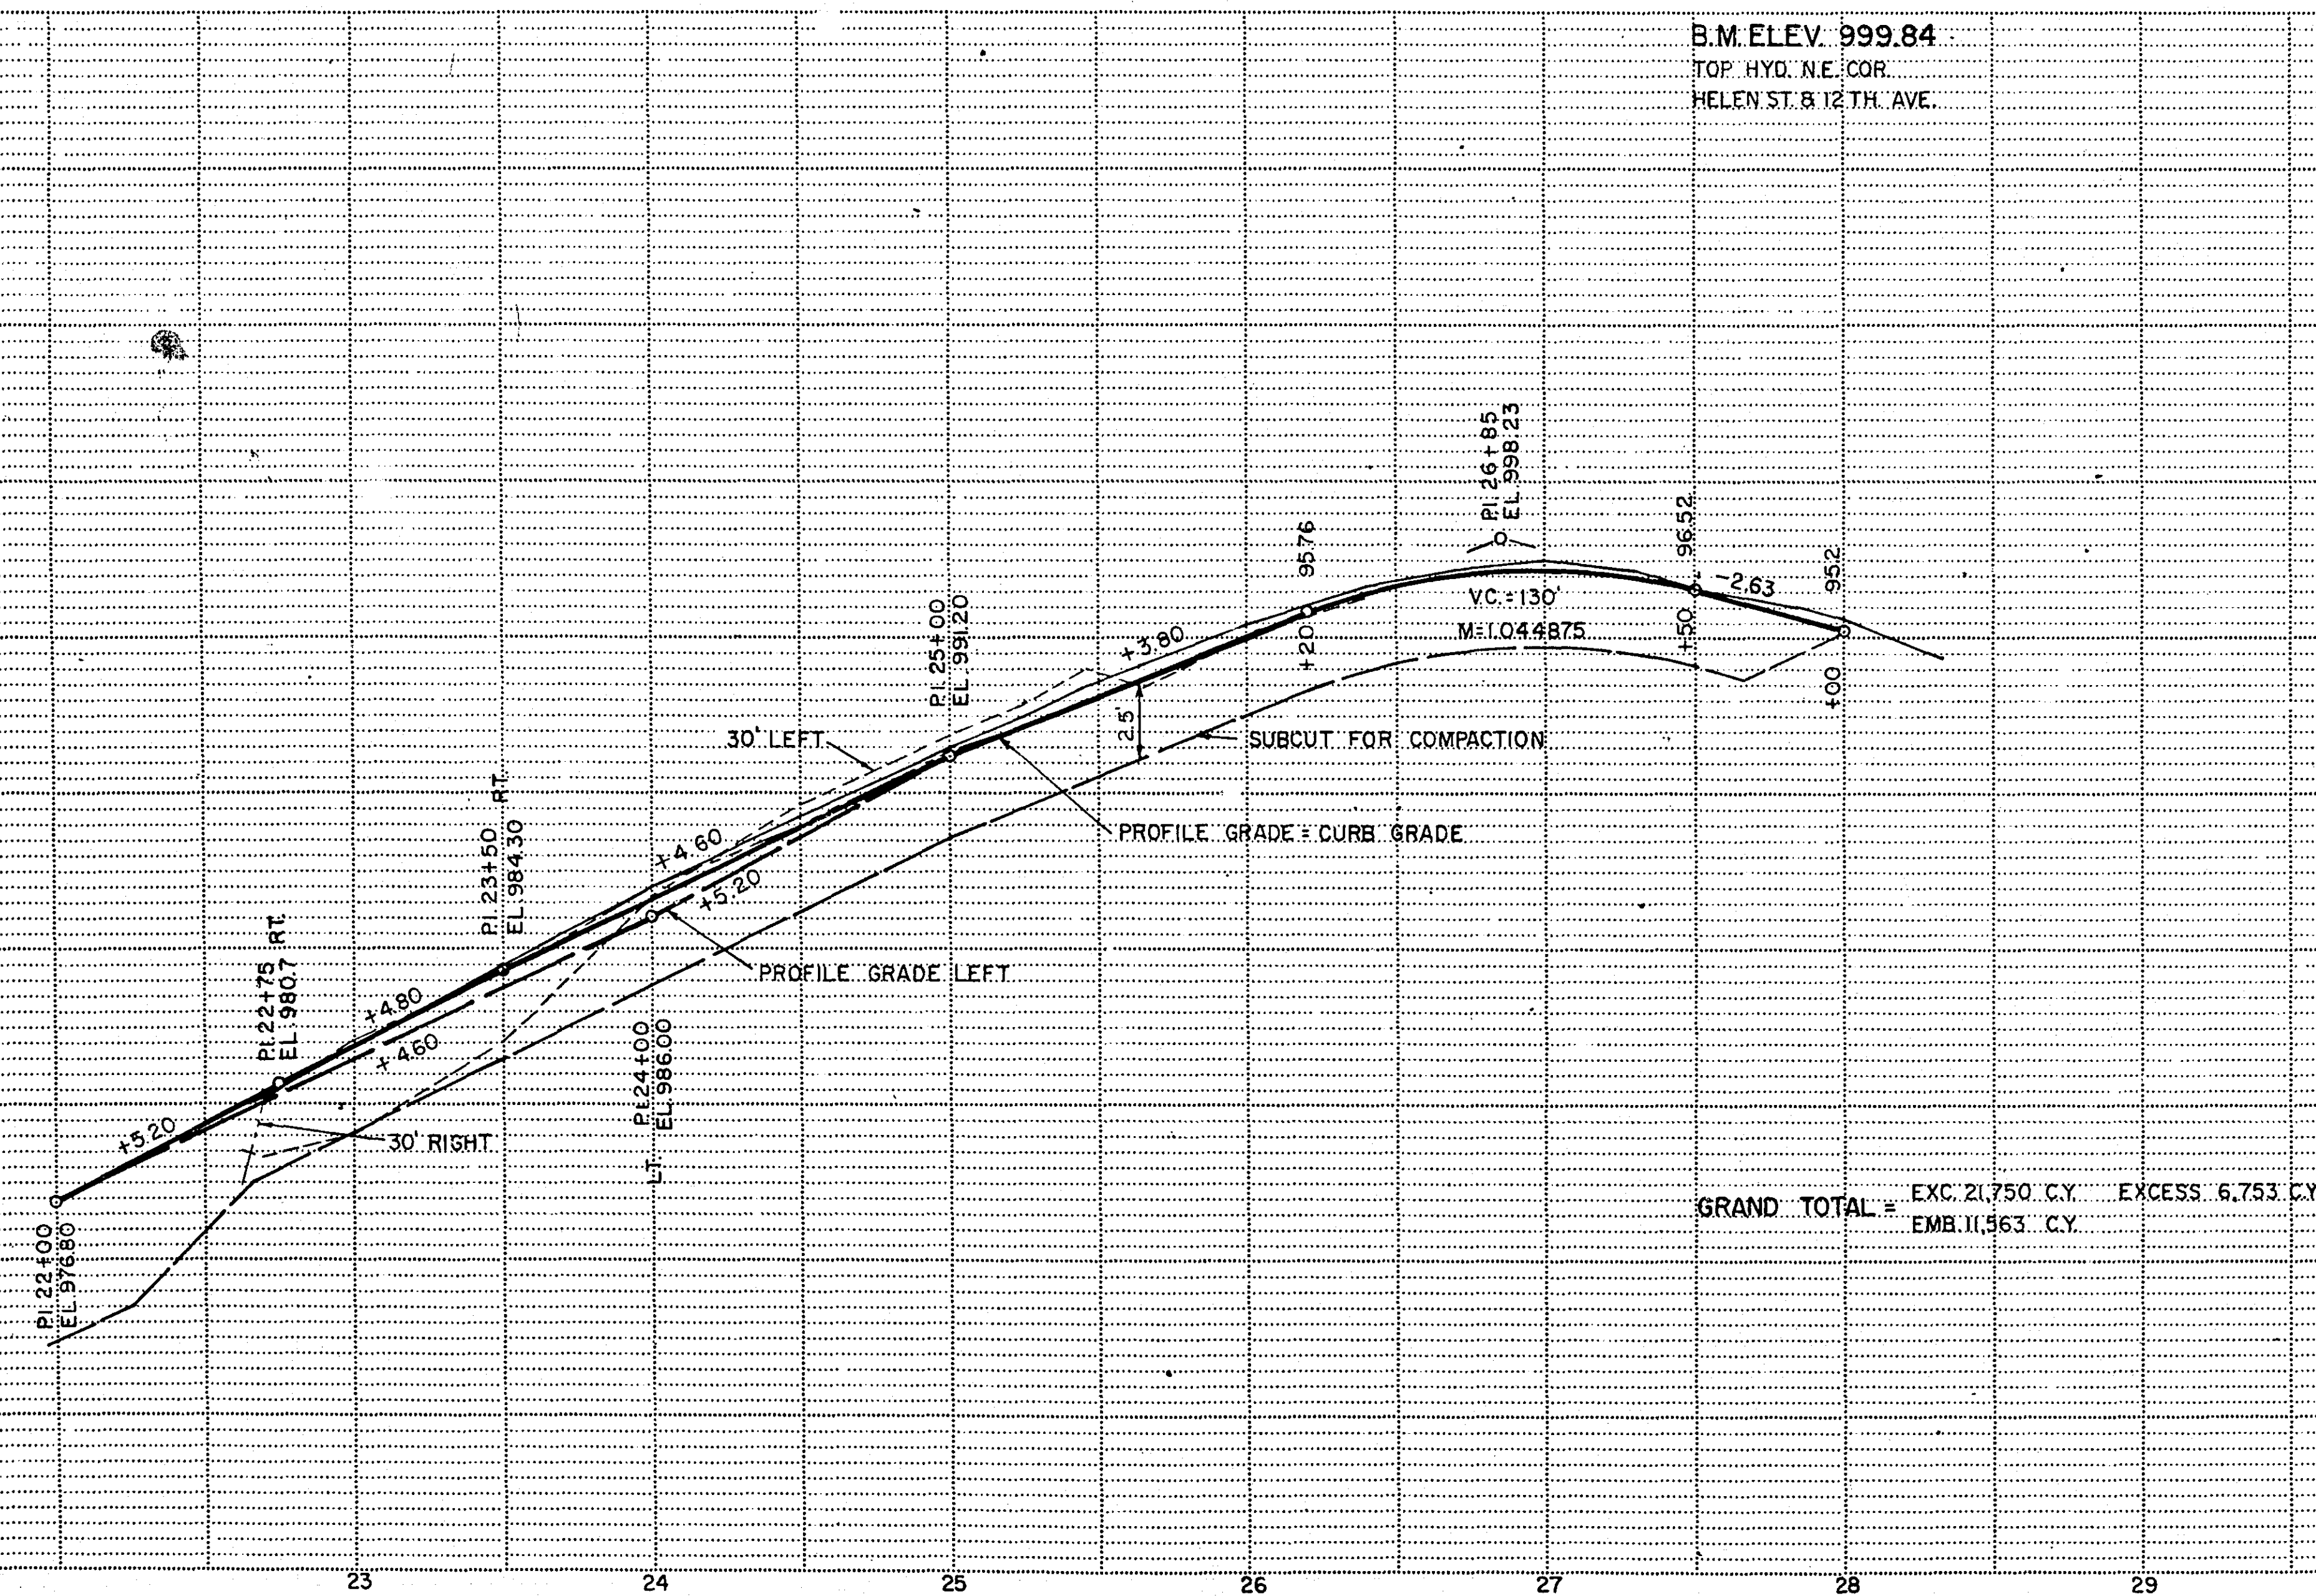


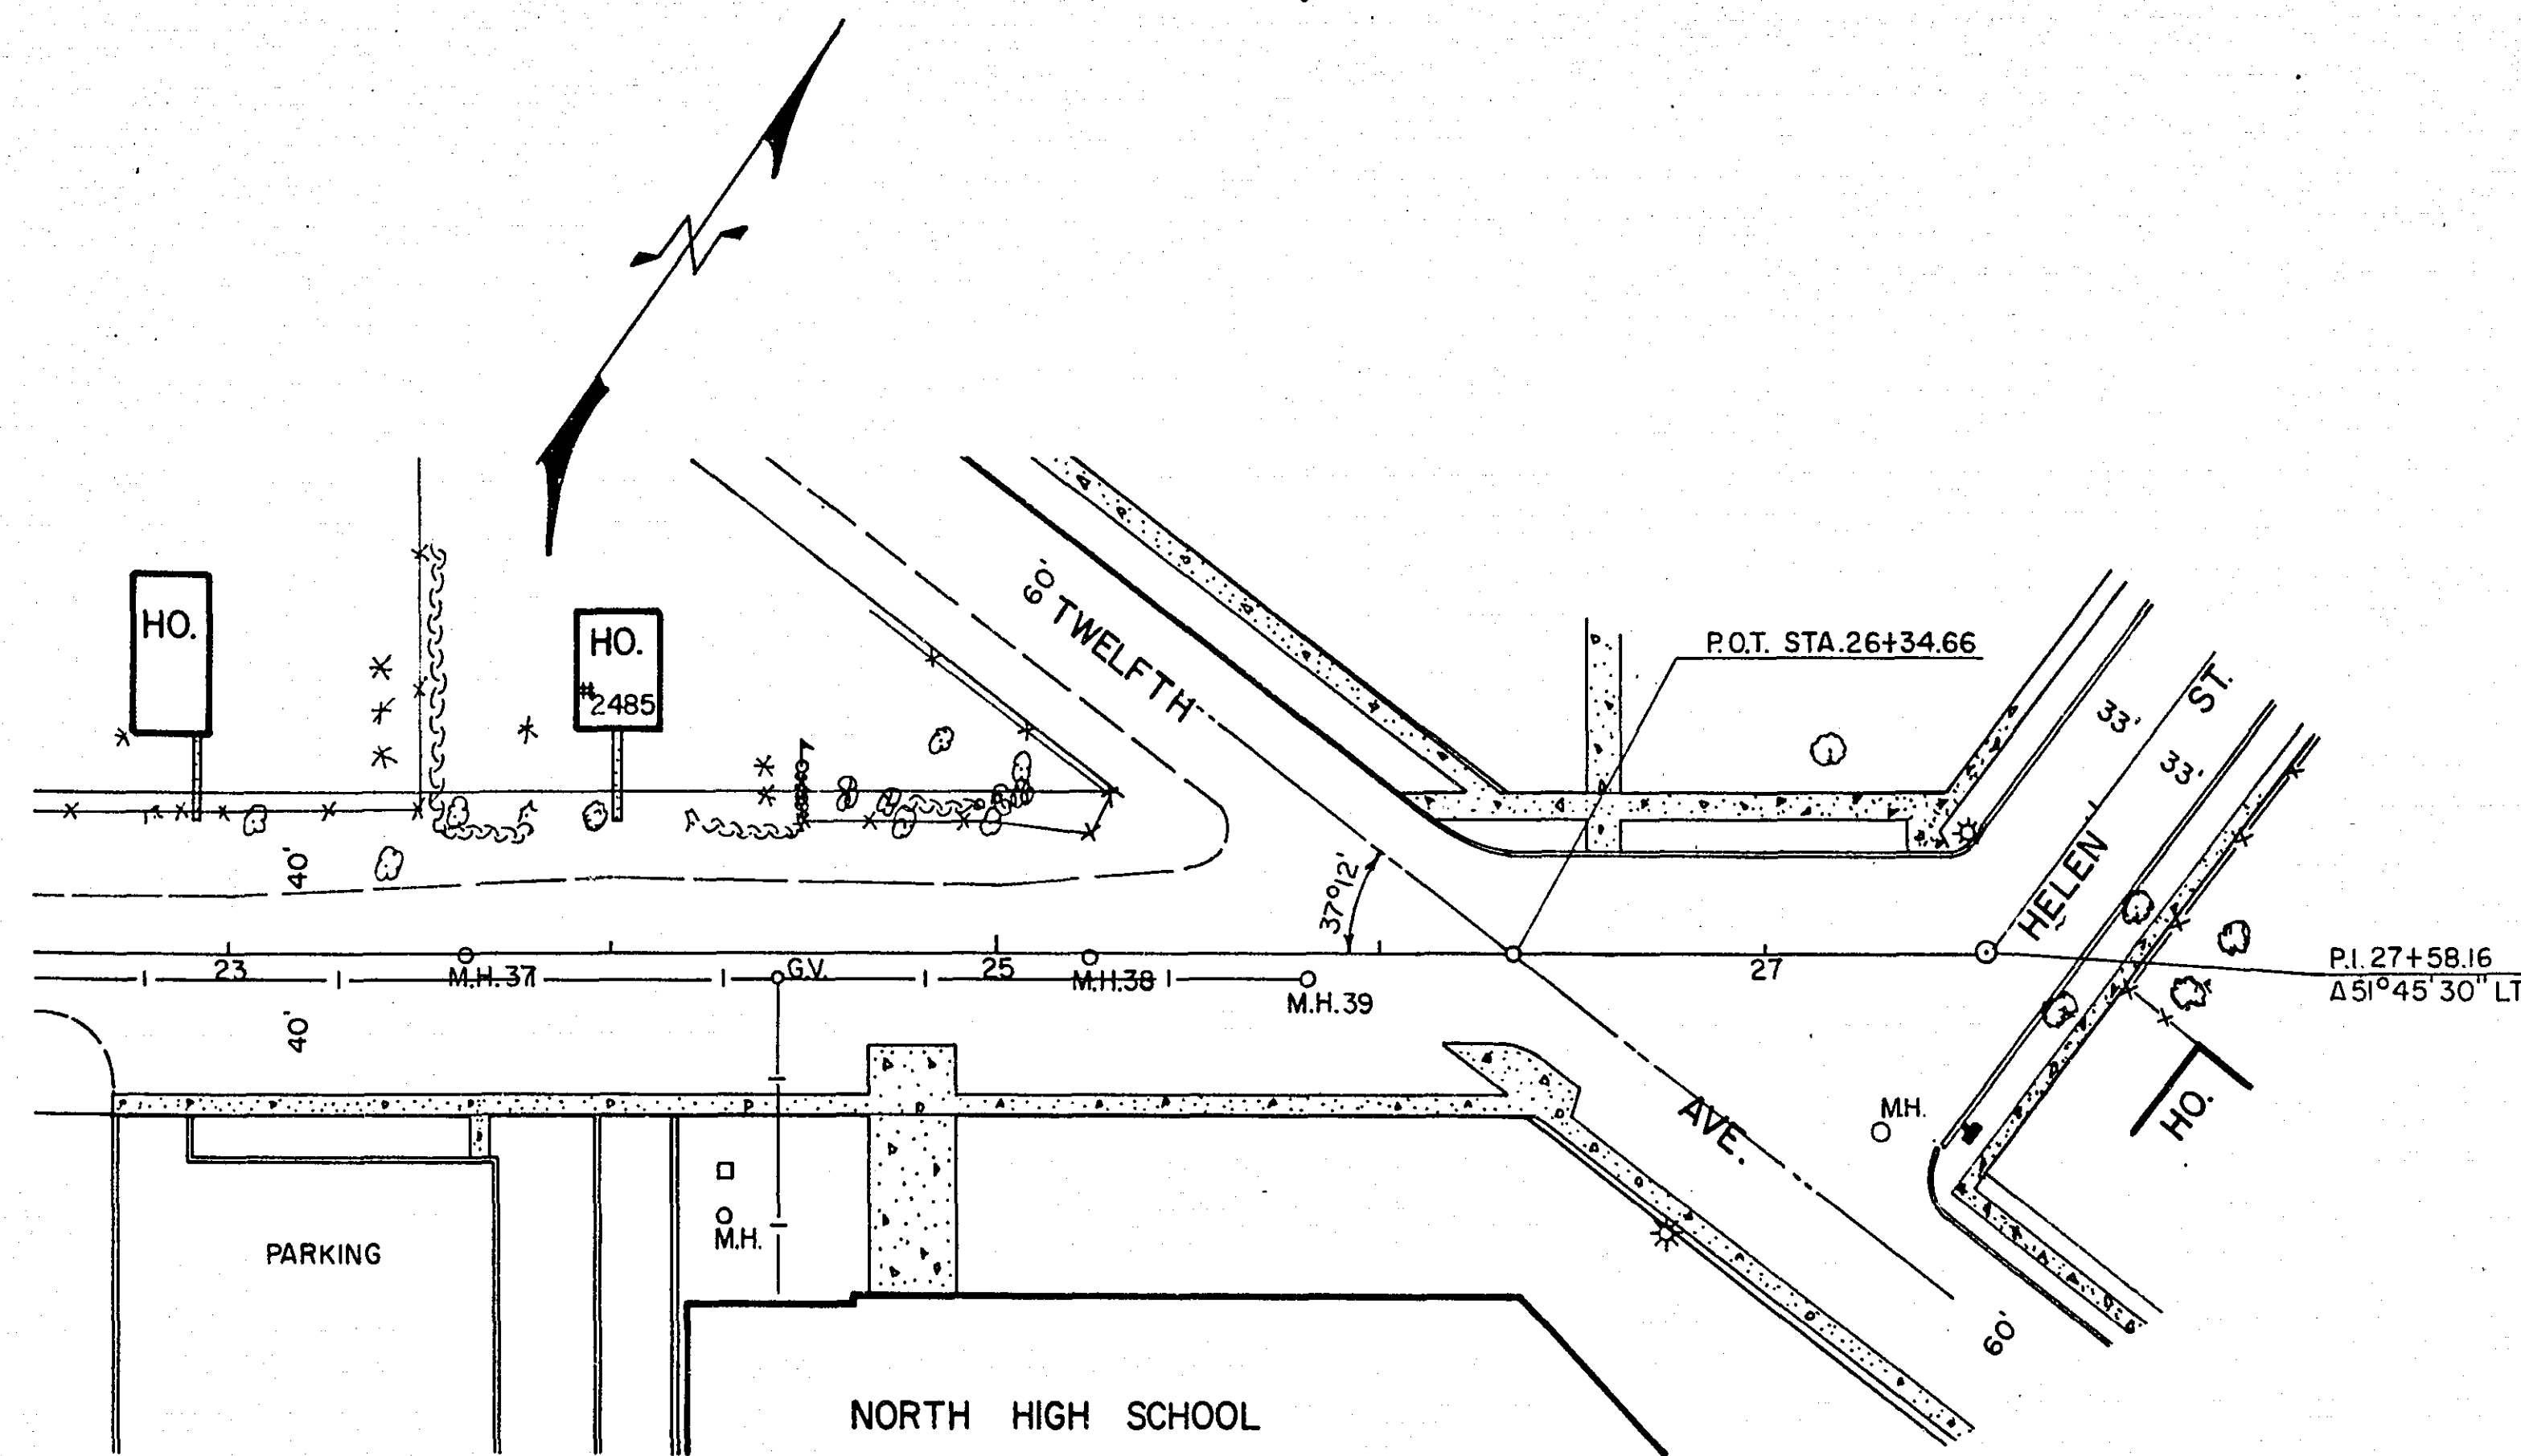

ASBUILT PLAN
 CONFORMING TO
 CONST. RECORDS
 DONE BY:
 DATE:

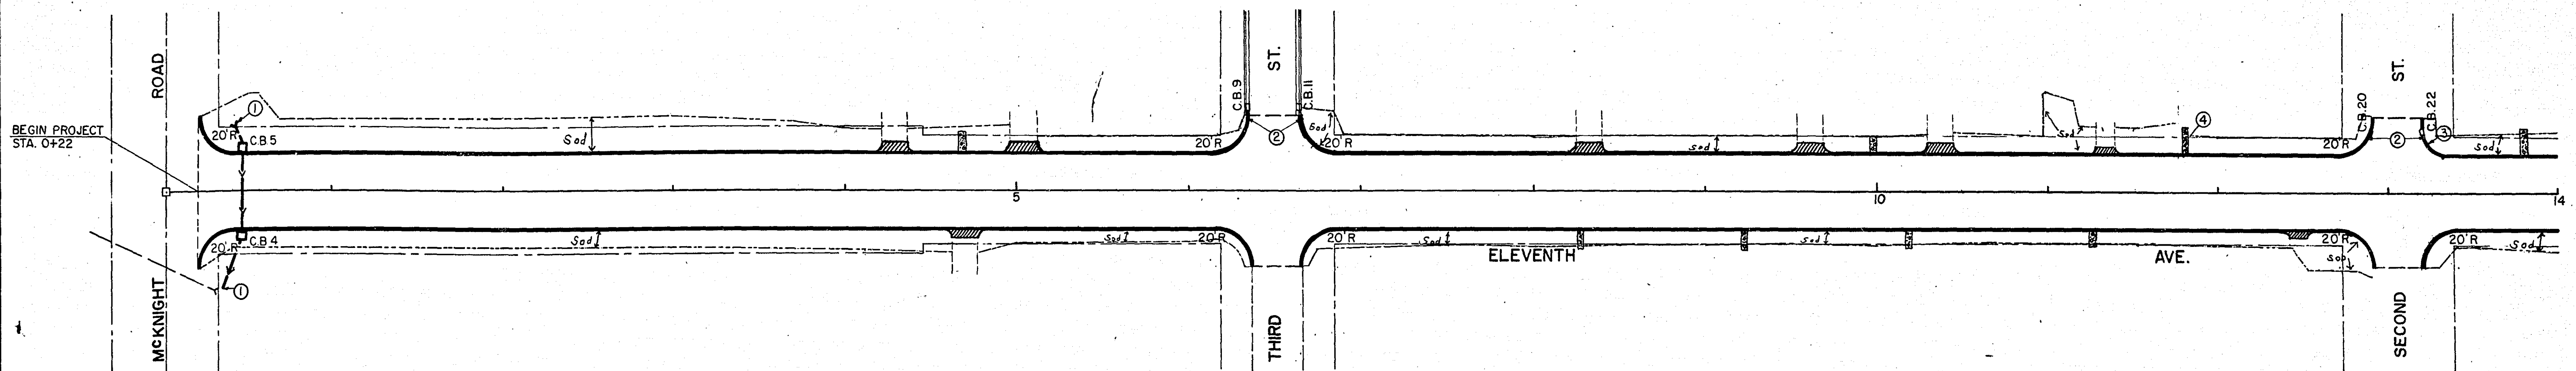

- NOTES: ① DETERMINE EXACT LOCATION AND ELEVATION IN FIELD AS DIRECTED BY ENGINEER.
 ② MATCH RADII TO EXISTING CATCH BASINS.
 ③ DETERMINE RADIUS IN FIELD.
 ④ REMOVE SIDEWALK AS DIRECTED BY ENGINEER.
 ⑤ CONSTRUCT STEPS WHERE AND AS DIRECTED BY ENGINEER.

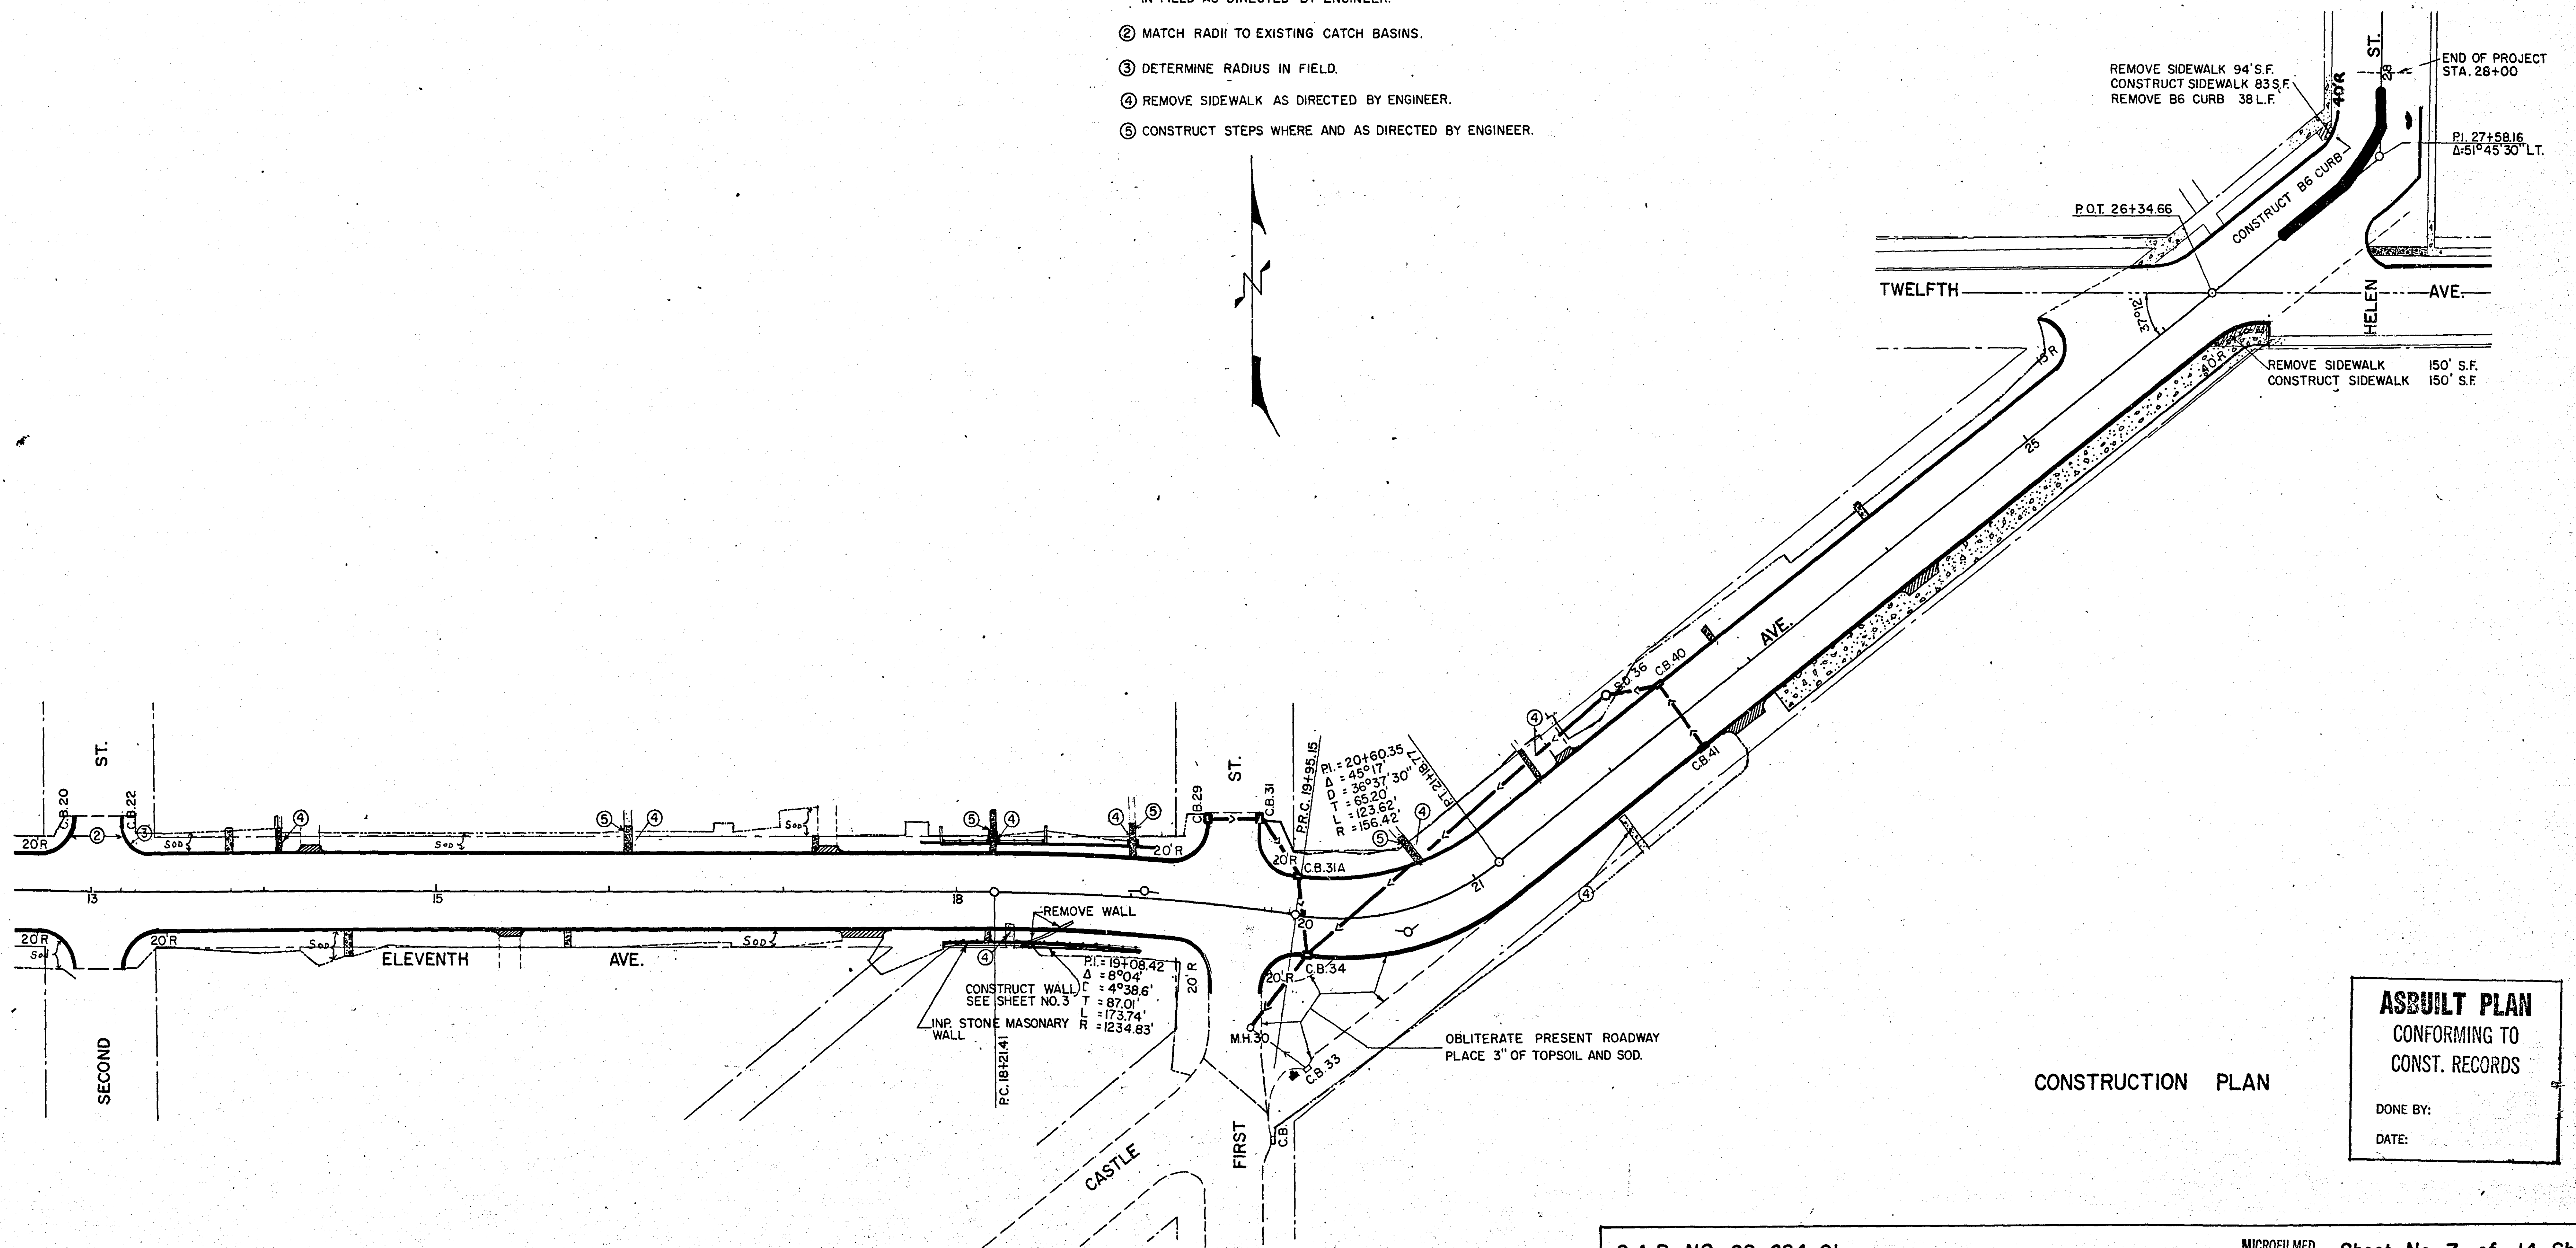

CONSTRUCTION PLAN

ASBUILT PLAN
 CONFORMING TO
 CONST. RECORDS

DONE BY:
 DATE: