

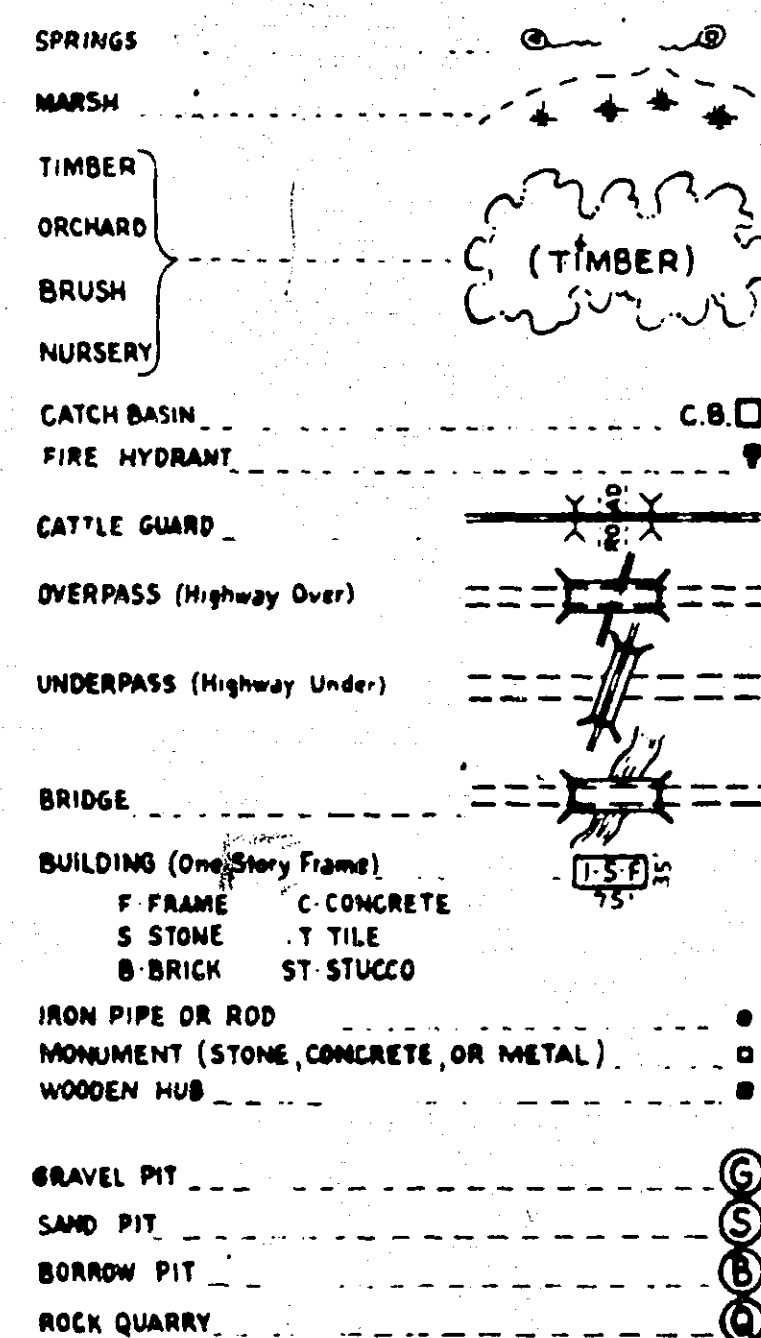
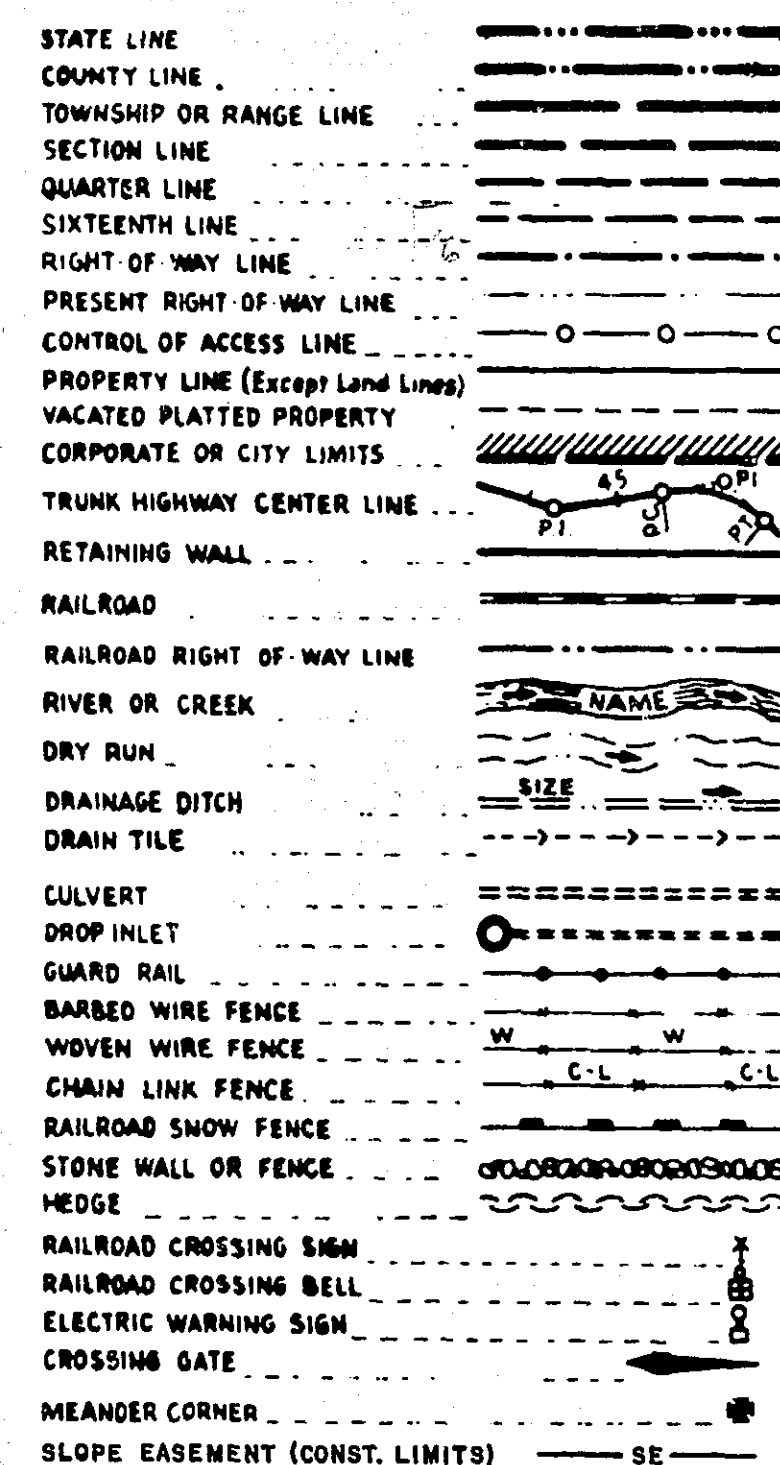
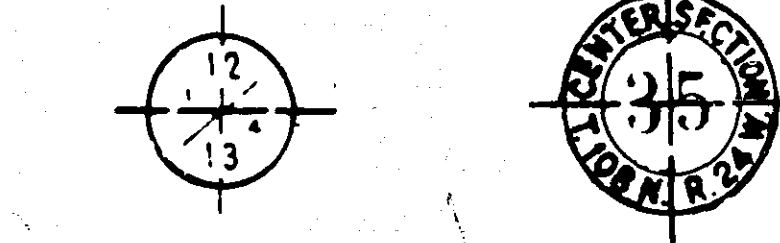


PLANS SYMBOLS

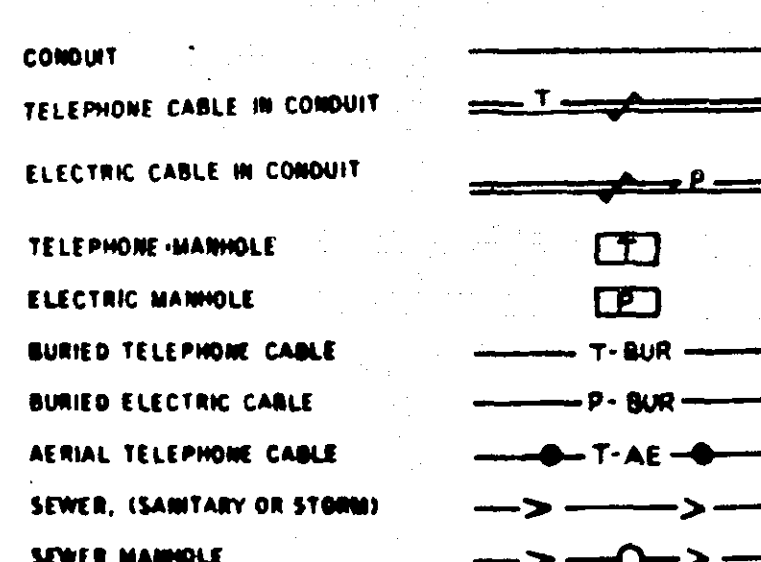

UTILITIES SYMBOLS

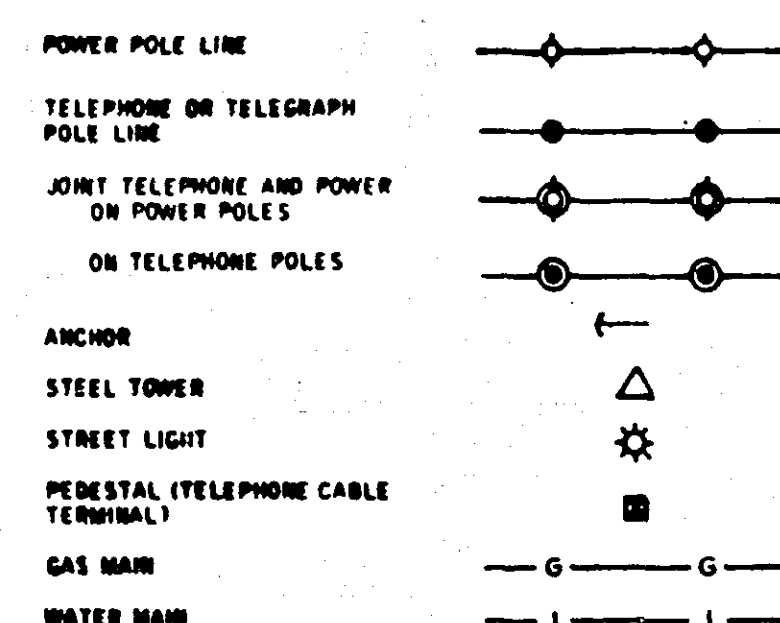

PIT DATA

PIT NO. _____ Located in _____
Dead Haul

PIT NO. _____ Located in _____
Dead Haul

BEGIN 62-626-01 STA. 0+48

END 62-626-01 STA. 16+07 LT.
BEGIN 62-626-02 STA. 16+07 LT.

END 62-626-01 STA. 22+56.75 RT.
BEGIN 62-626-02 STA. 22+56.75 RT.

END 62-626-02 STA. 48+93.93


STOPPING SIGHT DISTANCE BASED ON 3.5' HEIGHT OF EYE,
0.5' HEIGHT OF OBJECT.

THE 1983 EDITION OF THE MINNESOTA DEPARTMENT
OF TRANSPORTATION "STANDARD SPECIFICATIONS FOR
CONSTRUCTION" SHALL GOVERN.

	TOTAL	62-626-01	62-626-02
GROSS LENGTH	FEET = 4,845.93	FEET = 2,208.75	FEET = 3,286.93
BRIDGE LENGTH	FEET = 0.0	FEET = 0.0	FEET = 0.0
EXCEPTION	FEET = 0.0	FEET = 0.0	FEET = 0.0
NET LENGTH	FEET = 4,845.93	FEET = 2,208.75	FEET = 3,286.93
	MILES = 0.9178	MILES = 0.4183	MILES = 0.6225

* TOTAL LENGTH BASED ON
OVERLAP OF 62-262-01 AND
62-626-02 BETWEEN STA.
16+07 TO 22+56.75

PLAN
PROFILE HORIZ.
PROFILE VERT.
CROSS SECTIONS
LAYOUT MAP

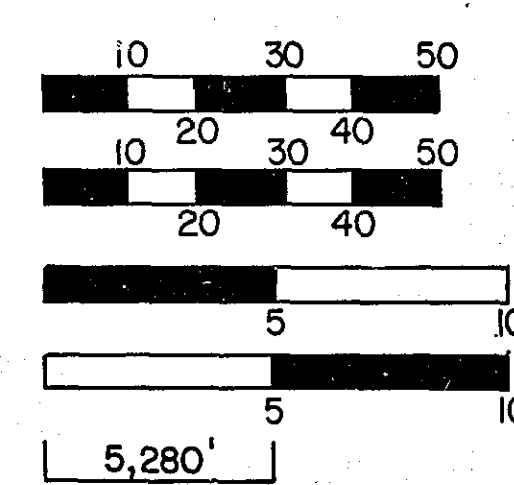

ADT (CURRENT YEAR) 1986	2550
ADT (FUTURE YEAR) 2006	4600
HCA DT	5%
Σ N 18 (20 YEAR)	230,000
DESIGN LOAD	9 TON
STABILOMETER "R" VALUE	20
DESIGN SPEED	40 MPH

APPROVED *Robert J. Schmitt* DATE 4/28/86
CITY ENGINEER, FALCON HEIGHTS

APPROVED *John A. Woodward* DATE 4/28/86
CITY ENGINEER, LAUDERDALE

RAMSEY COUNTY DEPARTMENT OF PUBLIC WORKS

CONSTRUCTION PLAN: FOR GRADING, AGGREGATE BASE, BITUMINOUS BASE
AND SURFACING, STORM SEWER, WATERMAIN, AND CONCRETE CURB AND GUTTER.

CSAH 26 (ROSELAWN AVENUE)

BETWEEN: TH 280 AND CLEVELAND AVE

FROM: A POINT 389.4 FEET EAST OF THE WEST
1/4 CORNER OF SECTION 17, TOWNSHIP 29N, RANGE 23W.

TO: A POINT 12.0 FEET WEST OF THE EAST
1/4 CORNER OF SECTION 17, TOWNSHIP 29N, RANGE 23W.

C.S.A.P. 62-626-01
C.S.A.P. 62-626-02
P-W-85-31 ROSEVILLE
P-86-15 ROSEVILLE

INDEX OF SHEETS

SHEET NO.	DESCRIPTION
1	TITLE SHEET
2-3	ESTIMATED QUANTITIES
4	TYPICAL SECTIONS & DETAILS
5	DRAINAGE CHART
6	DRAINAGE CHART & DETAIL
7-8	DETAILS
9-14	PLAN AND PROFILE SHEETS
15-29	CROSS SECTION SHEETS
29A	PLAN AND PROFILE (FULHAM STREET)
29B	CROSS SECTIONS (FULHAM STREET)

I HEREBY CERTIFY THAT THIS PLAN WAS PREPARED BY ME OR UNDER MY DIRECT
SUPERVISION AND THAT I AM A DULY REGISTERED PROFESSIONAL ENGINEER UNDER
THE LAWS OF THE STATE OF MINNESOTA

DATE 3-25-86 REG. NO. 14410 ENGR. *D. J. Schmitt* S.E.H.

RECOMMENDED FOR APPROVAL *Ken Schmitt* DATE 4-25-86
COUNTY ENGINEER

RECOMMENDED FOR APPROVAL *PAX* DATE 4-1-86
TRAFFIC ENGR

RECOMMENDED FOR APPROVAL *JP* DATE 4/28/86
ENGR

RECOMMENDED FOR APPROVAL *JP* DATE 4/28/86
MAINT. ENGR

RECOMMENDED FOR APPROVAL *RHP* DATE 4-28-86
DESIGN ENGR

RECOMMENDED FOR APPROVAL *LKF* DATE 4-28-86
DESIGN ENGR

RECOMMENDED FOR APPROVAL *JP* DATE 4-28-86
CONSTRUCTING ENGR

RECOMMENDED FOR APPROVAL *Julius Skallman* DATE 5/22/86
PLANS & SPEC. ENGINEER

RECOMMENDED FOR APPROVAL *JP* DATE 5/9/86
DISTRICT STATE AID ENGINEER

APPROVED *David A. Hylton* DATE 5/24/86
DIRECTOR, OFFICE OF STATE AID

PLAN REVISIONS		
DATE	SHEET NO.	BY
5-19-87	3, 7, 10	DEM
6-10-87	ADDED P-86-15 PLANS	D.I.P.

C.S.A.P. NO. 62-626-01, NO. 62-626-02, P-W-85-31

Sheet No. 1 of 29 Sheets

2

STATEMENT OF ESTIMATED QUANTITIES					S.A.P. 62-626-01				S.A.P. 62-626-02				P-86-15 NON-PARTICIPATING			
ITEM NO.	ITEM	UNIT	TOTAL ESTIMATED QUANTITIES	TOTAL FINAL QUANTITIES	RAMSEY COUNTY		LAUDERDALE		RAMSEY COUNTY		FALCON HEIGHTS		ROSEVILLE		ROSEVILLE	
					ESTIMATED QUANTITIES	FINAL QUANTITIES	ESTIMATED QUANTITIES	FINAL QUANTITIES	ESTIMATED QUANTITIES	FINAL QUANTITIES	ESTIMATED QUANTITIES	FINAL QUANTITIES	ESTIMATED QUANTITIES	FINAL QUANTITIES		
DIVISION I	STREET, STORM SEWER & RESTORATION															
2021.501	MOBILIZATION	L.S.	1		036				039		009		016			
2101.502	CLEARING	TREE	50		1						15		33		1	
2101.507	GRUBBING	TREE	50		1						15		33		1	
2104.501	REMOVE STORM SEWER PIPE	L.F.	949		500						100		344		5	
2104.501	REMOVE FENCE, CHAIN-LINK	L.F.	2,550						2,550							
2104.505	REMOVE CONCRETE DRIVEWAY PAVEMENT	S.Y.	252		218								34			
2104.509	REMOVE GATE WELL	EACH	1								1					
2104.509	REMOVE CATCH BASIN	EACH	21		13						1		6		1	
2104.509	REMOVE MANHOLE	EACH	24		1								23			
2104.521	SALVAGE FENCE, WOOD RAIL	L.F.	163		163											
2104.523	SALVAGE CASTING ASSEMBLIES	EACH	37		17								20			
2104.523	SALVAGE 21" R.C. APRON	EACH	1						1							
2105.501	COMMON EXCAVATION (P)	C.Y.	14,164		4,363				6,256		1,344		1,787		414	
					11,590				8,278				2,922		977	
2105.507	SUBGRADE EXCAVATION (P)	C.Y.	23,787		7,878				9,840				2,532		1270	
2105.521	GRANULAR BORROW (LV)	C.Y.	21,520													
2105.525	TOPSOIL BORROW (LV)	C.Y.	2,005		635						735		560		75	
2130.501	WATER, DUST CONTROL	(M) GAL	100		50				33				17			
2211.501	AGGREGATE BASE, CLASS 5 (100 % CRUSHED)	TON	9,698		3,941				3,172				2,085		500	
					128				119				69		44	
2331.504	BITUMINOUS MATERIAL FOR MIXTURE	TON	3204		755				699				407			
2331.510	BINDER COURSE MIXTURE	TON	1,861		2,014				1,871				1,080		97	
2331.514	BASE COURSE MIXTURE	TON	5,062						41				25		58	
2341.504	BITUMINOUS MATERIAL FOR MIXTURE	TON	116.8		45				699				407		97	
2341.508	WEARING COURSE MIXTURE	TON	1,958		755											
2341.605	BITUMINOUS DRIVEWAY RESTORATION	S.Y.	610		257								353			
2357.502	BITUMINOUS MATERIAL FOR TACK COAT	GAL.	2,111		832				850				370		59	
2411.603	CONSTRUCT STONE RETAINING WALL	S.F.	1,758		24						1,320		189		225	
2411.603	CONCRETE BLOCK RETAINING WALL	S.F.	2,458								2,458					
2451.511	COARSE FILTER AGGREGATE (LV)	C.Y.	425		225				200							
2451.513	FINE FILTER AGGREGATE (CV)	C.Y.	40		20				12				8			
2501.515	15" RC PIPE APRON	EACH	2						2							
2501.515	21" RC PIPE APRON	EACH	1		1											
2501.573	INSTALL 21" RC PIPE APRON	EACH	1						1							
2502.541	6" PERFORATED PE PIPE DRAIN	L.F.	101		63				27				11			
2503.541	15" RC PIPE SEWER, DESIGN 3006, CL. V	L.F.	1920		952				928						40	
2503.541	18" RC PIPE SEWER, DESIGN 3006, CL. V	L.F.	166		84				82							
2503.541	21" RC PIPE SEWER, DESIGN 3006, CL. IV	L.F.	94		84				10							
2506.506	CONSTRUCT MANHOLES, DESIGN F	L.F.	8		8										9	
2506.506	CONSTRUCT MANHOLES, DESIGN B	L.F.	40.2		13.2				18							
2506.506	CONSTRUCT MANHOLES, DESIGN C	L.F.	34.8		11.6				23.2							
2506.507	CONSTRUCT CATCH BASINS, DESIGN LP4	L.F.	28.7		18.8				9.9						8	
2506.507	CONSTRUCT CATCH BASINS, DESIGN RC-2	L.F.	113		64.5				40.5							
2506.507	CONSTRUCT CATCH BASINS, DESIGN B	L.F.	21		7.3				13.7							
2506.507	CONSTRUCT CATCH BASINS, DESIGN H	L.F.	140		2.8				11.2							
2506.511	RECONSTRUCT MANHOLES	L.F.	39.2		12.3								26.9			
2506.512	RECONSTRUCT CATCH BASINS	L.F.	1						1						1	
2506.516	CASTING ASSEMBLIES, R-1733	EACH	8		4				3						2	
2506.516	CASTING ASSEMBLIES, R-3067-L	EACH	39		19				18							
2506.516	CASTING ASSEMBLIES R-2502-B	EACH	3		1				2							
2506.521	INSTALL CASTING ASSEMBLIES	EACH	8		2								6		5	
2506.522	ADJUST FRAME AND RING CASTINGS	EACH	29		11								13			

BASIS OF ESTIMATED QUANTITIES

2211.501	AGGREGATE BASE, CL. 5	110#/S.Y./IN.
2331.504	BIT. MATERIAL FOR MIXTURE	4.5%
2331.510	BINDER COURSE MIXTURE	110#/S.Y./IN.
2331.514	BASE COURSE MIXTURE	110#/S.Y./IN.
2341.504	BIT. MATERIAL FOR MIXTURE	6.0%
2341.508	WEARING COURSE MIXTURE	110#/S.Y./IN.
2357.502	BIT. MATERIAL FOR TACKCOAT	0.05 GAL./S.Y.

SURVEY:	CHECKED BY:	NO.	DATE	REVISIONS	I HEREBY CERTIFY THAT THIS PLAN WAS PREPARED BY ME OR UNDER MY DIRECT SUPERVISION AND THAT I AM A DULY REGISTERED PROFESSIONAL ENGINEER UNDER THE LAWS OF THE STATE OF MINNESOTA. DATE: 3-25-86 REG. NO. 14410
DESIGN:		1	4-29-86	ADDED CB77B & CB77C QUANT.	
DRAWN:		2	6-10-87	ADDED P-86-15 QUANT.	



SHORT - ELLIOTT - HENDRICKSON, INC.
Saint Paul, Minnesota • Chippewa Falls, Wisconsin


RAMSEY COUNTY, MINNESOTA

ESTIMATED QUANTITIES


FILE NO.:	2
86068	
DATE:	
3-25-86	29

P-86-15

C.S.A.P. NO. 62-626-01, NO. 62-626-02, P-W-85-31 27-1/7

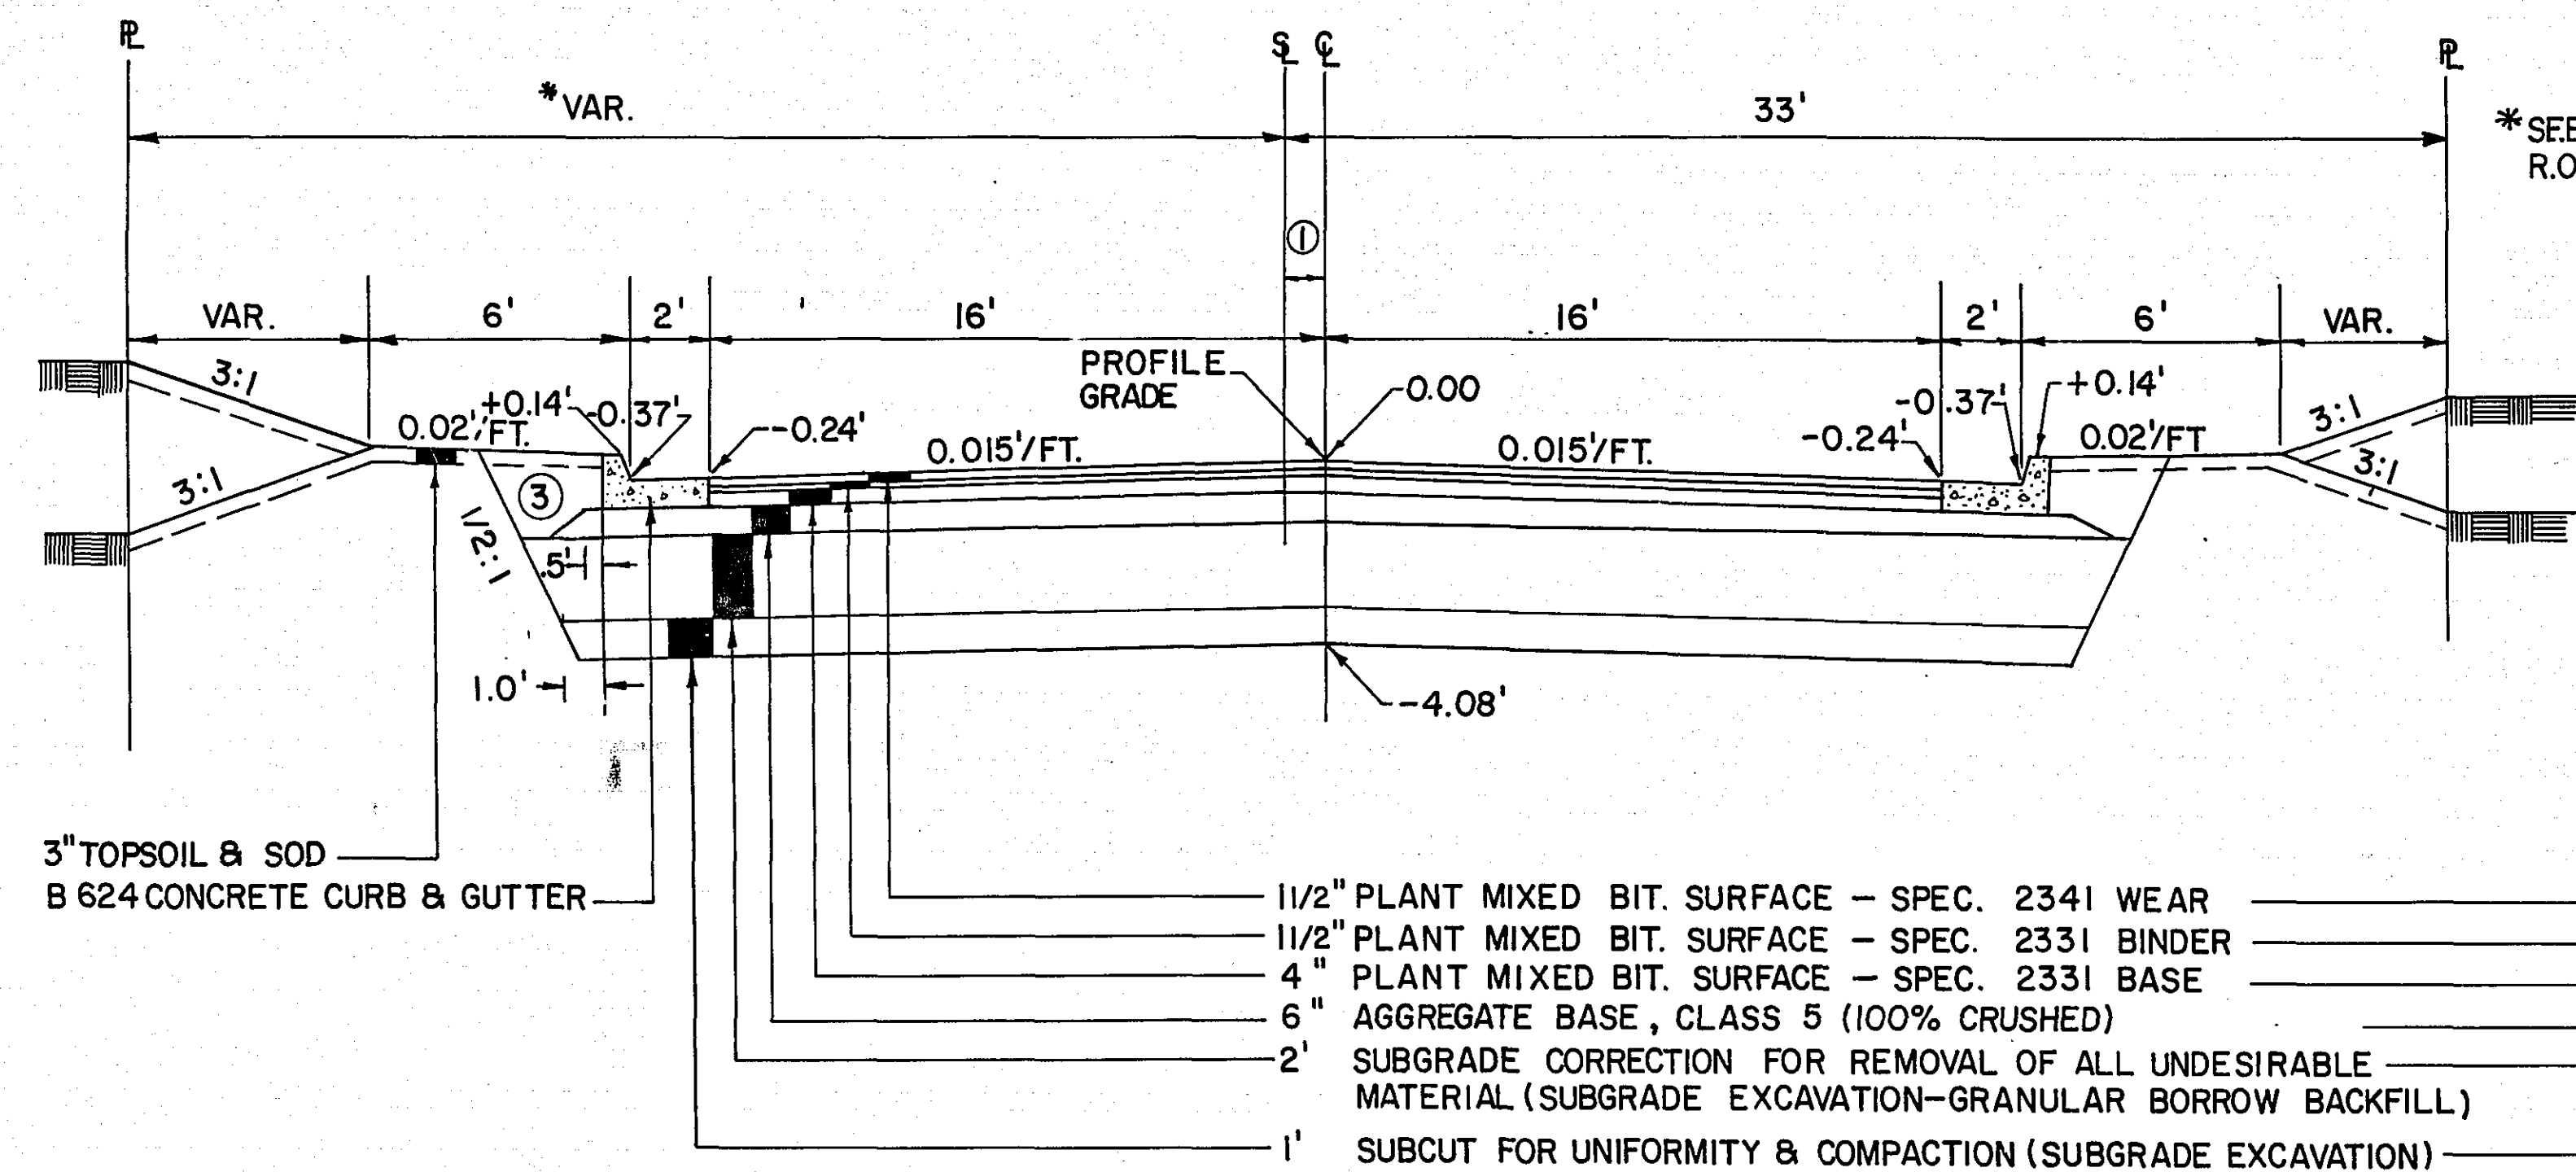


TYPICAL SECTION
0+48.00 TO 23+04.75

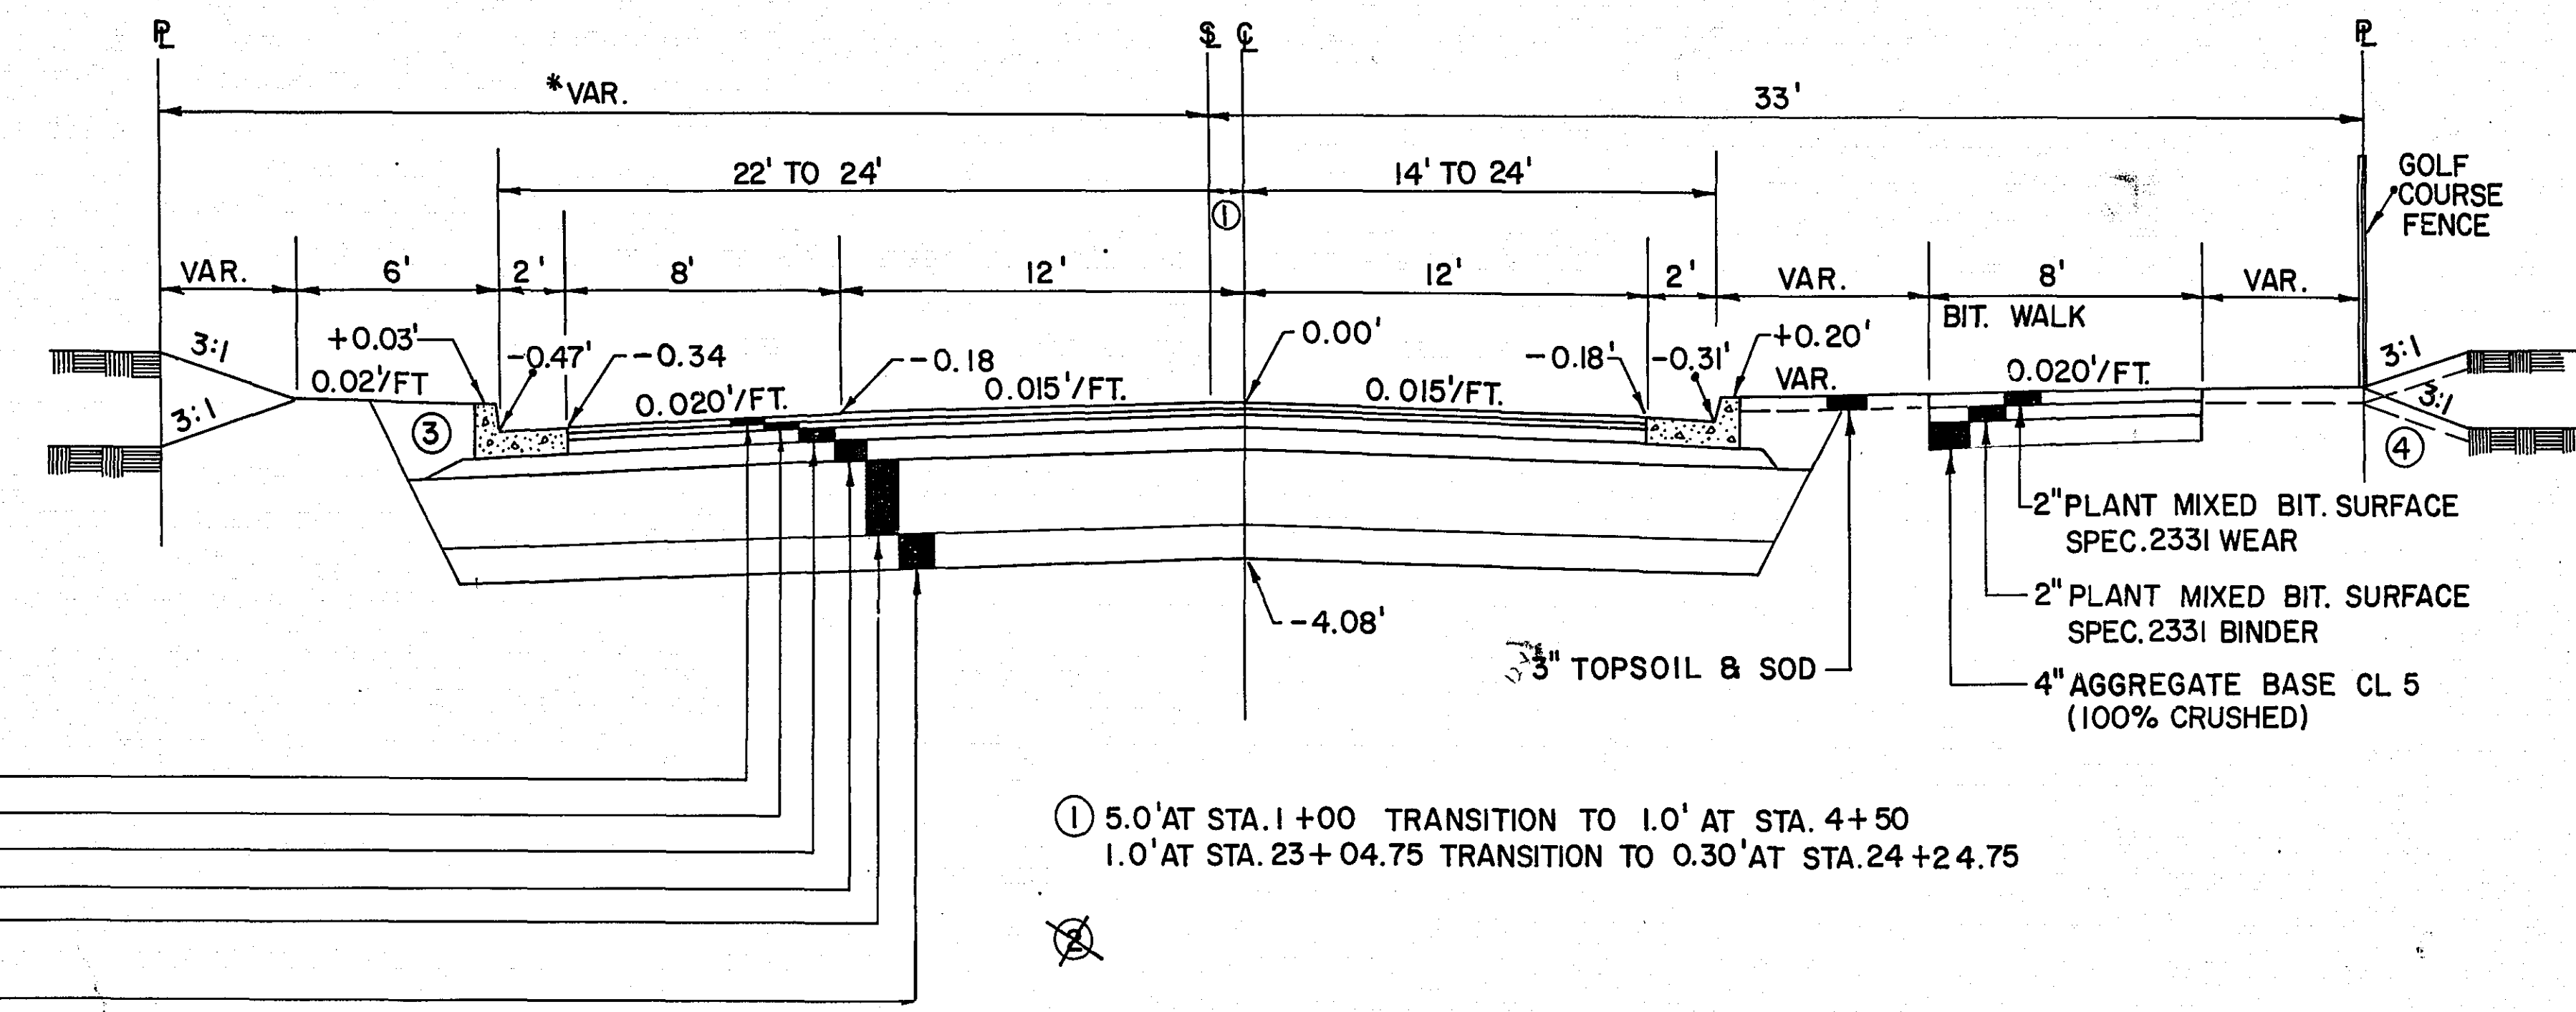


① 5.0' AT STA. 1+00 TRANSITION TO 1.0' AT STA. 4+50
1.0' AT STA. 23+04.75 TRANSITION TO 0.30' AT STA. 24+24.75

- ③ BACKFILL AREA TO BE CONSTRUCTED WITH MATERIAL FROM SUBGRADE CORRECTION AS DIRECTED BY THE ENGINEER.
④ FILL SLOPE SHALL BE 6:1 FROM STA. 30+85 TO STA. 34+10 RT.


TYPICAL SECTION
23+04.75 TO 48+93.93

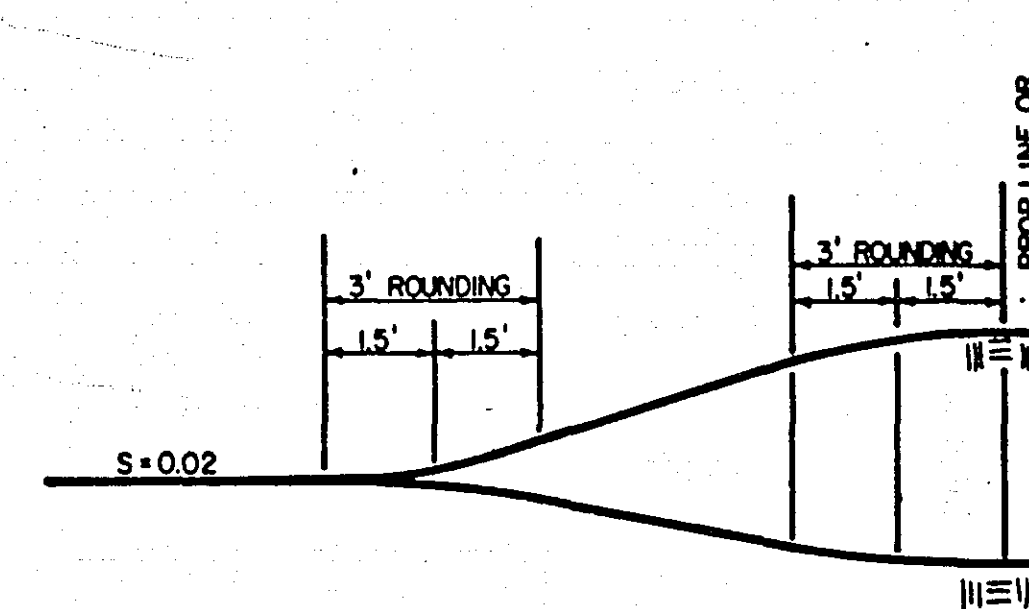

SLOPE ROUNDING DETAIL

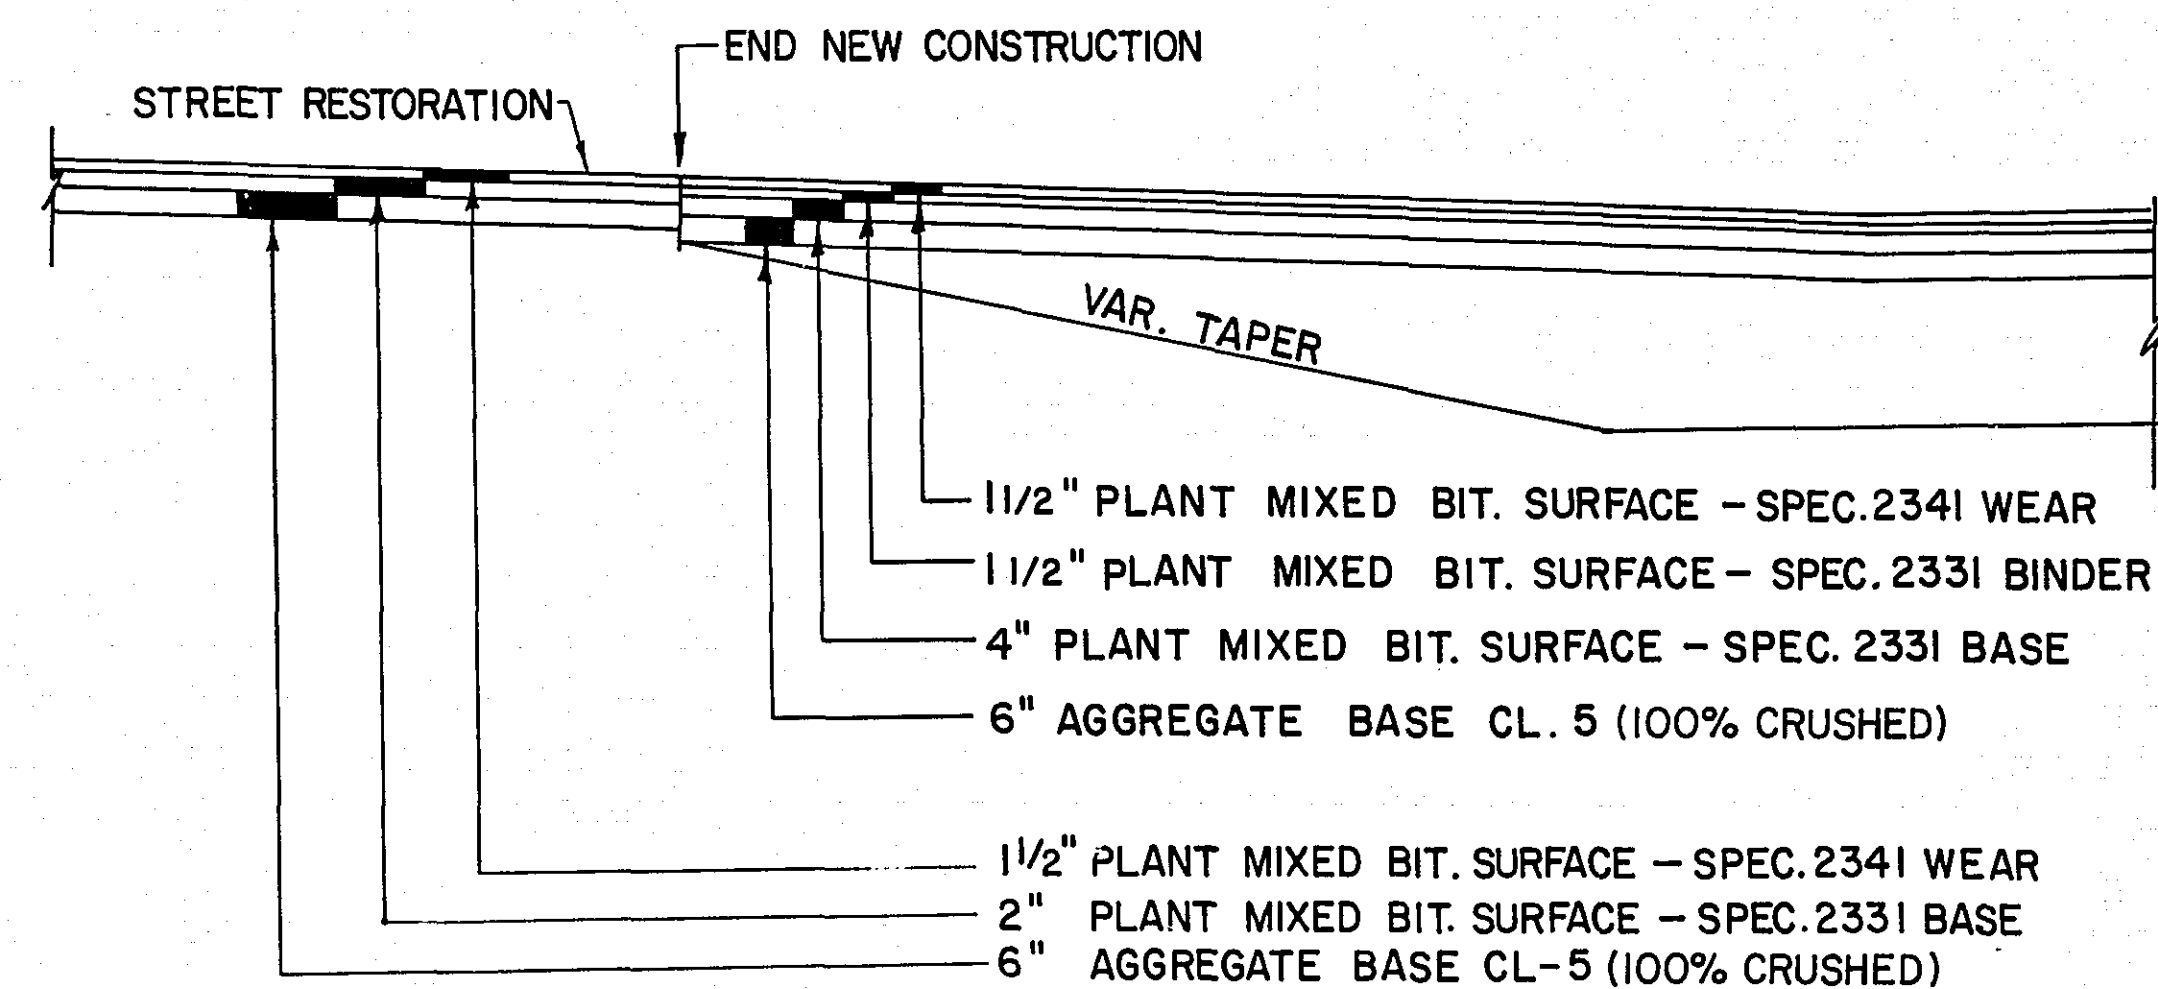

SUBSURFACE DRAIN DETAIL

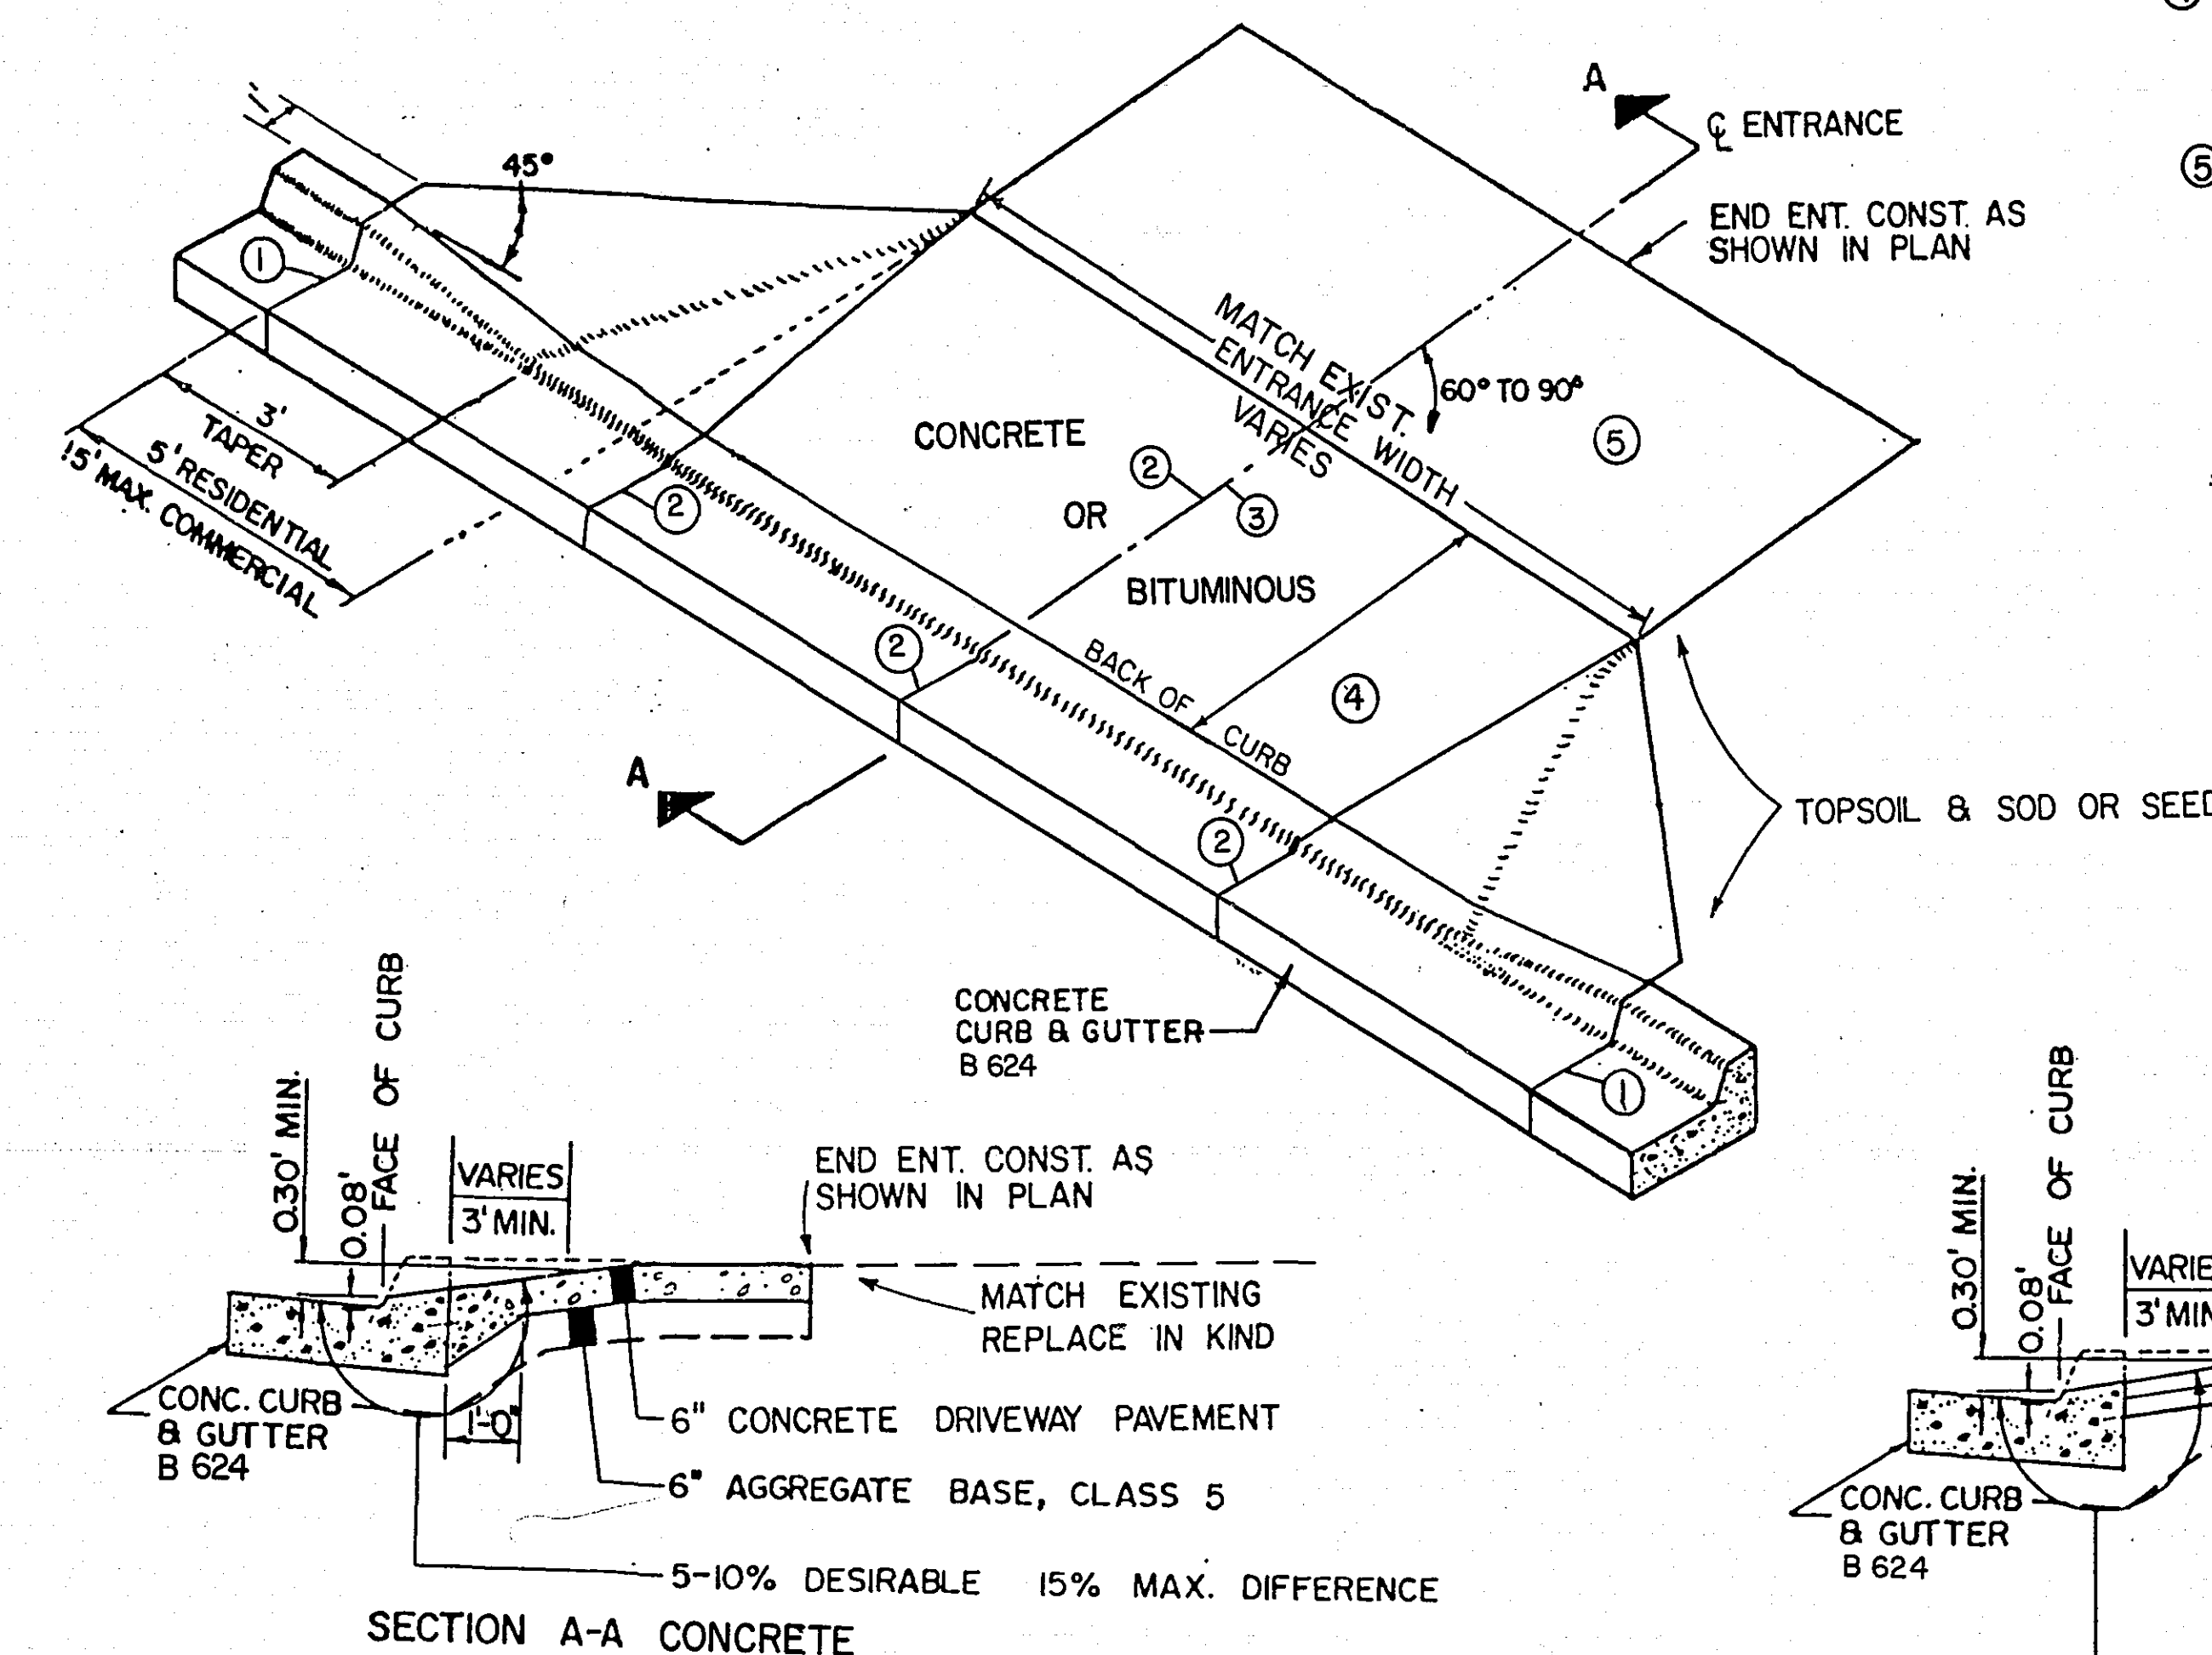


ENTRANCE DETAIL

- ① 1/2" EXPANSION JOINT AS NEEDED.
② PLACE JOINTS AS REQUIRED FOR CONCRETE ENTRANCE
③ CONTRACTION JOINT REQUIRED IF WIDTH EXCEEDS 16.0' FOR CONCRETE ENTRANCE.
④ APRON SECTION SHALL BE: CONCRETE - LAUDERDALE, ROSEVILLE CONCRETE - FALCON HEIGHTS
⑤ DRIVEWAY SECTION SHALL BE: MATCH IN KIND - LAUDERDALE, ROSEVILLE* CONCRETE - FALCON HEIGHTS
* EXISTING GRAVEL DRIVEWAYS SHALL BE CONSTRUCTED WITH BITUMINOUS SECTION.

GENERAL NOTE:

THE EXACT LOCATION AND WIDTH OF ENTRANCES TO BE DETERMINED IN THE FIELD BY THE ENGINEER.
12' MIN. - 22' MAX. RESIDENTIAL
18' MIN. - 32' MAX. COMMERCIAL

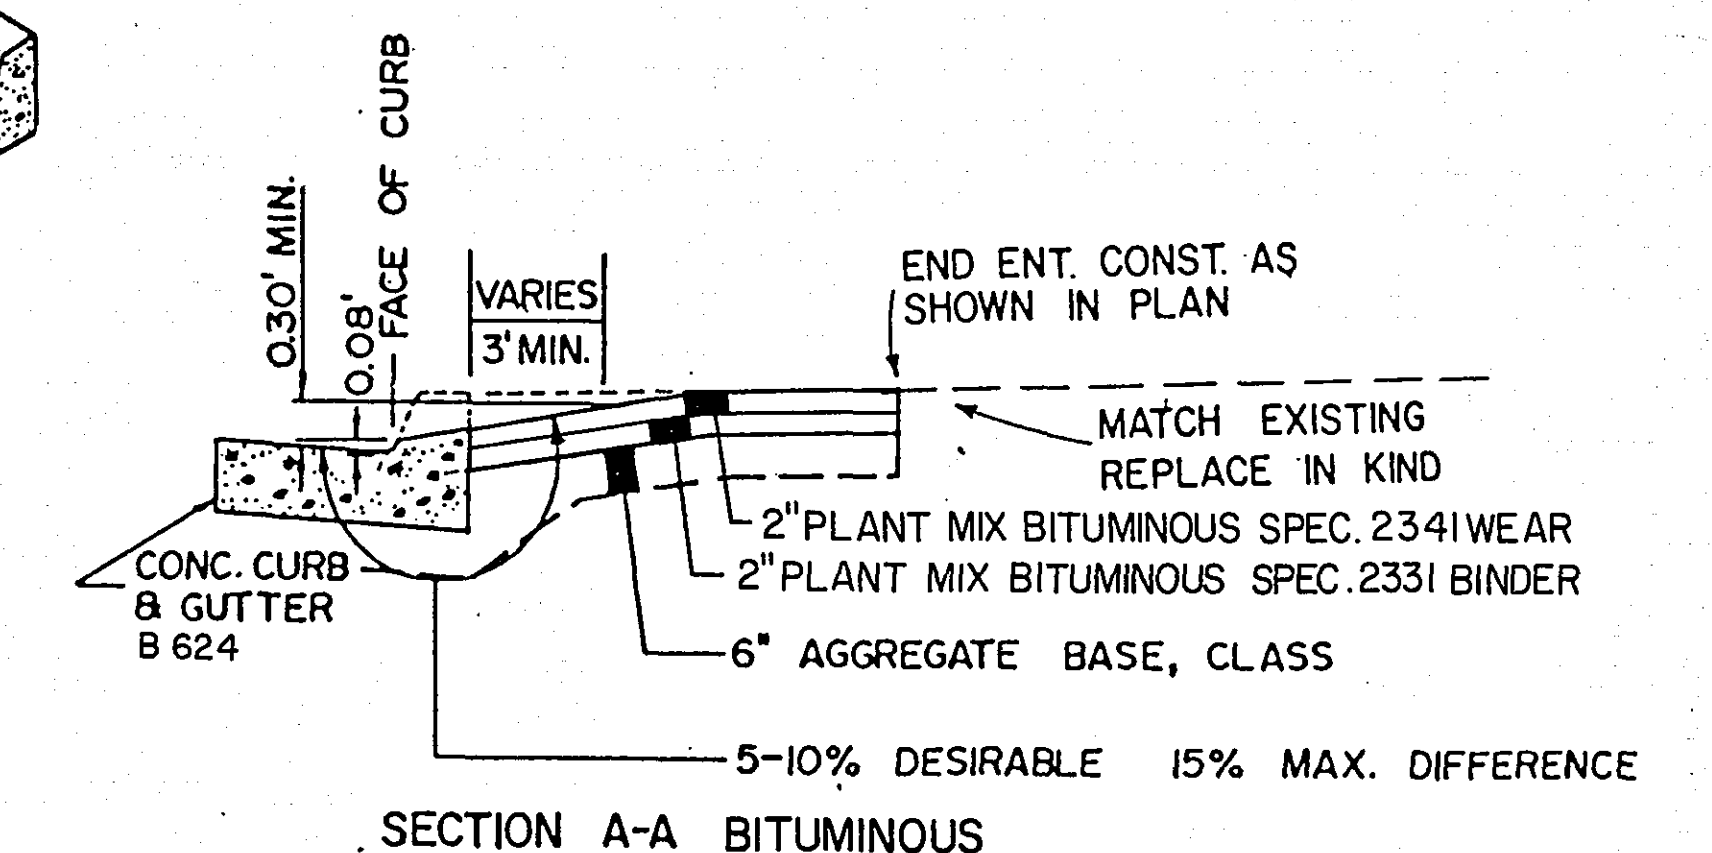

SECTION A-A BITUMINOUS

C.S.A.P. NO. 62-626-01, NO. 62-626-02, P-W-85-31

SURVEY:	CHECKED BY:	NO.	DATE	REVISIONS
DESIGN: D.H.				
DRAWN: G.N.				

SEEH

SHORT - ELLIOTT - HENDRICKSON, INC.
Saint Paul, Minnesota • Chippewa Falls, Wisconsin

RAMSEY COUNTY, MINNESOTA

TYPICAL SECTION & DETAILS

FILE NO.: 86068	4
DATE: 3-25-86	29

DRAINAGE CHART

STATION	LOCATION CONST. ℄					CONST HEIGHT LIN. FT.	CASTING ASSEMBLY	ELEVATION				ADJUST CASTING ASSEMBLY	RECONSTRUCT CATCH BASIN OR MANHOLE LIN. FT.	INSTALL CASTING ASSEMBLY	REMARKS
		NO.	DESIGN	TYPE	PROFILE			ORIGINAL GRATE OR RING	NEW GRATE OR RING	CB. or M.H. INVERT					
		EXISTING STRUCTURES													
2+47	38' LT	1	ST.	CB				48.42		45.32					REMOVE
2+53	23' RT	2	ST.	CB				49.54		46.34					REMOVE
2+76	℄	3	SAN.	MH				49.91	49.50	41.06	1				ADJUST
2+86	15' LT	4	ST.	MH				49.05±	49.12	42.75±	1				ADJUST
2+94	32' LT	5	ST.	CB				48.73		45.58					REMOVE
2+95	34' RT	6	ST.	CB				48.30		44.30					REMOVE
4+31	14' LT	7	ST.	MH				47.07	46.94	39.07	1				ADJUST
5+96	2' RT	8	SAN.	MH				48.00	47.28	39.30					REMOVE
5+96	24' RT	9	SAN.	MH				47.61	47.12	38.91	1				ADJUST
6+14	44' LT	10	ST.	CB				45.22		41.92					REMOVE
6+25	15' LT	11	ST.	MH				47.57	47.25	34.17	1				ADJUST
6+26	24' RT	12	ST.	CB				46.59		43.00					REMOVE
9+05	31' RT	13	ST.	CB				48.69		45.59					REMOVE
9+24	6' RT	14	SAN.	MH				48.93	48.66	40.83	1				ADJUST
9+28	20' LT	15	ST.	MH				48.30	48.41	33.40	1				ADJUST
9+43	32' RT	16	ST.	CB				48.22		44.67					REMOVE
11+66	43' LT	17	ST.	CB				44.72		41.90±					REMOVE
12+37	17' LT	18	ST.	CB				45.19		41.29					REMOVE
12+66	23' LT	19	SAN.	MH				45.03	45.32	35.93	1				ADJUST
12+85	16' LT	20	ST.	MH				45.27	44.70	32.07		6.2	1	(1)	
12+96	15' RT	21	ST.	CB				44.67		39.07					REMOVE
13+90	16' LT	22	ST.	CB				43.69		32.19					REMOVE
14+37	21' LT	23	SAN.	MH				44.01	44.39	27.16		6.1	1	(1)	
14+38	22' RT	24	SAN	MH				44.62	44.41	27.52	1				ADJUST
15+89	17' RT	25	ST.	CB				42.90		37.65					REMOVE
15+99	30' LT	26	ST.	MH				39.67±	40.02	31.47±	1				ADJUST
16+08	18' RT	27	SAN.	MH				43.54	42.98	28.04	1				ADJUST
16+37	15' RT	28	ST.	CB				42.67		40.07					REMOVE
21+98	15' RT	29	TEL.	MH				37.22	35.74						ADJUST BY OTHERS
22+21	45' LT	30	ST.	CB				35.77		32.37					REMOVE
22+30	30' LT	31	ST.	MH				36.42	36.22	27.52	1				ADJUST
22+57	46' LT	32	SAN.	MH				36.48	36.16		1				ADJUST
22+66	27' LT	33	ST.	MH				36.31	35.48	27.31					REMOVE
22+72	45' LT	34	ST.	CB				35.74		32.34					REMOVE
22+94	25' RT	35	ST.	MH				34.14		26.44					REMOVE
27+54	23' LT	36	SAN.	MH				43.49	43.13	34.54	1				ADJUST
27+69	31' LT	37	ST.	MH				43.22	43.43	36.72	1				ADJUST
27+84	13' RT	38	NSP	MH				44.39	43.95						ADJUST BY OTHERS
27+94	21' LT	39	ST.	CB				43.55		40.35					REMOVE
28+06	19' RT	40	ST.	MH				45.61±	44.97	38.81±	1				ADJUST, M.H. BURIED
30+13	24' LT	41	SAN.	MH				49.40±	48.91	37.60±	1				ADJUST, M.H. BURIED
31+80	24' LT	42	SAN.	MH				50.64	50.50	39.54	1				ADJUST
31+96	19' RT	43	ST.	MH				50.81	50.84	44.71	1				ADJUST
32+56	46' LT	44	ST.	CB				50.89	50.94	48.29	1				ADJUST
32+74	30' LT	45	SAN.	MH				51.79	52.25	40.39		5.8	1	(1)	
32+80	41' RT	46	ST.	CB				45.34		40.24					REMOVE, BULKHEAD TILE
32+84	47' LT	47	ST.	CB				51.20	51.46	47.90	1				ADJUST
32+96	14' RT	48	ST.	MH				53.78		46.58					REMOVE
33+05	21' LT	49	ST.	CB				52.56		46.71					REMOVE
33+10	23' LT	50	SAN.	MH				53.22	53.75	43.22		1.6	1	(2)	
35+84	15' RT	51	ST.	MH				62.47	61.05	54.57	1				ADJUST
35+85	21' LT	52	ST.	MH				62.02	61.07	56.02	1				ADJUST
36+24	18' LT	53	SAN.	MH				63.16	61.93	51.81		4.0	1	(3)	
37+33	47' LT	54	ST.	CB				65.35		61.85					O.K. LEAVE AS IS
37+48	18' LT	55	SAN.	MH				65.68	64.41	56.43		5.1	1	(4)	
37+63	43' LT	56	ST.	CB				65.38		59.88					O.K. LEAVE AS IS
37+81	15' RT	57	ST.	MH				66.26		58.06					
37+87	22' LT	58	ST.	CB				65.30	64.95	59.80		1		(5)	

DRAINAGE CHART

STATION	LOCATION CONST. E	NO.	DESIGN	TYPE	CONST. HEIGHT LIN. FT.	CASTING ASSEMBLY	ELEVATION				ADJUST CASTING ASSEMBLY	RECONSTRUCT CATCH BASIN OR MANHOLE LIN. FT.	INSTALL CASTING ASSEMBLY	REMARKS
							PROFILE	ORIGINAL GRATE OR RING	NEW GRATE OR RING	C.B. or M.H. INVERT				
		EXISTING STRUCTURES												
38+23	36' RT	58A	ST.	CB			62.19							O.K. LEAVE AS IS
40+13	19' LT	59	SAN.	MH			71.40±	69.77	62.30±	1				ADJUST
40+66	50' LT	60	ST.	CB			71.63		68.33					O.K. LEAVE AS IS
40+80	19' LT	61	SAN.	MH			72.96	71.60	63.96		4.4	1	⑥	
40+95	50' LT	62	ST.	CB			71.96		67.96					O.K. LEAVE AS IS
41+13	15' RT	63	ST.	MH			73.79		67.34					REMOVE
41+20	21' LT	64	ST.	CB			73.05		67.75					REMOVE
44+08	22' LT	65	SAN.	MH			78.90	78.35	69.08		6.0	1	⑦	
45+79	15' RT	66	ST.	MH			79.68		74.68					REMOVE
45+79	21' LT	67	ST.	CB			79.09±		75.19±					REMOVE
46+00	20' RT	68	ST.	CB			78.48		74.98					REMOVE
48+95	18' LT	69	NWB	MH										O.K. LEAVE AS IS

- REMOVE CONE, PLACE 1'-4" M.H. SECTION, REPLACE CONE
- REMOVE TOPSLAB, PLACE 1'-4" M.H. SECTION, REPLACE CONE
- REMOVE CONE, PLACE 3' M.H. SECTION, INSTALL TYPE B M.H. TOP SLAB
- REMOVE CONE & 2' M.H. SECTION, REPLACE CONE
- REMOVE TOPSLAB, INSTALL TYPE B. C. B. TOPSLAB
- REMOVE CONE AND 1' SECTION, REPLACE CONE
- REMOVE CONE AND PLACE 1' SECTION, REPLACE CONE

REMOVAL CHART

STATION	LOCATION CONST. E.	CONCRETE DRIVEWAY S.Y.	RC, C.M.P. & V.C.P. PIPE L.F.	MANHOLE EACH	CATCH BASIN EACH	CONCRETE CURB & GUTTER L.F.
2+47	38' LT		44		1	
2+53	23' RT		44		1	
2+94	32' LT		20		1	
2+95	34' RT		50		1	
4+47	21' LT	32				
6+14	44' LT		30		1	
6+26	24' RT		38		1	
7+30	25' LT	11				
7+33	23' RT	23				
7+78	23' LT	62				
9+05	31' RT		39		1	
9+43	32' RT		53		1	
10+60	16' LT	32				
11+04	17' RT	42				
12+37	17' LT		48		1	
12+82	42' RT	16				
12+96	15' LT		33		1	
13+90	16' LT				1	
15+89	17' RT		49		1	
16+37	15' RT		52		1	
20+63	25' LT		25			
22+10	31' LT		41			
22+20	41' RT		82			
22+21	45' LT		18		1	
22+66	27' LT		54	1		
22+72	45' LT		20		1	
22+94	25' RT		69	1		
27+94	21' LT		26		1	
28+89	25' LT	23.3				
30+77	33' LT	11				
32+96	14' RT		38	1		
33+05	21' LT		34		1	
33+72	27' LT		20			
34+45	26' LT		20			
35+02	26' LT		22			
37+34	44' LT					3
37+65	41' LT					4
37+81	15' RT			1		
40+66	41' LT					8
40+96	41' LT					8
41+13	15' RT			1		
41+20	21' LT		2		1	
45+79	21' LT		2		1	
45+79	15' RT			1		
46+00	20' RT		21		1	
TOTAL		252.3	944	26		23

C.S.A.P. NO.62-626-01, NO.62-626-02, P-W-85-31

SURVEY:	CHECKED BY:	NO.	DATE	REVISIONS
DESIGN: D.H.				
DRAWN: D.H.				

I HEREBY CERTIFY THAT THIS PLAN WAS PREPARED BY ME OR UNDER MY DIRECT SUPERVISION AND THAT I AM A FULLY LICENSED PROFESSIONAL ENGINEER UNDER THE LAWS OF THE STATE OF MINNESOTA.

DATE: 3-25-86 REG. NO. 14410

SEH

SHORT - ELLIOTT - HENDRICKSON, INC.
Saint Paul, Minnesota • Chippewa Falls, Wisconsin


RAMSEY COUNTY, MINNESOTA

DRAINAGE CHART

FILE NO.:	5
DATE:	3-25-86
	29

DRAINAGE CHART


STATION	LOCATION	NO.	TYPE	DESIGN	CONST HEIGHT LIN. FT	CASTING ASSEMBLY	ELEVATION				ADJUST CASTING ASSEMBLY	FURNISH AND INST REINFORCED CONCRETE PIPE						APRON	CLASS	DRAINS TO		REMARKS		
							PROFILE	ORIGINAL GRATE OR RING	NEW GRATE OR RING	CB. or M.H. INVERT		12"	15"	18"	21"	24"				STRUCTURE NO.	INVERT EL.			
NEW STRUCTURES																								
2+20	19'LT	70	CB	RC-2	3.5	A			49.99	46.49				45							71	46.04		
2+56.5	46'RT	71	CB	RC-2	4.24	A			50.28	46.04				31							73	45.73		
2+59.5	46'LT	72	CB	RC-2	4.01	A			49.48	45.47				40							4	44.91		
2+87.5	46'RT	73	CB	RC-2	4.33	A			50.06	45.73				63							4	44.55		
2+90.5	46'LT	74	CB	RC-2	3.50	A			49.28	45.78				31							72	45.47		
4+93.70	19.5'LT	75	CB	LP-4	4.78	D			46.99	42.21				8							76	42.13		
4+93.70	13.5'LT	76	MH	B	8.19	B			46.65	38.46±													BUILD OVER EXIST.	
4+93.70	19.5'RT	77	CB	LP-4	4.78	D			46.99	42.21				35							76	41.80		
5+81	46'LT	77B	CB	RC-2	3.5	A			45.40	41.90				37							77C	41.59	BUILD OVER EXIST.	
5+96	2'RT	77A	MH	P	7.98	B			47.28	39.30											11	41.25		
6+12	46'LT	77C	CB	RC-2	3.81	A			45.40	41.59				34							11	43.10		
6+44	19'LT	78	CB	RC-2	3.88	A			47.18	43.30				20							78	43.30		
6+44	19'RT	79	CB	RC-2	3.50	A			47.18	43.68				38							81	44.45		
9+05.5	49'LT	80	CB	LP-4	4.66	D			49.35	44.69				24							15	43.38		
9+28	49'RT	81	MH	B	5.0	B			49.20	44.20					68						81	44.20	STUB	
9+28	65'RT		STUB							44.36					16						81	44.45		
9+44.5	49'RT	82	CB	LP-4	4.57	D			49.20	44.63				21							84	41.35		
11+66	44'LT	83	CB	H	2.82	C			44.72	41.90				55							20	39.00		
12+13	19'LT	84	CB	B	3.88	A			45.23	41.35				71							84	41.35		
12+13	19'RT	85	CB	RC-2	3.50	A			45.23	41.73				38							20	40.00		
12+49.4	46'LT	86	CB	B	3.43	A			46.24	42.81				72							88	41.51		
12+49.4	46'RT	87	CB	RC-2	3.50	A			45.32	41.82				31							20	41.20		
12+80.6	46'LT	88	CB	RC-2	3.65	A			45.16	41.51				31							86	42.81		
12+80.6	70'RT	89	CB	RC-2	3.50	A			46.70	43.20				39									BUILD OVER EXIST.	
13+90	16'LT	90	MH	C	11.57	B			43.76	32.19±											26	36.99		
15+57	19'LT	91	CB	RC-2	4.57	A			43.09	38.52				45							91	38.52		
15+57	19'RT	92	CB	RC-2	4.19	A			43.09	38.90				38							94	39.80		
15+93.5	46'RT	93	CB	RC-2	3.50	A			43.61	40.11				31							26	37.08		
16+24.5	46'RT	94	CB	RC-2	3.85	A			43.65	39.80				80							98A	36.05		
19+00	19'LT	95	CB	B	4.38	A			41.38	37.00				49							95	37.00		
19+00	19'RT	96	CB	RC-2	4.00	A			41.38	37.38				38							98	38.44		
19+21	36'RT	97	CB	RC-2	3.63	A			42.35	38.72				28							98A	36.57		
19+49	36'LT	98	CB	RC-2	3.78	A			42.22	38.44				17							99	31.12		
19+49	19'LT	98A	MH	B	4.87	B			40.92	36.05				254							31	30.63		
22+03	19'LT	99	CB	B	4.38	A			35.50	31.12				49							99	31.12		
22+03	19'RT	100	CB	RC-2	4.00	A			35.50	31.50				38							104	26.68		
22+19	42'RT	101	APRON						28.54												31	31.22		
22+27	44'LT	101B	CB	H	5.44	C			35.00	31.56				15		84								
22+41.25	46'LT	102	CB	RC-2	4.36	A			35.77	31.41				19									BUILD OVER EXIST.	
22+66	27'LT	103A	MH	B	8.17	B			35.48	27.31													BUILD OVER EXIST.	
22+72.25	46'LT	103	CB	RC-2	4.36	A			35.57	31.21				21							103A	31.00		
23+01	31'RT	104	MH	SPEC.	8.80	B			35.28	26.44					82						31	27.52		
23+26.17	20.21LT	105	CB	LP-4	5.69	D			34.99	29.30				60							103A	28.70		
23+26.17	18.81RT	106	CB	LP-4	4.20	D			35.01	30.81				39							105	29.64		
24+32	44'LT	107	APRON						30.40					110							105	29.30		
28+00	23'LT	108	CB	RC-2	4.01	A			44.01	40.00				35							37	39.34		
28+06	15'LT	109	CB	RC-2	4.00	A			44.16	40.16				4							4	40.12		
31+50	62'RT	109A	CB	H	7.7	C			47.7±	40.0±													BUILD OVER EXIST.	
32+84	47'LT	47	CB	EXIST.	2.95				51.20	48.25				40							111	47.85		
32+96	15'RT	110	CB	C	5.81	A			52.39	46.58													BUILD OVER EXIST.	
33+02	12'LT	111	MH	B	4.90	A			52.75	47.85				27							110	47.58		
33+18	23'LT	112	CB	RC-2	3.98	A			52.97	48.99				18							111	48.79		
37+81	15'RT	113	CB	C	6.97	A			65.03	58.06													BUILD OVER EXIST.	
41+13	15'RT	114	CB	C	5.35	A			72.69	67.34													BUILD OVER EXIST.	
41+18	23'LT	115	CB	B	4.98	A			72.74	67.76±				4							114	67.37		
45+79	15'RT	116	CB	C	5.10	A			79.78	74.68													BUILD OVER EXIST.	
45+79	23'LT	117	CB	RC-2	4.38	A			79.61	75.23±				2							116	74.68		
46+00	41'RT	118	APRON						79.00					38							15"	116	75.20	
48+55	55'RT																						R&R R.C.APRON ADD 16'-21"	
TOTAL														1880	166	94								

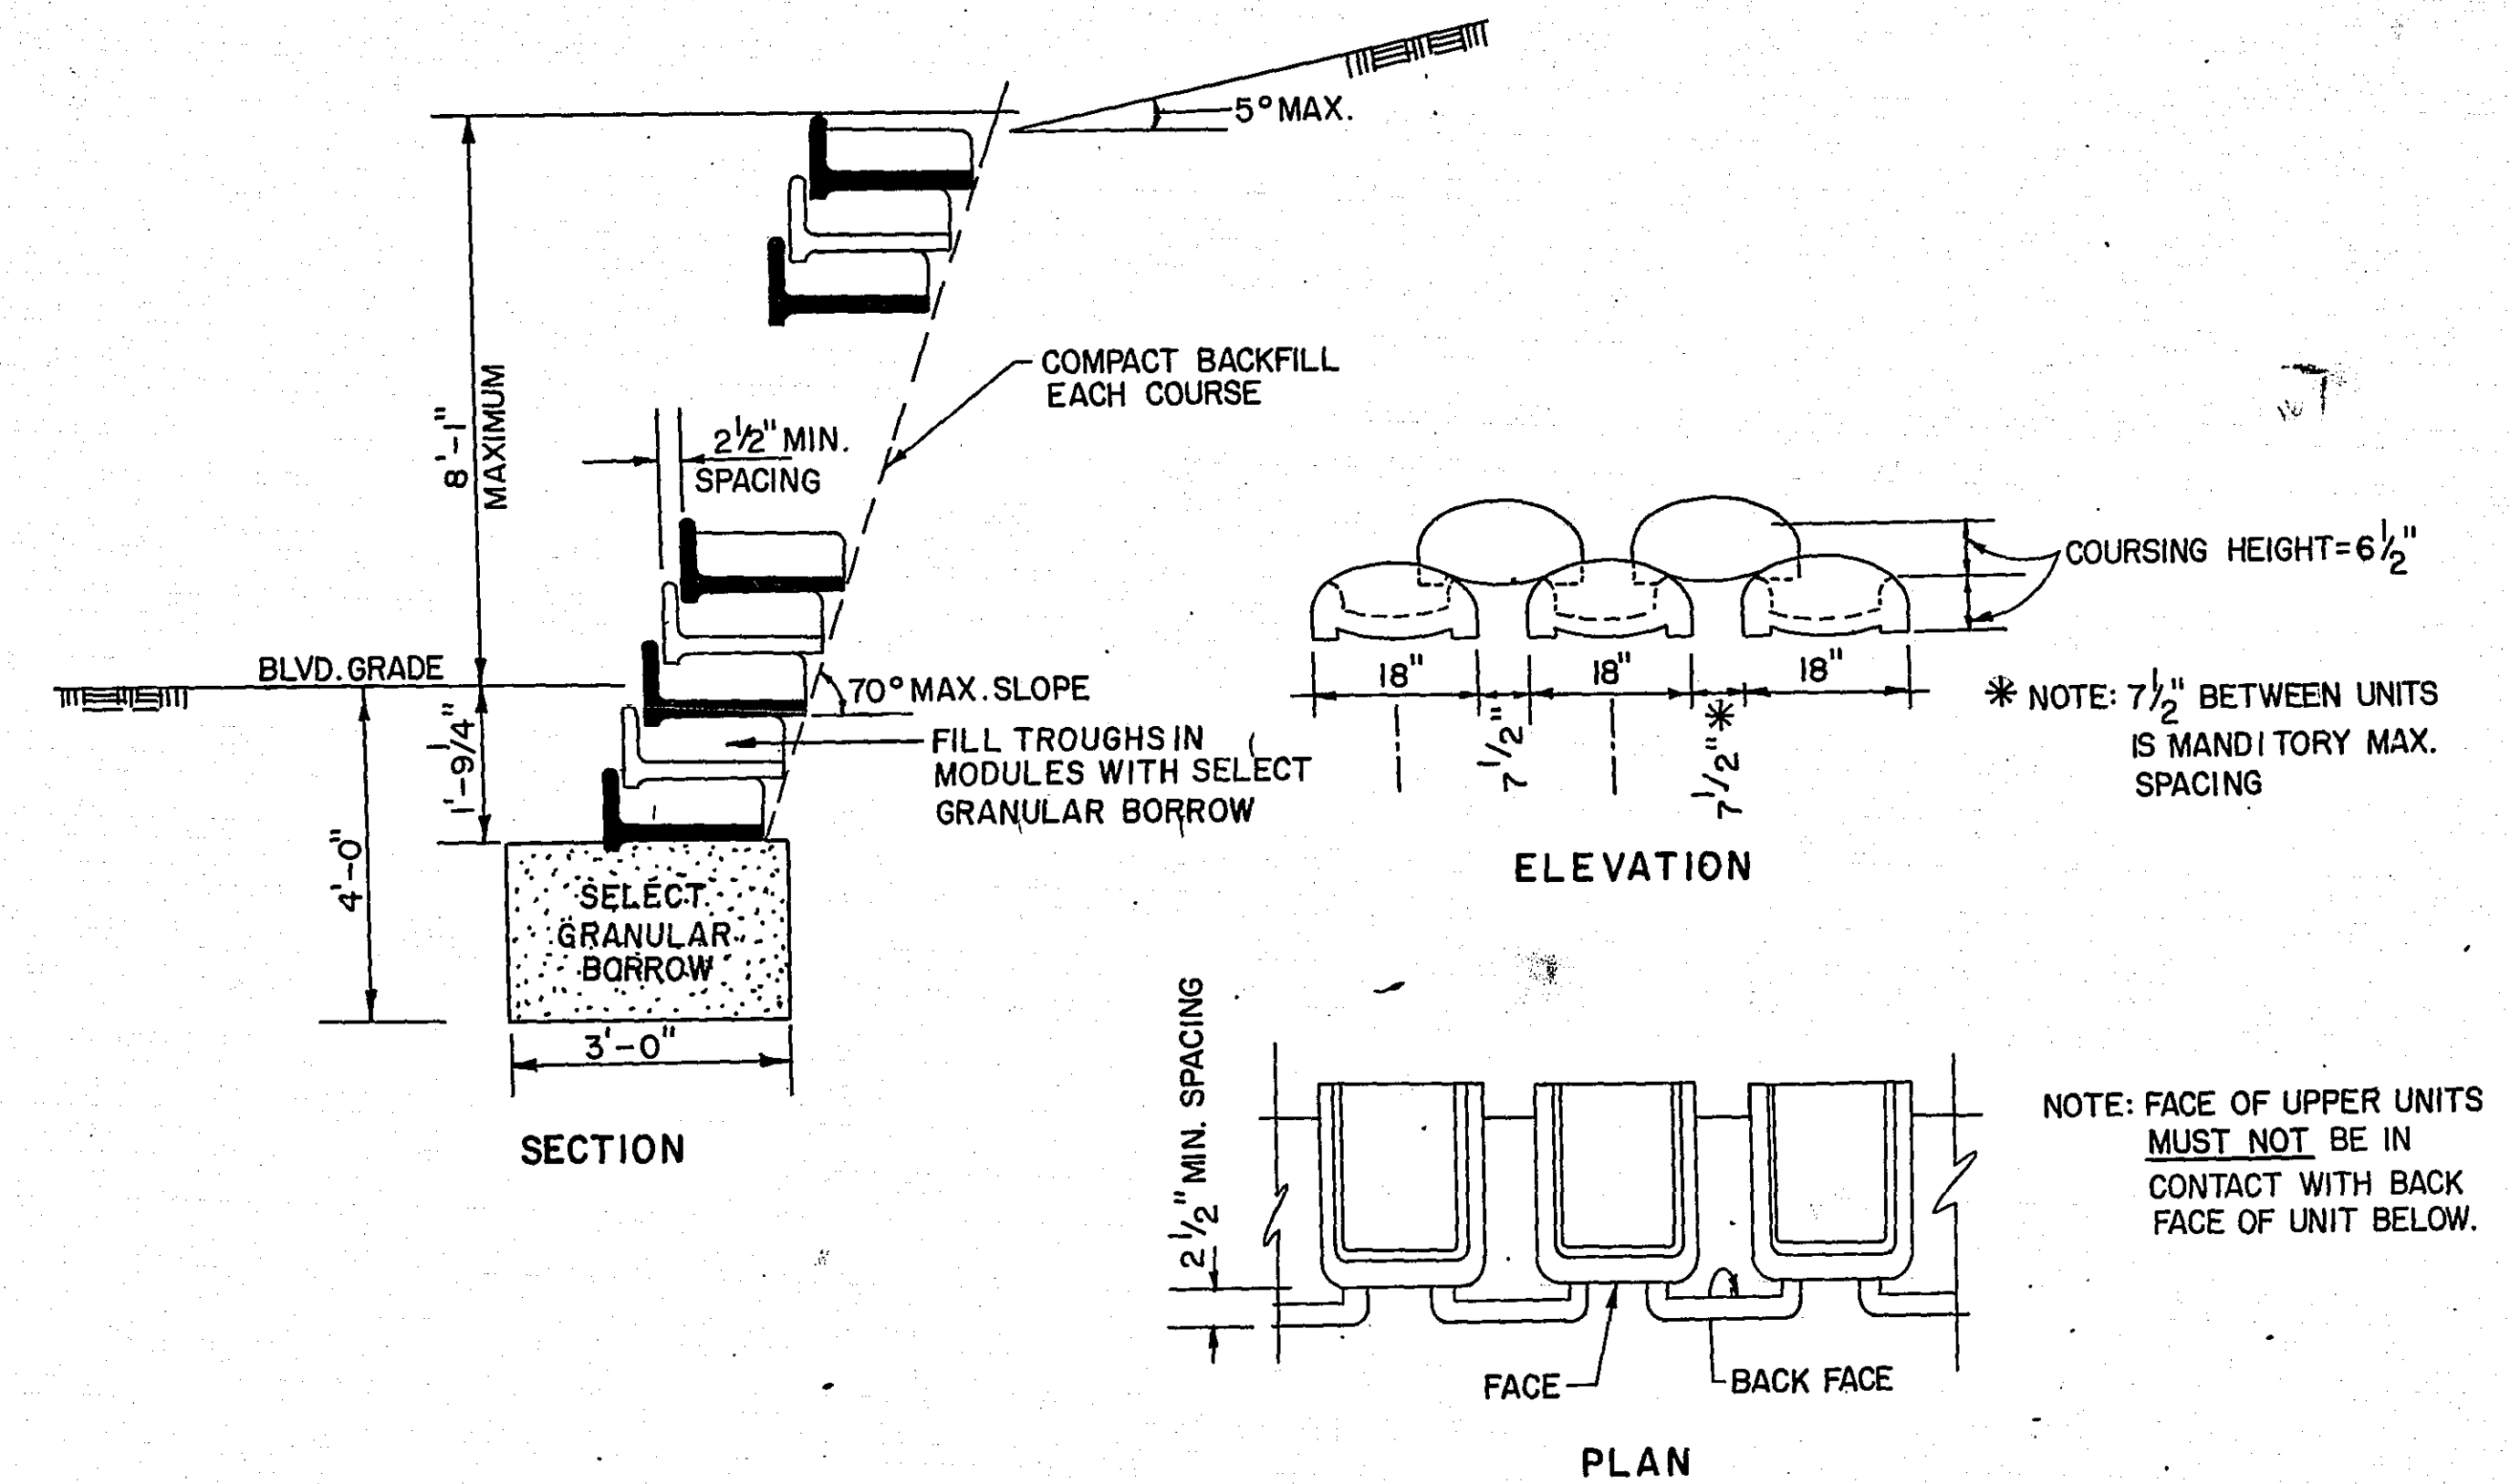

CONCRETE BLOCK RETAINING WALL

The following Standard Plates, approved by the FEDERAL HIGHWAY ADMINISTRATION, shall apply on this project.

MN/DOT STANDARD PLATES	
PLATE NO.	DESCRIPTION
0004 A	SPECIFICATION REFERENCE TO STANDARD PLATES
3000 K	REINFORCED CONCRETE PIPE
3006 D	GASKET JOINT FOR REINFORCED CONCRETE PIPE
3100 F	CONCRETE APRON FOR REINFORCED CONCRETE PIPE
3133 B	RIPRAP AT R.C.P. OUTLETS
3145 D	CONCRETE PIPE TIES
4000 I	MANHOLE OR CATCH BASIN
4005 K	MANHOLE OR CATCH BASIN
4006 K	MANHOLE OR CATCH BASIN
4011 D	PRECAST CONCRETE BASE
4021 C	PRECAST CURB OPENING CATCH BASIN
4101 C	RING CASTING FOR MANHOLE OR CATCH BASIN
4180 H	MANHOLE OR CATCH BASIN STEP
7036 C	PEDESTRIAN CURB RAMP
7100 F	CONCRETE CURB AND GUTTERS
8000 I	STANDARD BARRICADES
9322 I	CHAIN LINK FENCE
4020 E	MANHOLE OR CATCH BASIN

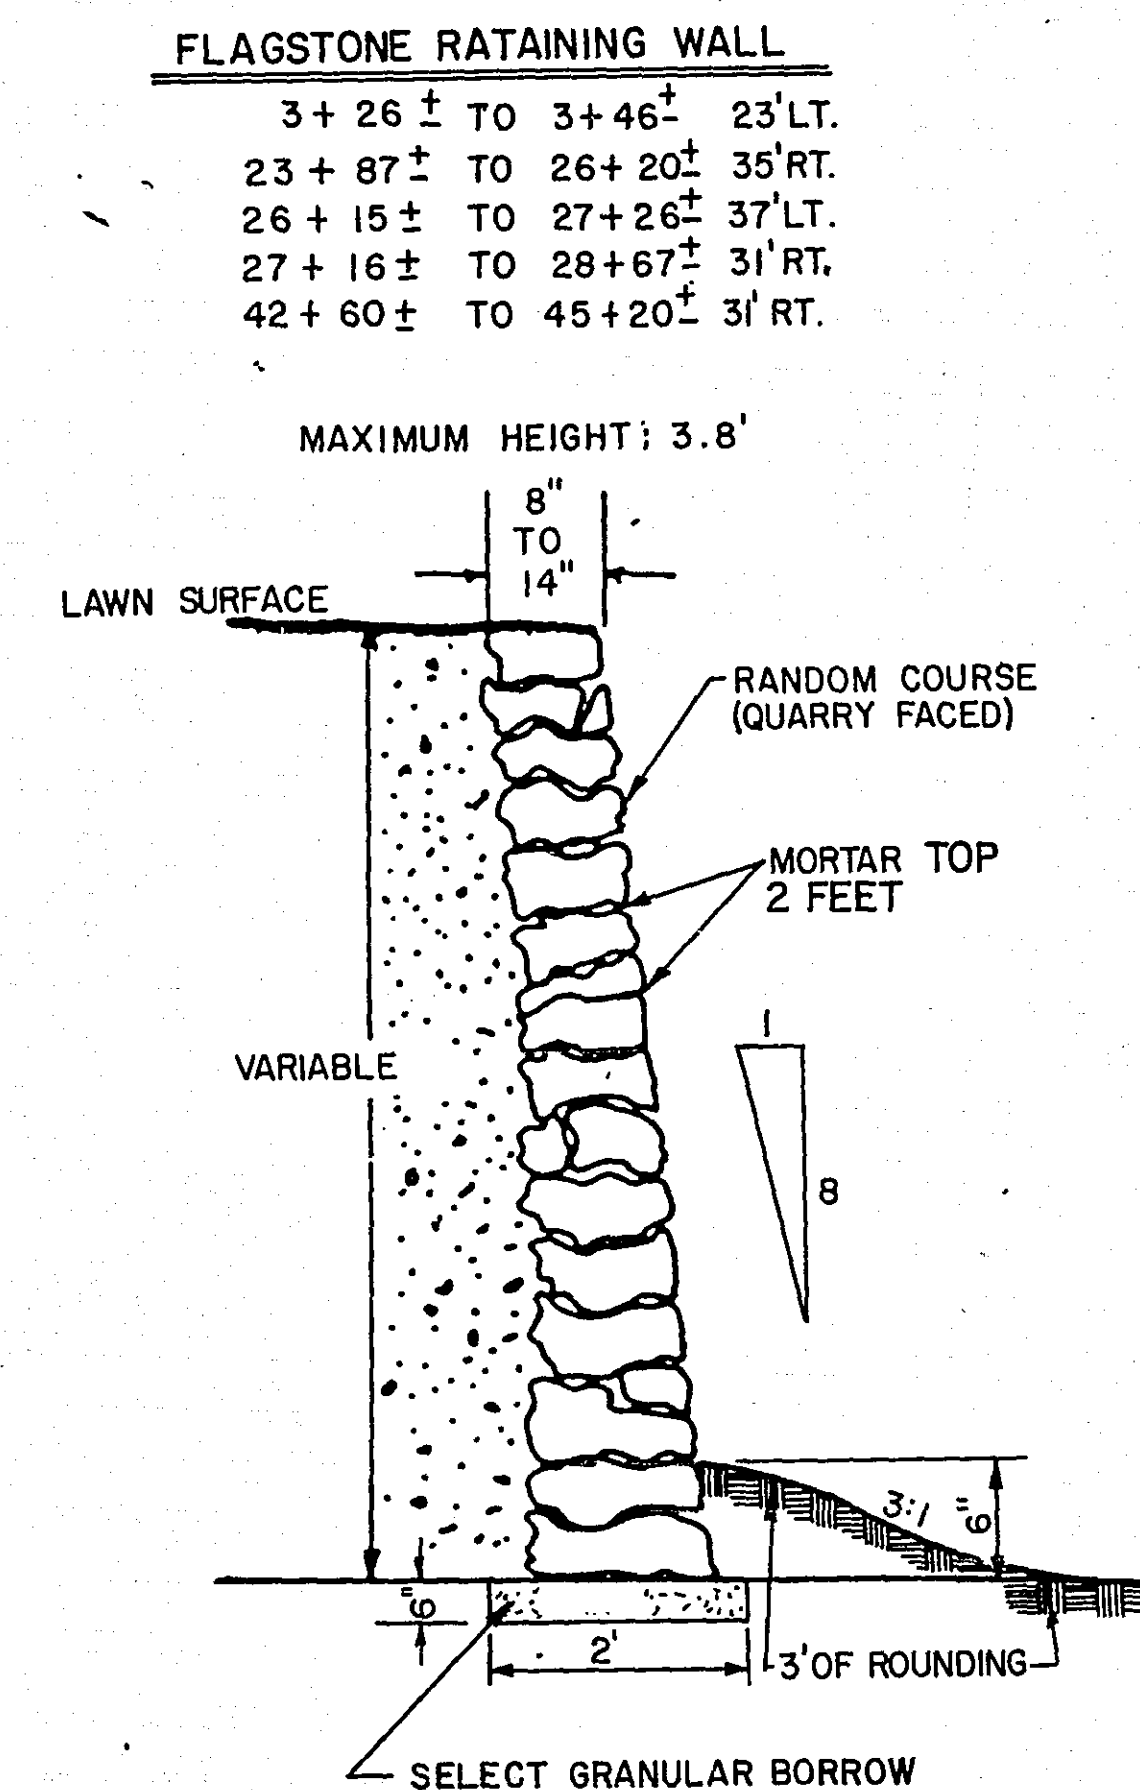

- CASTINGS
- A = NEENAH INLET FRAME, GRATE & CURB BOX NO. R-3067-C OR EQUAL.
 - B = NEENAH MANHOLE FRAME AND COVER NO. R-1733 OR EQUAL.
 - C = NEENAH CATCH BASIN FRAME R-2502-B, GRATE TYPE D OR EQUAL.
 - D = RING CASTING MHD 790-2, COVER CASTING NO. 712 (INCLUDE WITH STRUCTURE, NOT SEPARATE PAY ITEM).

SURVEY: _____ CHECKED BY: _____ NO. _____ DATE _____ REVISIONS _____

DESIGN: DH. _____

DRAWN: DH. _____

1. I HEREBY CERTIFY THAT THIS PLAN WAS PREPARED BY ME OR UNDER MY DIRECT SUPERVISION AND THAT I AM A DULY REGISTERED PROFESSIONAL ENGINEER UNDER THE LAWS OF THE STATE OF MINNESOTA.

DATE: 3-25-86 P.D. NO. 14410

SEH SHORT - ELLIOTT - HENDRICKSON, INC.
Saint Paul, Minnesota • Chippewa Falls, Wisconsin


RAMSEY COUNTY, MINNESOTA

C.S.A.P. NO.62-626-01, NO.62-626-02, P-W-85-31 27/77

FILE NO.: 86068 6


DATE: 3-25-86 29

CATCH BASIN DESIGN RC-2

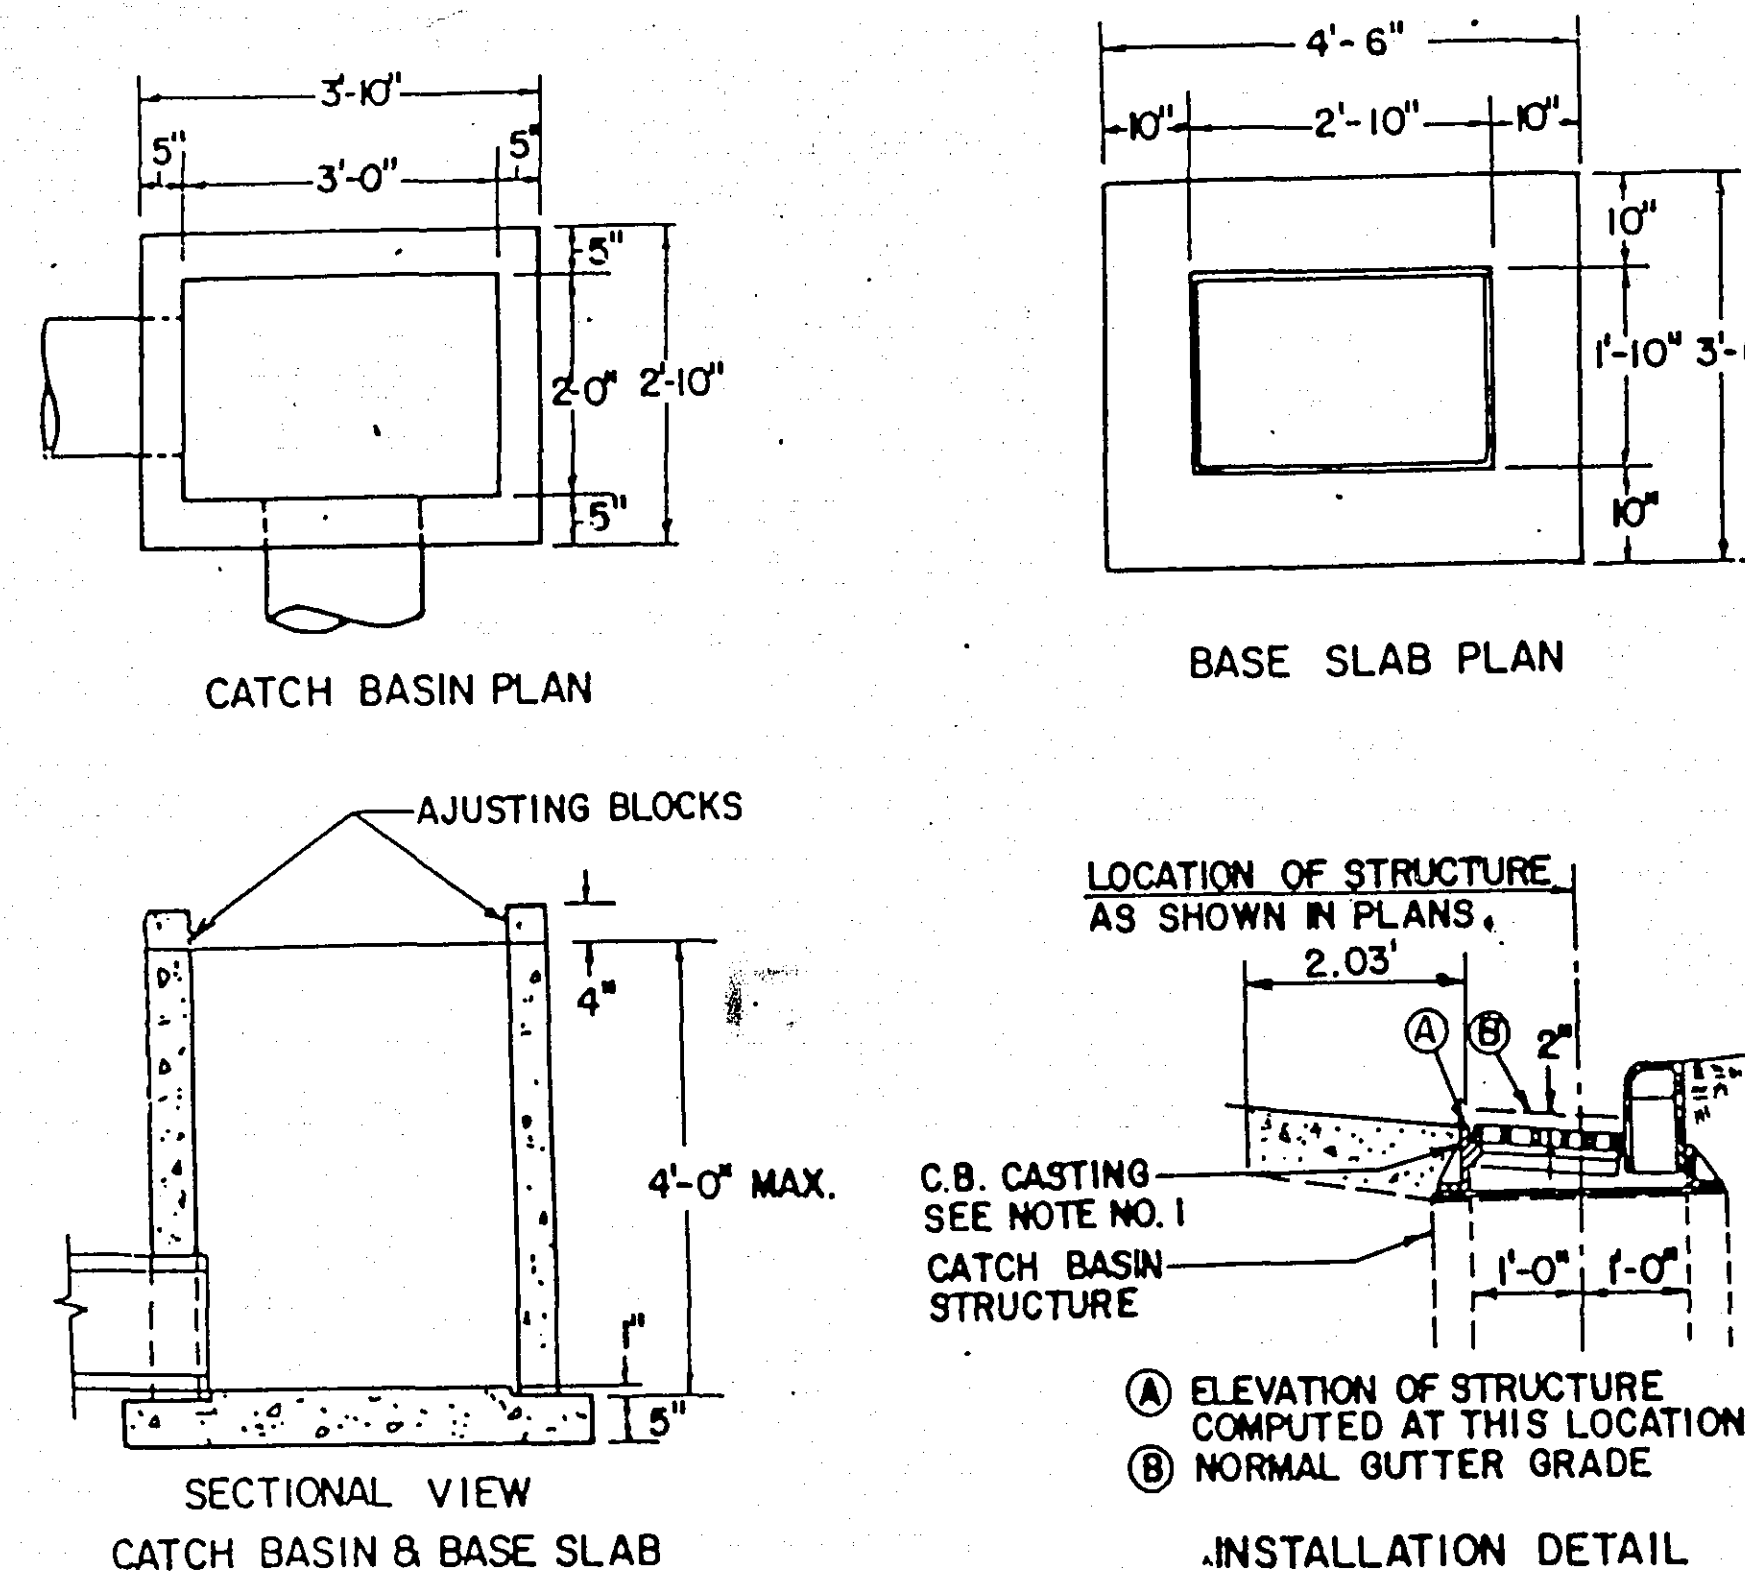


- NOTES**
1. CASTING ASSEMBLY—SEE DETAIL THIS SHEET.
 2. PIPE CUT-OUTS TO BE LOCATED WHERE REQUIRED.
 3. ALTERNATE CAST-IN-PLACE BASE SLAB CAN BE USED.
 4. INSTALL AS PER MN/DOT STD. PLATE NO. 7111 & DETAIL THIS SHEET.
 5. REINFORCING: SINGLE LINE STEEL WIRE FABRIC.
WALL = W35 x W3.0 HAVING AN AREA OF NOT LESS THAN .21 SQ. IN. PER FOOT OF HEIGHT.
BASE = W4.0 x W4.0 HAVING AN AREA OF NOT LESS THAN .16 SQ. IN. PER FOOT OF HEIGHT.
 6. ALTERNATE CONSTRUCTION—THIS CATCH BASIN MAY BE CONSTRUCTED OF BLOCK OR BRICK CONFORMING TO THE REQUIREMENTS OF MN/DOT SPEC. 2506 AND AS DIRECTED BY THE ENGINEER.

CURB OPENING CATCH BASIN—DESIGN RC-2 & DESIGN B & C

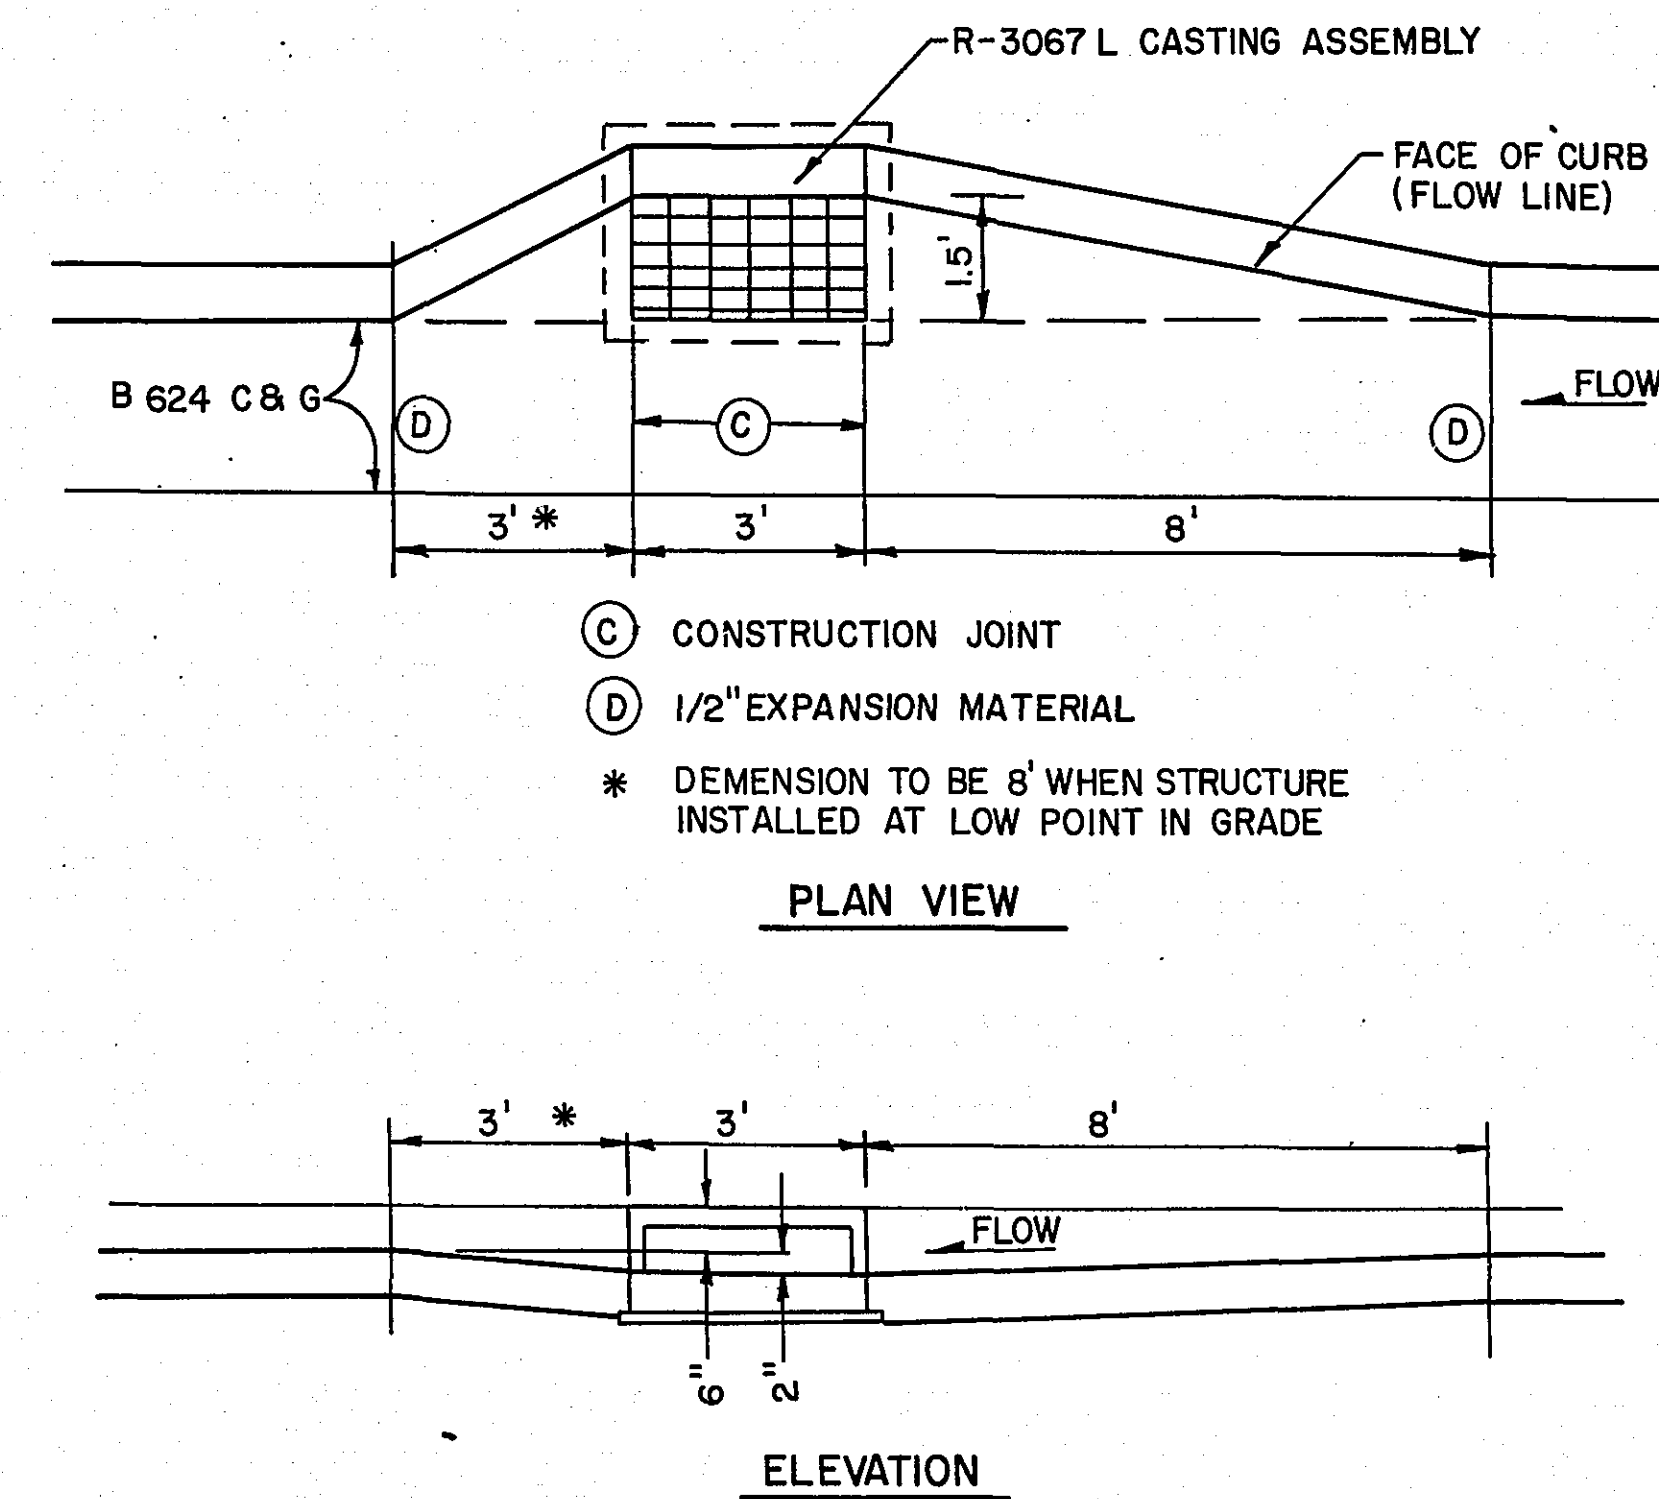



GATEWELL MANHOLE SPECIAL DESIGN 104

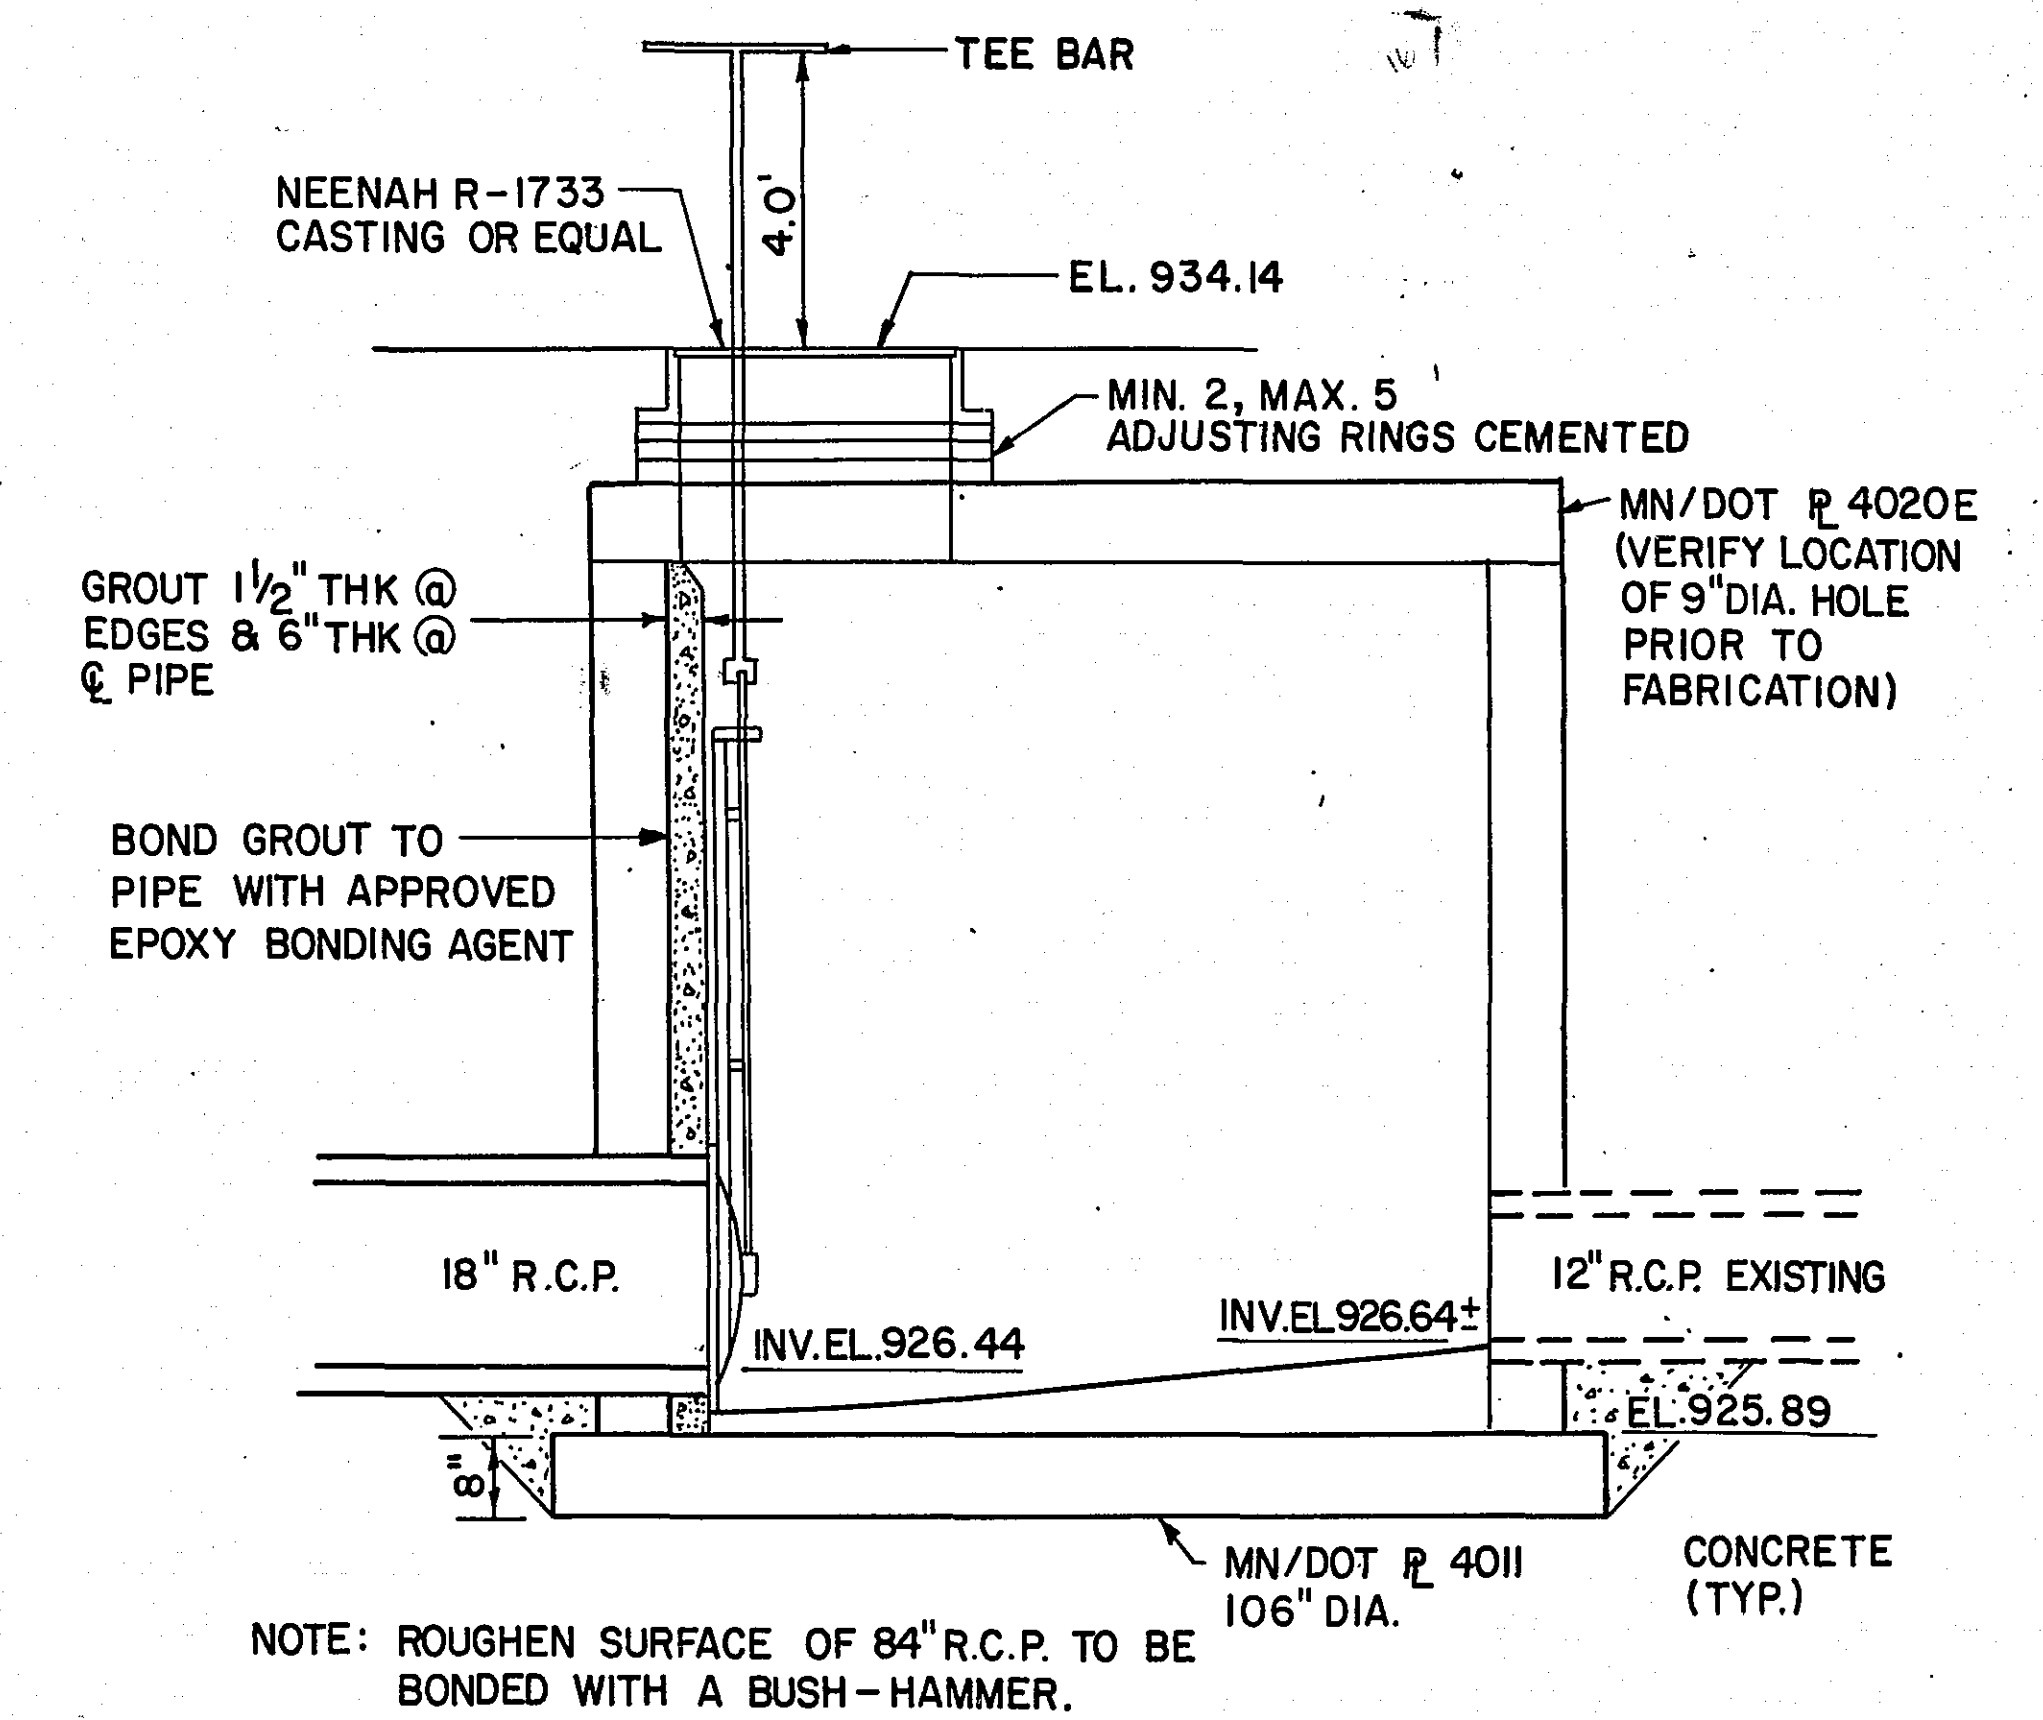


CASTING ASSEMBLY FOR DESIGN RC-2 CATCH BASIN

NOTES:

1. MATERIALS: CAST GRAY IRON, CLASS 30, MN/DOT SPEC. REFERENCE 3321
2. CURB BOX HEIGHT SHALL BE ADJUSTABLE 6" TO 9"
3. SEE CATCH BASIN—DESIGN RC-2 DETAIL FOR CASTING INSTALLATION DETAIL.

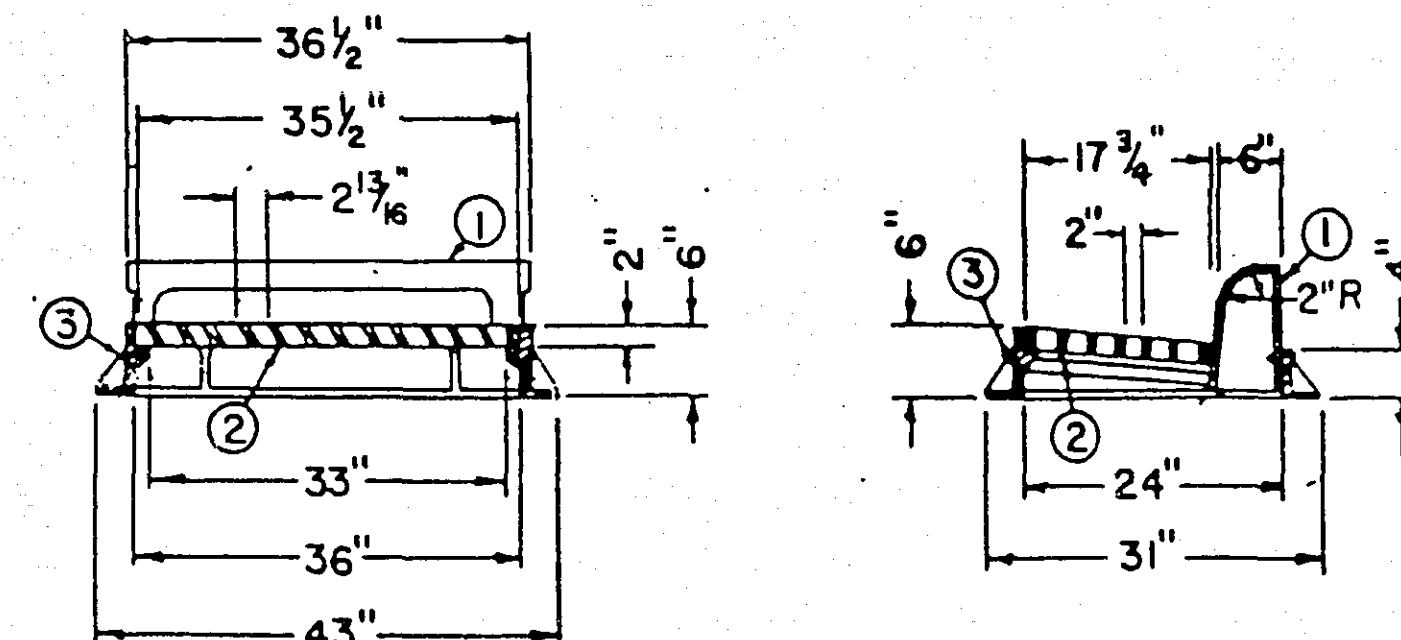
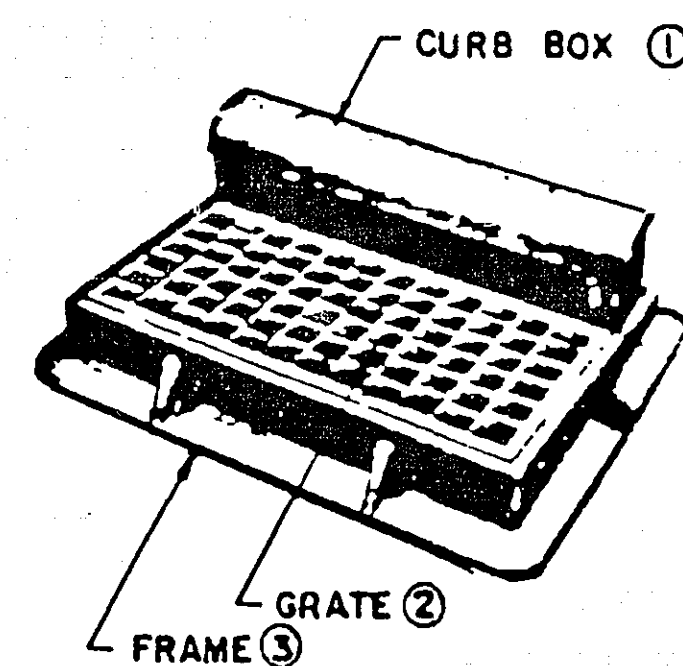


CURB OPENING CATCH BASIN—DESIGN LP INSTALLATION DETAIL

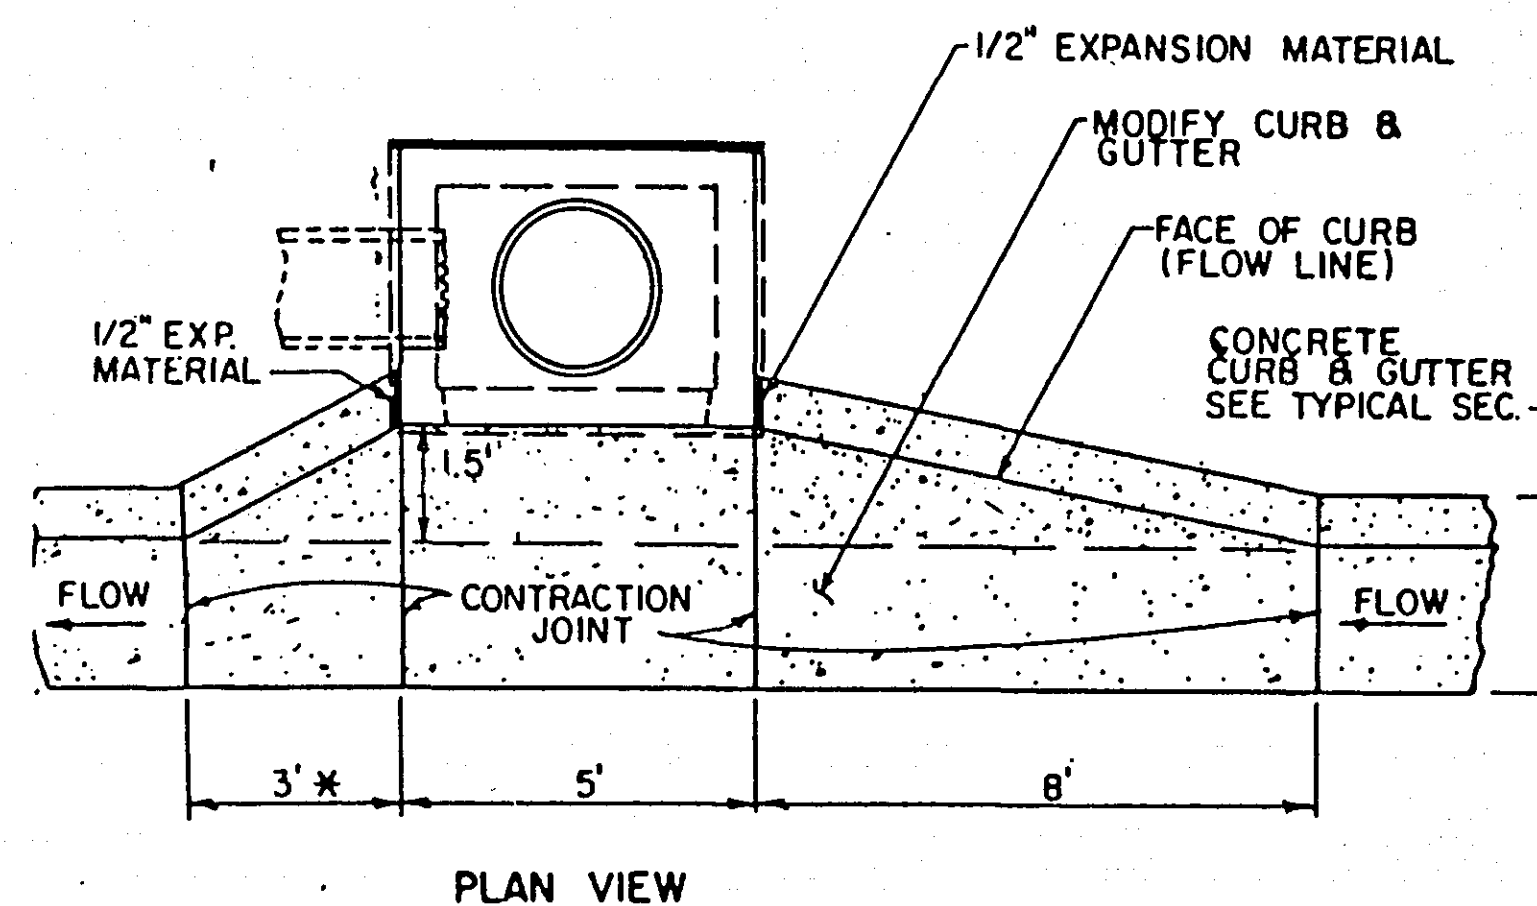

- NOTES:**
1. * DIMENSION SHALL BE 8' WHEN STRUCTURE INSTALLED AT LOW POINT IN GRADE
 2. CATCH BASIN—DESIGN LP—SEE MN/DOT STD. PL. NO. 4021C.
 3. TOP OF CATCH BASIN SHALL BE INSTALLED AT SAME SLOPE AS BLVD. GRADES AND TOP OF CURB GRADE EACH SIDE OF STRUCTURE.
 4. ELEVATION OF STRUCTURE IS COMPUTED AT LOCATION SHOWN IN SEC. A-A AT 1/2" OF C.B. OPENING.

		STRUCTURE SCHEDULE											
		MANHOLE OR CATCH BASIN DESIGN											
DIMENSIONS		B	B-1	C	C-1	D	D-1	E	E-1	F	F-1	G	G-1
P	48"	48"	60"	60"	72"	72"	84"	84"	96"	96"	102"	102"	102"
K	6"	11"	7"	18"	8"	25"	9"	32"	9"	38.5"	9"	41.5"	41.5"
T	6"	6"	8"	8"	8"	8"	8"	8"	8"	8"	8"	8"	8"
W	58"	58"	72"	72"	86"	86"	100"	100"	113"	113"	119"	119"	119"
H	27"	36"	27"	36"	27"	36"	27"	36"	27"	36"	27"	36"	36"
OPENING		ECC.	CON.	ECC.	CON.	ECC.	CON.	ECC.	CON.	ECC.	CON.	ECC.	CON.

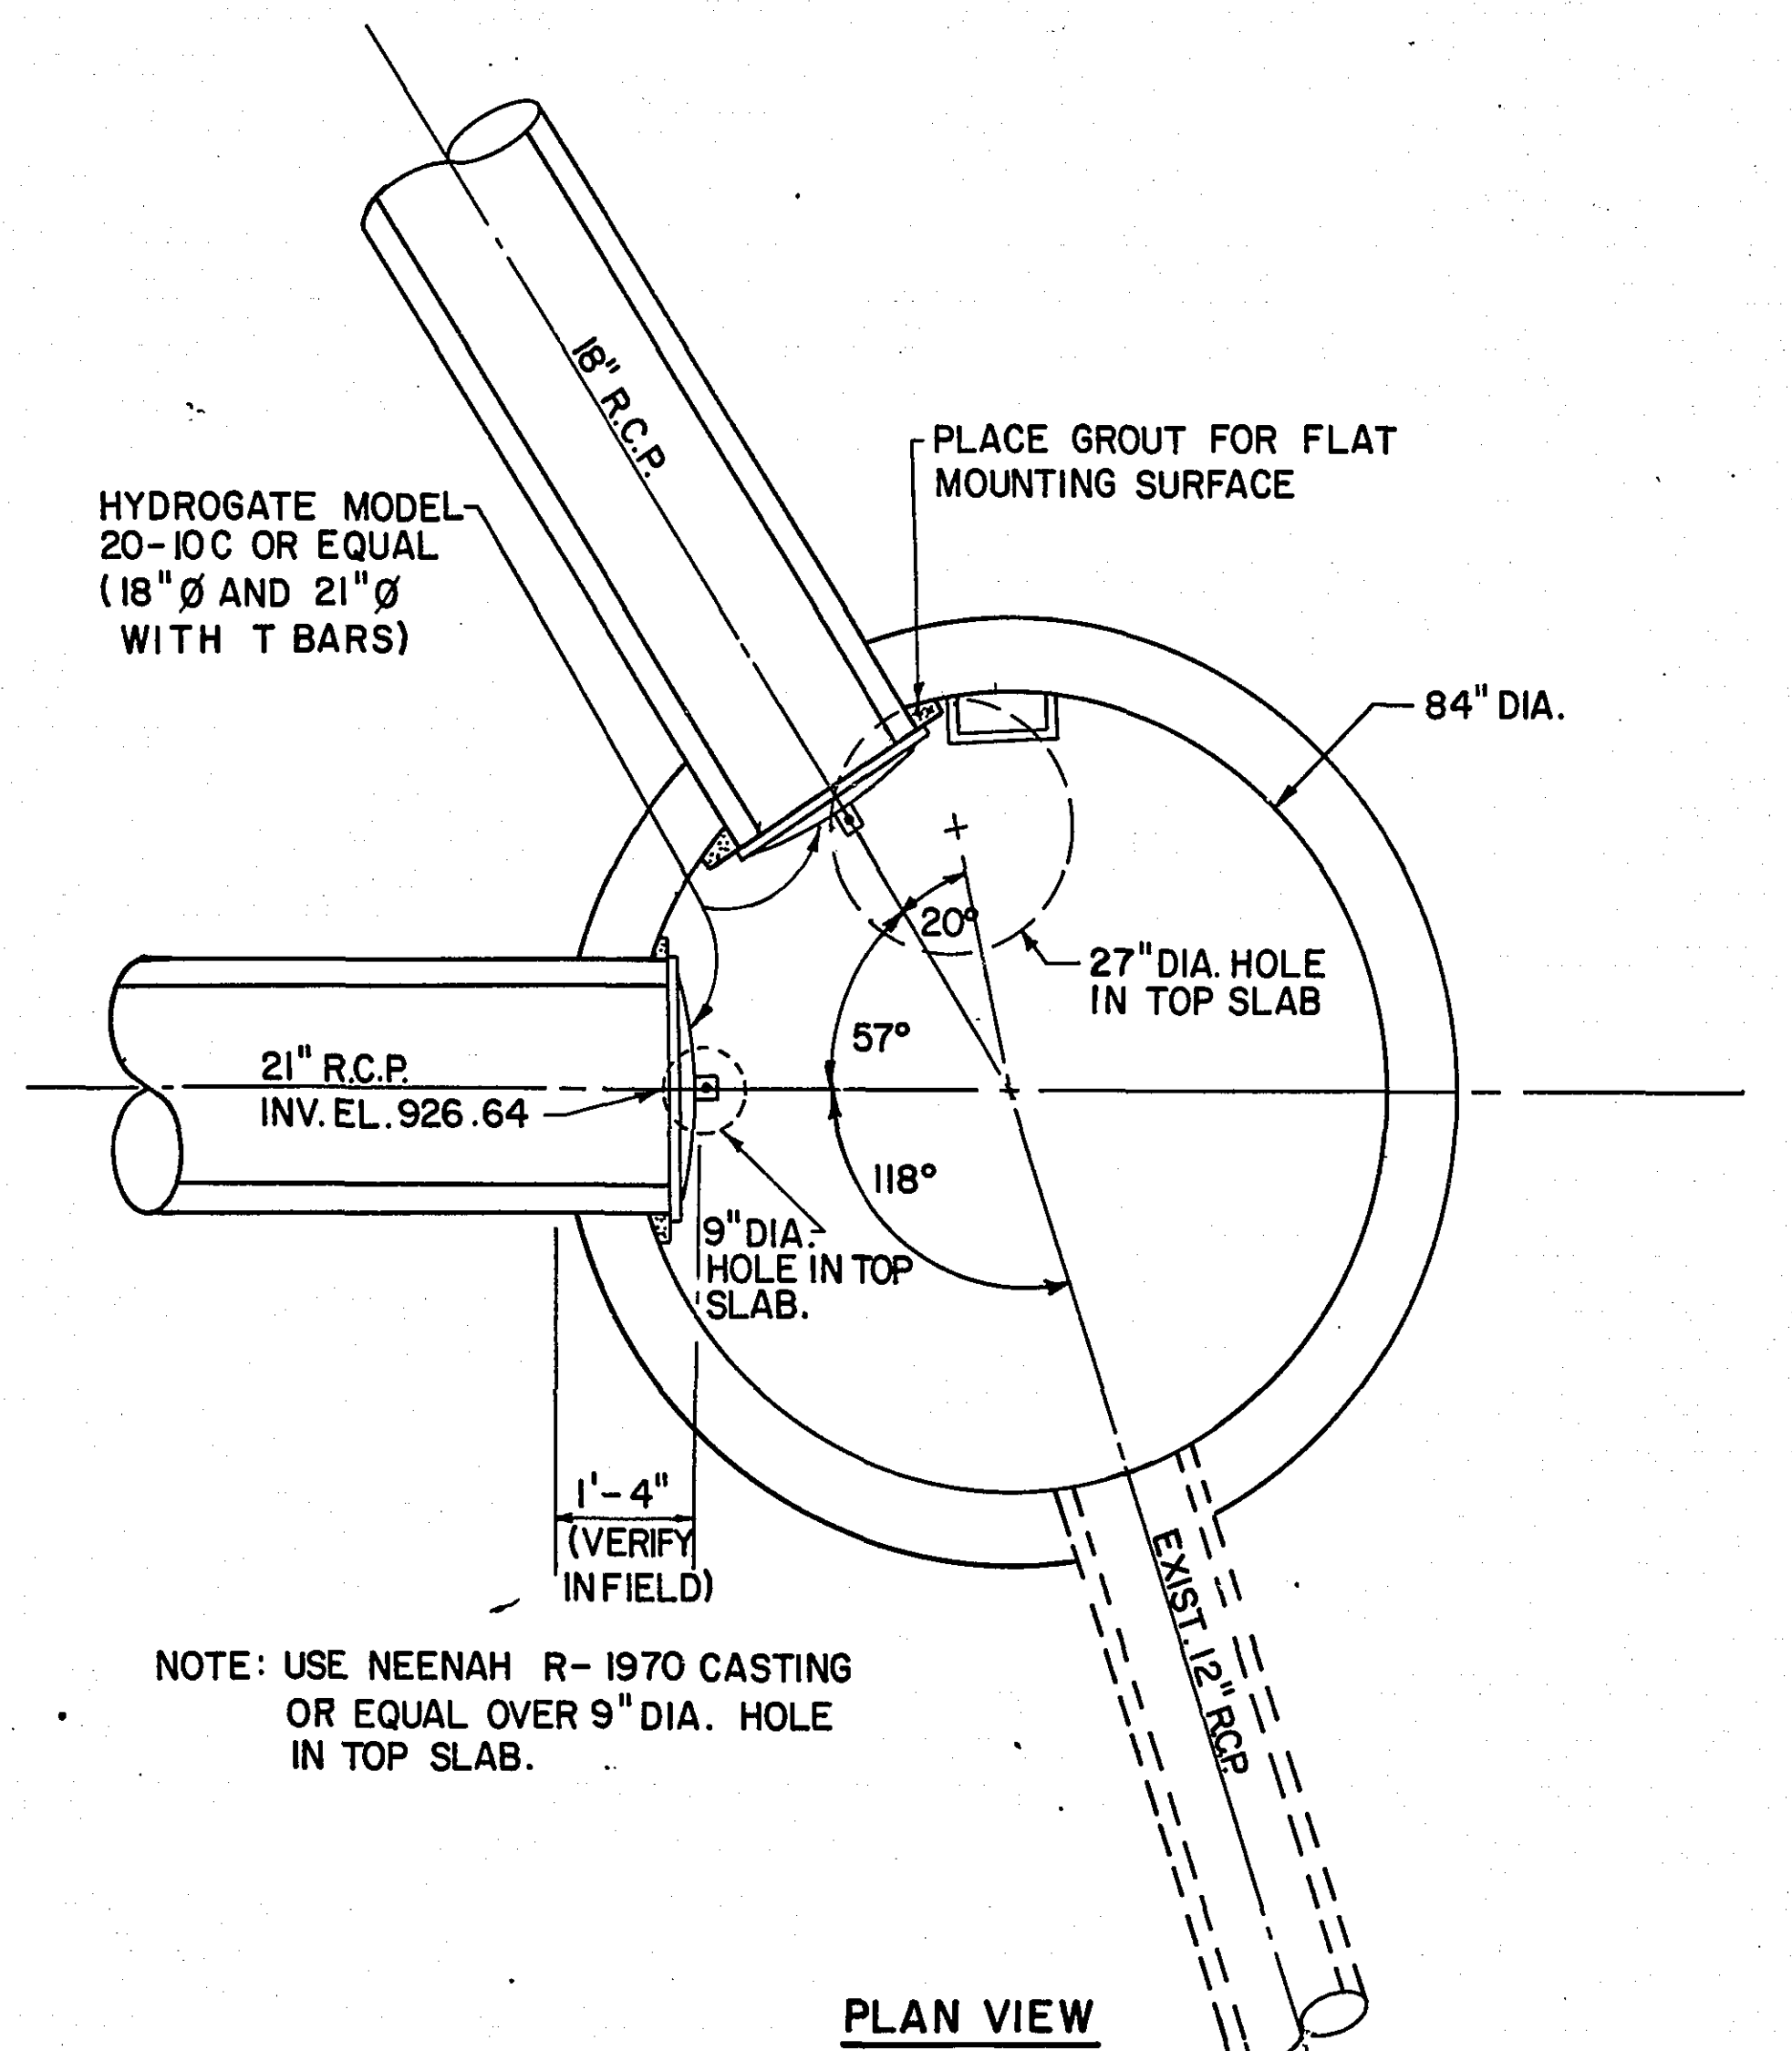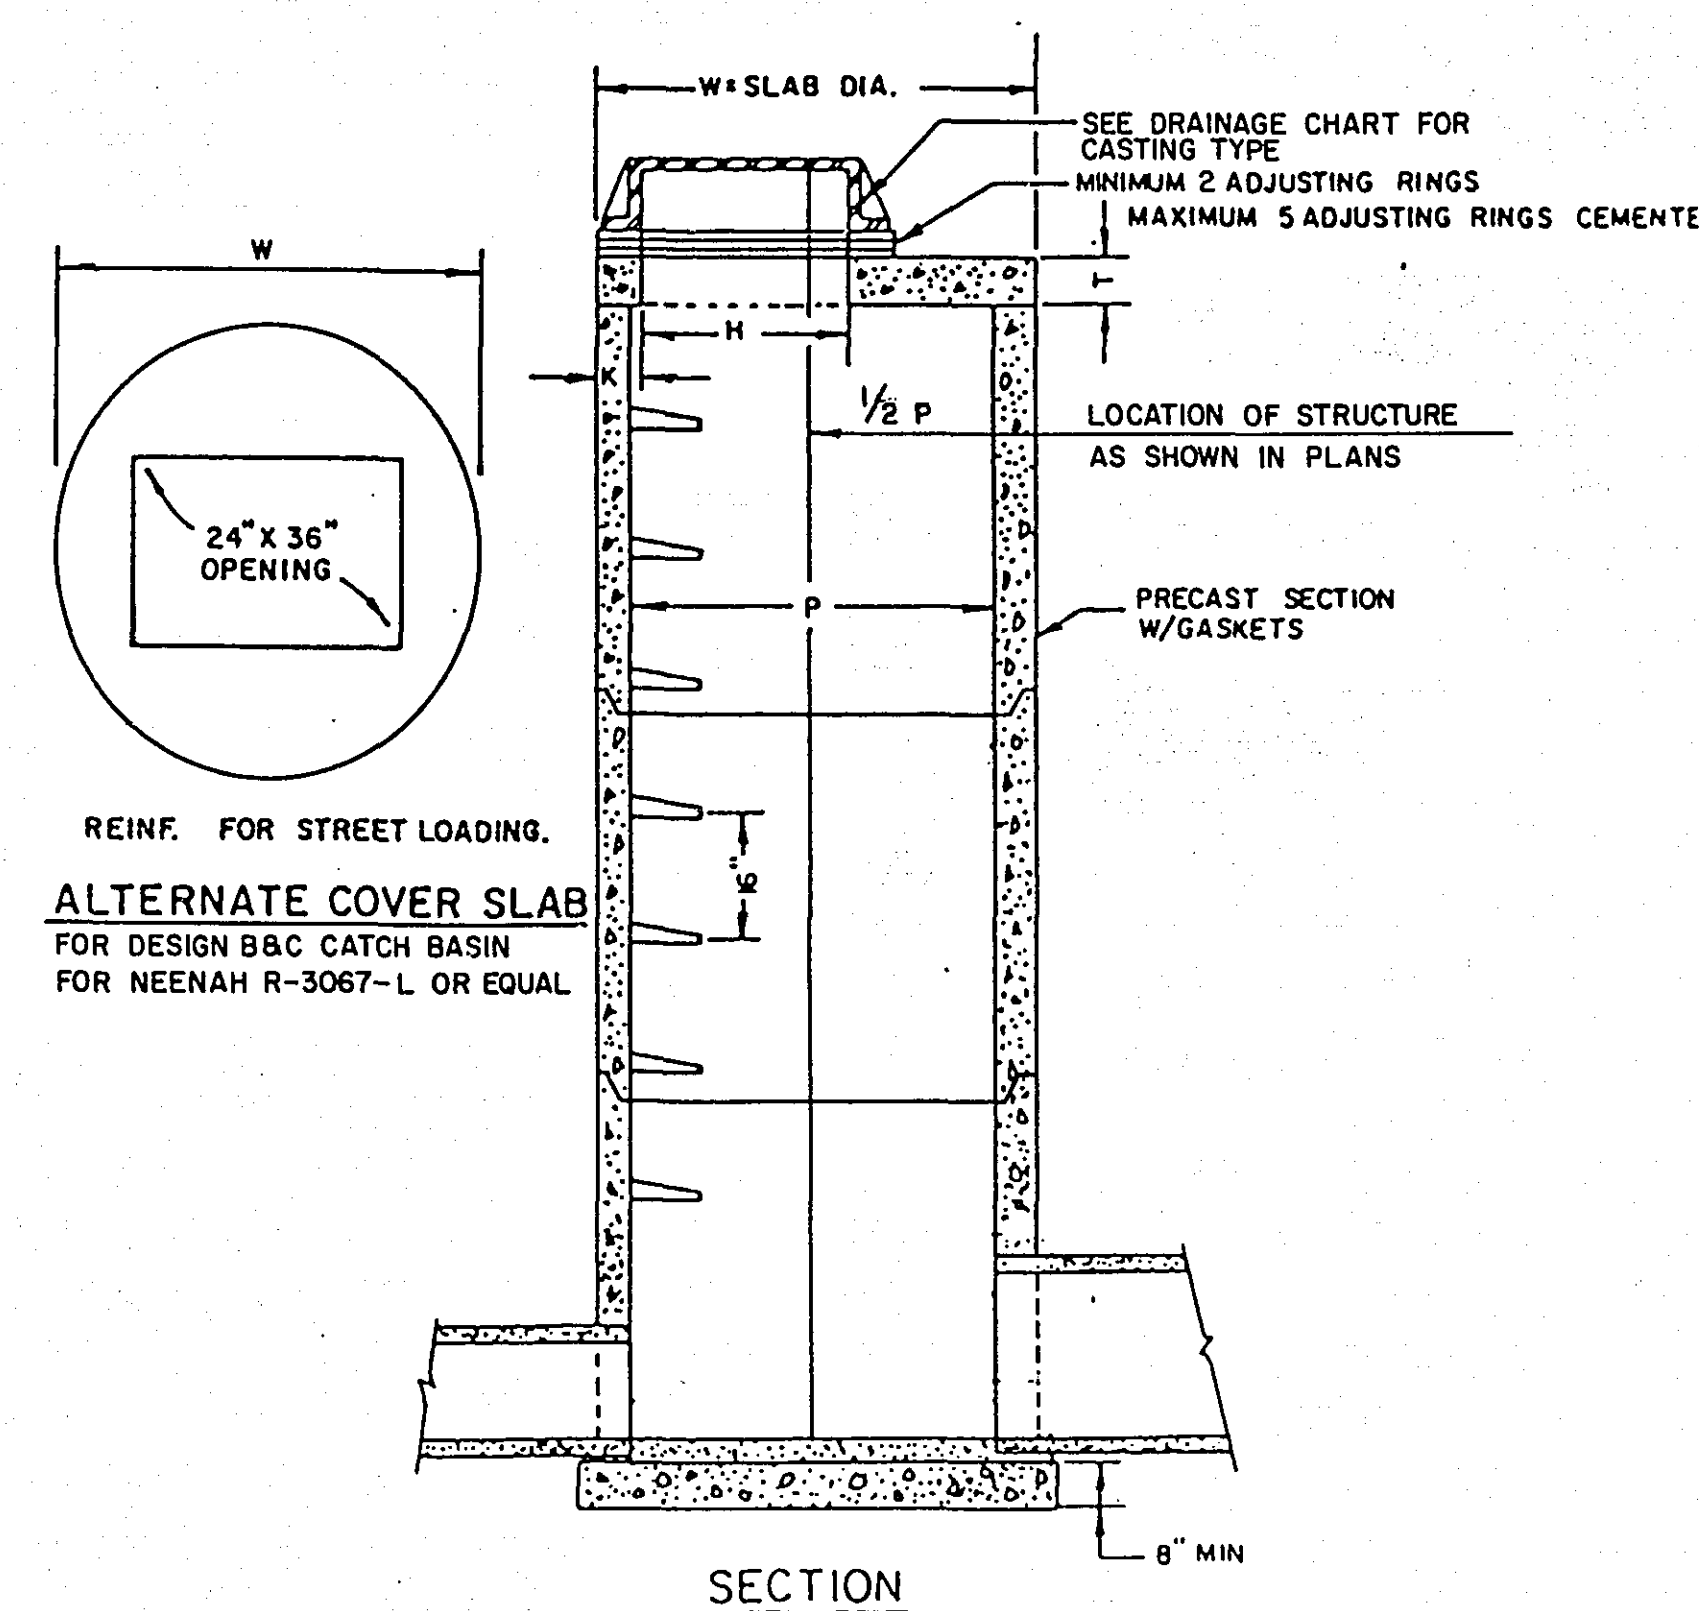

STORM SEWER M.H. OR C.B. DESIGN "B"(B-1) THRU "G"(G-1)

C.S.A.P. NO.62-626-01, NO.62-626-02, P-W-85-31

SURVEY:	CHECKED BY:	NO.	DATE	REVISIONS
DESIGN: D.H.				
DRAWN: G.N.				



SHORT-ELLIOTT-HENDRICKSON, INC.
Saint Paul, Minnesota • Chippewa Falls, Wisconsin

RAMSEY COUNTY, MINNESOTA

DETAILS

FILE NO.:	7
86068	
DATE:	3-25-26
29	

27" DIA HOLE IN TOP SLAB

12" DIA. HOLE IN BASE SLAB

84" DIA.

5

1

2

3

4

1

5

PLAN VIEW

ELEVATION

Diagram illustrating the elevation view of the valve assembly. The assembly is shown installed in a trench, with the ground surface labeled "FINISHED GRADE". The components labeled include:

- VALVE BOX ASSEMBLY
- 2" OPERATING NUT (OPEN LEFT)
- PIPE SIZE VARIES
- CONCRETE BLOCK

A vertical dimension line on the left indicates a "MINIMUM 7' COVER" from the finished grade to the top of the valve box assembly.

HYDRANT, PACER MODEL WB-67 OR EQUAL

3'

5-SIDED CAP NUT

16 3/4"

FINISHED GRADE

6" GATE VALVE & BOX

STAND PIPE

2" OPERATING NUT (OPEN LEFT)

MINIMUM 7" COVER

MINIMUM 2 LAYERS TAR PAPER

1 CU. YD. CRUSHED ROCK

CONCRETE THRUST BLOCK AND BASE

CONCRETE BLOCK

6" D.I.P.

TEE

WATERMAIN SIZE VARIES

NAIL ALL CORNERS SECURELY
 W/ALUMINUM OR GALVANIZED NAILS
 MAKE TOP IN TWO PIECES

NOTE: SEE SPECIFICATION FOR
 ALTERNATE ROCK/PLASTIC
 DRAINAGE OPTION.

2'-0"
 2'-0"
 1'-0"
 2'-0"
 2'-0"
 TOP VIEW

HYDRANT	HOLE DIA.
DOUBLE PUMPER NOZZLE	11"
SINGLE "	10"
MUELLER (MOD. NO. A-24015)	9"
WATEROUS (MOD. NO. WB-59)	8 1/2"

1/2"
 0'-1 1/2"
 2' X 12"
 FRONT VIEW

1/2"
 0'-1 1/2"
 2' X 12"
 SIDE VIEW

EL. 942.69

NEENAH R-1733 CASTING OR EQUAL

MIN. 2, MAX. 5 ADJUSTING RINGS CEMENTED

MN/DOT PLATE NO. 4020E

84" DIA.

ALUM. STEPS
16" O.C.

EL. 935.69 ±

6" DIA.

8" CONC. BLOCK
W/METAL SHIMS

EL. 933.51

MN/DOT PLATE NO. 4011
106" DIA.

1 1/2" ROCK

GROUT-SLOPE TO DRAIN

- ① 4" GATE VALVE W/WHEEL
- ② 4" COUPLING - DRESSER STYLE 38 OR EQUAL
- ③ 4" TURBINE STRAINER - TRIDENT NEPTUNE TURBINE OR EQUAL
- ④ 4" COLD WATER METER - TRIDENT NEPTUNE TRU/FLOW OR EQUAL
- ⑤ 4" X 6" REDUCER W/RETAINER GLANDS
- ⑥ 4" WALL SLEEVE - LINK SEAL OR EQUAL

SURFACE OF STREET OR GROUND
 COVER
 TOP SECTION
 STANDARD VALVE BOX 7" (16" AND LARGER VALVES)
 BOTTOM SECTION
 GATE VALVE
 BASE
 4"
 RETAINER GLANDS TO BE USED AS DIRECTED BY THE ENGINEER
 D.I. PIPE
 MECHANICAL JOINT FITTING

GATE BOX BASE SHALL REST ON CONCRETE OR TREATED WOOD BLOCKS, AND SHALL BE AT LEAST 4" ABOVE PIPE OR VALVE.

Technical drawing of a gate box assembly, showing a side elevation and a plan view.

Side Elevation Labels:

- OPERATING NUT
- BOHNET
- NOZZLE SECTION
- TRAFFIC FLANGE
- CHAIN
- GROUND LINE
- LIMIT OF EXCAVATION
- STAND PIPE
- DRAIN BOX A1-1089
- BOTTOM
- CEMENT BLOCK
- BASE
- GRAVEL OR CRUSHED ROCK
- BACK FILL & TAMP
- COVER
- CURB SECTION
- HOSE NOZZLE

Dimensions:

- 7'-6" AS PER SPECIFICATION
- 18" MIN.
- 7' MIN.
- 2'-0"
- 6" GATE VALVE
- 2'-0" MIN.

Plan View Labels:

- MAIN & TEE
- RETAINER GLANDS TO BE USED
- 6" GATE VALVE

Other Labels:

- PROPERTY LINE
- GATE BOX ASSEMBLY
- TOP SECTION
- BOTTOM SECTION

USE RETAINER GLANDS 27-
C.S.A.P. NO.62-626-01, NO.62-626-02, P-W-85-31

SURVEY:	CHECKED BY:	NO.	DATE	REVISIONS	I HEREBY CERTIFY THAT THIS PLAN WAS PREPARED BY ME OR UNDER MY DIRECT SUPERVISION AND THAT I AM A DULY REGISTERED PROFESSIONAL ENGINEER UNDER THE LAWS OF THE STATE OF MINNESOTA.  DATE: 5-25-26 REG. NO. 14410
DESIGN: D.H.					
DRAWN: D.H.	1				

SEE

SHORT – ELLIOTT – HENDRICKSON, INC.
Saint Paul, Minnesota • Chippewa Falls, Wisconsin

RAMSEY COUNTY, MINNESOTA

DETAILS

FILE NO.: 86068	8 29
DATE: 5-25-86	

ROSEVILLE


ROSEVILLE

S.A.P. 62-626-02
S.A.P. 62-626-01

ROSELAWN AVENUE

FALCON HEIGHTS

NOTE: NORTH BOULEVARD AREA BETWEEN STA. 23+00 TO STA. 25+90 SHALL BE FILLED TO FINISHED GRADE NOT LESS THAN 30 DAYS PRIOR TO UTILITY CONSTRUCTION. A TEMPORARY DRAINAGE CULVERT SHALL BE INSTALLED FROM THE EXISTING 12" R.C.P. F.E.S. TO THE LOW AREA AT STA. 24+35 - 45' LT.

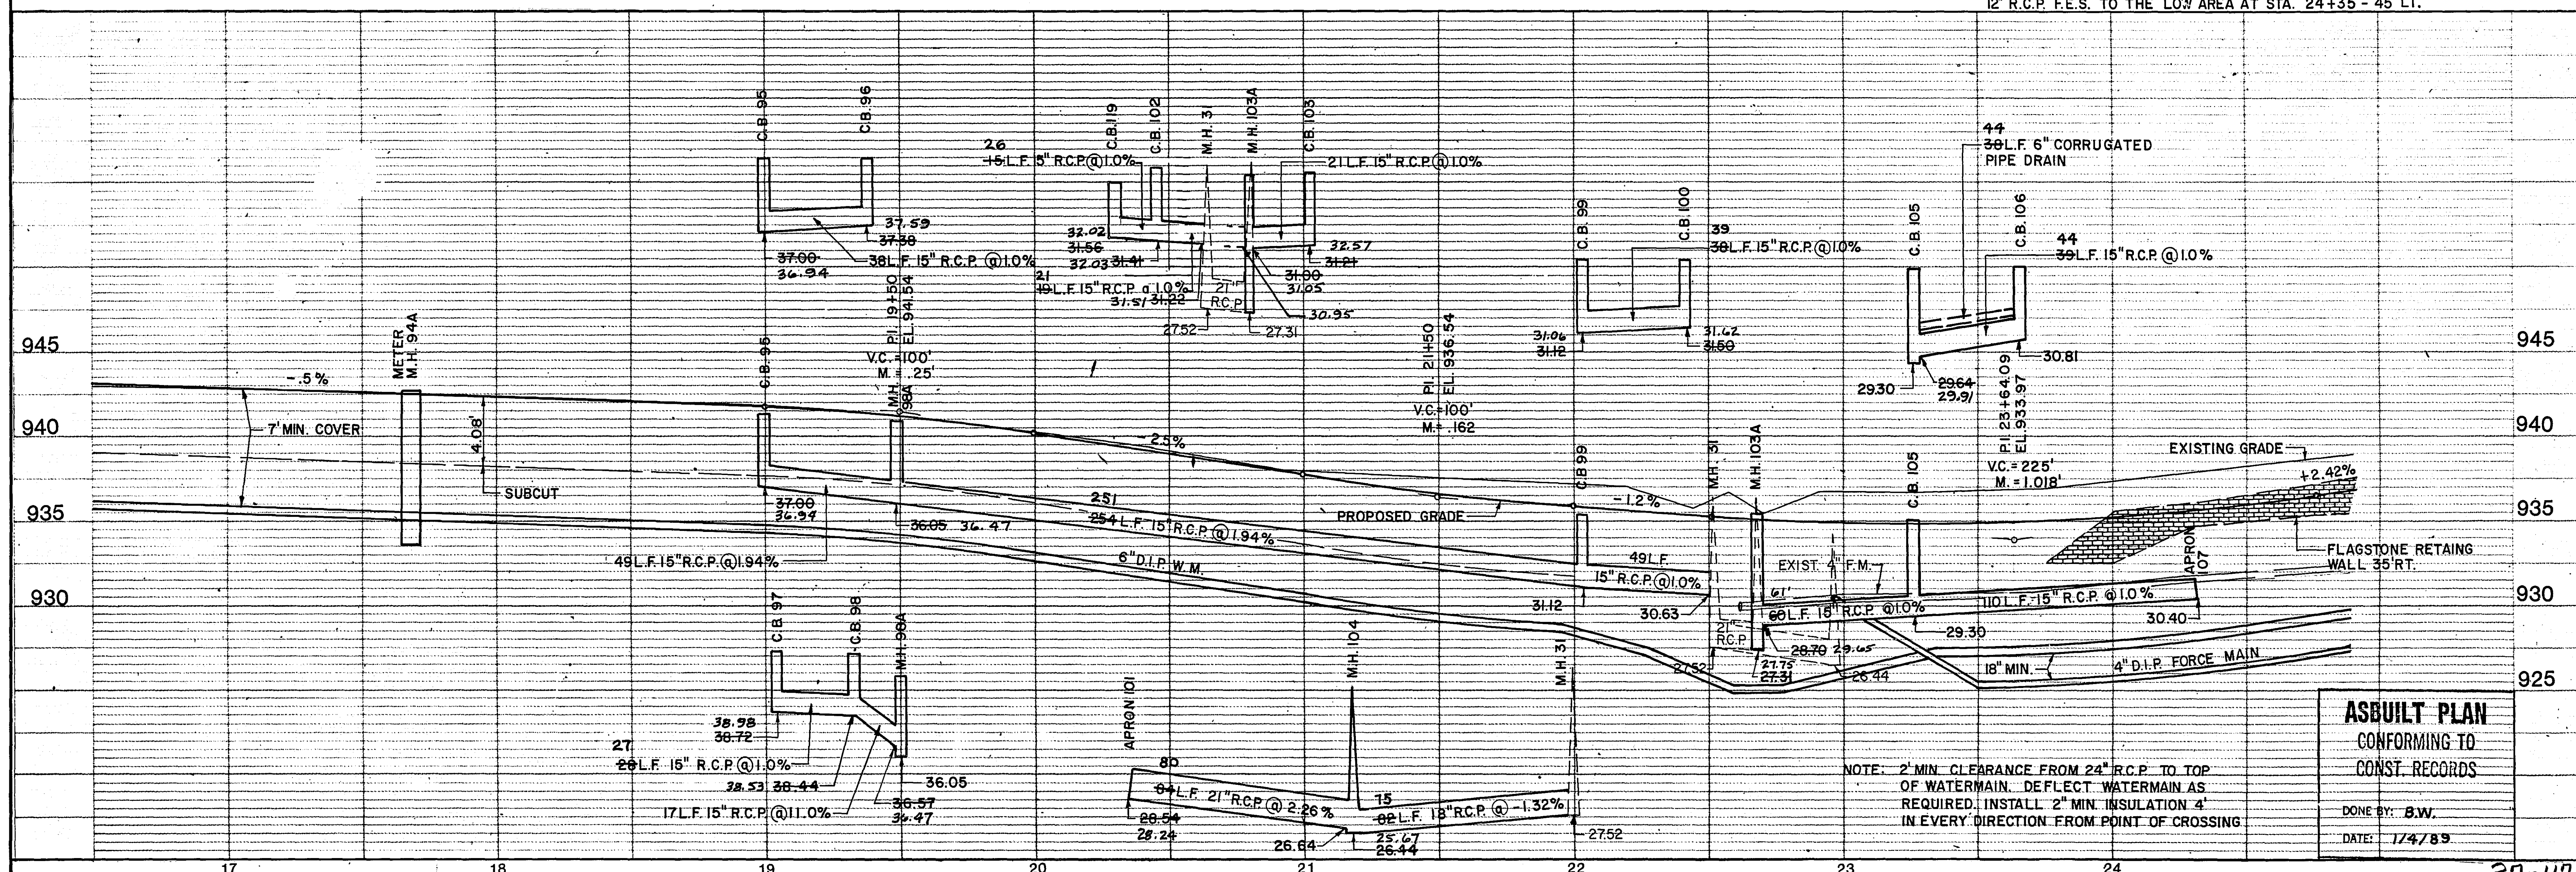

SURVEY:
DESIGN: DPH
DRAWN: GN

CHECKED BY:

NO.

DATE

REVISIONS

① 4-29-86 ADDED NOTE

I hereby certify that this plan was prepared by me or under my direct supervision and that I am a duly Registered Professional Engineer under the laws of the State of Minnesota.
Date: 3-25-86 Reg. No. 14410



SHORT - ELLIOTT - HENDRICKSON, INC.
Saint Paul, Minnesota • Chippewa Falls, Wisconsin

RAMSEY COUNTY, MINNESOTA



STREET, STORM SEWER,
AND WATERMAIN

FILE NO.:
86068
DATE:
3-25-86

11

29

C.S.A.P. NO. 62-626-01, NO. 62-626-02, P-W-85-31

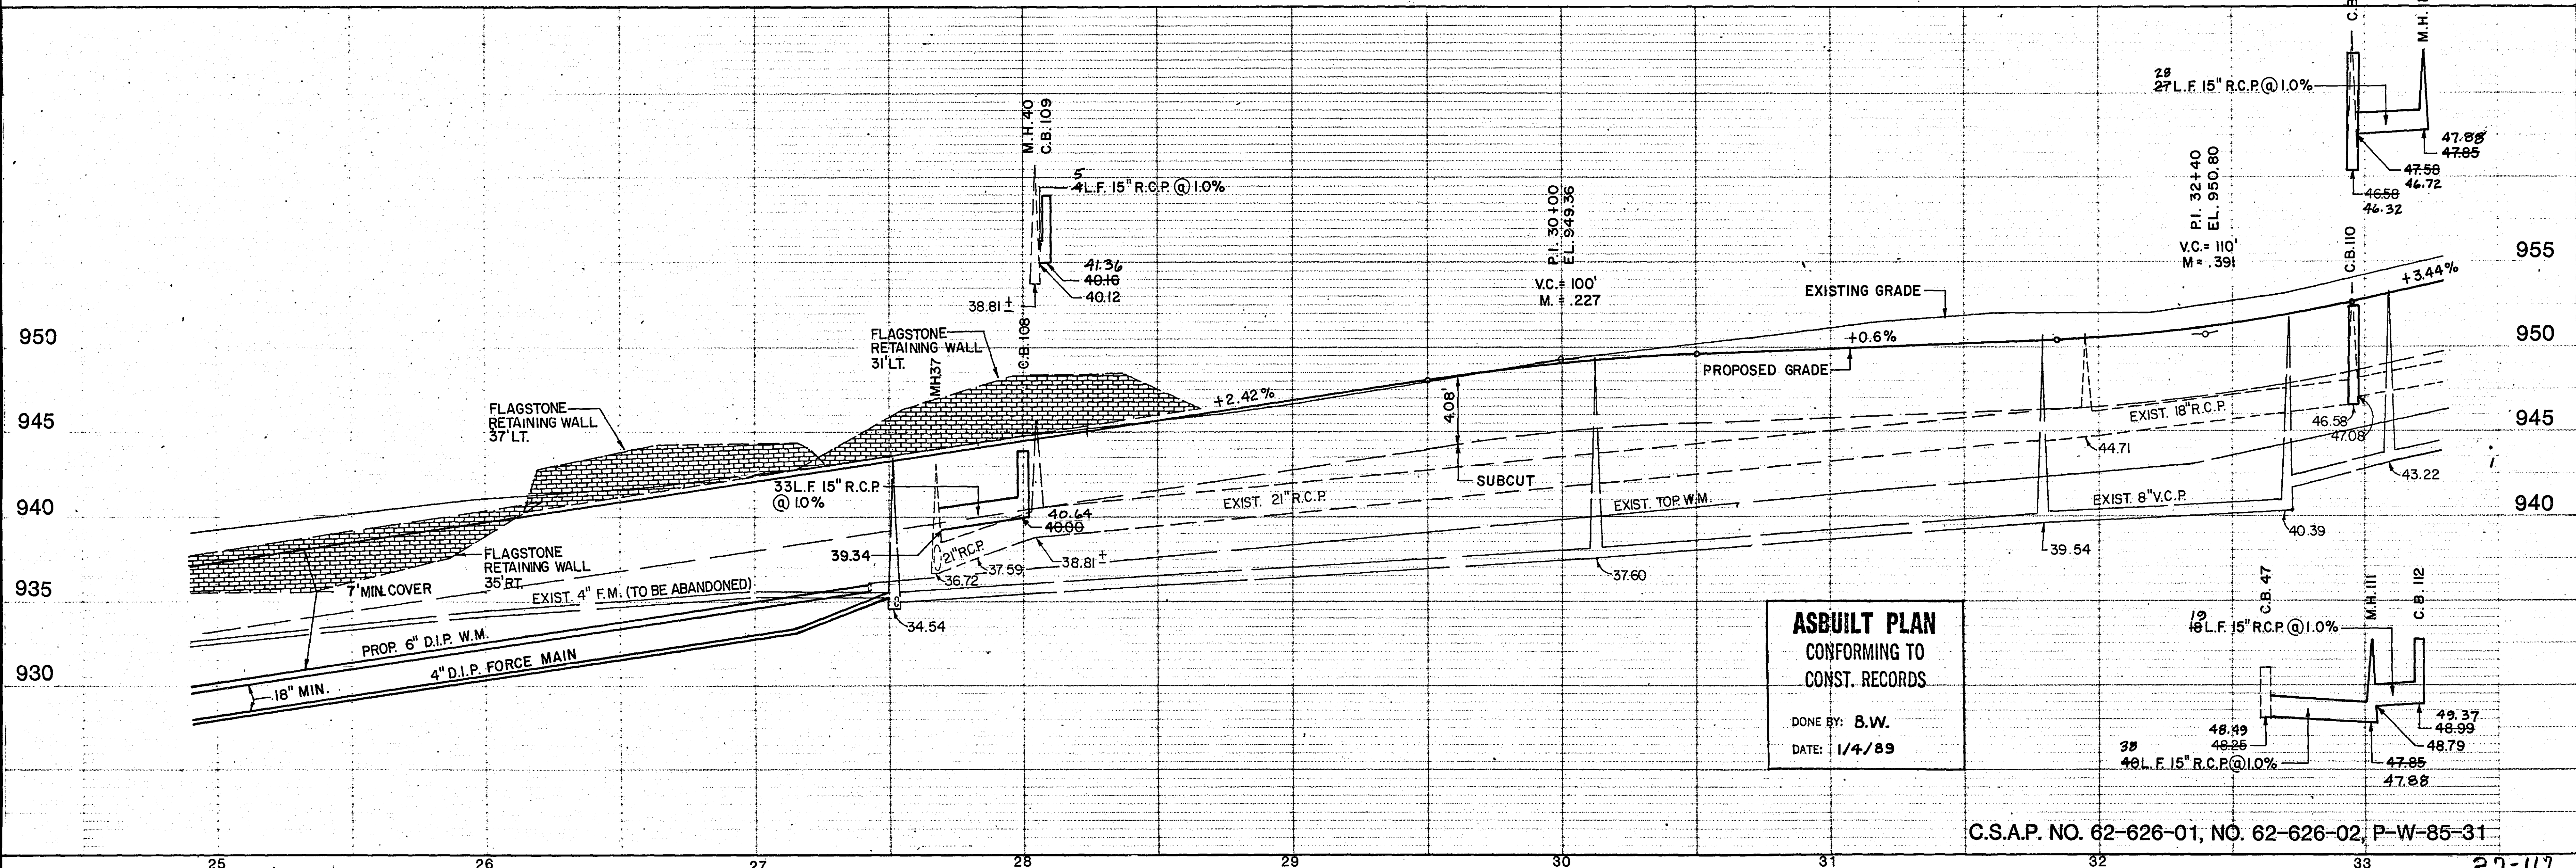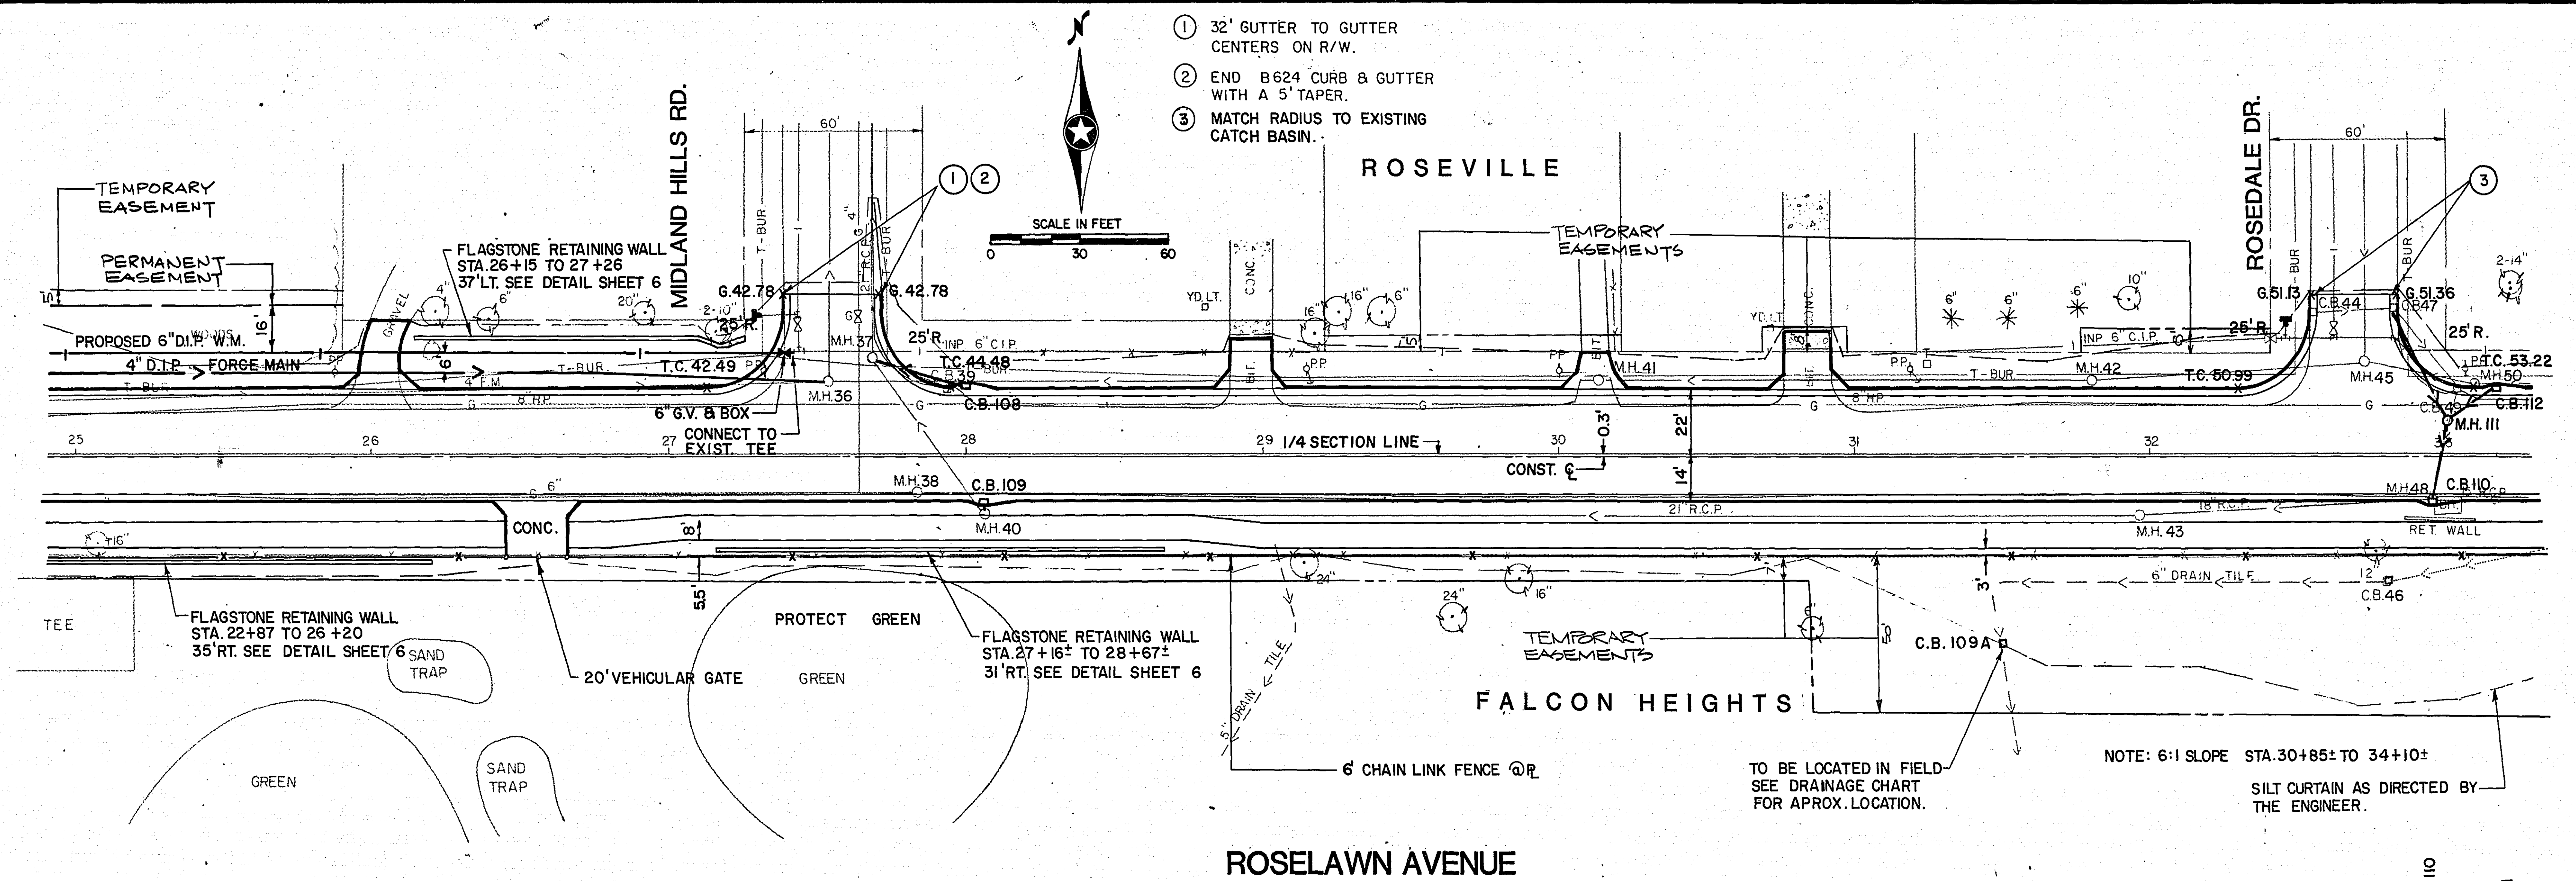

SURVEY:	CHECKED BY:	NO.	DATE	REVISIONS
DESIGN: D.H.				
DRAWN: D.H.				

I hereby certify that this plan was prepared by me or under my direct supervision and that I am a duly Registered Professional Engineer under the laws of the State of Minnesota.

Date: 3-25-89 Reg. No. 14410







SHORT - ELLIOTT - HENDRICKSON, INC.
Saint Paul, Minnesota • Chippewa Falls, Wisconsin

RAMSEY COUNTY, MINNESOTA

STREET, STORM SEWER,
AND WATERMAIN


FILE NO.: 12
DATE: 3-25-89
29

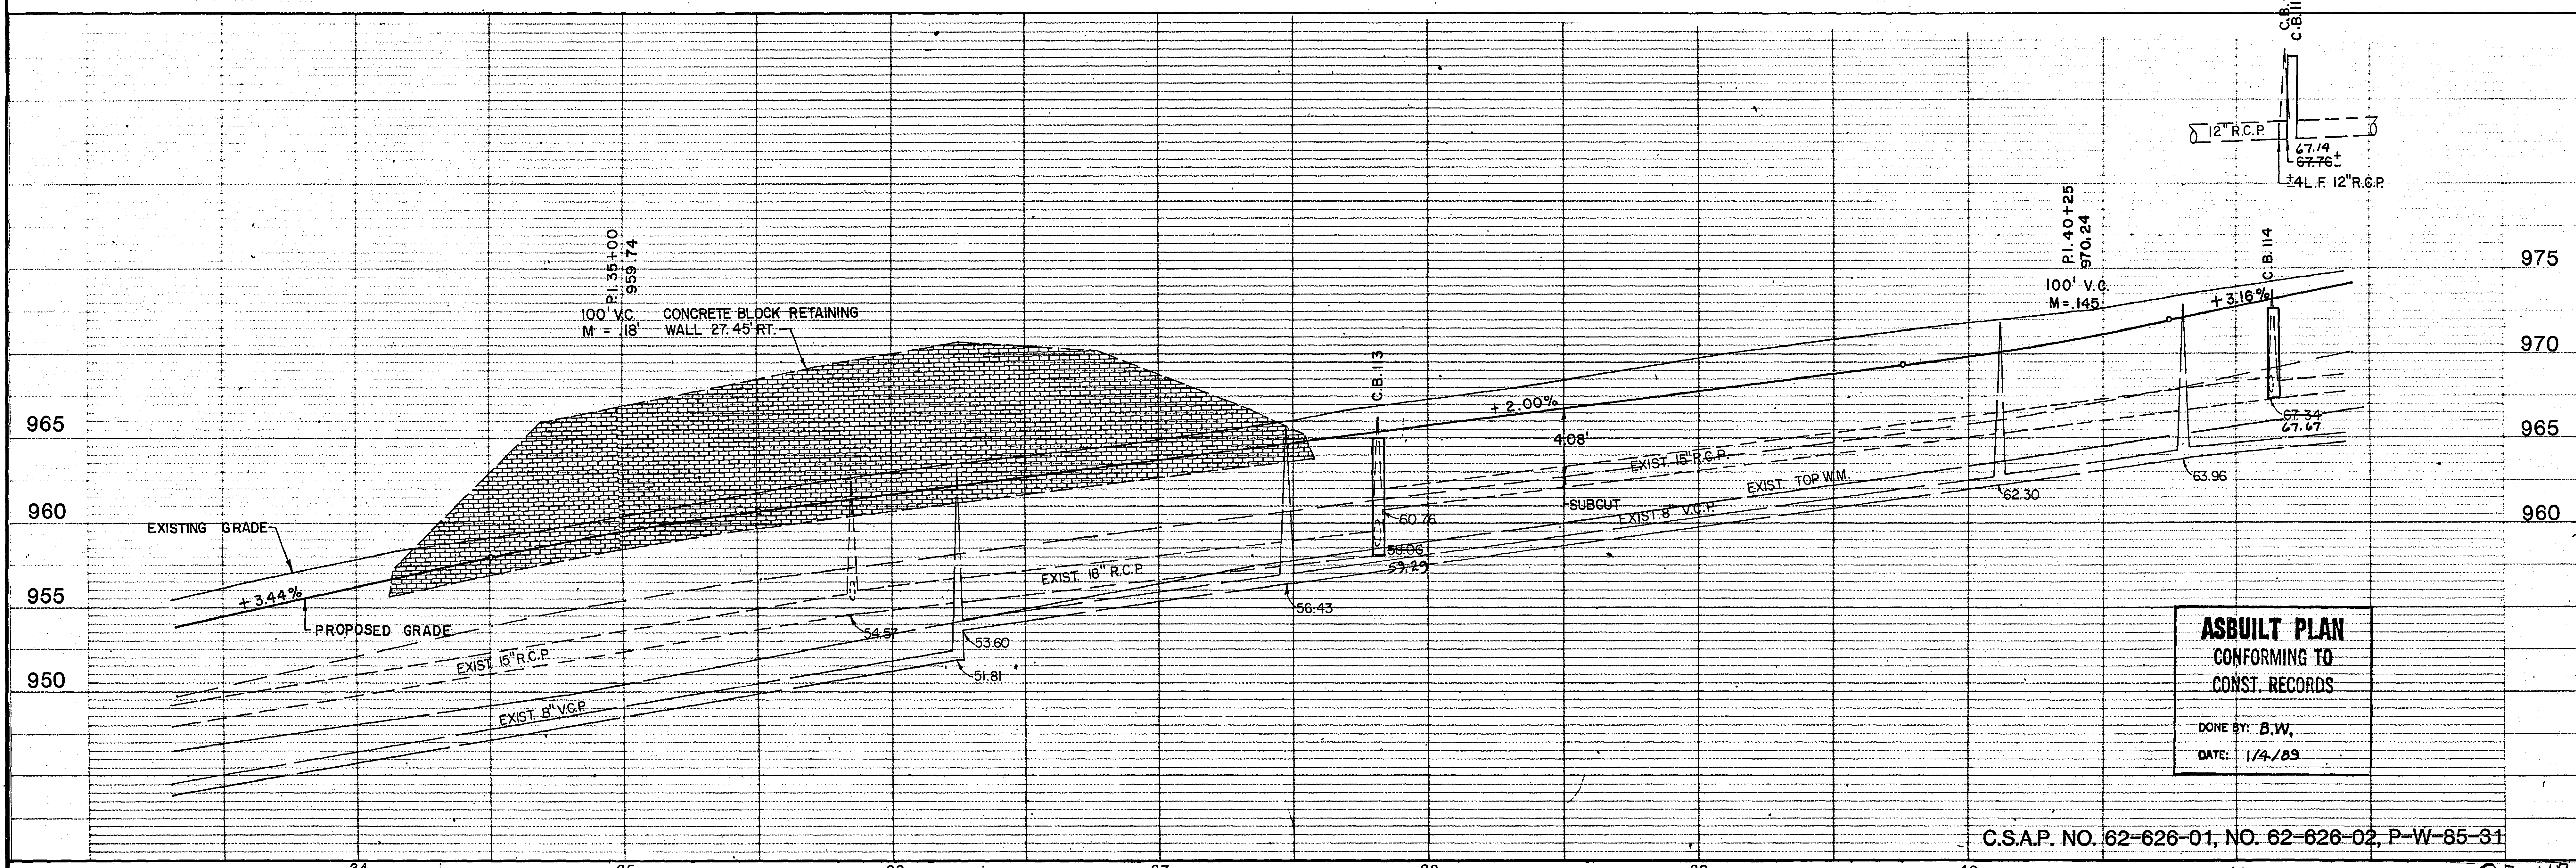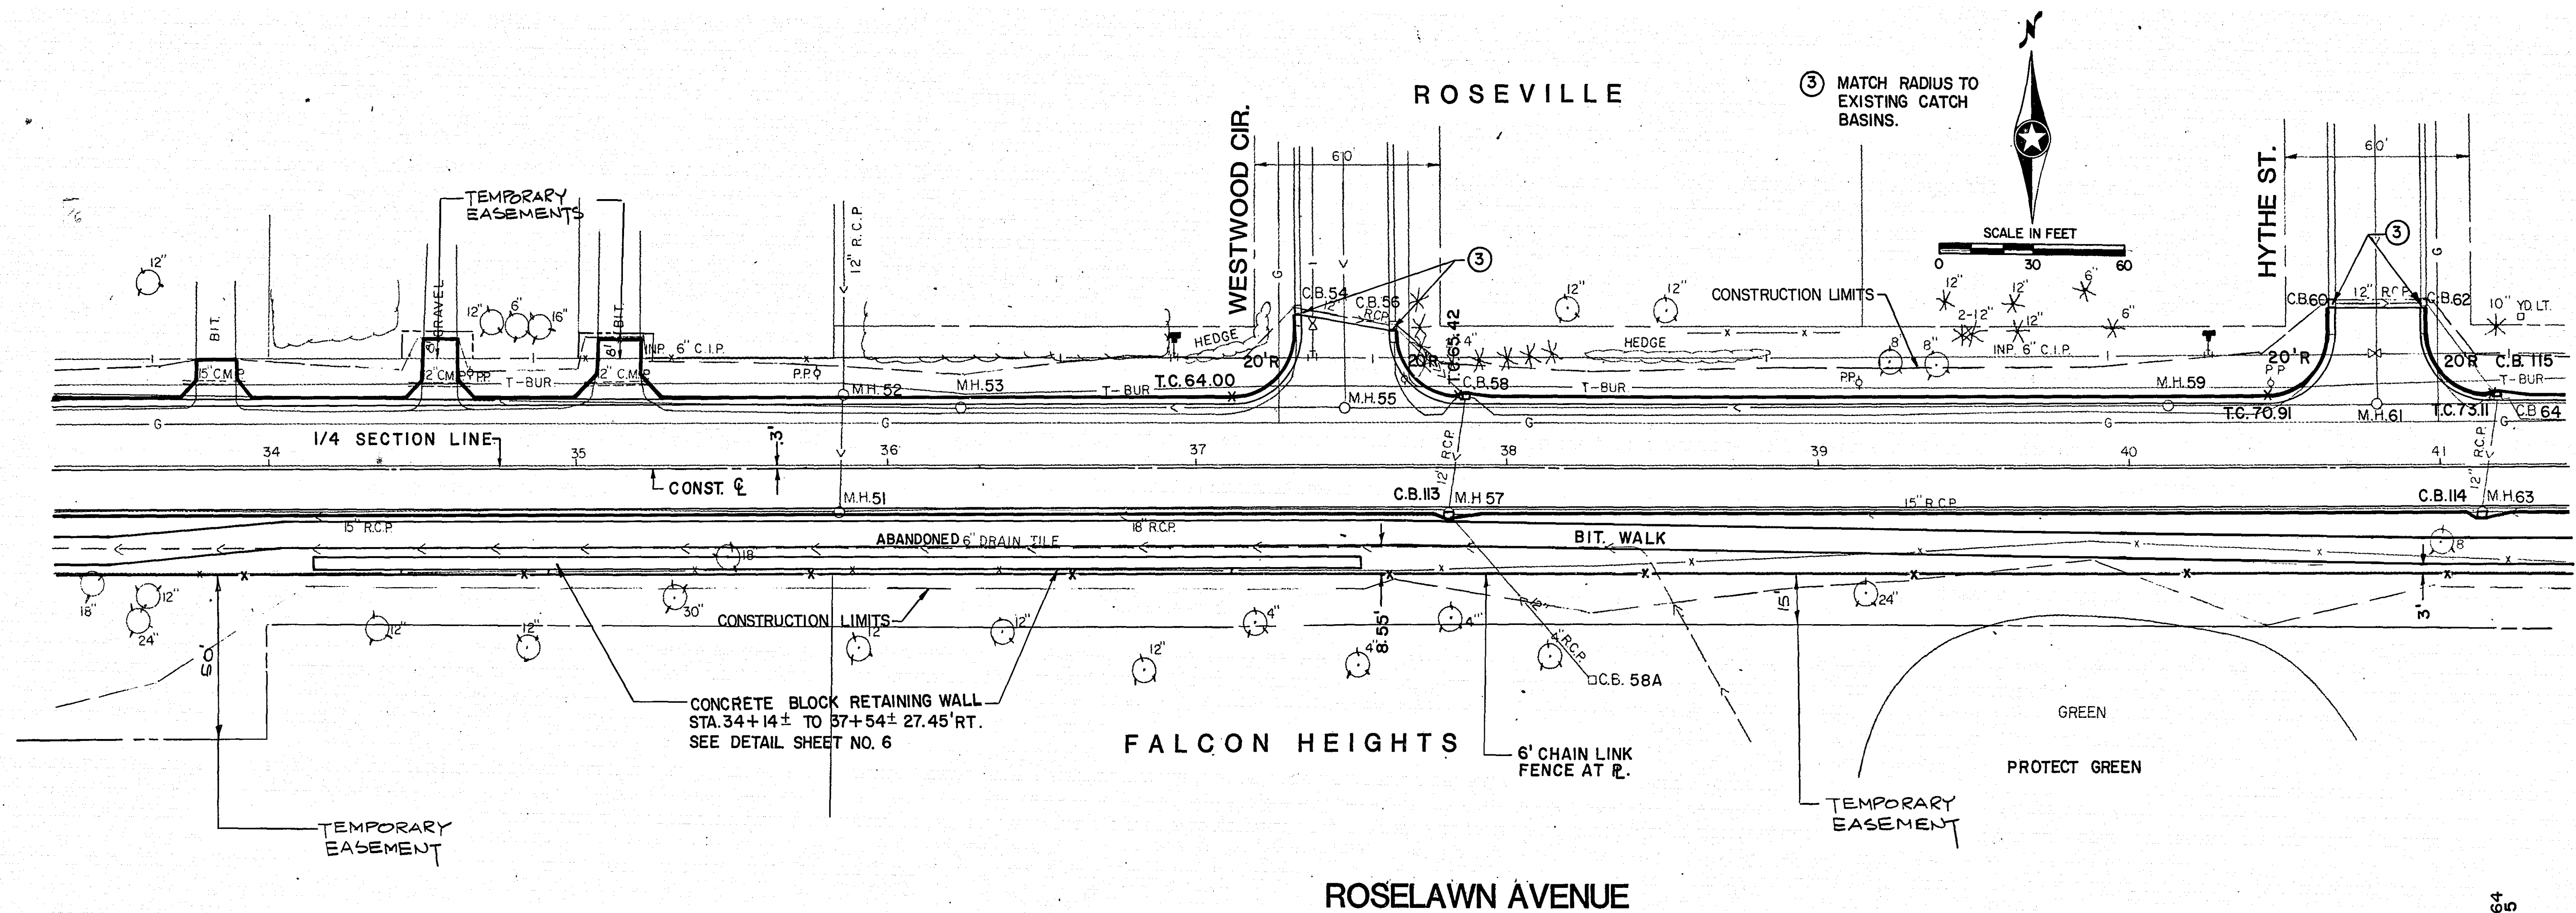

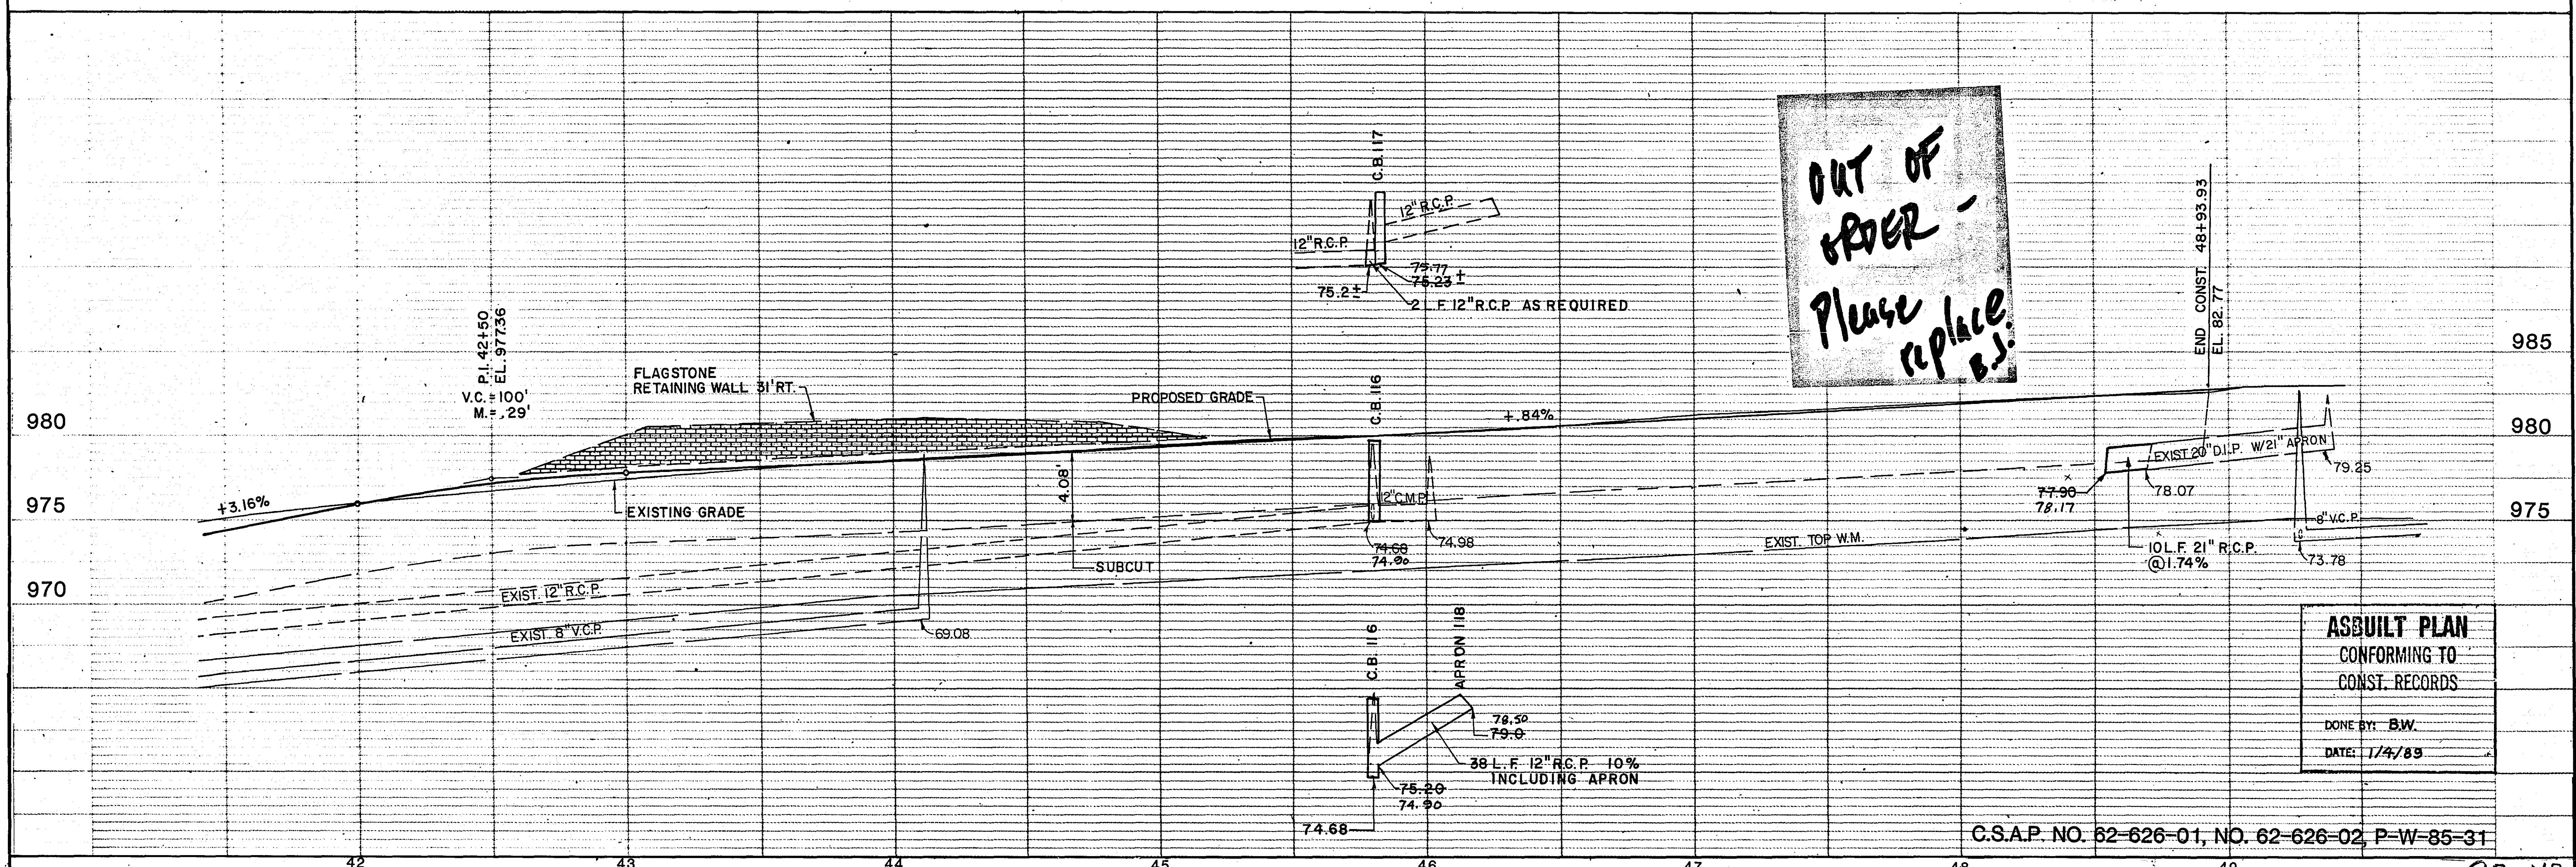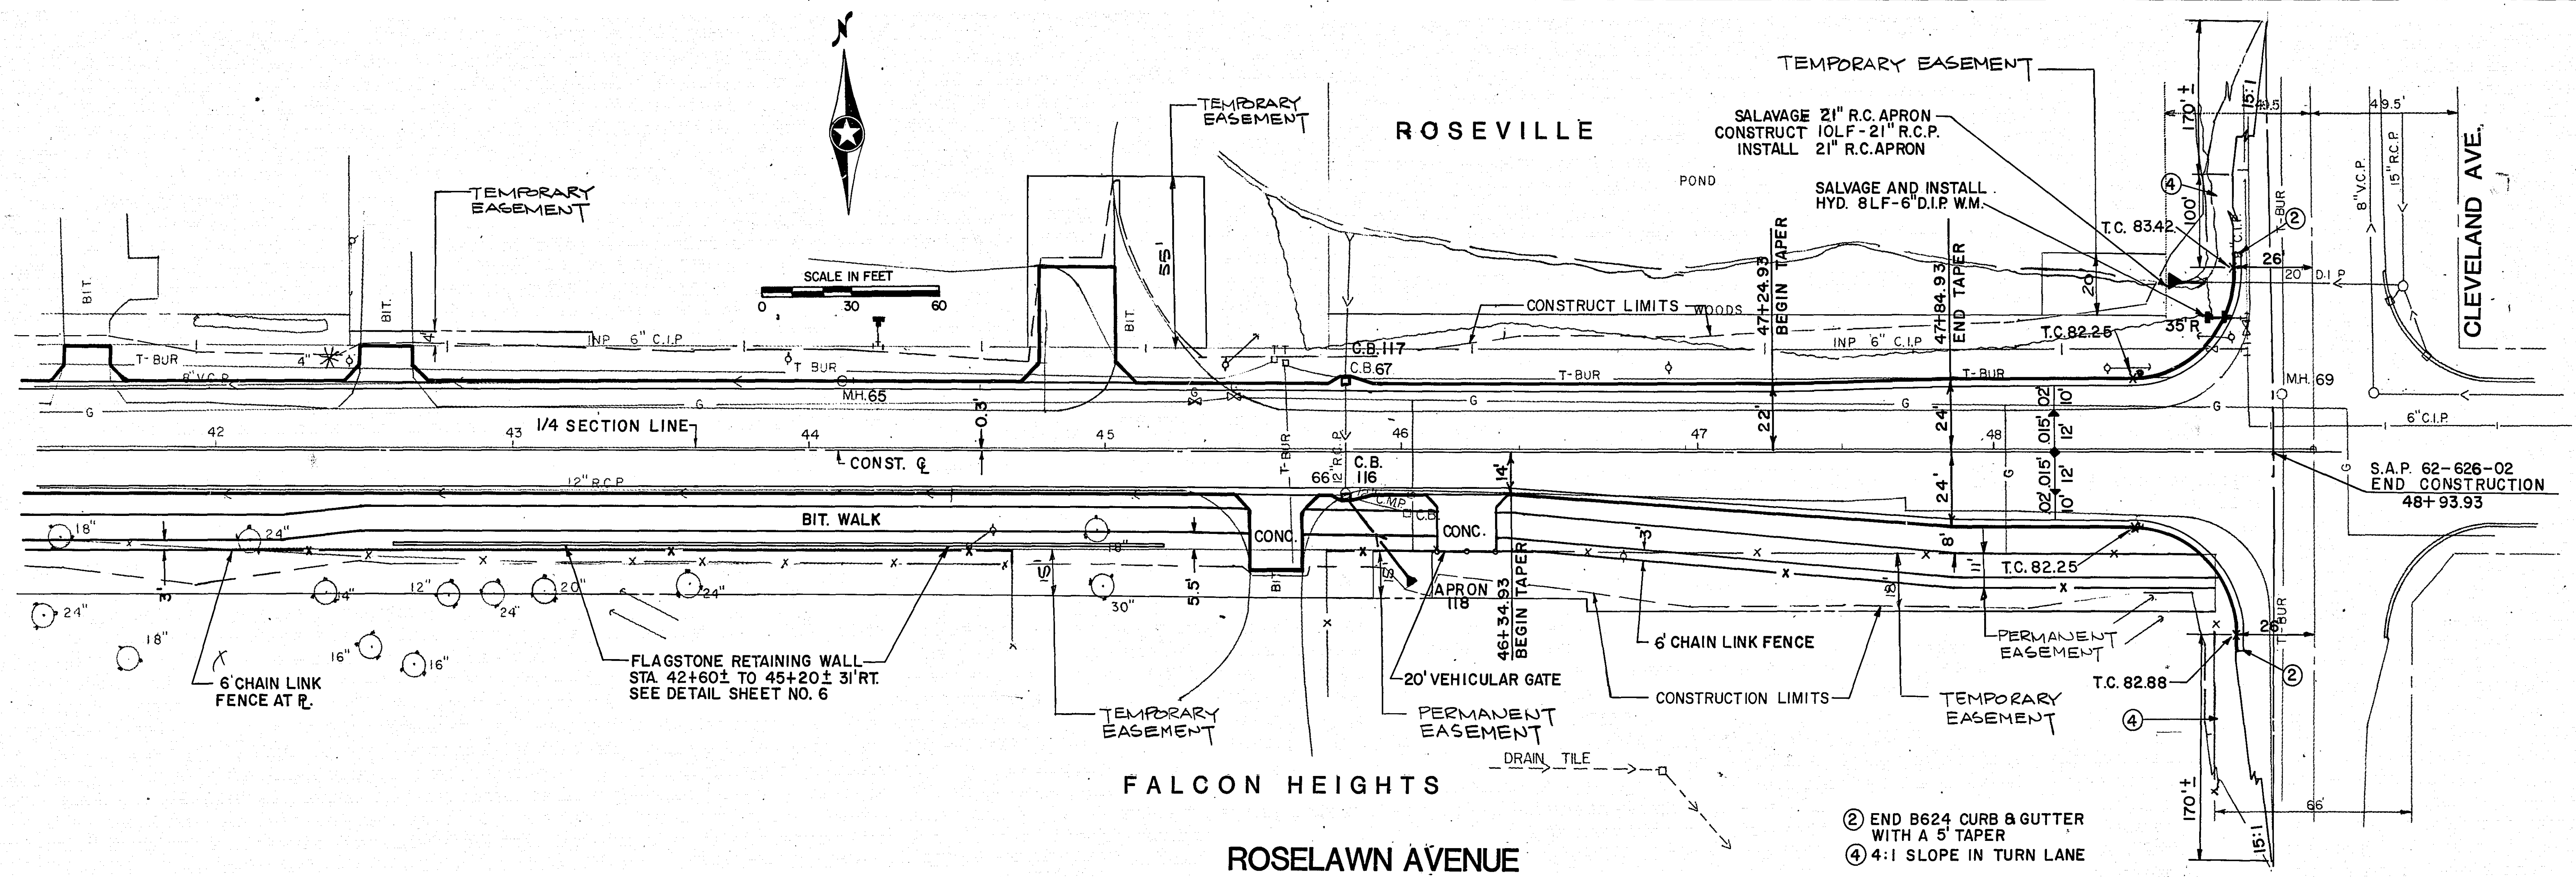


OUT OF ORDER - Please replace B.I.


SURVEY: D.H.	CHECKED BY: D.H.	NO. 1	DATE 3-25-86	REVISIONS	I hereby certify that this plan was prepared by me or under my direct supervision and that I am a duly Registered Professional Engineer under the laws of the State of Minnesota. Date 3-25-86 Reg. No. 14410	SHORT - ELLIOTT - HENDRICKSON, INC. Saint Paul, Minnesota • Chippewa Falls, Wisconsin	RAMSEY COUNTY, MINNESOTA	STREET, STORM SEWER, AND WATERMAIN	FILE NO. 86088 DATE 3-25-86	14 29
DESIGN: D.H.										
DRAWN: D.H.										

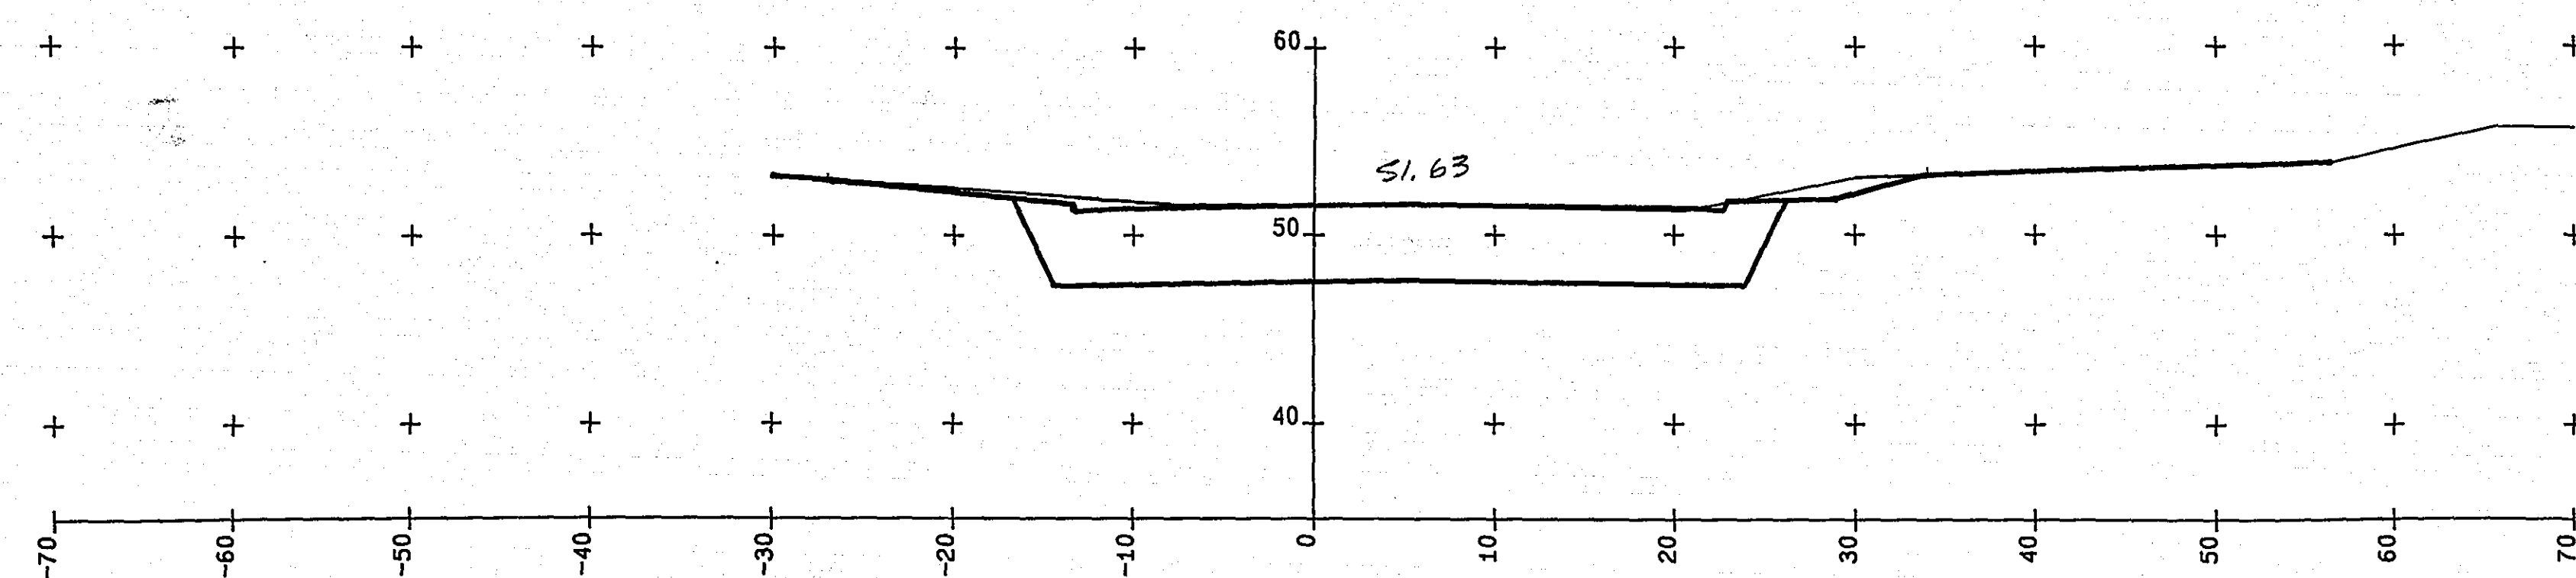


1+25.00

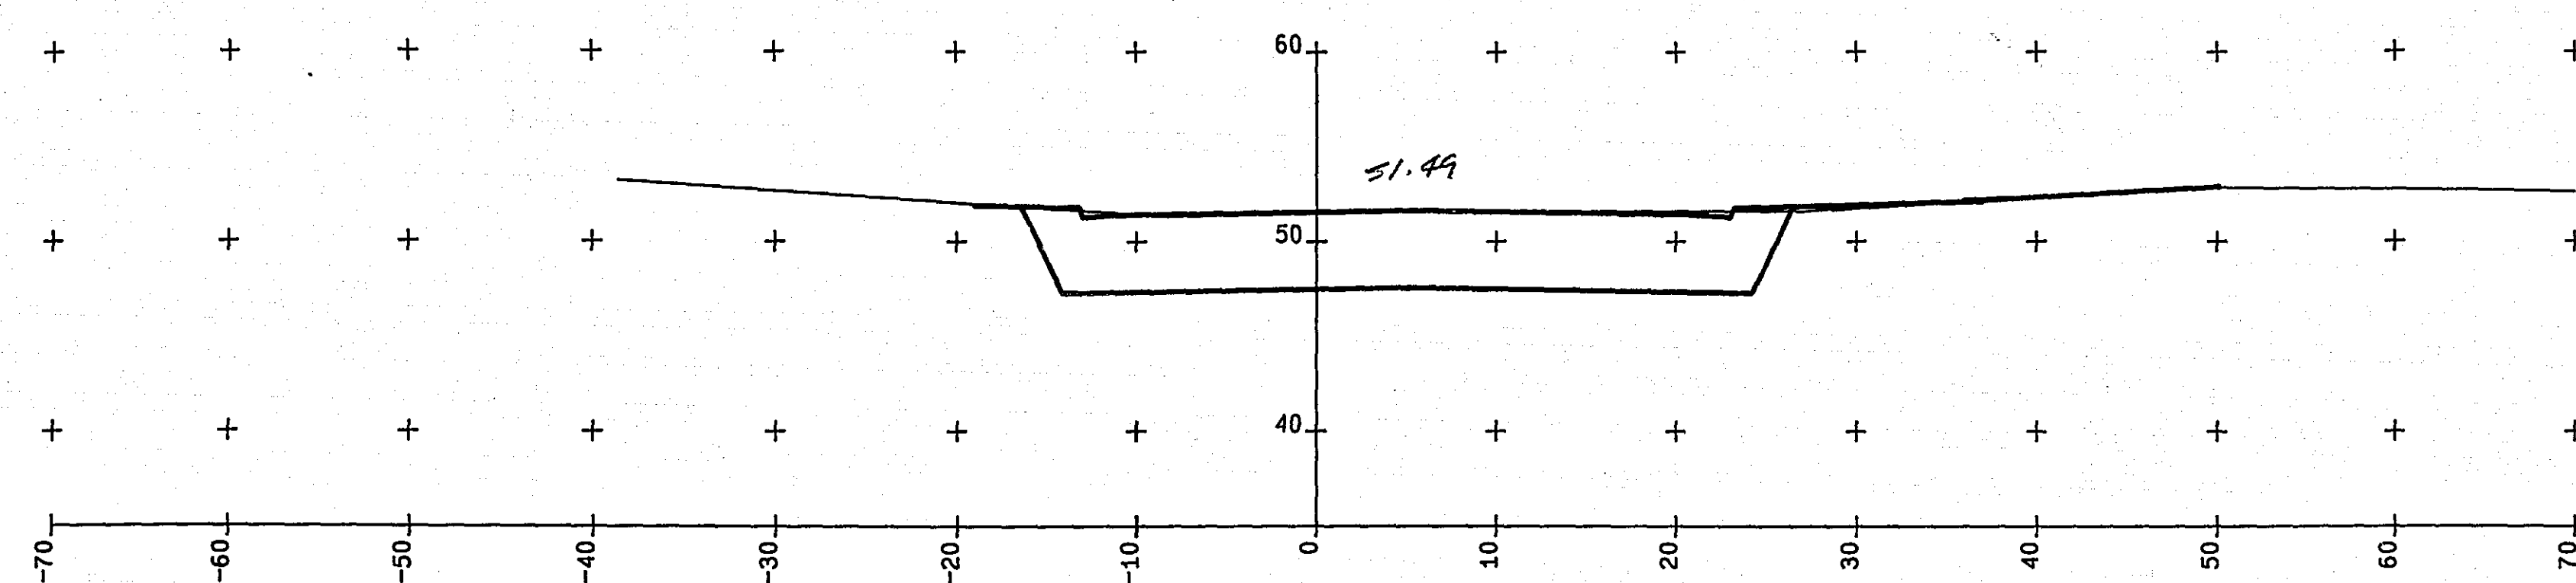


0+90.00

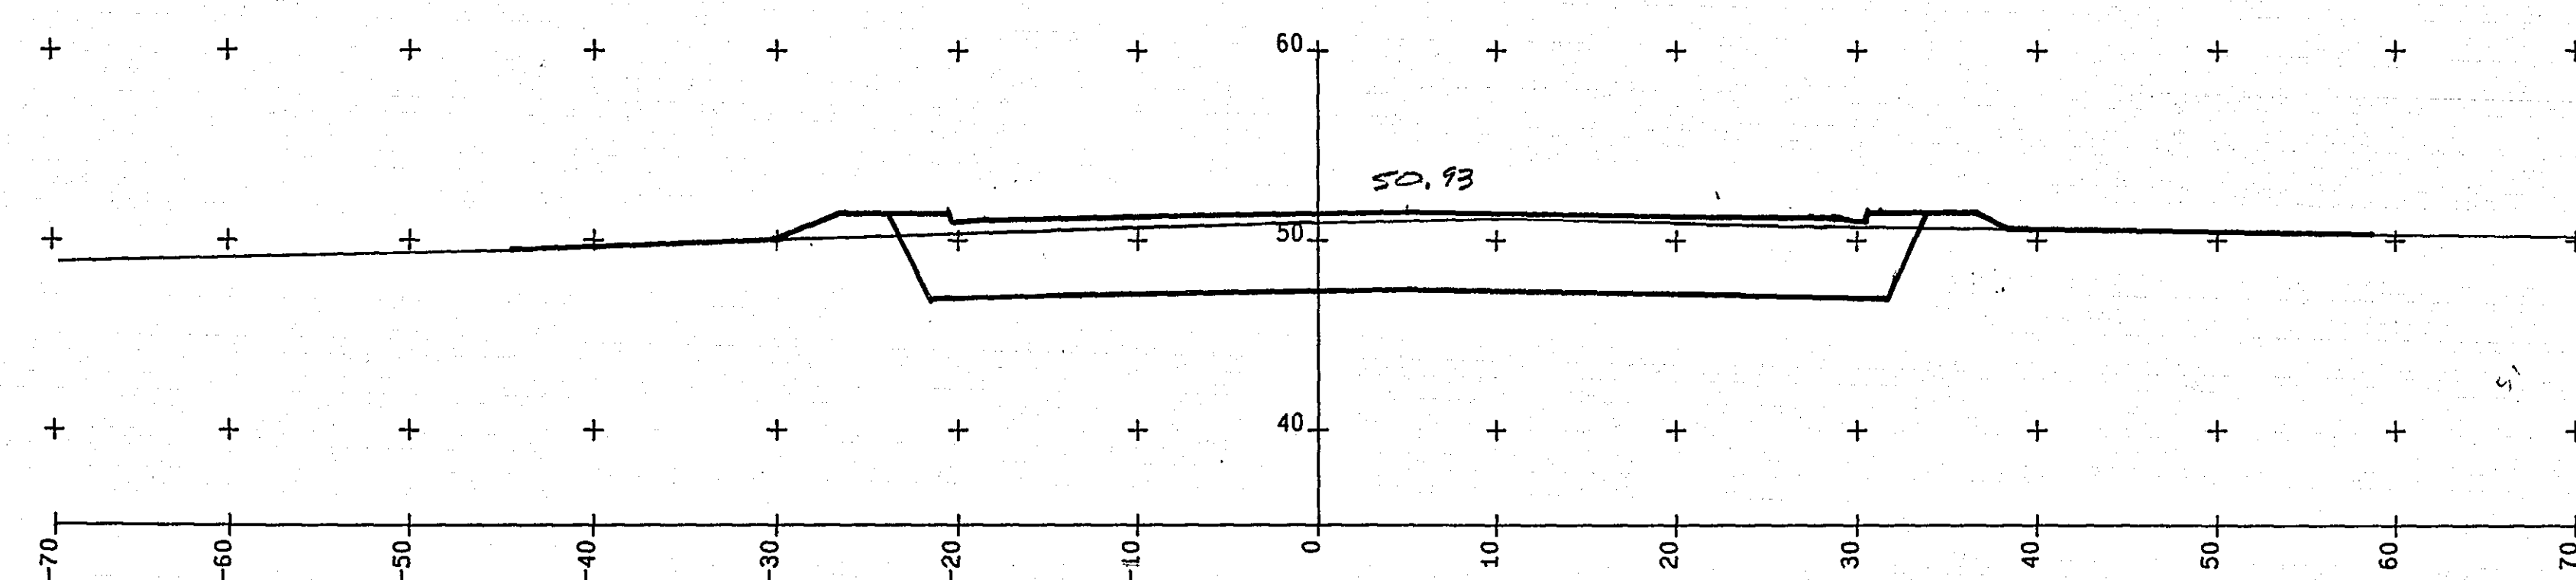


0+65.00

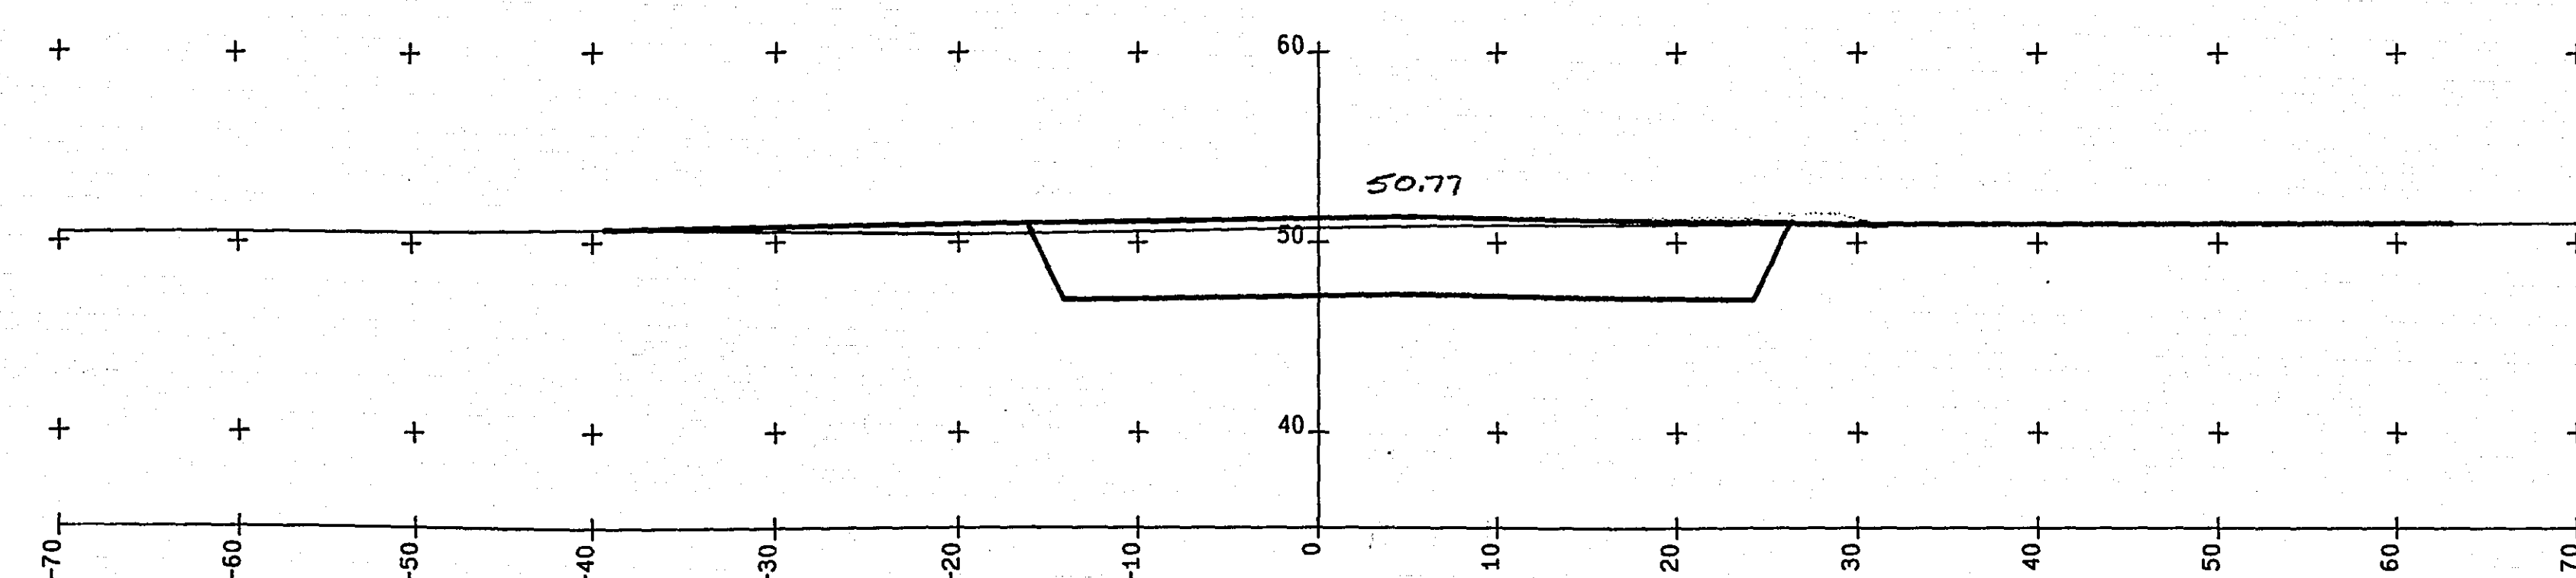


0+48.00

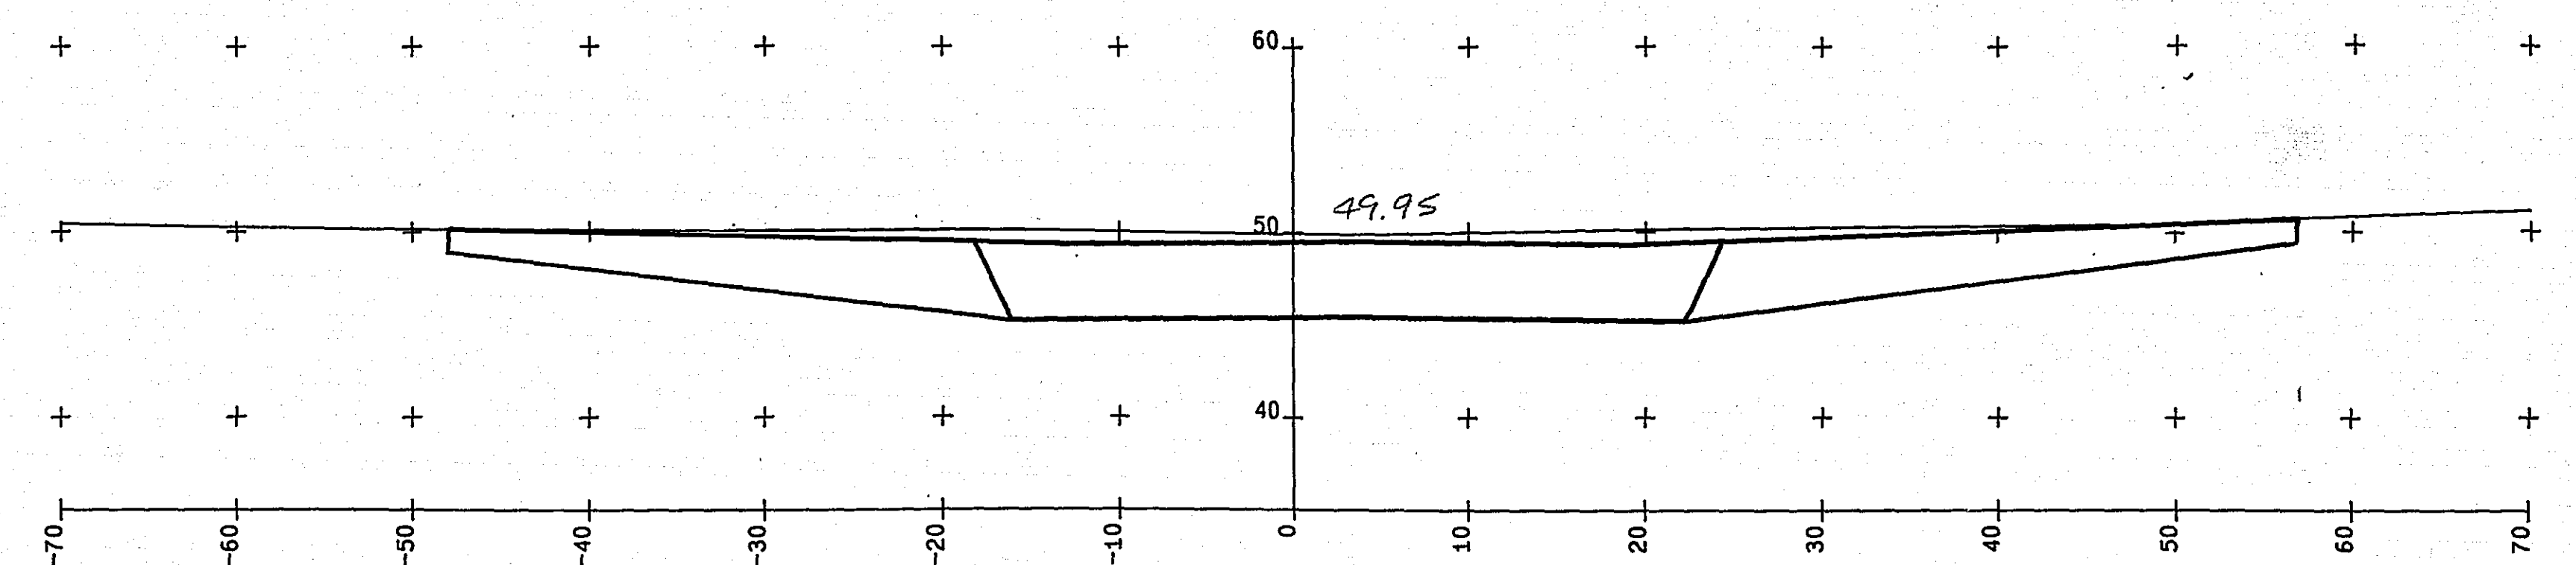


2+74.00

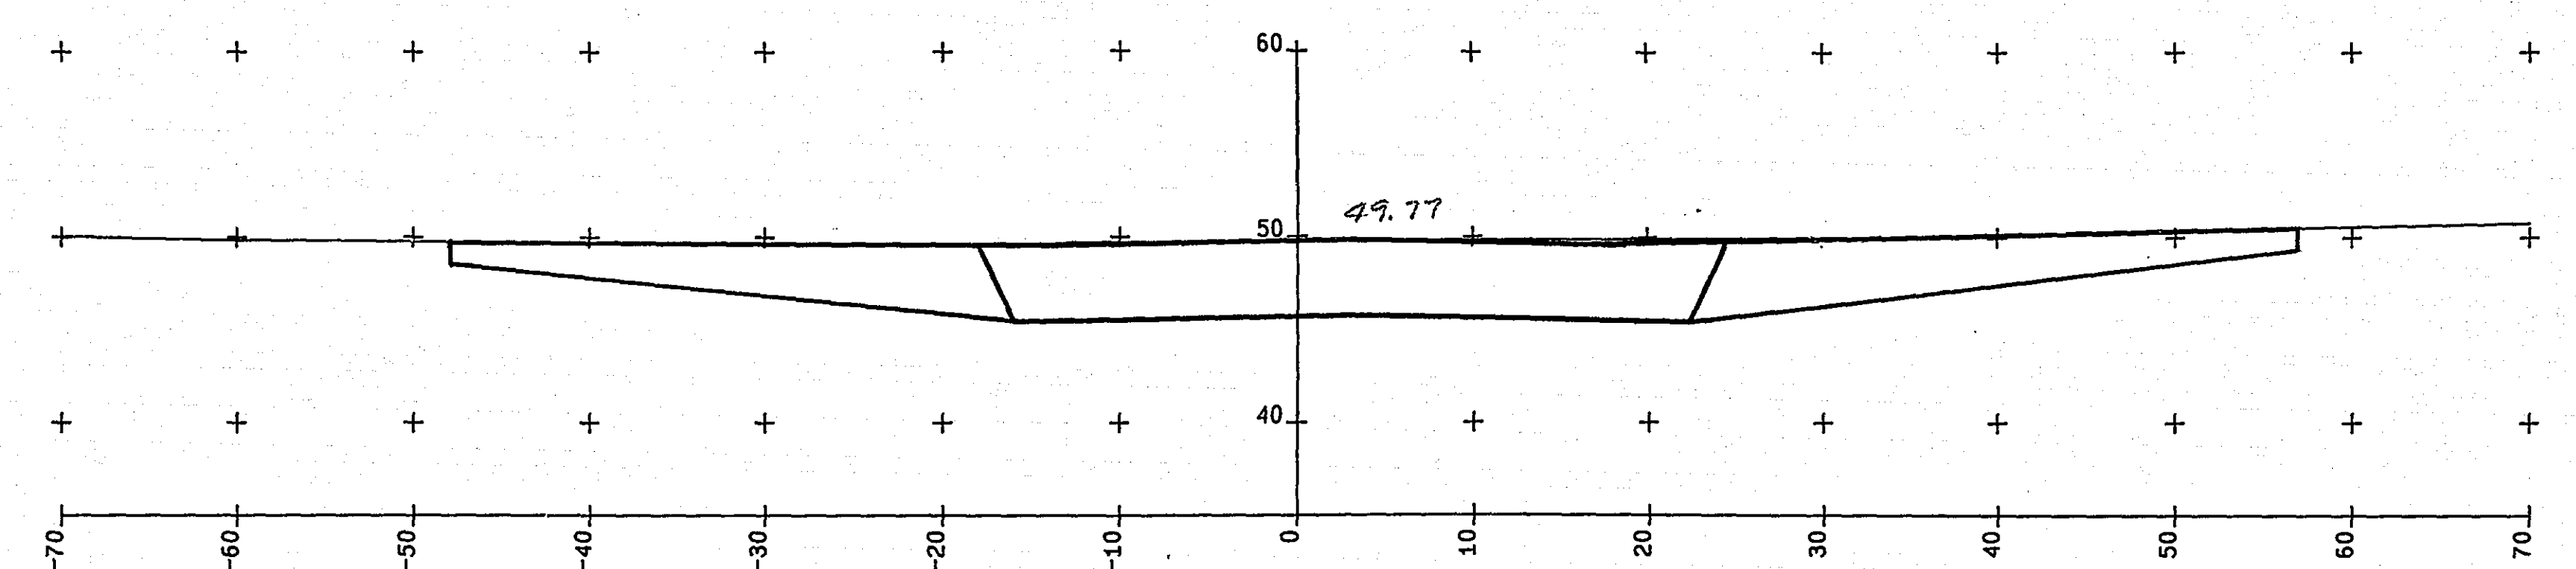


2+58.00

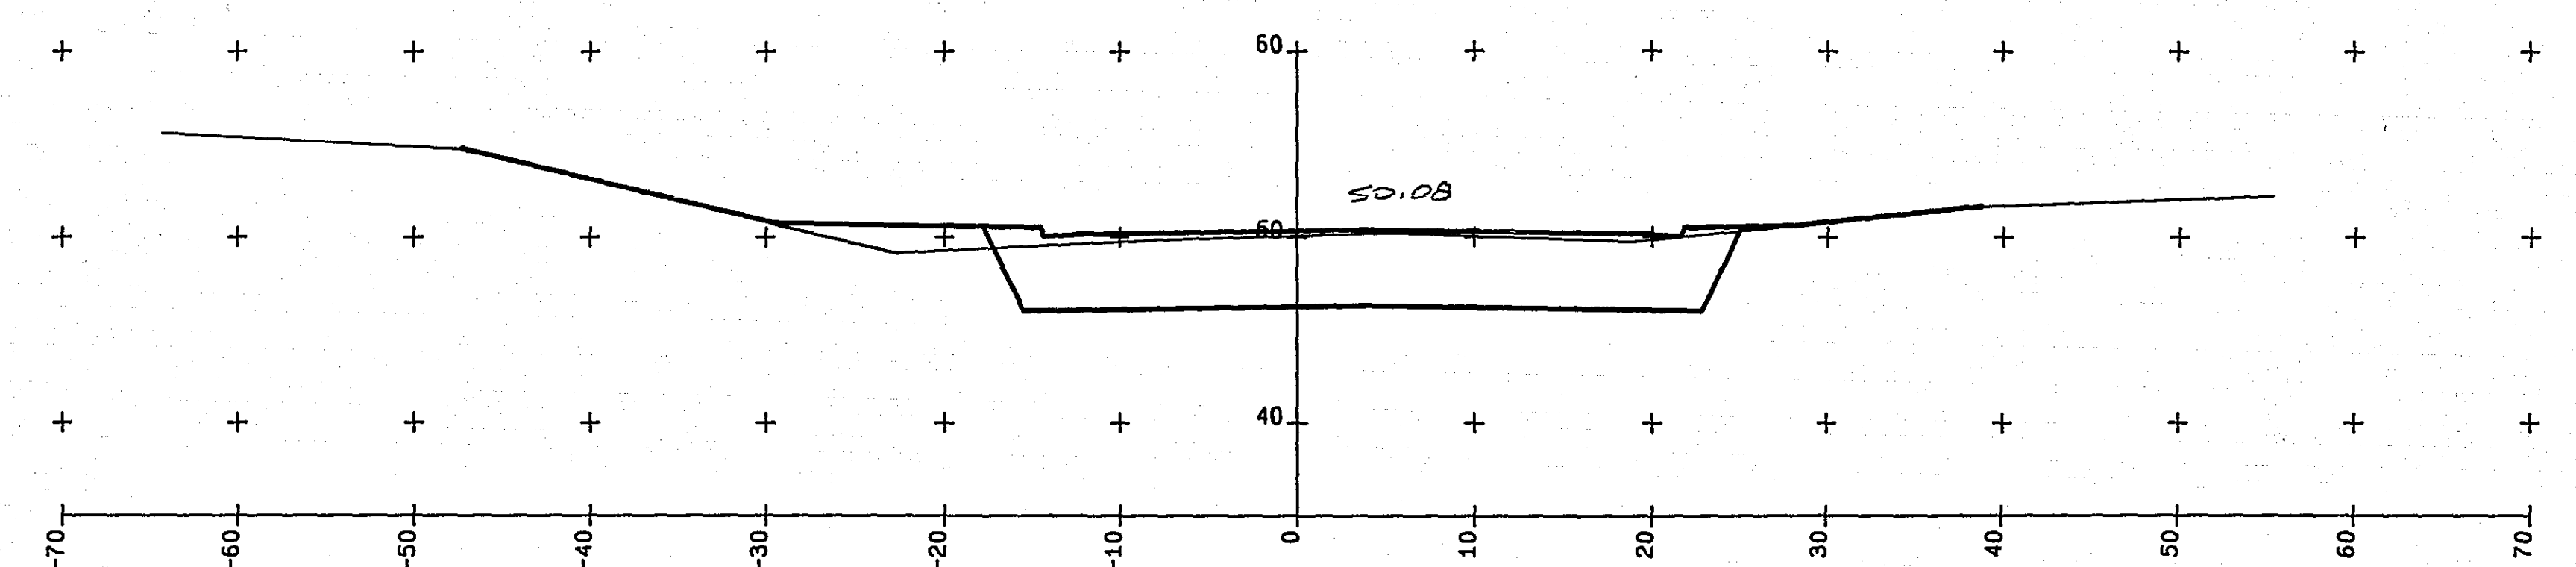


2+22.00

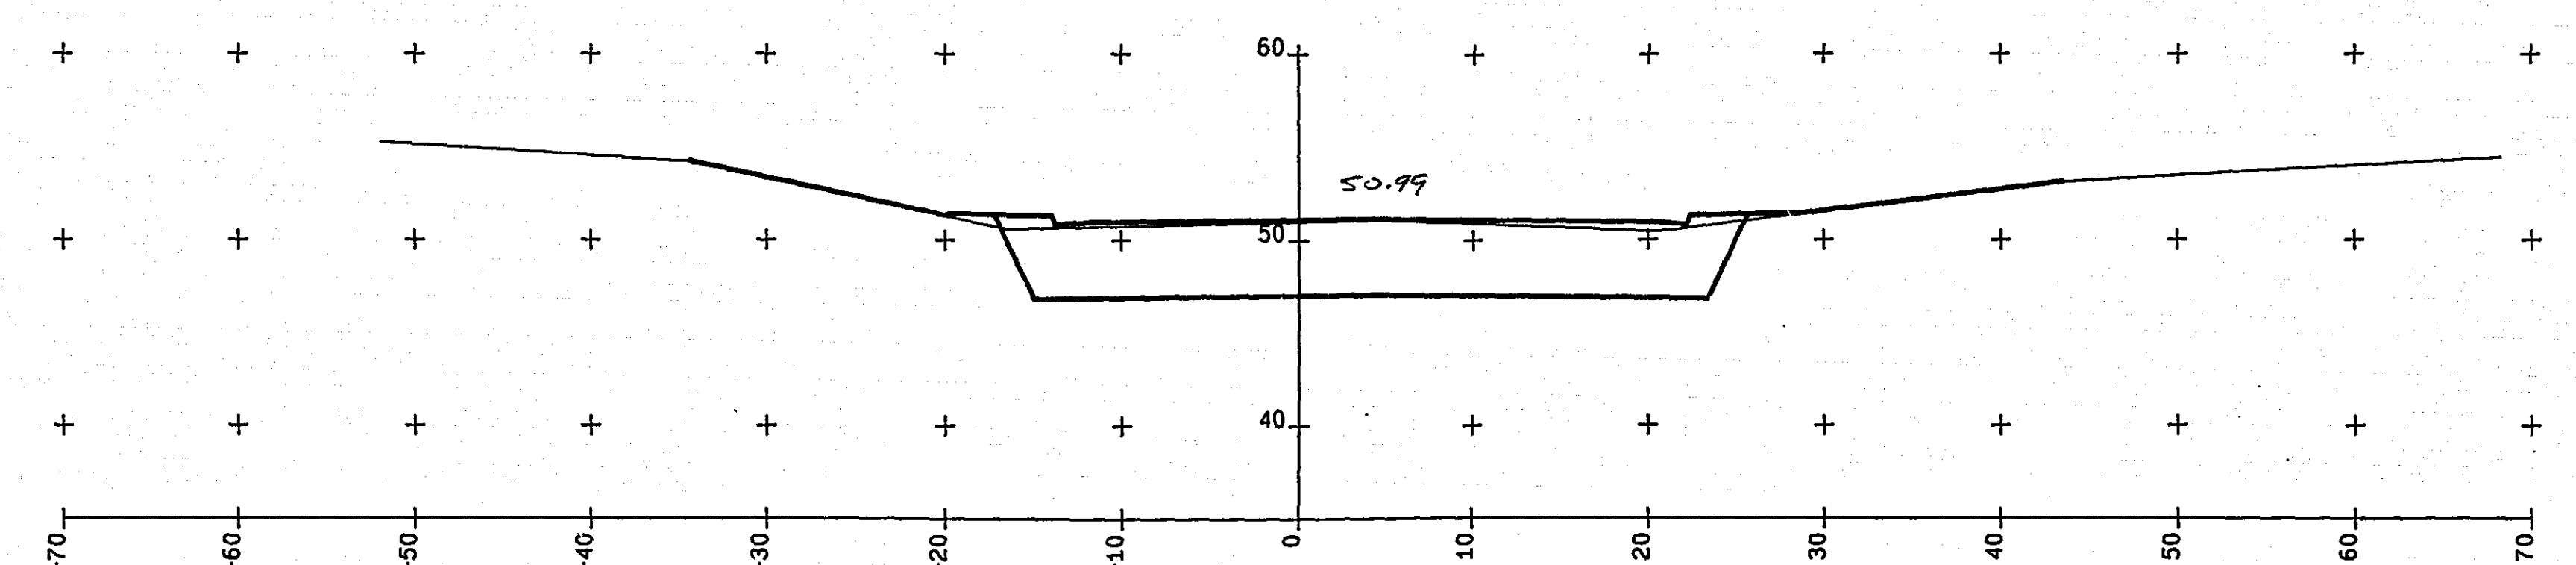


1+73.00

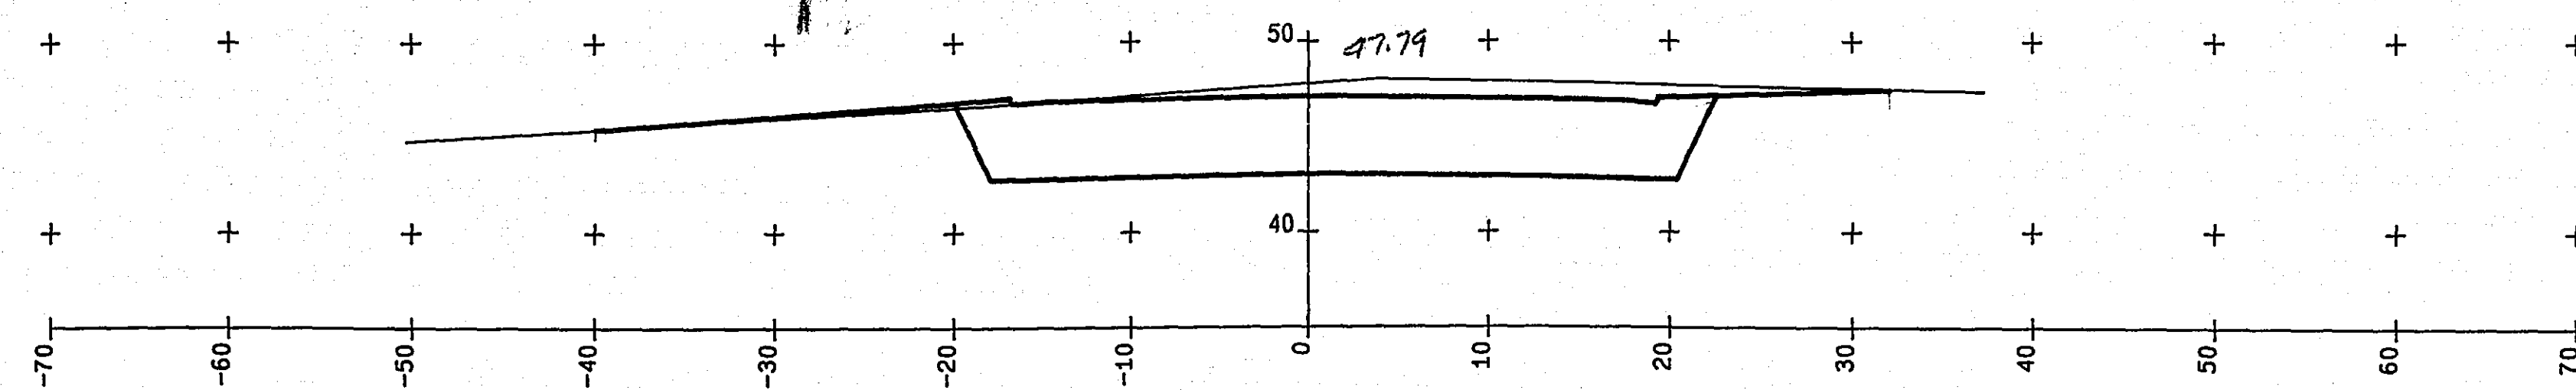


4+32.00

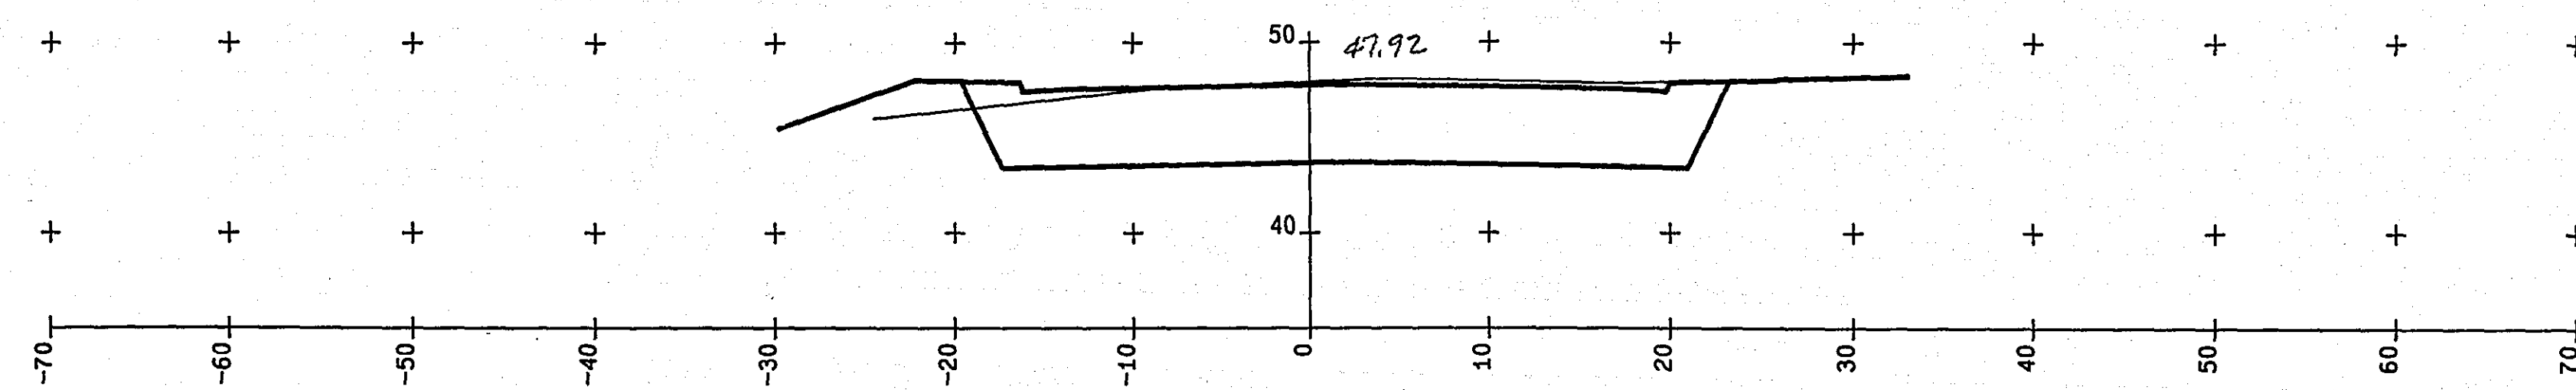


3+83.00

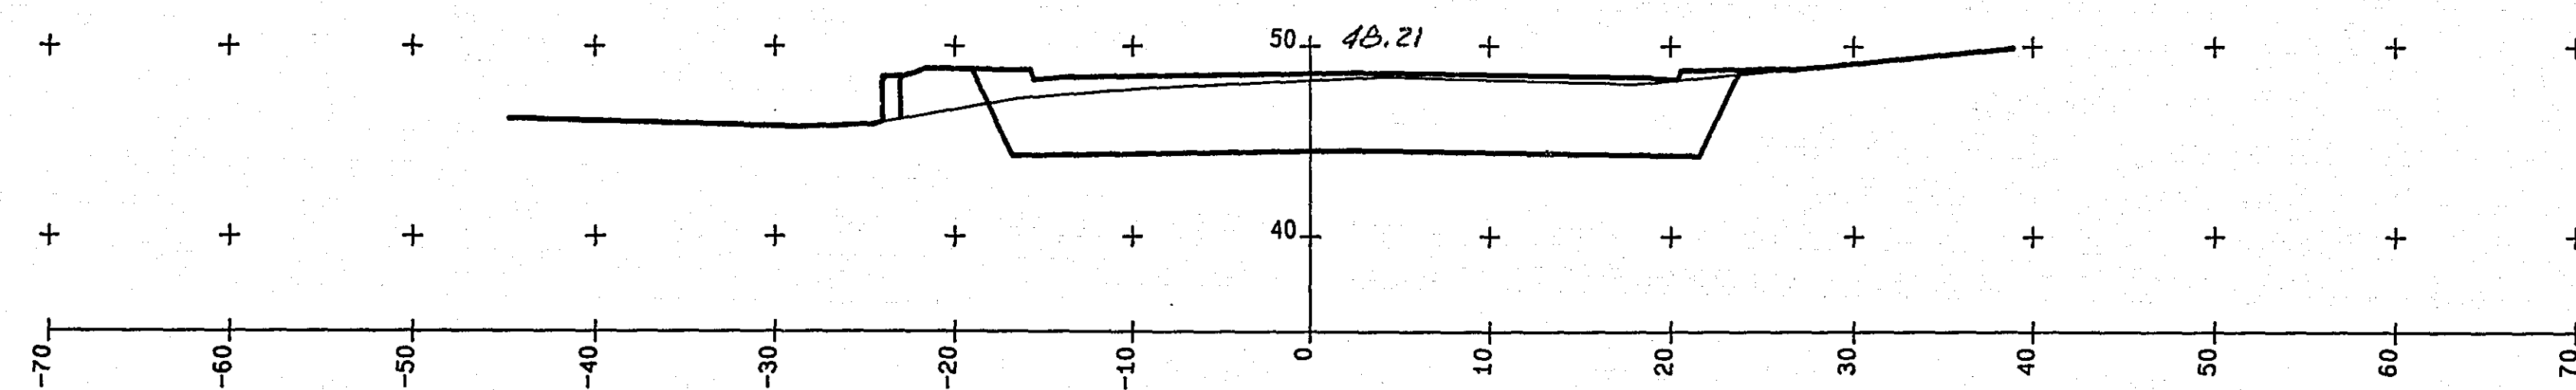


3+32.00

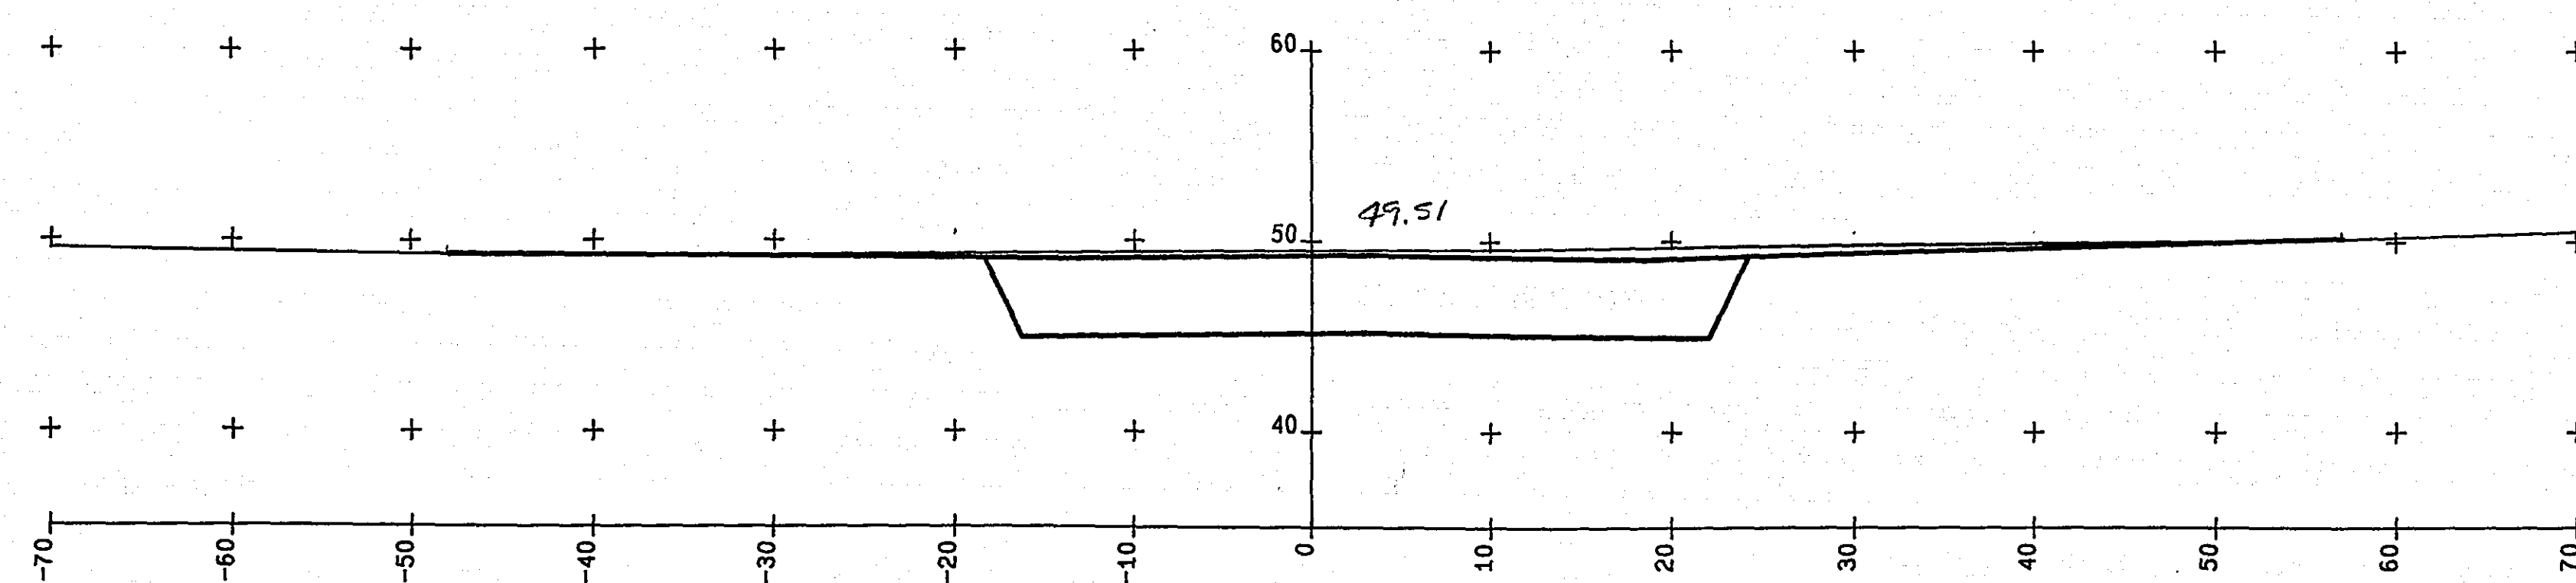


2+89.00

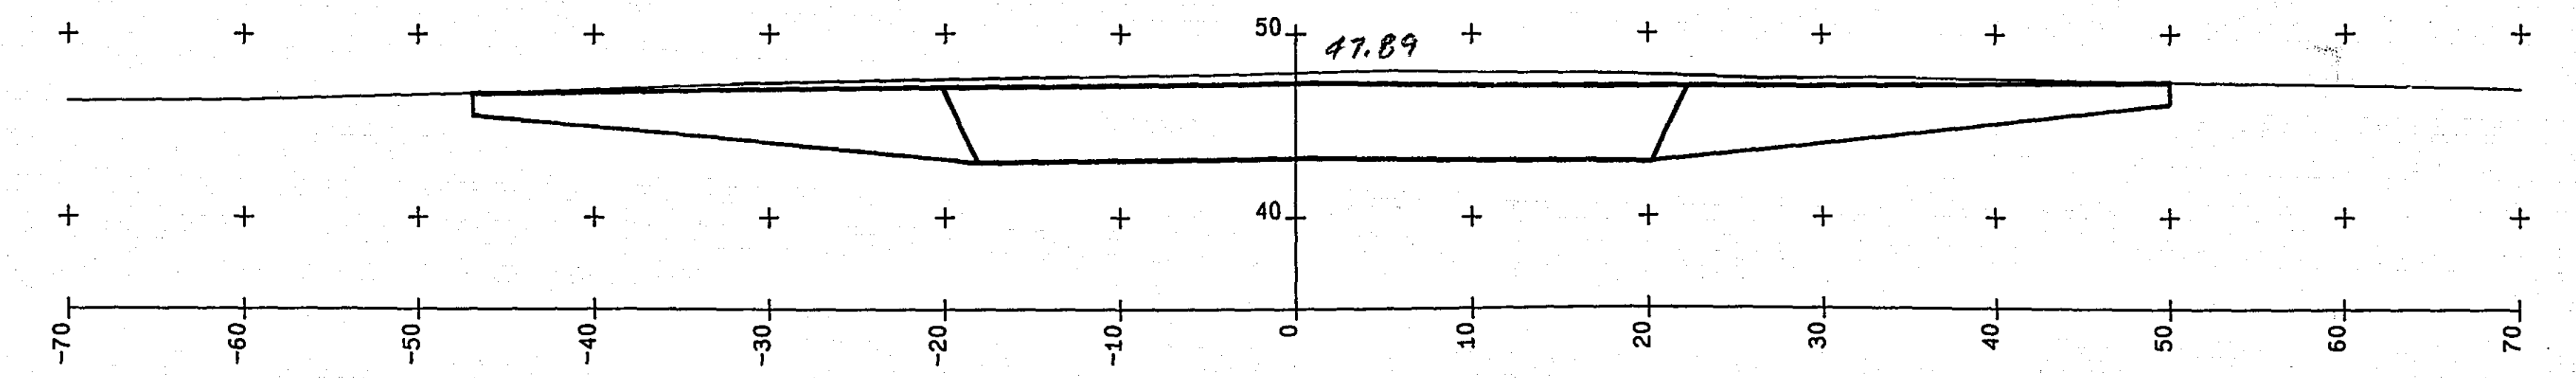


5+95.00

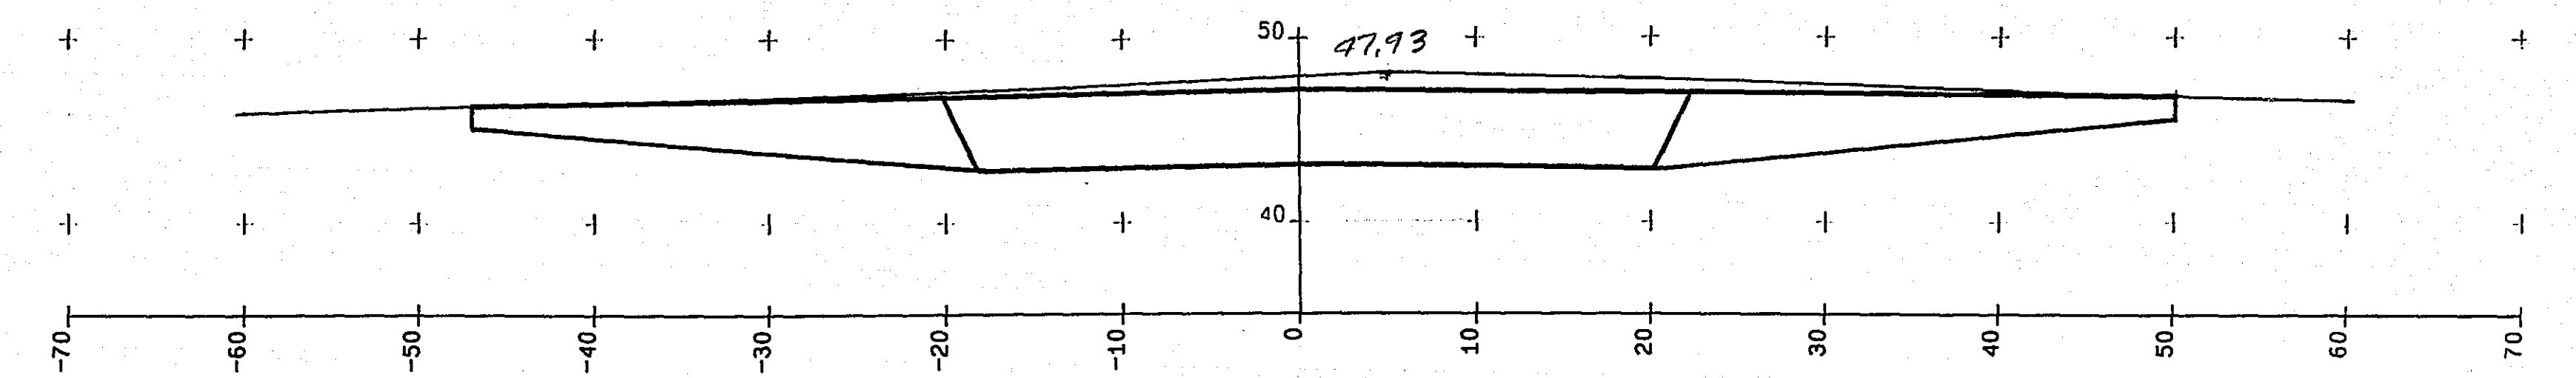


5+82.00

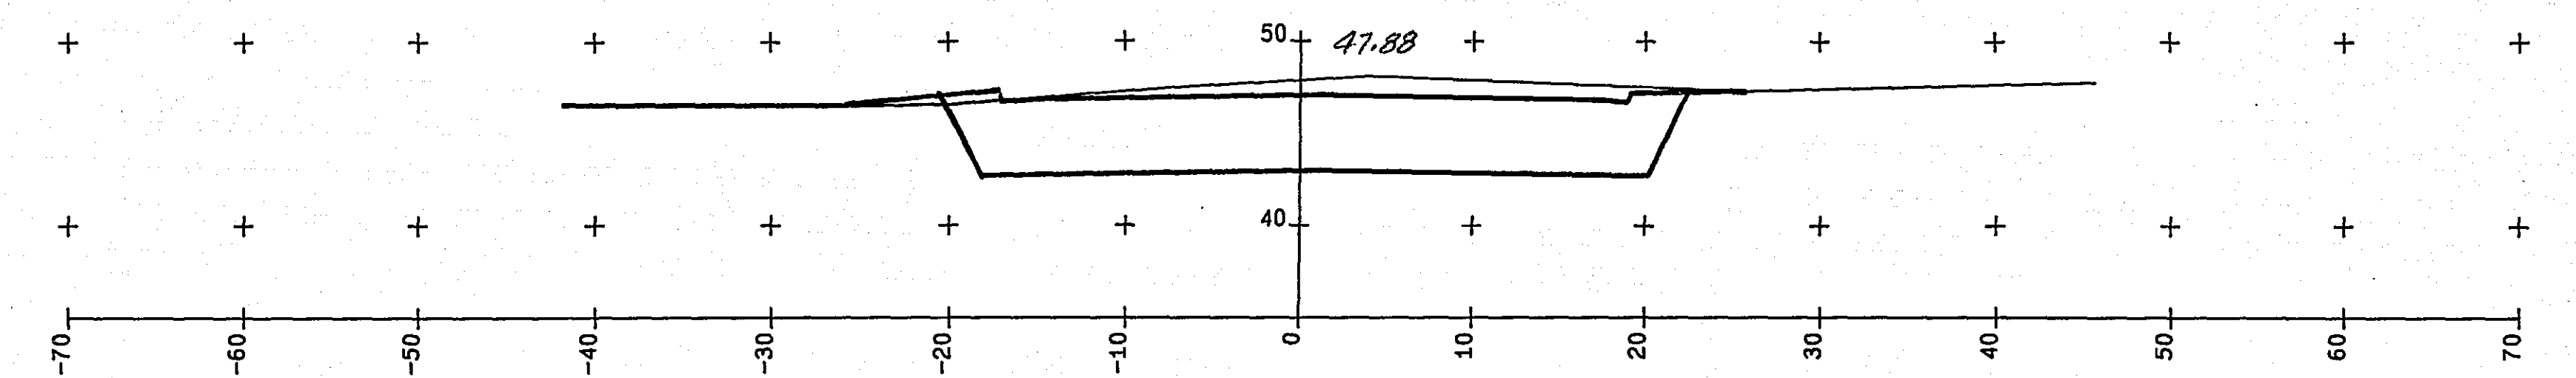


5+58.00

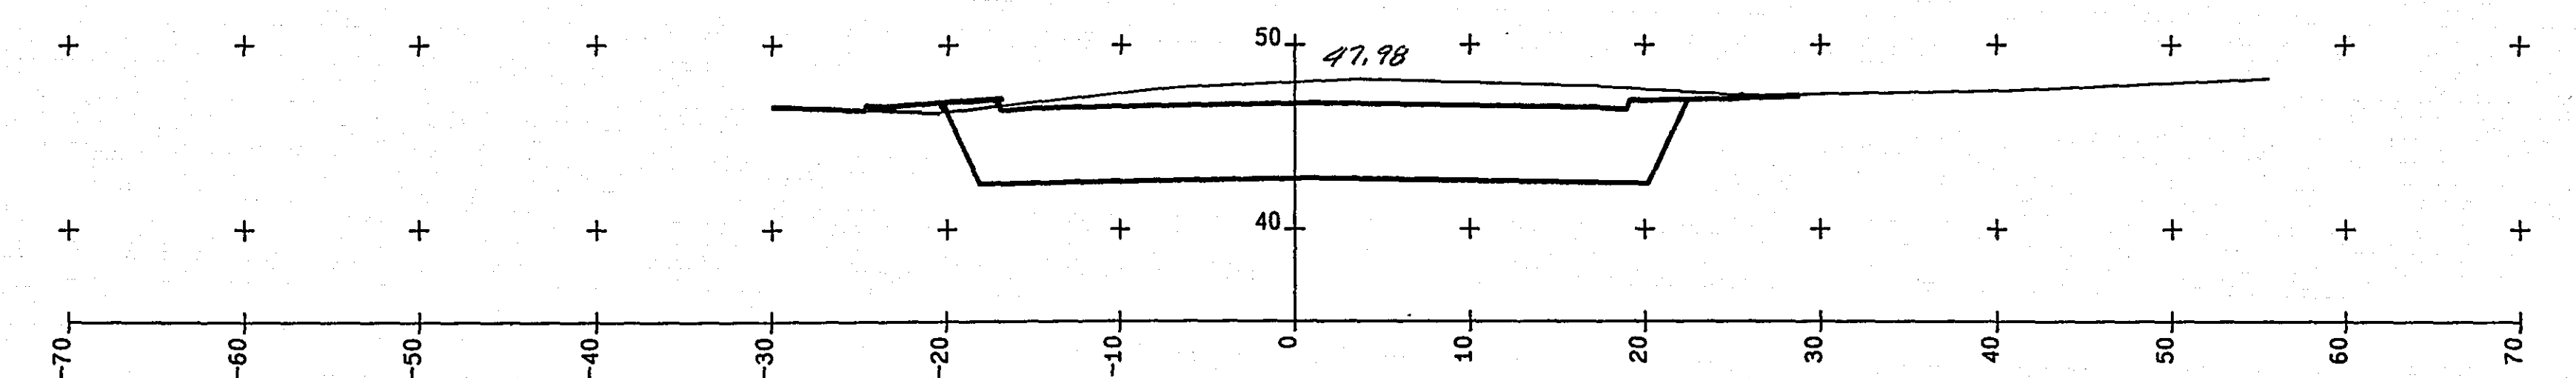


5+04.00

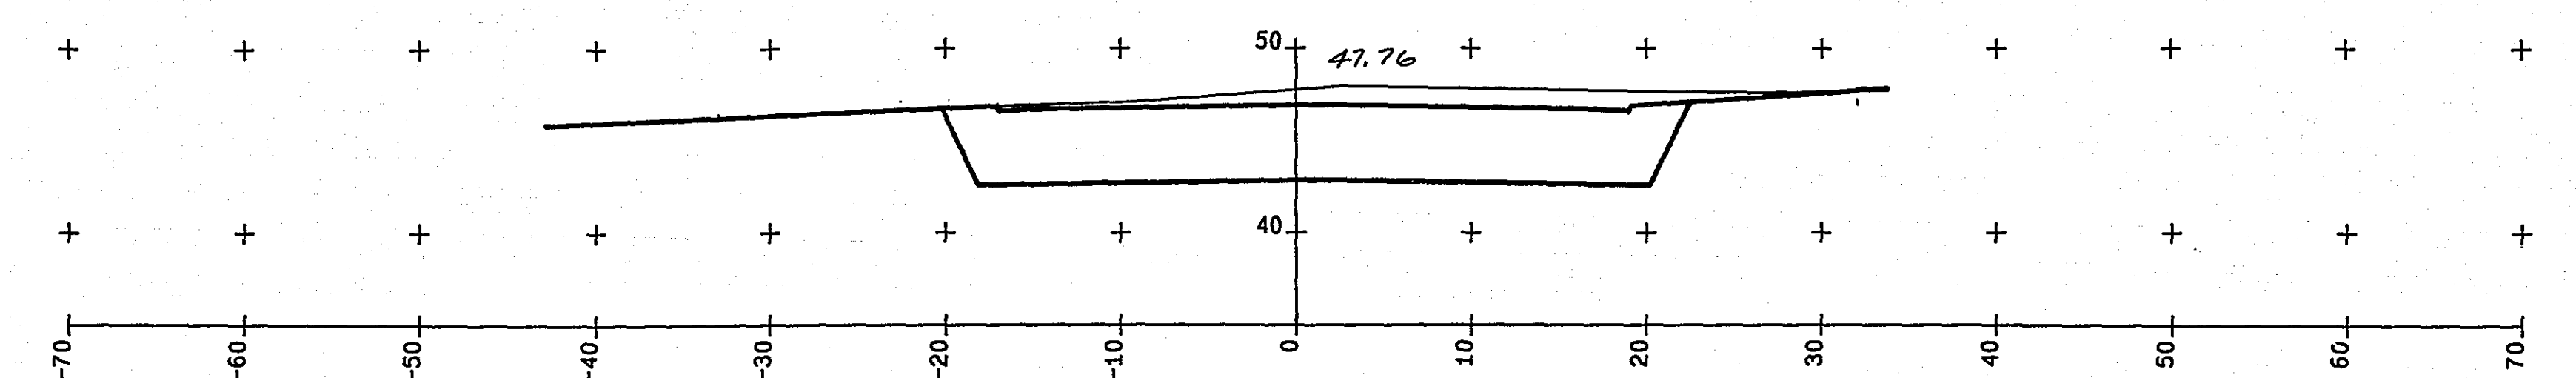


4+56.00

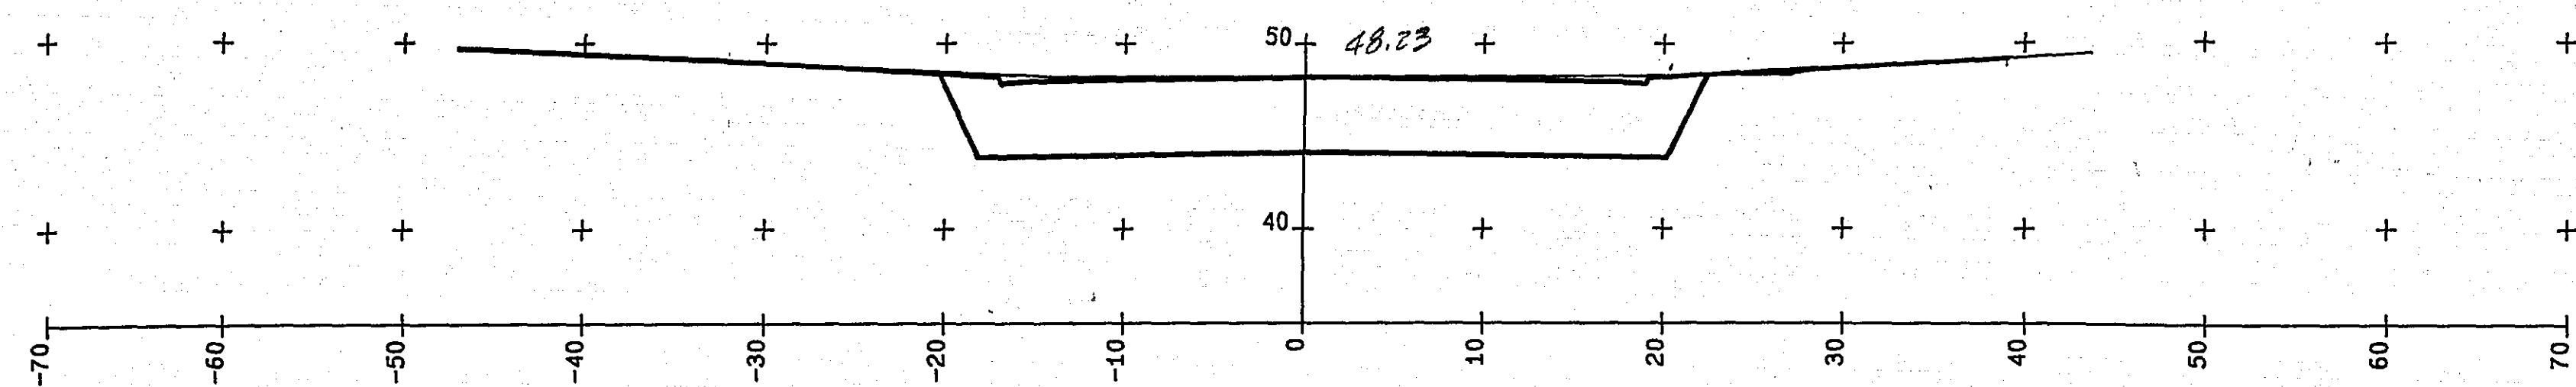


7+52.00

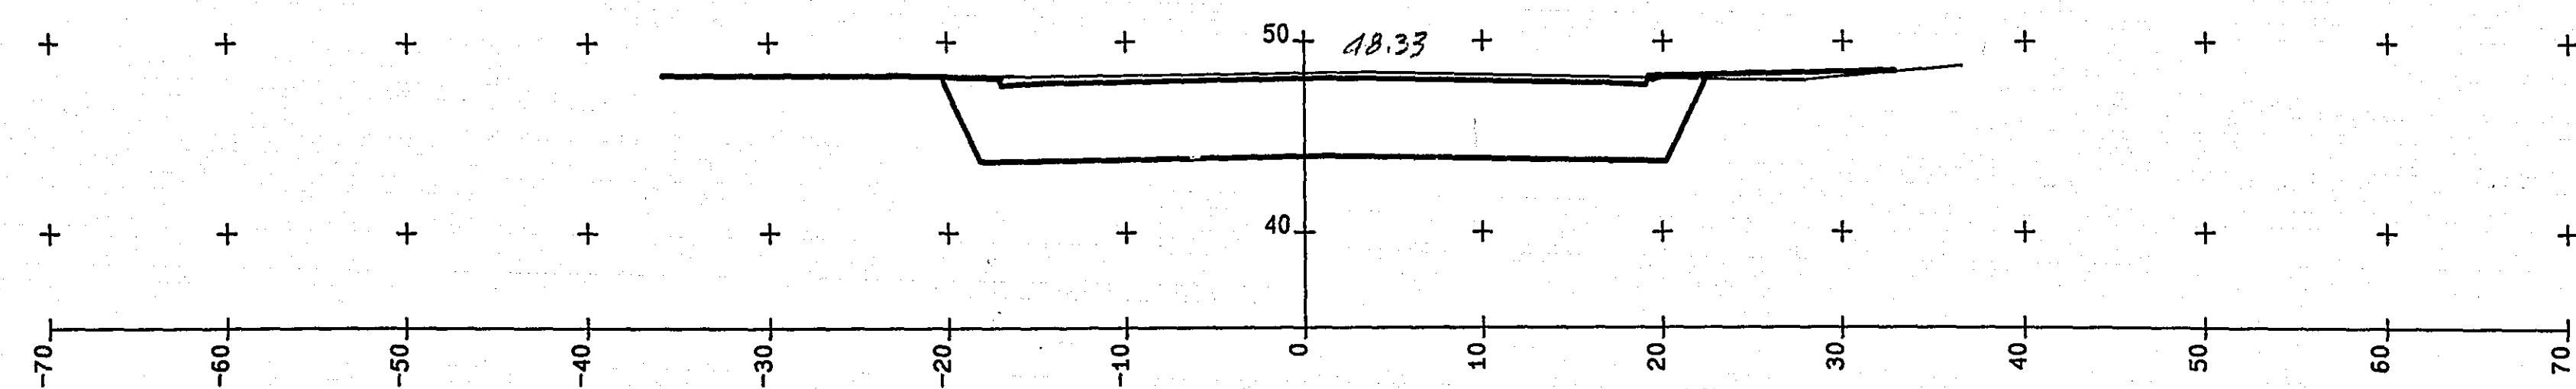


7+28.00

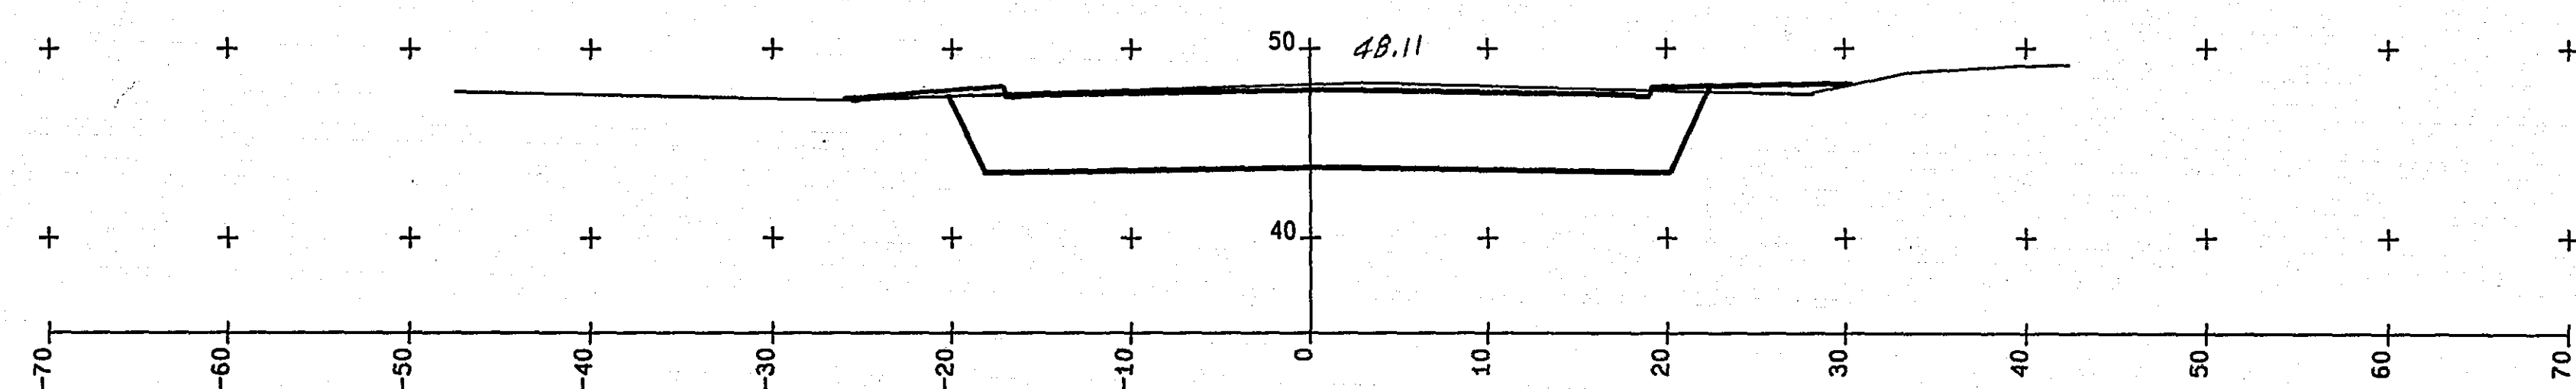


6+86.00

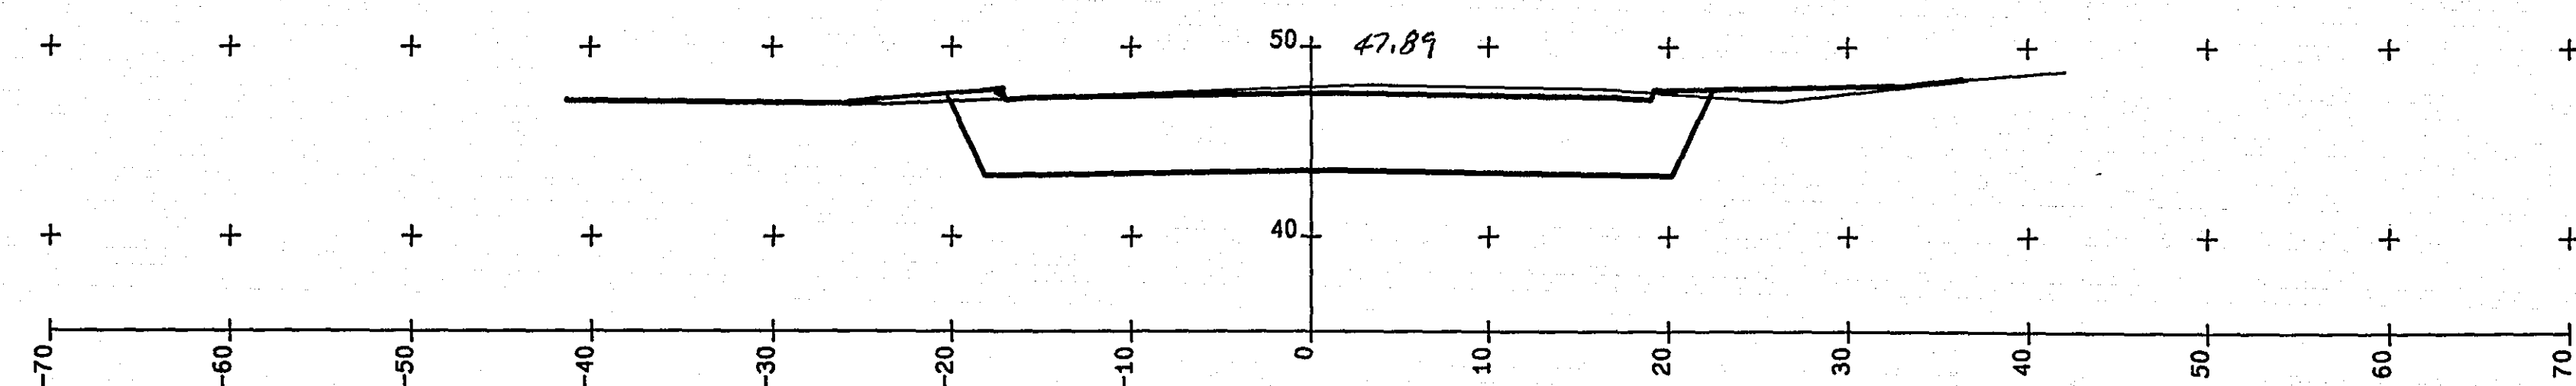


6+38.00

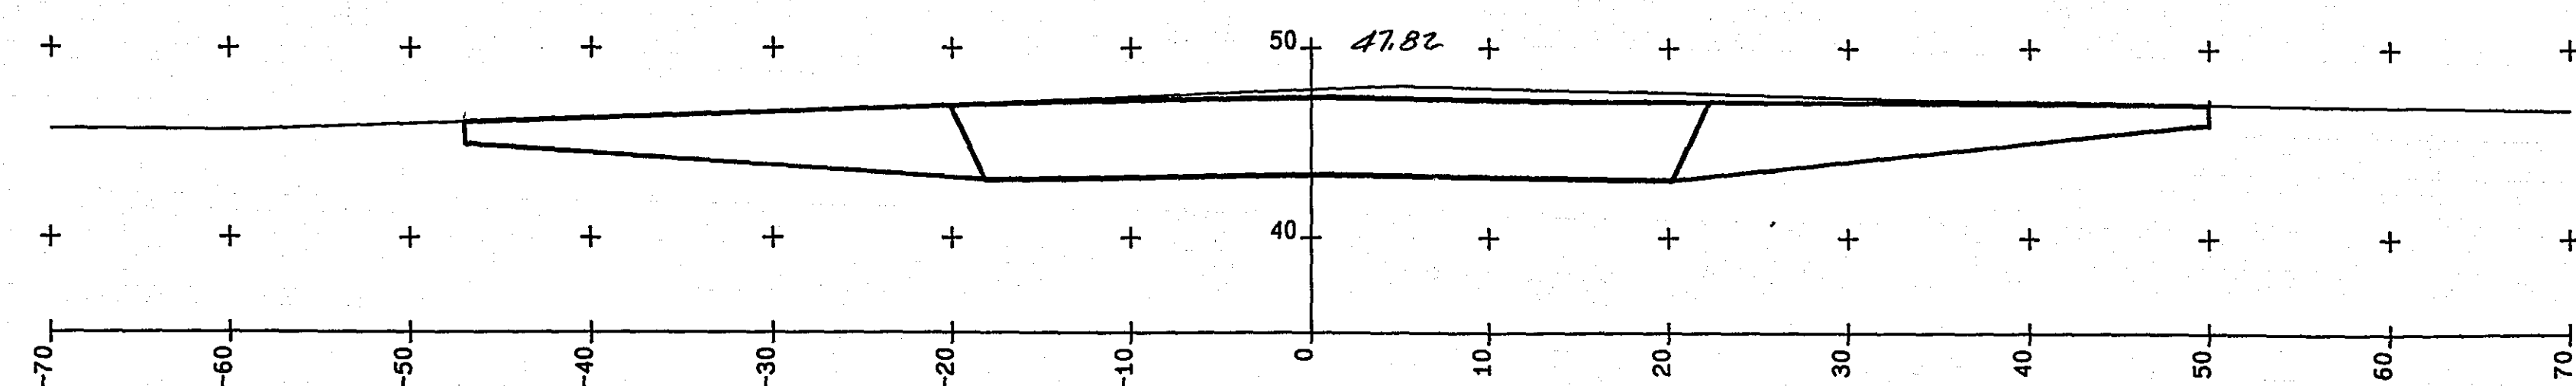


6+10.00

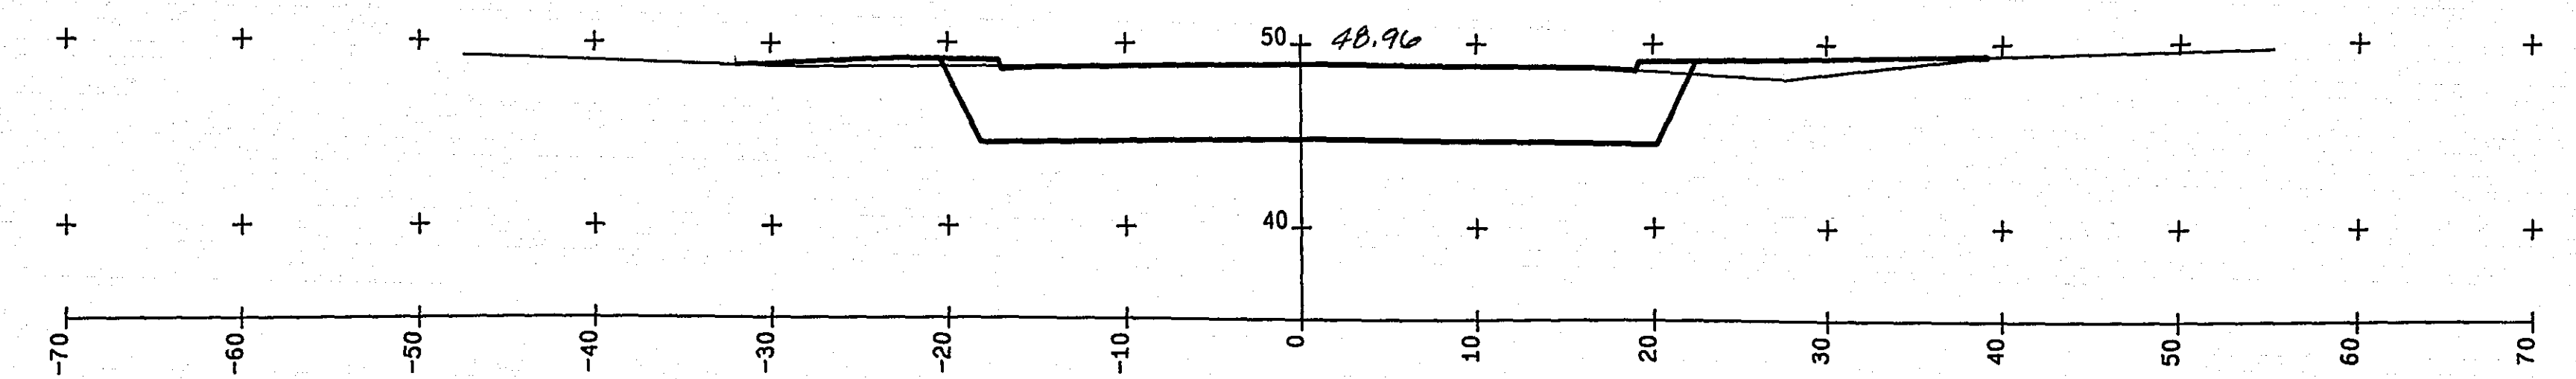


8+88.00

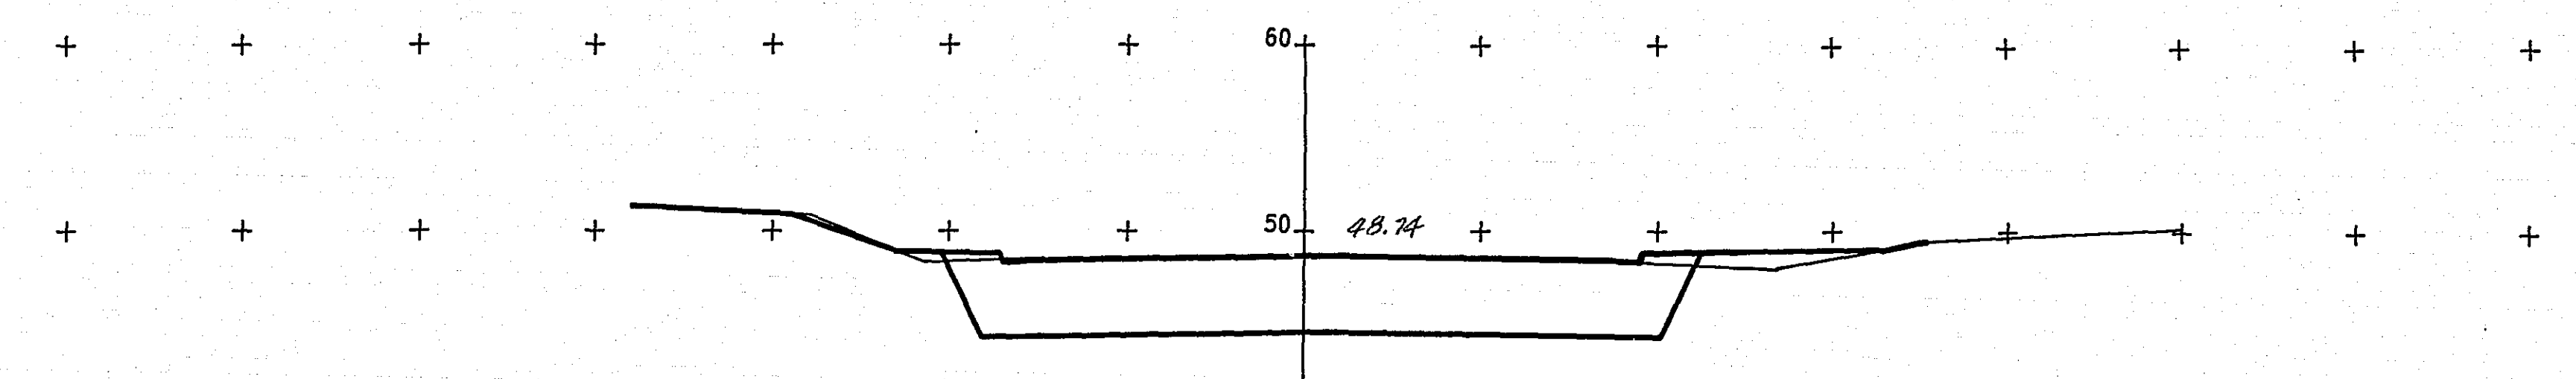










8+39.00

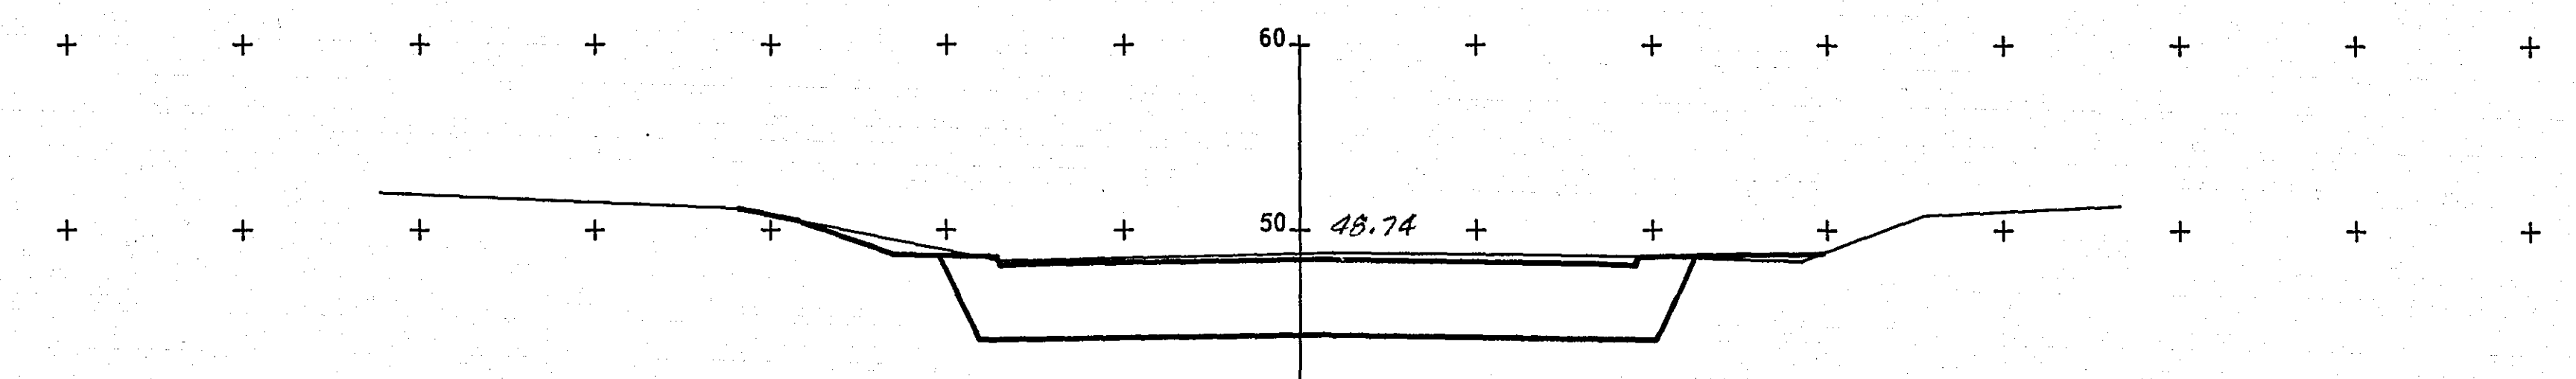


7+95.00

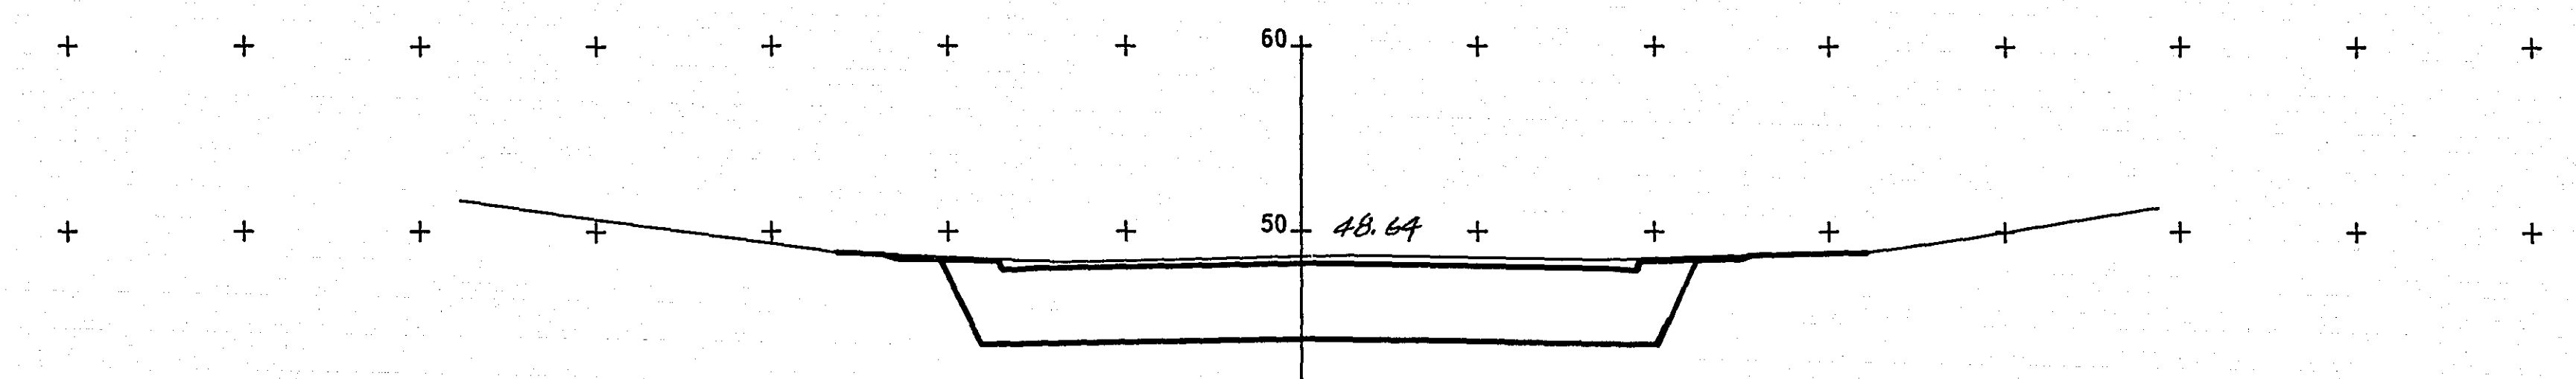


7+67.00

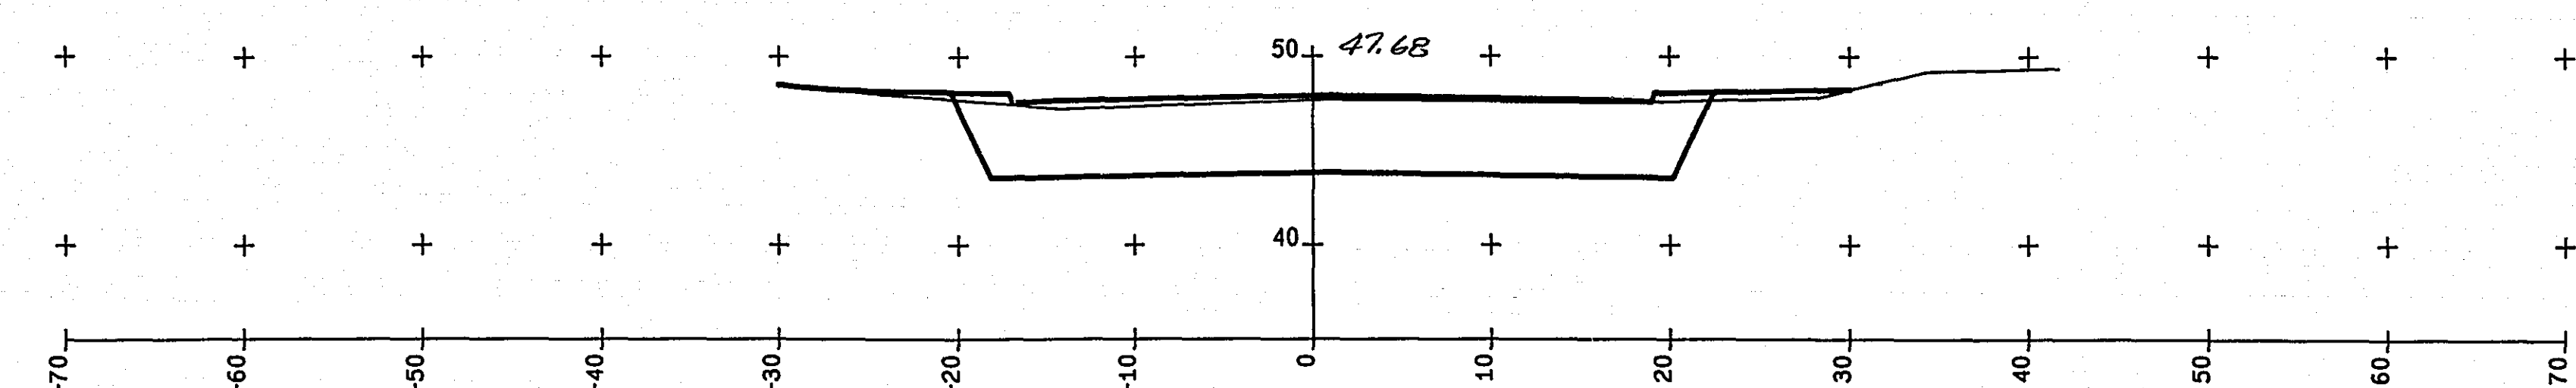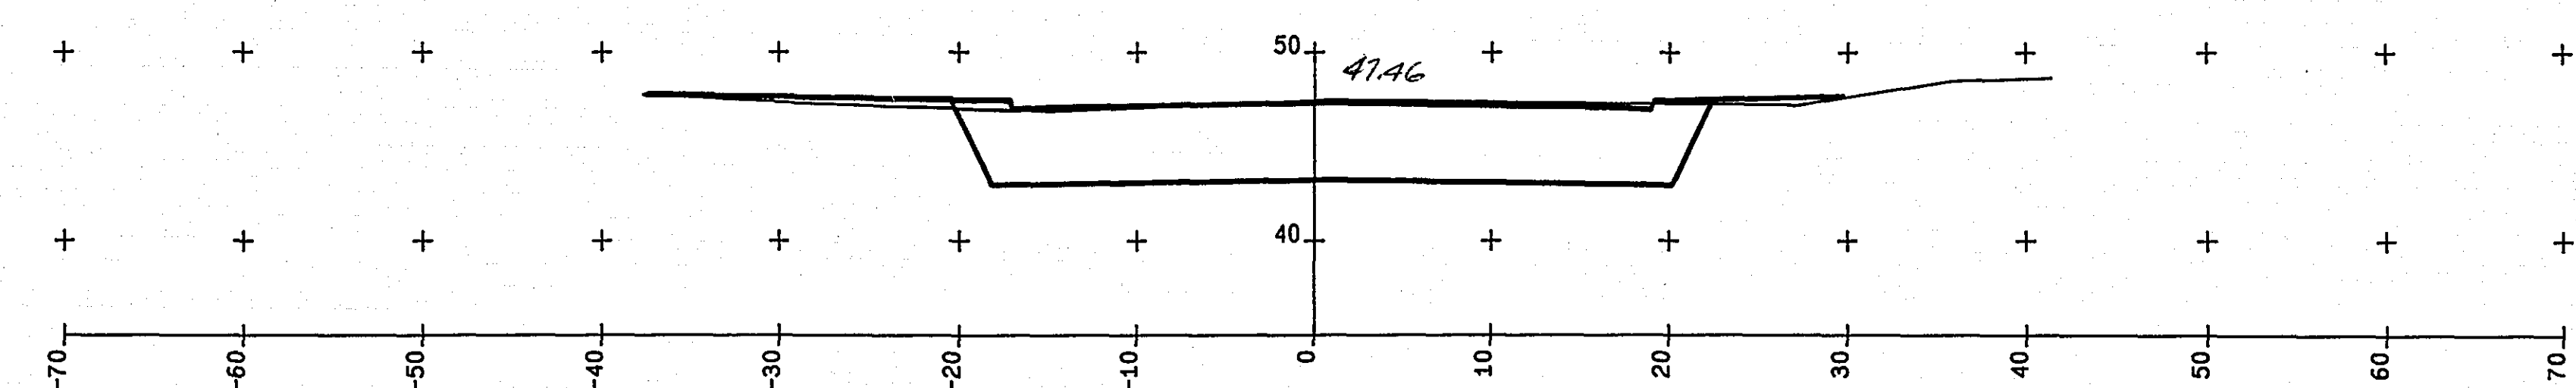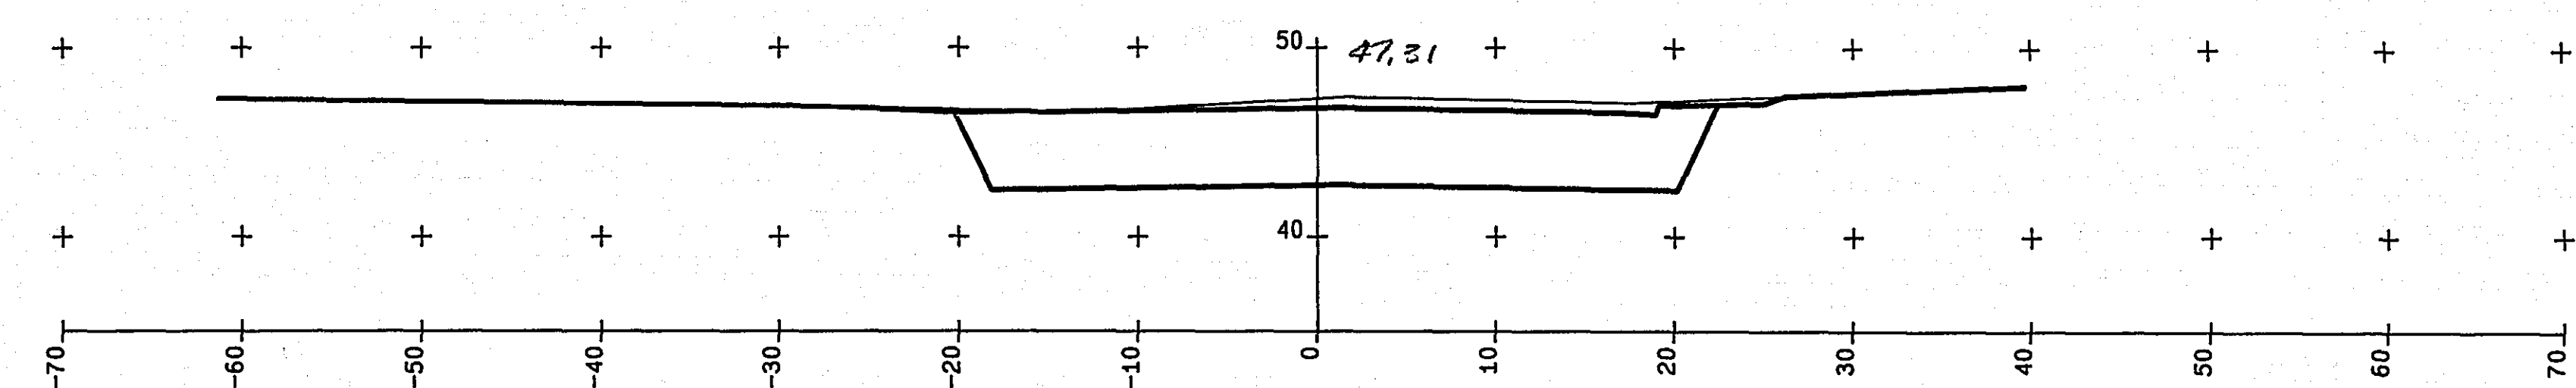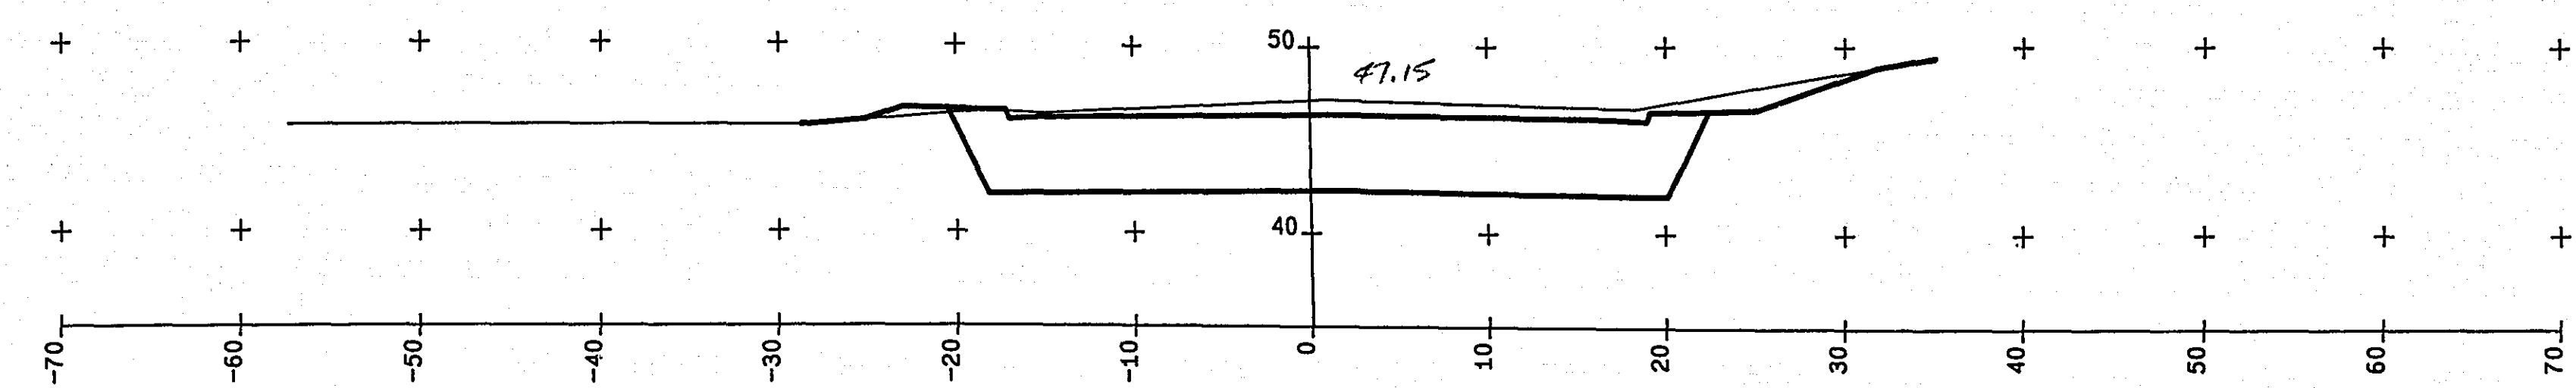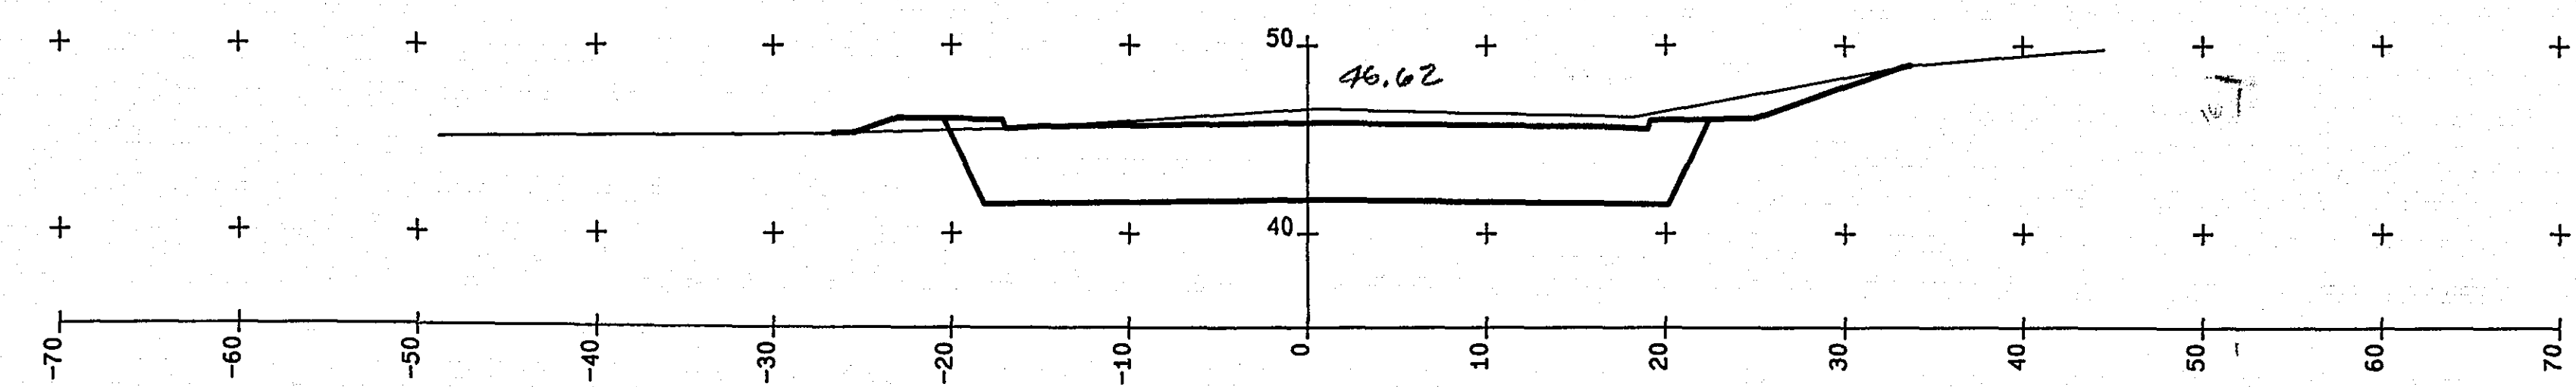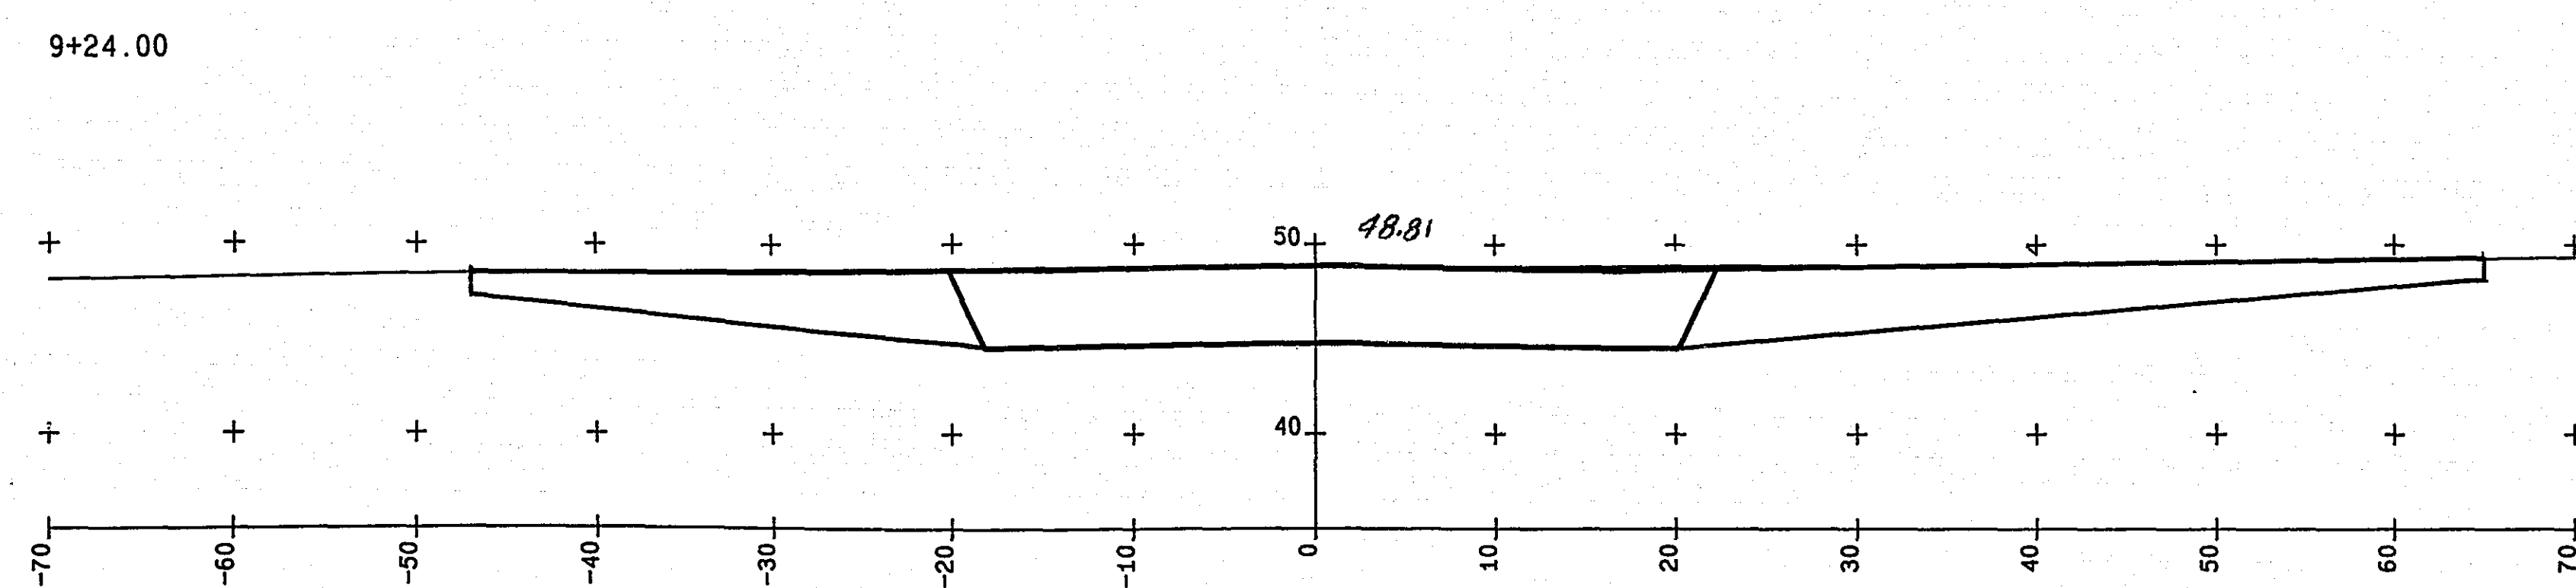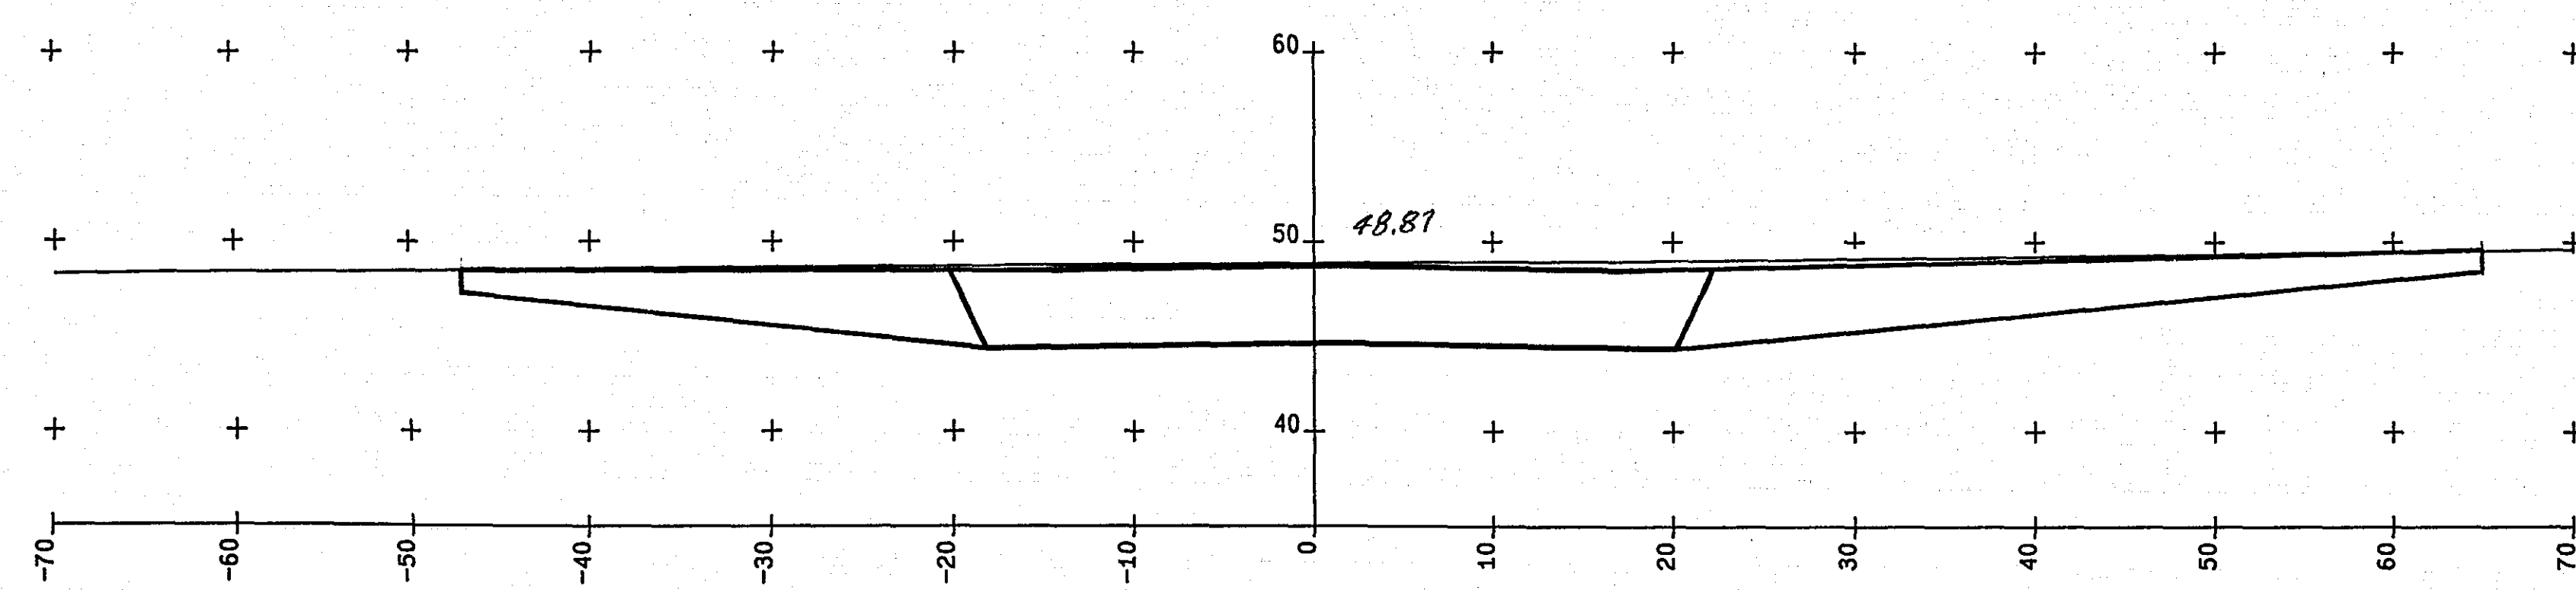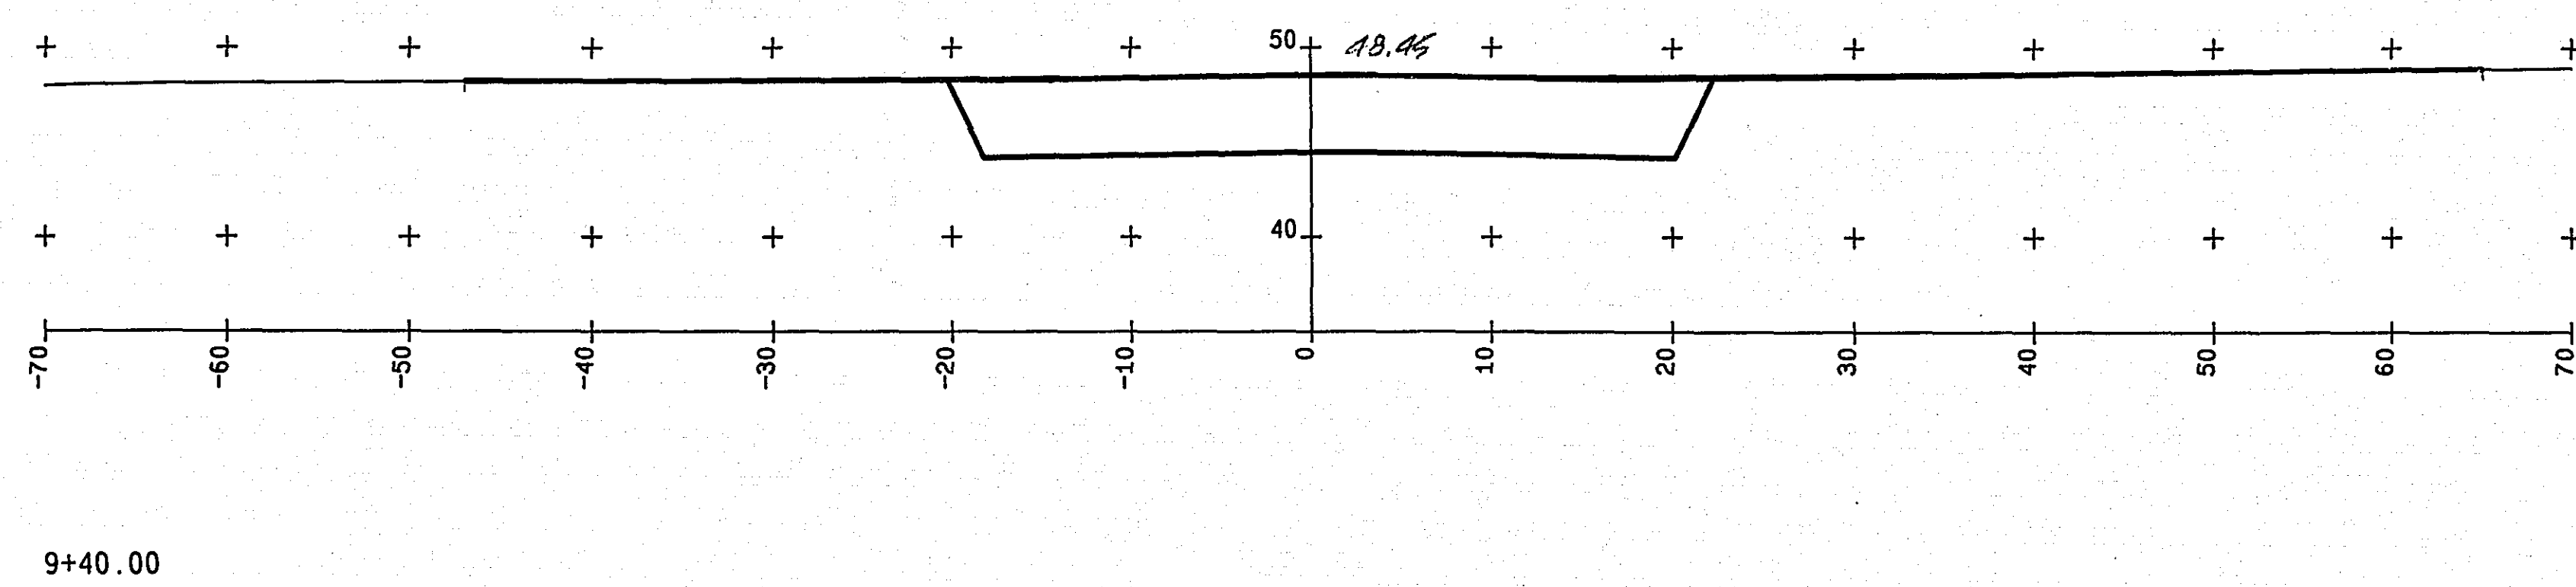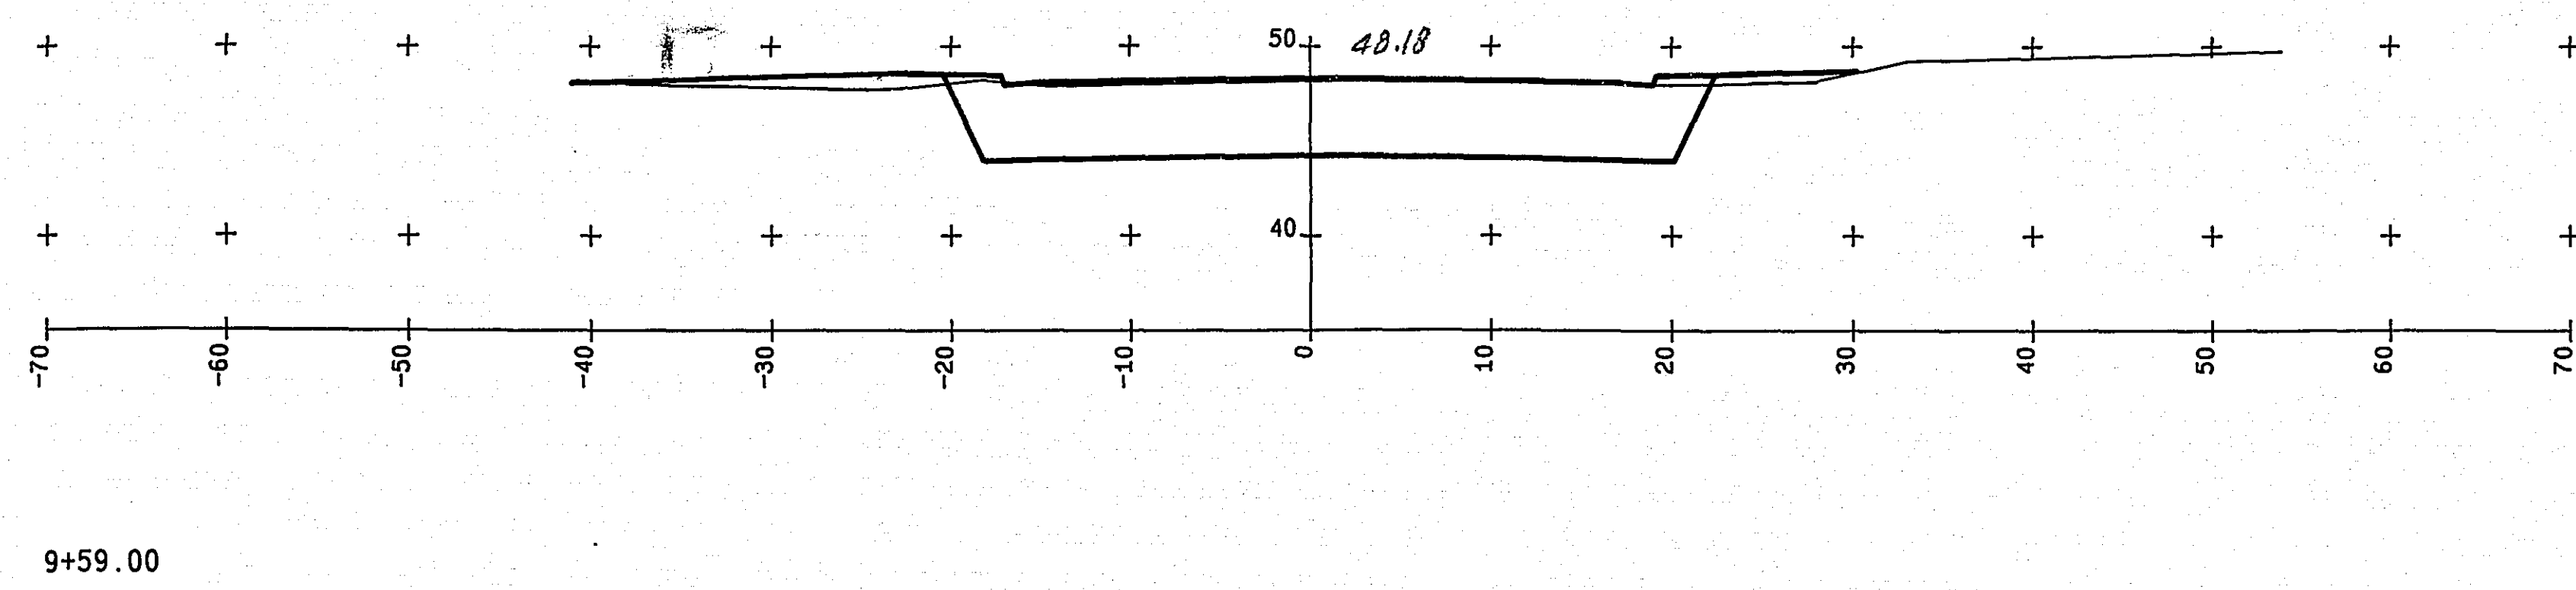


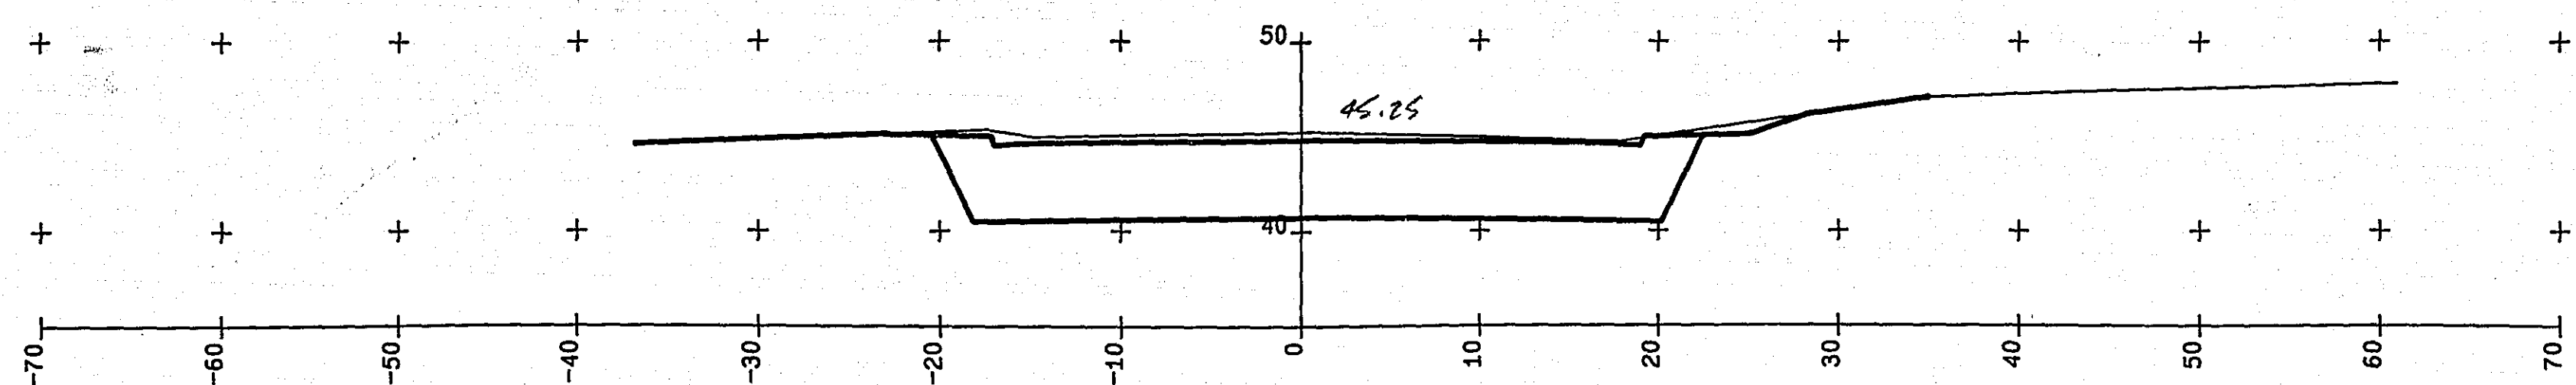


12+96.00

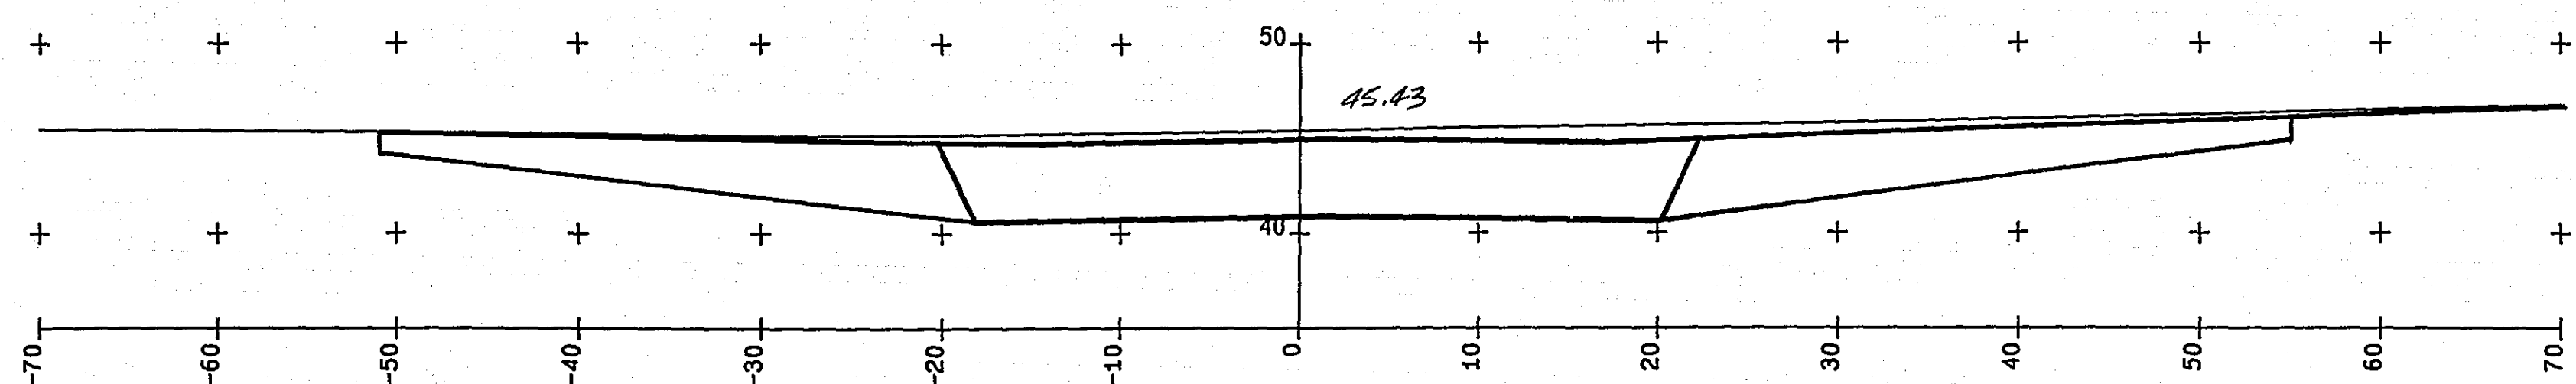


12+82.00

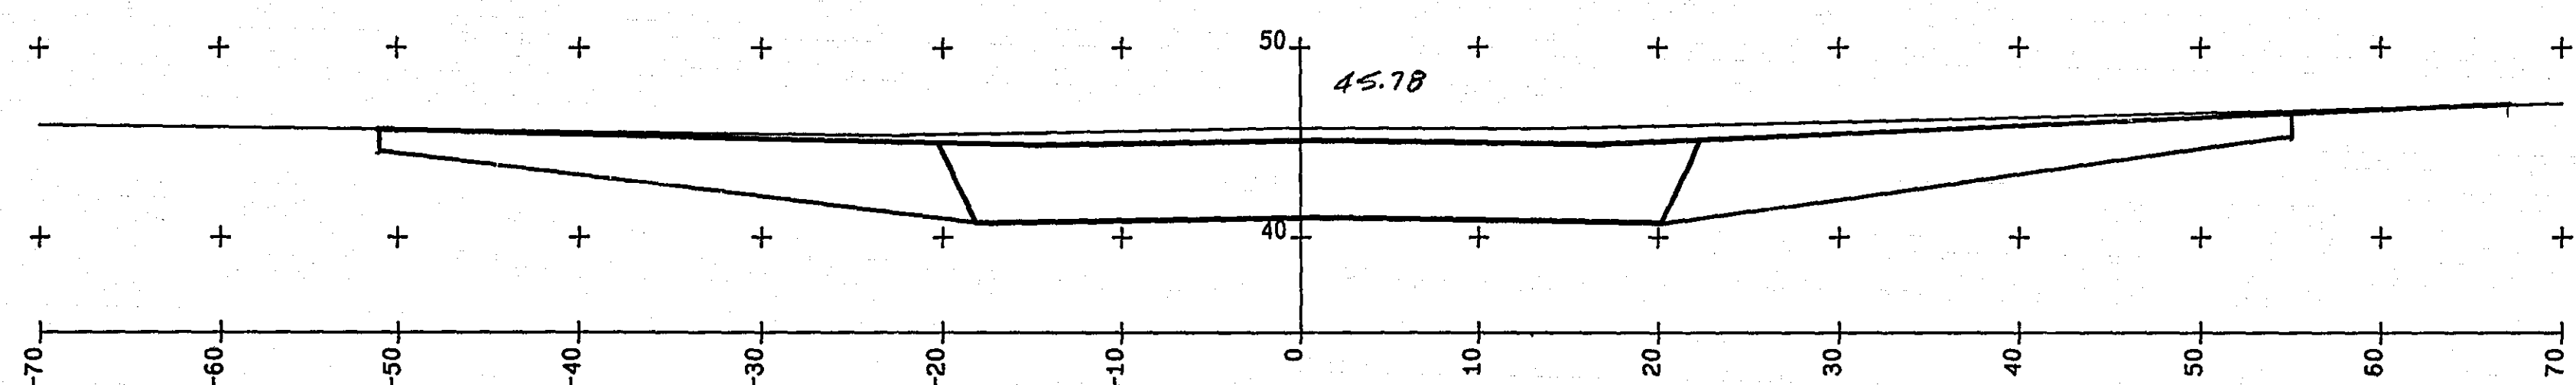


12+66.00

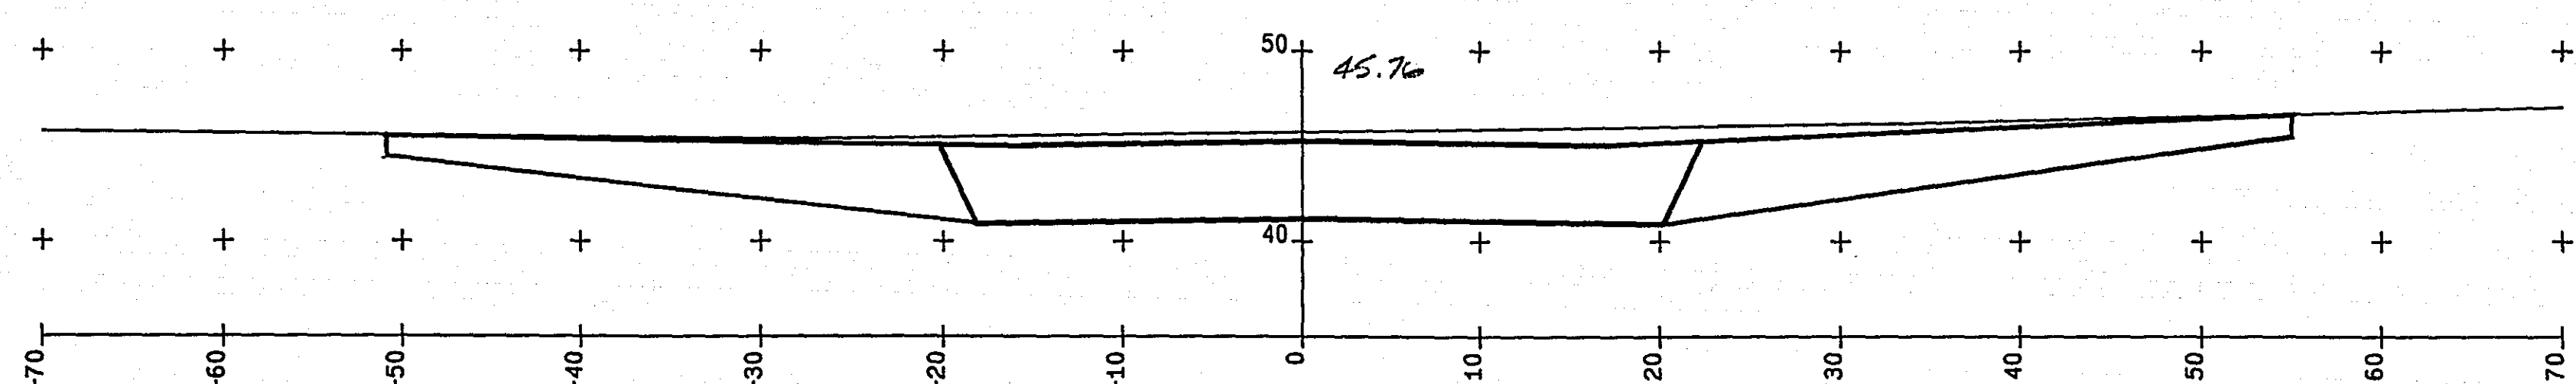


12+51.00

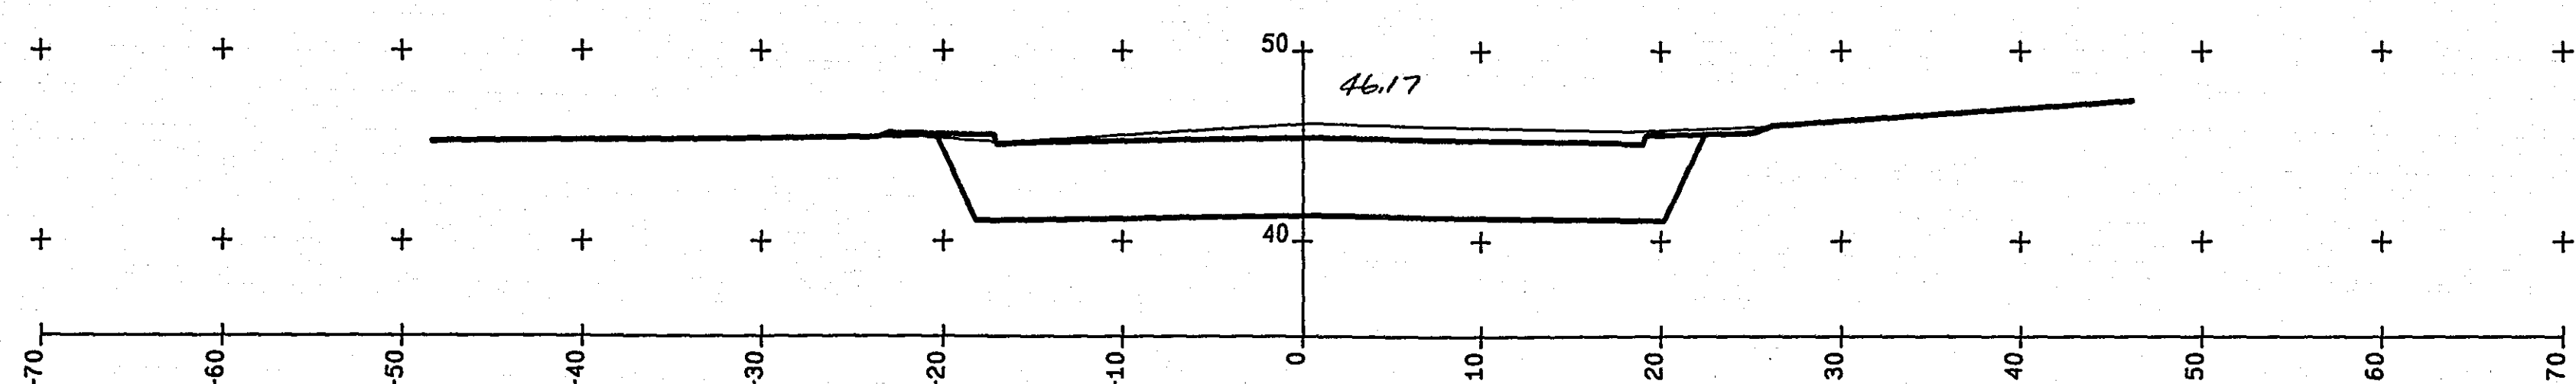


12+35.00

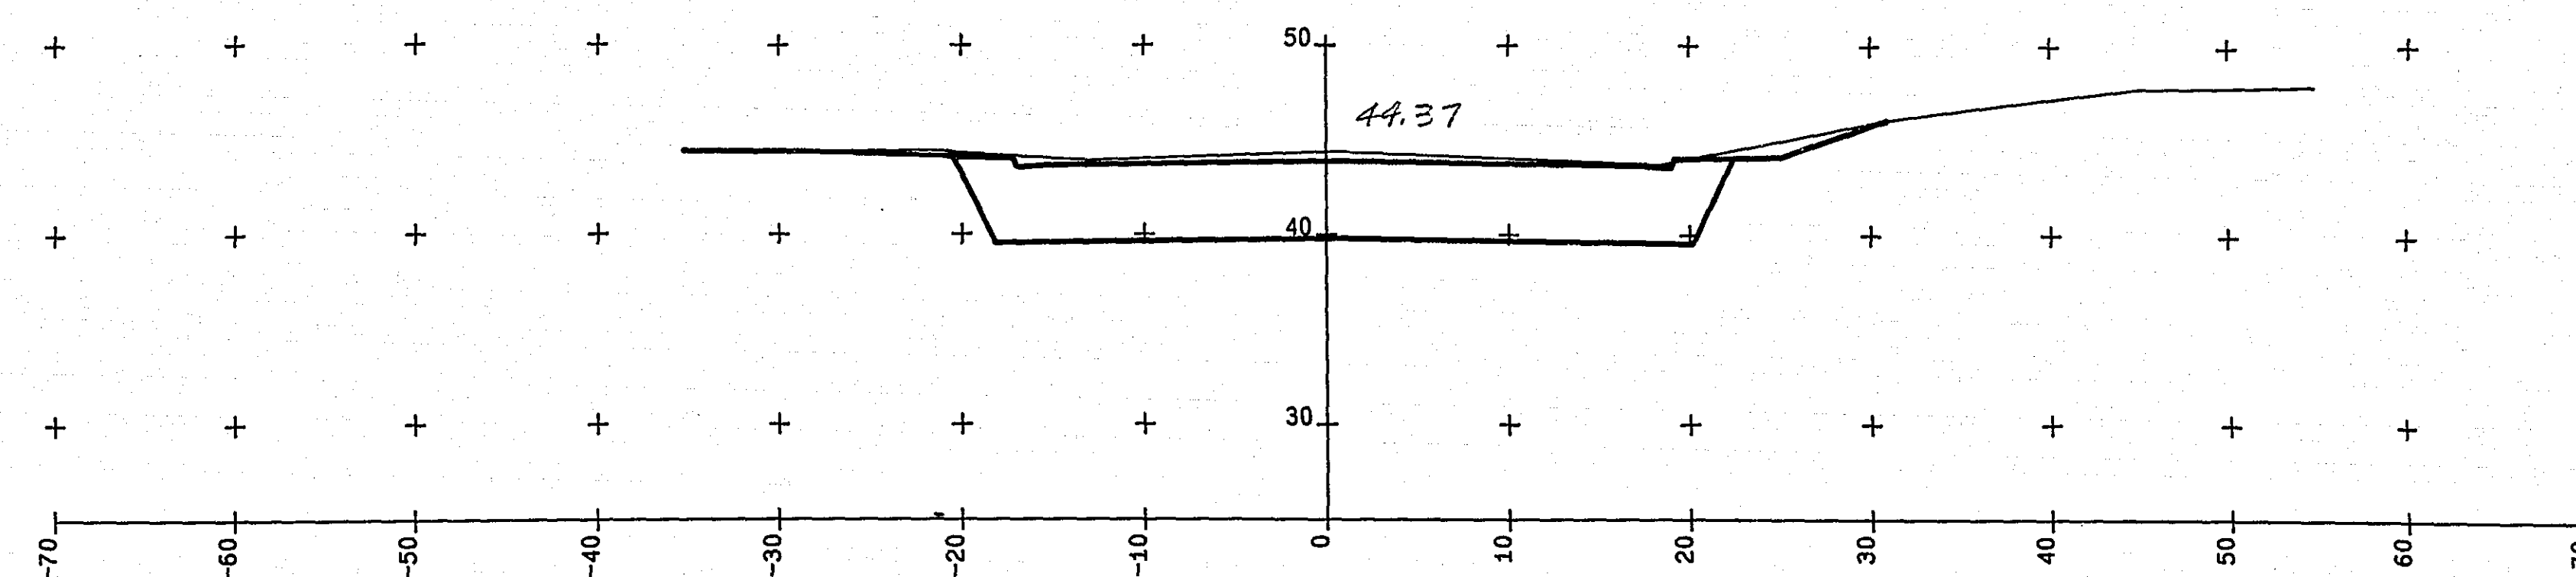


14+78.00

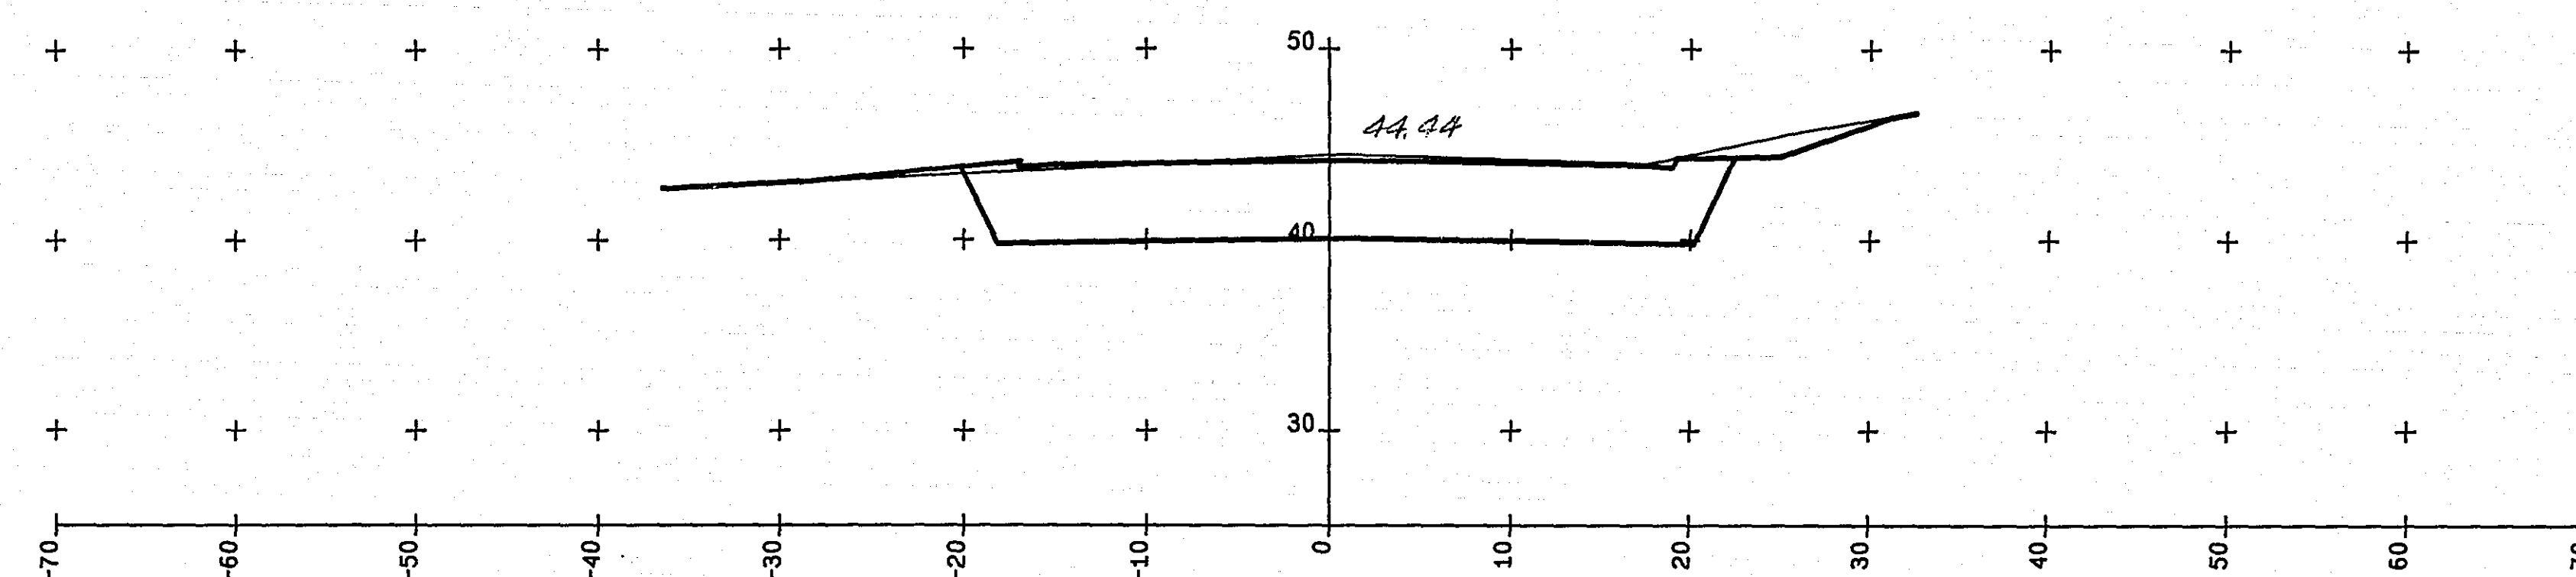


14+25.00

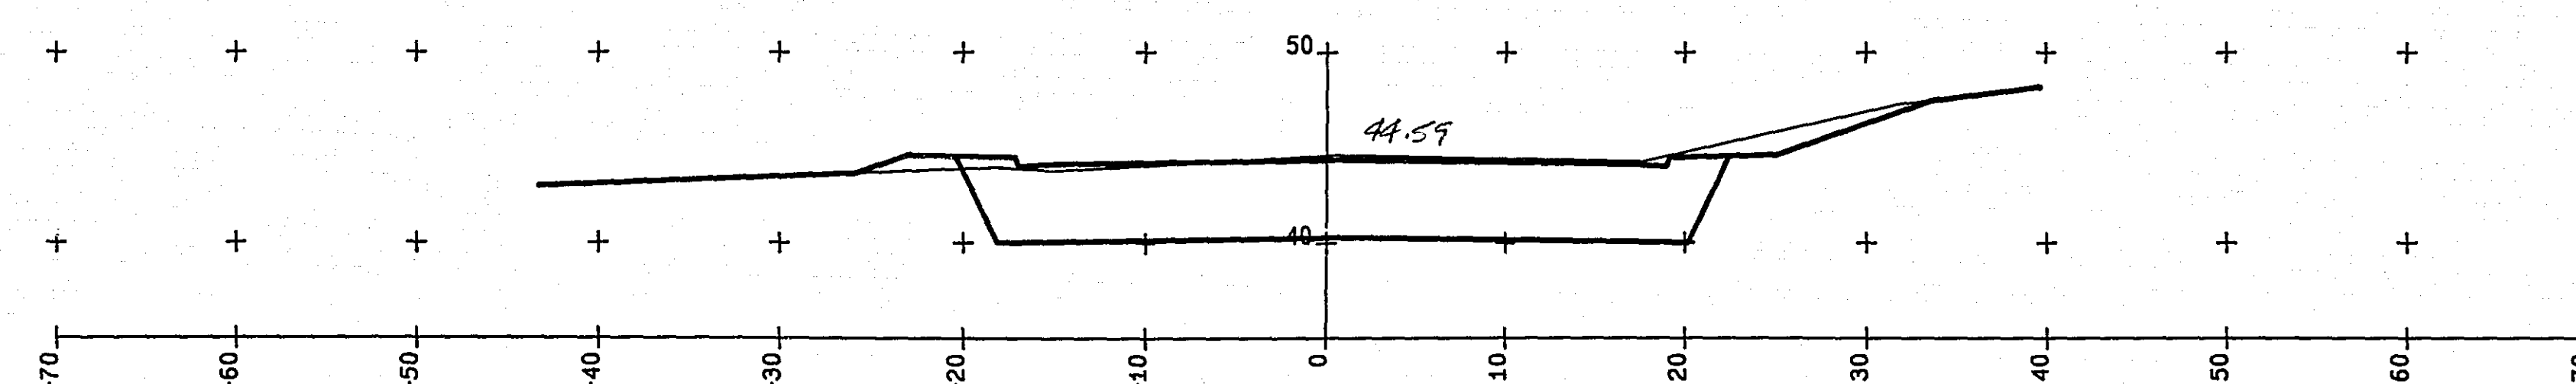


13+80.00

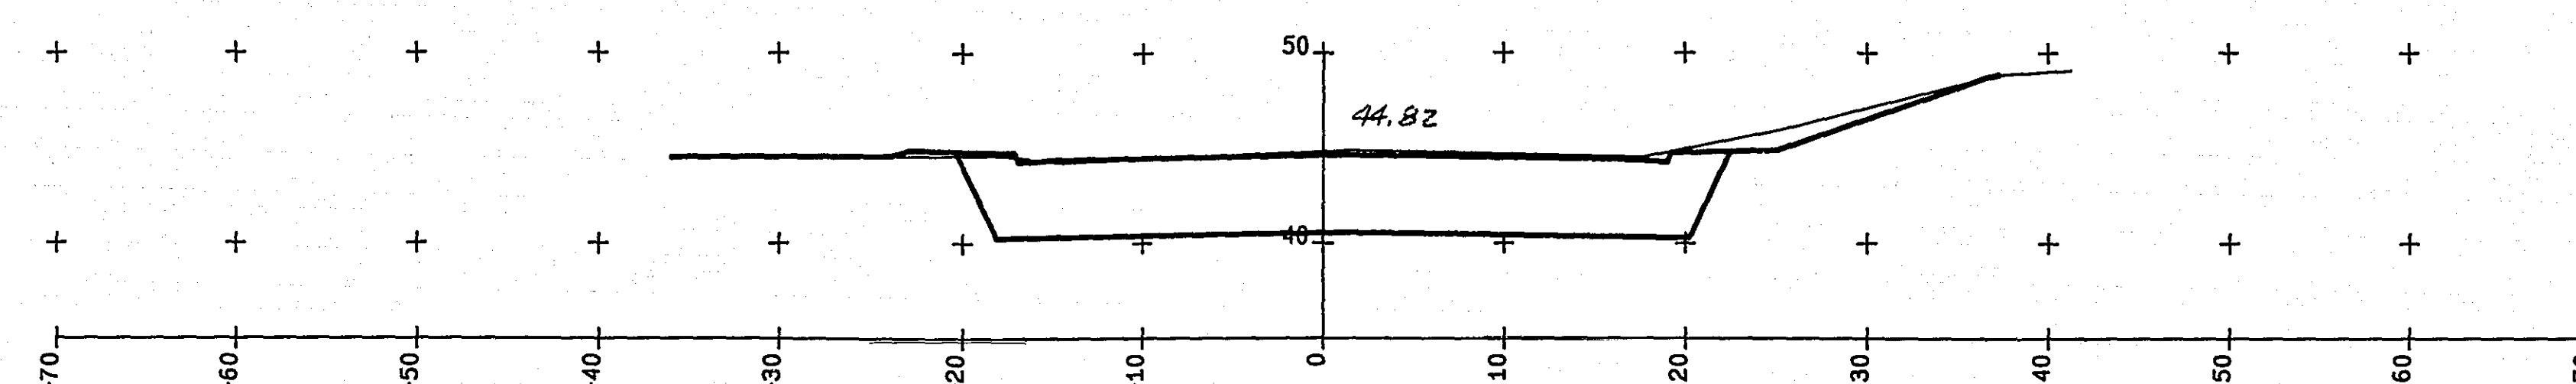


13+31.00

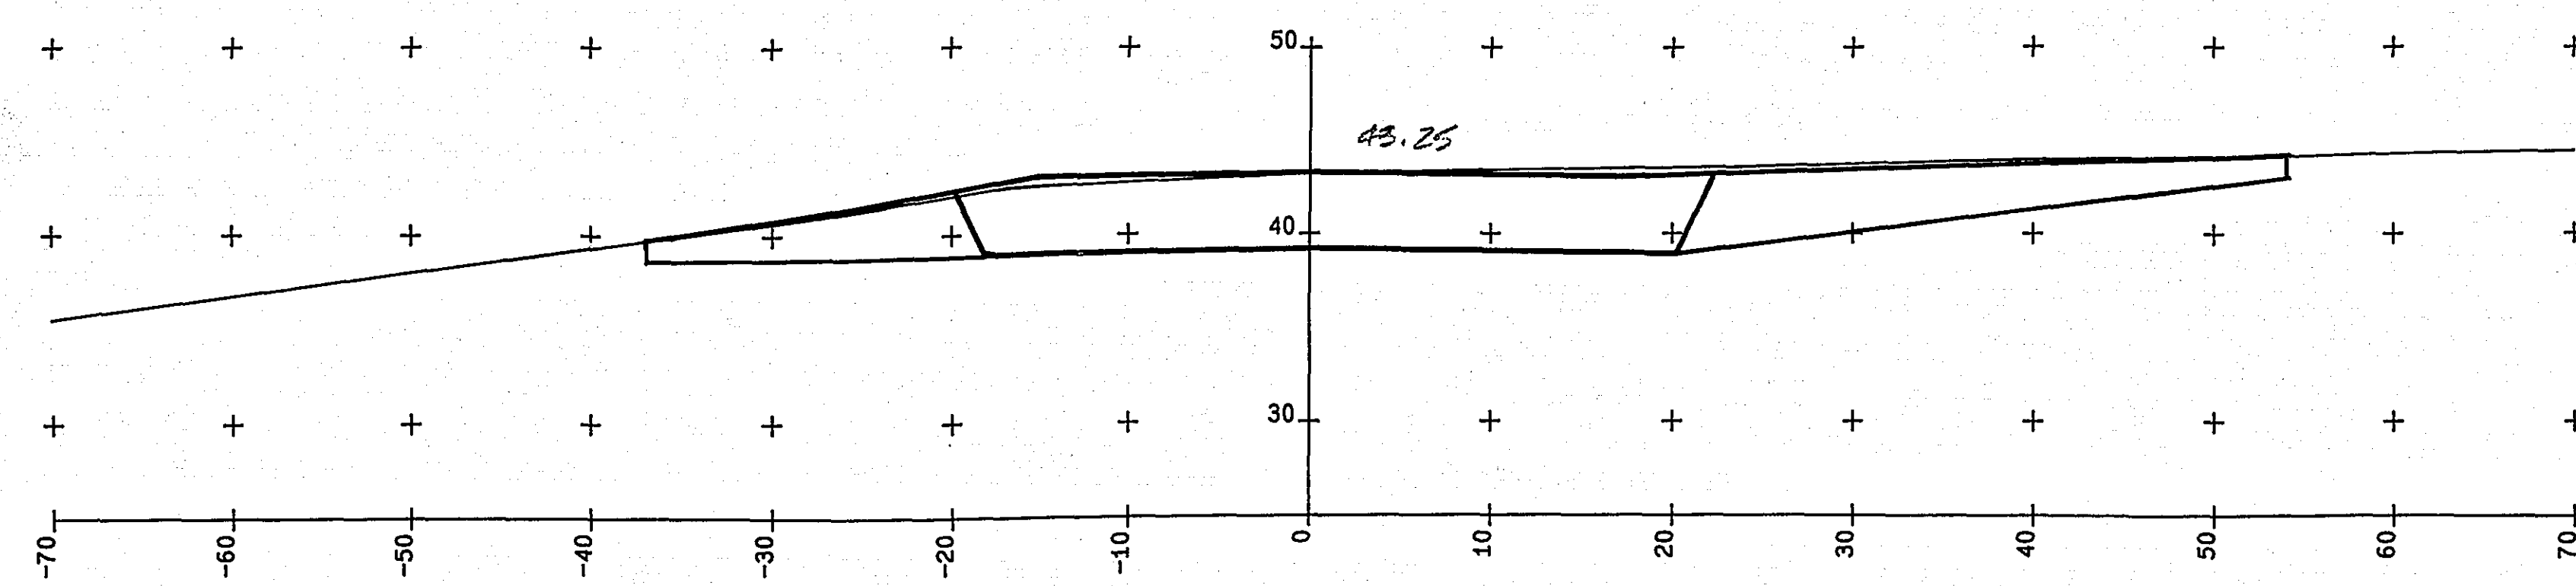


16+07.00

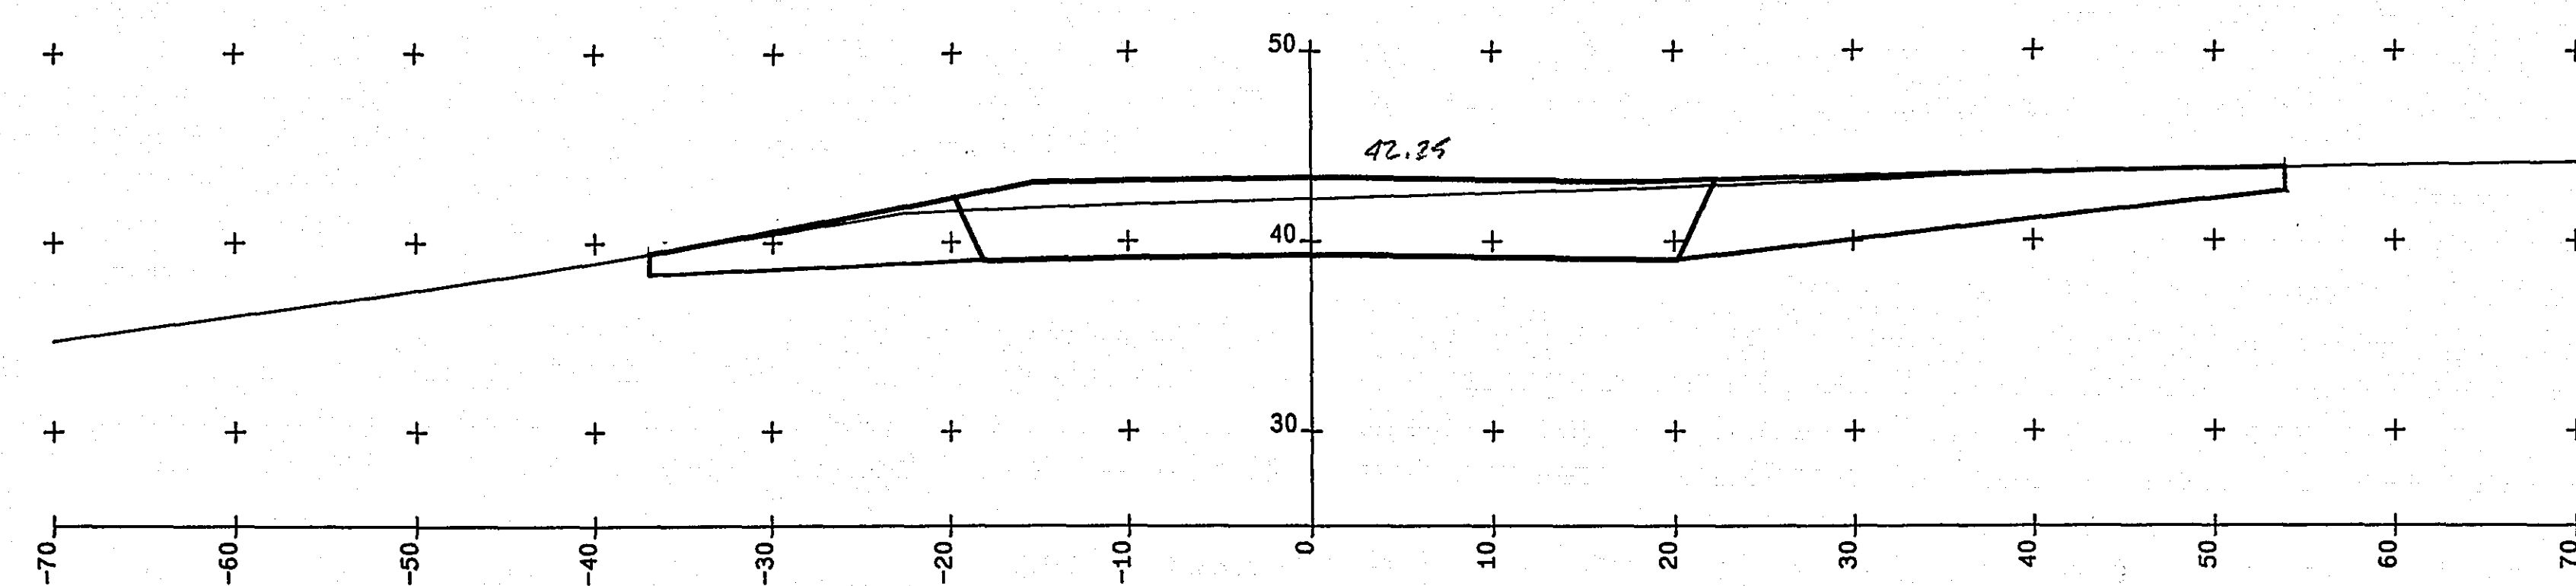


15+93.00

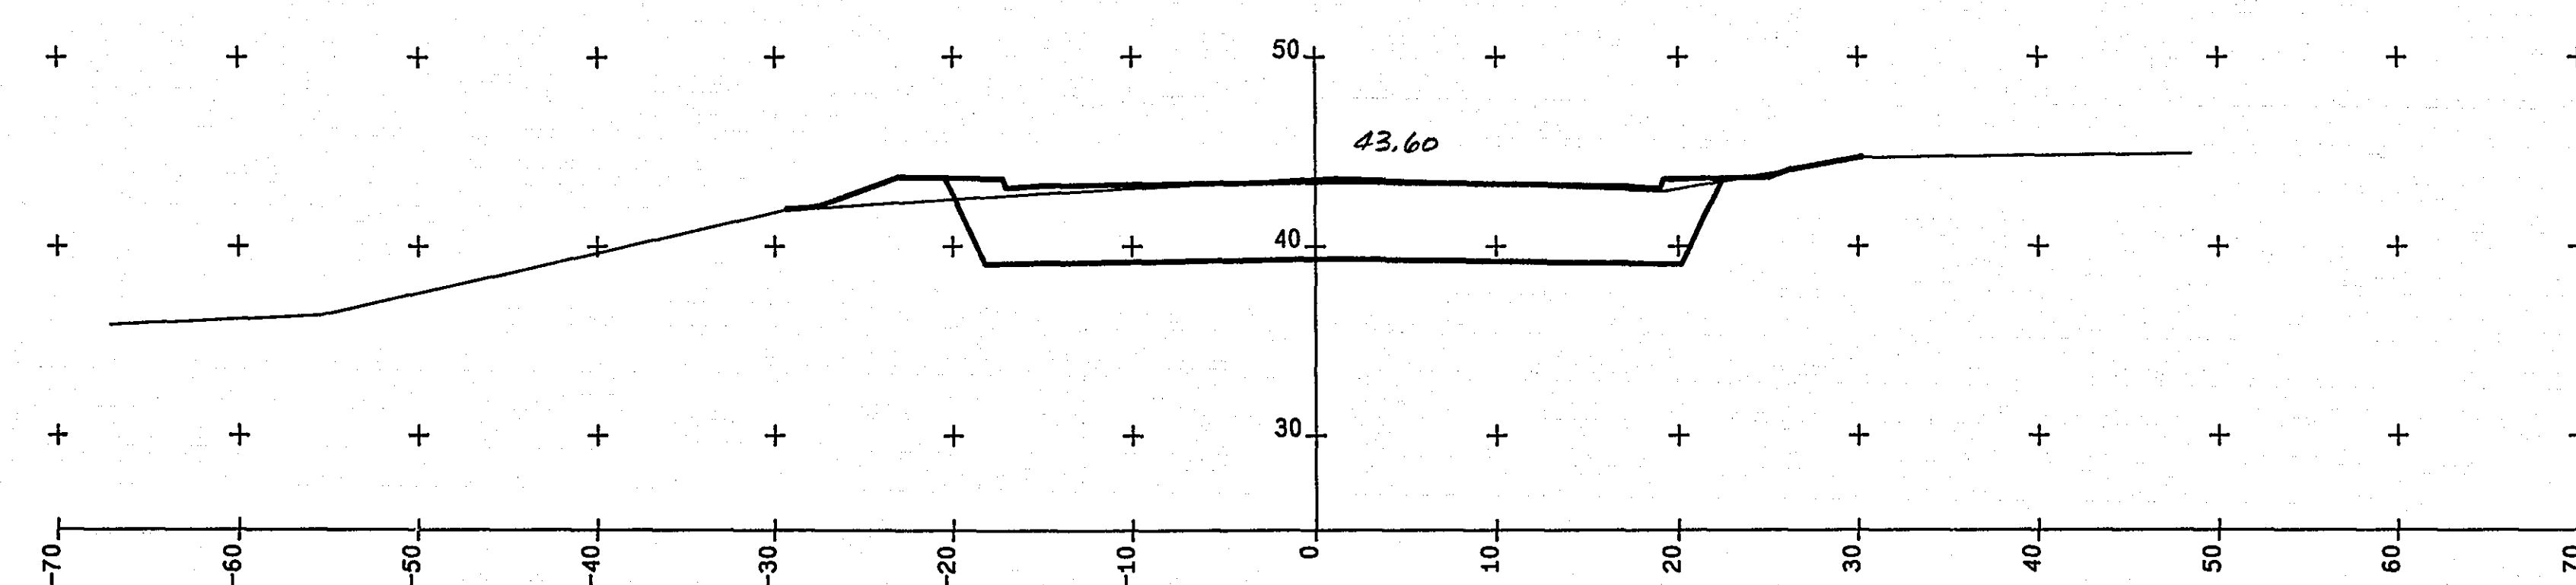


15+80.00

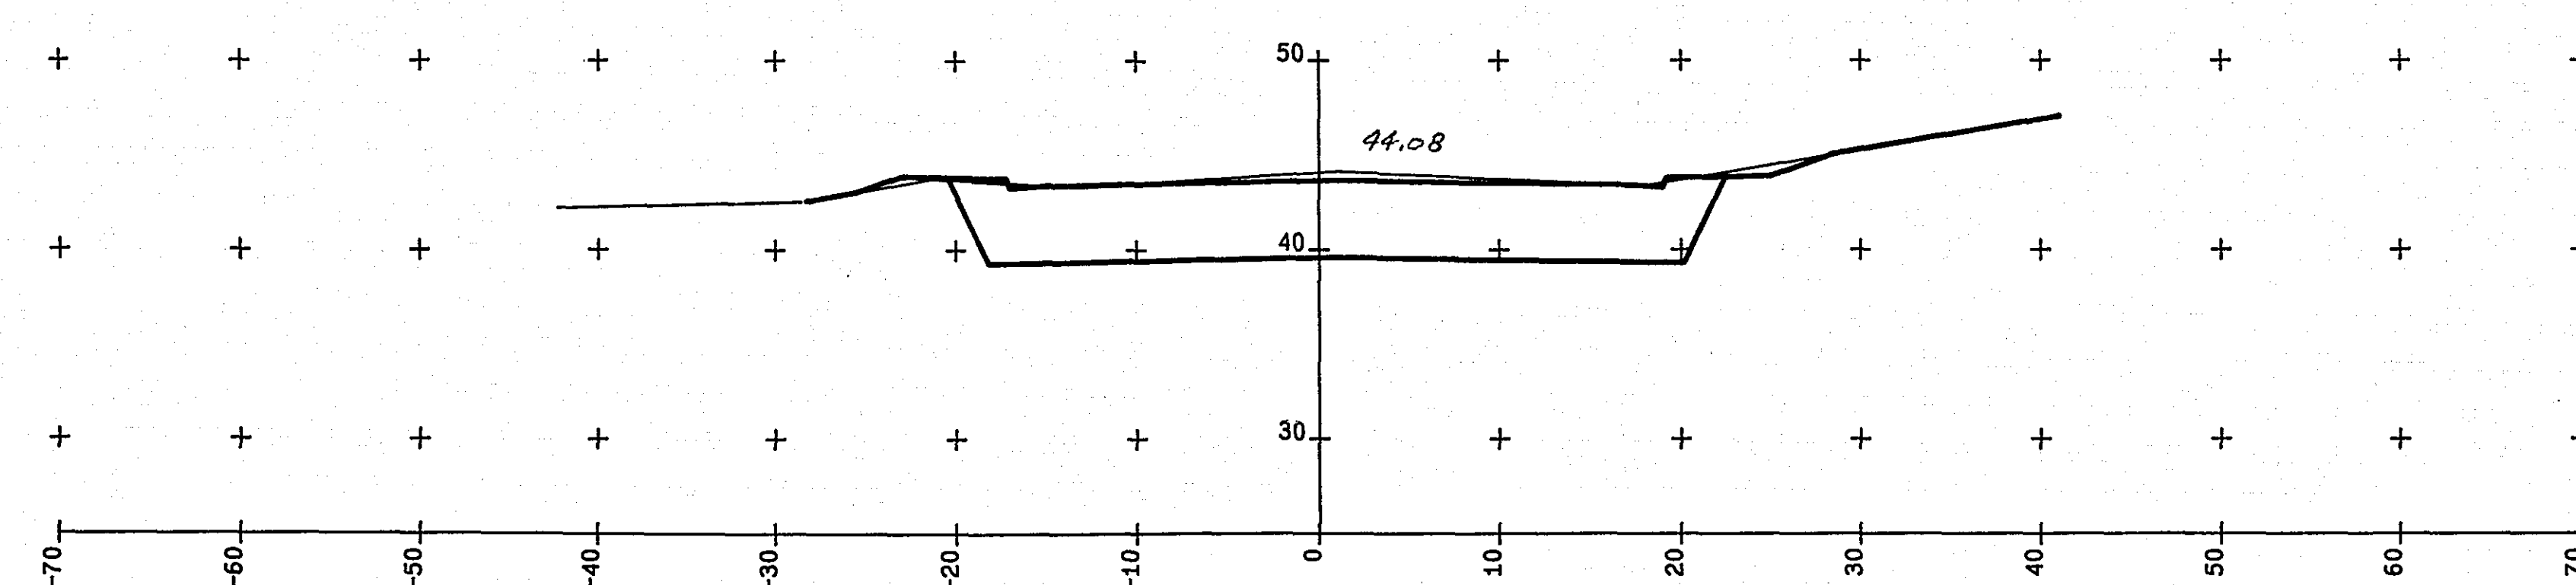


15+30.00

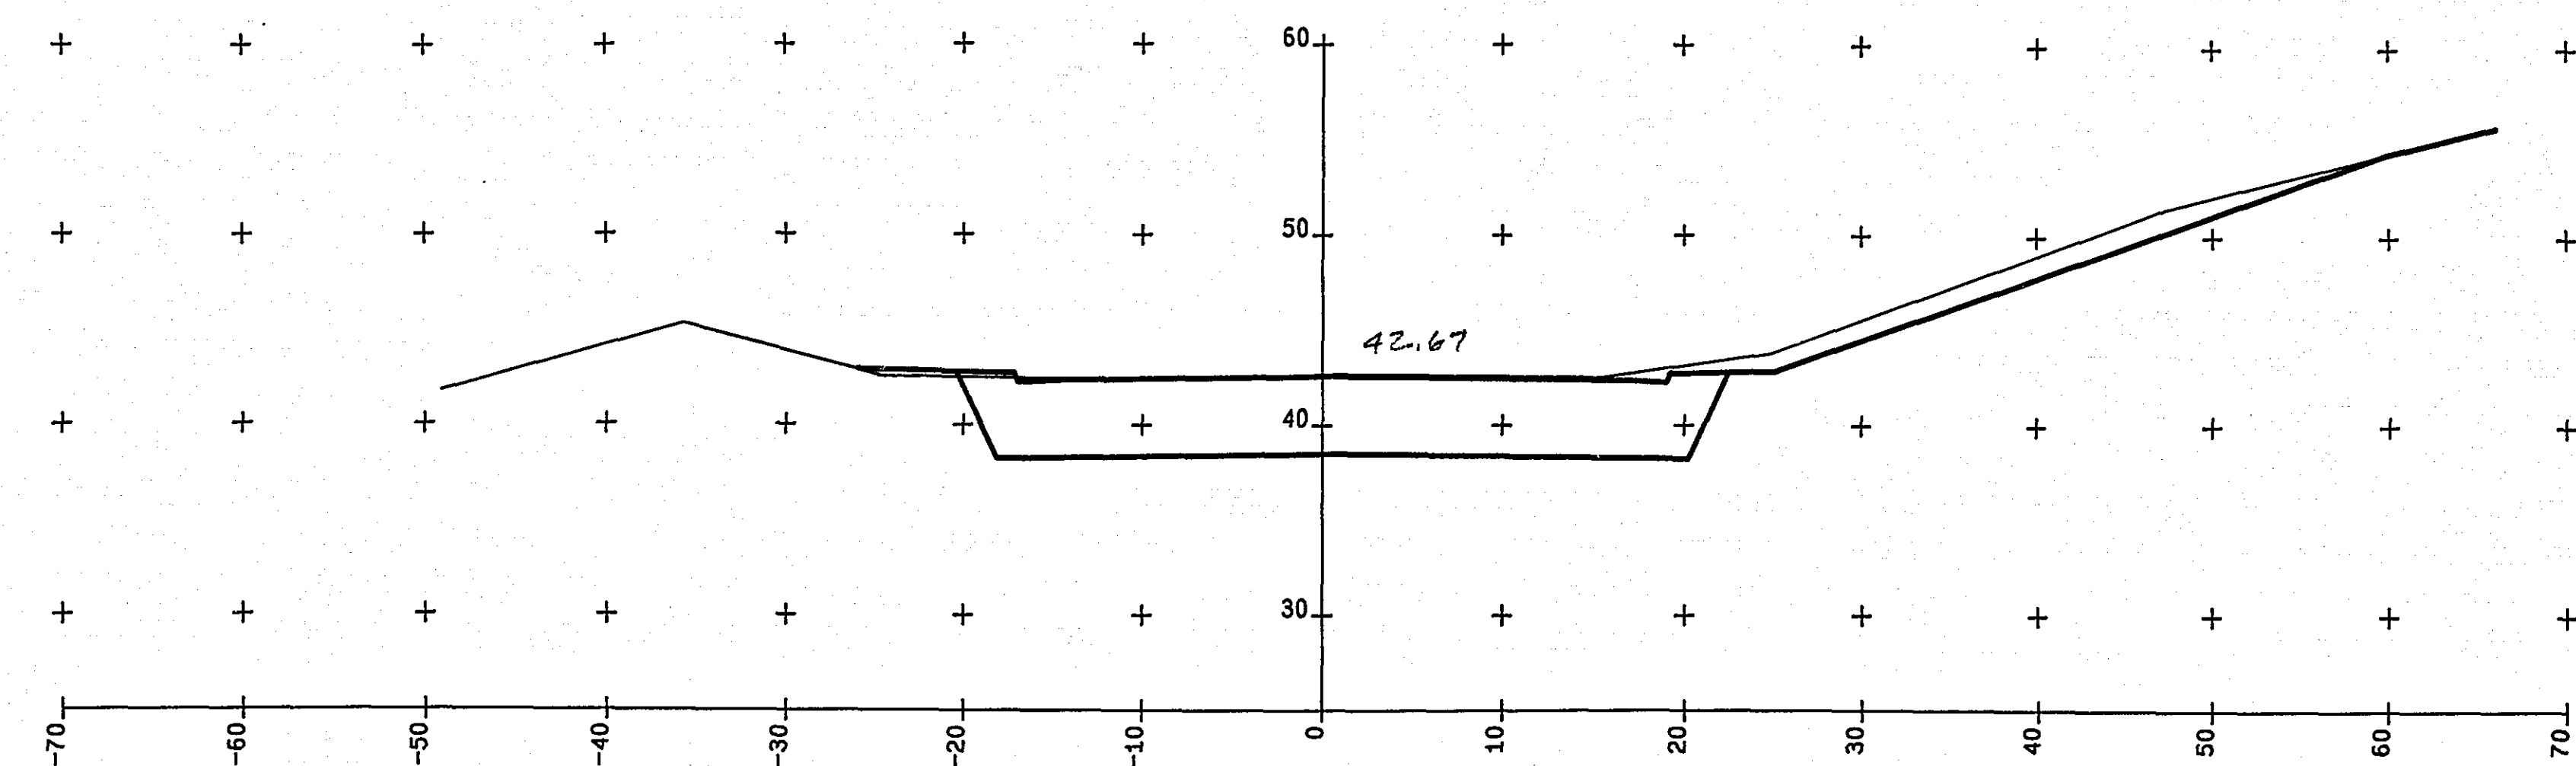


17+44.00

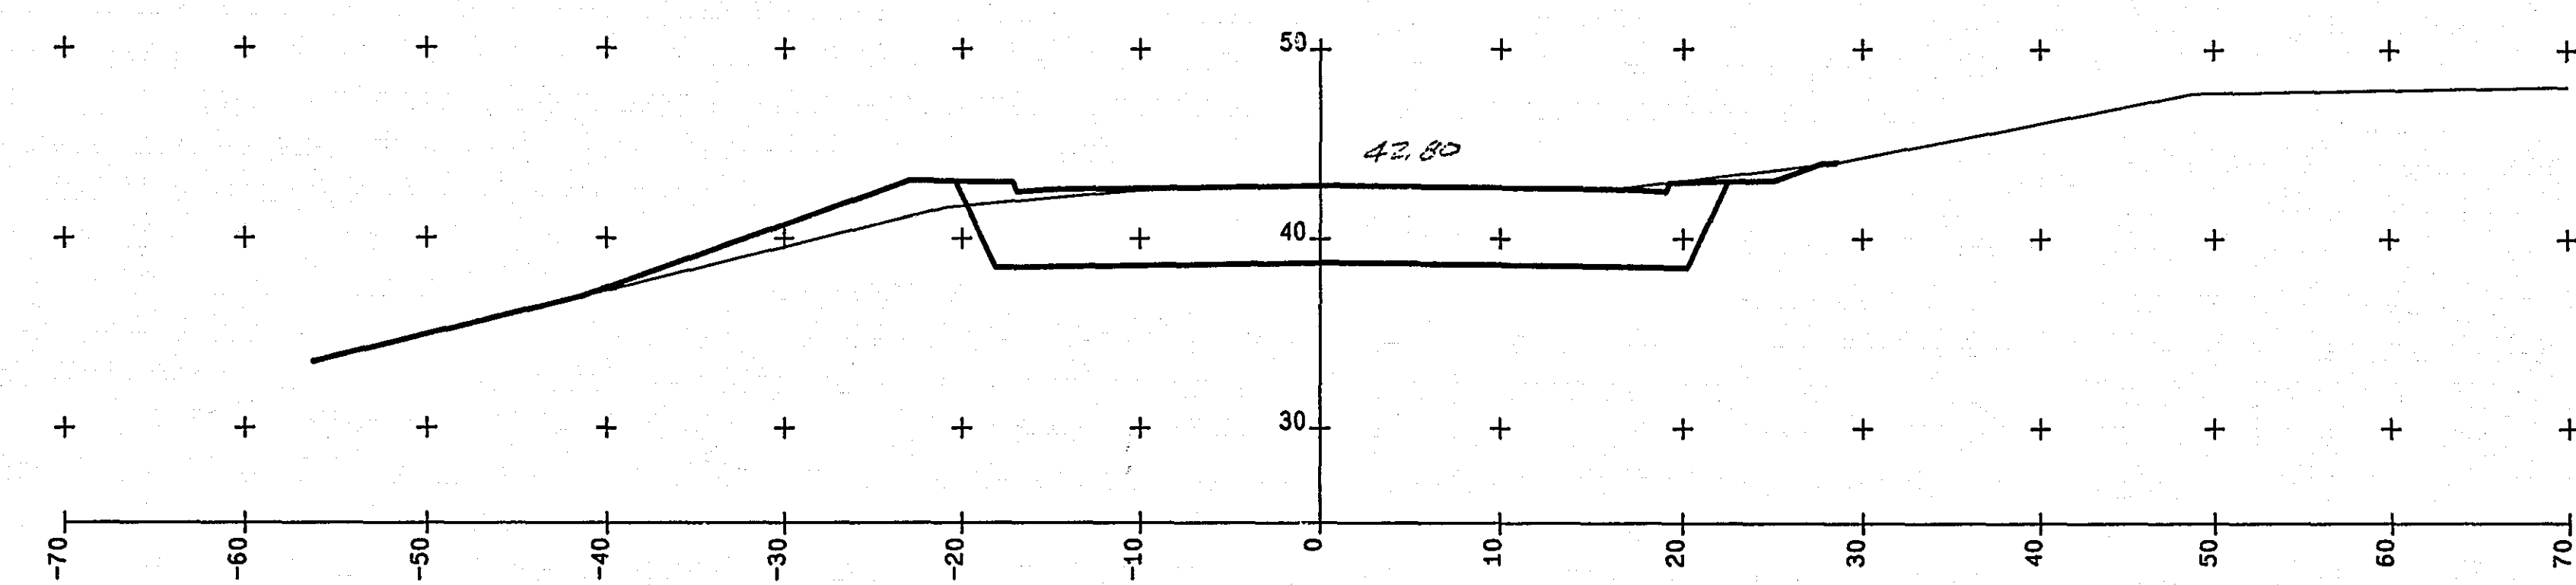


16+97.00

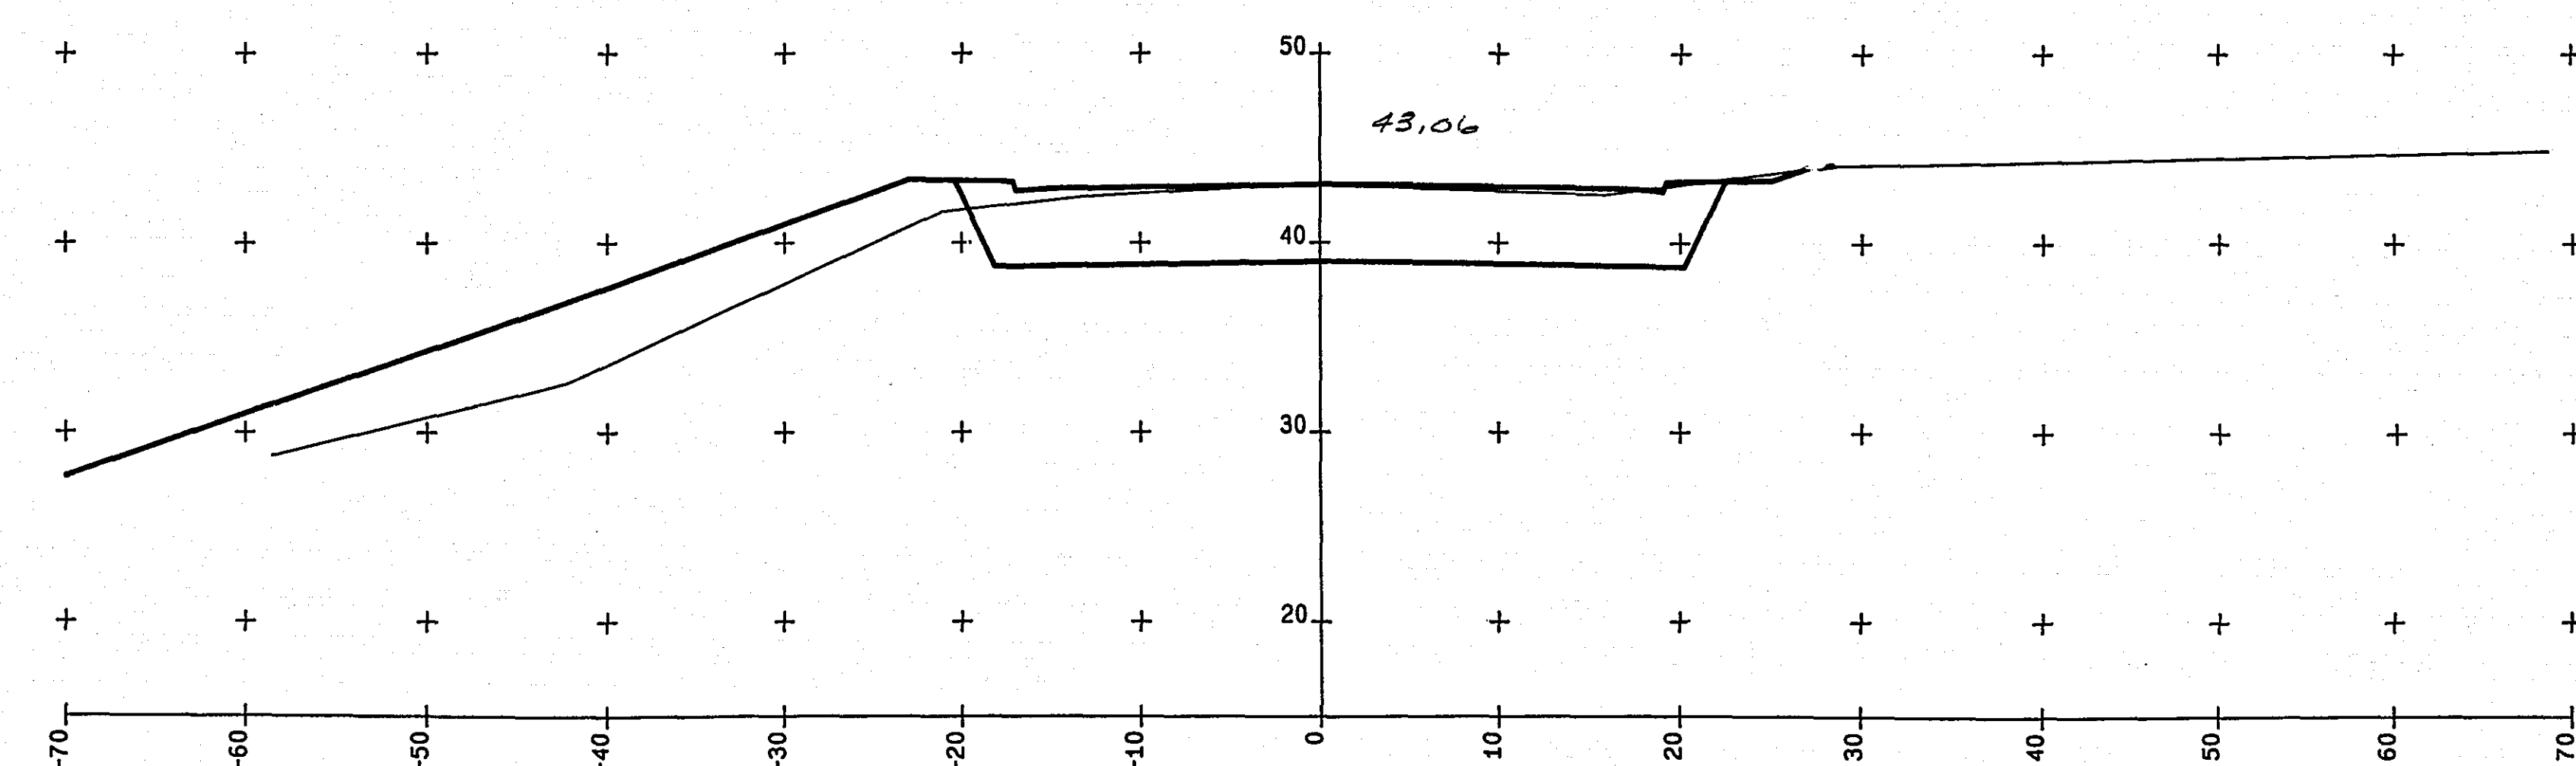


16+46.00

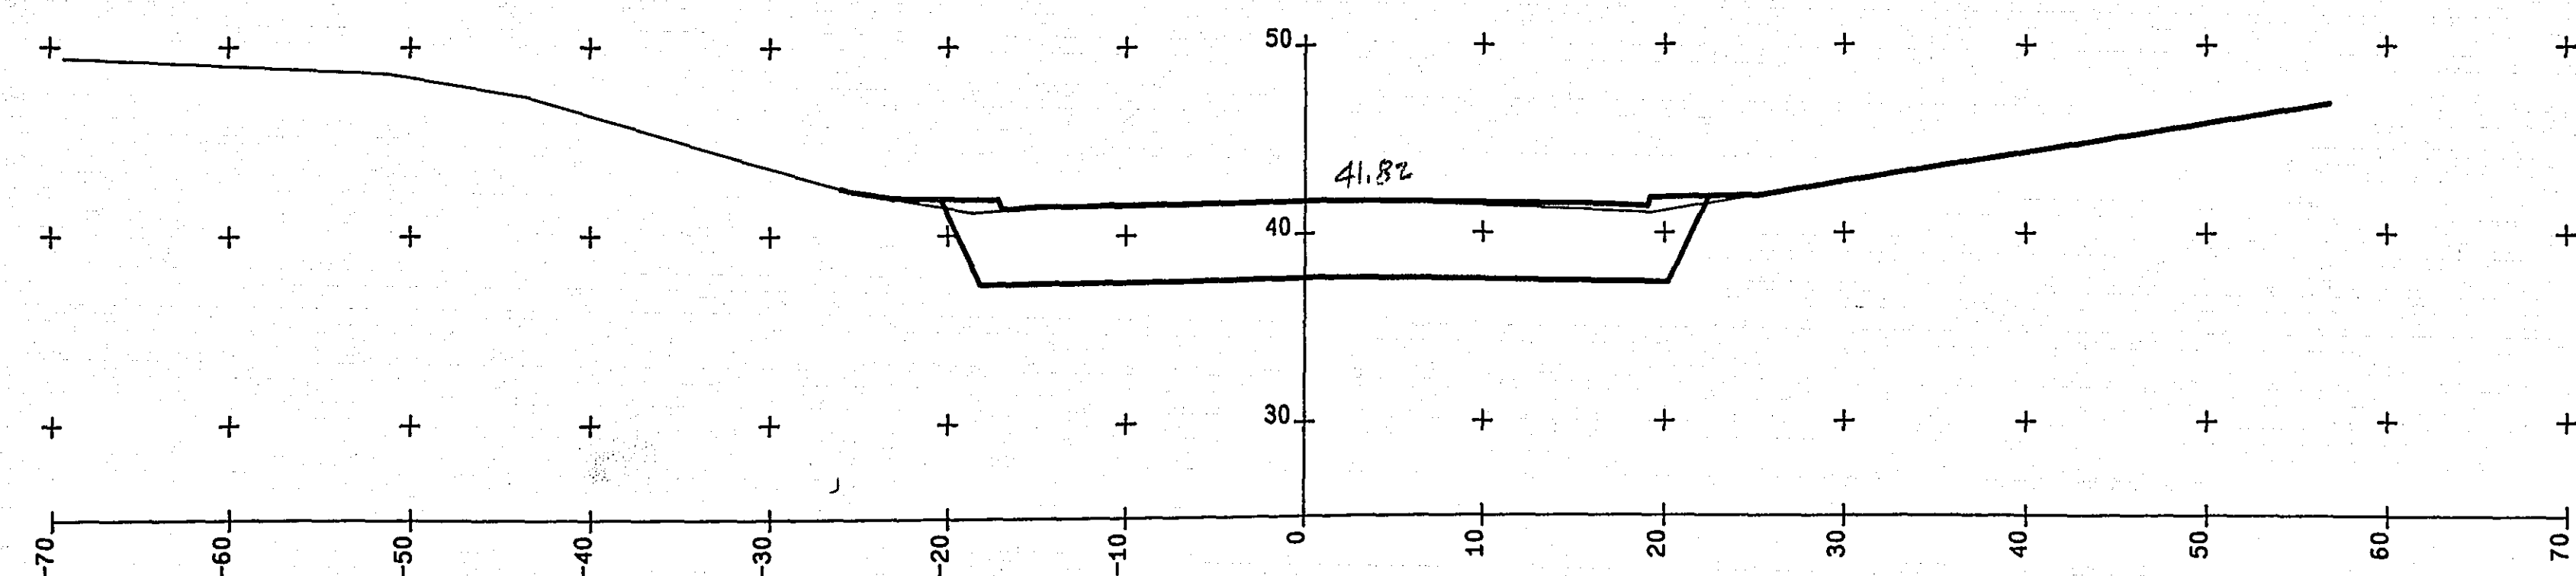


19+04.00

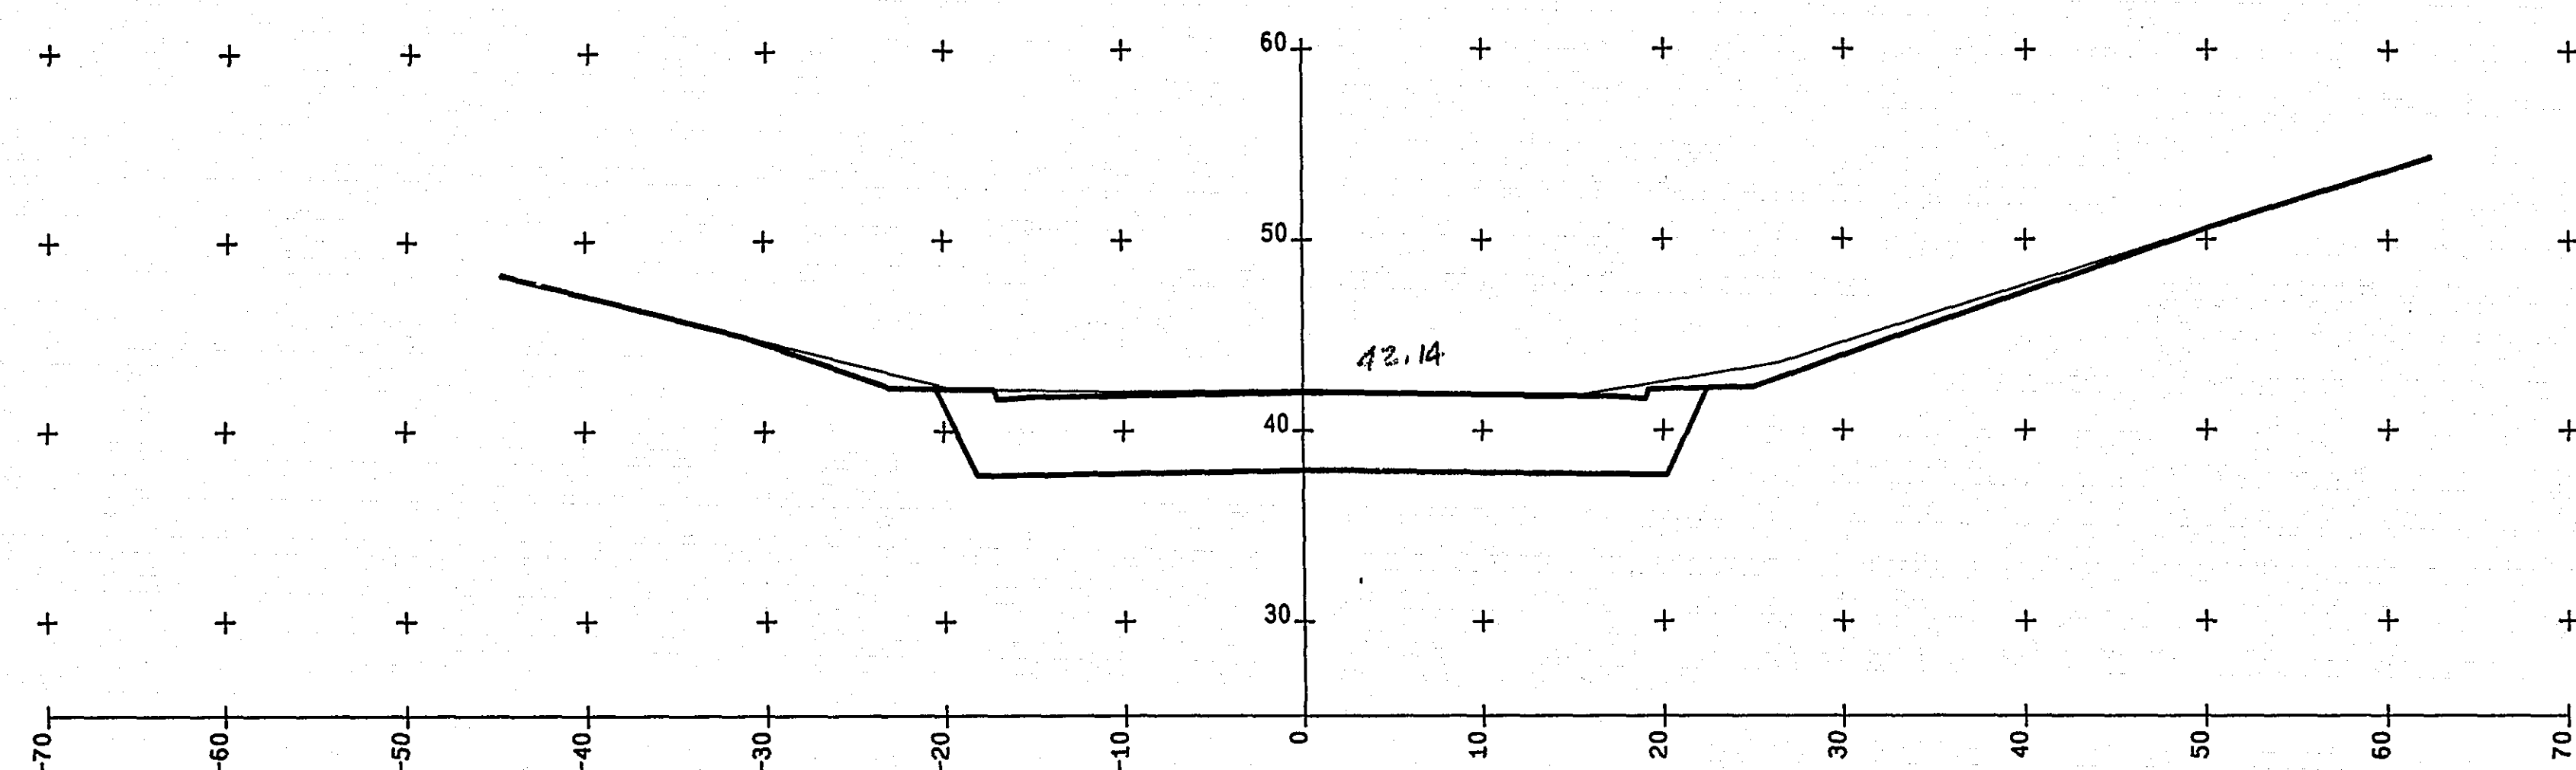


18+51.00

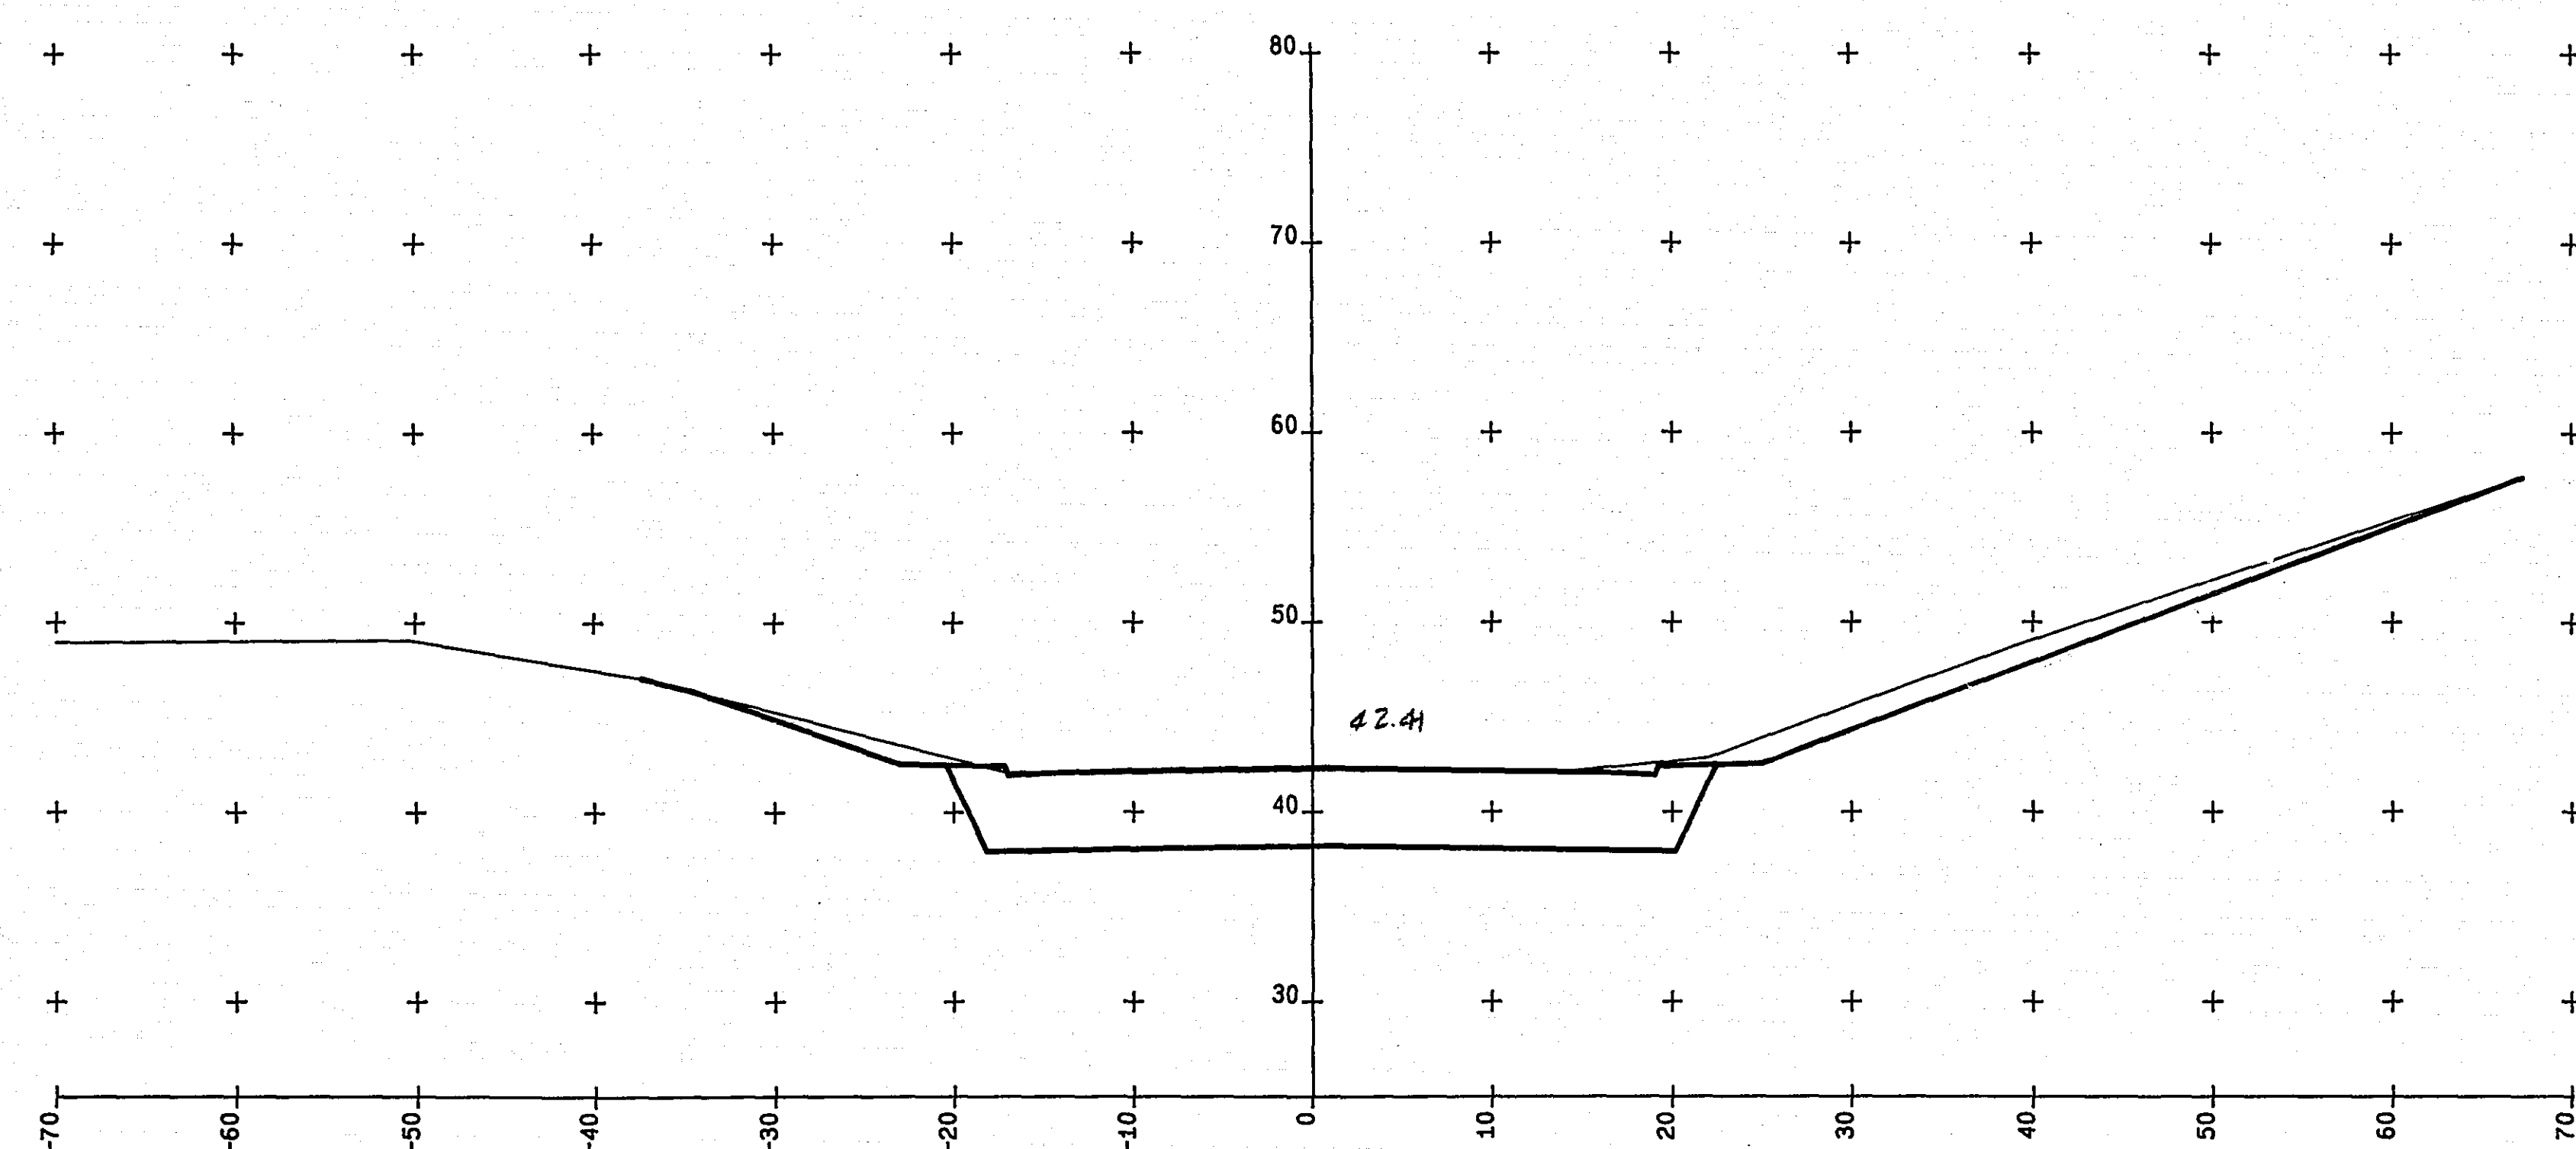


17+96.00

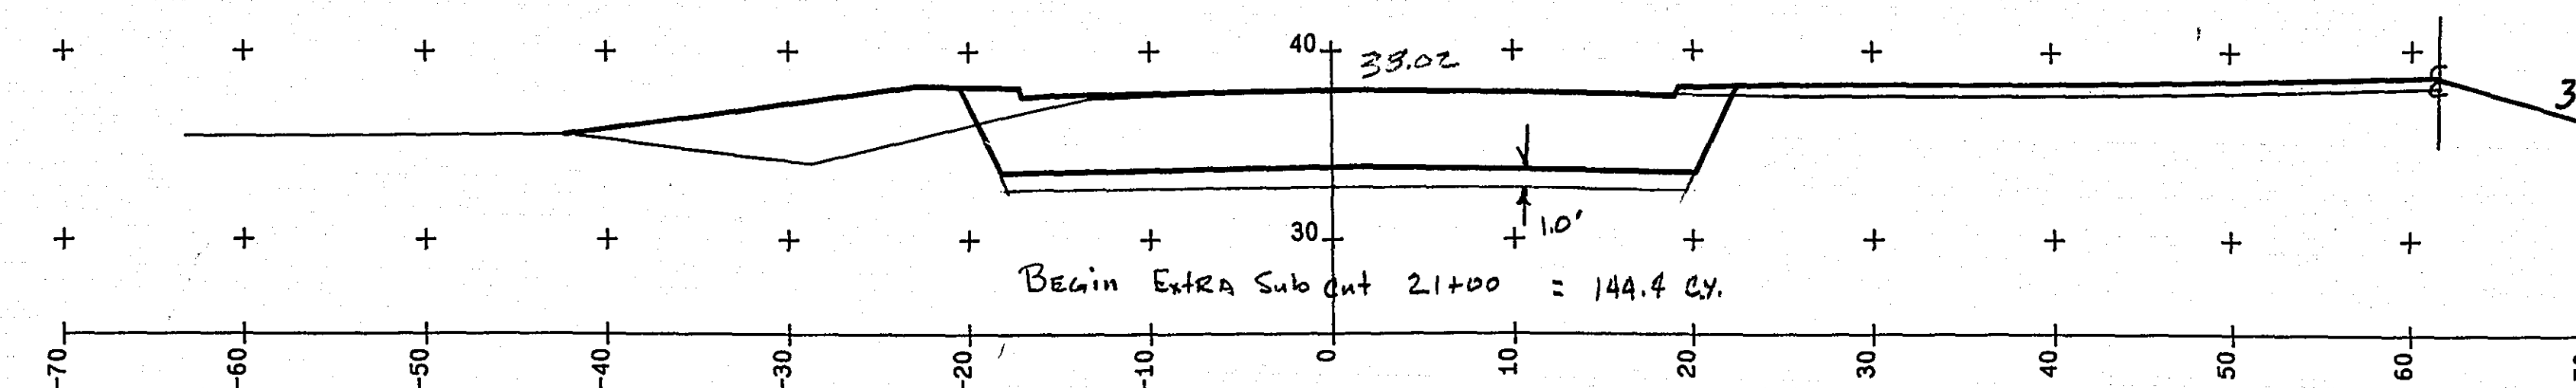


20+94.00

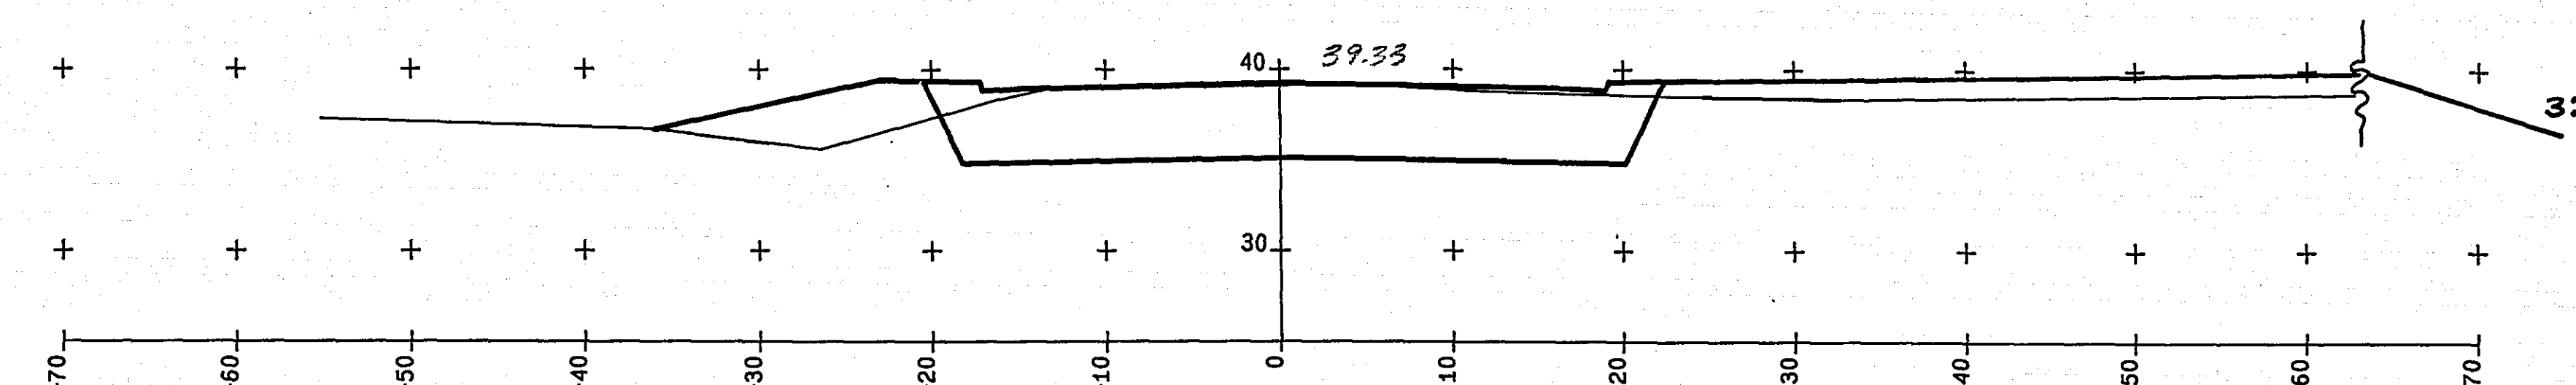

20+43.00

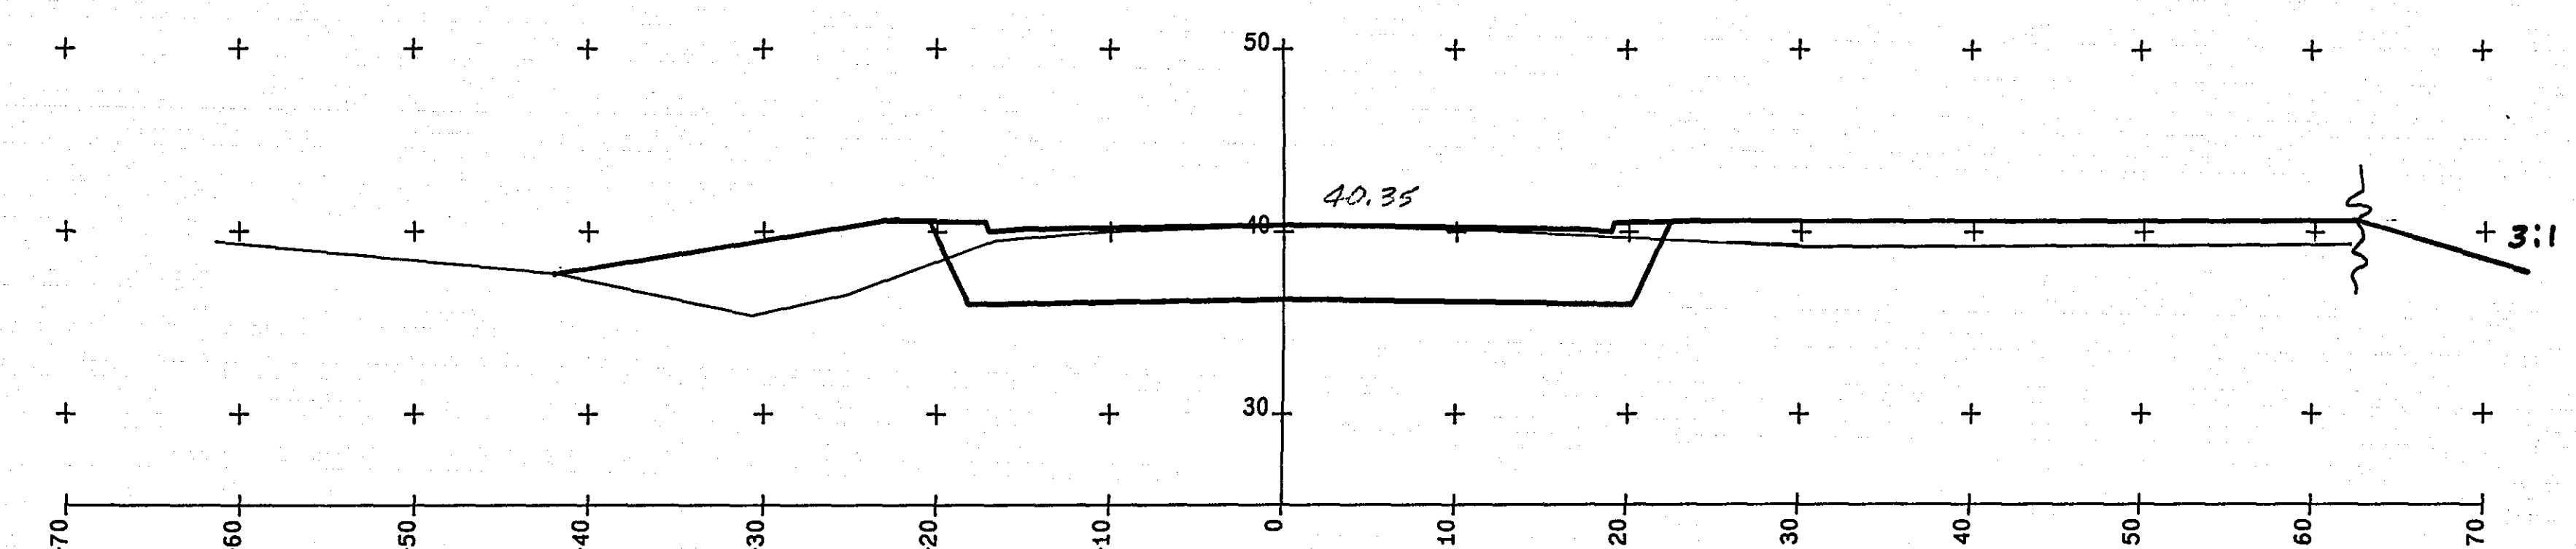

19+95.00

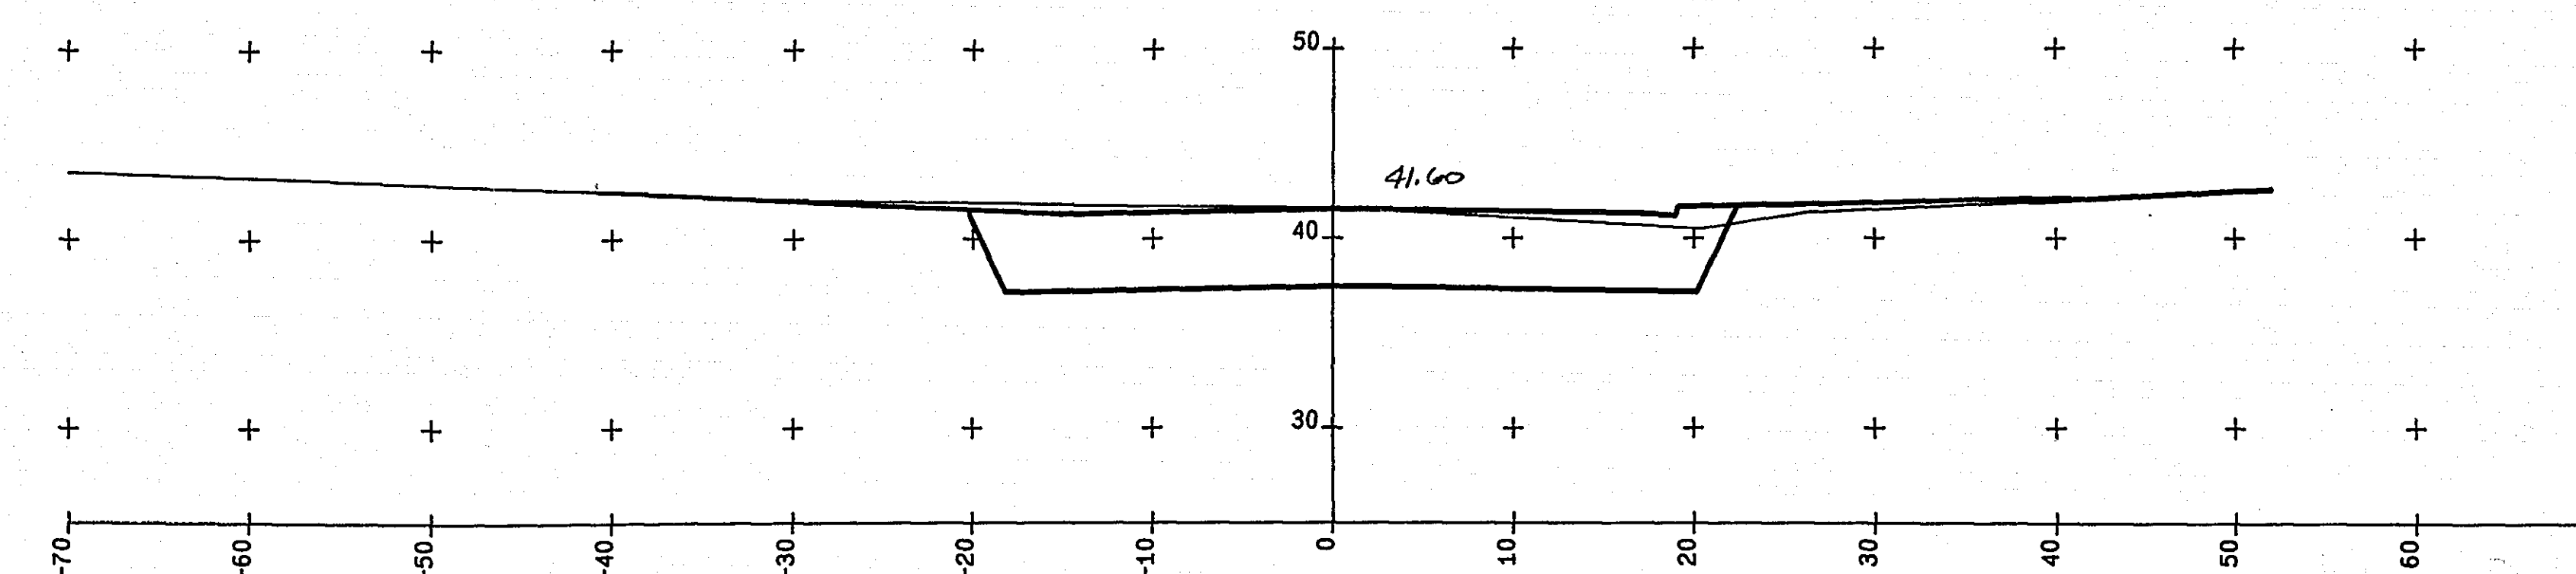









19+28.00

C.S.A.P. NO. 62-626-01, NO. 62-626-02, P-W-85-31

ASBUILT PLAN
CONFORMING TO
CONST. RECORDS

DONE BY: J.A.
DATE: 1-4-89

21/29
27-117

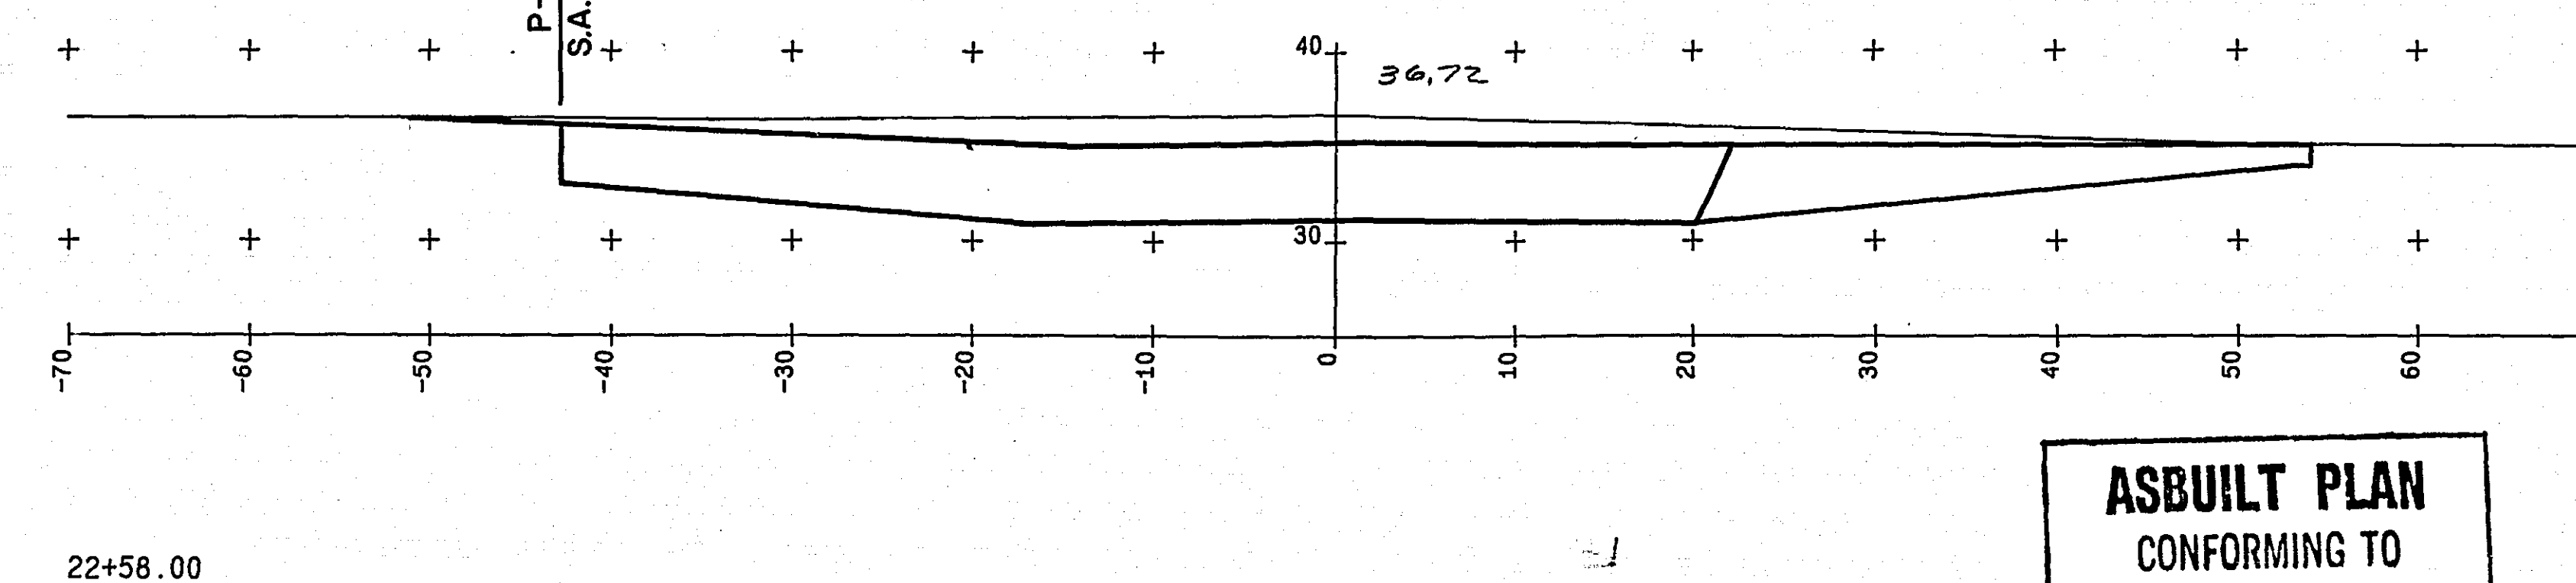
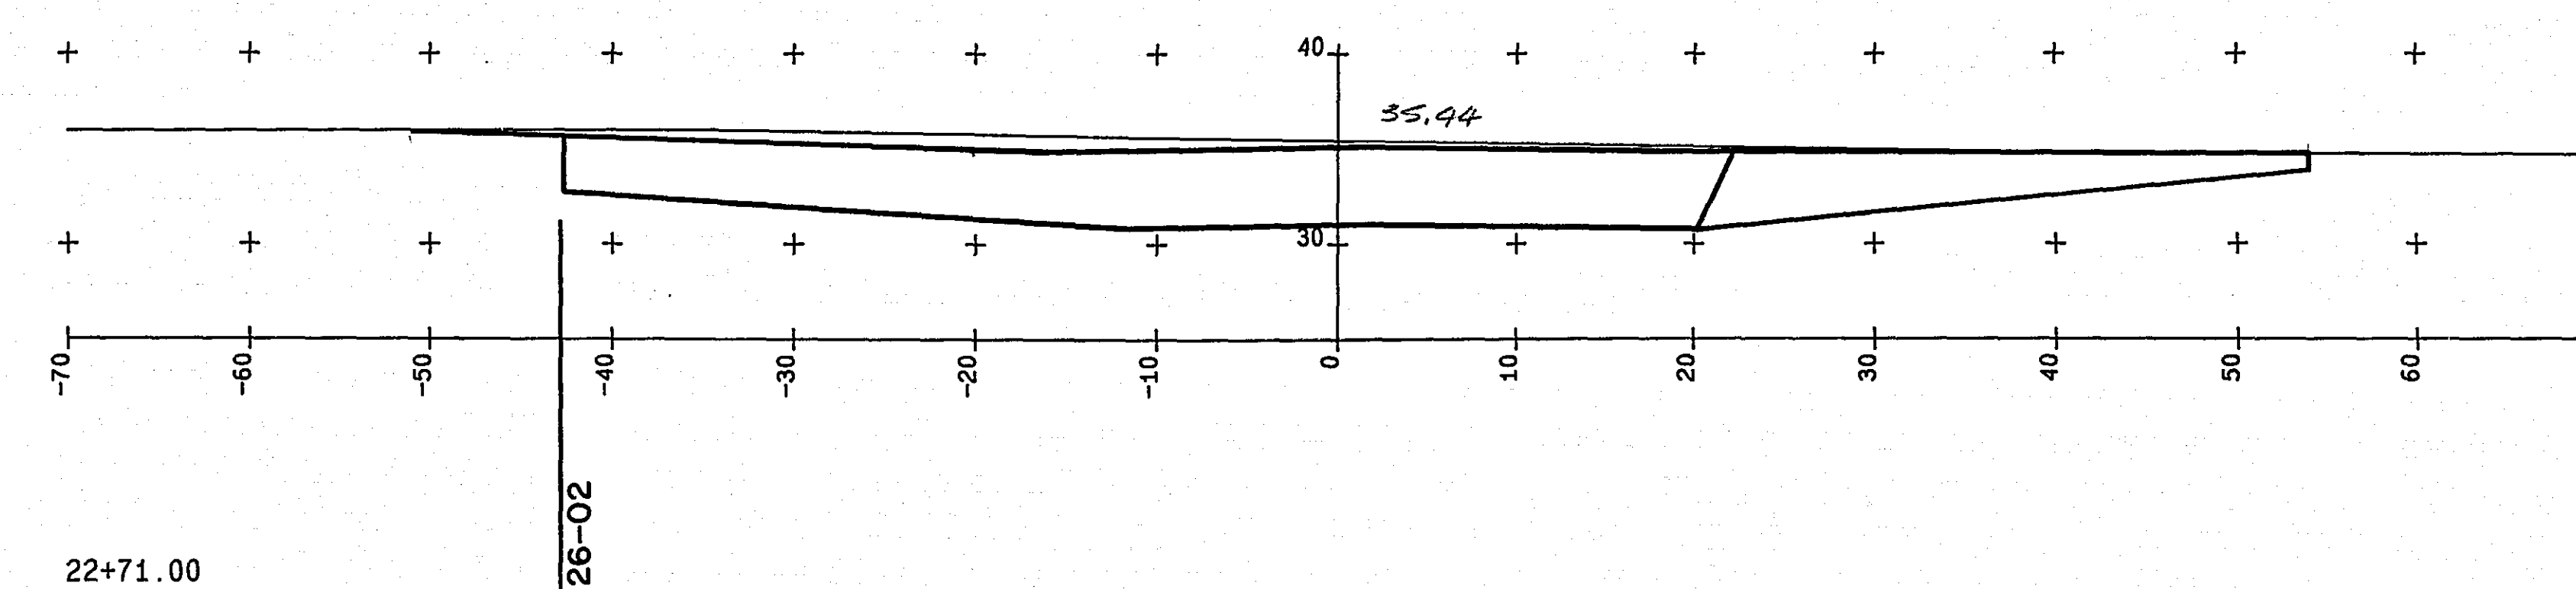
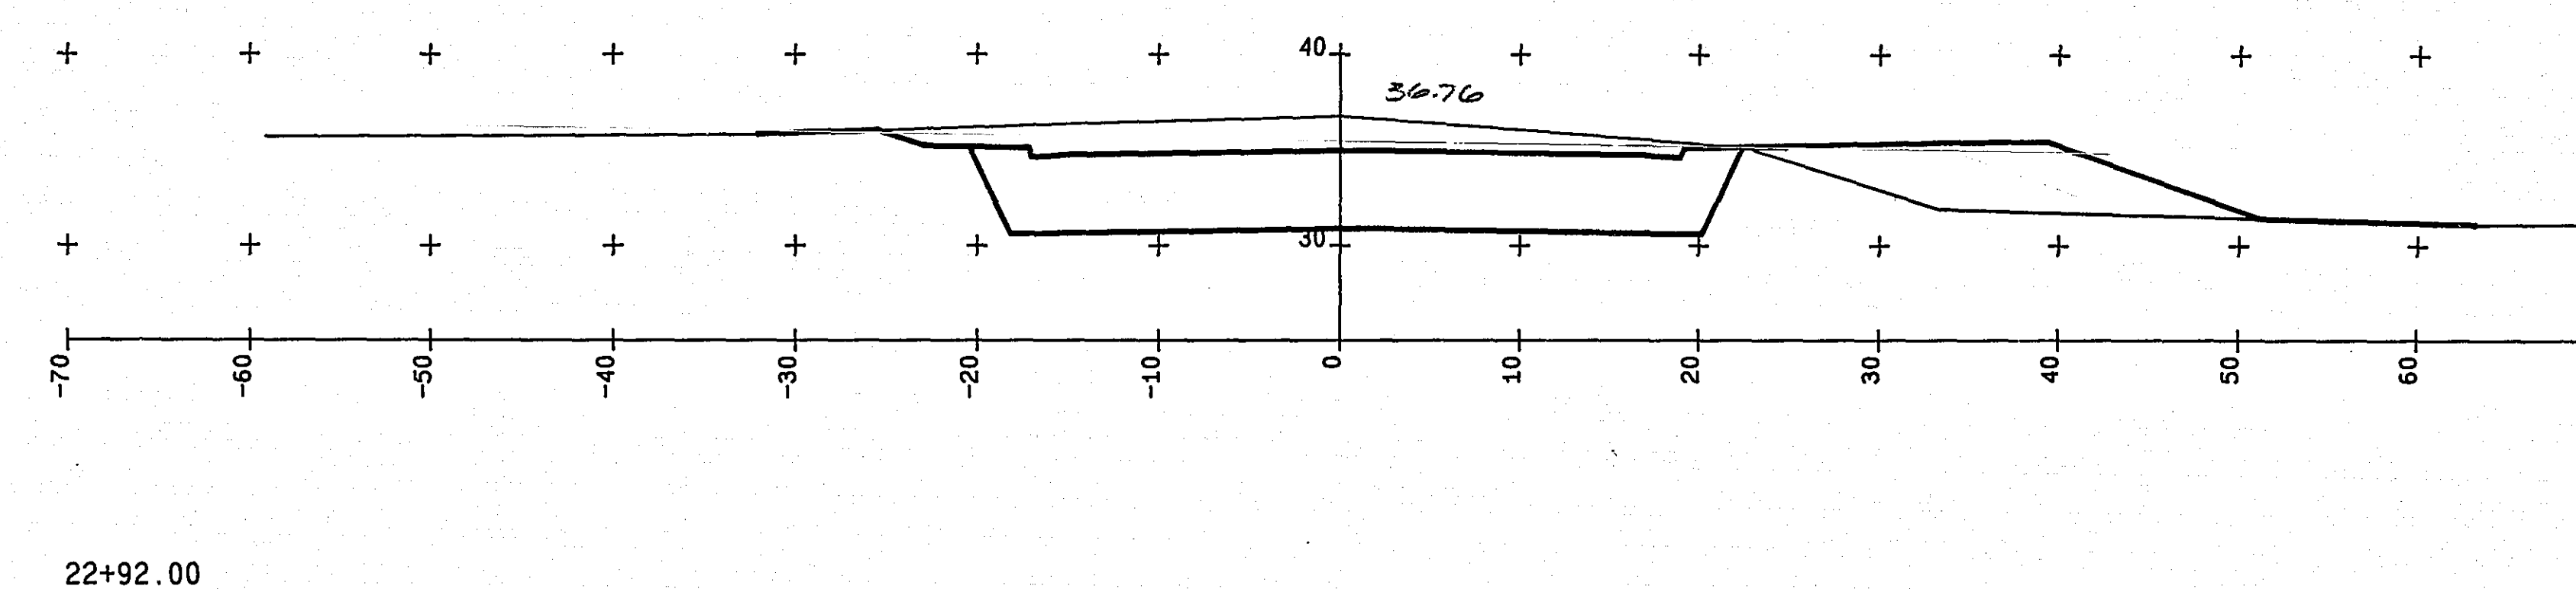
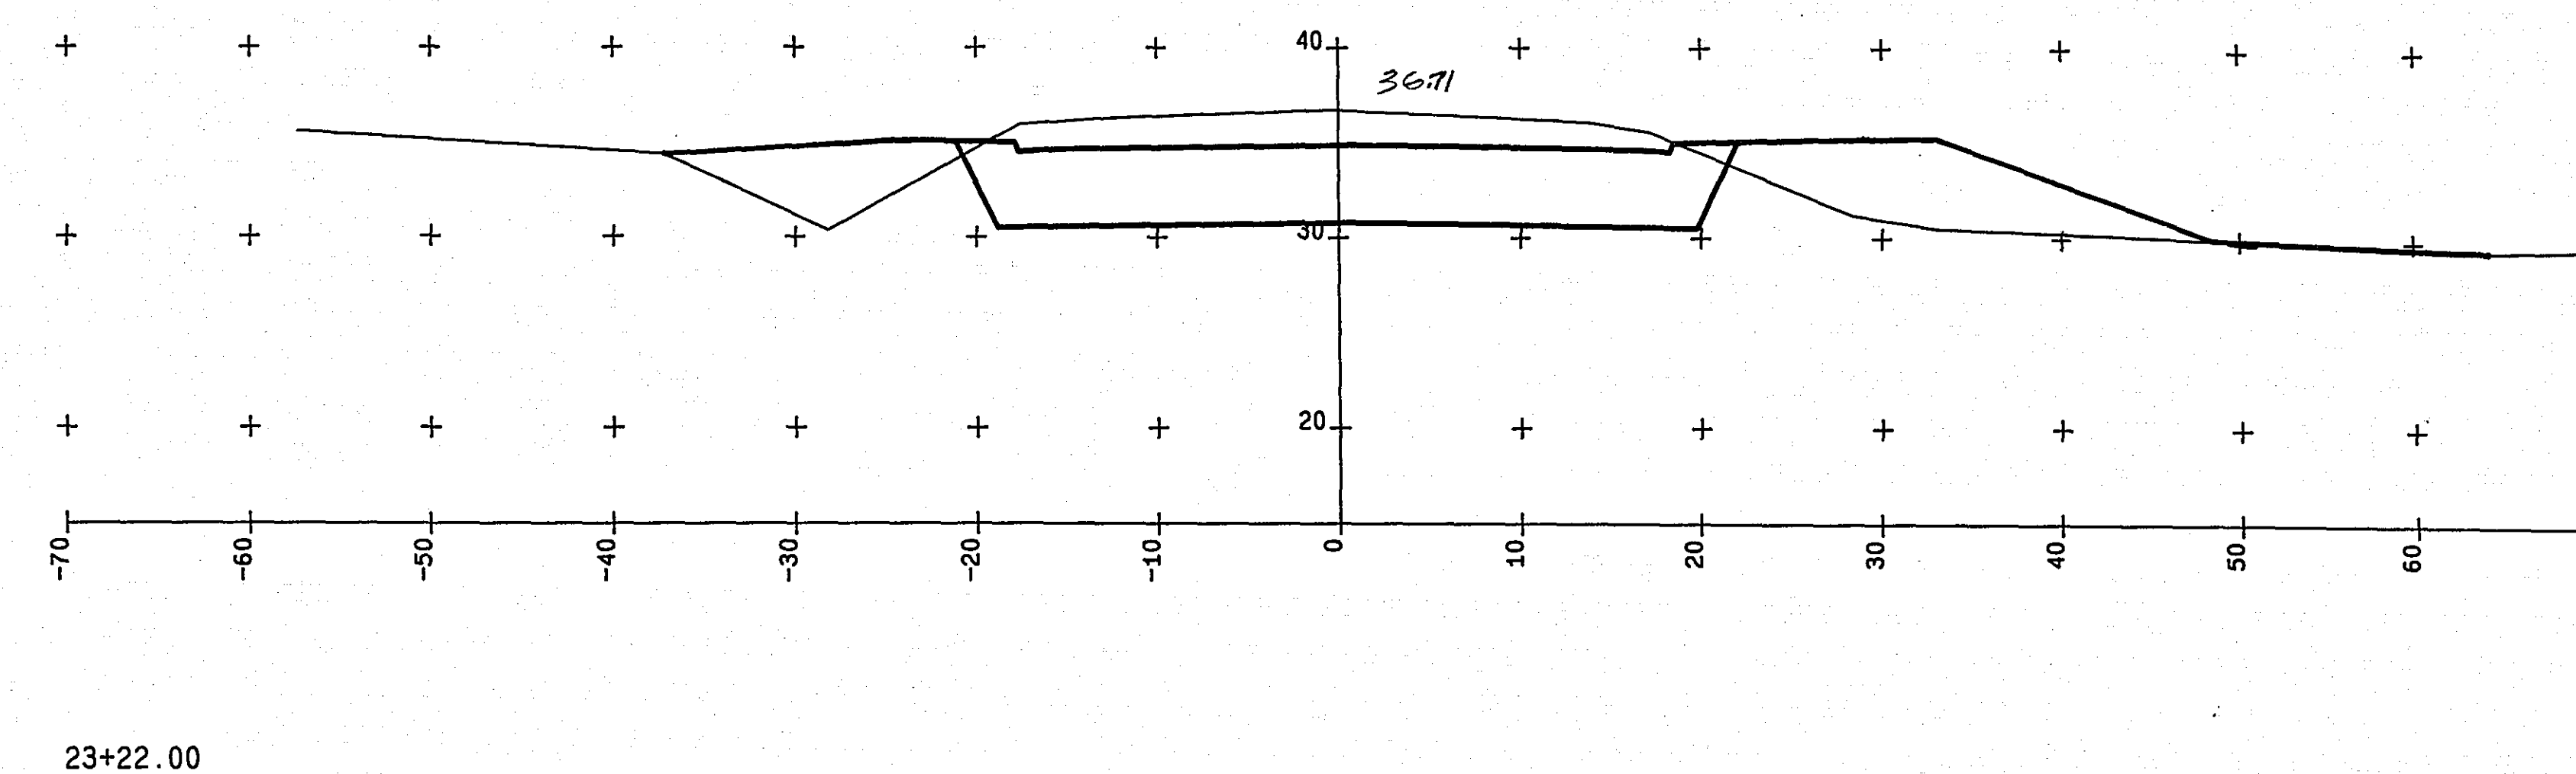
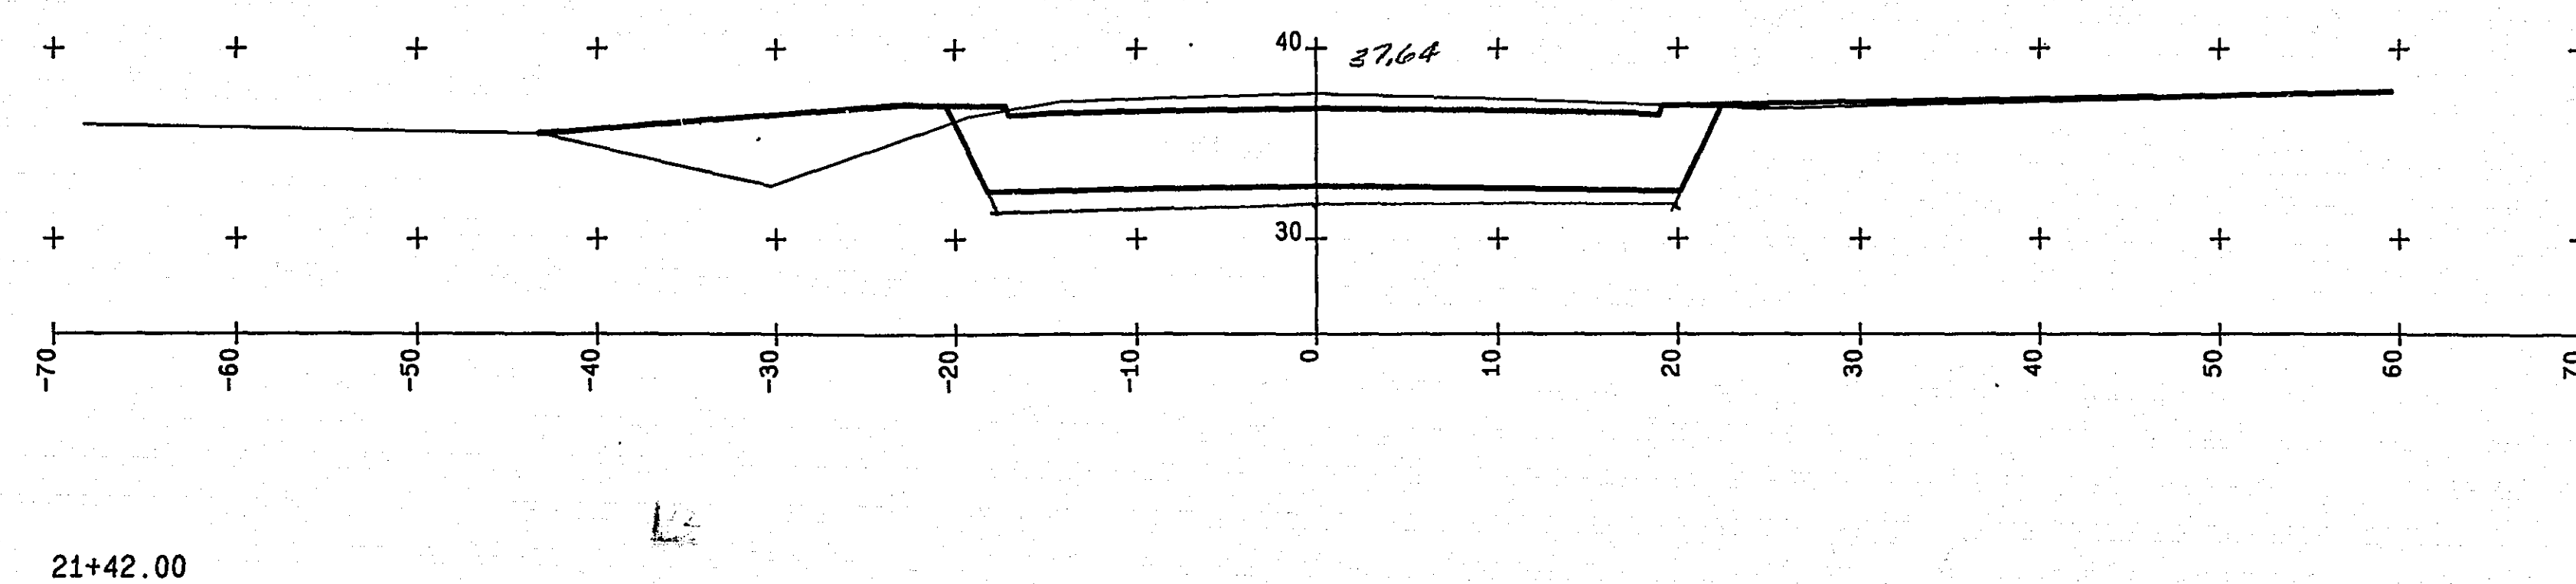
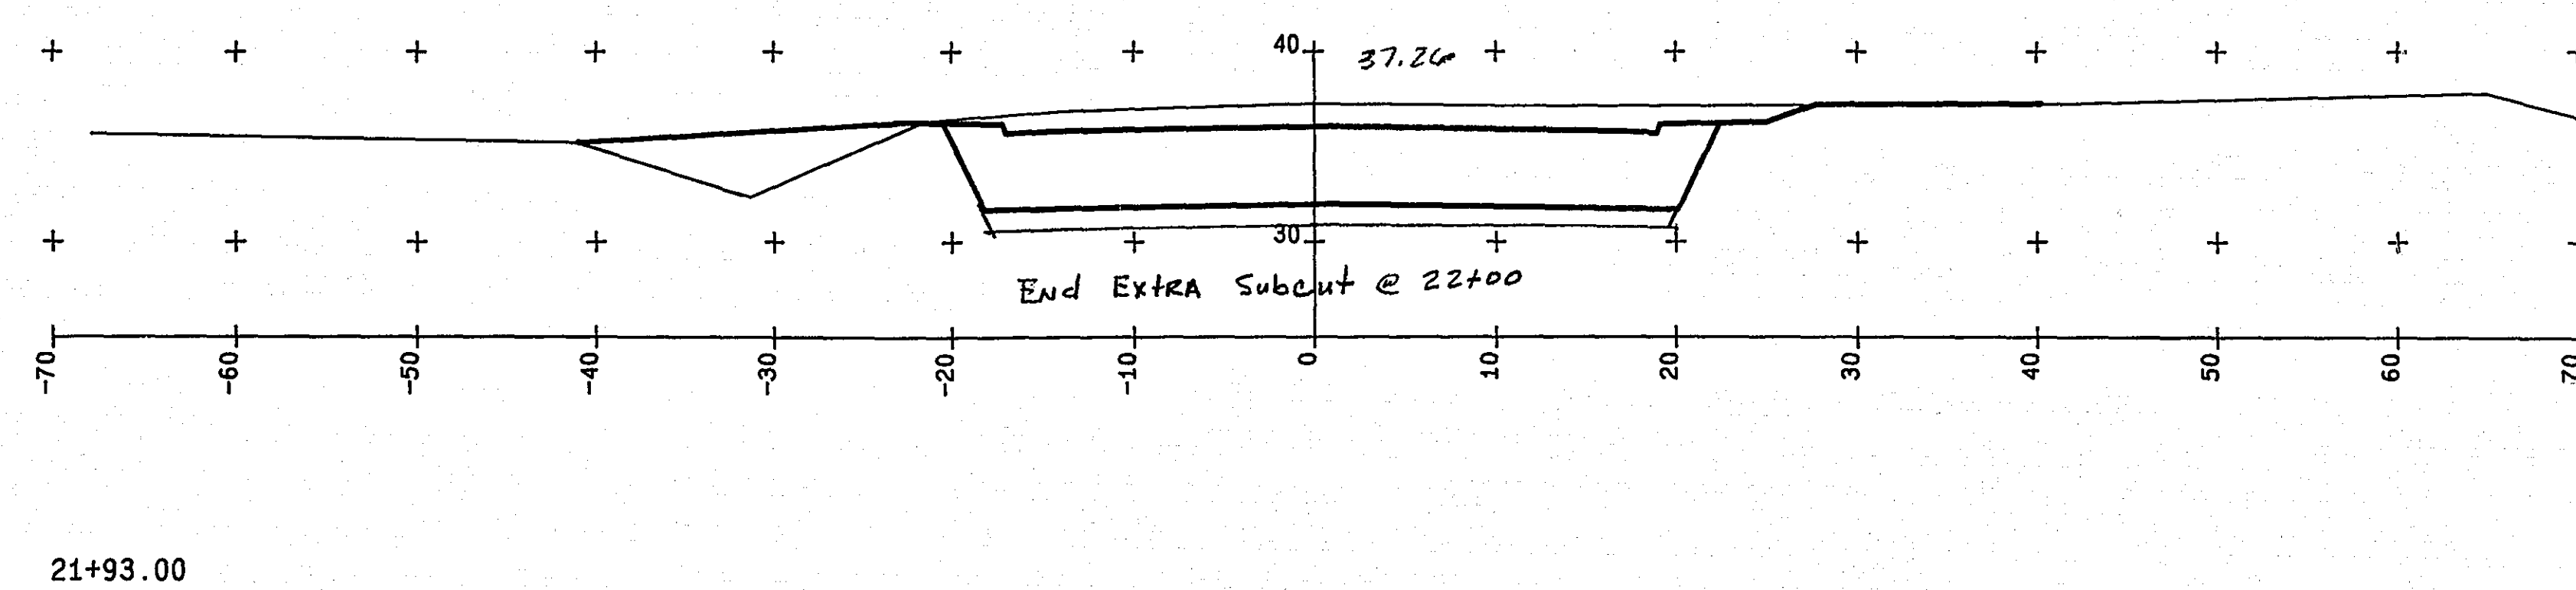
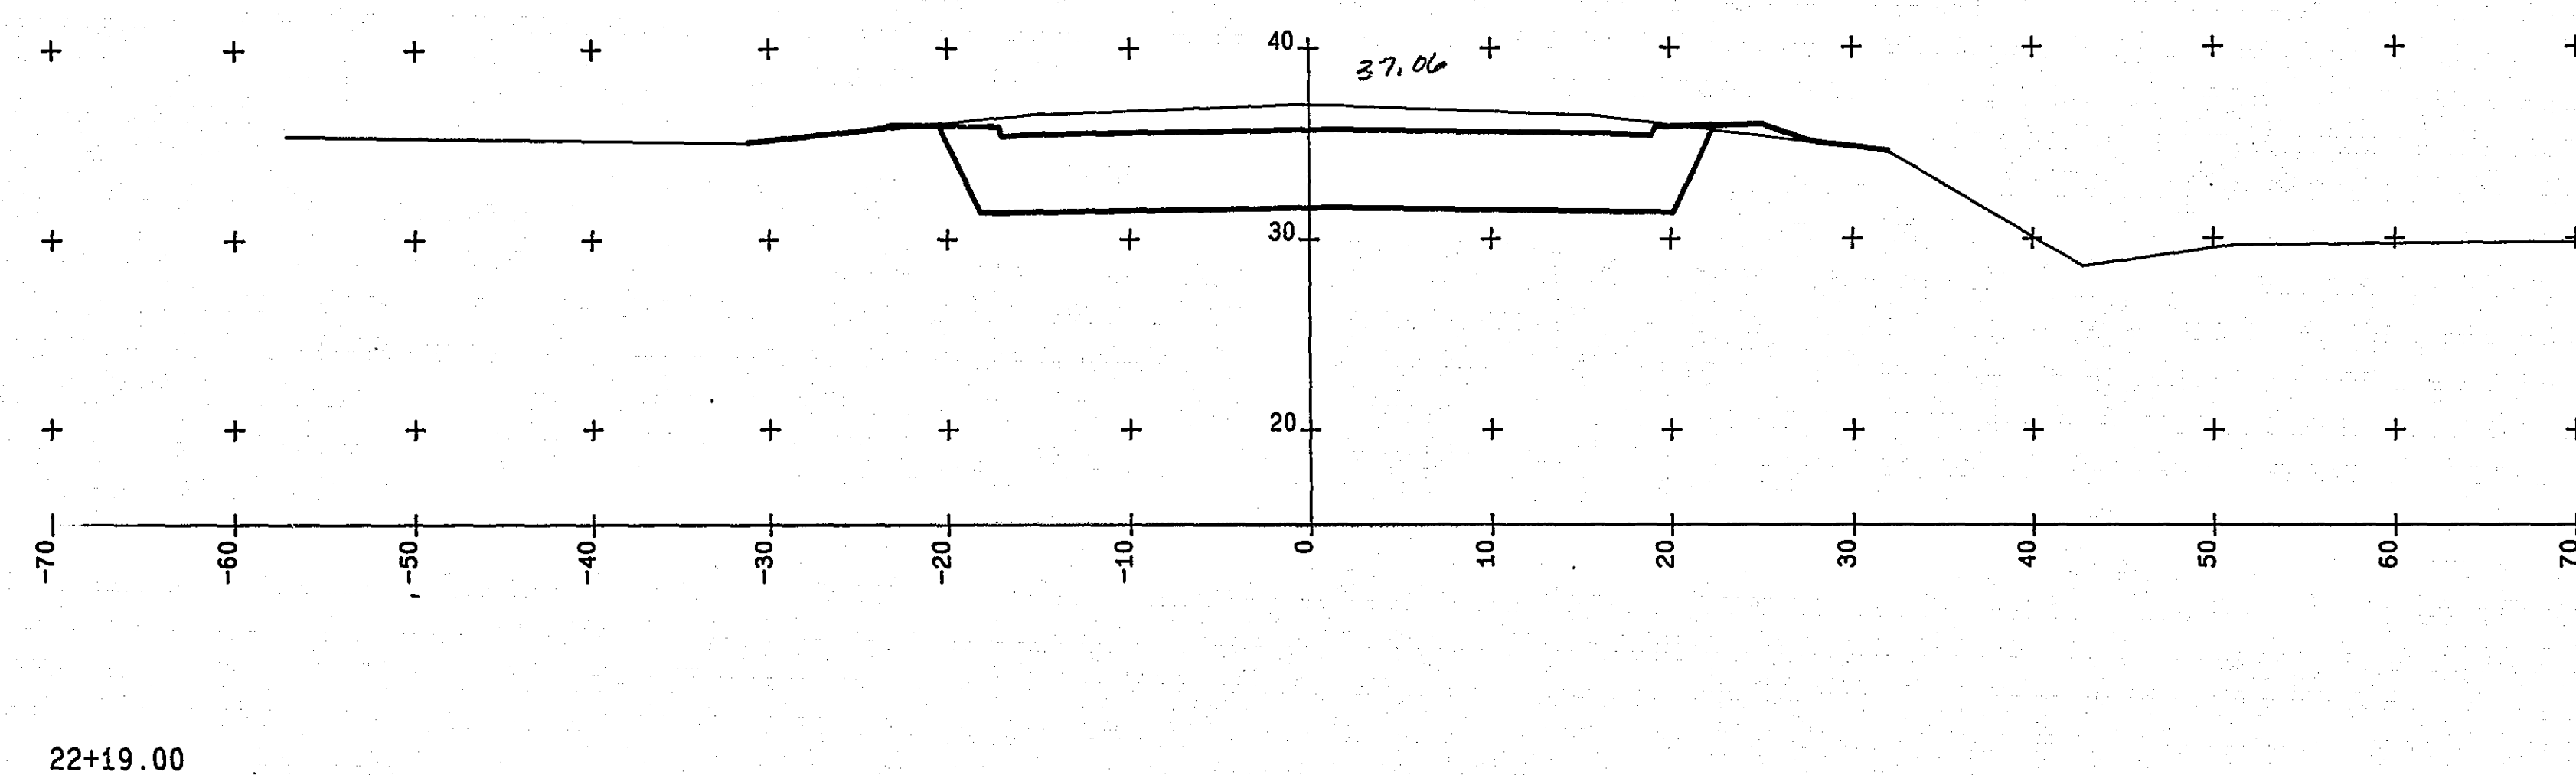
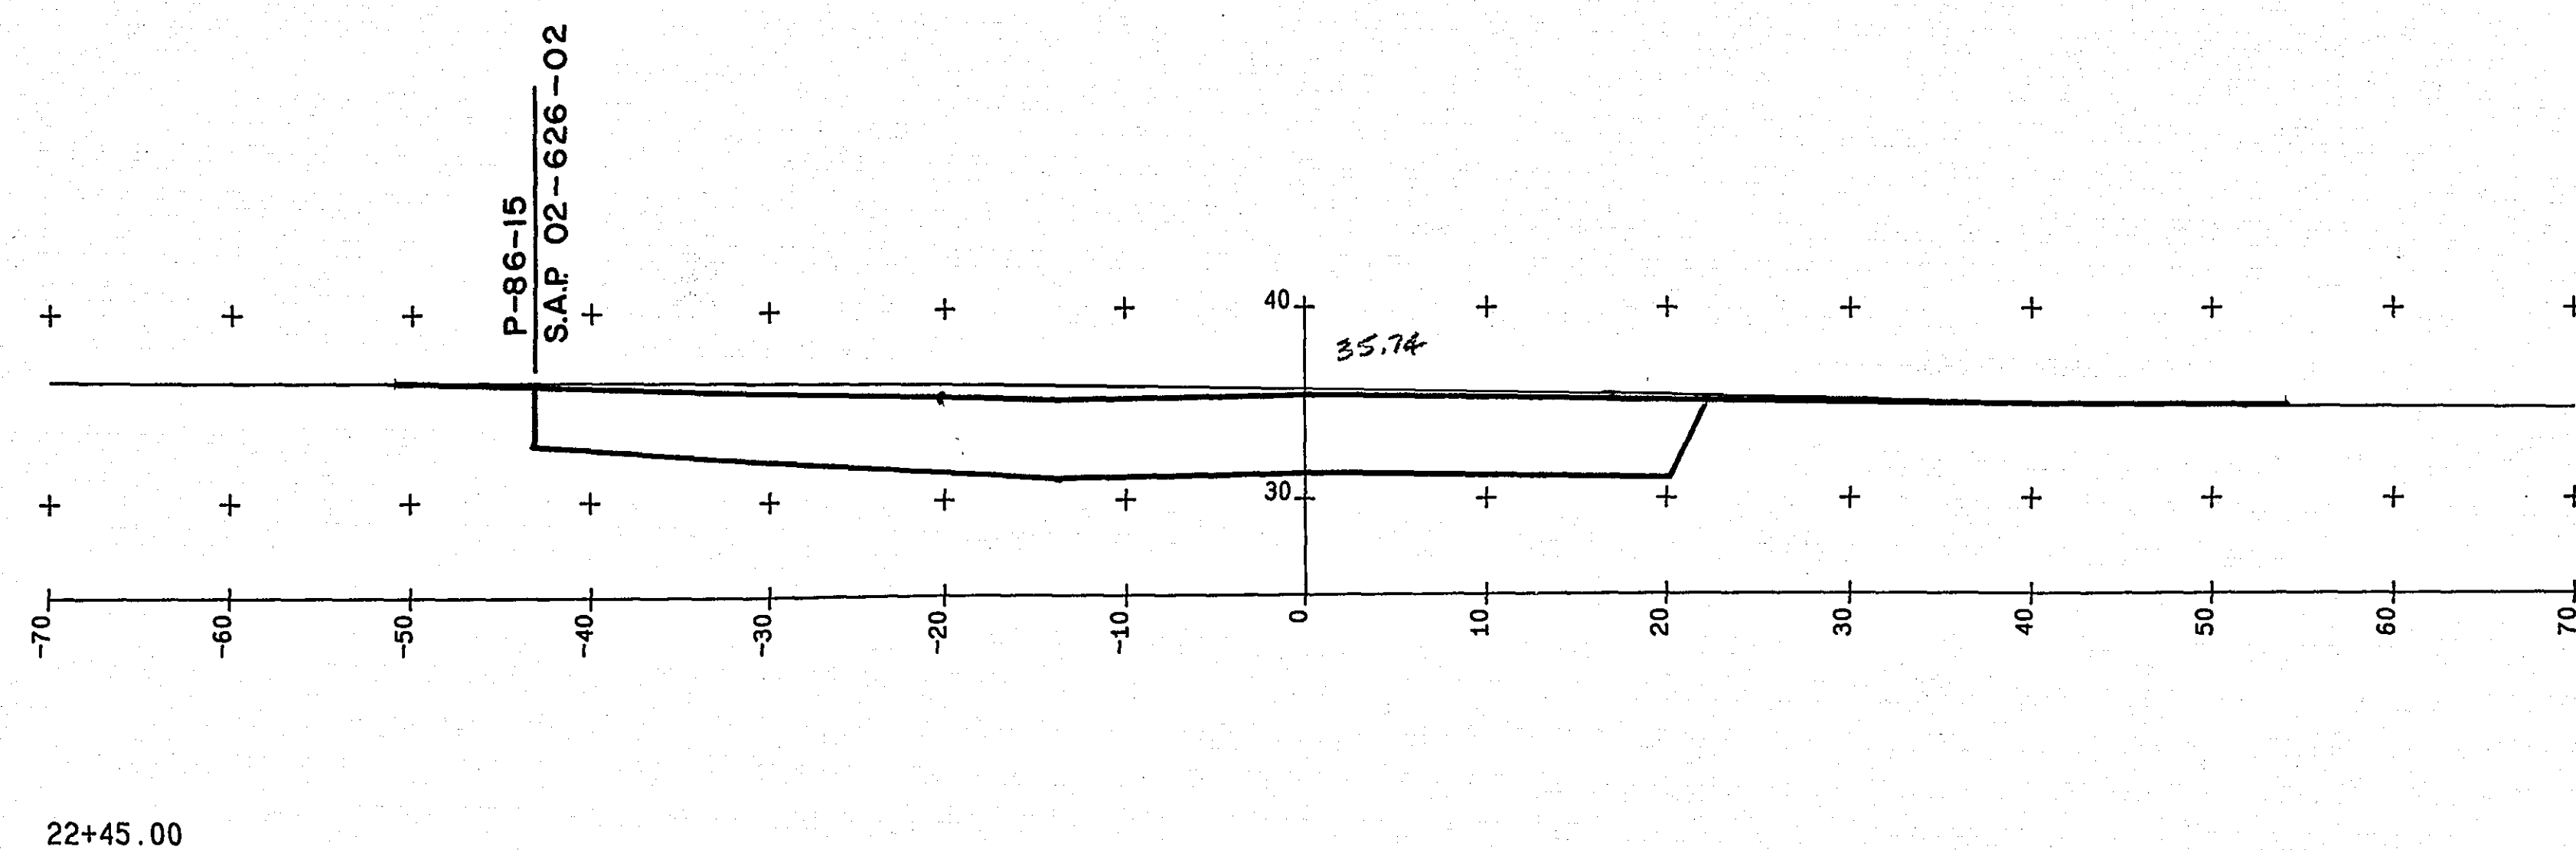



ASBUILT PLAN
CONFORMING TO
CONST. RECORDS

DONE BY: *J.A.*
DATE: 1-4-89


C.S.A.P. NO. 62-626-01, NO. 62-626-02, P-W-85-31

22/29
27-117

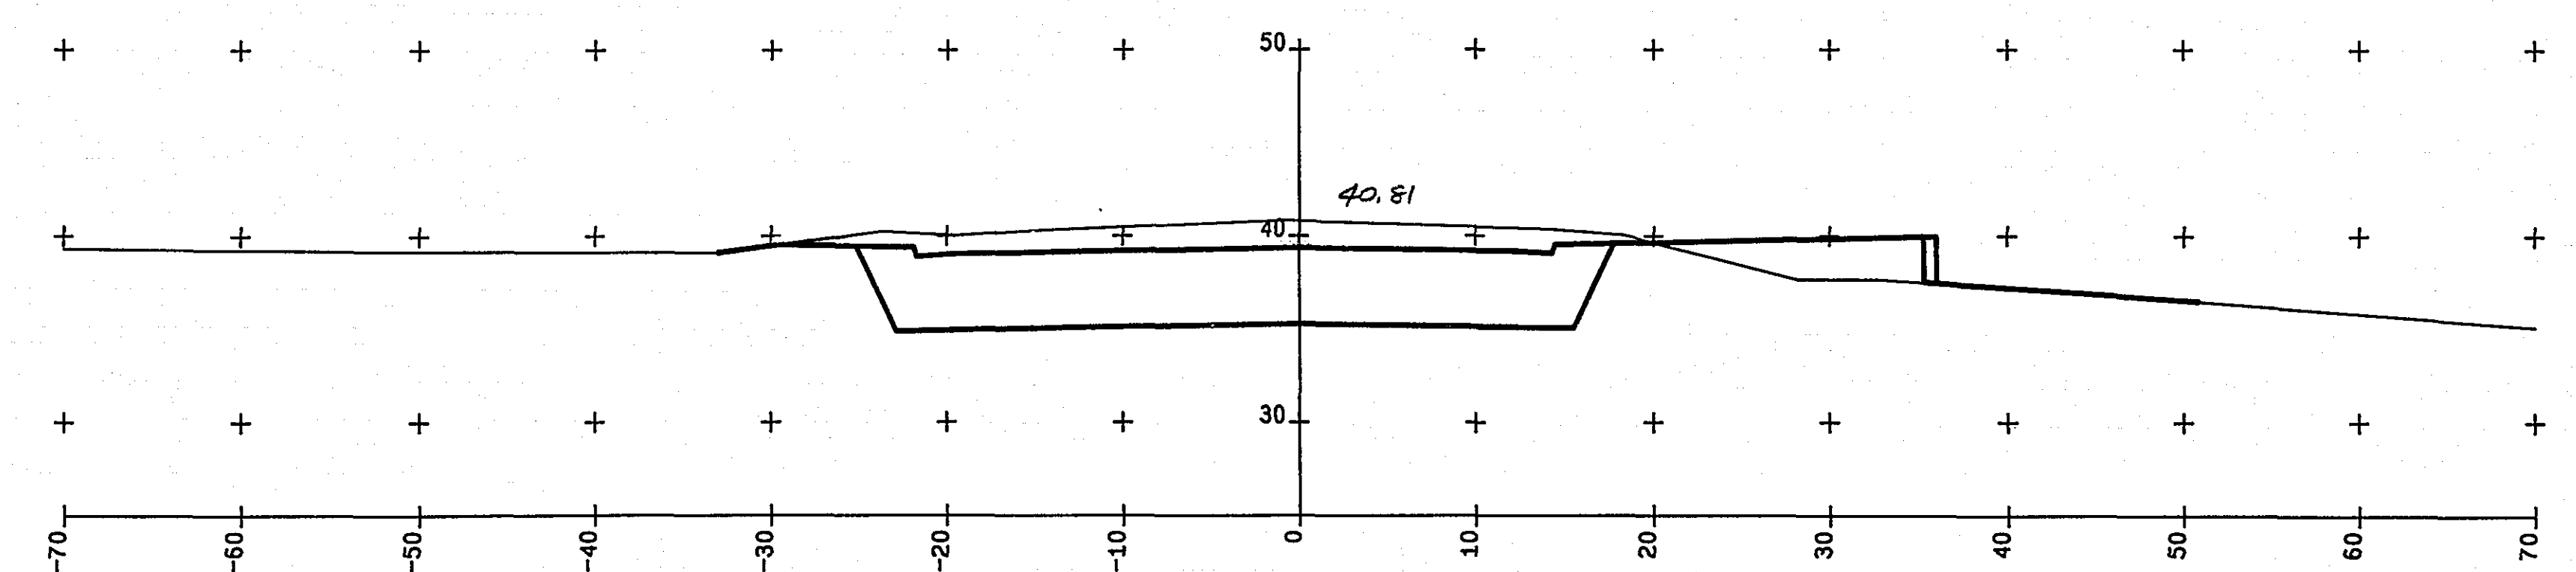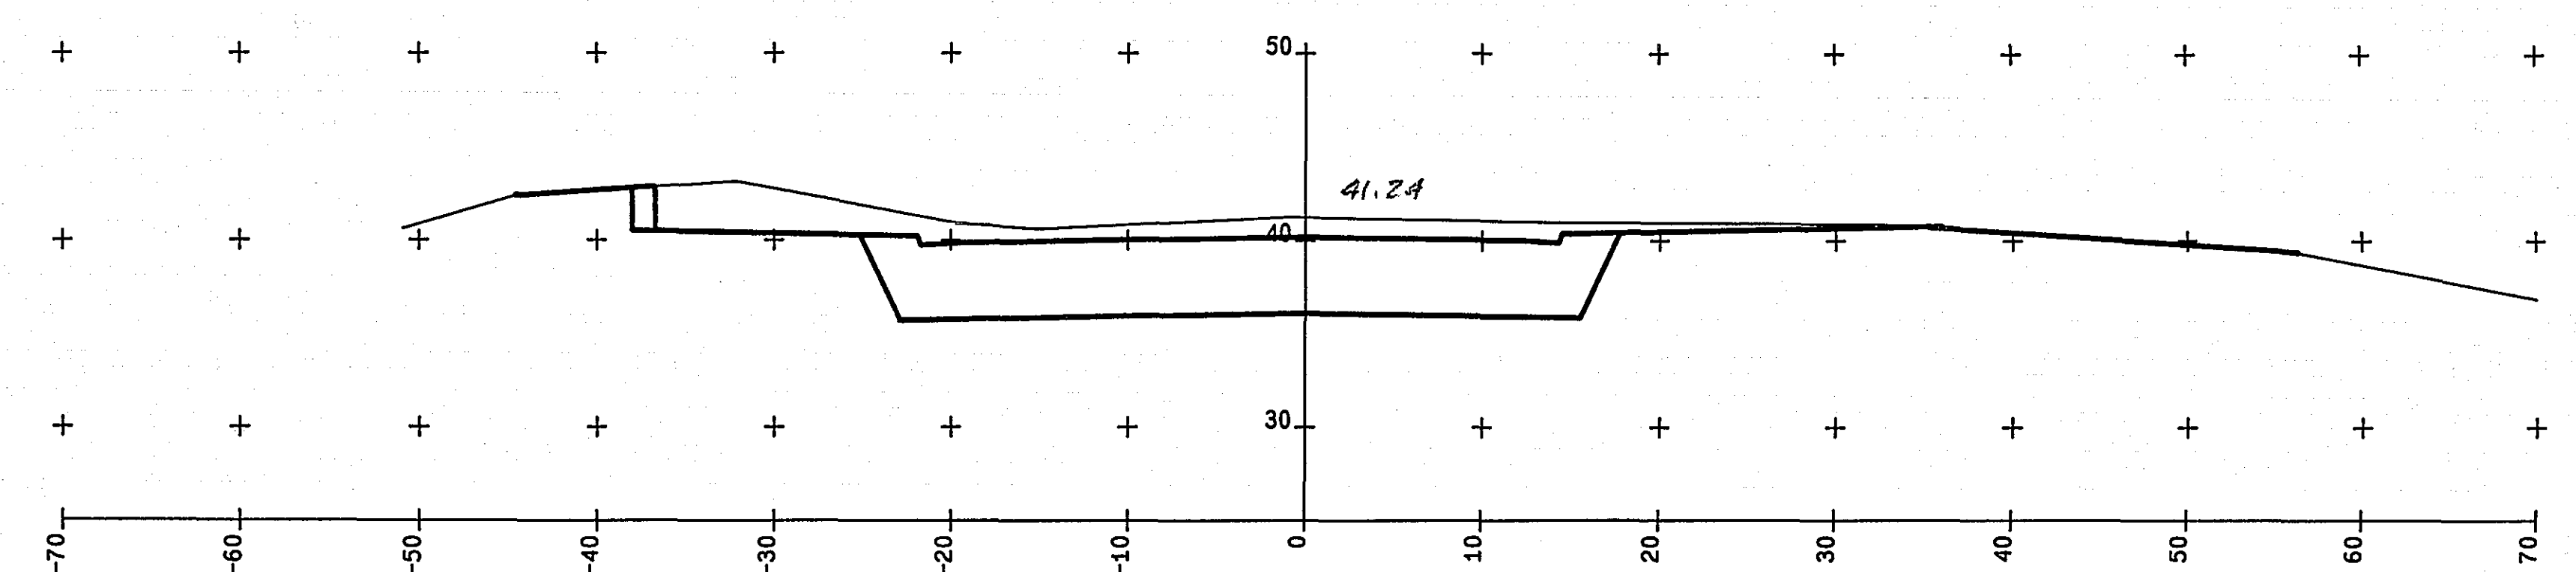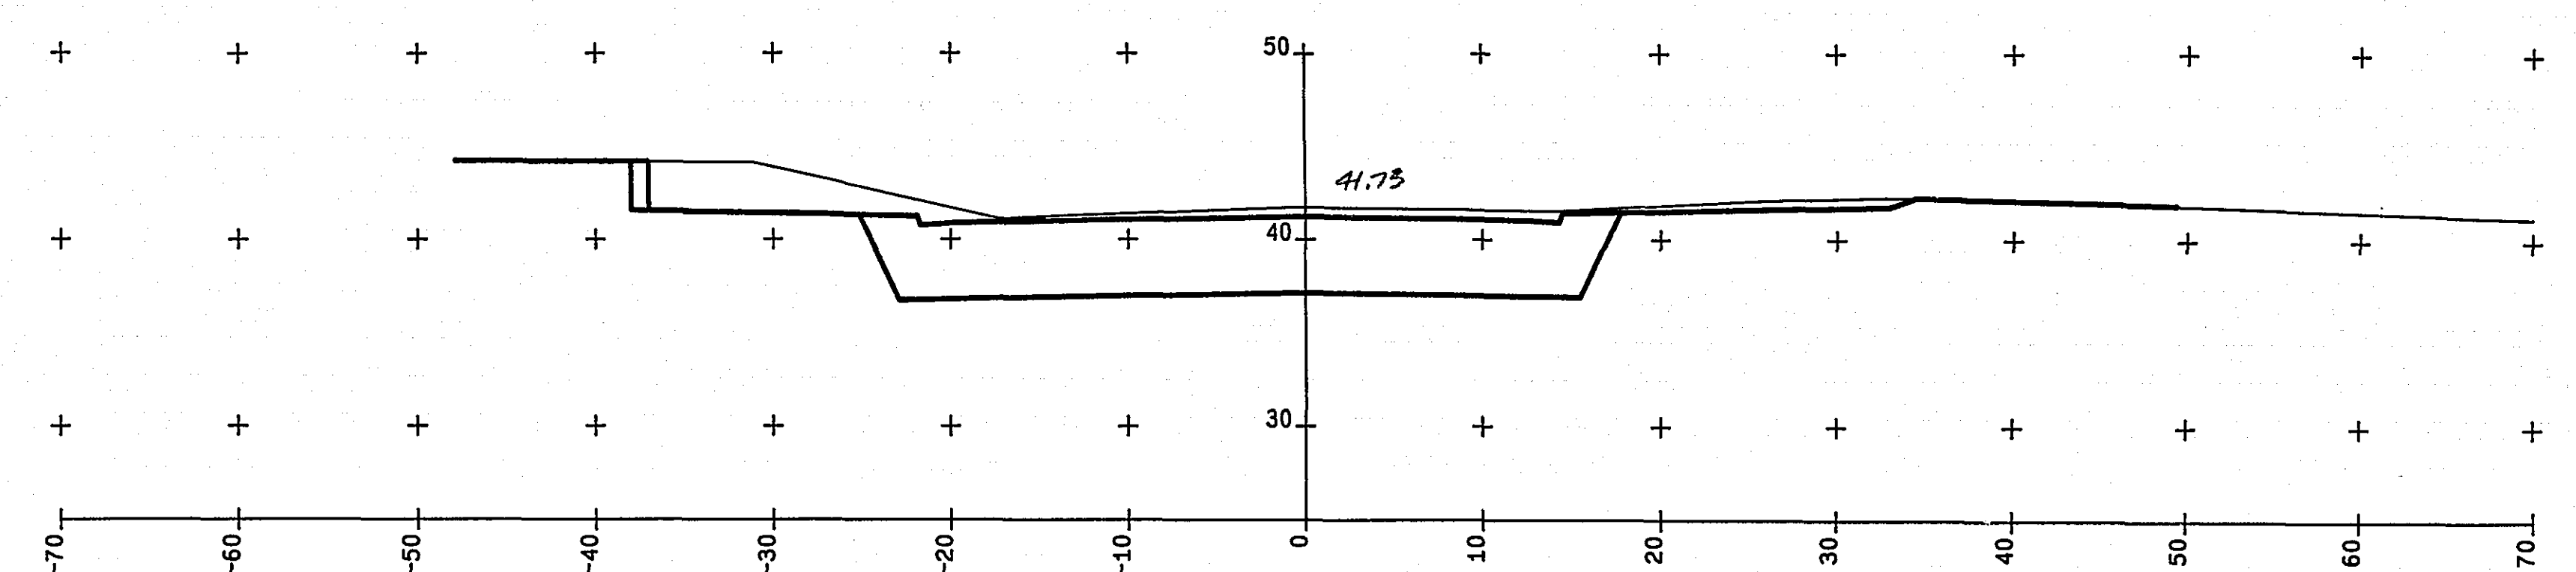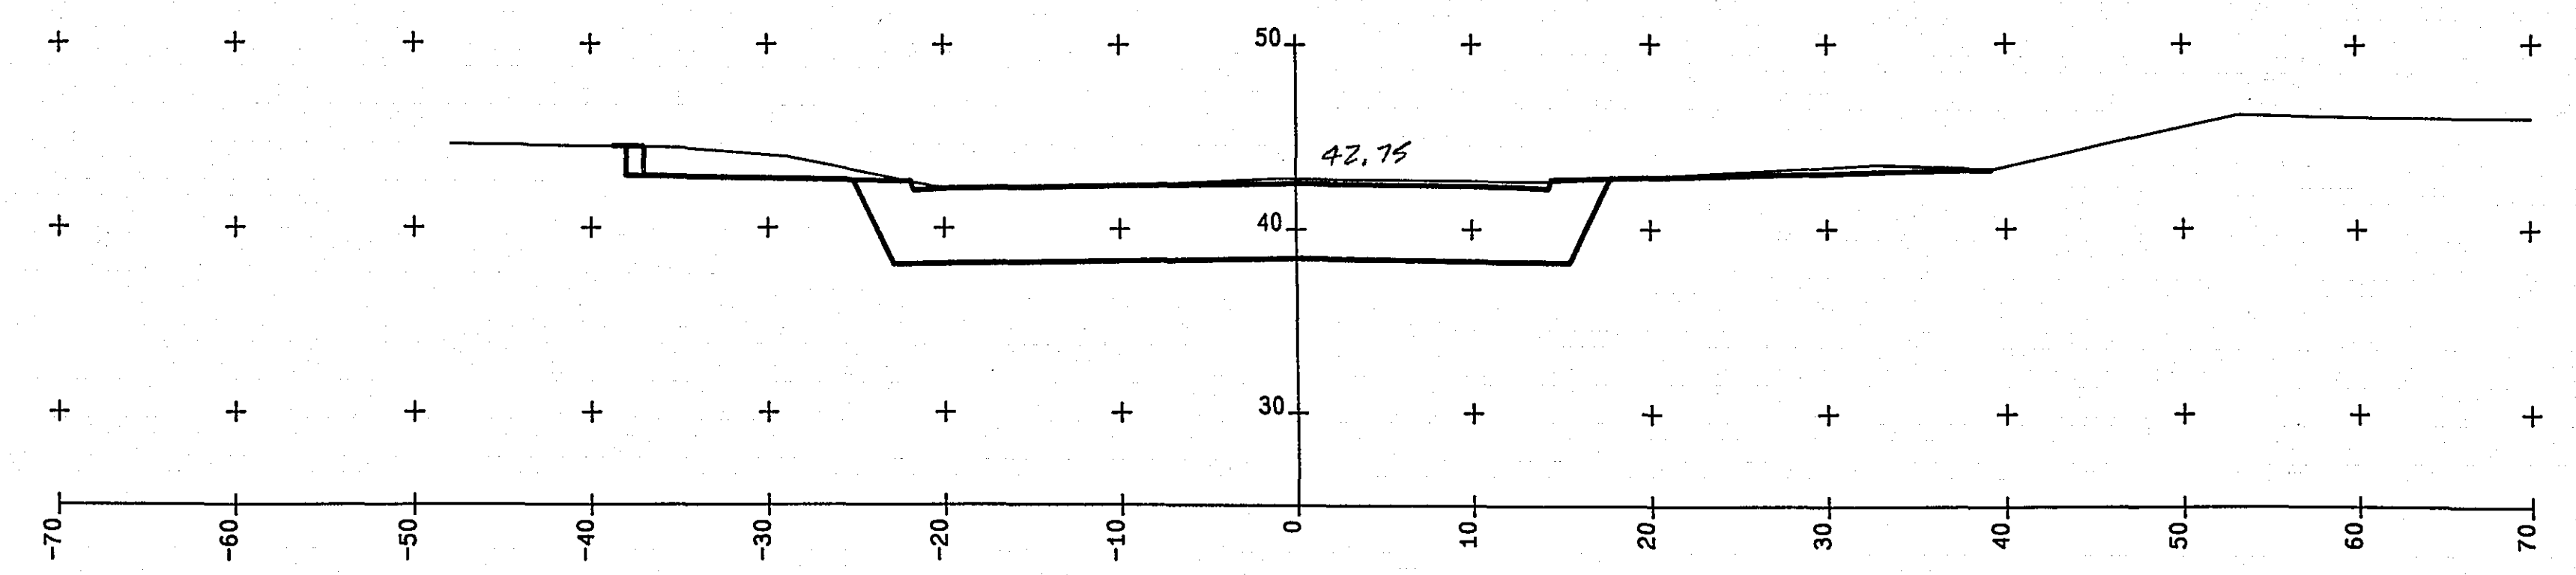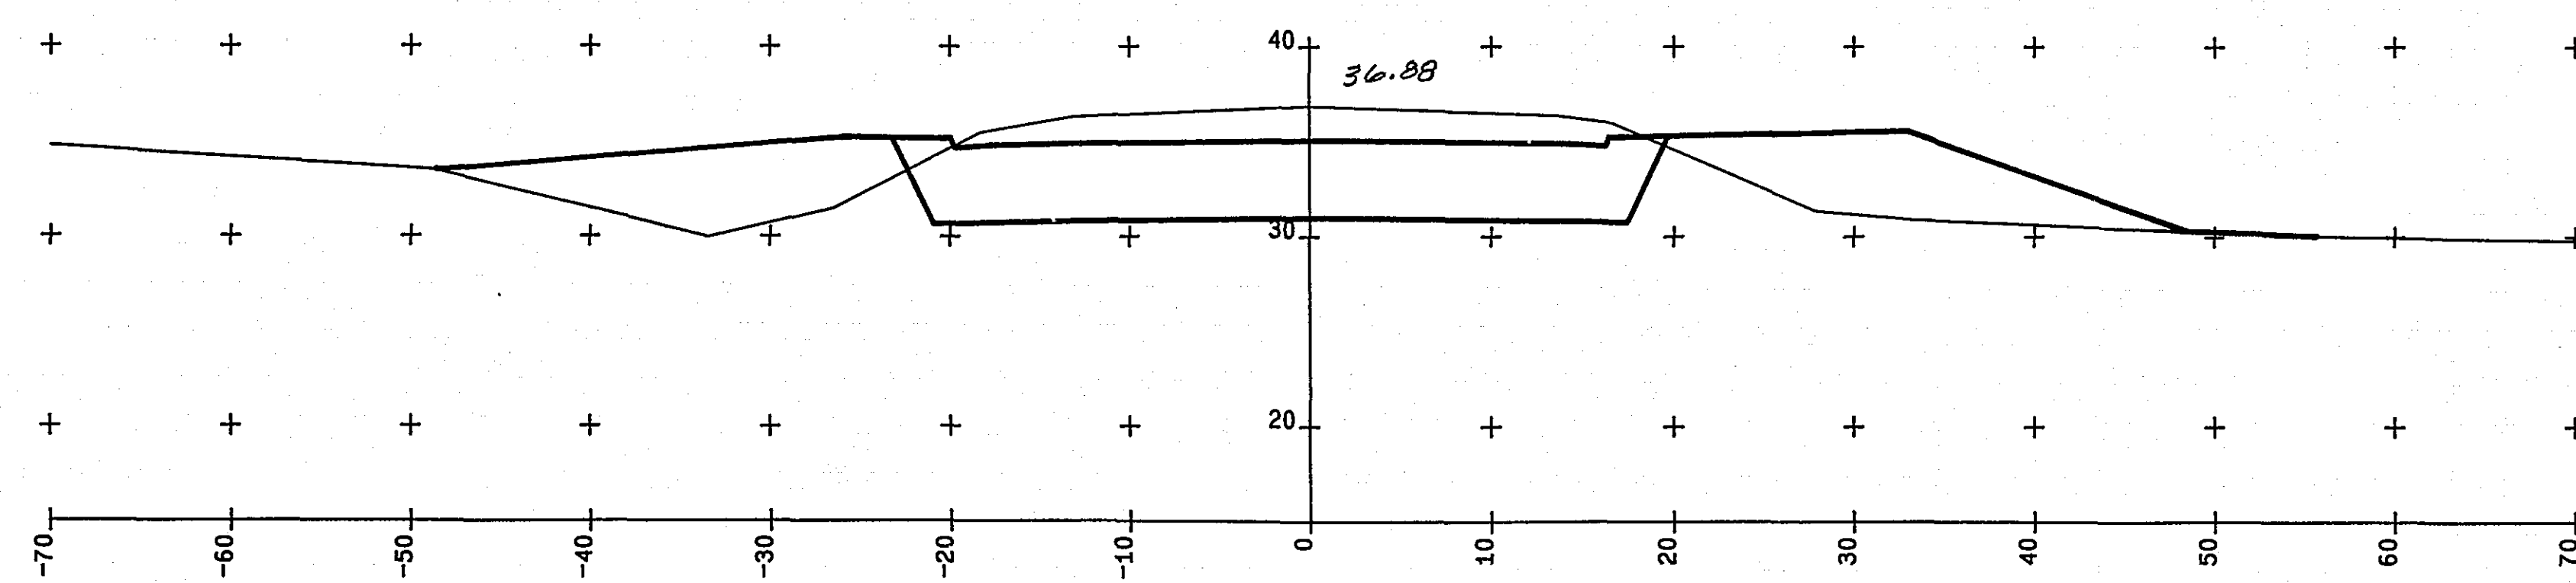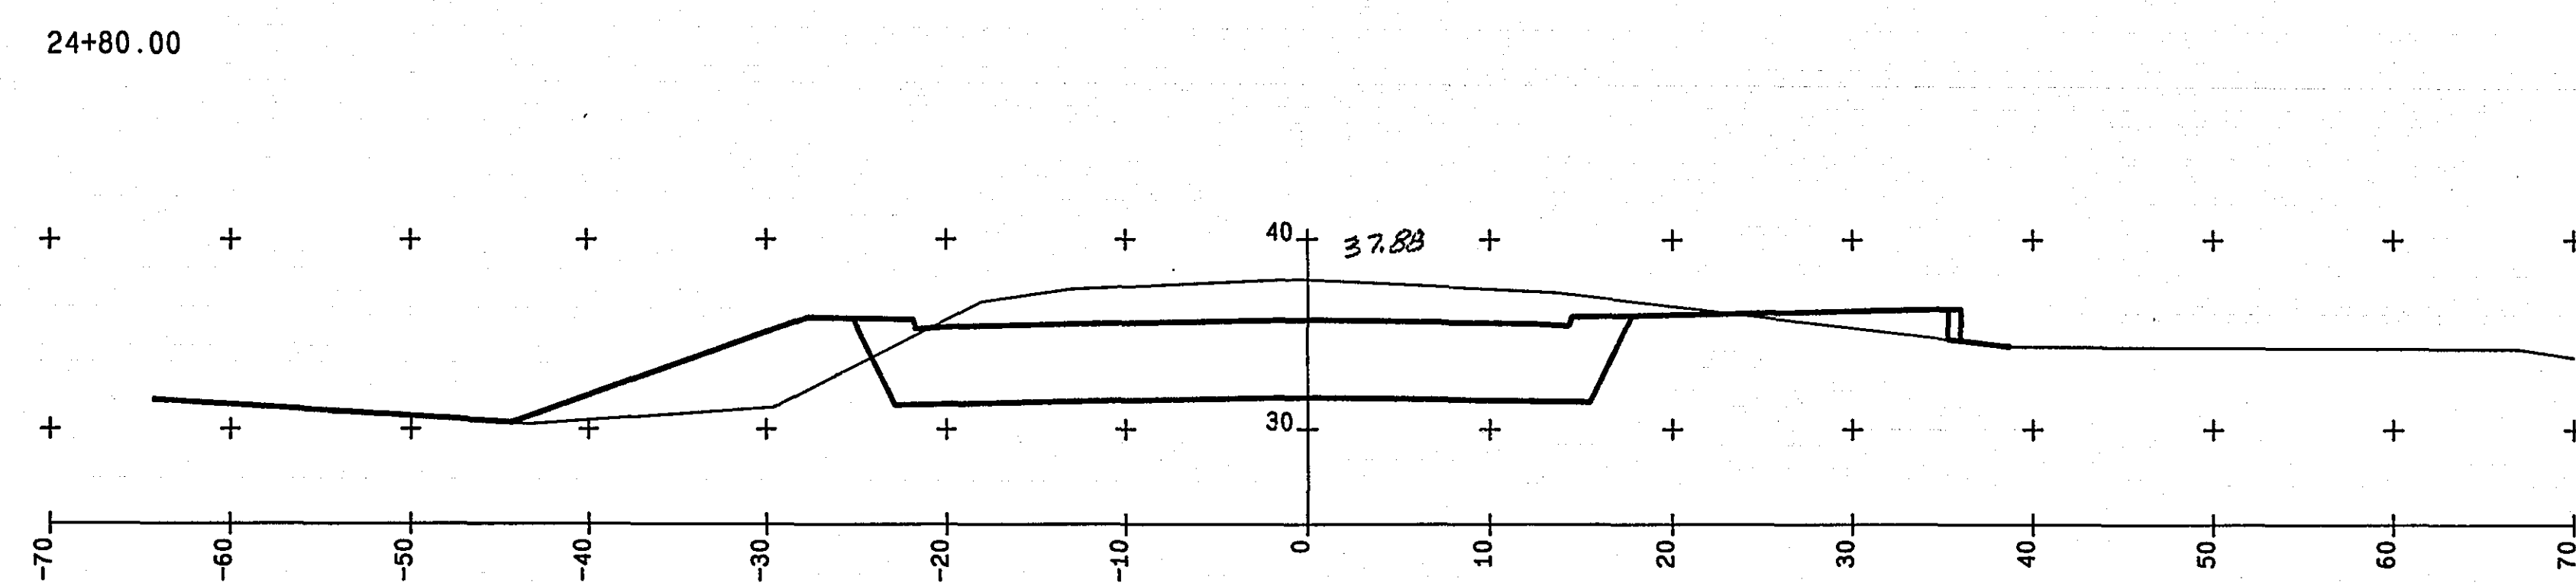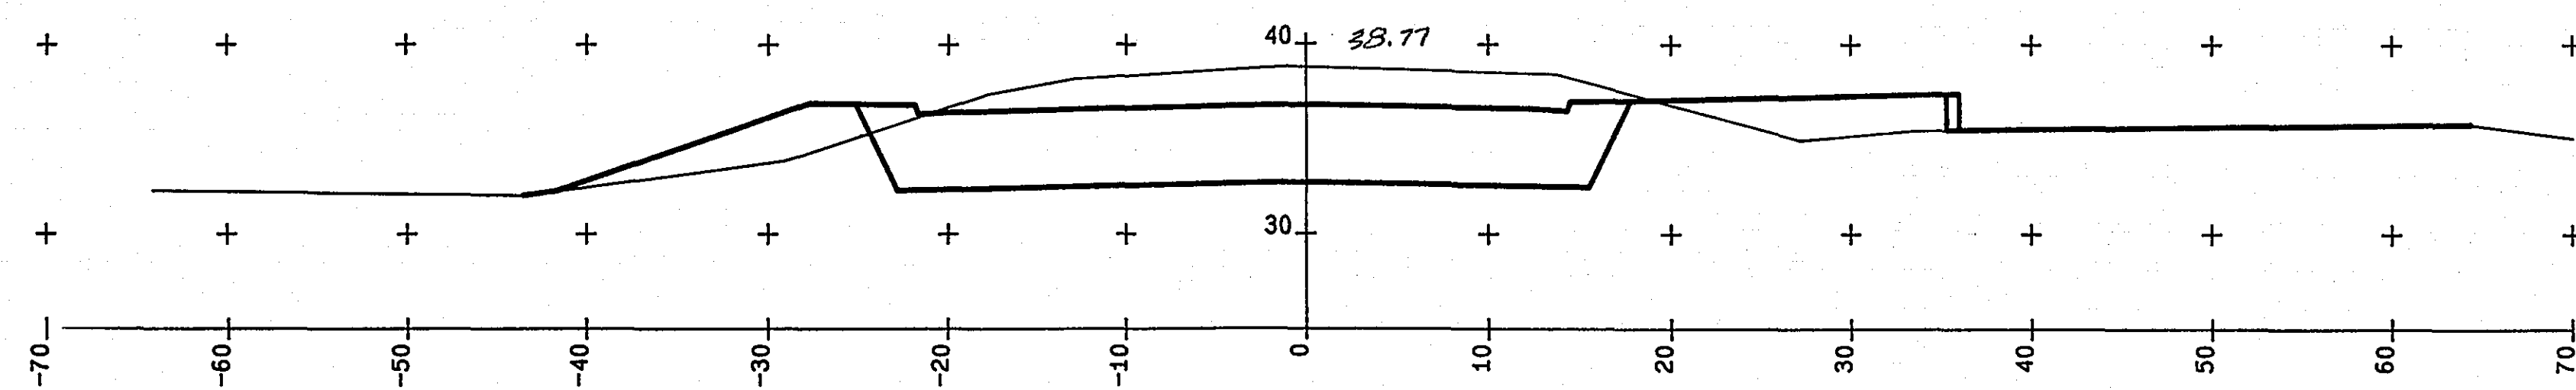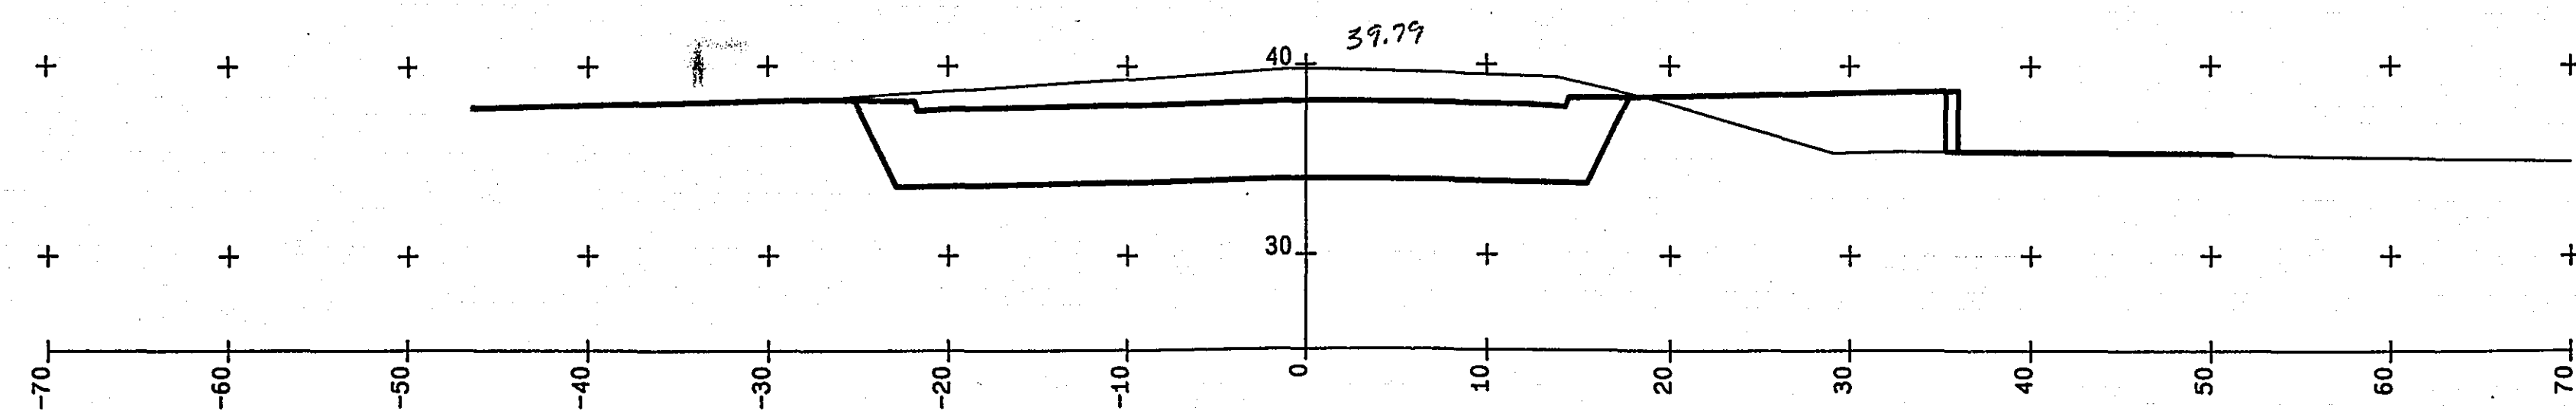


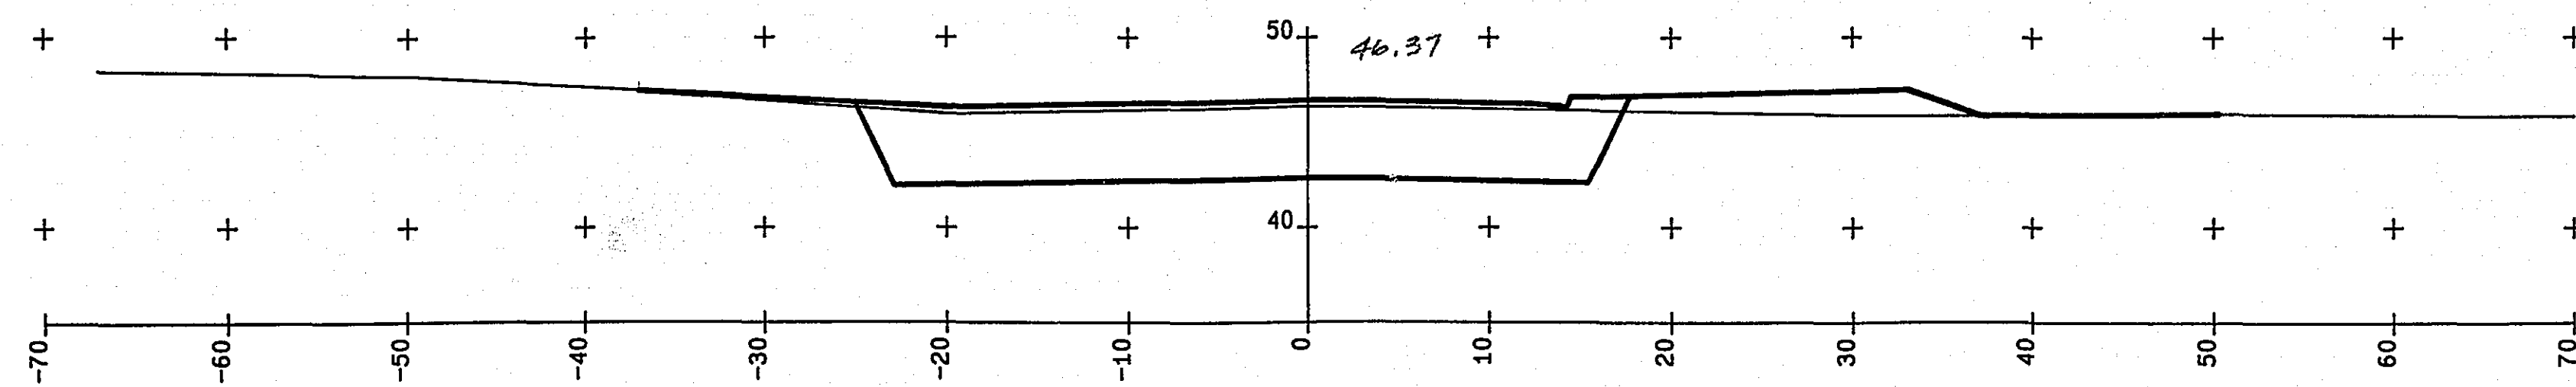


28+90.00

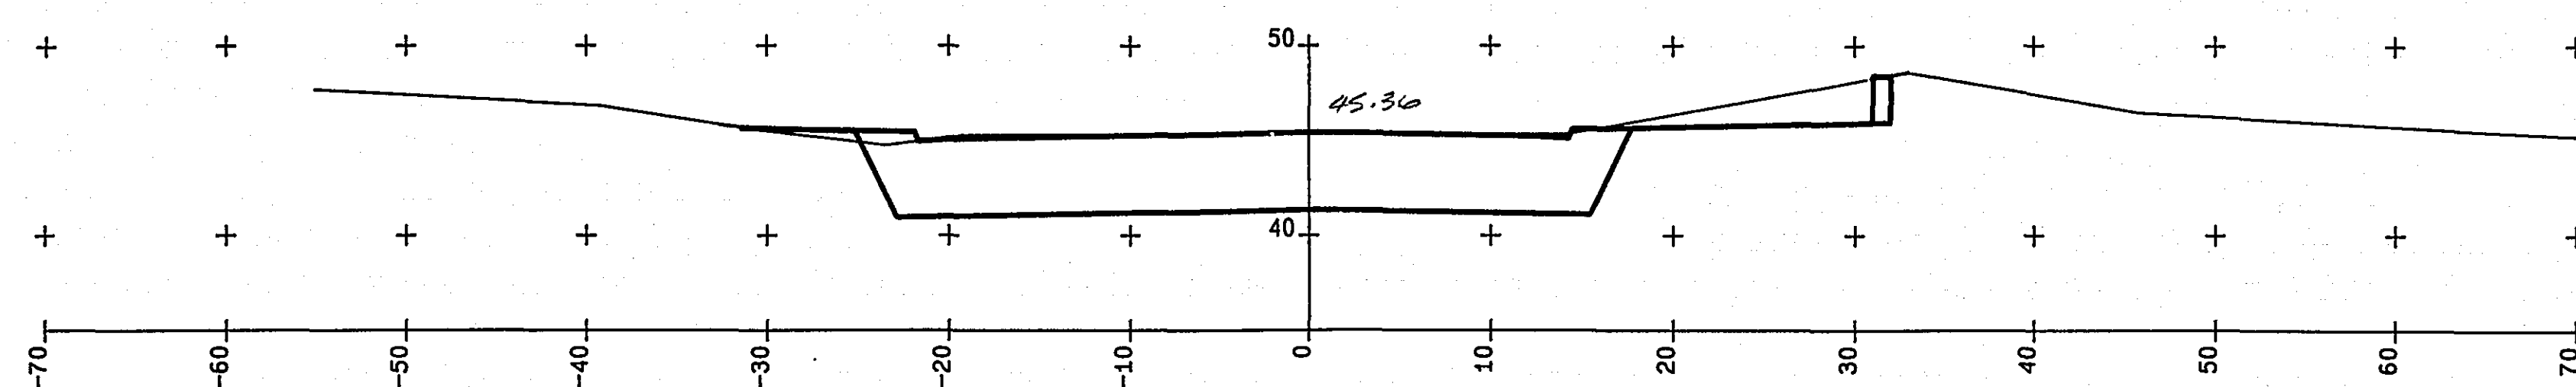


28+37.00

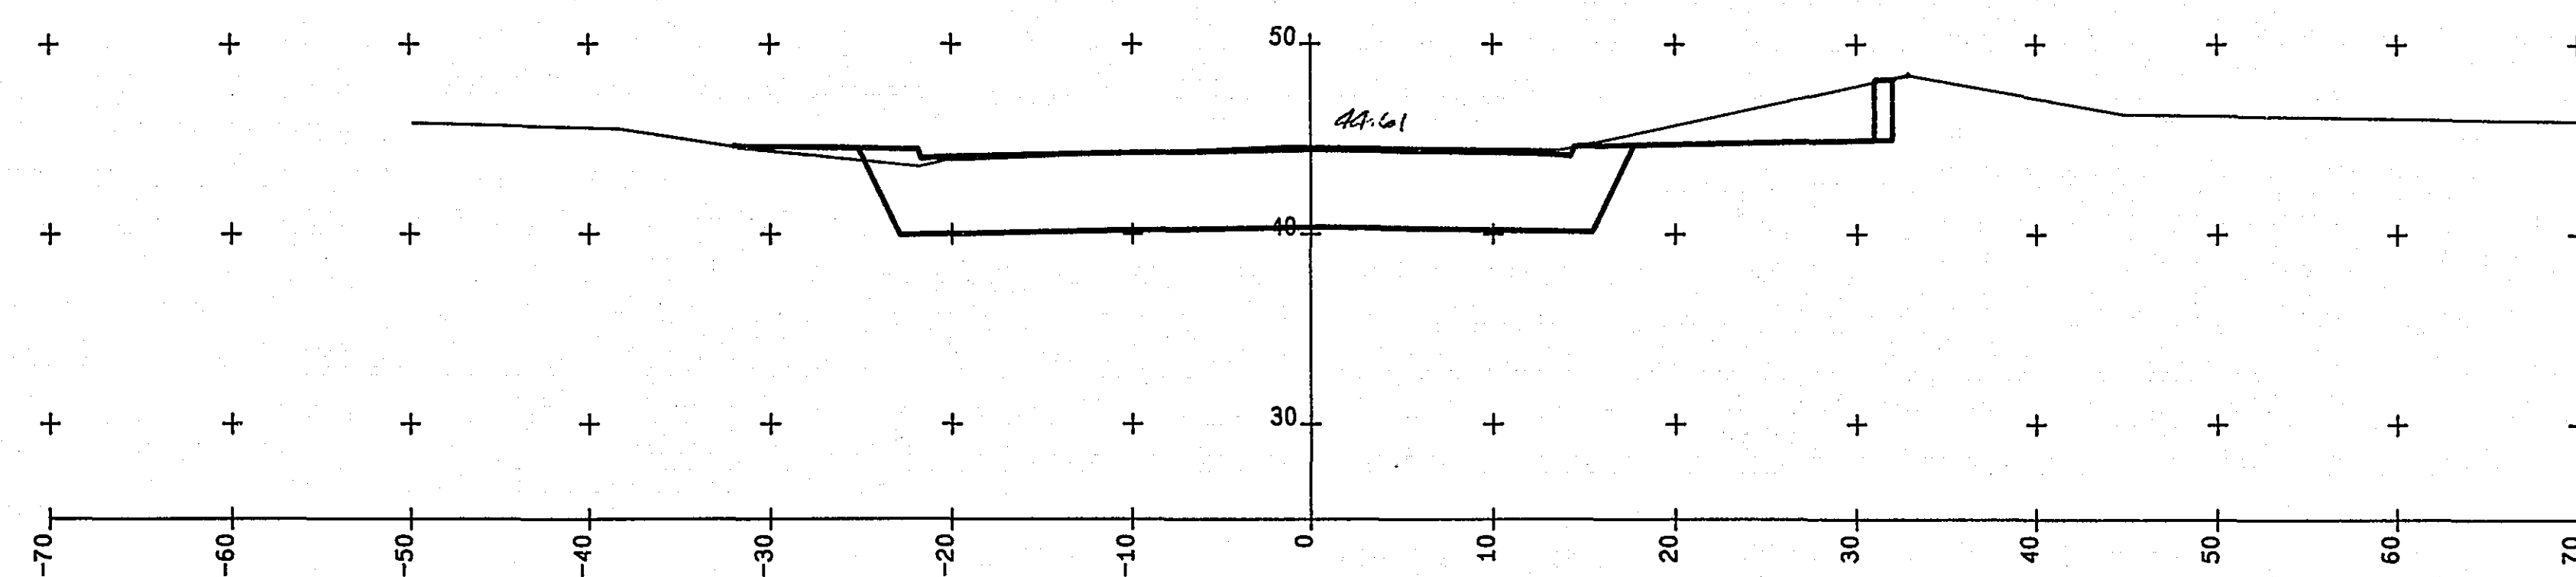


27+96.00

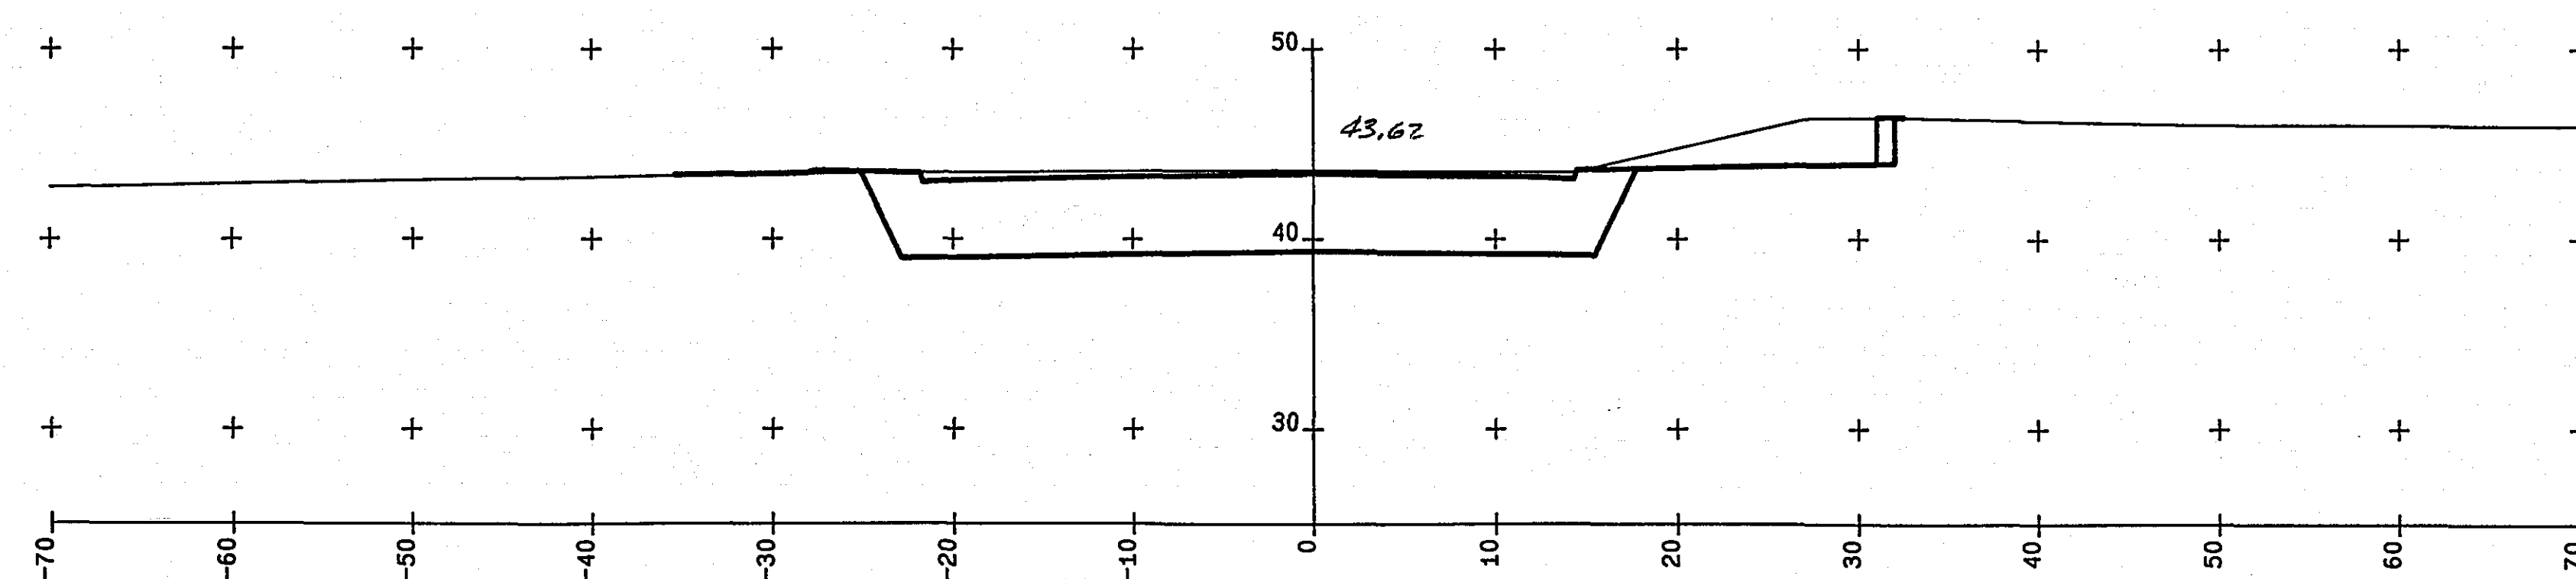


27+55.00

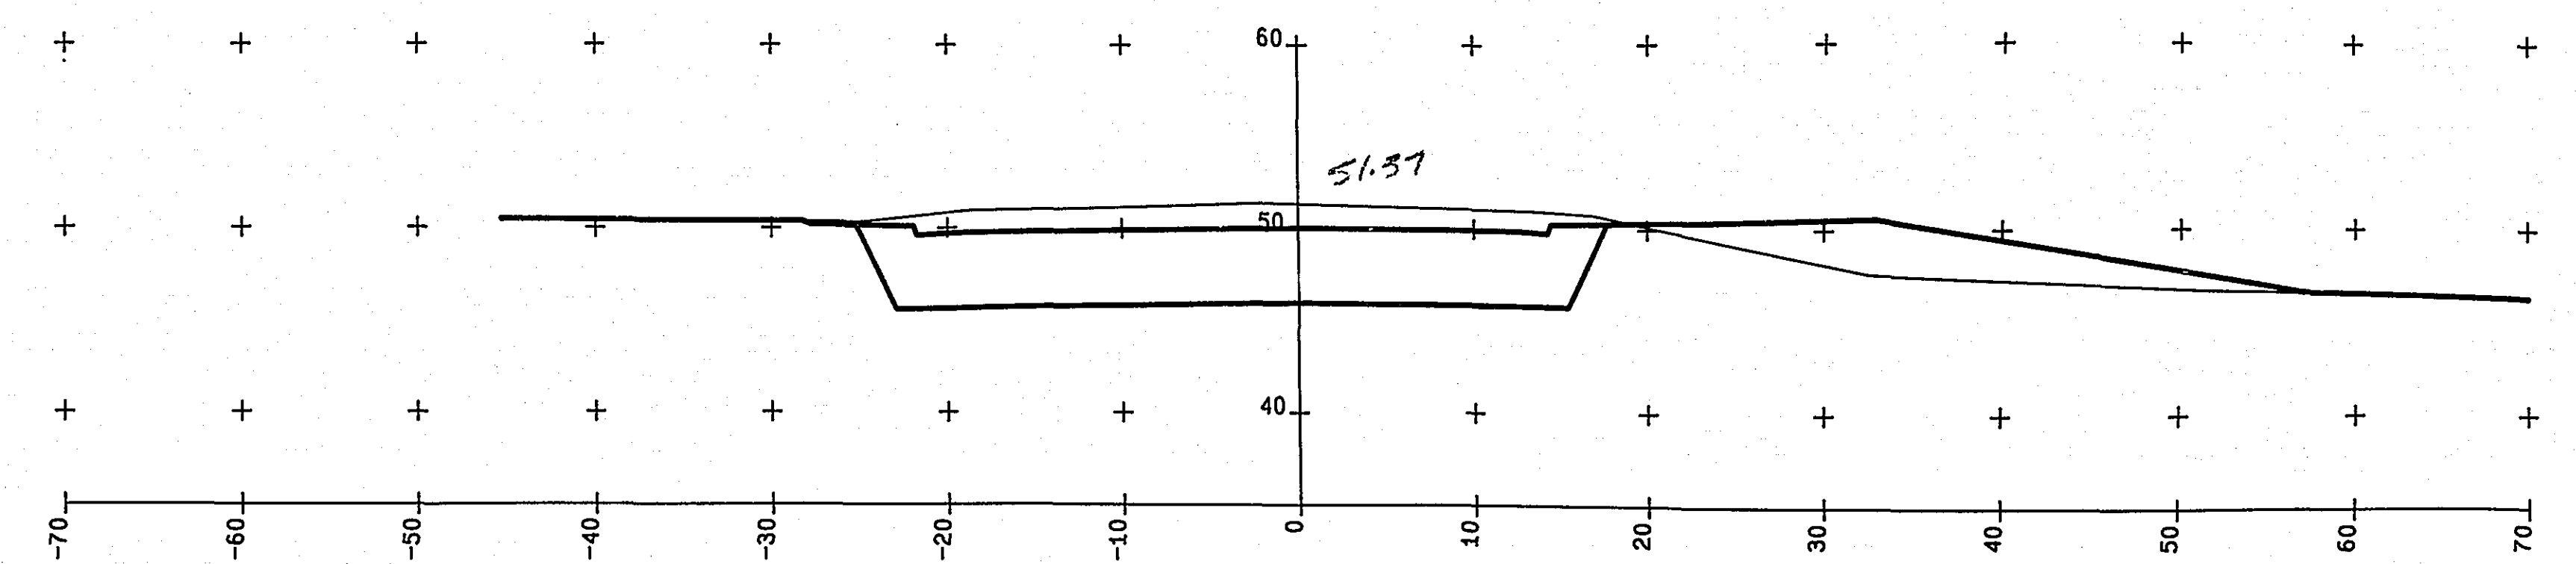


31+13.00

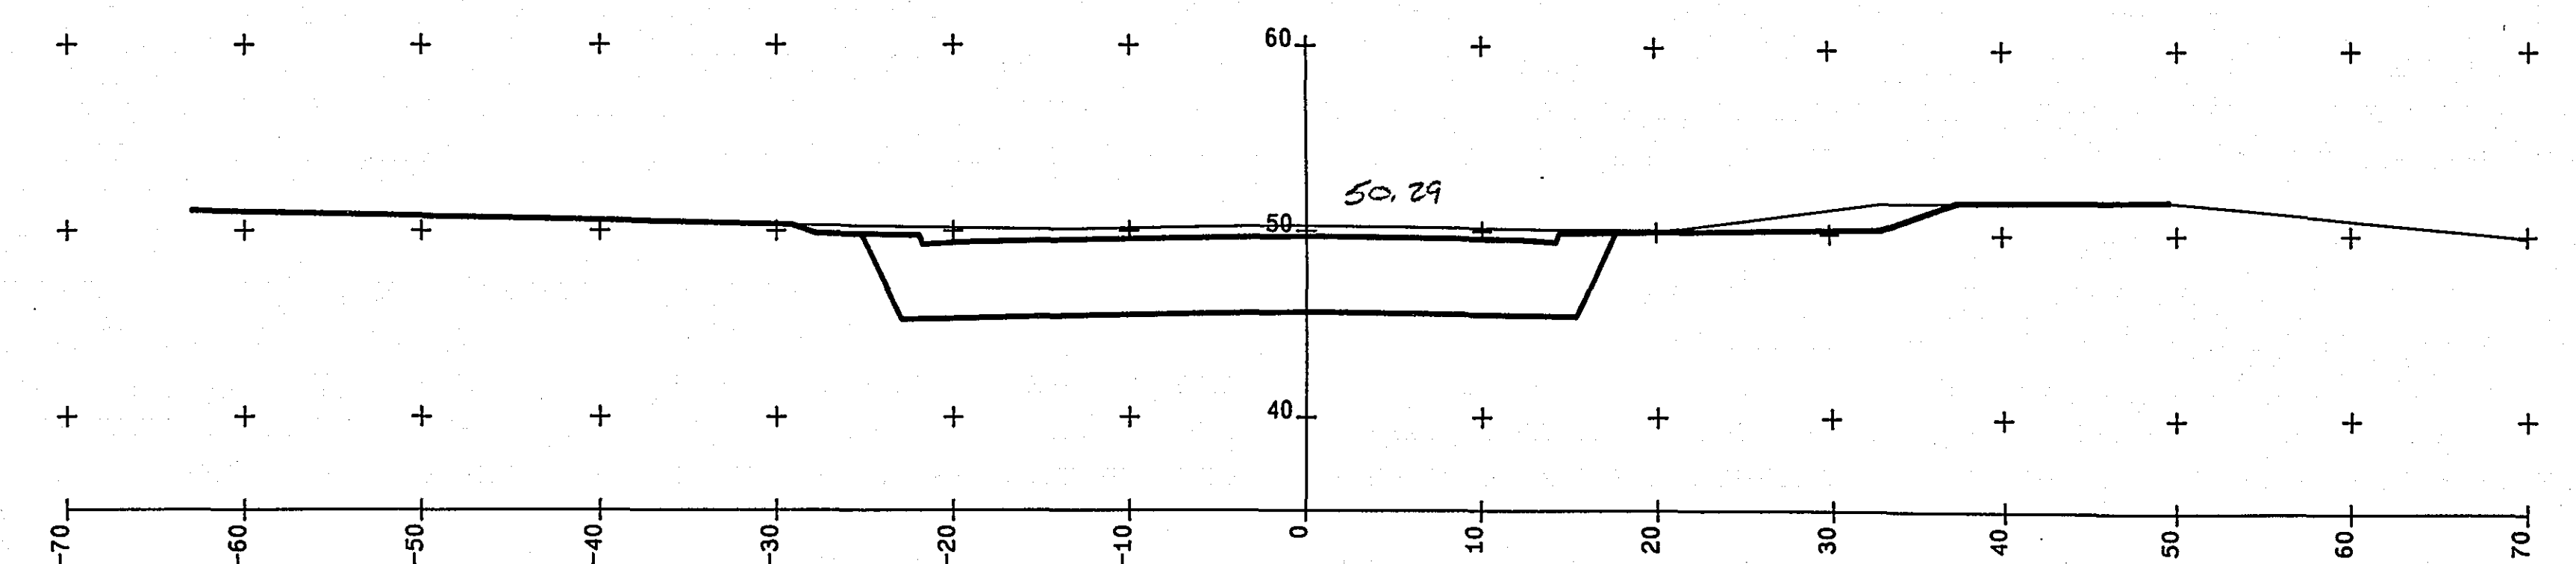


30+59.00

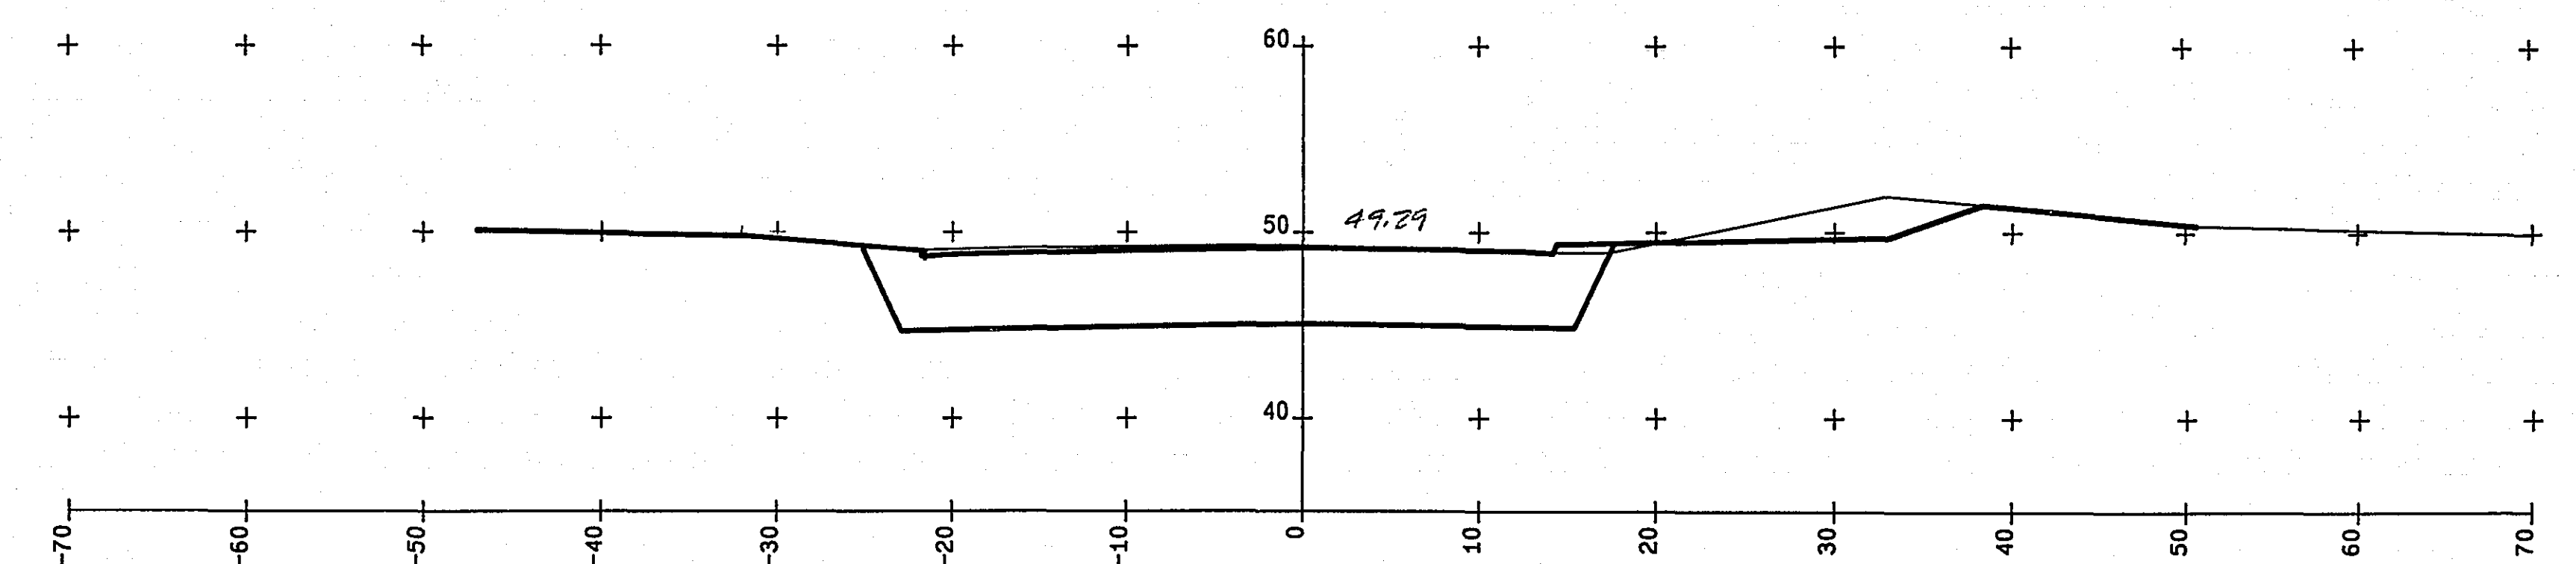


30+03.00

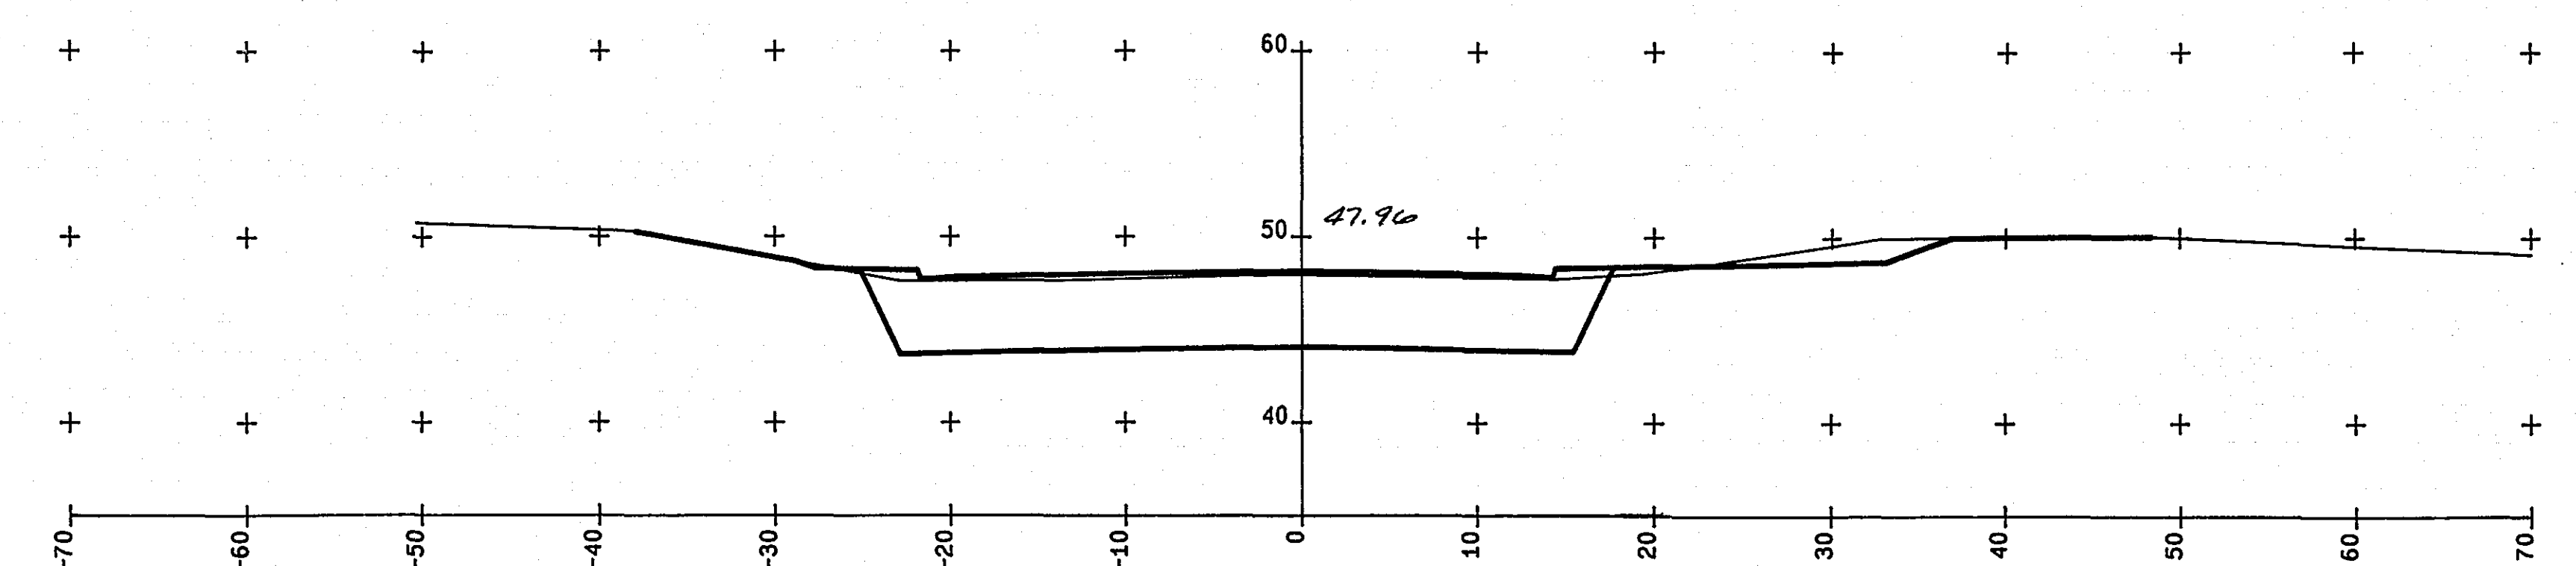


29+51.00

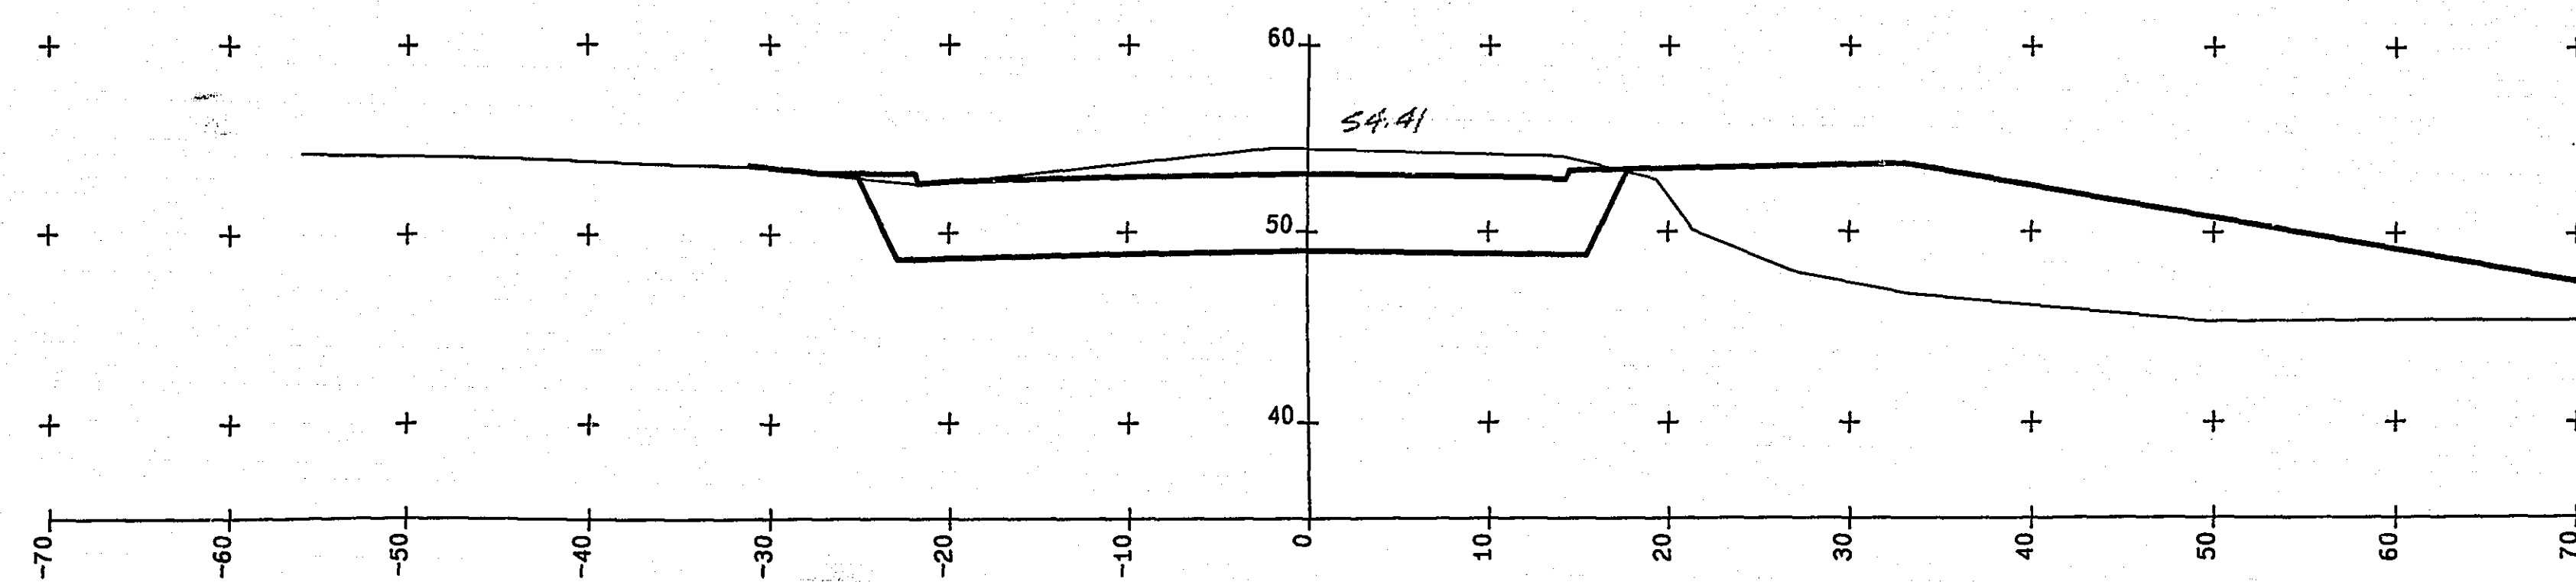


33+05.00

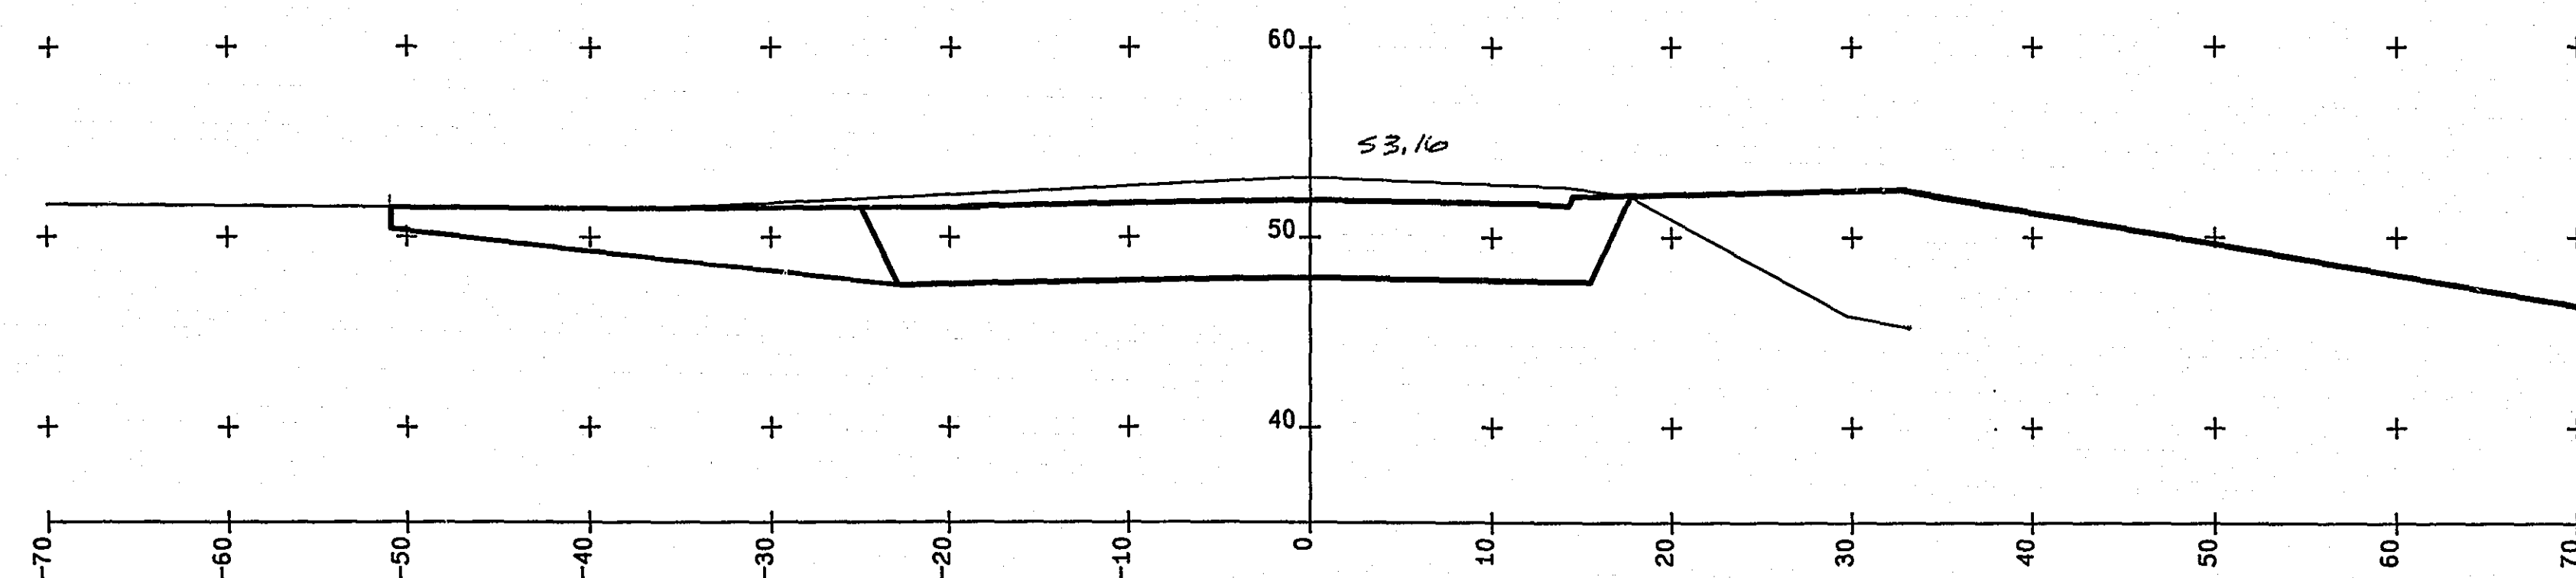


32+70.00

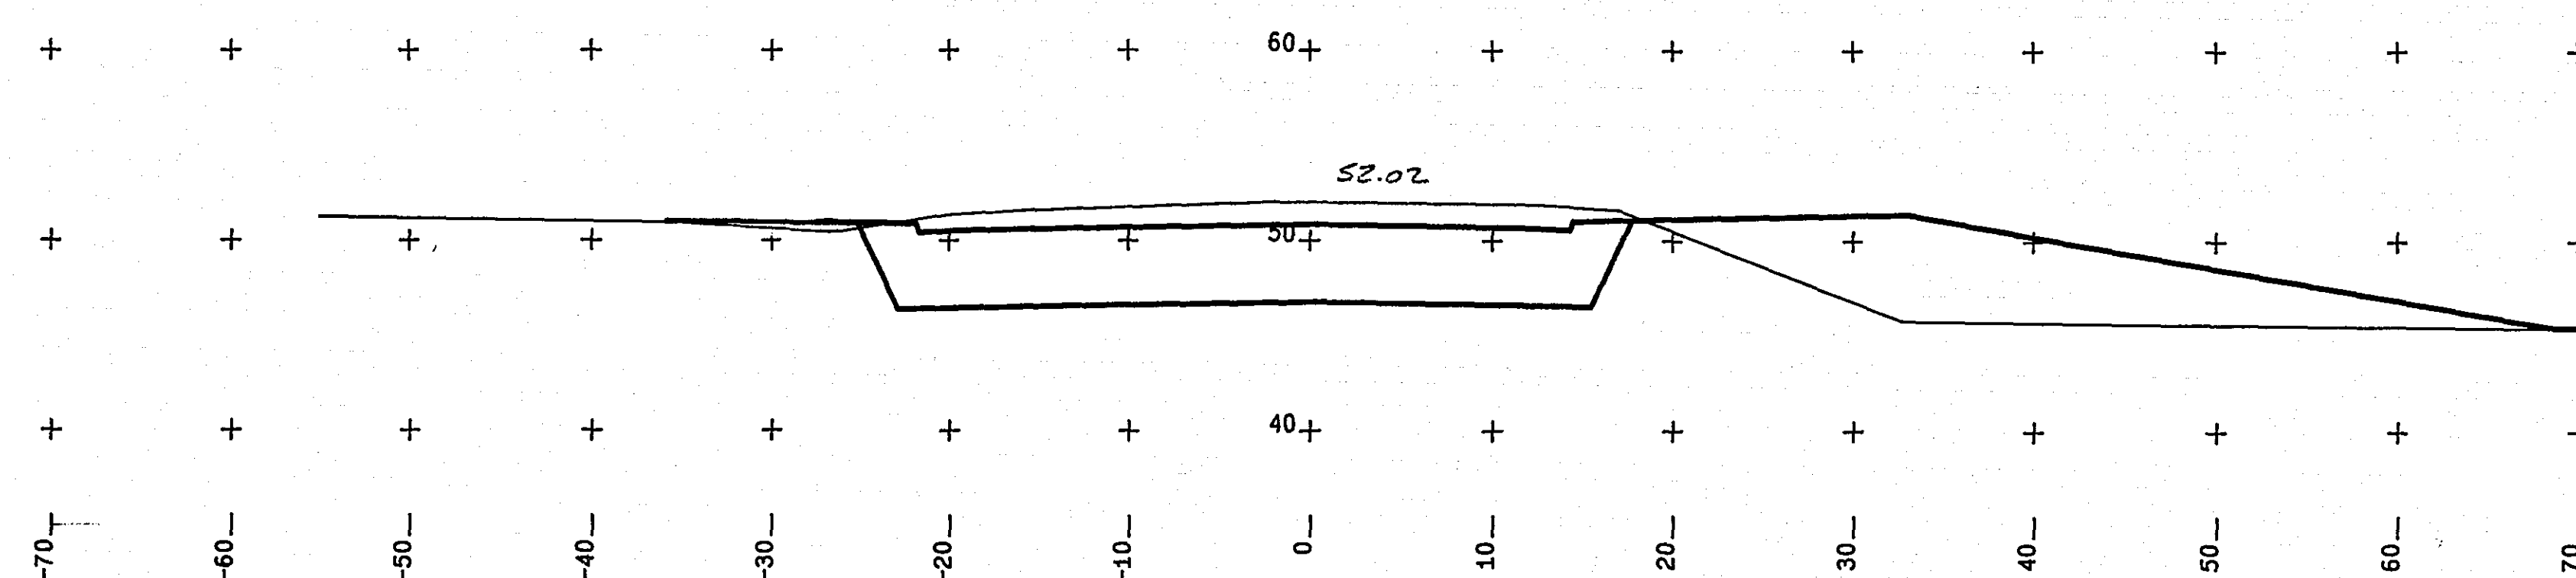


32+18.00

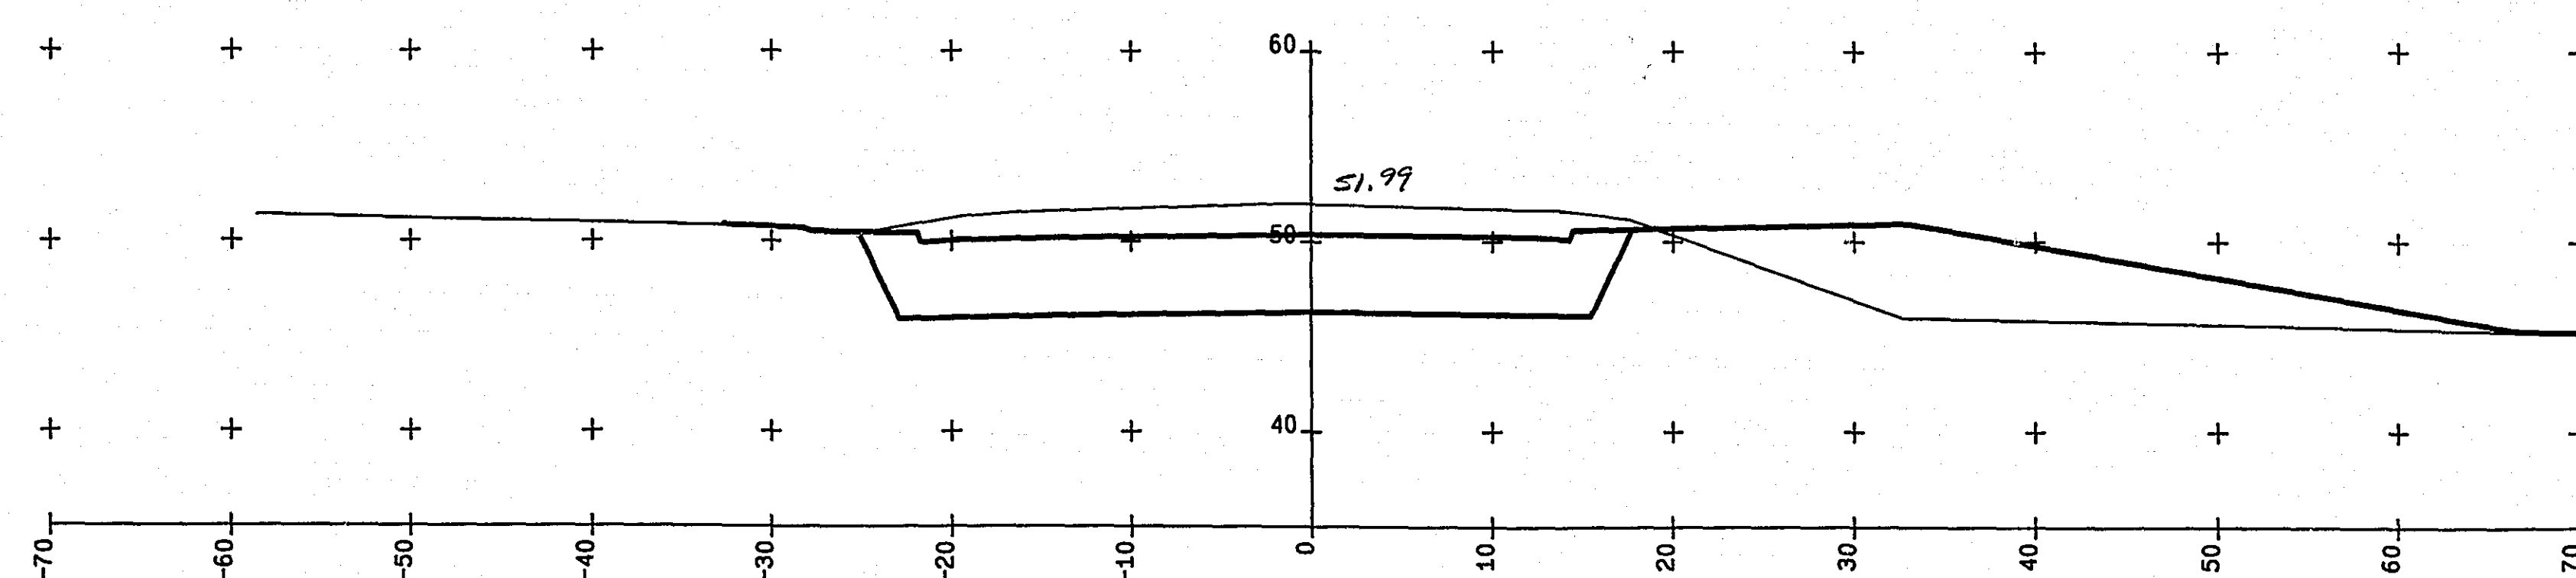


31+65.00

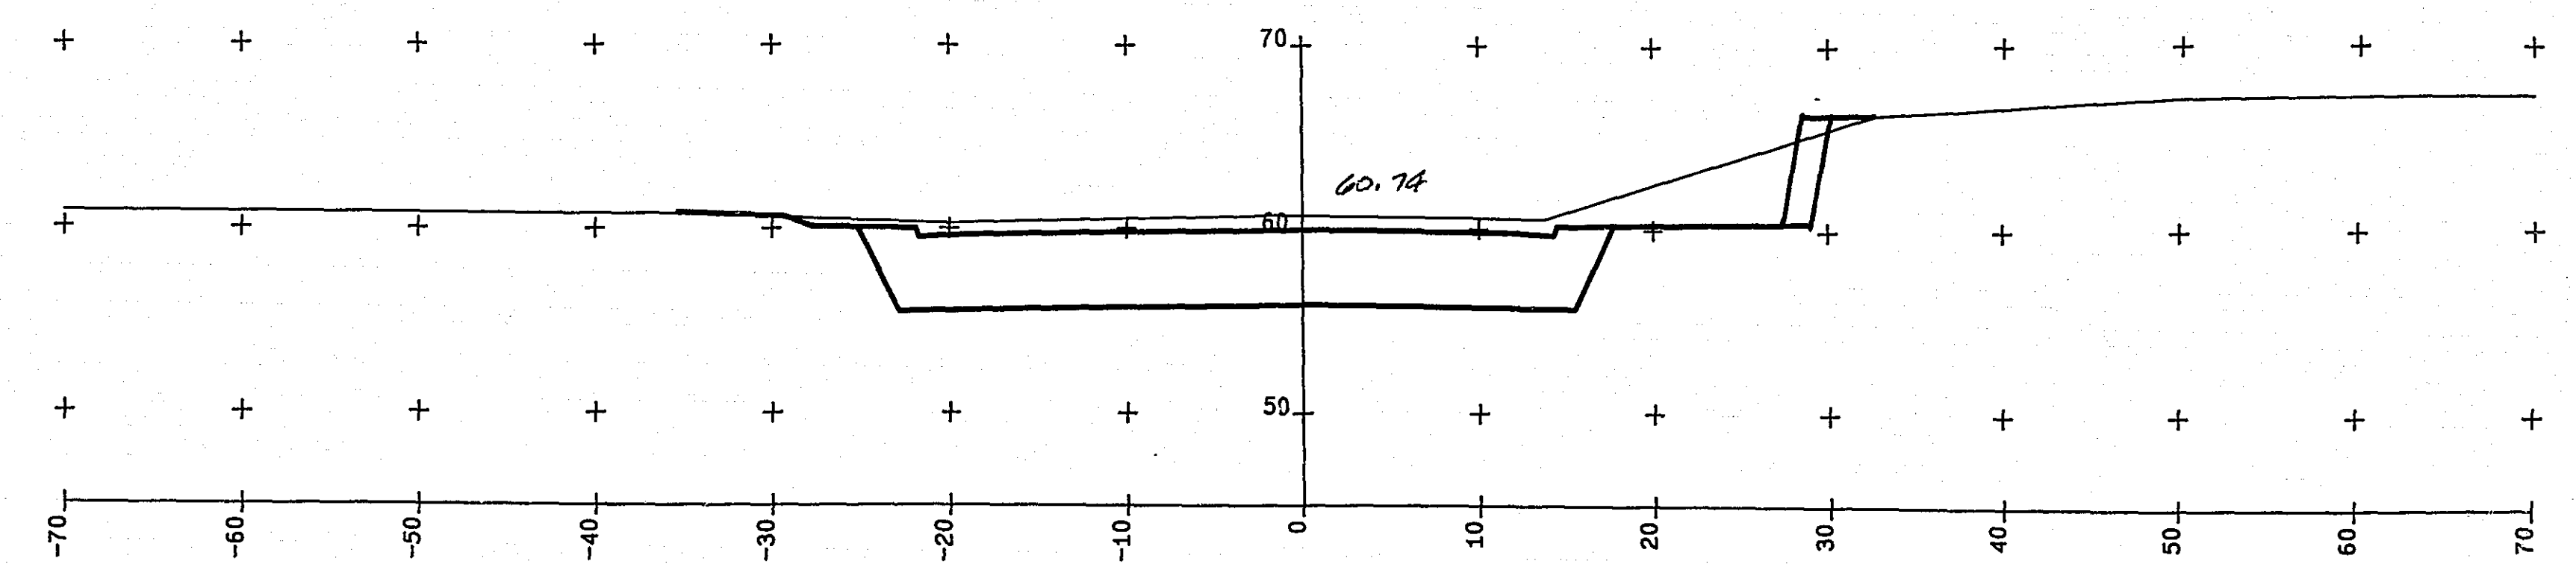


35+14.00

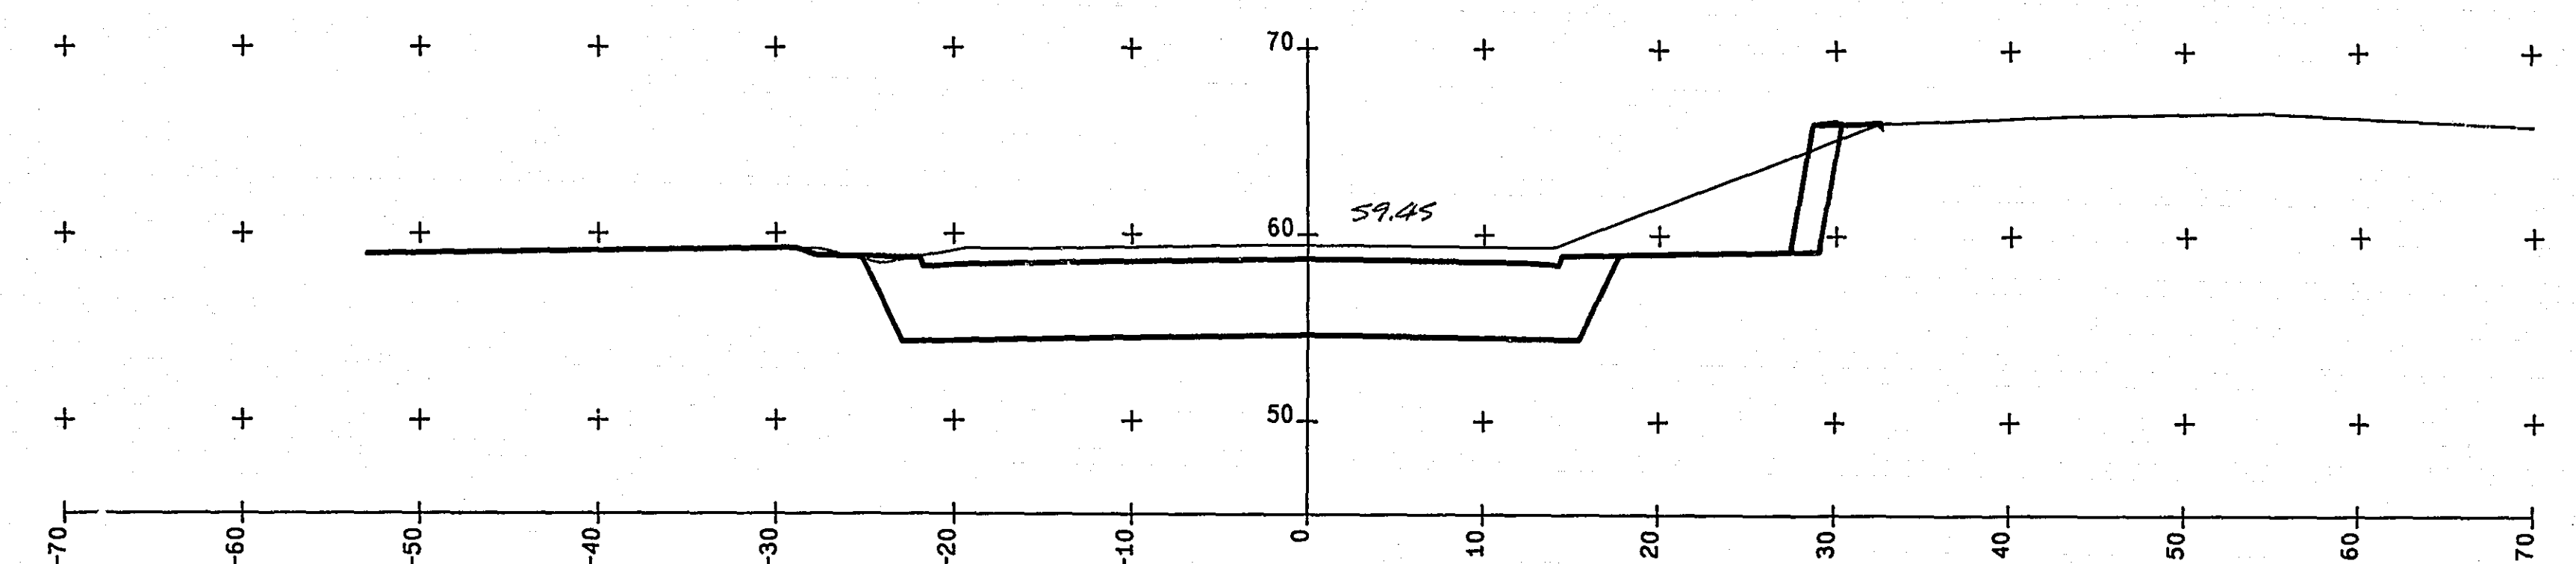


34+69.00

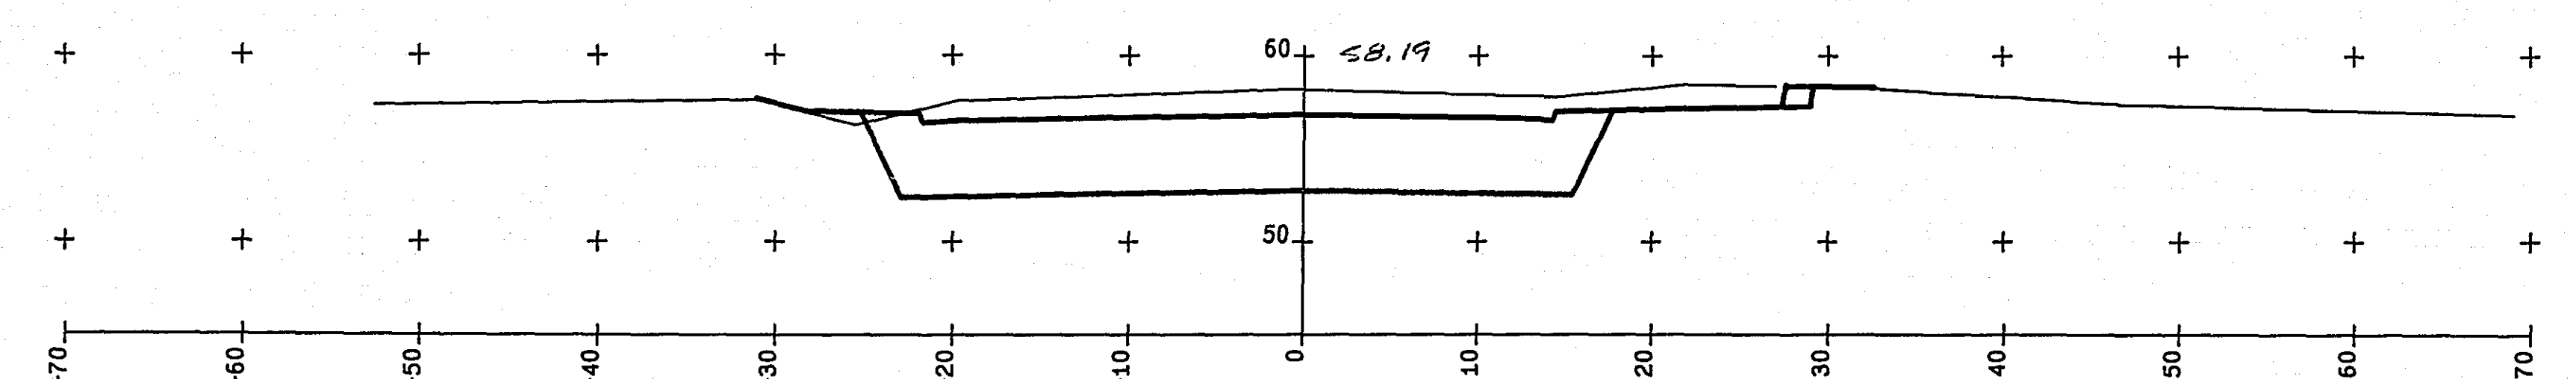


34+14.00

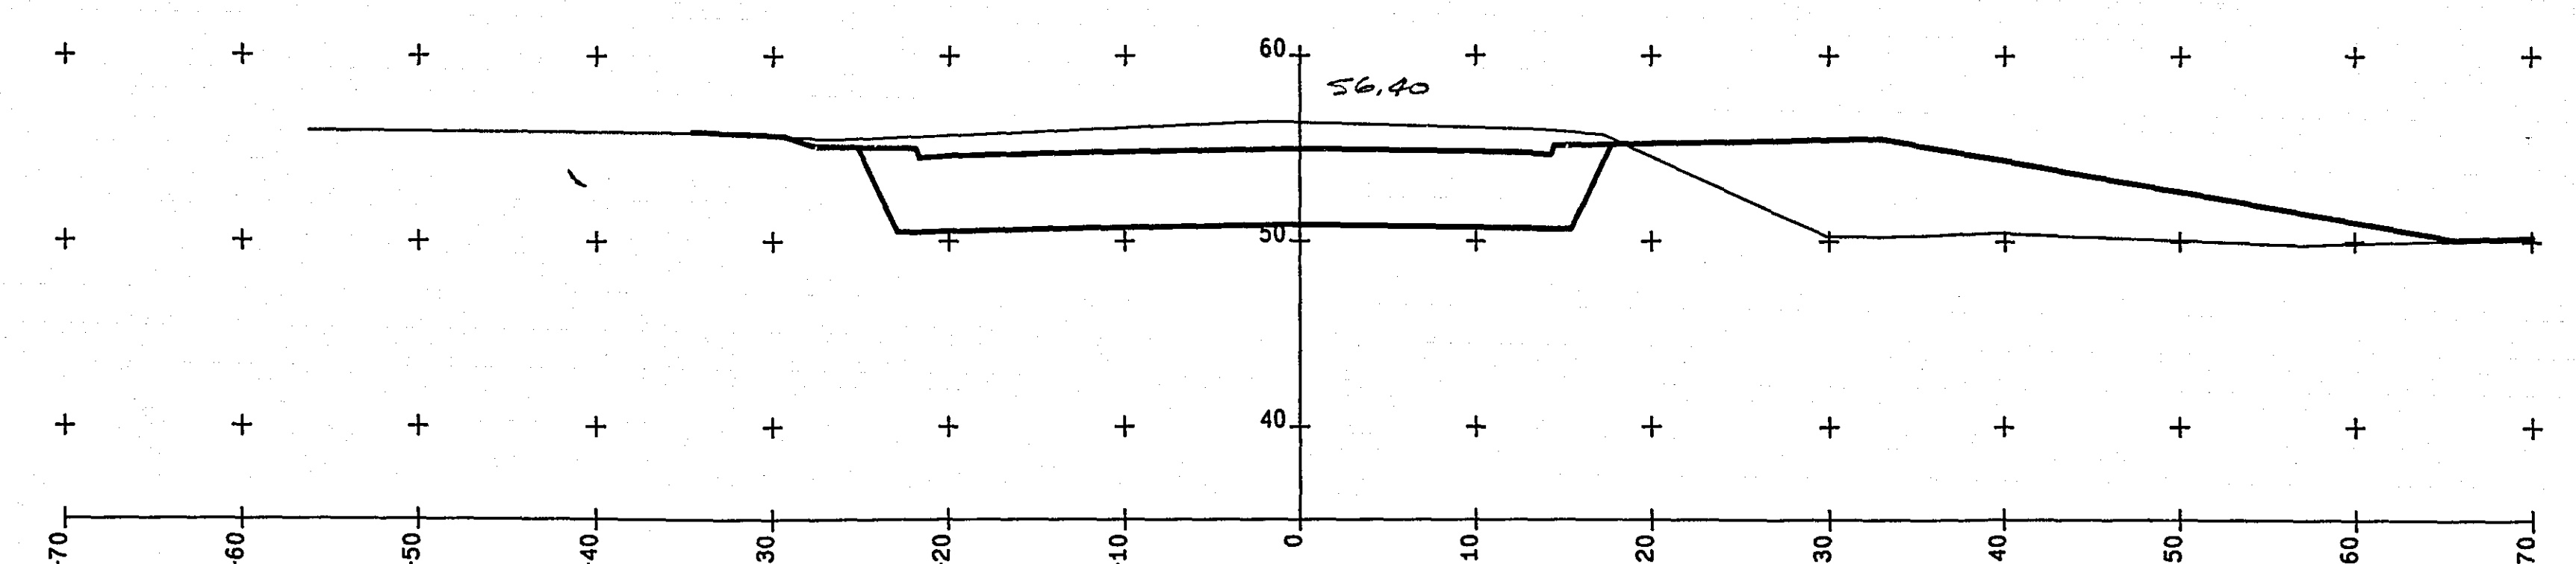


33+60.00

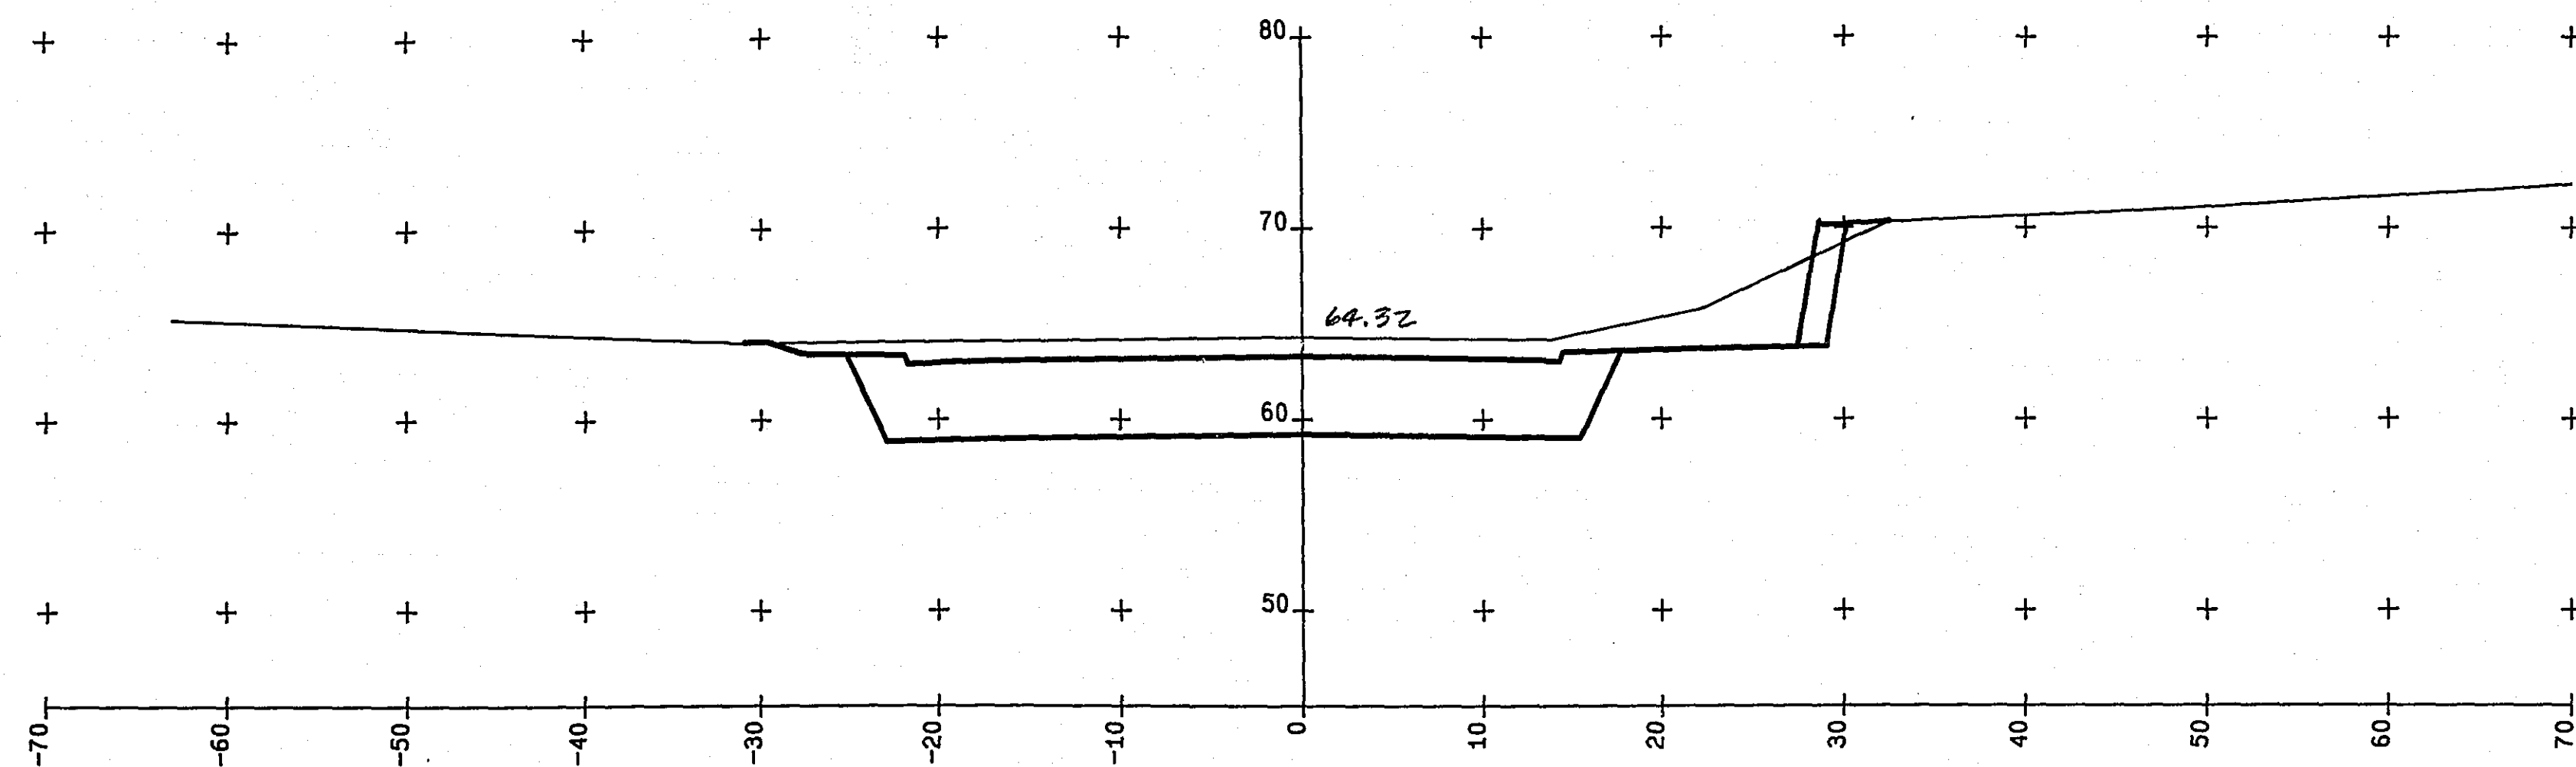


36+77.00

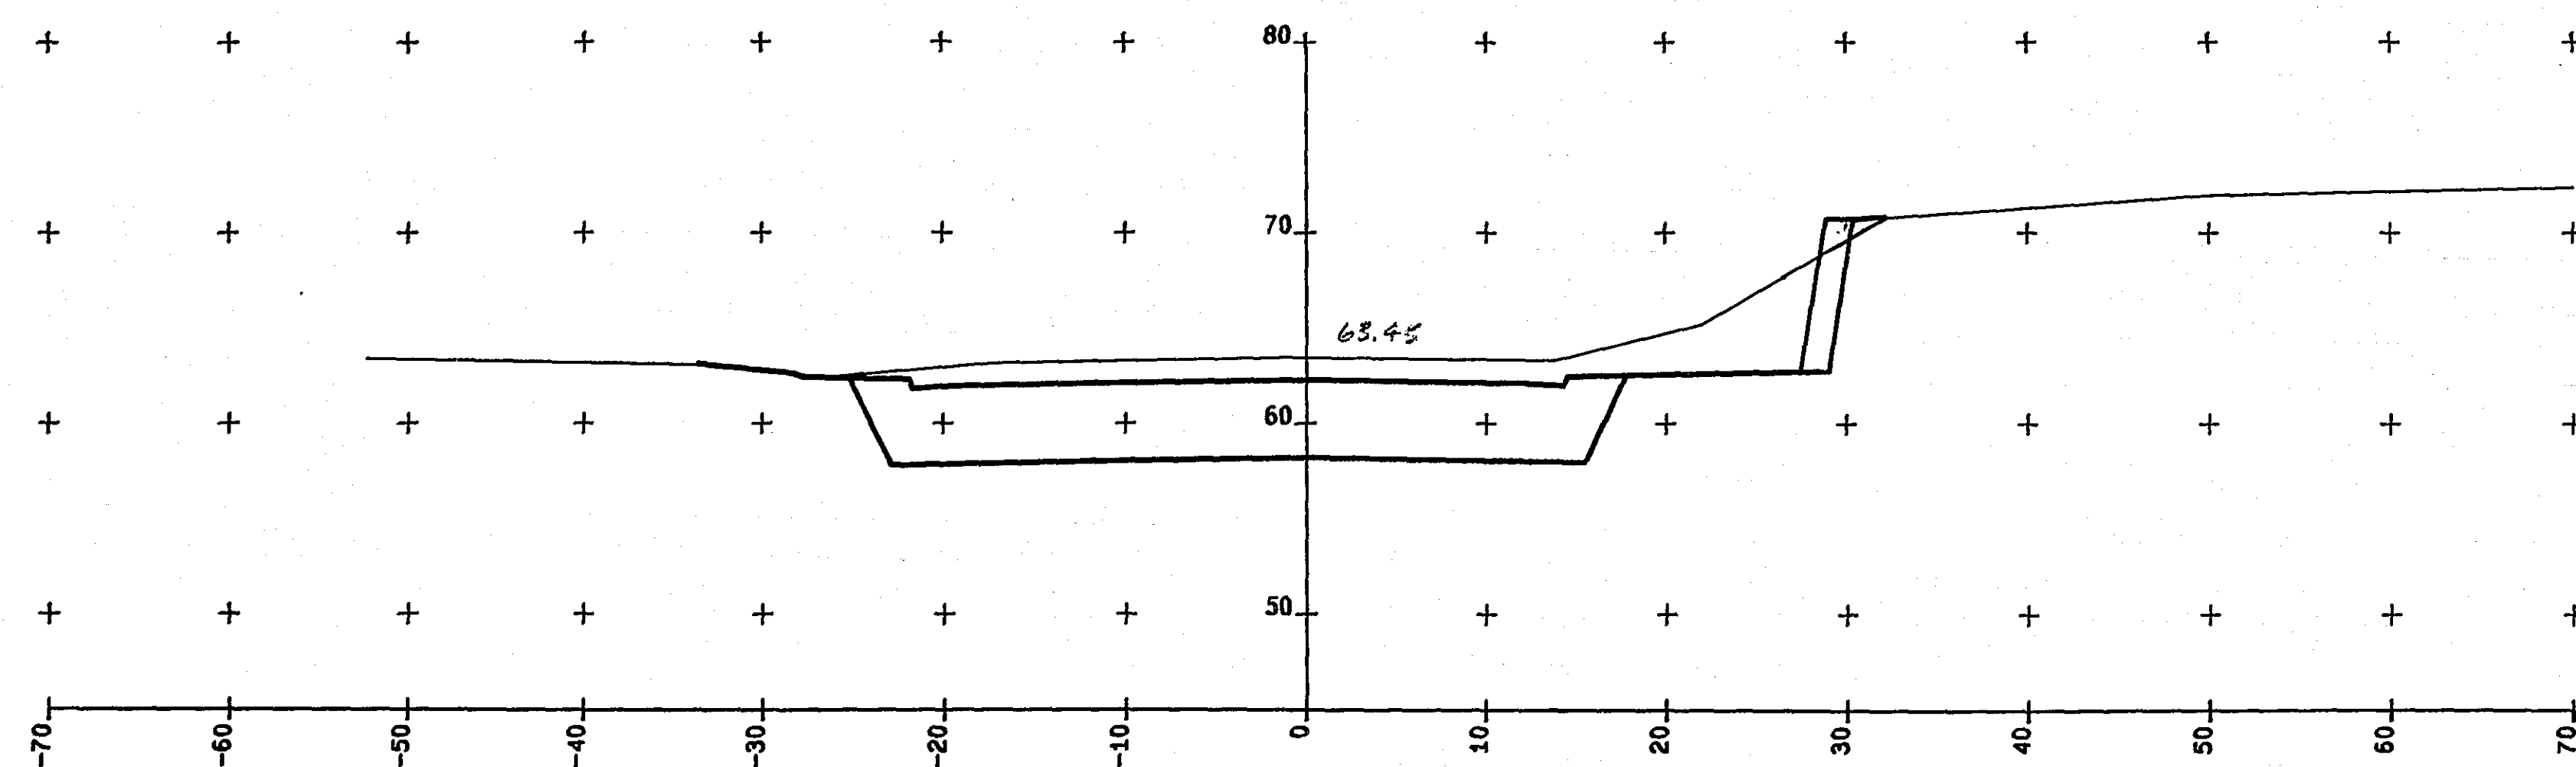


36+25.00

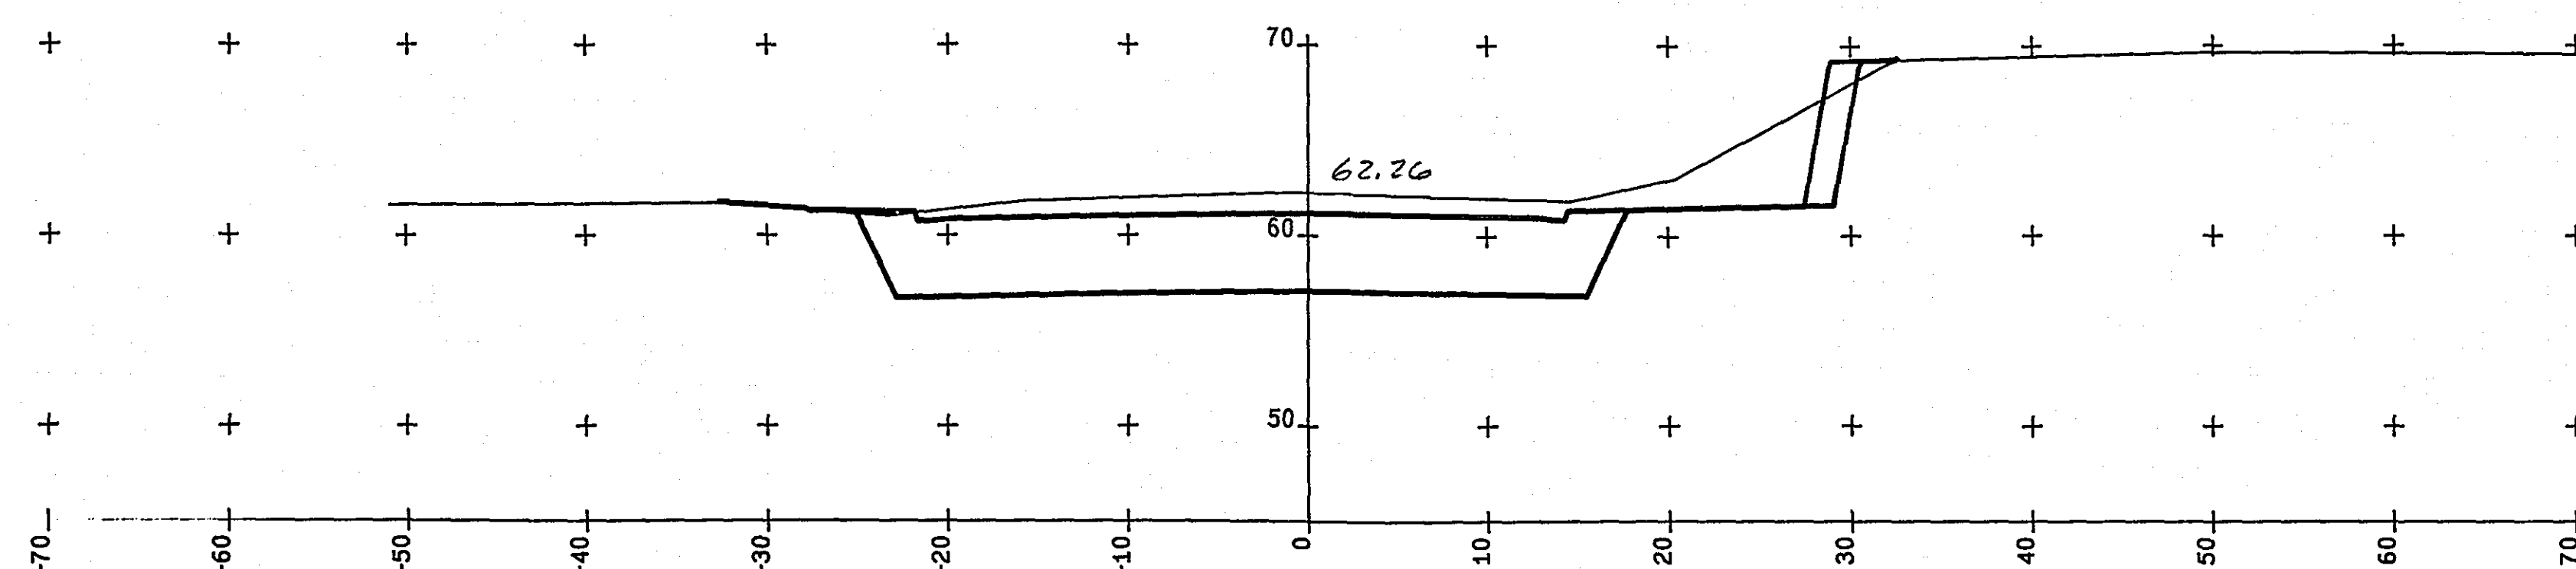


35+70.00

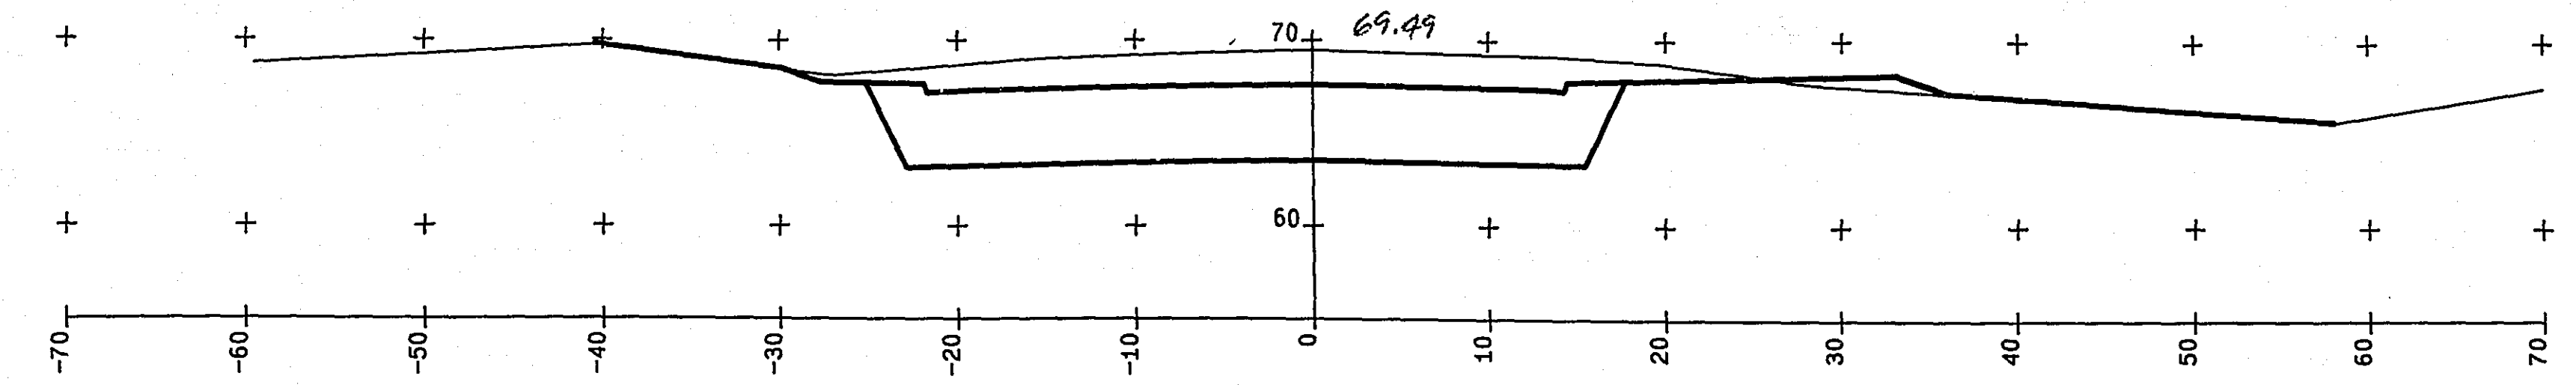


38+92.00

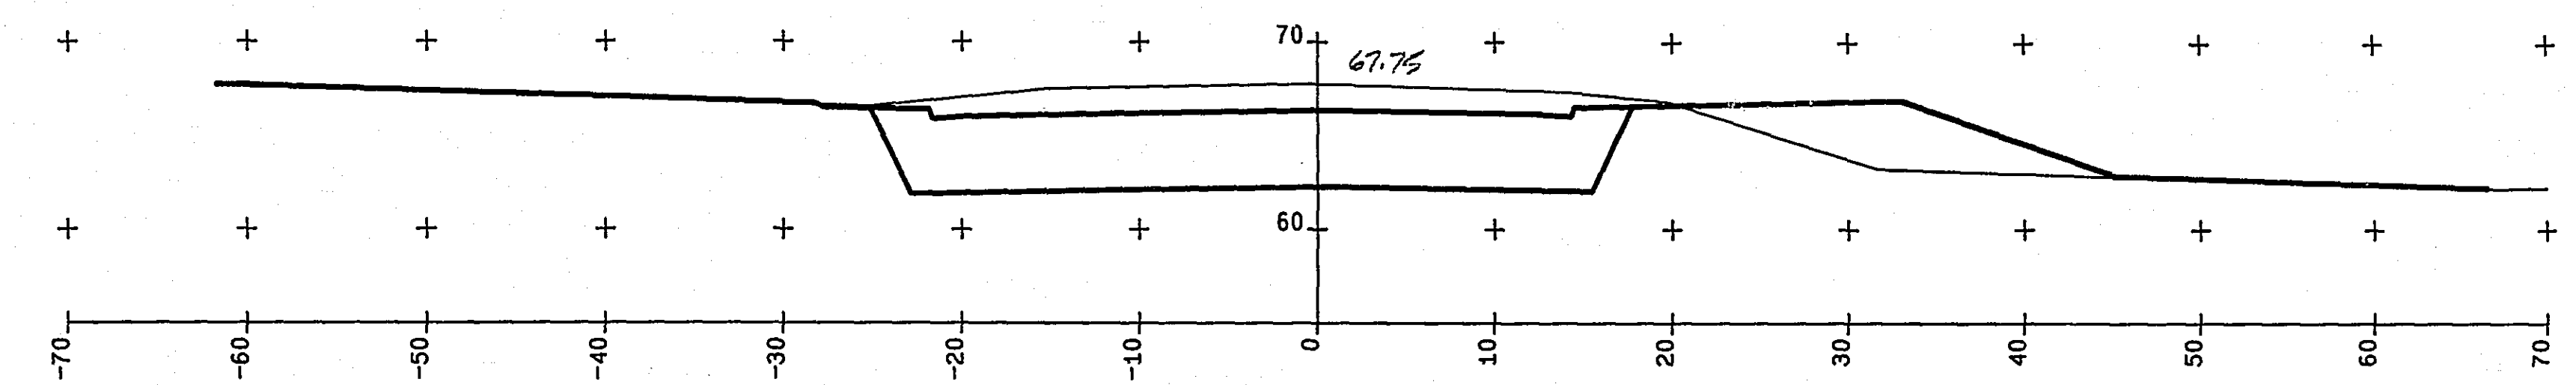









38+28.00

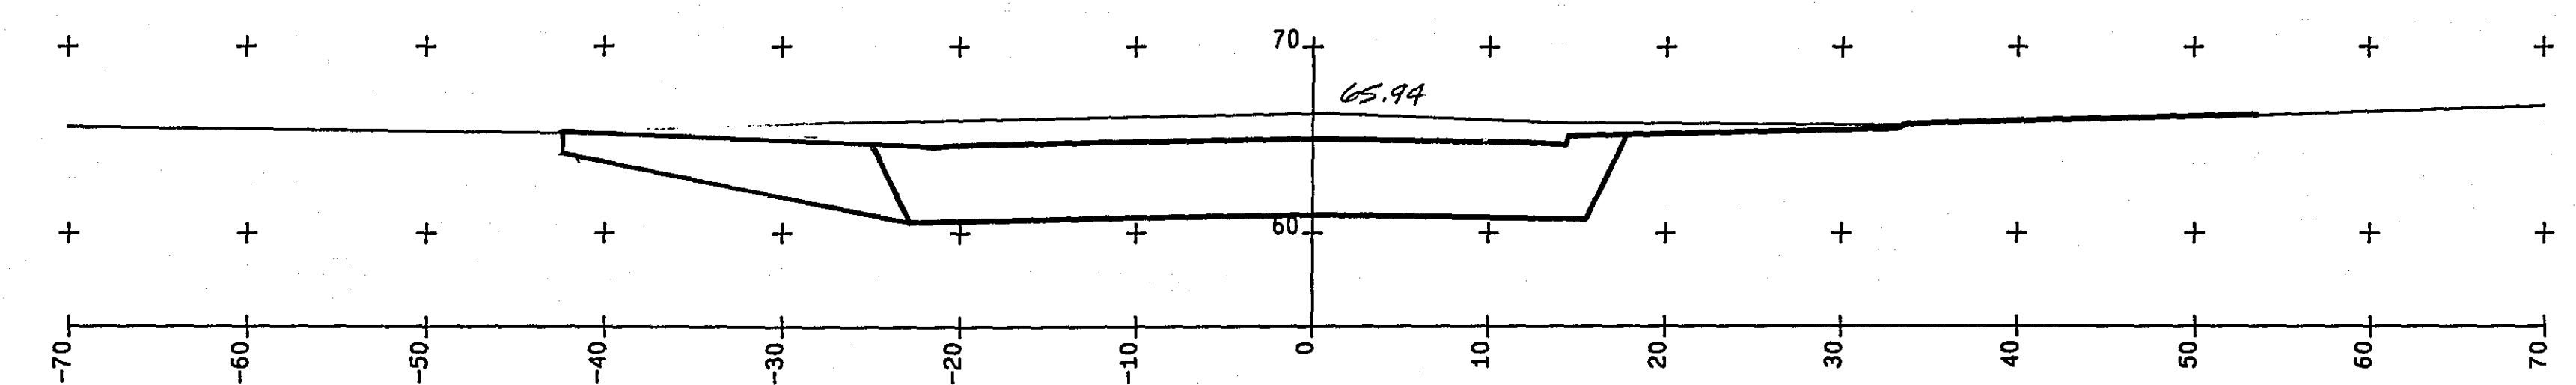


37+64.00

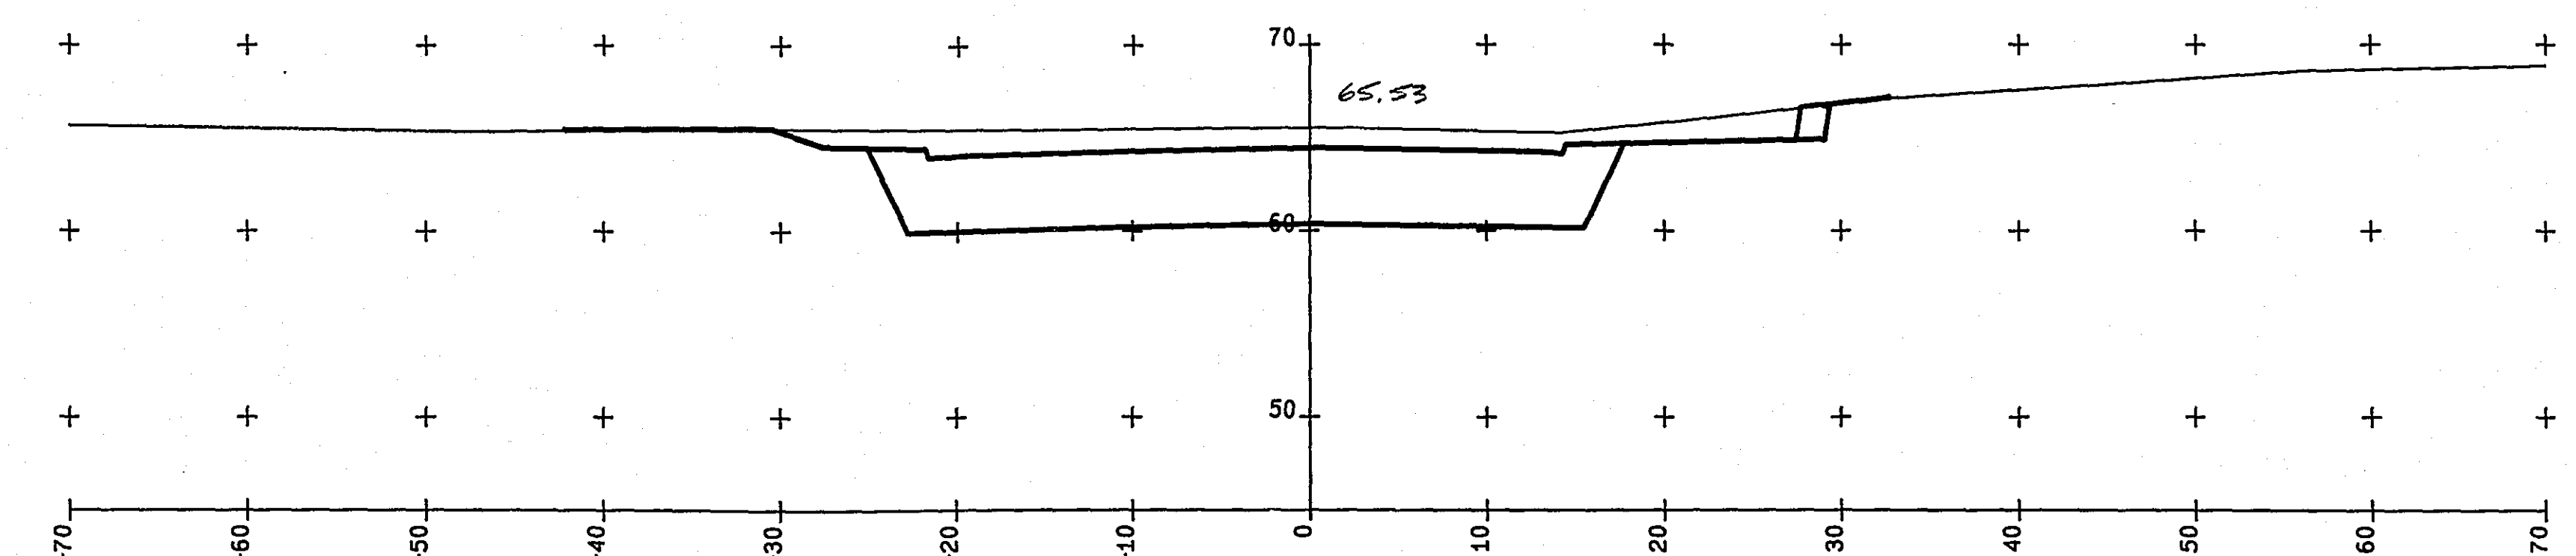


37+33.00

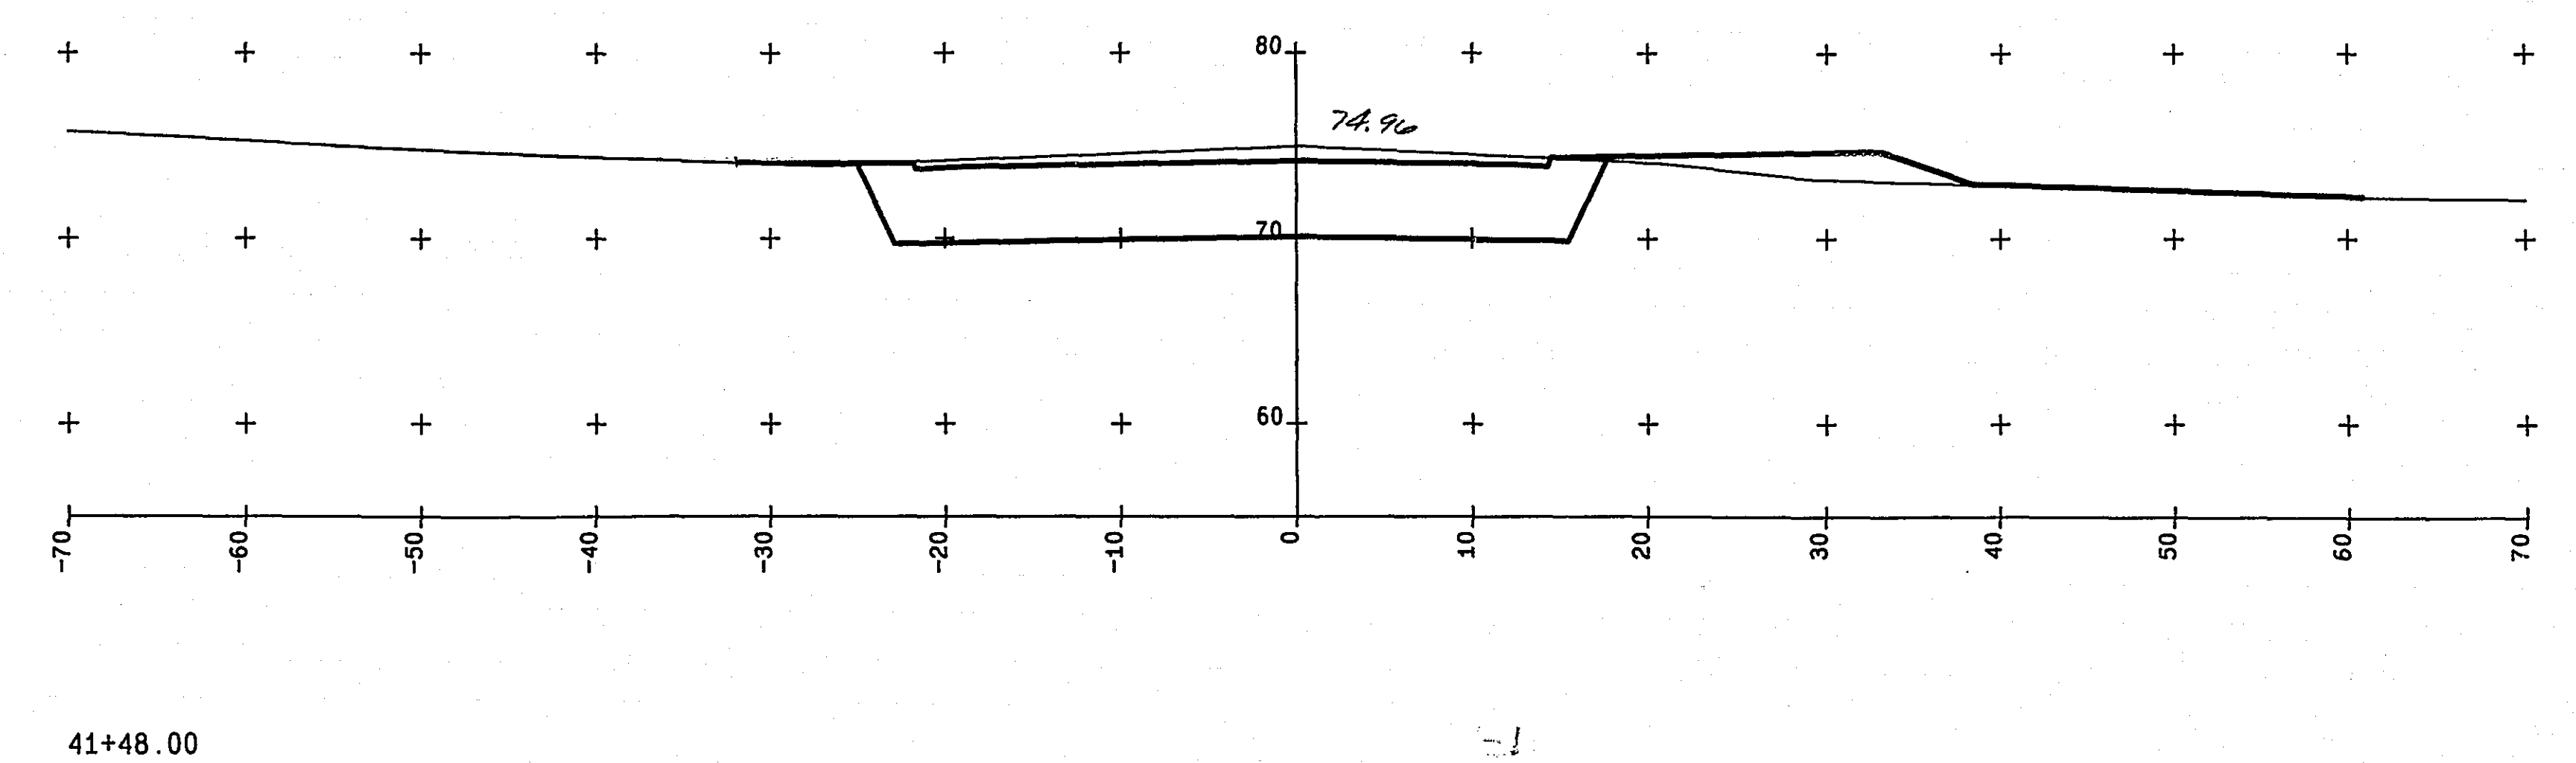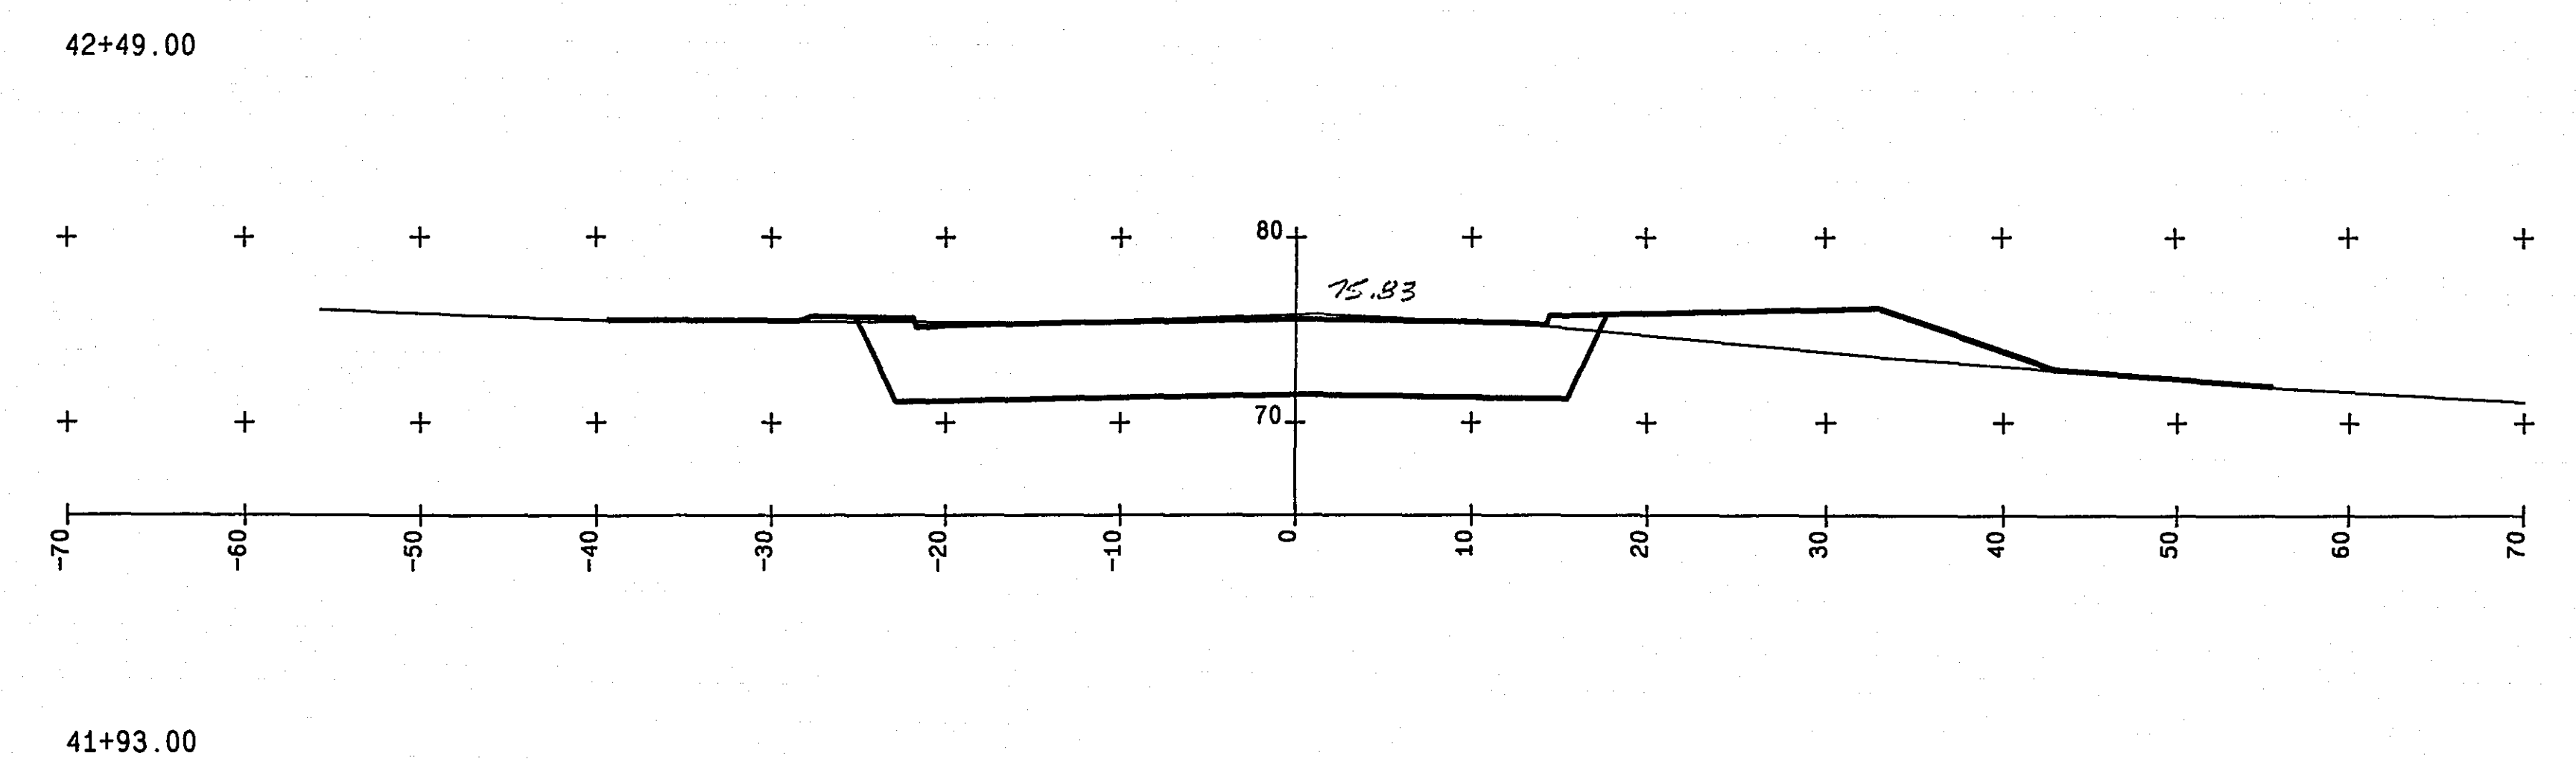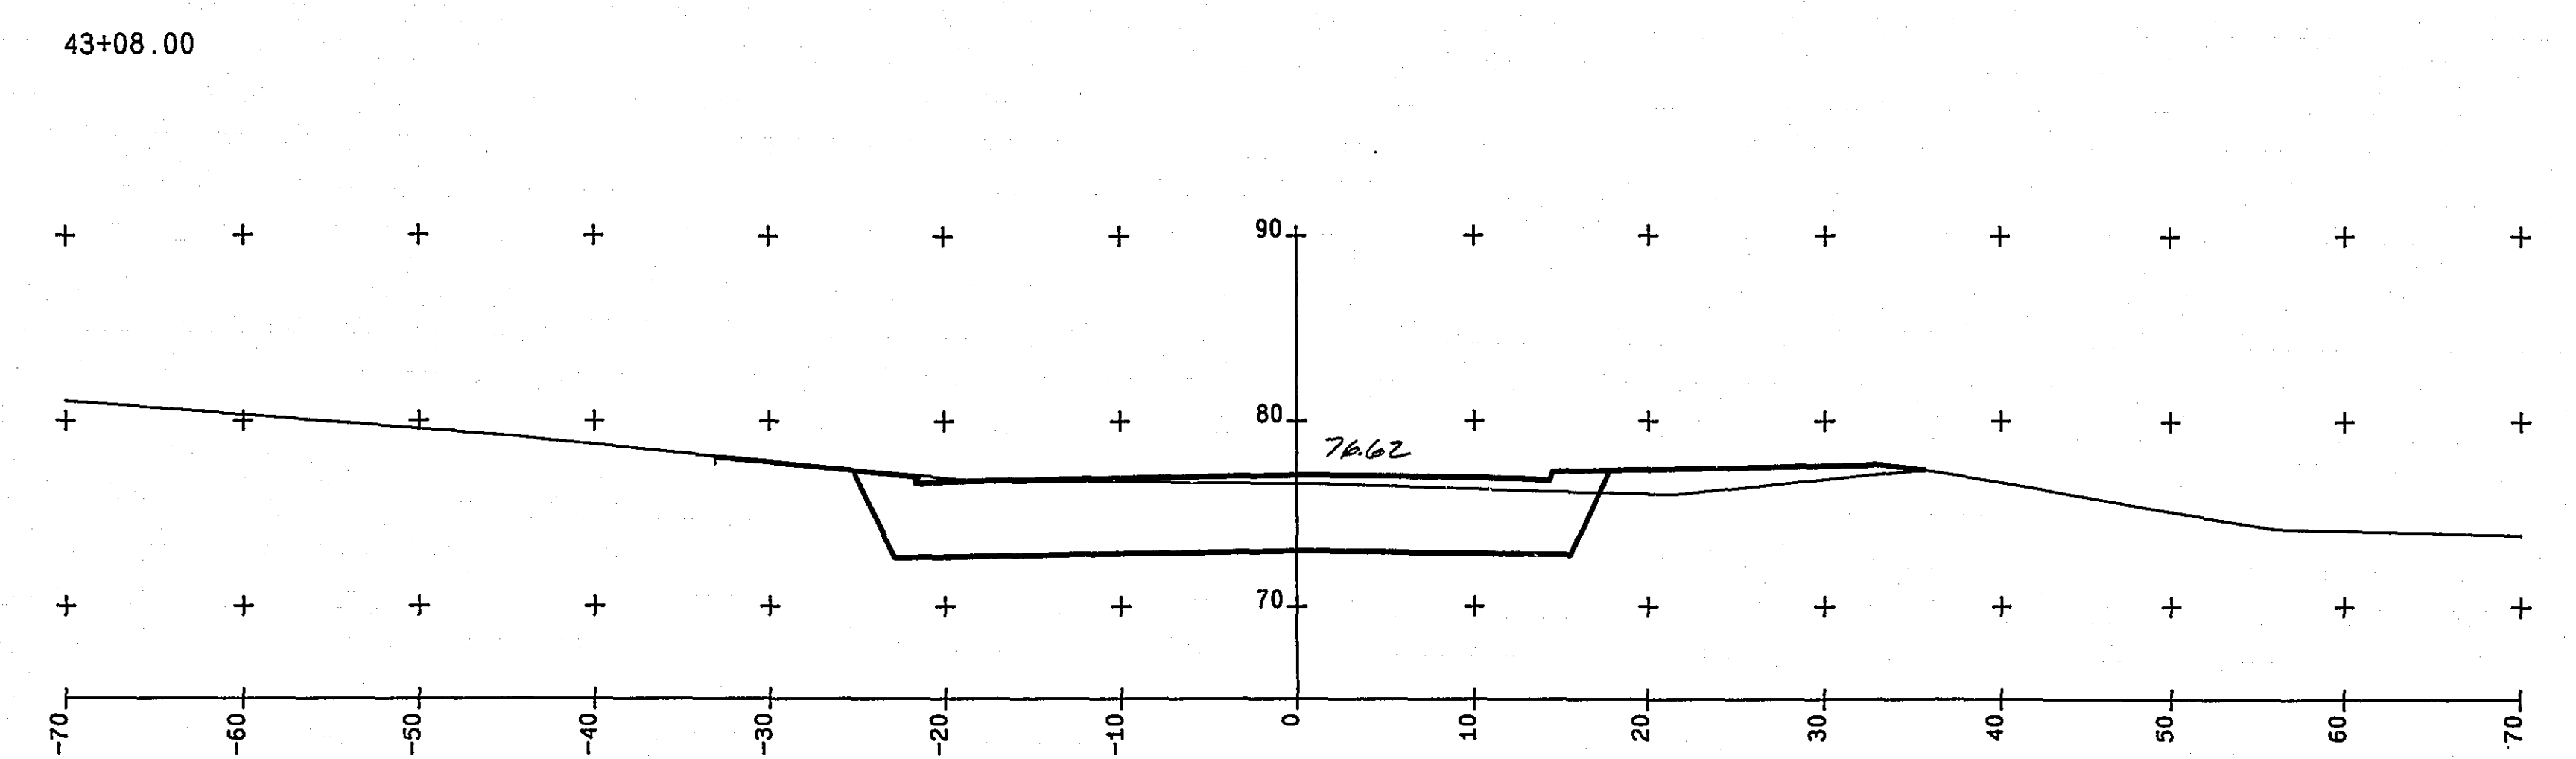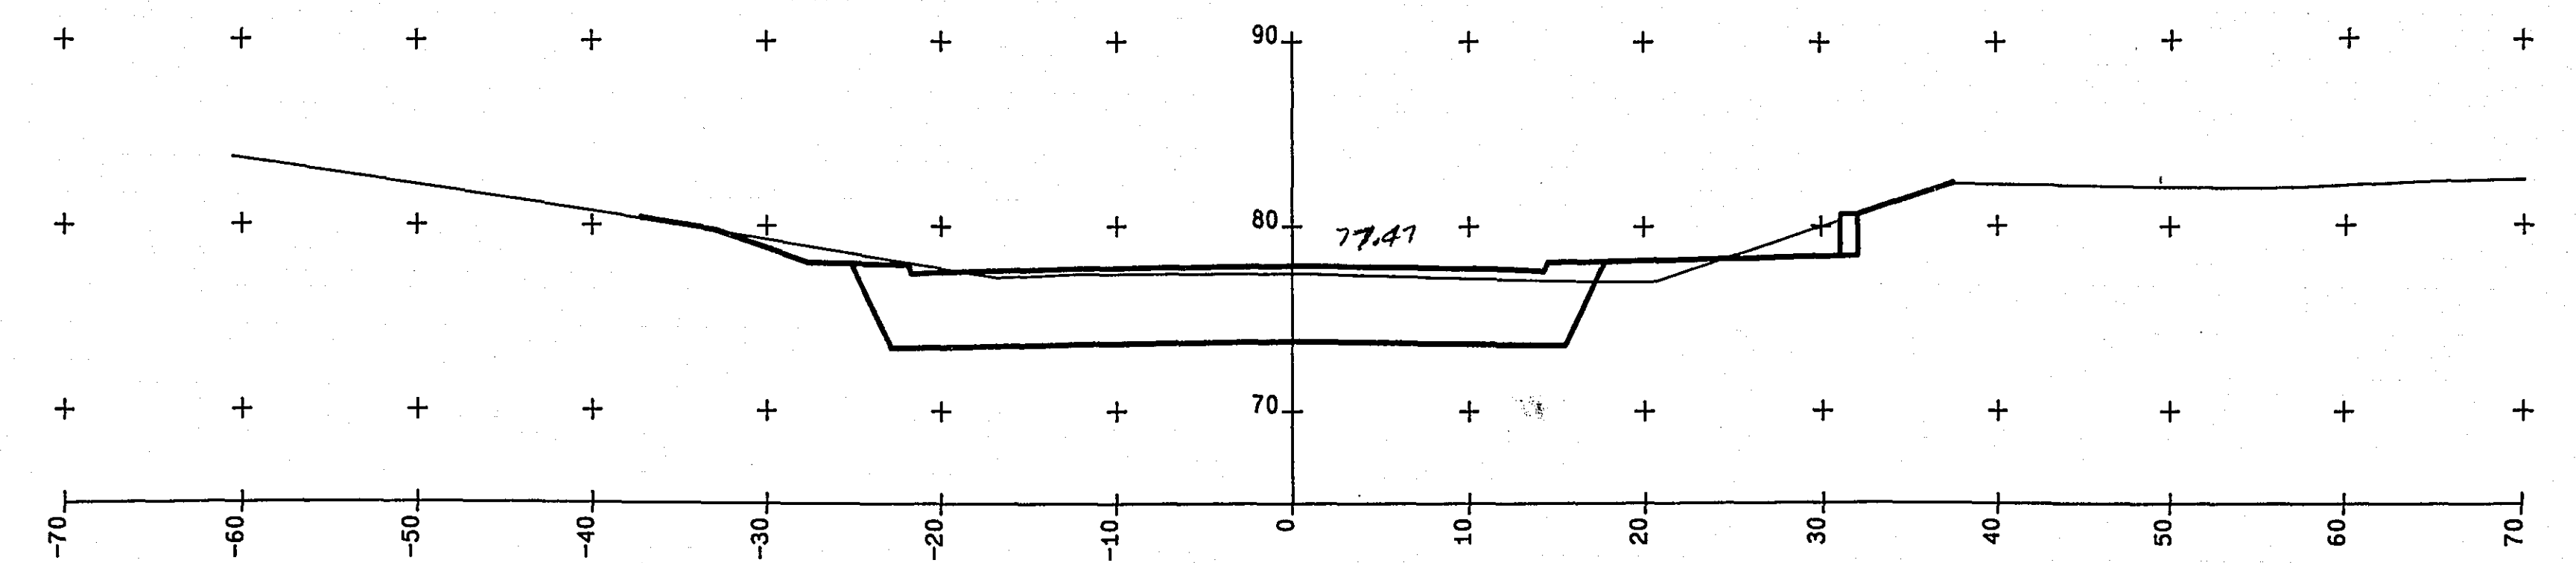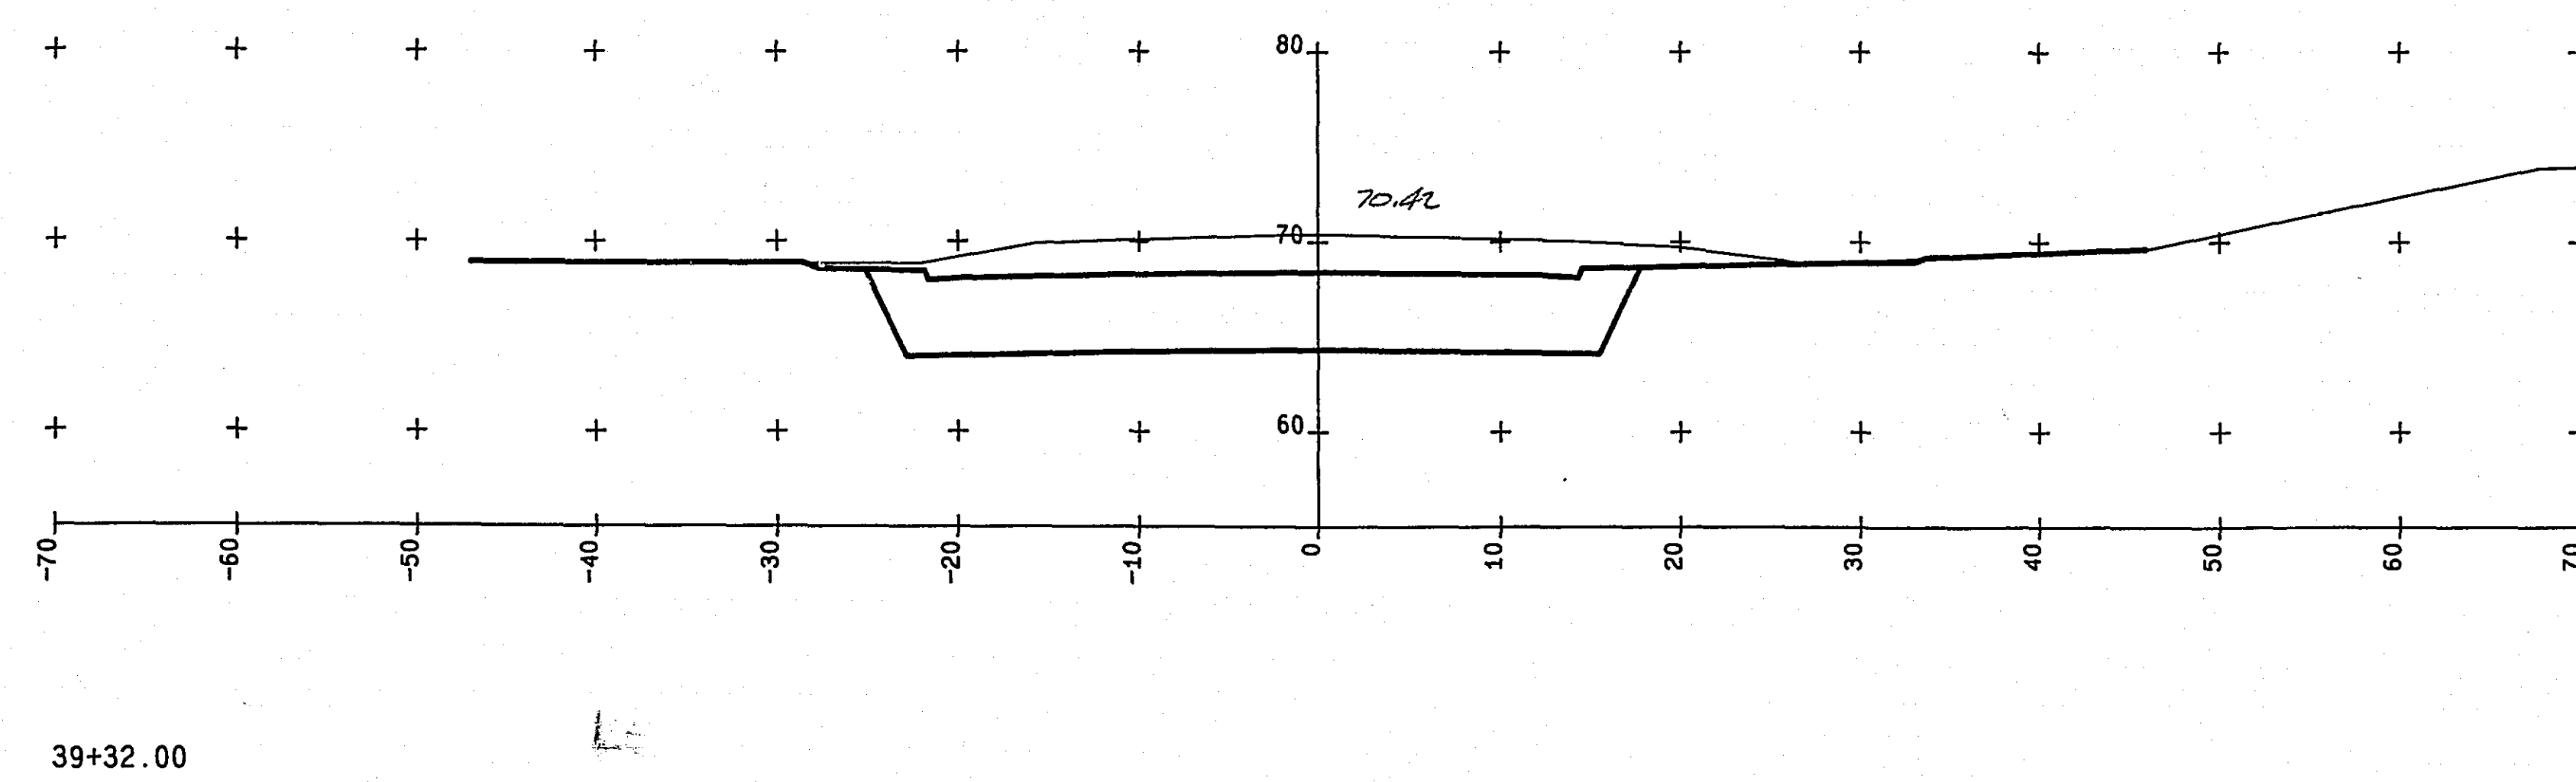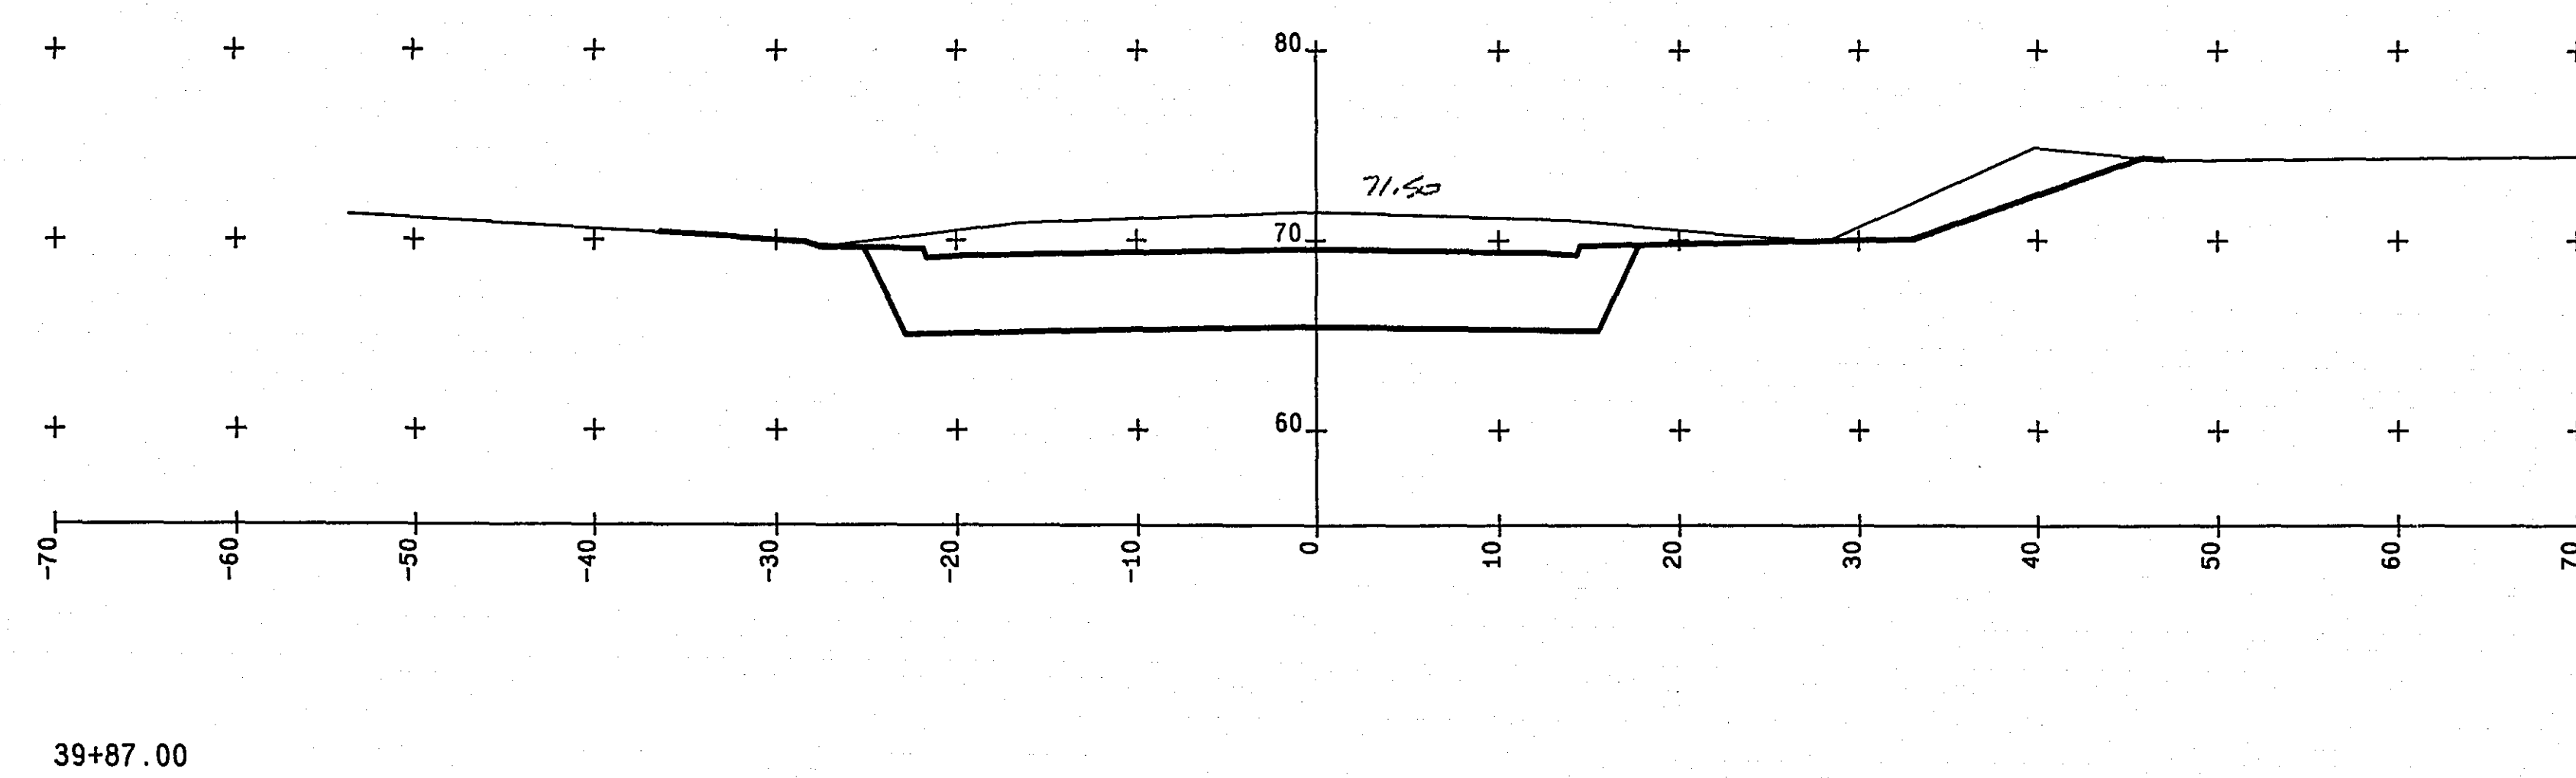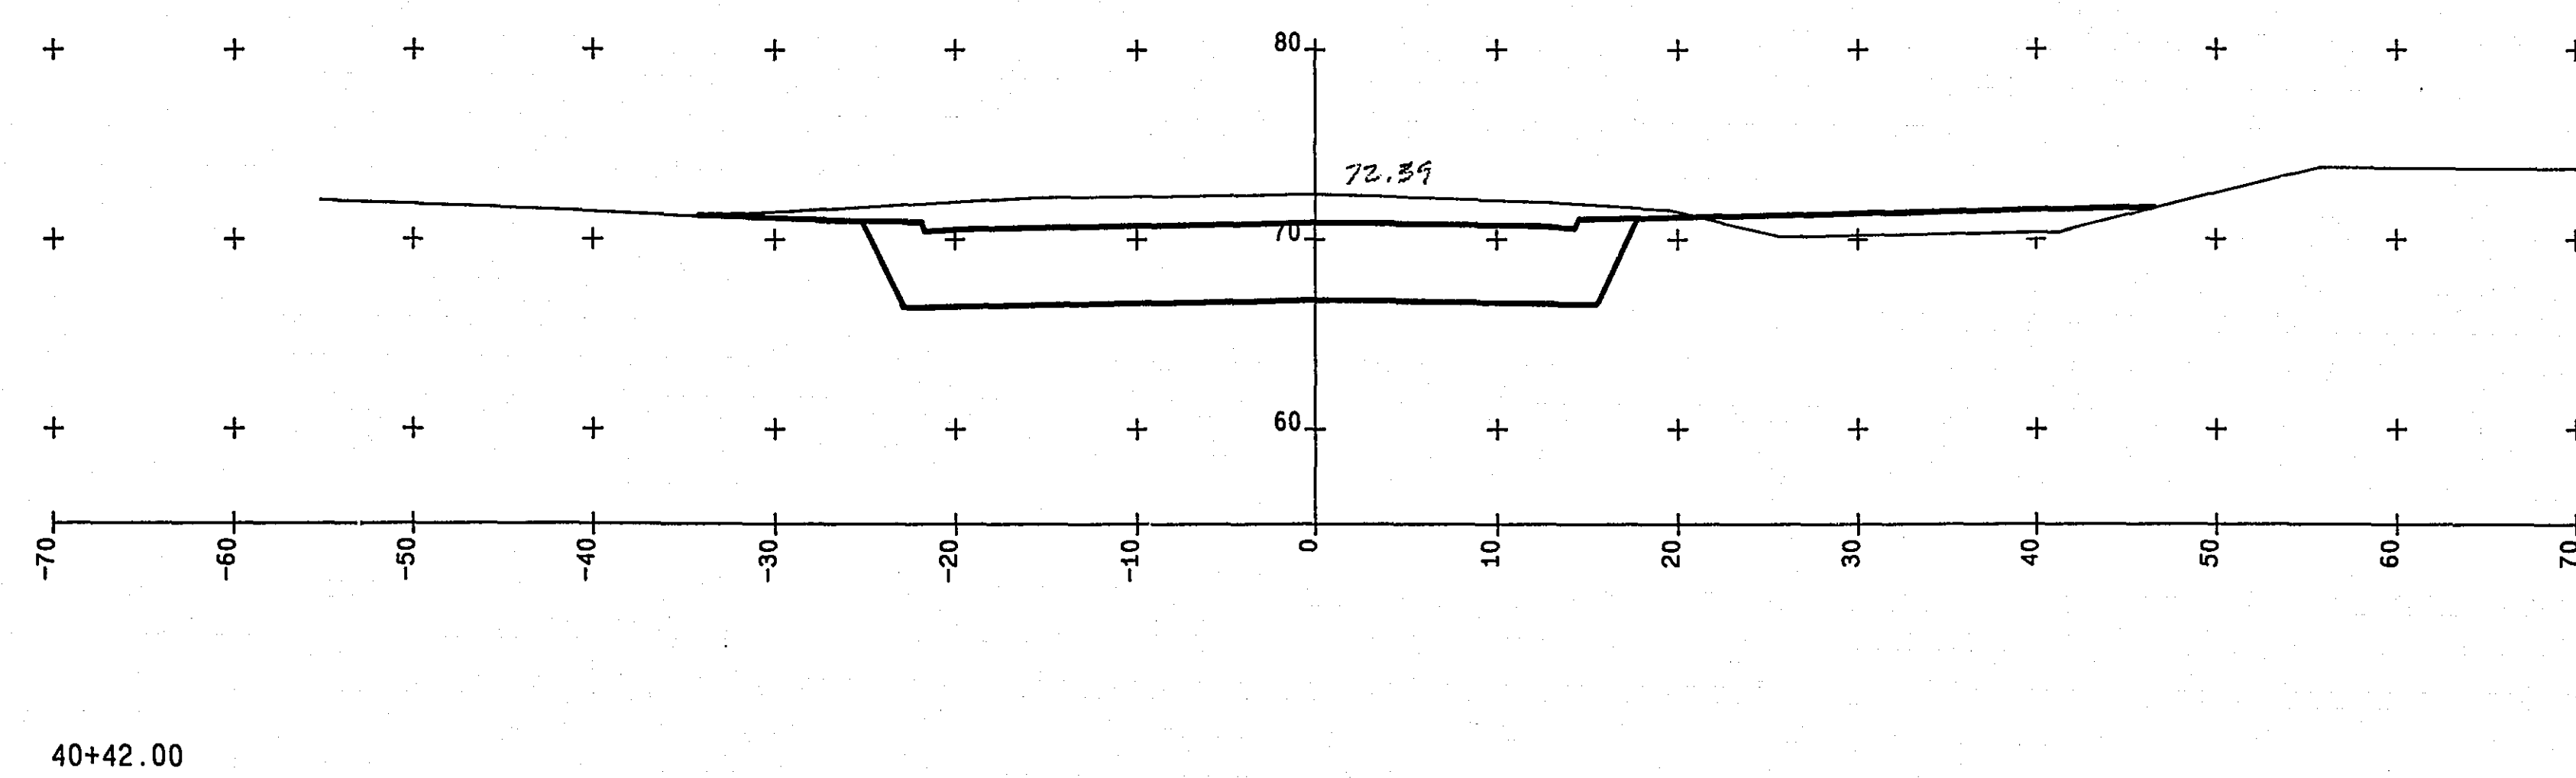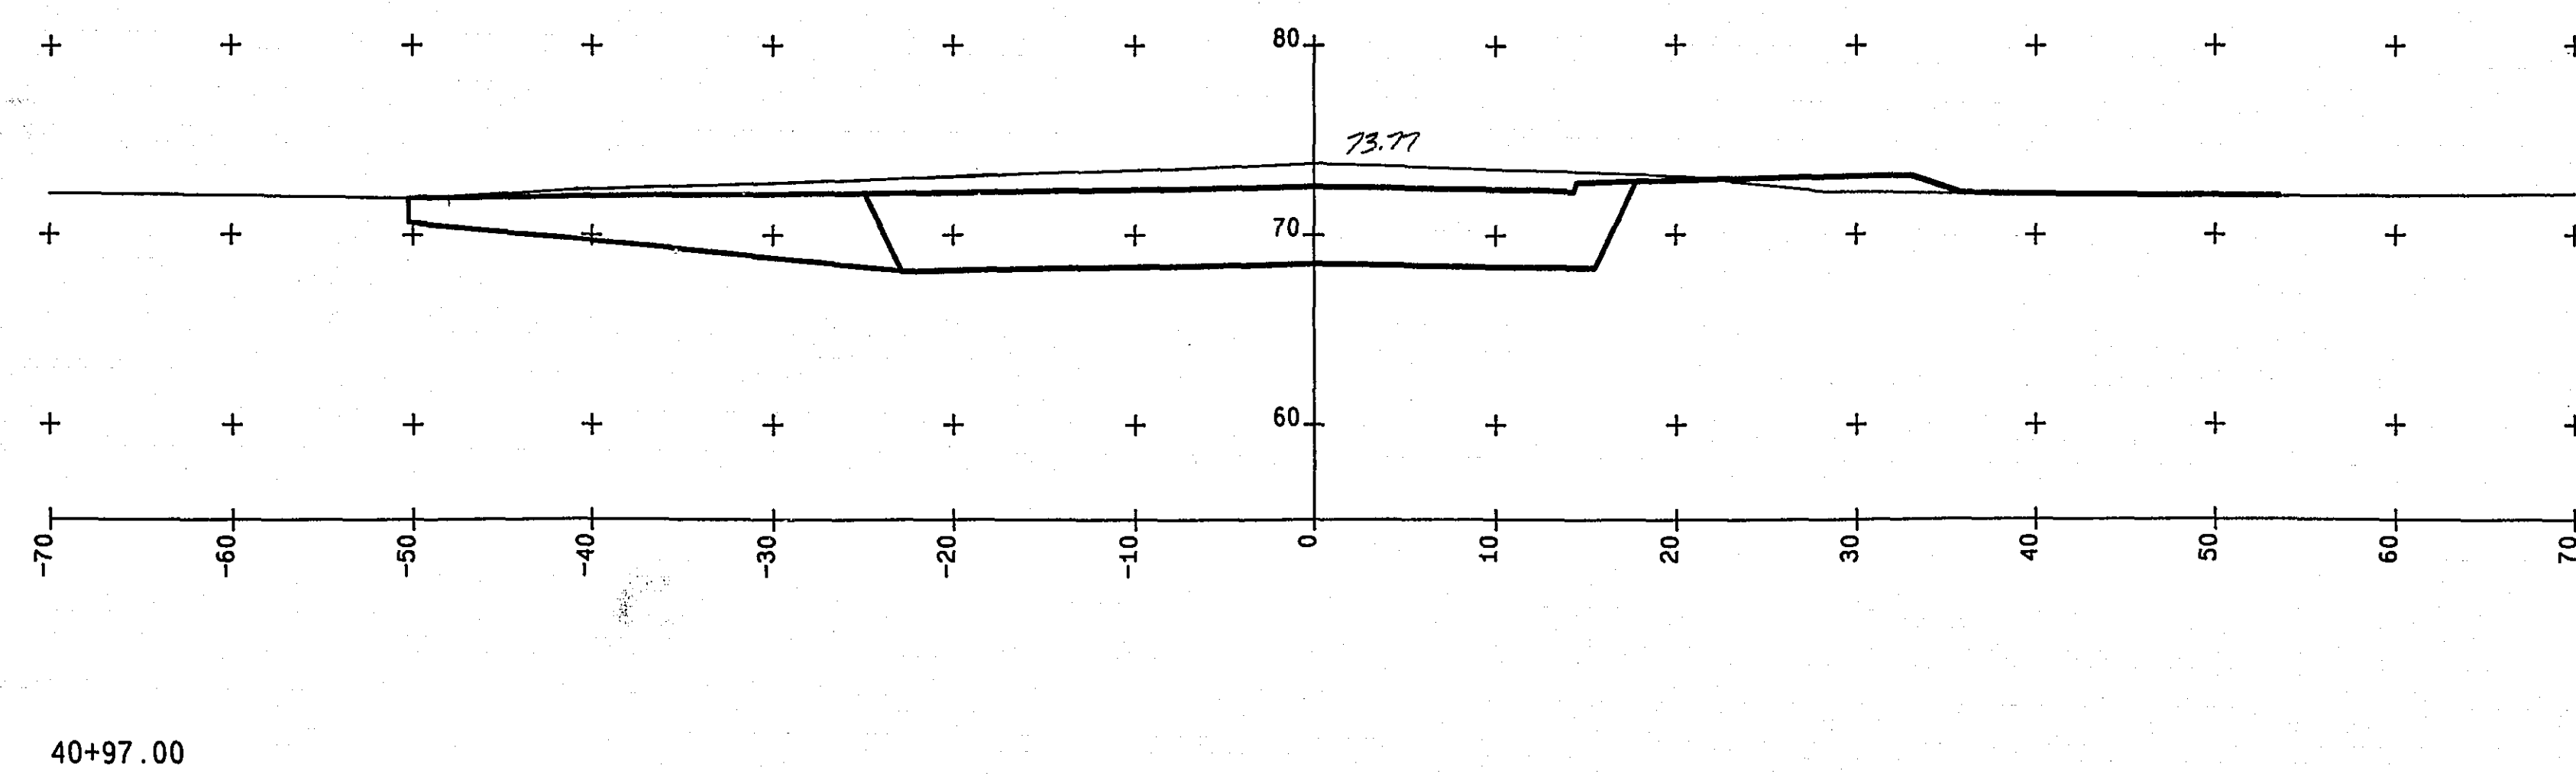


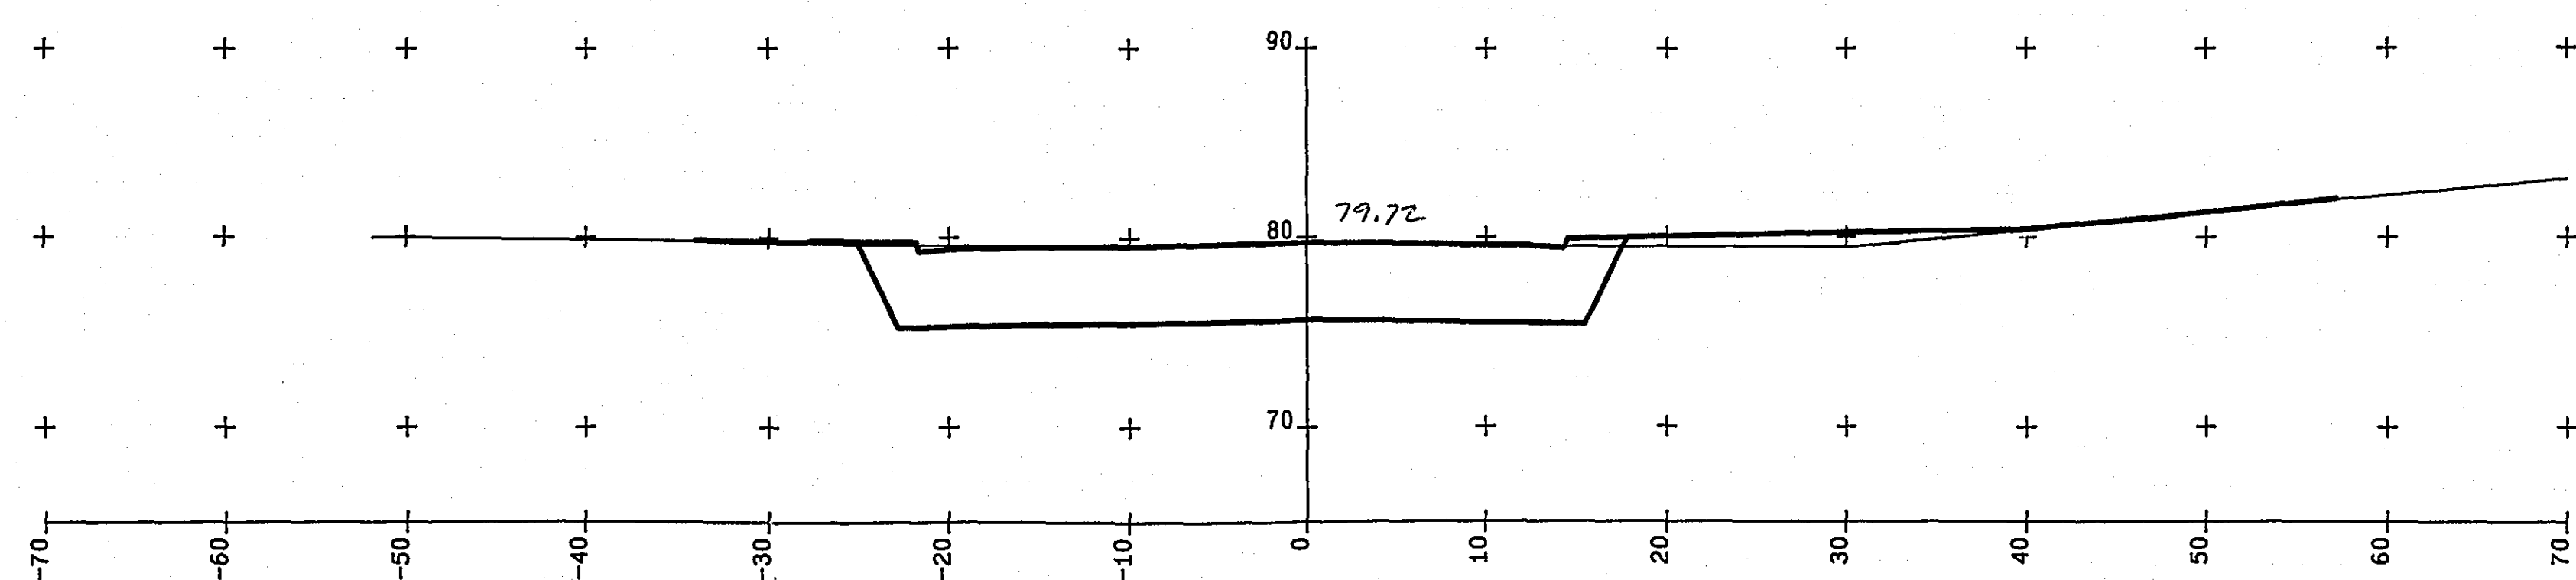


45+27.00

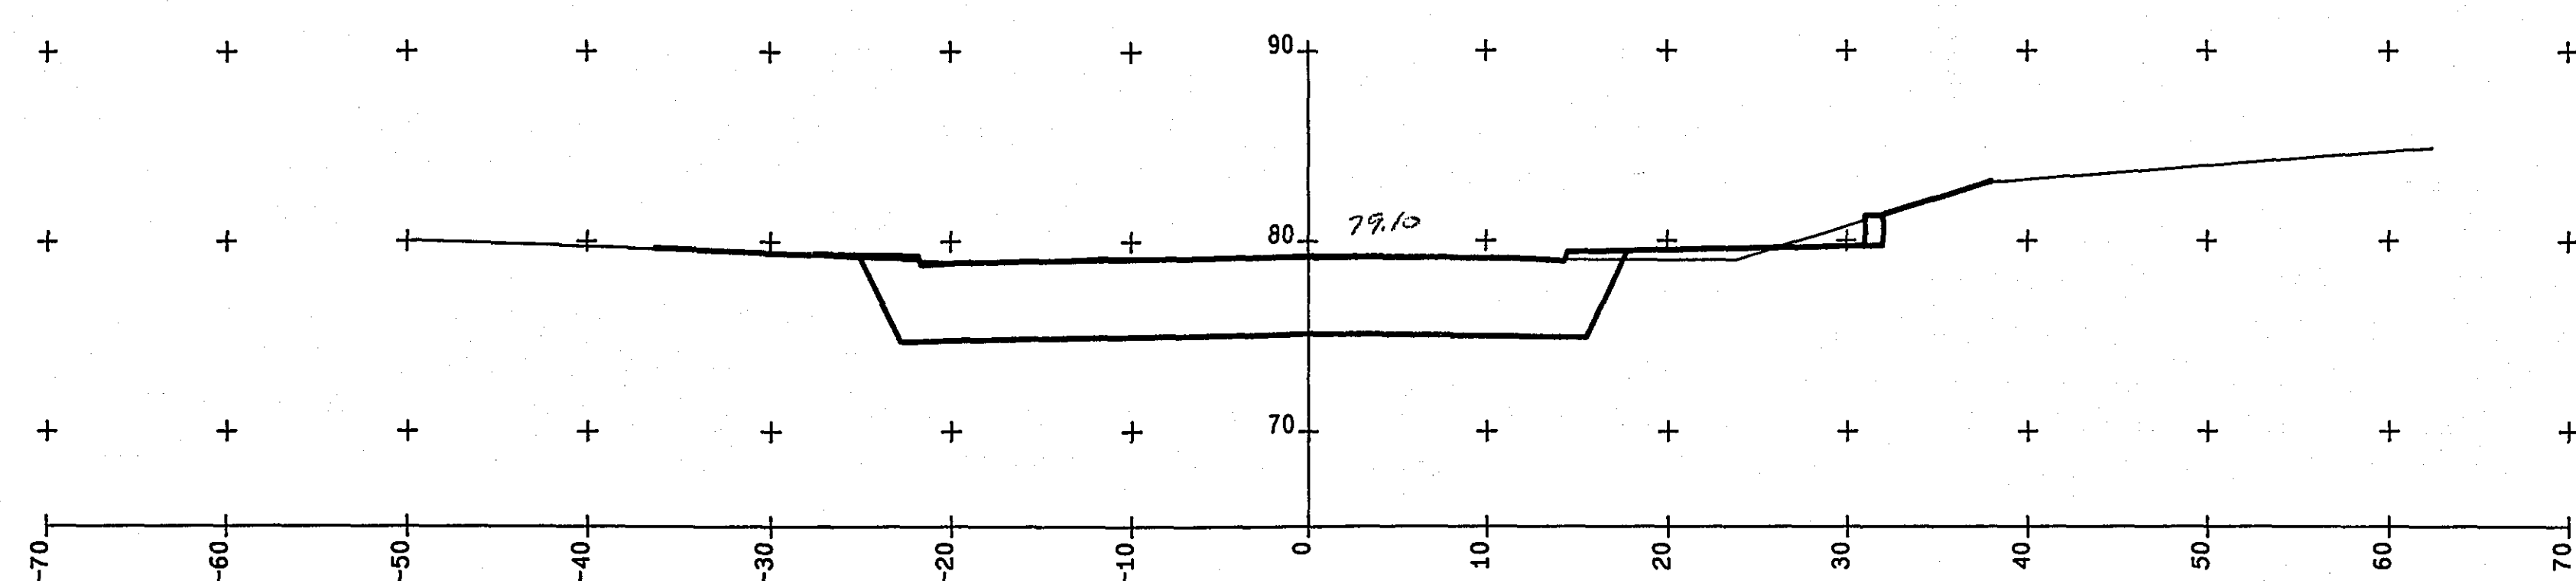


44+67.00

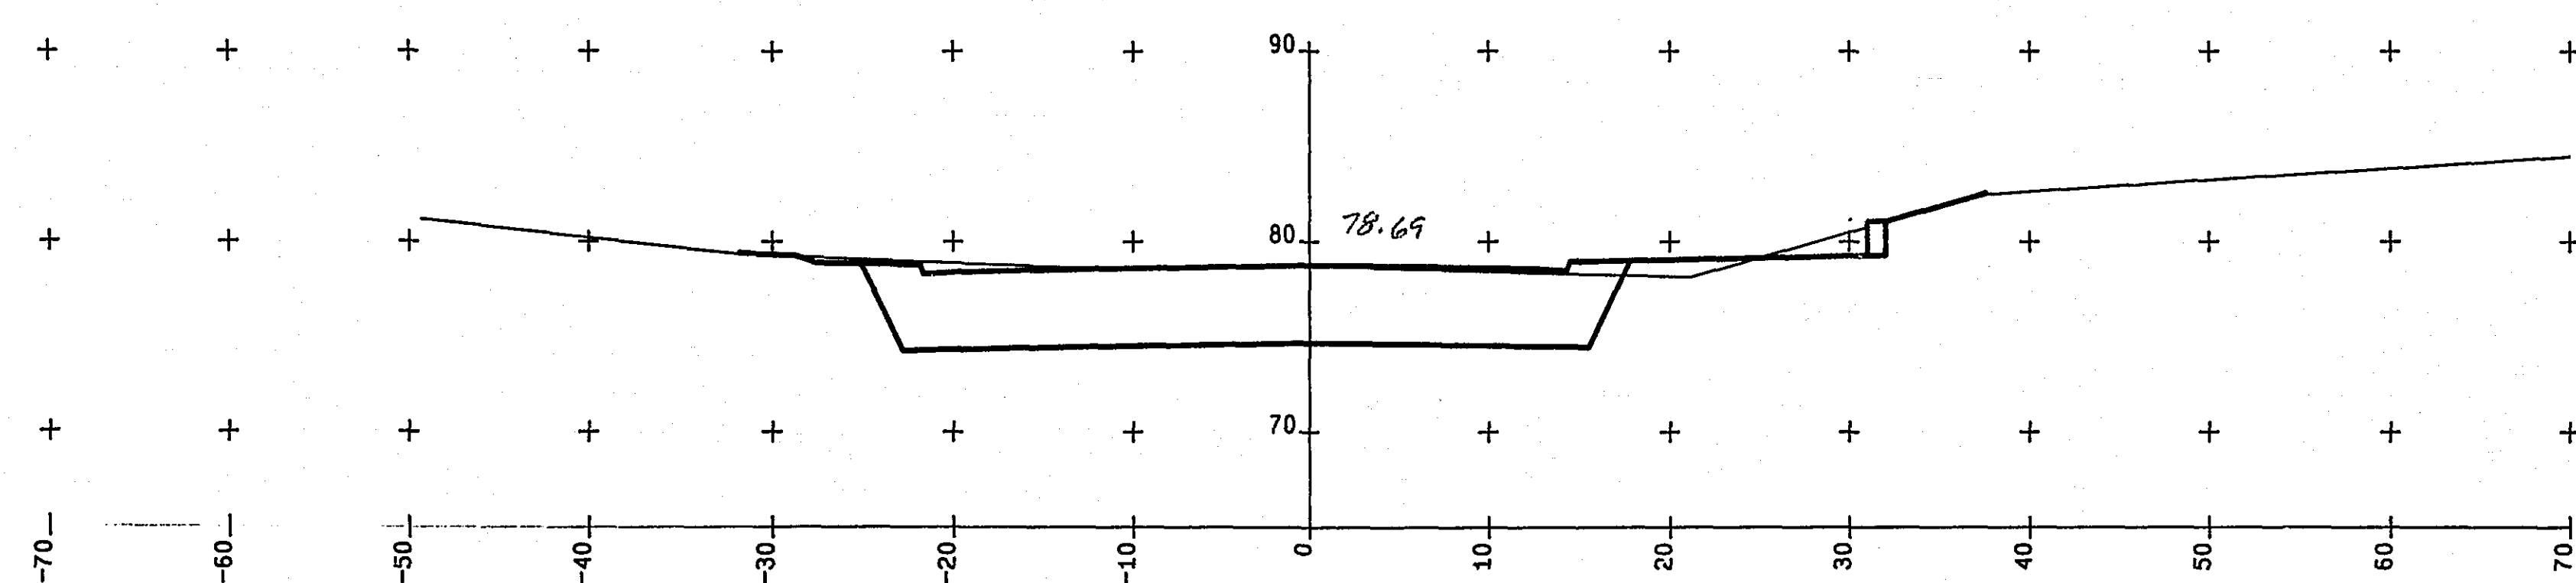


44+12.00

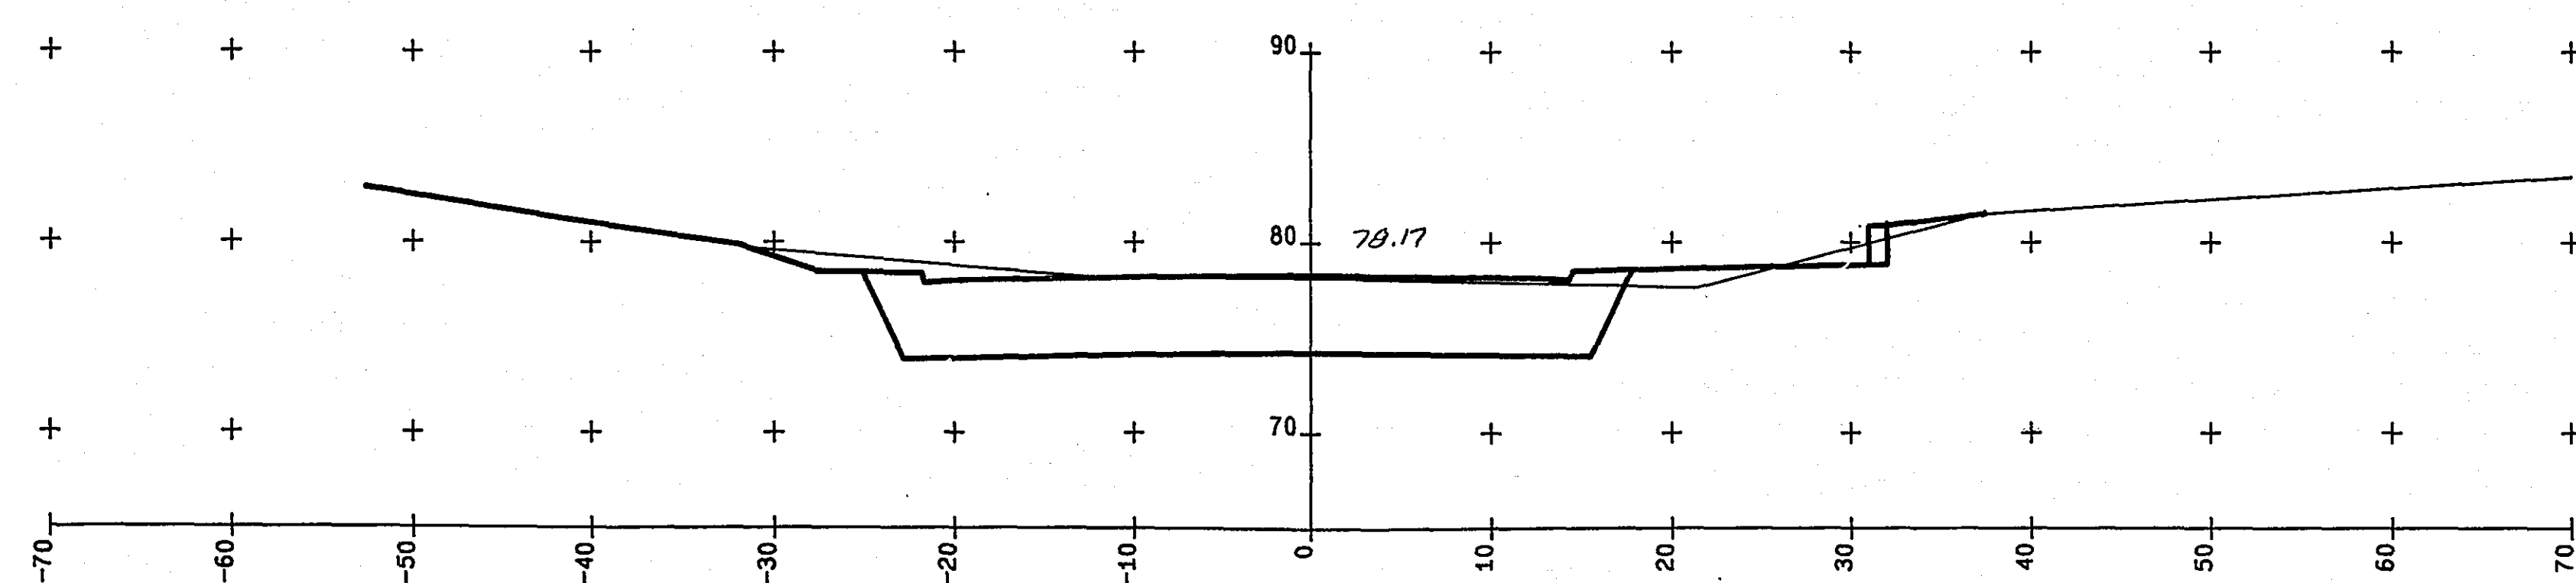


43+60.00

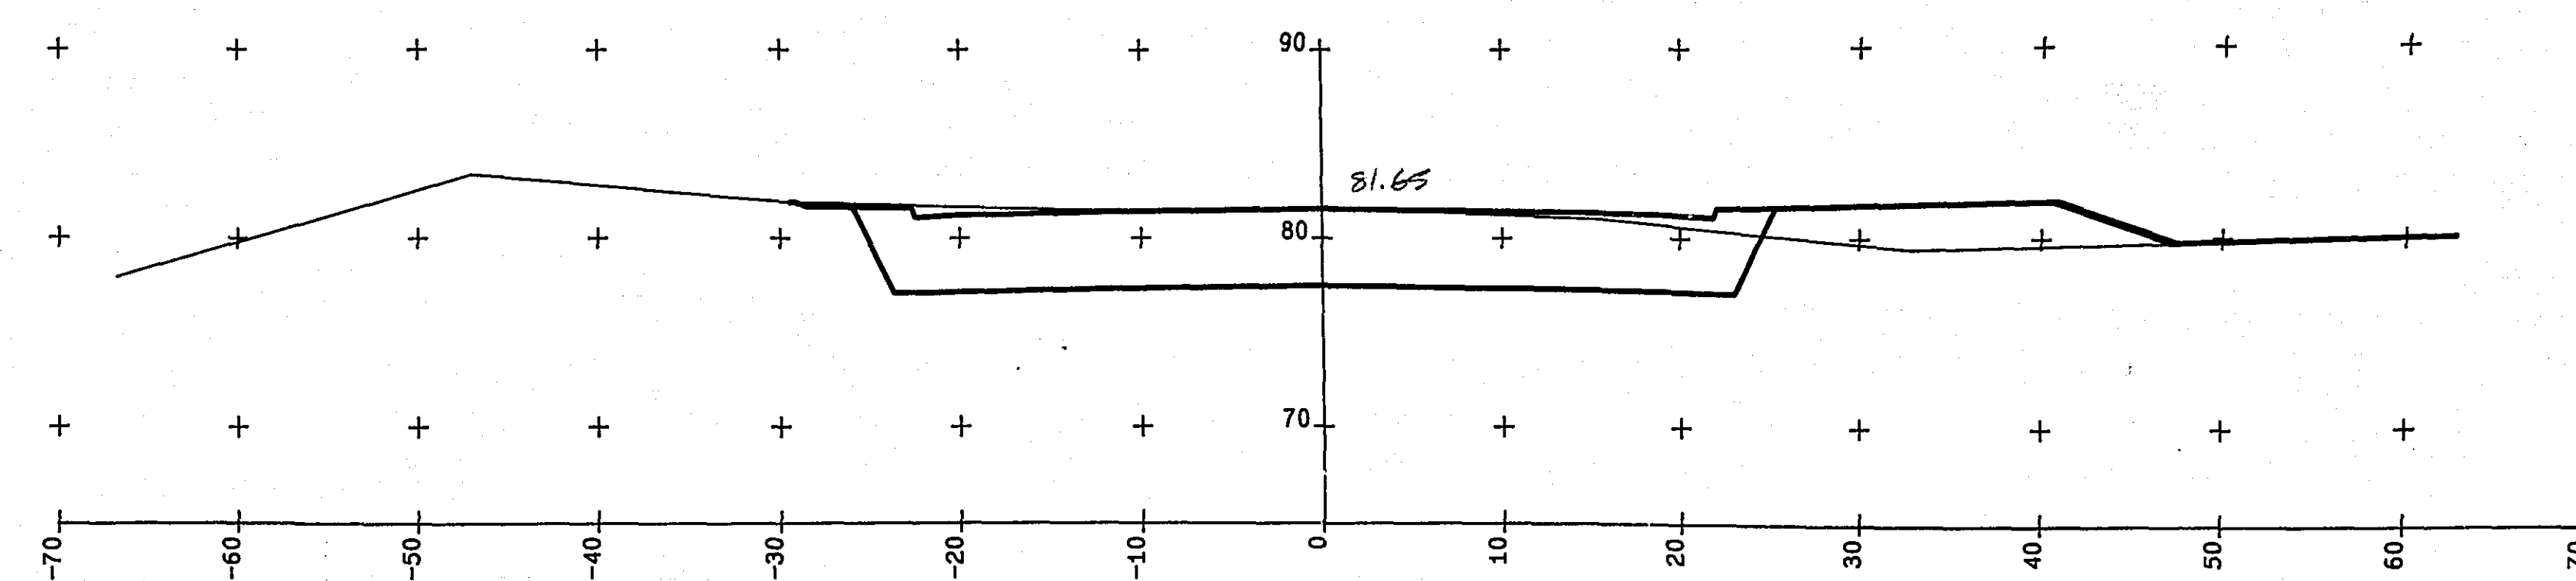


47+49.00

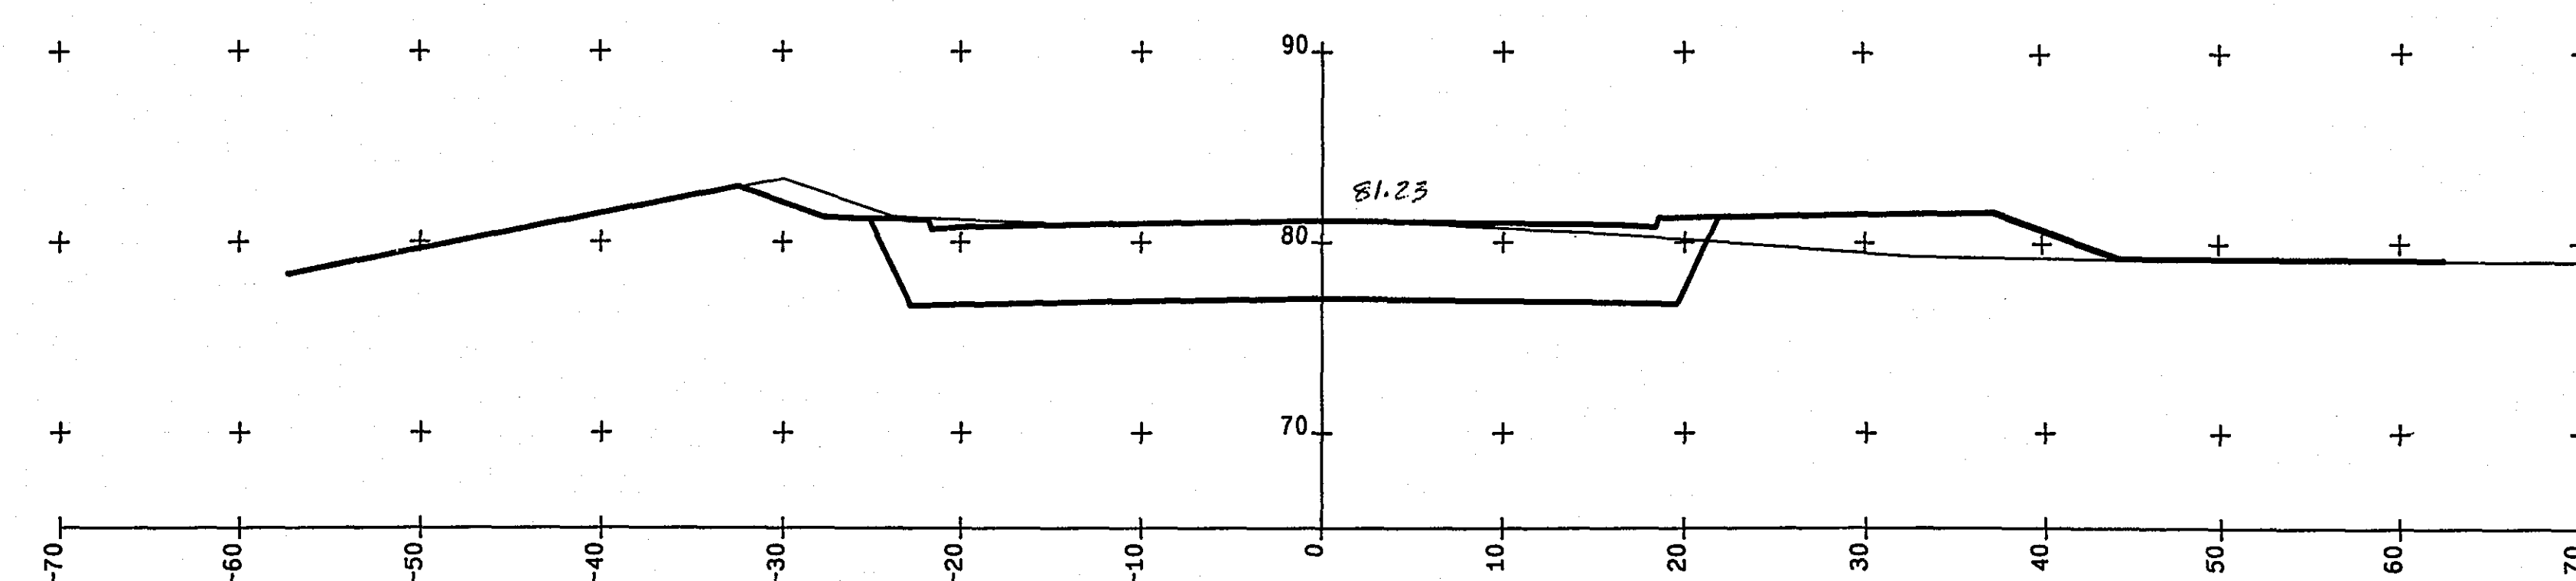


46+96.00

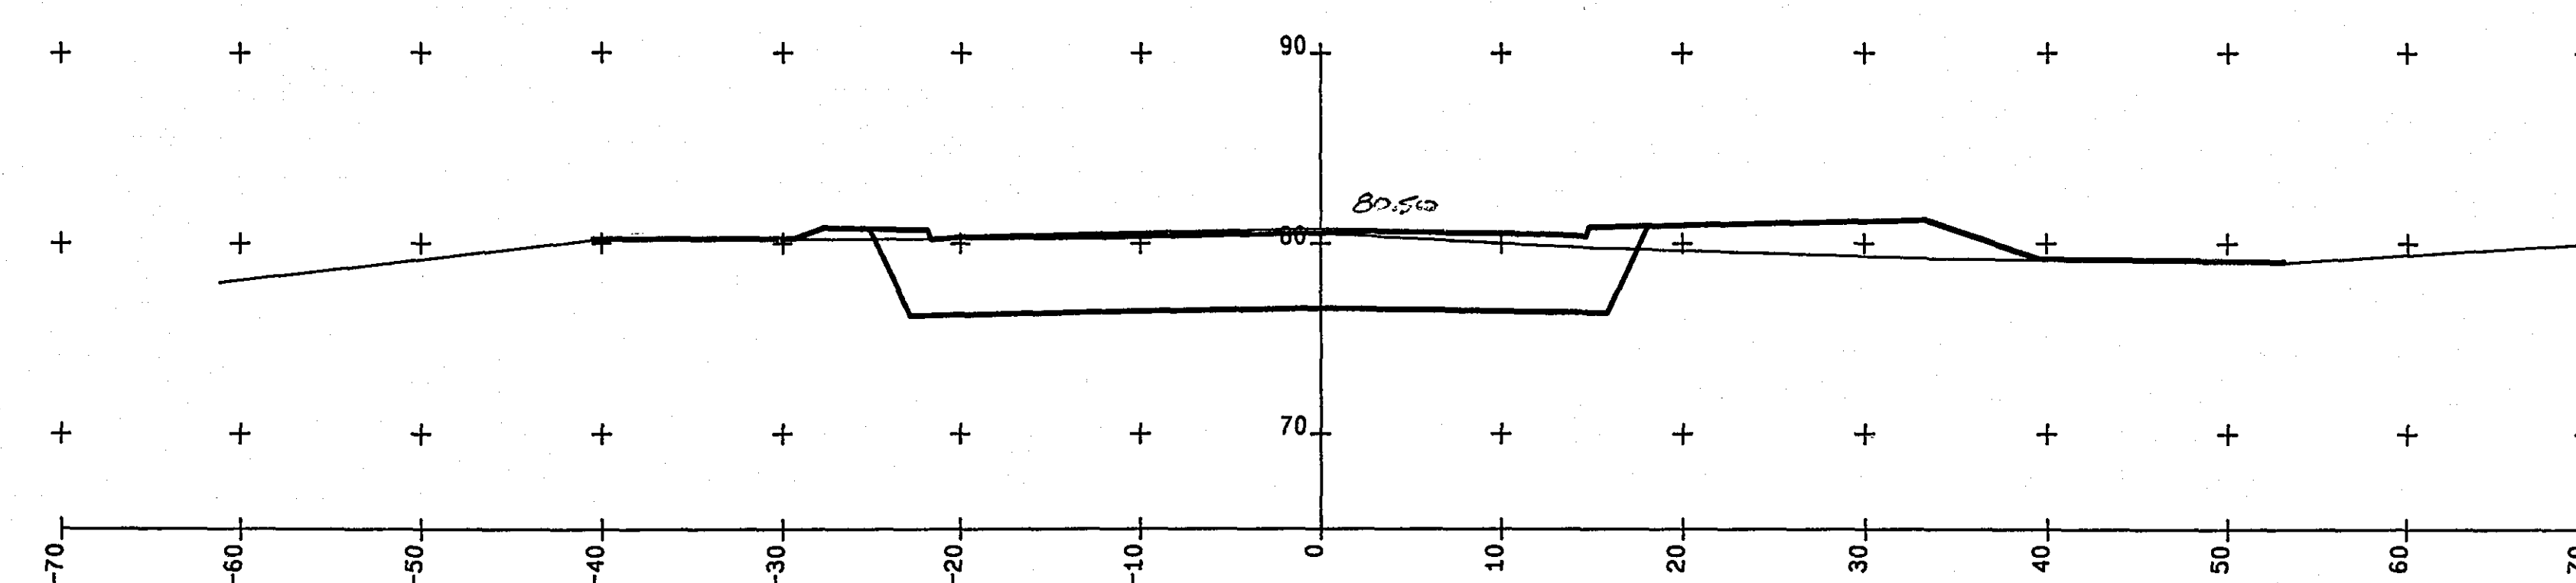


46+40.00

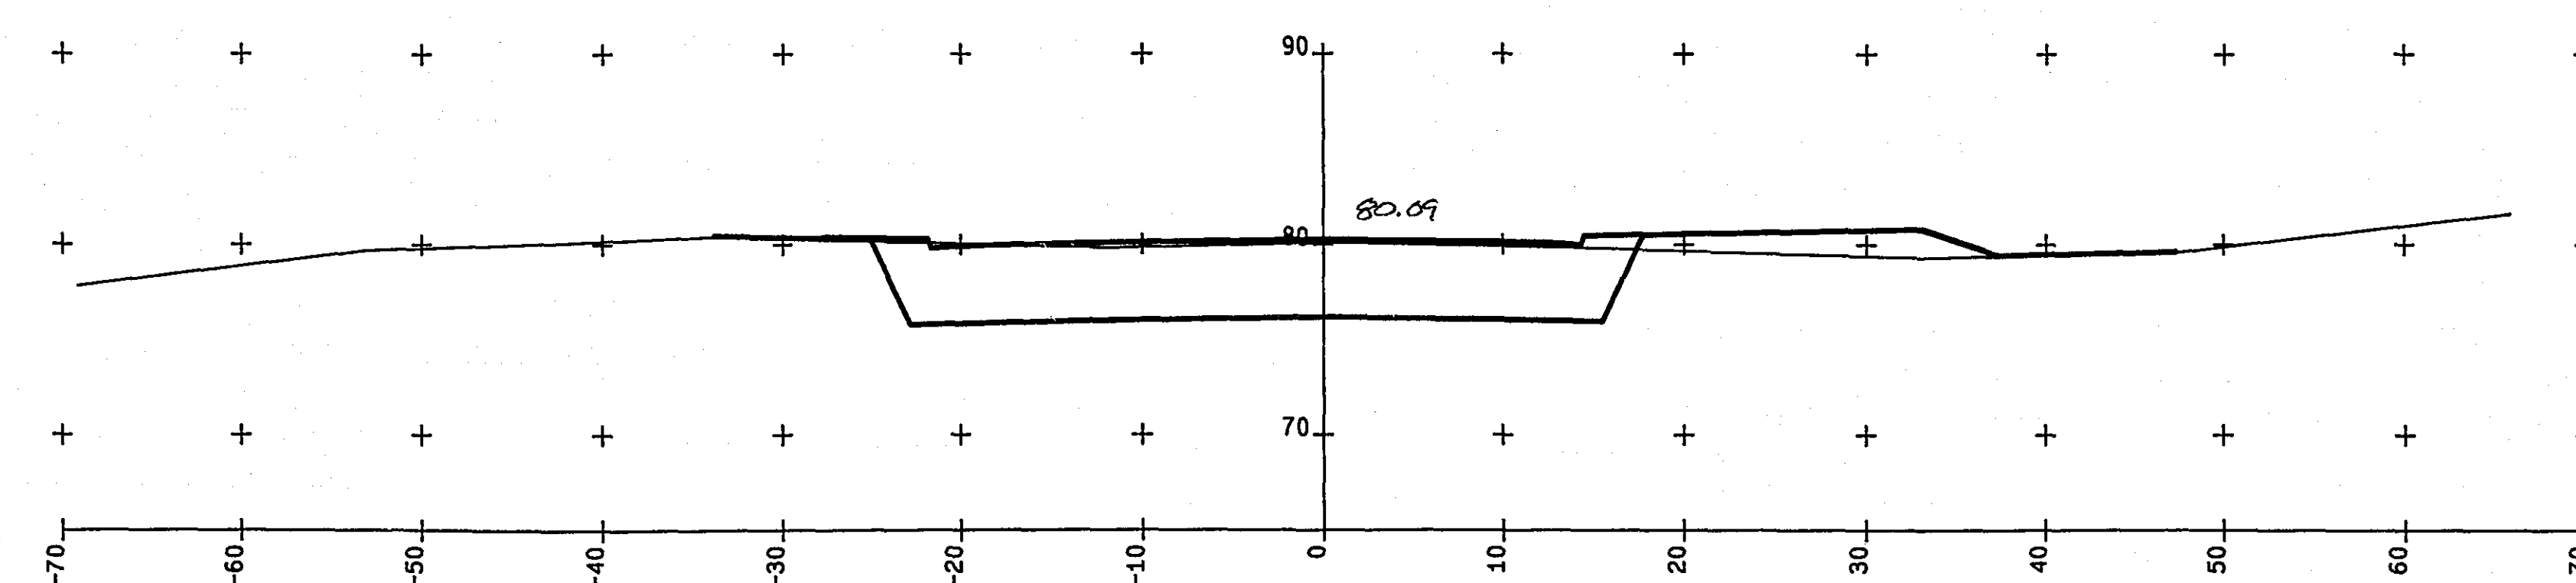


45+91.00

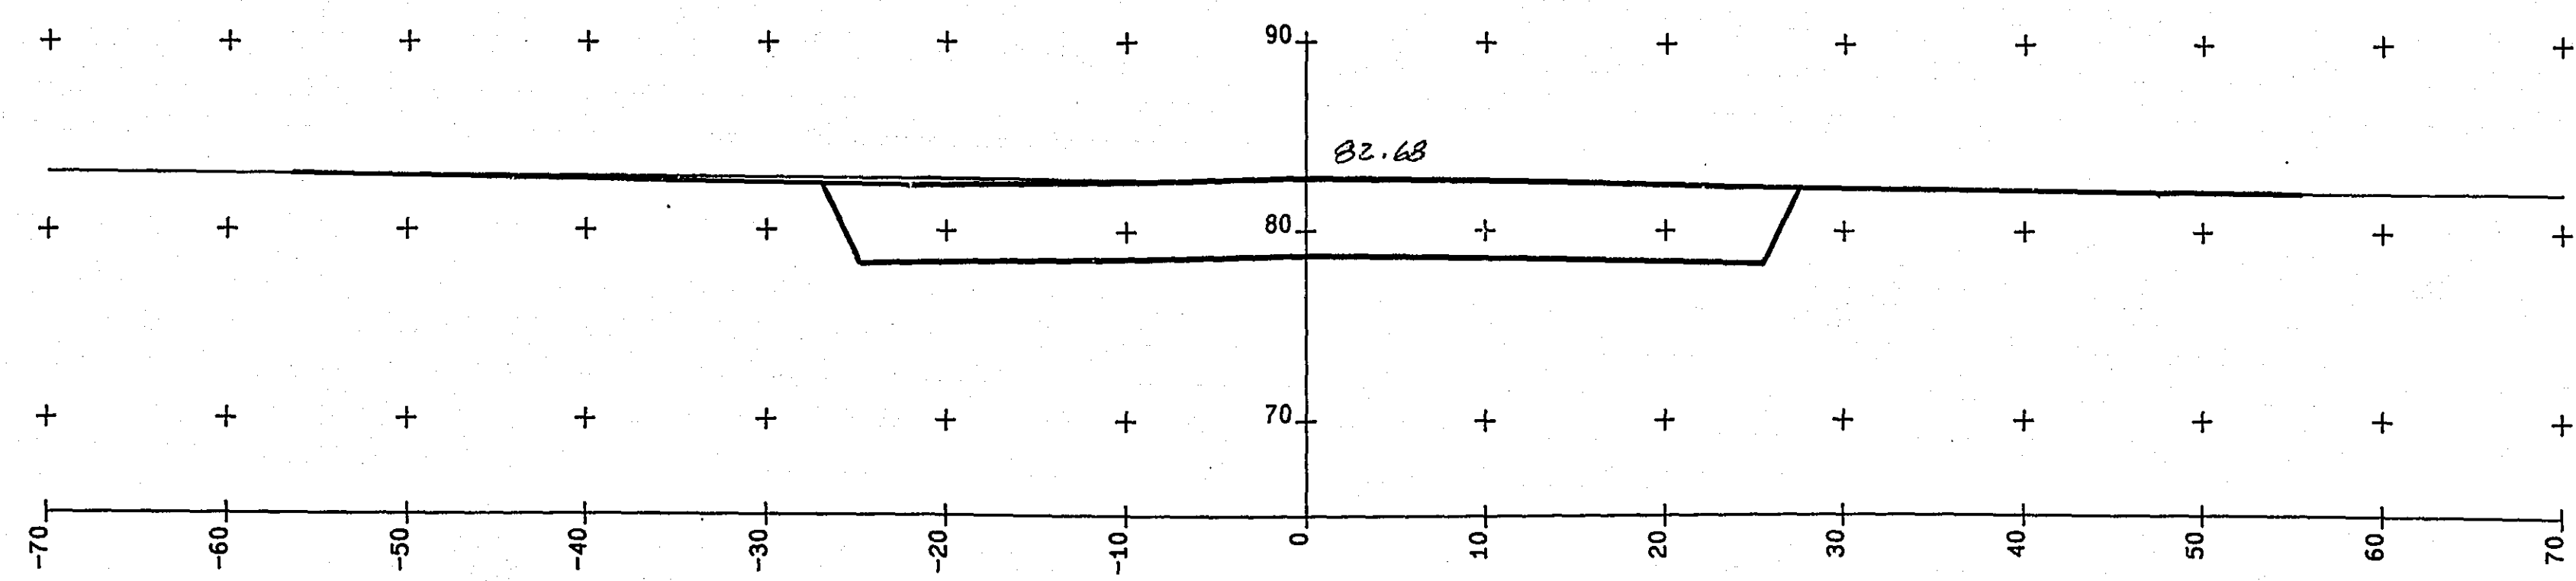


48+94.00

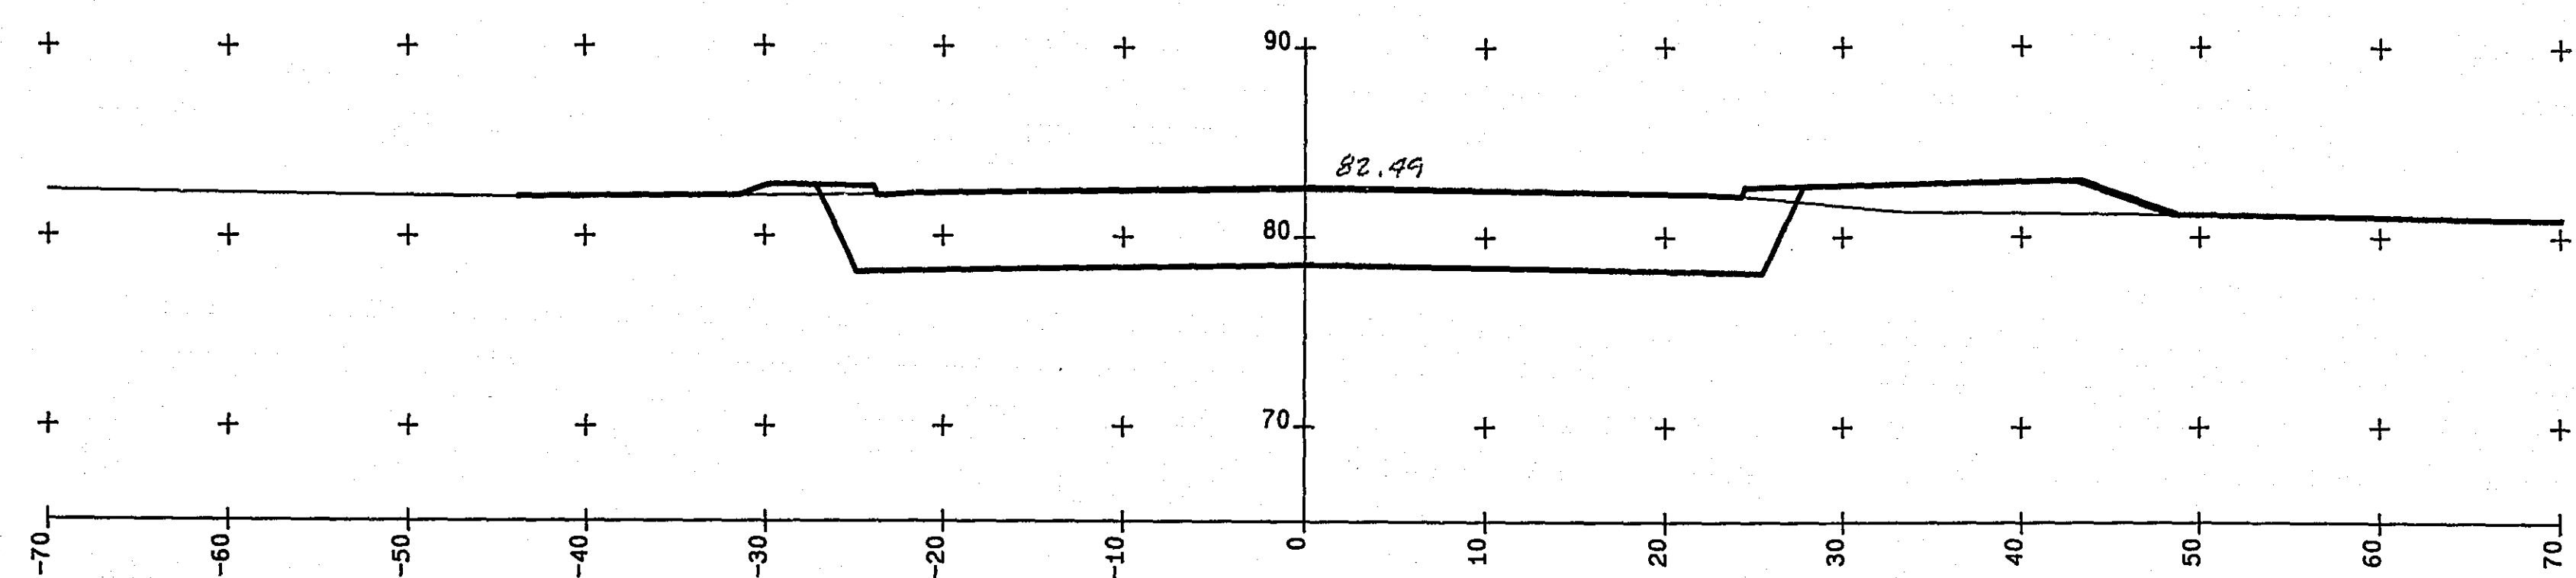

48+75.00




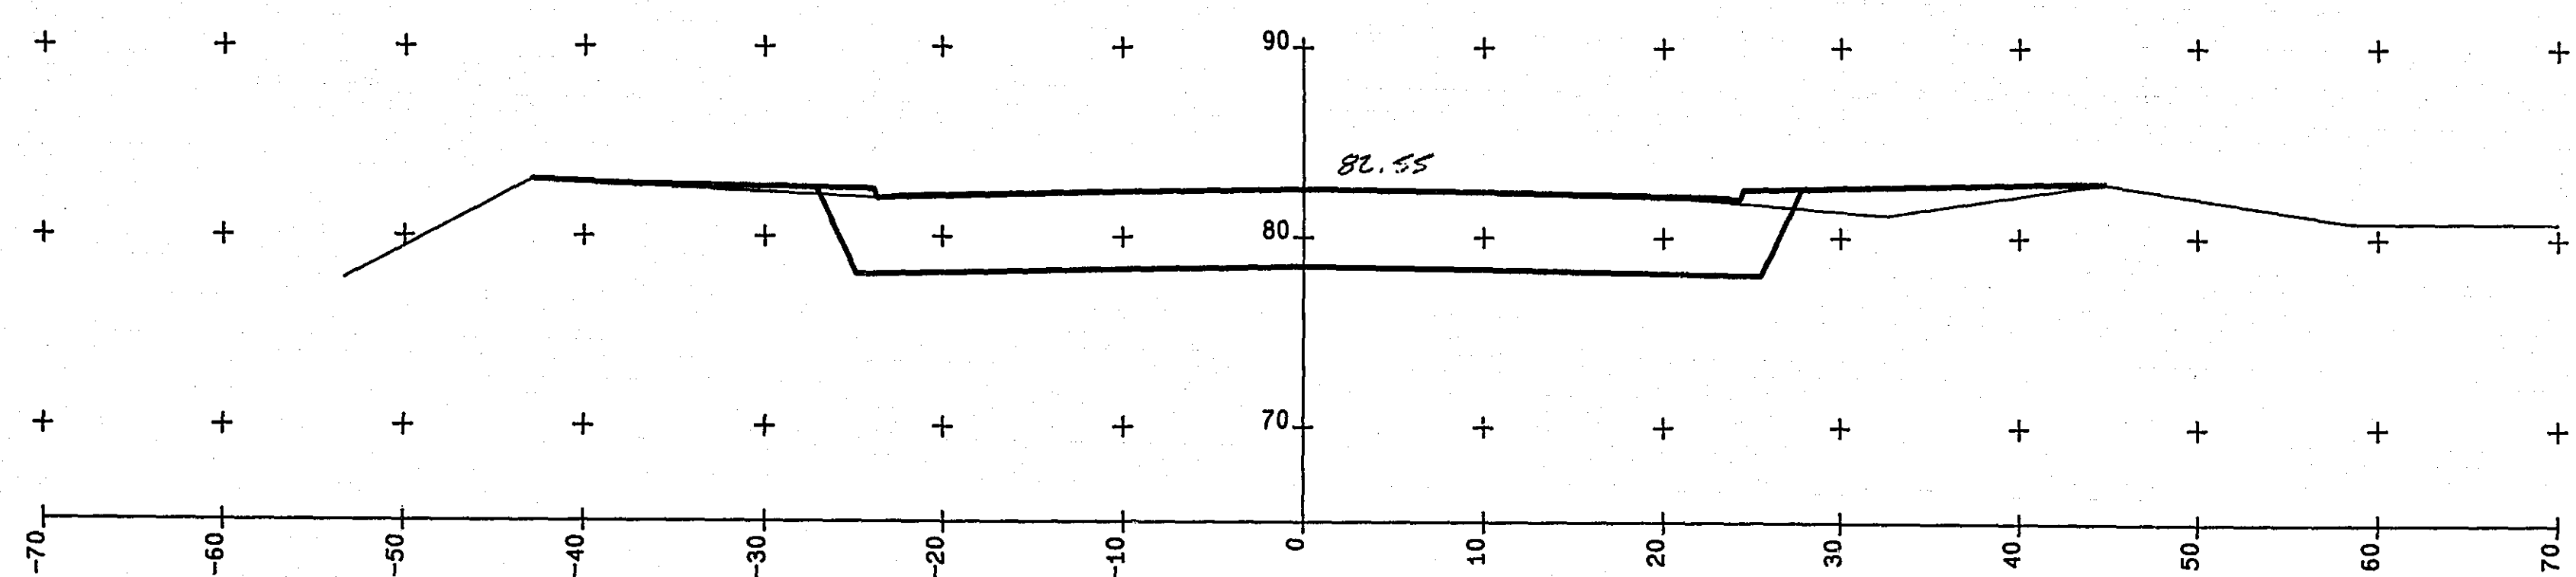


48+65.00

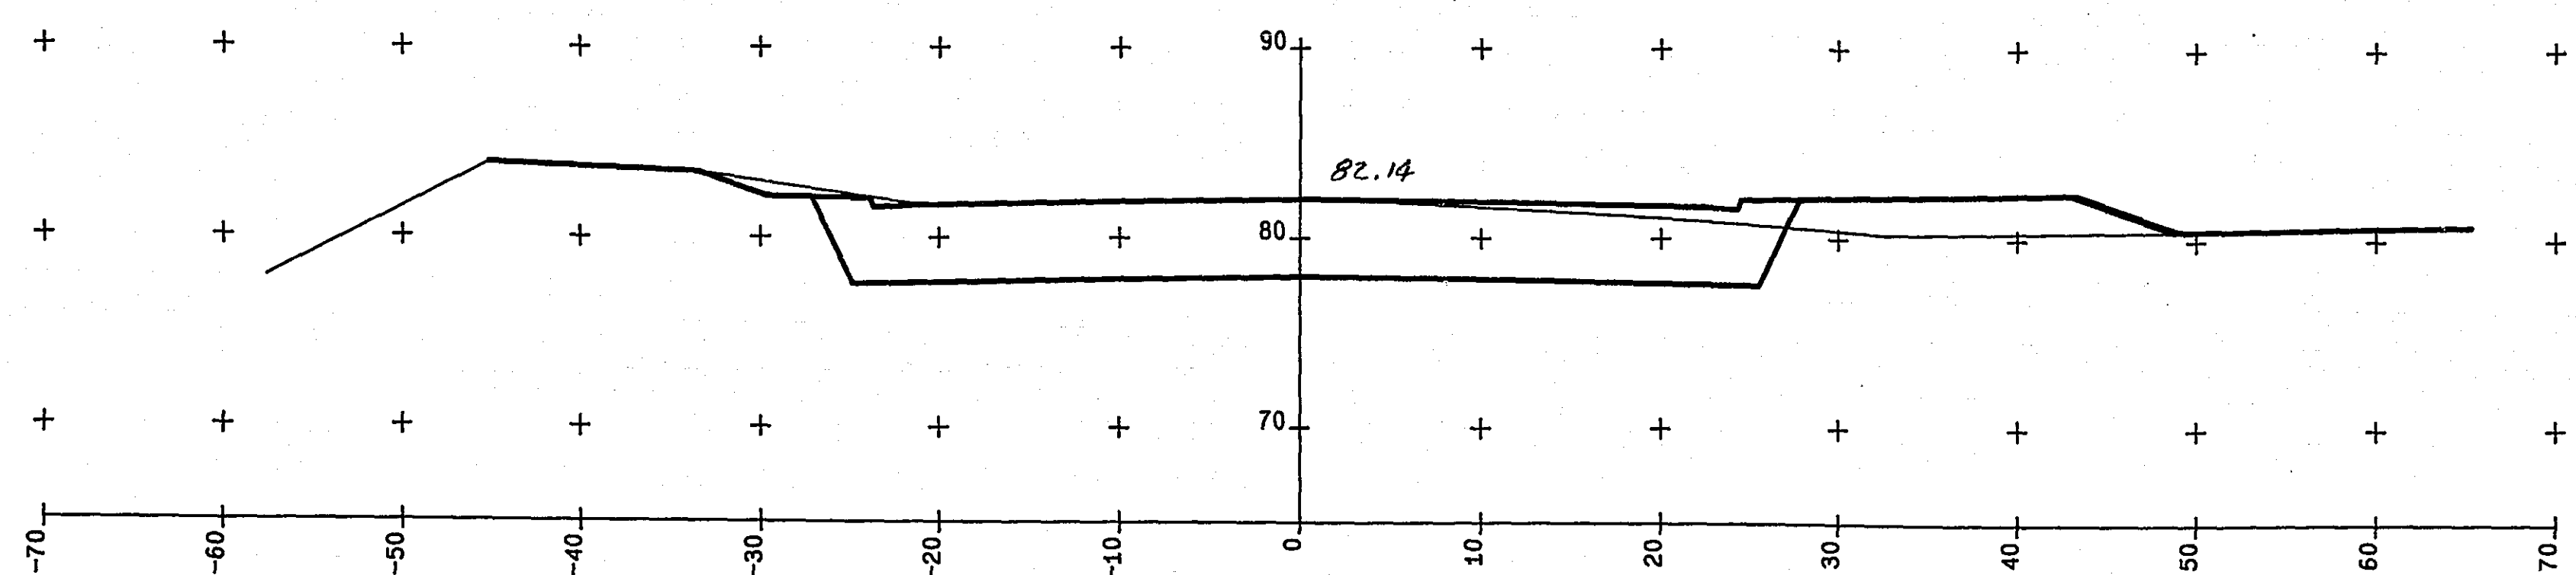


48+09.00

TOPOGRAPHY	PLOTTED BY B.H. BEHNING	DATE 6-20-86	CHECKED BY	DATE
UTILITIES	PLOTTED BY B.H. BEHNING	DATE 6-20-86	CHECKED BY	DATE
PROFILE	PLOTTED BY A.H. BEHNING	DATE 6-05-87	AS-BUILT BY	DATE

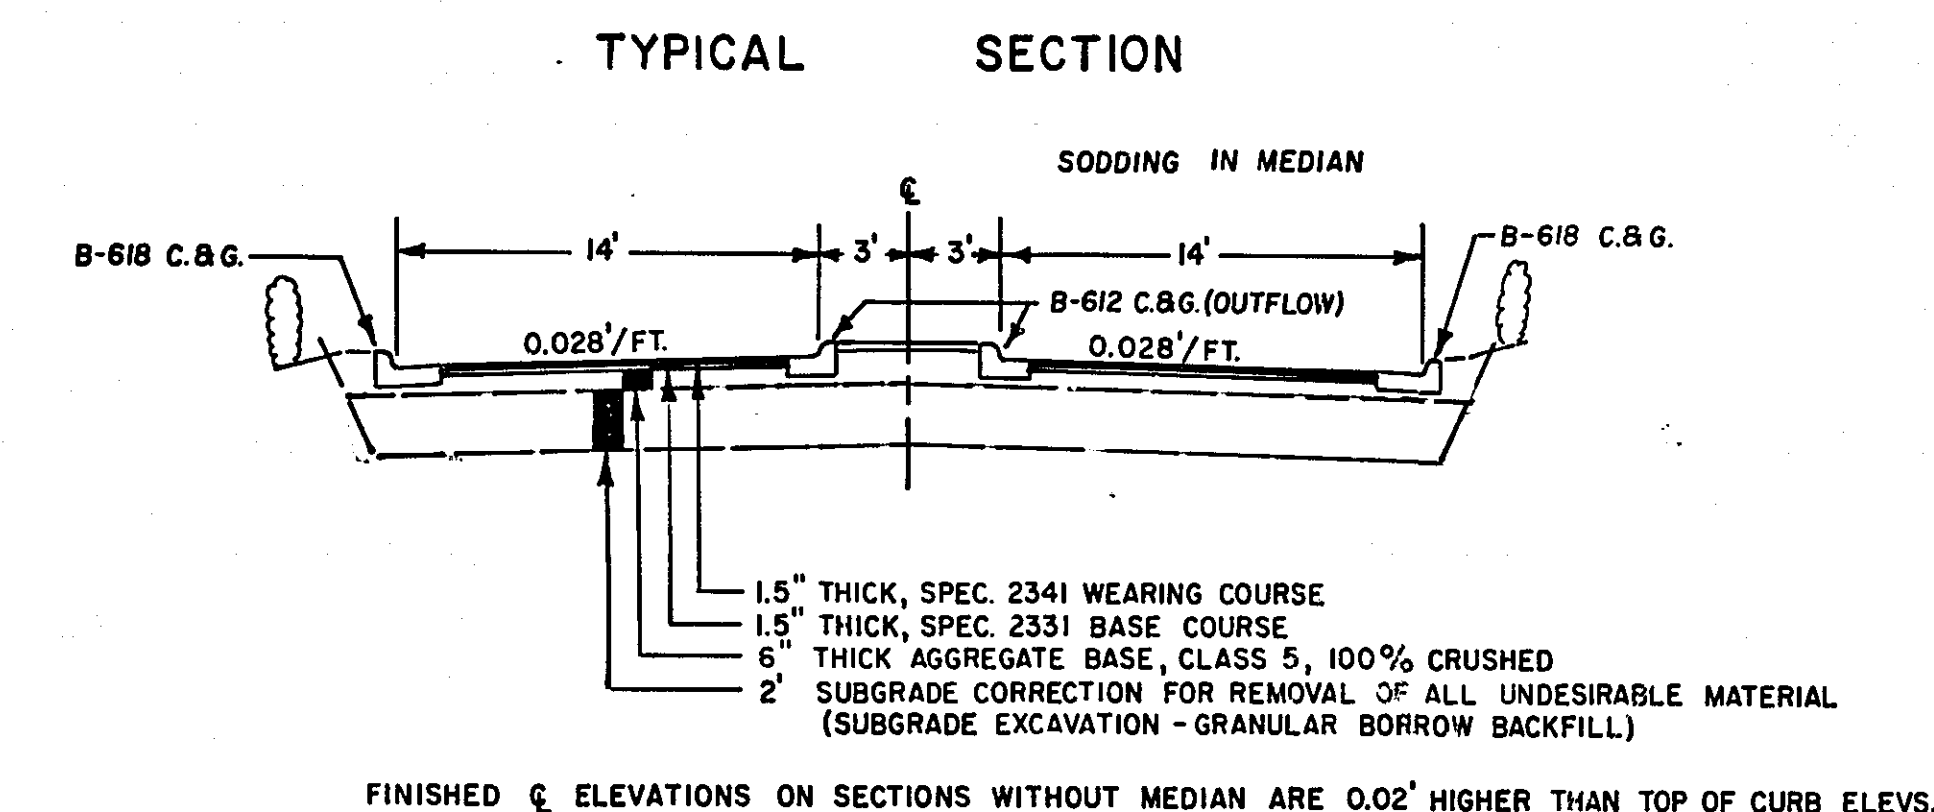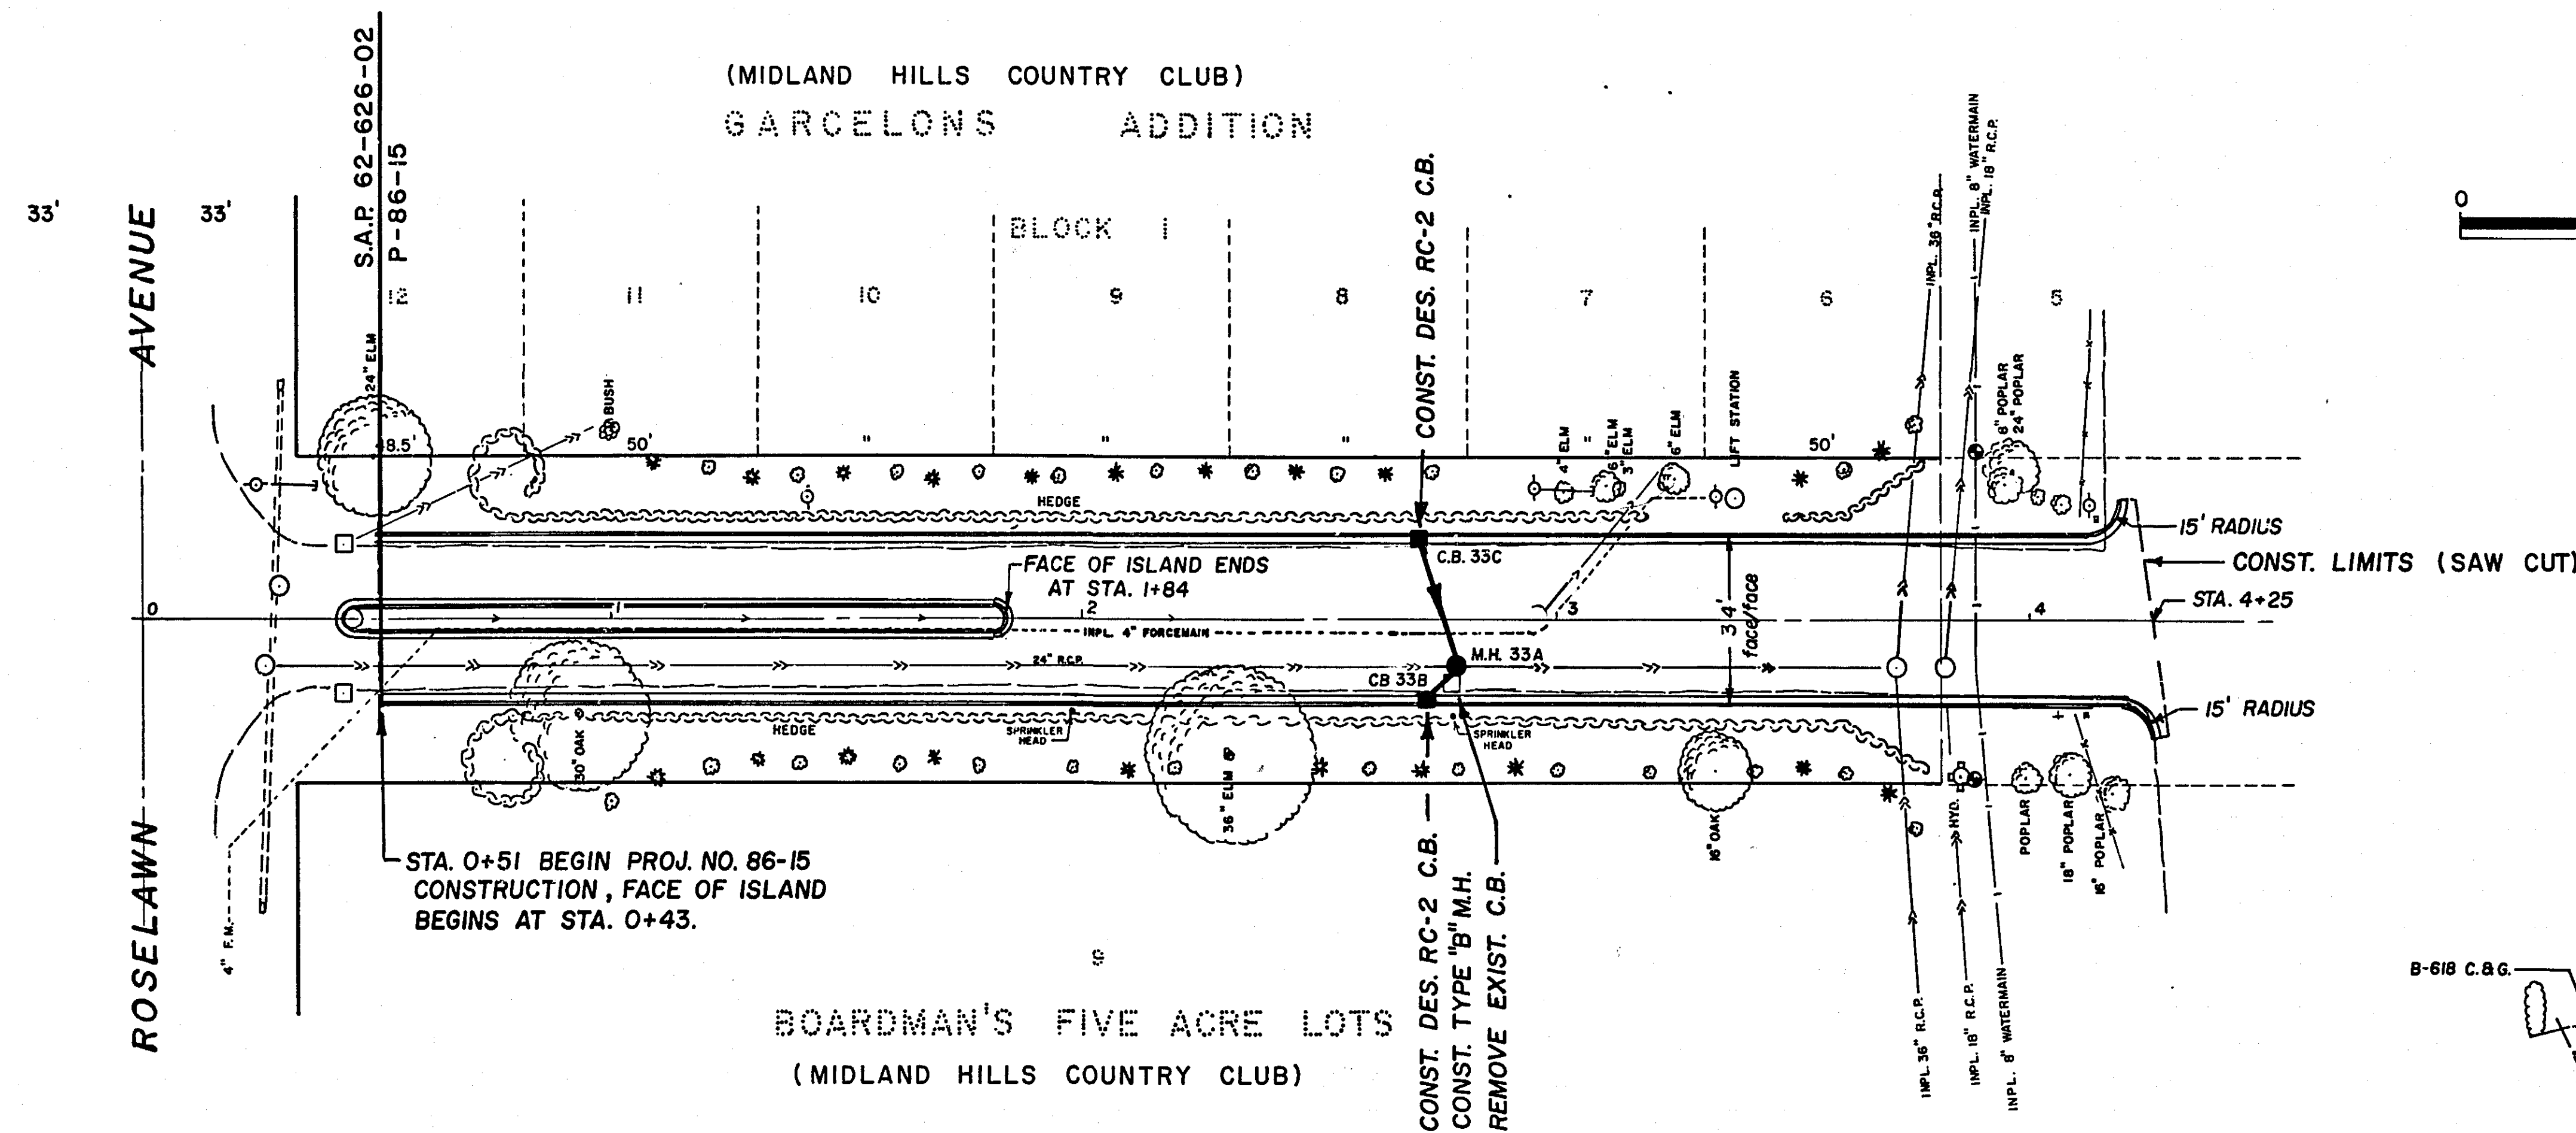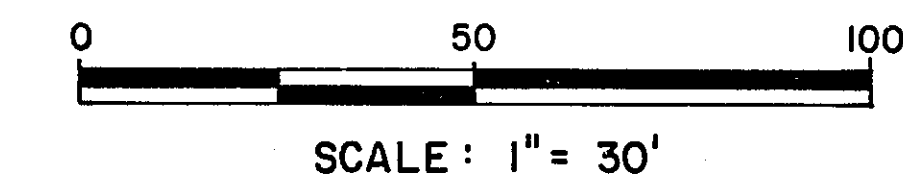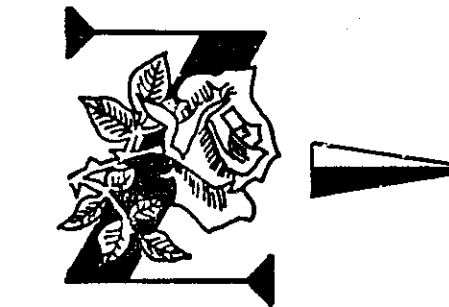

FULHAM STREET


66' Right-of-way

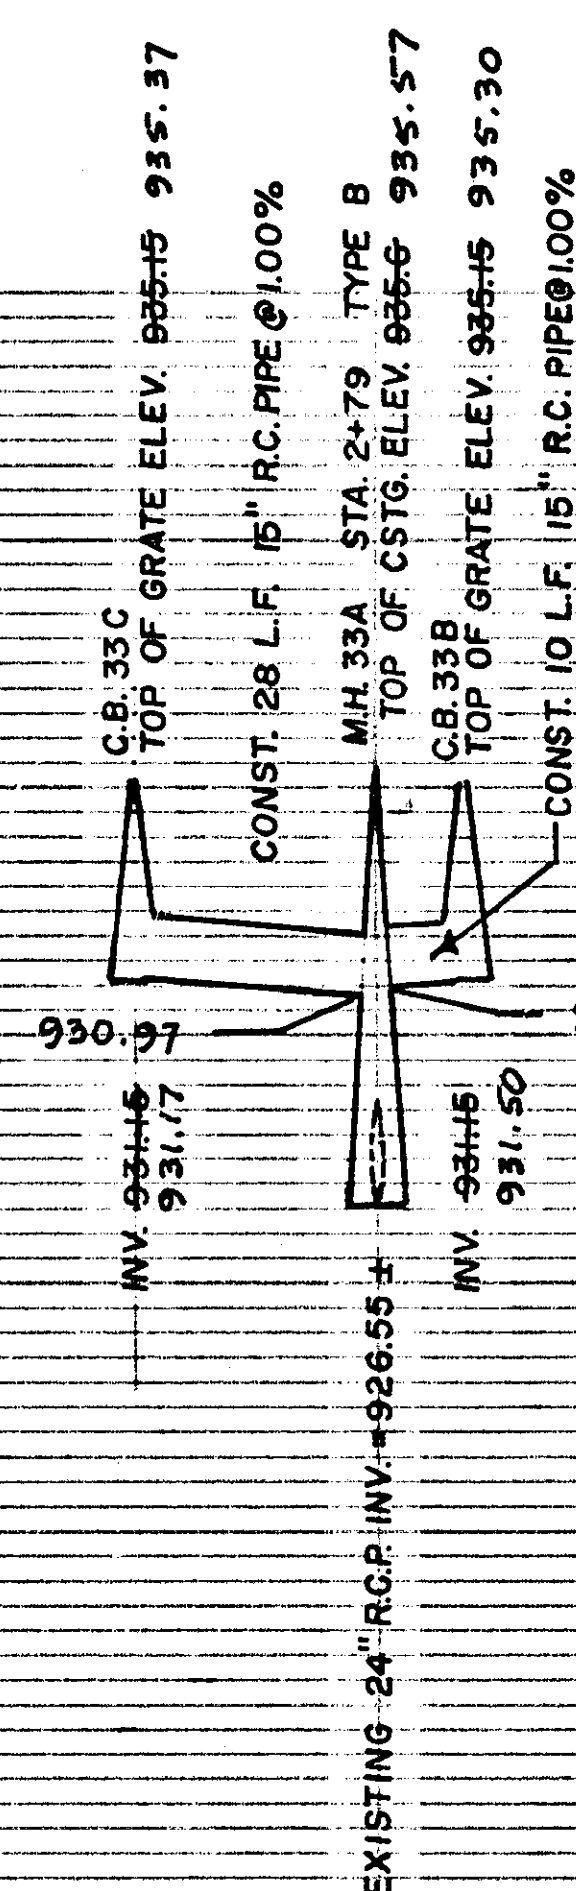

NOTES:


- | | | | | | | |
|-----|--|------|--|--------|------------|-------|
| NO. | | DATE | DESCRIPTION | AMOUNT | UNIT PRICE | TOTAL |
| 1. | | | CONSTRUCT FLAGSTONE RETAINING WALL FROM STA. 1+75 TO STA. 3+10 EAST SIDE. FACE OF WALL TO BE 1.5' FROM BACK OF CURB; TOP OF WALL TO BE 1' HIGHER THAN TOP OF CURB. | | | |
| 2. | | | REMOVE 30" OAK, STA. 0+93, 18' EAST. | | | |

PROFILE SCALE
HORIZ. : 1" = 30'
VERT. : 1" = 5'

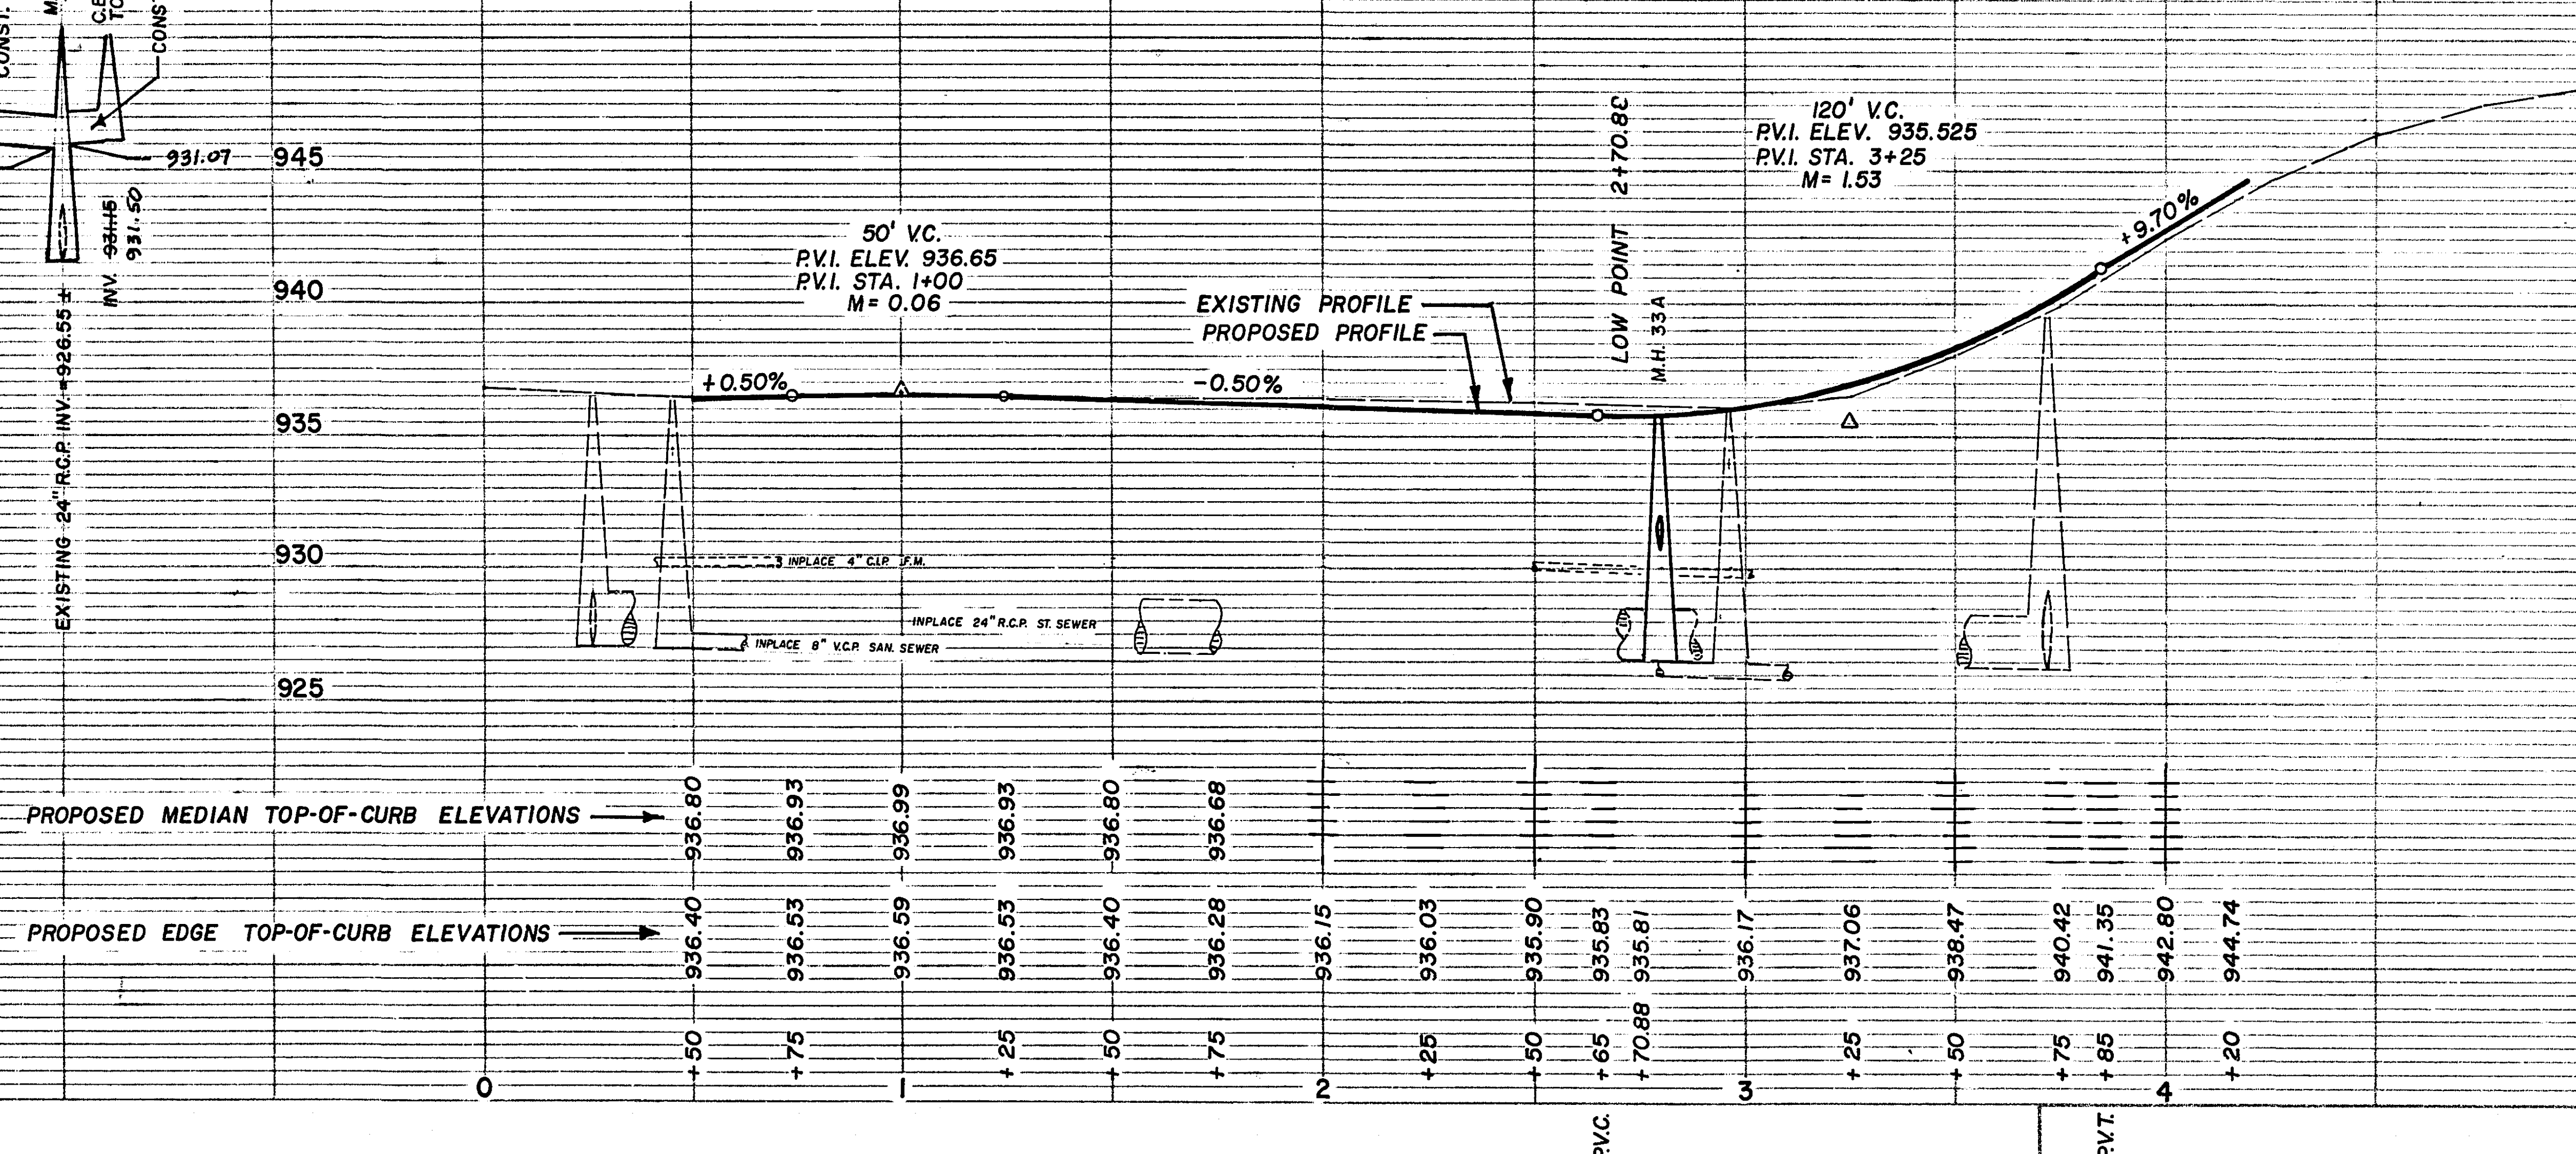

**ASBUILT PLAN
CONFORMING TO
CONST. RECORDS**

DONE BY: G.A.
DATE: 1-4-89

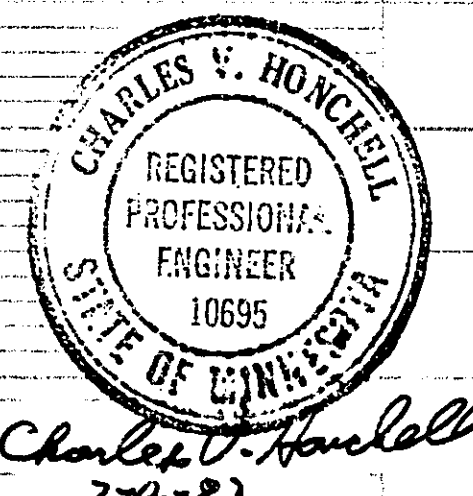

ENGINEERING DEPARTMENT
CITY OF ROSEVILLE
STREET RECONSTRUCTION
FULHAM STREET
FROM ROSELAWN AVE. TO 400[±] NORTH
CITY PROJECT NO. 86-15

SHEET NO. 29A OF 29 SHEETS


27-117

FINAL	SURVEYED	DATE
SURVEY	PLOTTED	BY
NOTE BOOK	DATE	
NO.	AREAS CHECKED	

ORIGINAL	SURVEYED	DATE
SURVEY	PLOTTED	BY
NOTE BOOK	DATE	
NO.	AREAS CHECKED	

STA	DIST	COMM. EXC	S.G. EXC.	CE/C.Y.	SG/C.Y.
0+51	49	41.25	73.0	73.05	132.48
1+00	50	44.25	73.0	62.46	135.18
1+50	50	27.75	73.0	55.09	135.18
2+00	50	31.75	73.0	64.35	135.18
2+50	50	37.75	73.0	58.56	135.18
3+00	50	25.50	73.0	38.66	135.18
3+50	50	16.25	73.0	36.57	135.18
4+00	25	23.25	0	23.96	33.20
4+25				414.1	977.4

4 + 25 EXIST 944.7
PROF

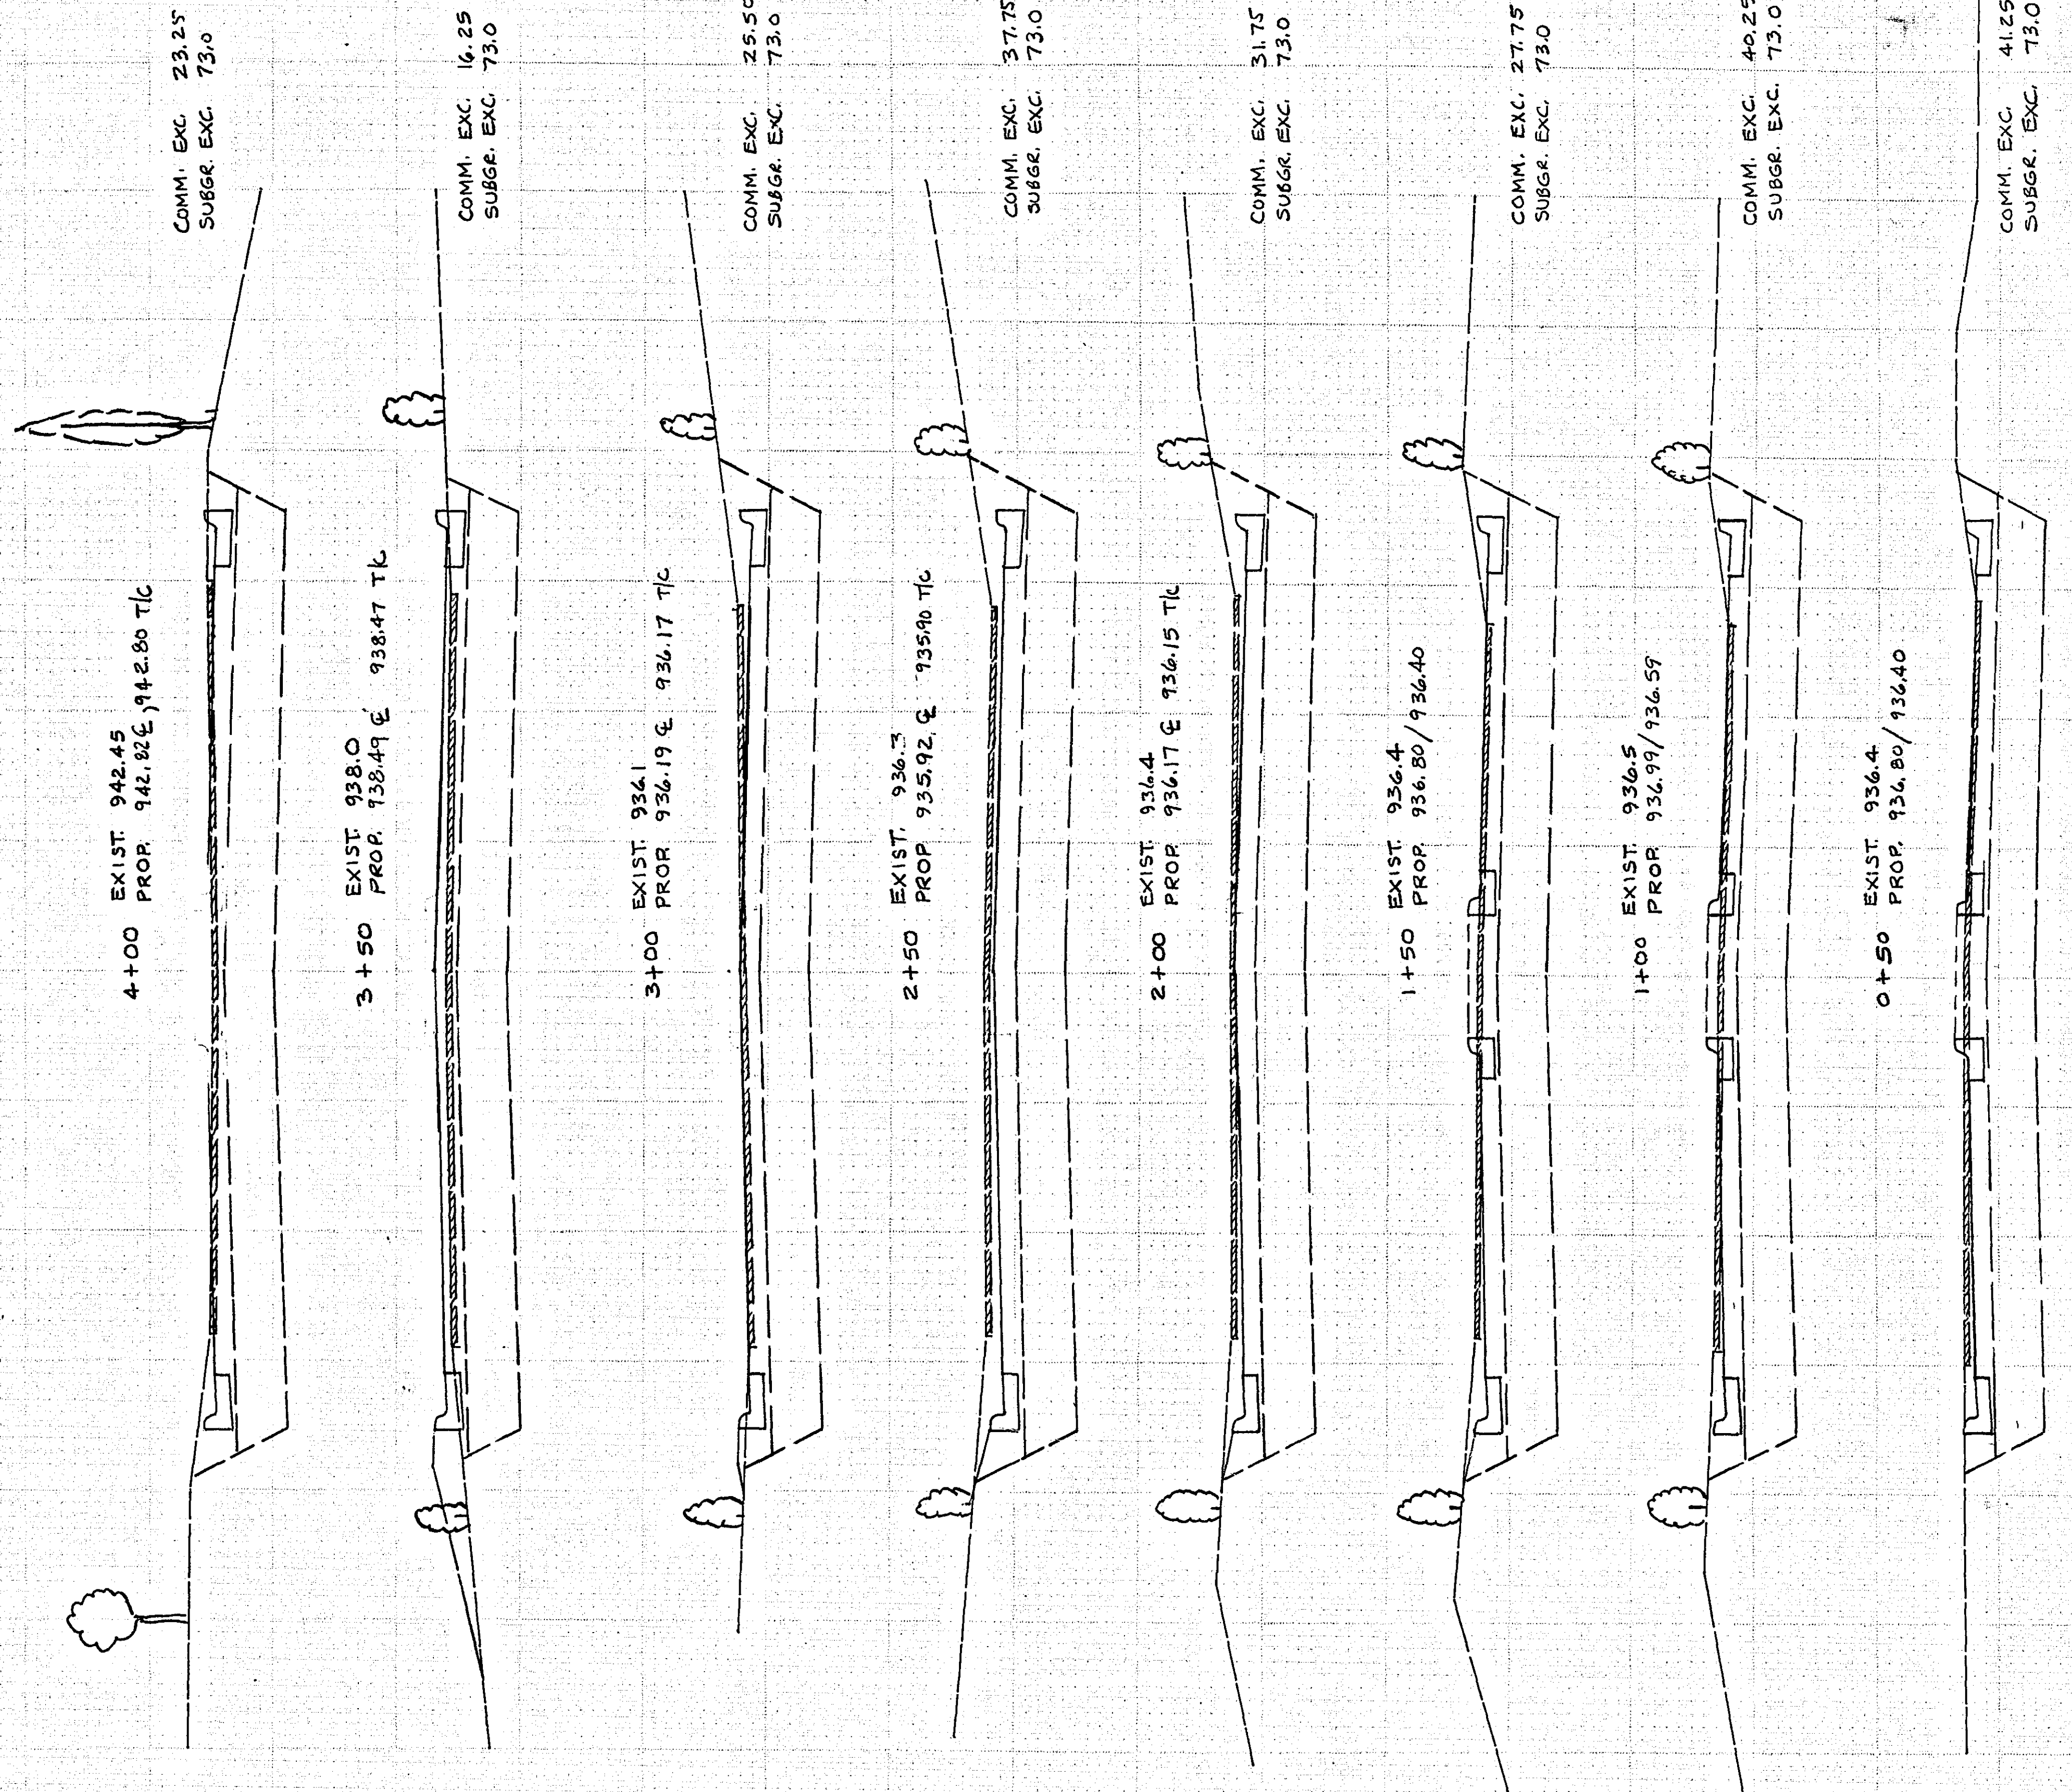


HIGHWAY FEDERAL AID SHEET
PLATE 3-FULL CROSS SECTION-FULL DOT
NOTES
PRINTED IN U.S.A.

City of Roseville

Proj. no. P-86-15

Fulham Street 27-117

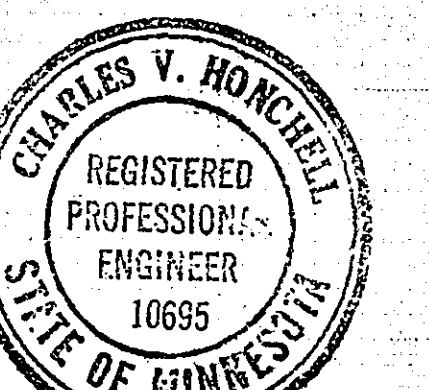

SHEET NO. 29B OF 29 SHEETS