




PLANS SYMBOLS

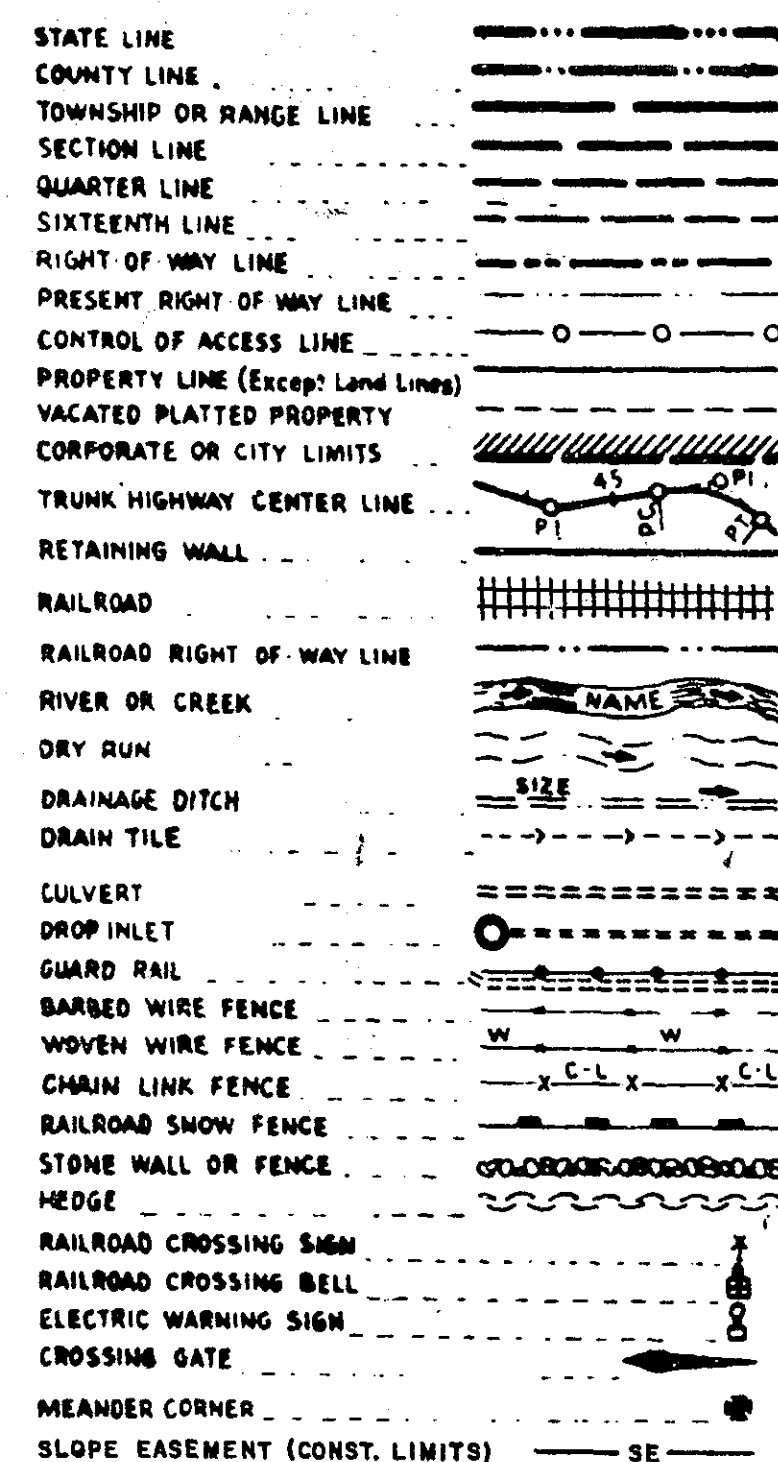

UTILITIES SYMBOLS

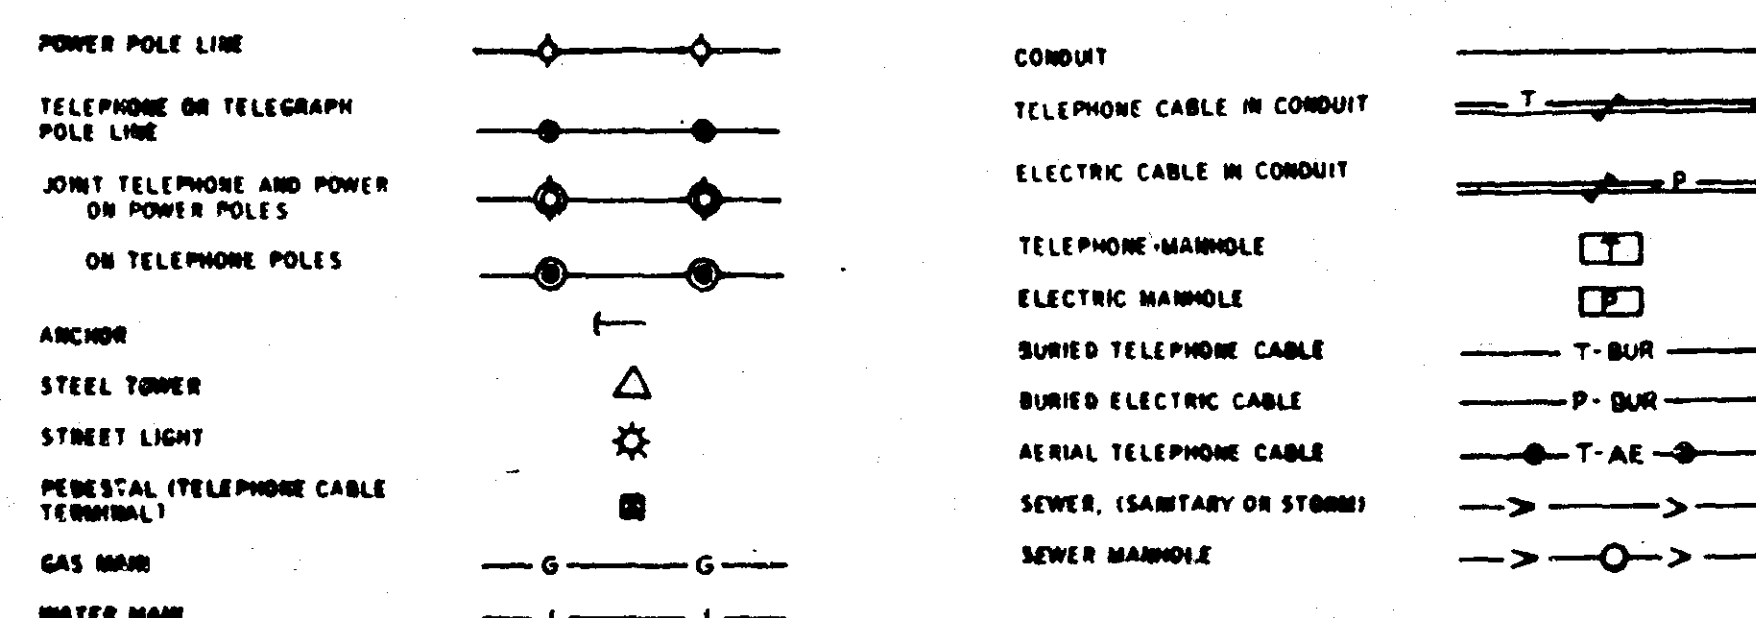

	FEET	MILES
GROSS LENGTH	2330.0	= 0.4413
BRIDGE LENGTH	159.1	= 0.0303
EXCEPTION	159.1	= 0.0303
NET LENGTH	2170.9	= 0.4110
PLAN	10 30 50	
PROFILE HORIZ.	10 20 30 40 50	
PROFILE VERT.	5 10	
CROSS SECTIONS	10 20	
LAYOUT MAP	0 2000 4000	

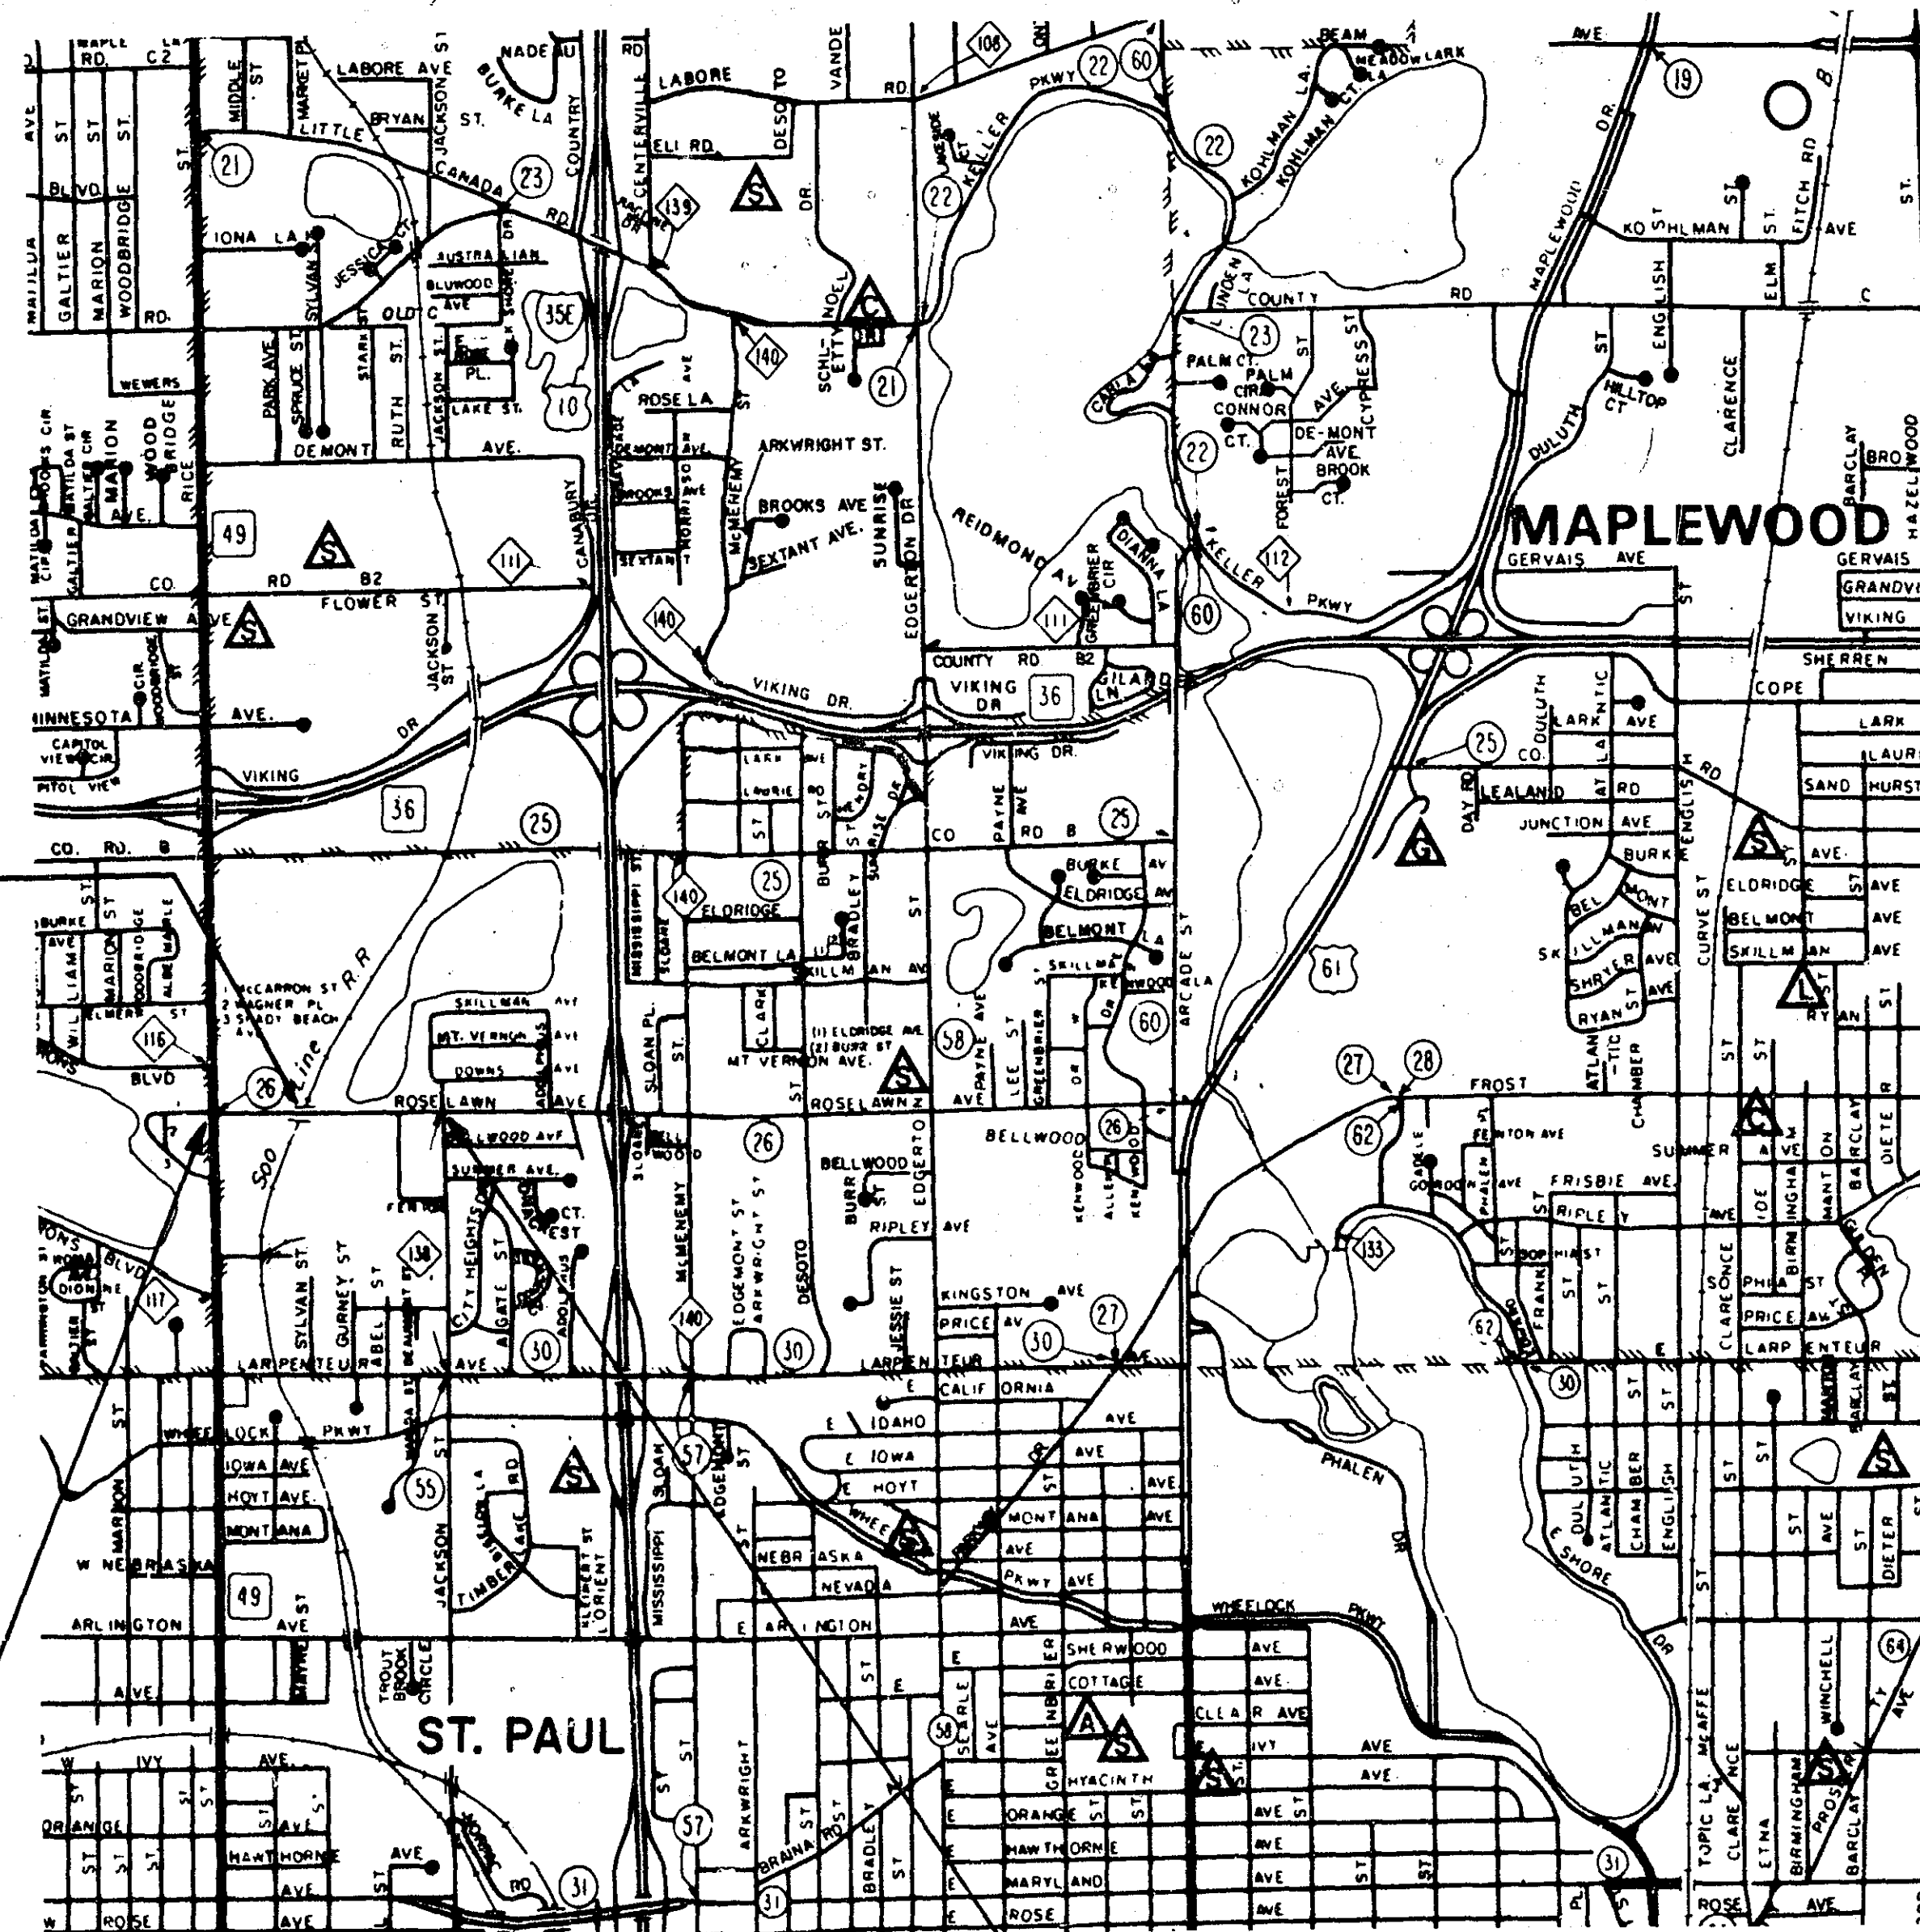

BRIDGE 62559
8+49 TO 10+08

BEGIN PROJECT
STA. 0+50

END PROJECT
STA. 23+80

DESIGN DESIGNATION

S.A.P. NO. 62-626-04

RICE STREET to JACKSON STREET

ADT (CURRENT YEAR) 1989	3100
ADT (FUTURE YEAR) 2009	5000
Σ N 20 YEAR	325,000
DESIGN LOAD	10 TON
STABILOMETER "R" VALUE	17
DESIGN SPEED	40 MPH
HC ADT	350
FUNCTIONAL CLASSIFICATION	COLLECTOR-HIGH DENSITY
NO. OF TRAFFIC LANES	2
NO. OF PARKING LANES	0

RAMSEY COUNTY
DEPARTMENT OF PUBLIC WORKS
CONSTRUCTION PLAN: FOR GRADING, AGGREGATE BASE,
BITUMINOUS BASE AND SURFACING, STORM SEWER,
CONCRETE CURB & GUTTER, AND UTILITY IMPROVEMENTS.

ROSELAWN AVENUE (CSAH NO. 26)

BETWEEN: RICE STREET AND JACKSON STREET

FROM: THE SOUTHWEST CORNER OF THE NORTH HALF OF SECTION
18, TOWNSHIP 29N, RANGE 22W.

TO: THE CENTER POINT OF SECTION 18, TOWNSHIP 29N, RANGE 22W.

S.A.P. 62-626-04
M.S.A.P. 138-020-13 WEST CITY LIMITS TO JACKSON STREET

INDEX OF SHEETS

SHEET NO.	DESCRIPTION
1	TITLE SHEET
2	STATEMENT OF ESTIMATED QUANTITIES
3	TYPICAL SECTIONS
4,5	MISCELLANEOUS DETAILS
6	SCHEDULES AND CHARTS
7	DRAINAGE CHART
8-10	STREET AND STORM SEWER CONSTRUCTION
11,12	WATERMAIN AND SERVICE CONSTRUCTION
13	LANDSCAPE PLAN
14-23	CROSS SECTIONS
24	BRIDGE PLAN (FOR INFORMATION ONLY)

ASBUILT PLAN
CONFORMING TO
CONST. RECORDS

DONE BY: *RED*
DATE: *2/5/93*

DESIGN SQUAD _____ DATE _____
DRAWN BY _____ DATE _____
CHECKED BY _____ DATE _____
I HEREBY CERTIFY THAT THIS PLAN WAS PREPARED BY ME OR UNDER MY DIRECT
SUPERVISION AND THAT I AM A DULY REGISTERED PROFESSIONAL ENGINEER UNDER
THE LAWS OF THE STATE OF MINNESOTA.
DATE *10/19/89* REG. NO. *16610* ENGR. *Thomas A. Peterson*

THE 1988 EDITION OF THE MINNESOTA DEPARTMENT
OF TRANSPORTATION "STANDARD SPECIFICATIONS FOR
CONSTRUCTION" SHALL GOVERN.

STOPPING SIGHT DISTANCE BASED ON
3.5' HEIGHT OF EYE - 0.5' HEIGHT OF OBJECT

RAMSEY COUNTY
RECOMMENDED FOR APPROVAL *DES* DATE *5/8/90* RECOMMENDED FOR APPROVAL *Kenneth W. Smith* DATE *6-1-90*
TRAFFIC ENGR. COUNTY ENGINEER
RECOMMENDED FOR APPROVAL *KMR* DATE *5/8/90* APPROVED *R. A. Noyard* DATE *10-23-91*
ENR. ENGR. CHAIR, OF THE RAMSEY COUNTY BOARD
RECOMMENDED FOR APPROVAL *DES* DATE *5-8-90* APPROVED *Kenneth D. Hesse* DATE *11/1/90*
MAINT. ENGR. MAPLEWOOD CITY ENGINEER
RECOMMENDED FOR APPROVAL *BMP* DATE *5-9-90* APPROVED _____ DATE _____
CORR. ENGR.
RECOMMENDED FOR APPROVAL *DLR* DATE *5-10-90* MINNESOTA DEPARTMENT OF TRANSPORTATION
DESIGN ENGR.
RECOMMENDED FOR APPROVAL _____ DATE _____ RECOMMENDED FOR APPROVAL *Julius Skellman* DATE *7/25/90*
DISTRICT STATE AID ENGINEER
RECOM'D *Wendell Conrad* DATE *5-8-90* RECOMMENDED FOR APPROVAL *Wendell Conrad* DATE *7/11/90*
DESIGN ENGR. APPROVAL *Daniel C. Carlson* DATE *7/25/90*
RECOM'D *Frank R. Hill* DATE *6/1/90* ASSISTANT CO. ENGINEER

DATE	SHEET NO.	BY
<i>5/7/91</i>	<i>2, 13</i>	<i>B.J.-T.L.</i>
<i>5/24/92</i>	<i>7, 9, 10, 18-23</i>	<i>B.J.-WRL</i>

ROSELAWN AVENUE
STATEMENT OF ESTIMATED QUANTITIES

				TOTAL QUANTITIES		RAMSEY CO. ①		MAPLEWOOD ②		MAPLEWOOD		STORM SEWER ③	
				EST. QUANTITY	FINAL QUANTITY	EST. QUANTITY	FINAL QUANTITY	EST. QUANTITY	FINAL QUANTITY	EST. QUANTITY	FINAL QUANTITY	EST. QUANTITY	FINAL QUANTITY
ITEM NO.	CONTRACT	ITEM	UNIT	EST. QUANTITY	FINAL QUANTITY	EST. QUANTITY	FINAL QUANTITY	EST. QUANTITY	FINAL QUANTITY	EST. QUANTITY	FINAL QUANTITY	EST. QUANTITY	FINAL QUANTITY
2021.501	MOBILIZATION		LS	1		0.6		0.4					
2101.501	CLEARING		AC	1				1					
2101.506	GRUBBING		AC	1				1					
2104.501	REMOVE SEWER PIPE		LF	155		155							
2104.501	REMOVE CURB & GUTTER		LF	60		60							
2104.501	REMOVE CONCRETE SWALE		LF	240		240							
2104.503	REMOVE CONCRETE SIDEWALK		SF	184		184							
2104.503	REMOVE CONCRETE DRIVEWAY		SF	1140		1140							
2104.503	REMOVE RETAINING WALL		SF	900		900							
2104.505	REMOVE BITUMINOUS PAVEMENT		SY	7500		7500							
2104.505	REMOVE CONCRETE PAVEMENT		SY	35		35							
2104.511	SAVING CONCRETE PAVEMENT		LF	110		110							
2104.513	SAVING BITUMINOUS PAVEMENT		LF	170		170							
2104.521	SALVAGE CHAIN LINK FENCE		LF	1400		1400							
2104.521	SALVAGE GUARD RAIL		LF	518		518							
2104.523	SALVAGE ANCHORAGE ASSEMBLY		EA	4		4							
2104.523	SALVAGE VEHICULAR GATE		EA	5		5							
2104.523	SALVAGE CASTING		EA	6				6					
2104.523	SALVAGE 24" FES, BULKHEAD PIPE		EA	2		2							
0104.602	SALVAGE & REINSTALL MAIL BOX		EA	10				10					
0104.602	SALVAGE HYDRANT		EA	1				1					
2105.501	COMMON EXCAVATION (P)		CY	6400		4700		1700					
2105.522	SELECT GRANULAR BORROW (LV)		CY	13000		8125		4875					
2105.523	COMMON BORROW (LV)		CY	32000		23100		8900					
2105.525	TOPSOIL BORROW (LV)		CY	2300		2300							
2130.501	WATER		MGAL	50		35		15					
2211.503	AGGR. BASE PLACED, CLASS 6		CY	1900		1160		740					
2211.503	AGGR. BASE PLACED, CL. 6 (DRWYS)		CY	150		150							
2331.504	BIT. MATERIAL FOR MIXTURE		TON	164		117		47					
2331.510	BINDER COURSE MIXTURE		TON	1185		800		385					
2331.510	BINDER COURSE MIXTURE (DRWYS)		TON	100		100							
2331.514	BASE COURSE MIXTURE		TON	1910		1400		510					
2341.504	BIT. MATERIAL FOR MIXTURE		TON	51		37		14					
2341.508	WEARING COURSE MIXTURE		TON	820		600		220					
2341.510	WEARING COURSE MIXTURE (DRWYS)		TON	100		100							
2357.502	BIT. MAT'L FOR TACK COAT		GAL	1000		660		340					
0411.603	KEYSTONE RETAINING WALL		SF	3000				3000					
2503.511	15" CM PIPE SEWER		LF	139								139	
2503.541	15" RC PIPE SEWER, CL V-DES 3006		LF	1737								1737	
2503.541	18" RC PIPE SEWER, CL V-DES 3006		LF	20								20	
2501.515	15" CM PIPE APRON		EA	2								2	
2501.515	36" RC PIPE APRON		EA	2		2							
2501.561	36" RC PIPE CULVERT, CL V-DES 3006		LF	200		200							
2502.541	4" PERF. TP PIPE DRAIN		LF	4200		4200							
2503.511	8" PVC SEWER, 12' - 14'		LF	76						76			
2503.511	8" PVC SEWER, 14' - 16'		LF	200						200			
2503.511	8" DIP SEWER, 16' - 18'		LF	125		125*							
2503.511	8" DIP SEWER, 18' - 20'		LF	40		40*							
2503.511	8" DIP SEWER, 20' - 22'		LF	40		40*							
2503.511	8" DIP SEWER, 22' - 24'		LF	30		30*							
2503.511	8" DIP SEWER, 24' - 26'		LF	25		25*							
2503.511	8" DIP SEWER, 26' - 28'		LF	22		22*							
2503.511	10" DIP SEWER, 20' - 22'		LF	7		7*							
2503.511	10" DIP SEWER, 22' - 24'		LF	5		5*							
2503.511	10" DIP SEWER, 24' - 26'		LF	4		4*							
2503.511	10" DIP SEWER, 26' - 28'		LF	4		4*							
2503.511	10" DIP SEWER, 28' - 30'		LF	60		60*							
2503.511	10" DIP SEWER, 30' - 32'		LF	50		50*							
2503.511	10" DIP SEWER, 32' - 34'		LF	42		42*							

NOTE: Quantities with a "*" following them have been revised 9/26/90

NOTE:

- ① CENTER 24', 100% S.A.P. FUNDED
- ② OUTSIDE CENTER 24' AND WITHIN ROADWAY:
75% M.S.A.P. FUNDED (MAPLEWOOD)
25% S.A.P. FUNDED (RAMSEY COUNTY)
- ③ STORM SEWER - PROPORTIONAL SPLIT
BETWEEN RAMSEY CO. AND MAPLEWOOD

ROSELAWN AVENUE
STATEMENT OF ESTIMATED QUANTITIES

				TOTAL QUANTITIES		RAMSEY CO. ①		MAPLEWOOD ②		MAPLEWOOD		STORM SEWER ③	
				EST. QUANTITY	FINAL QUANTITY	EST. QUANTITY	FINAL QUANTITY	EST. QUANTITY	FINAL QUANTITY	EST. QUANTITY	FINAL QUANTITY	EST. QUANTITY	FINAL QUANTITY
ITEM NO.	CONTRACT	ITEM	UNIT	EST. QUANTITY	FINAL QUANTITY	EST. QUANTITY	FINAL QUANTITY	EST. QUANTITY	FINAL QUANTITY	EST. QUANTITY	FINAL QUANTITY	EST. QUANTITY	FINAL QUANTITY
2503.511	10" DIP SEWER, 34' - 36'		LF	21								21	
2503.511	10" DIP SEWER, 36' - 38'		LF	40								40	
2503.511	6" RISER PIPE		LF	20								20	
0503.601	REPAIR WYE, RISER, SERVICE & MAIN PIPE @ STA. 1+25		LS	1								1	
0503.602	8" X 6" WYE		EA	3								3	
0503.602	6" PLUG		EA	3								3	
0503.603	6" PVC SEWER SERVICE		LF	13								13	
0503.603	6" DIP SEWER SERVICE		LF	36								36	
0503.603	REPAIR 8" VCP SAN. SEWER		LF	38								38	
0504.602	CONNECT TO EX. WATER MAIN		EA	4								4	
0504.602	FURNISH AND INSTALL HYDRANT		EA	3								3	
0504.602	CONSTRUCT BLOWOFF MANHOLE		EA	1								1	
0504.602	FURN. & INSTALL 6" G.V. & BOX		EA	5								5	
0504.602	FURN. & INSTALL 8" G.V. & BOX		EA	3								3	
0504.602	FURN. & INS. 12" BF VALVE & BOX		EA	5								5	
0504.602	ADJUST VALVE BOX		EA	7								7	
0504.602	ADJUST VALVE NUT AND BOX		EA	4								4	
0504.602	WATER EASEMENT MARKER		EA	7								7	
0504.603	WATER SERVICE TRENCH EXCAVATION		LF	5								5	
0504.603	6" DIP WATER MAIN, CL. 53		LF	120								120	
0504.603	8" DIP WATER MAIN, CL. 53		LF	225								225	
0504.603	12" DIP WATER MAIN, CL. 52		LF	1165								1165	
0504.603	12" DIP CL. 52 W/24" CASING-JACK		LF	55								55	
0504.605	2" POLYSTYRENE INSULATION		SY	30								30	
0504.620	CAST/DUCTILE IRON FITTINGS		LBS	7200								7200	
2506.507	CONSTRUCT CATCH BASIN, DES SP 2		EA	2								2	
2506.508	CONSTRUCT MANHOLE, DES. A OR F		EA	8		2*						4	
2506.509	CONST. CB, DES. LP4-4 OR 5		EA	11								11	
2506.509	CONST. SIDE DRAINS, DES. C		EA	2								2	
2506.511	RECONSTRUCT MANHOLE		LF	53.9		24.5						29.4	
2506.521	INSTALL CASTING		EA	7		5						2	
2506.522	ADJ. FRAME & RING CASTING		EA	2		2							
0506.602	CON. 15" CMP TO 18" RCP W/CON. JNT.		EA	1								1	
0506.602	CONNECT INTO EX. MANHOLE		EA	1								1	
0506.602	OFF ROAD STRUCTURE MARKER		EA	8								3	
0506.603	MANHOLE DEPTH GREATER THAN 8'		LF	83		60*						5	
2511.501	RANDOM RIPRAP, CL. III		CY	30								30	
2511.511	GRANULAR FILTER		CY	15								15	
2511.515	GEOTEXTILE FILTER, TYPE IV		SY	60								60	
2521.501	4" CONCRETE WALK		SF	80				80					
2531.501	CONC. CURB & GUTTER, DES. B624		LF	4500		4500							
2531.501	CONC. CURB & GUTTER, DES. B612		LF	280				280					
2531.507	6" CONC. DRIVEWAY PAVEMENT		SY	90		90							
2535.501	BITUMINOUS CURB		LF	200				200					
2554.511	INSTALL T BARRIER, DES. B8307		LF	500		500							
2554.523	TWISTED END TREATMENT		EA	4		4							
2557.501	WIRE FENCE, DES. 72-9322		LF	30		30							
0557.602	INSTALL VEHICULAR GATE		EA	5		5							
0557.603	INSTALL CHAIN LINK FENCE		LF	1350		1350							
0563.601	TRAFFIC CONTROL (DETOUR SIGNING)		LS	1		0.5		0.5					
2571.501	PINE, AUSTRIAN 5' B&B		TREE	7				7					
2571.501	SPRUCE, BLACK HILLS 5' HI B&B		TREE	9				9					
2571.502	POPLAR, ROBUSTA 8' HI BR		TREE	20				20					
2571.502	LINDEN, AMERICAN 1.75" CAL B&B		TREE	3				3					
2573.502	SILT FENCE, HEAVY DUTY		LF	1735				1735					
2575.505	SODDING, TYPE LAWN		SY	1500		1500							
0575.609	SEEDING W/FERTILIZER & MULCH		AC	3		3							

REVISIONS	DATE	BY
2571.501	5/14	T.L.
BLACK HILLS SPRING		


© BONESTROO, ROSENE, ANDERLIK,
AND ASSOCIATES, INC. 1989

I HEREBY CERTIFY THAT THIS PLAN WAS PREPARED BY ME OR UNDER MY
DIRECT SUPERVISION AND THAT I AM A DULY REGISTERED PROFESSIONAL
ENGINEER/ARCHITECT UNDER THE LAWS OF THE STATE OF MINNESOTA.
DATE: 5/30/90 REG. NO. 66610 Thomas W. Peterson




SURVEY HBR
DRAWN DFD
DESIGN TWP
APPROVED MLS

REVISIONS

BONESTROO, ROSENE, ANDERLIK & ASSOC., INC.
Engineers & Architects
St. Paul, Minnesota

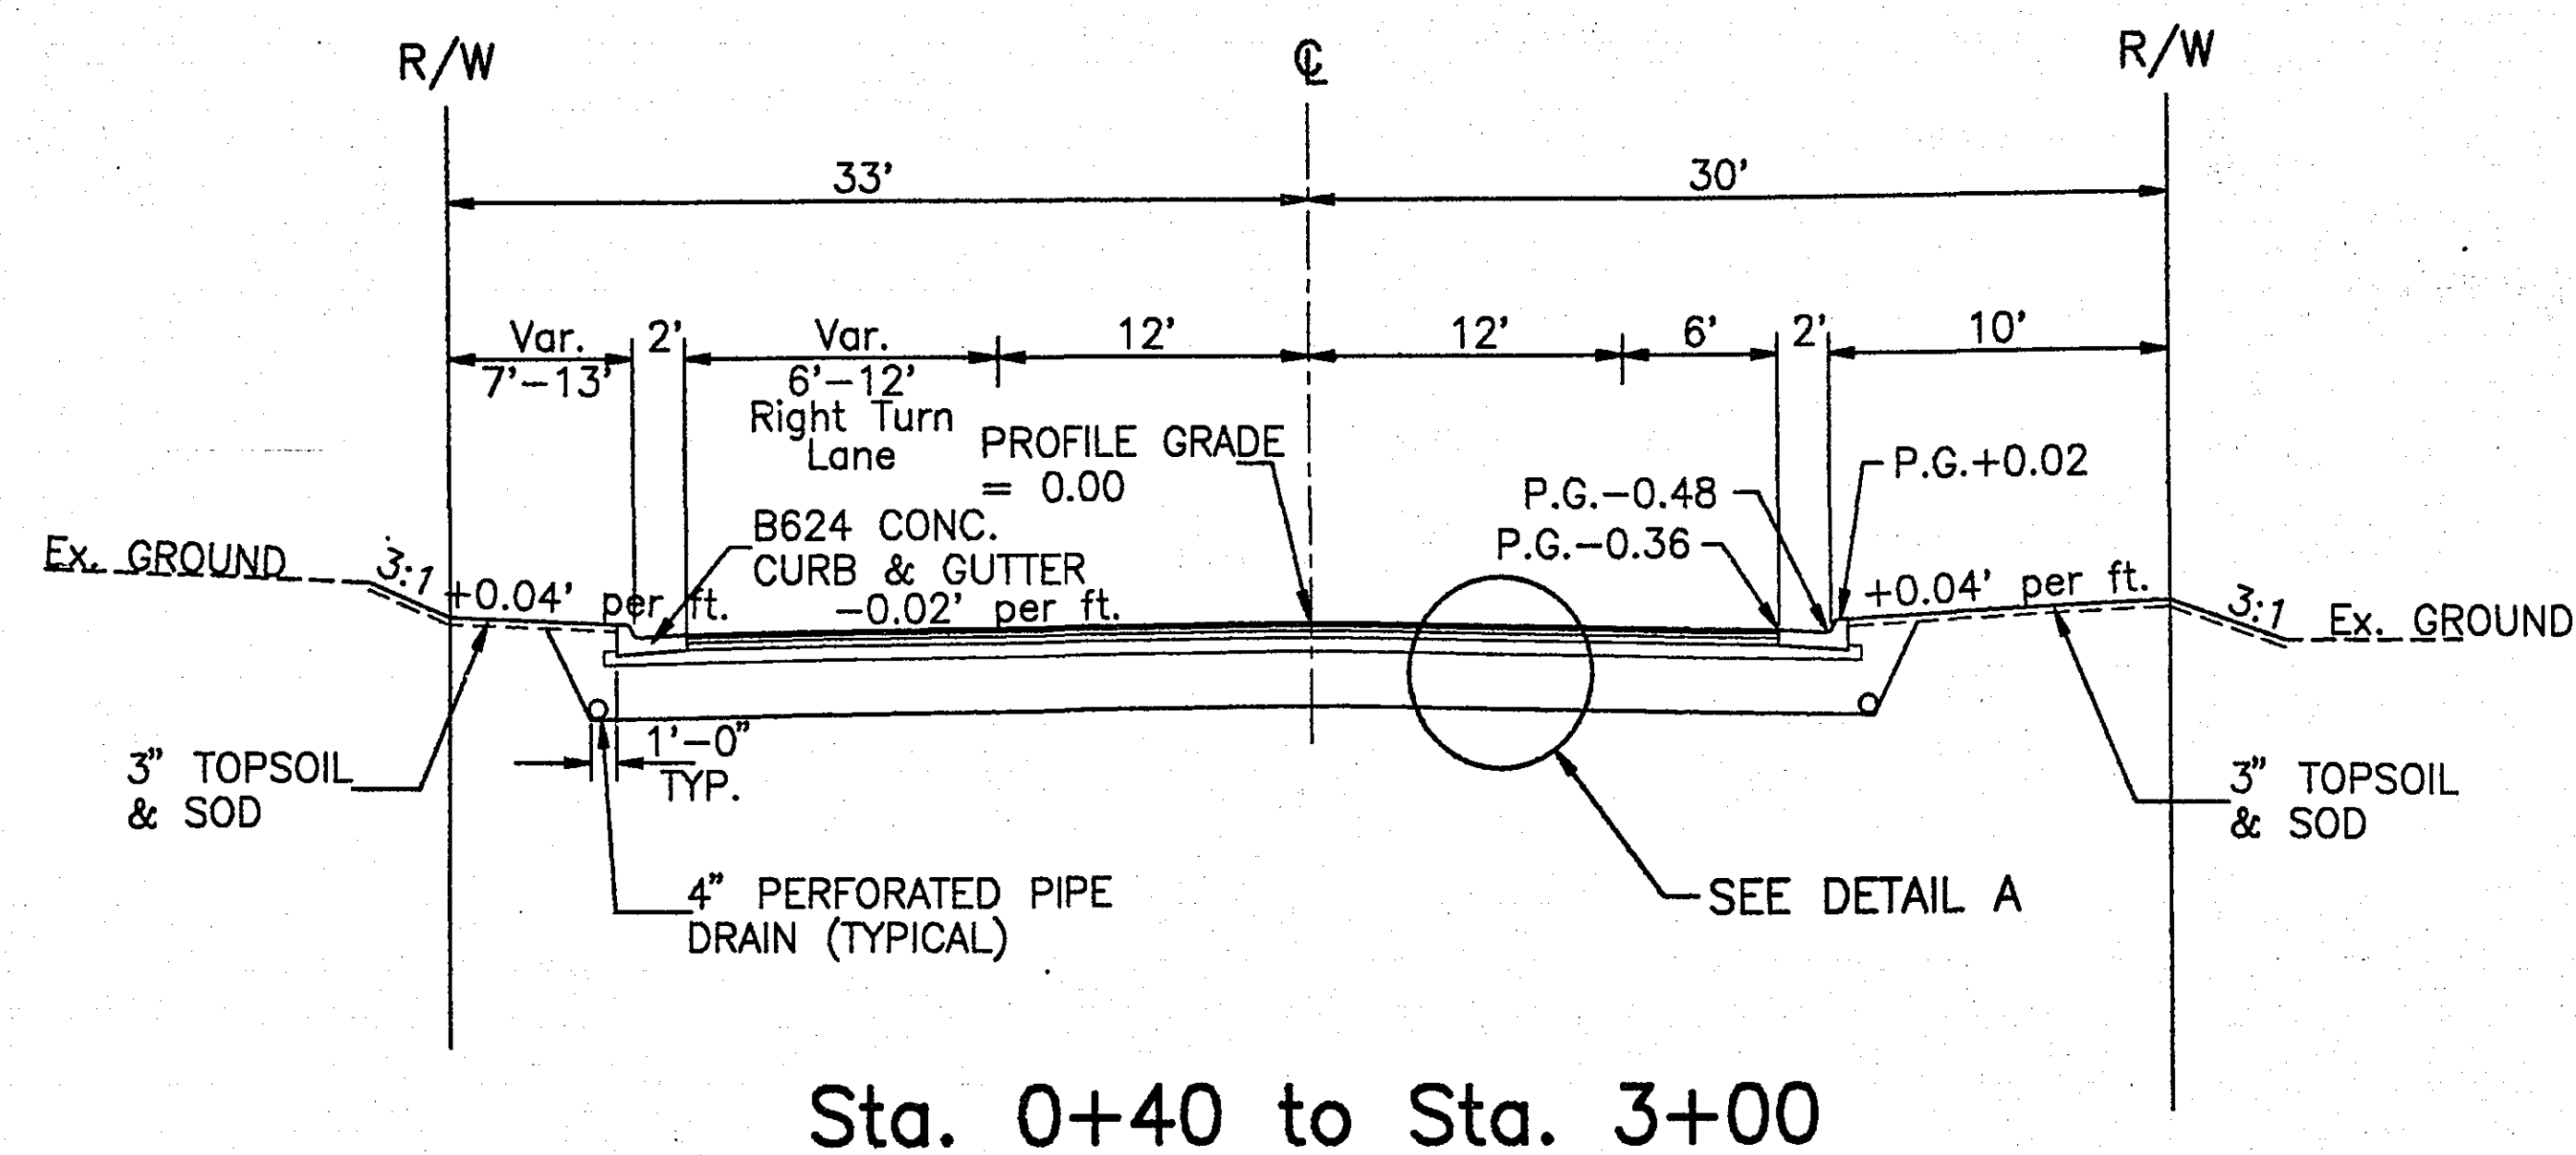


NOTE: 2' OBSTACLE FREE CLEAR ZONE
IS REQUIRED FROM FACE OF CURB.

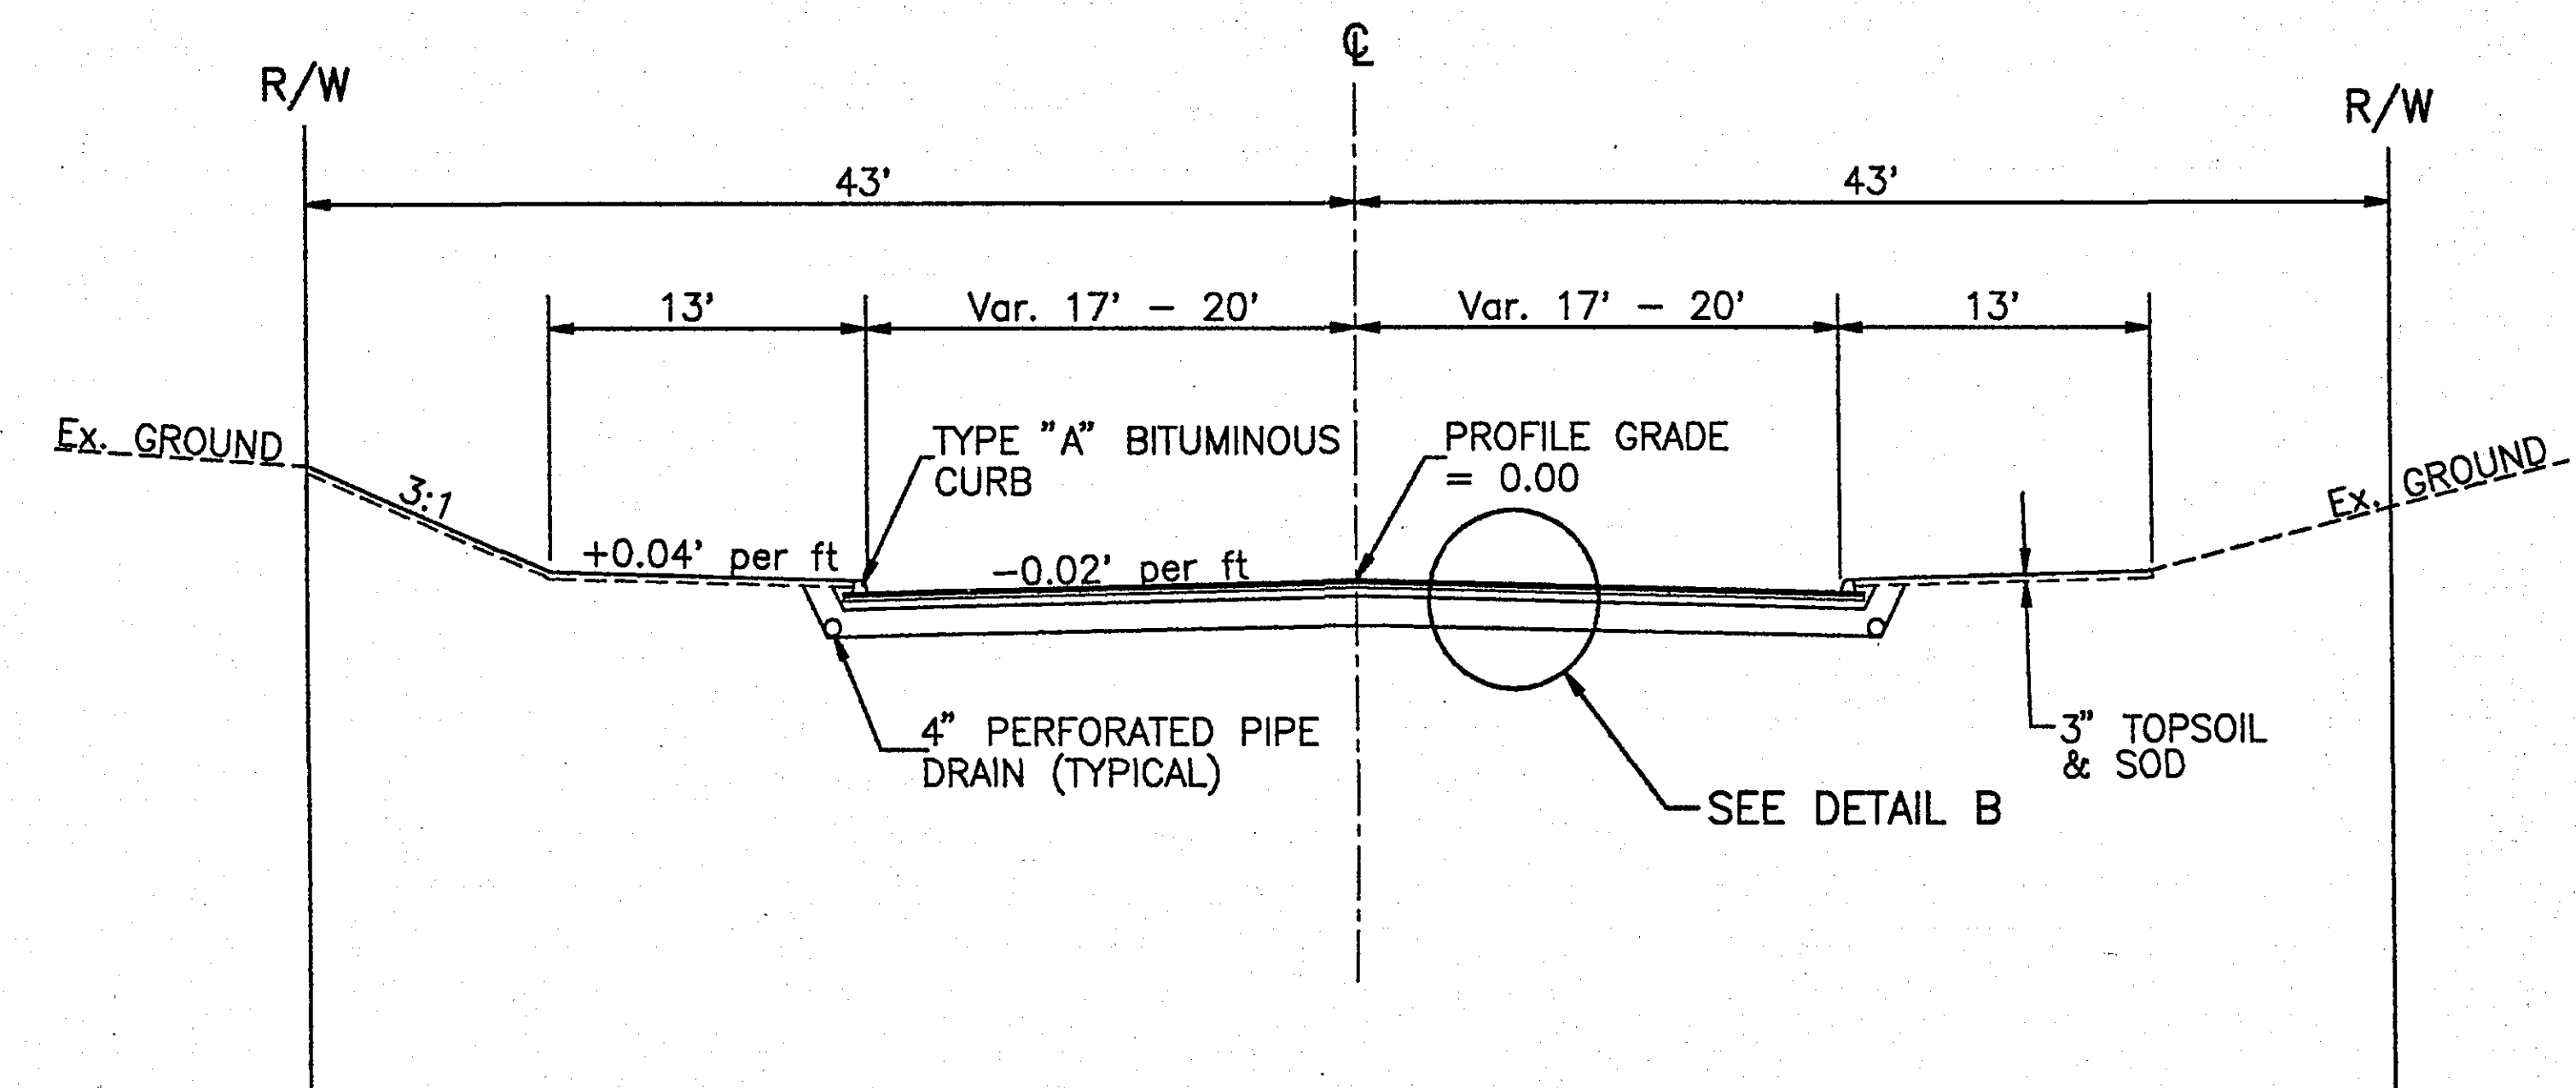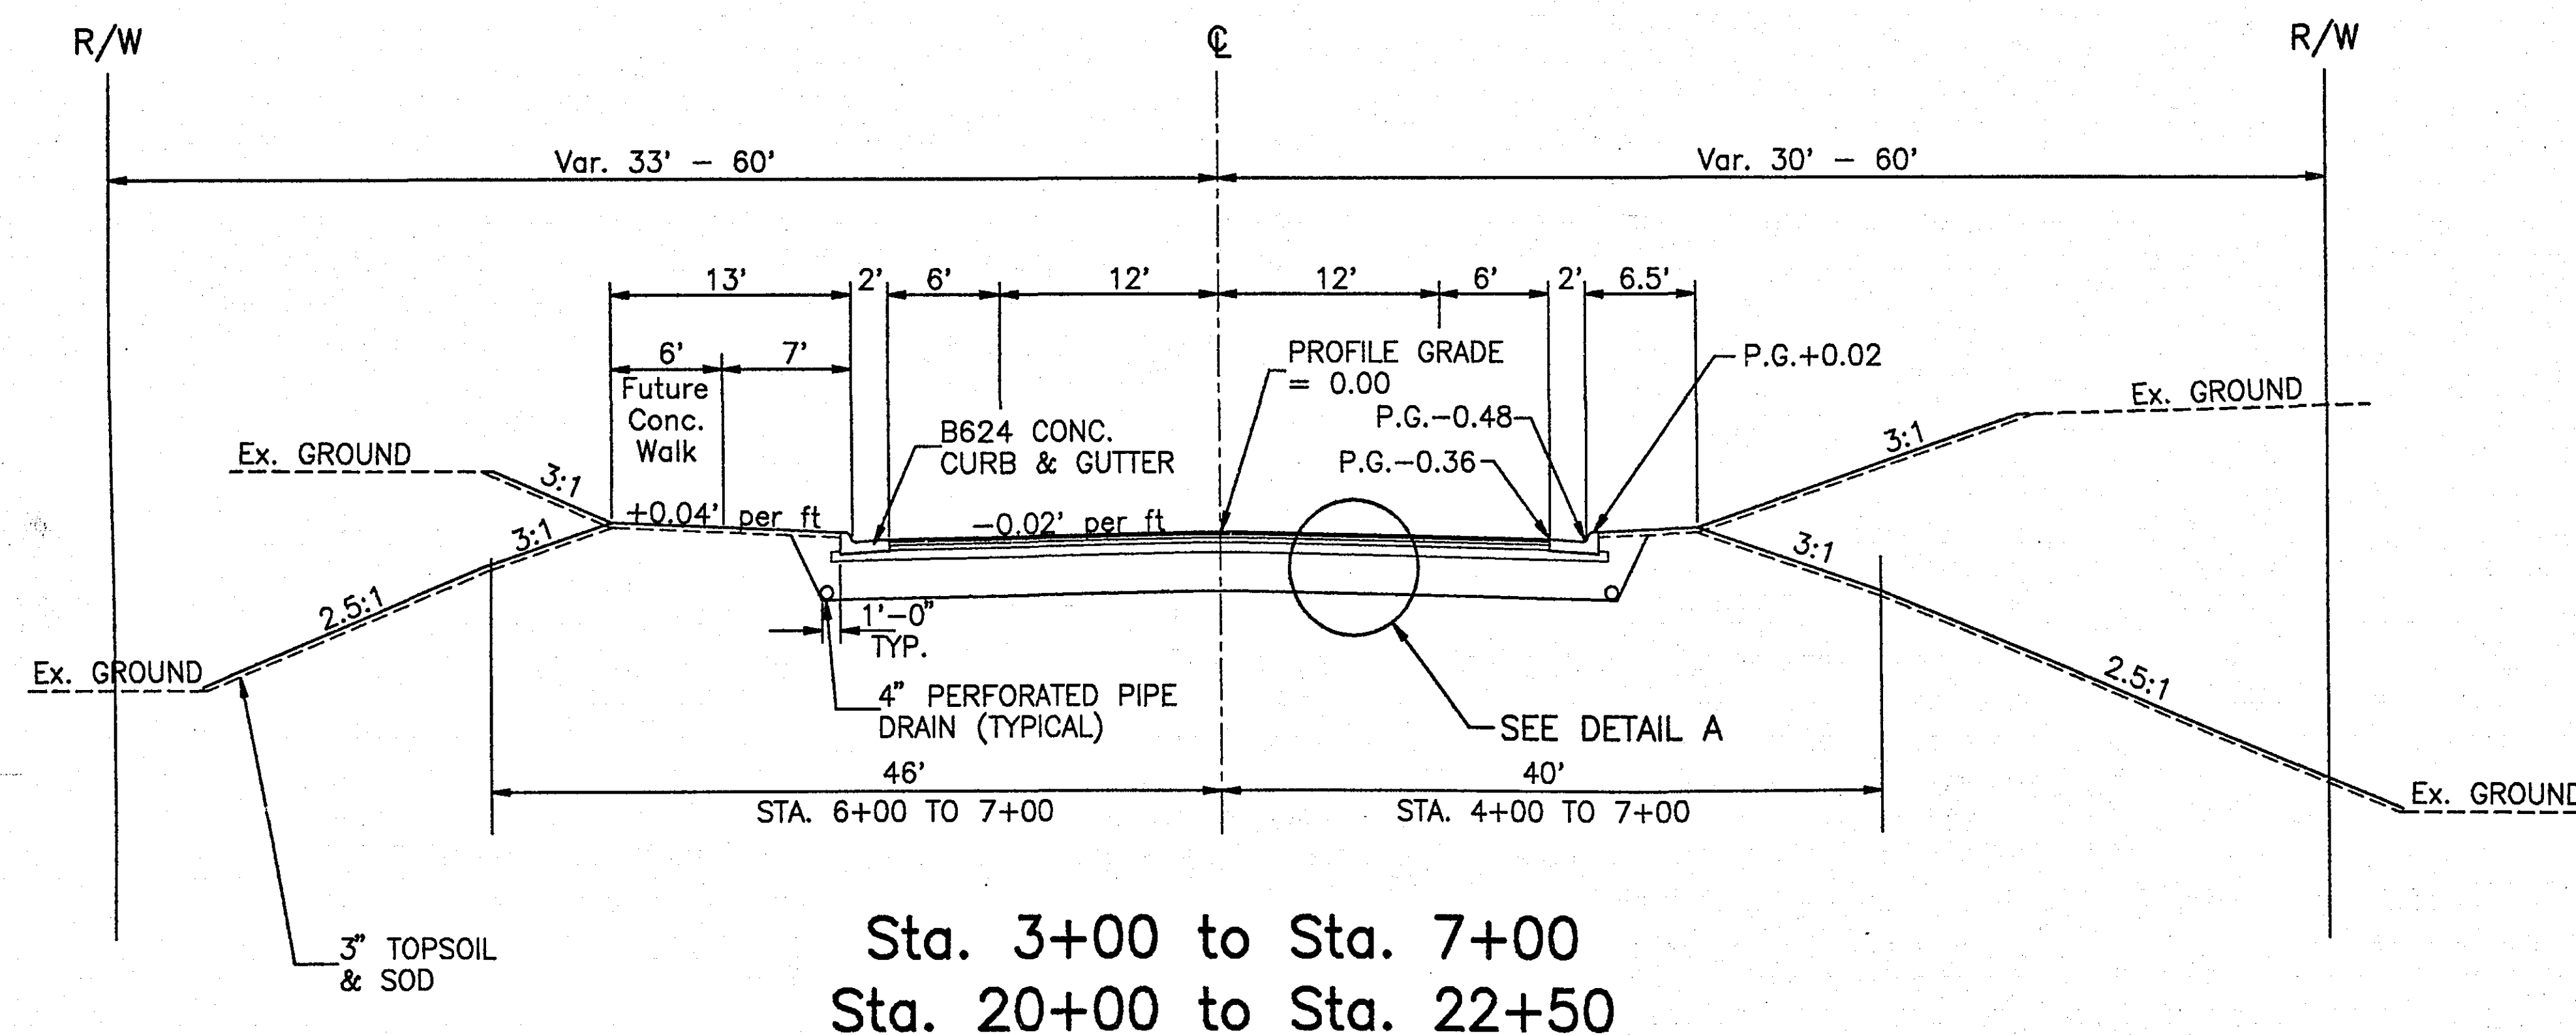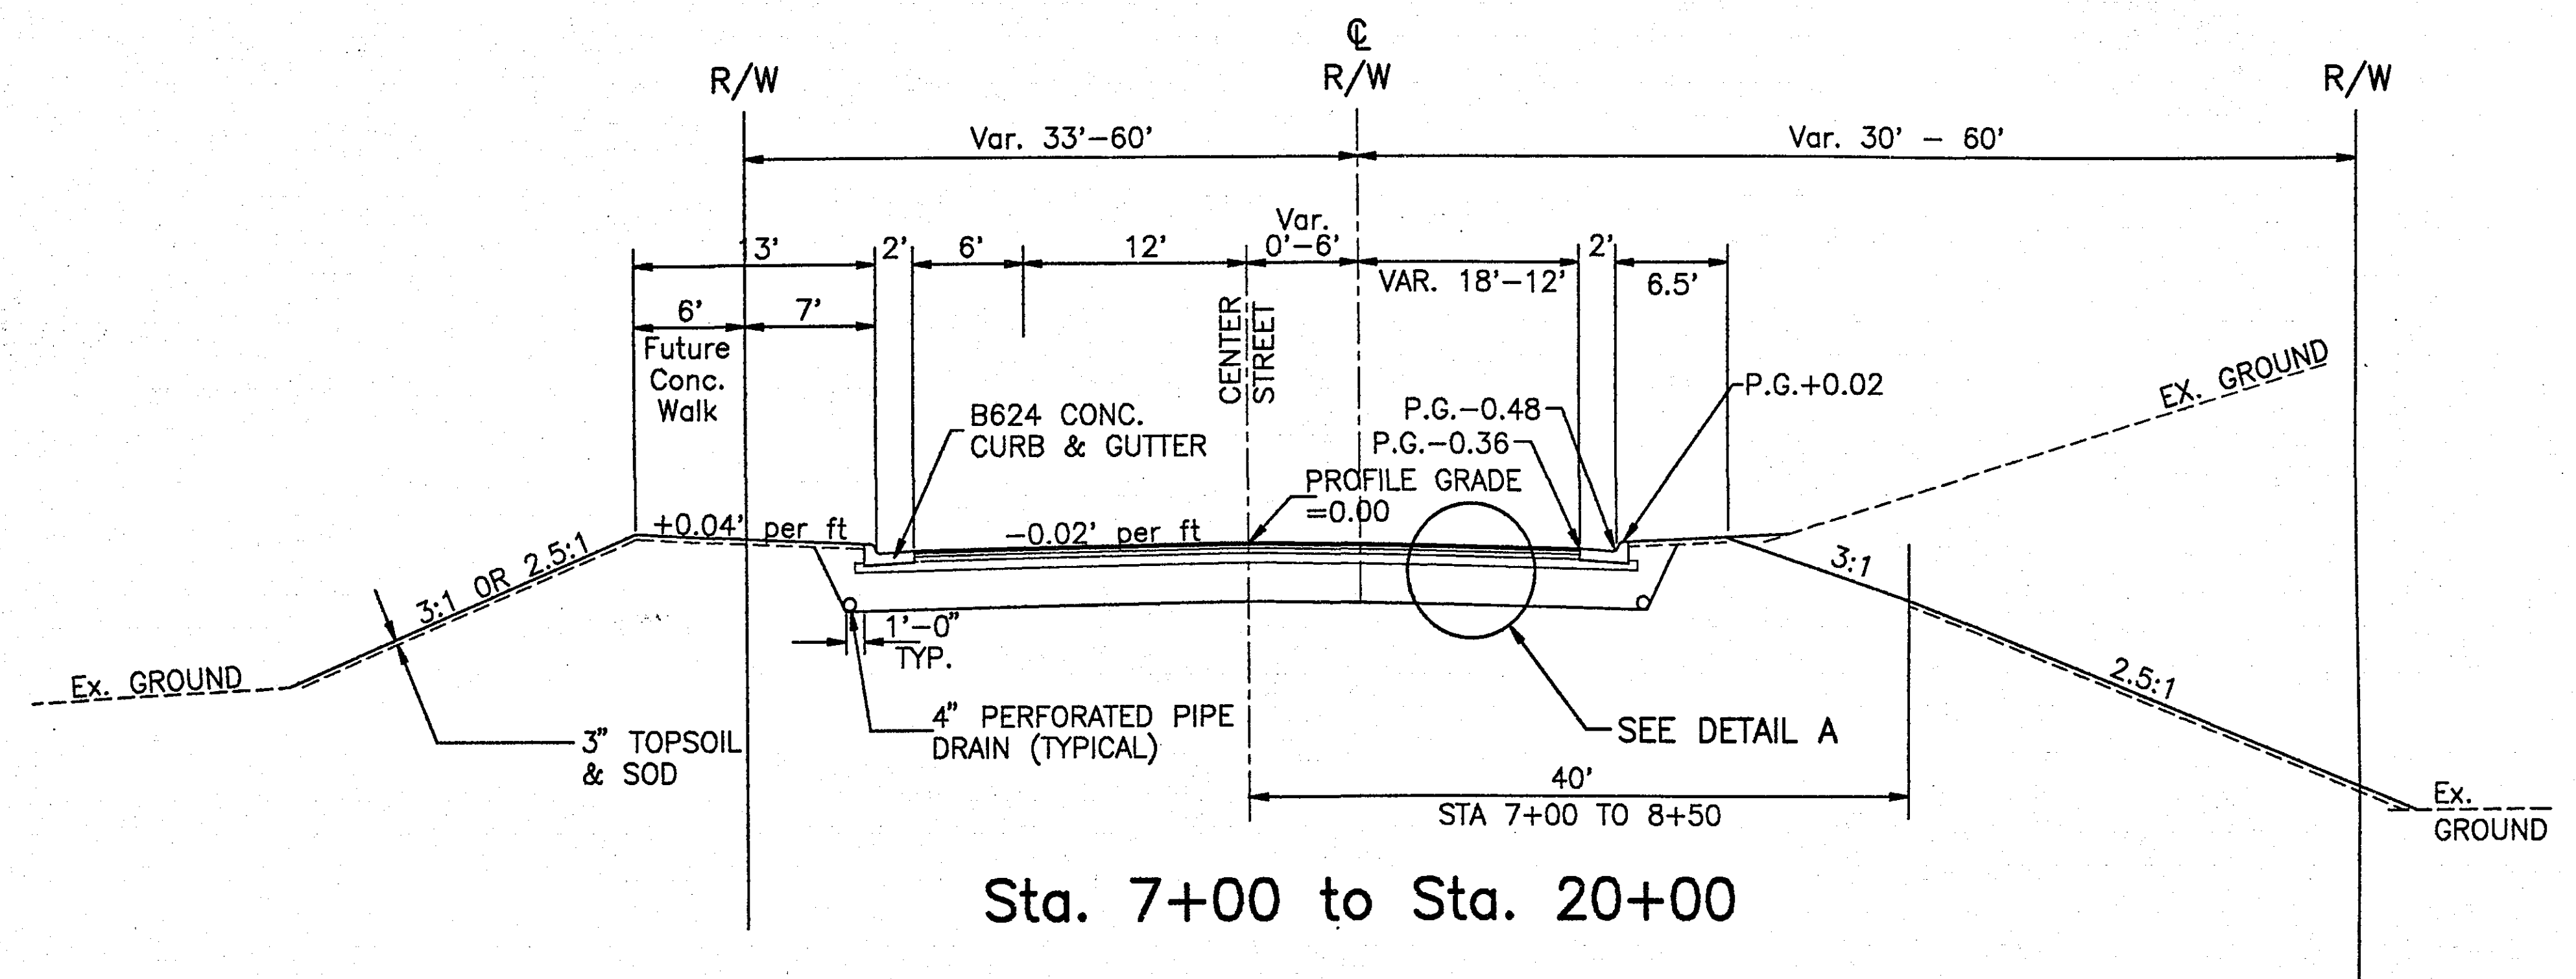


TYPICAL SECTIONS

Not to Scale

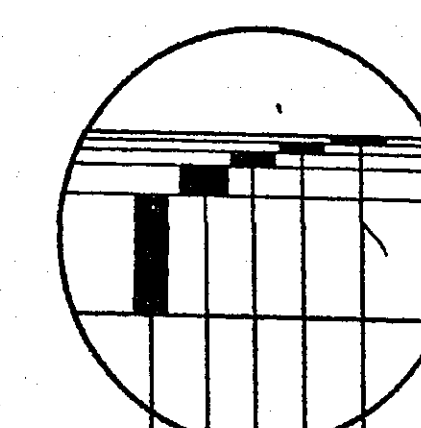

DETAIL A


- 1 1/2" PLANT MIXED BITUMINOUS WEARING COURSE SPEC. 2341 (FOLLOWING YEAR)
- 2" PLANT MIXED BITUMINOUS BINDER COURSE SPEC. 2331
- 3.5" PLANT MIXED BITUMINOUS BASE COURSE SPEC. 2331
- 6" AGGREGATE BASE, CL. 6
- 24" SUBGRADE CORRECTION (USE SELECT GRANULAR BORROW)

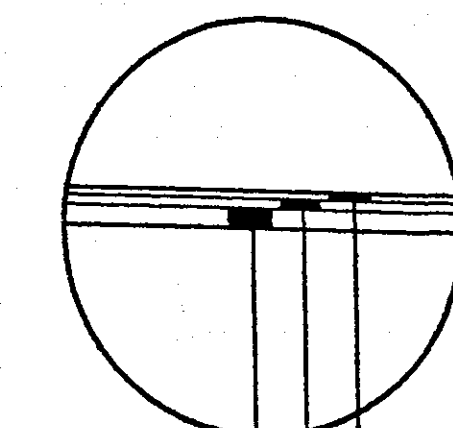

DETAIL B



- 1 1/2" PLANT MIXED BITUMINOUS WEARING COURSE SPEC. 2341 (FOLLOWING YEAR)
- 2" PLANT MIXED BITUMINOUS BASE COURSE SPEC. 2331
- 4" AGGREGATE BASE, CL. 6

RIPRAP & GRANULAR FILTER DETAIL

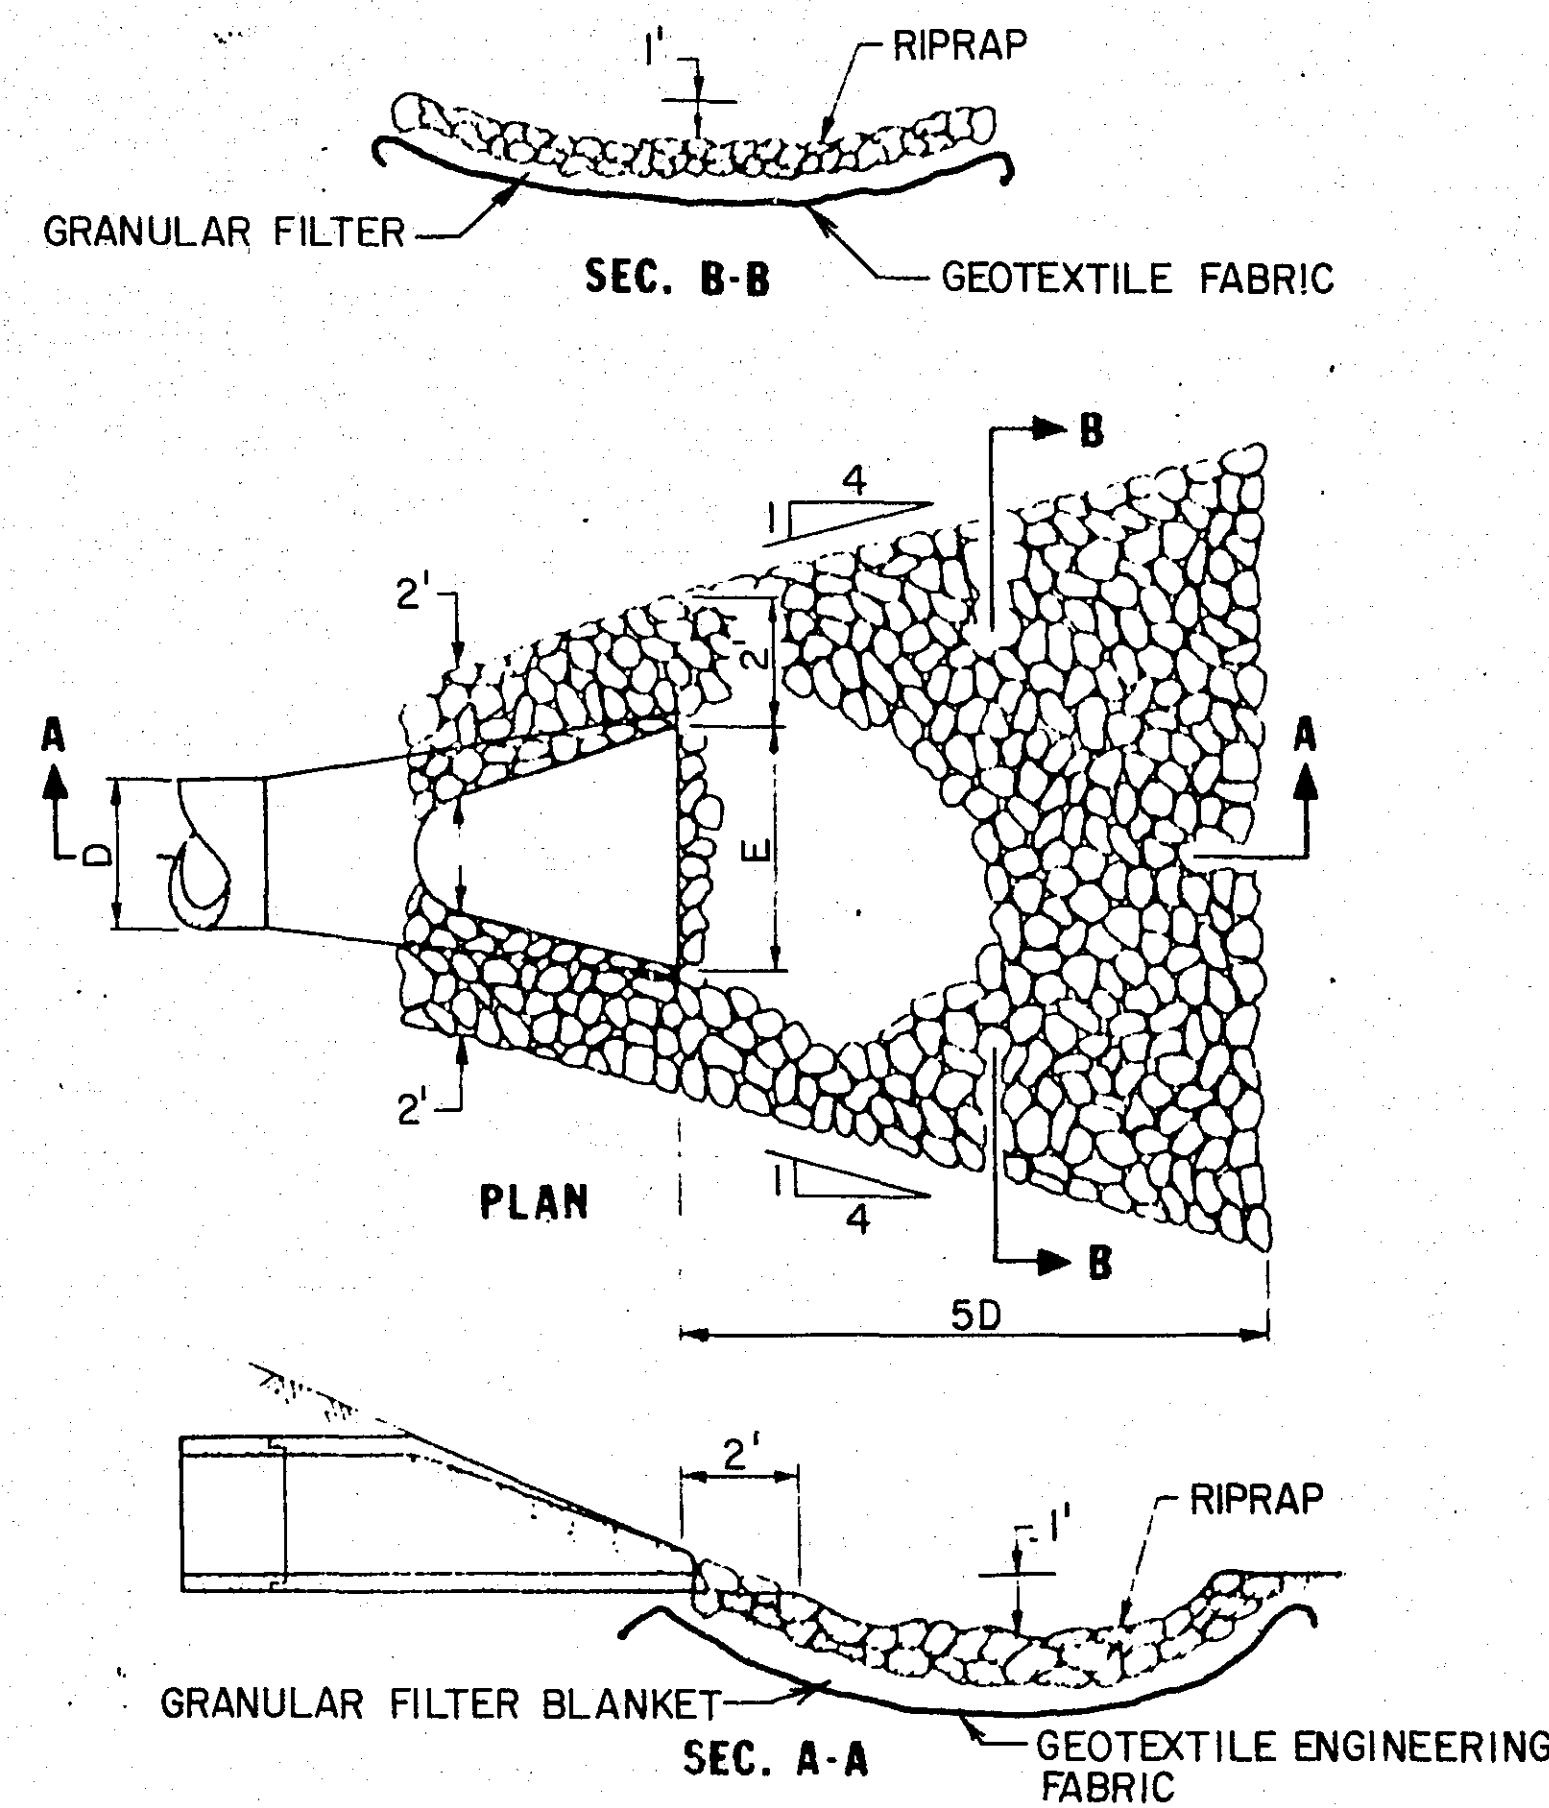

NOTE: INCLUDE PRICE OF GEOTEXTILE FABRIC IN OTHER ITEMS.
NO SEAMS WILL BE PERMITTED.
GEOTEXTILE FILTER MATERIAL SHALL BE FURNISHED &
INSTALLED PER SPEC. 2511.515 & 3733 FOR TYPE III
GEOTEXTILES.
TABLE OF MATERIAL QUANTITIES FOR APRONS AT R.C.P.
OUTLETS (?)

CURB OPENING CATCH BASIN - DESIGN LP INSTALLATION DETAIL

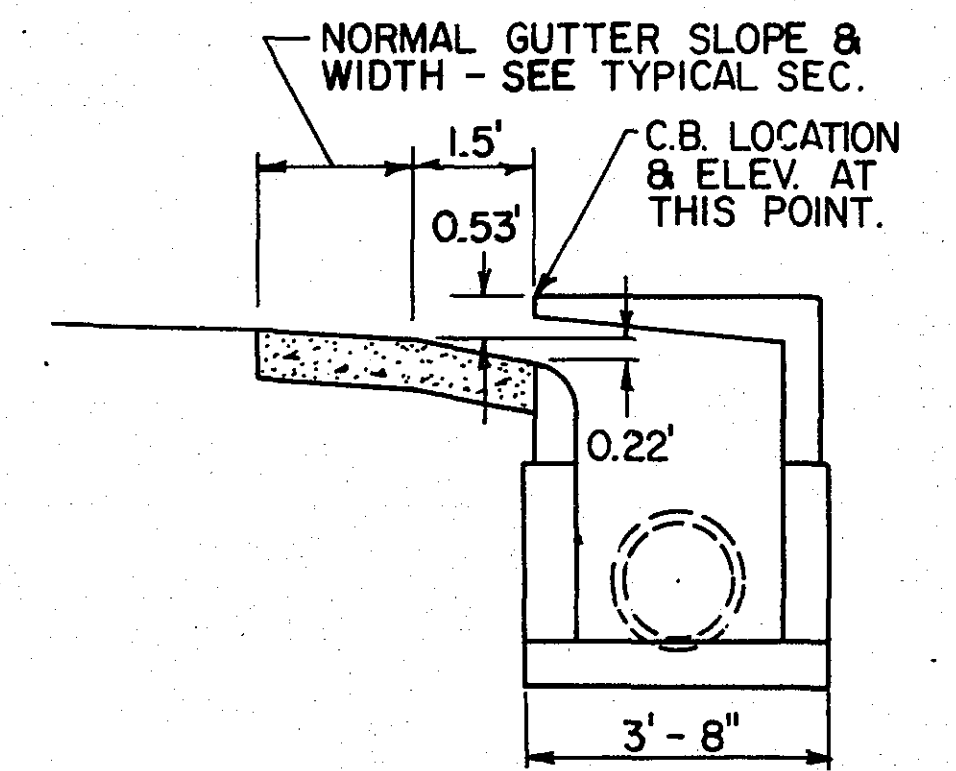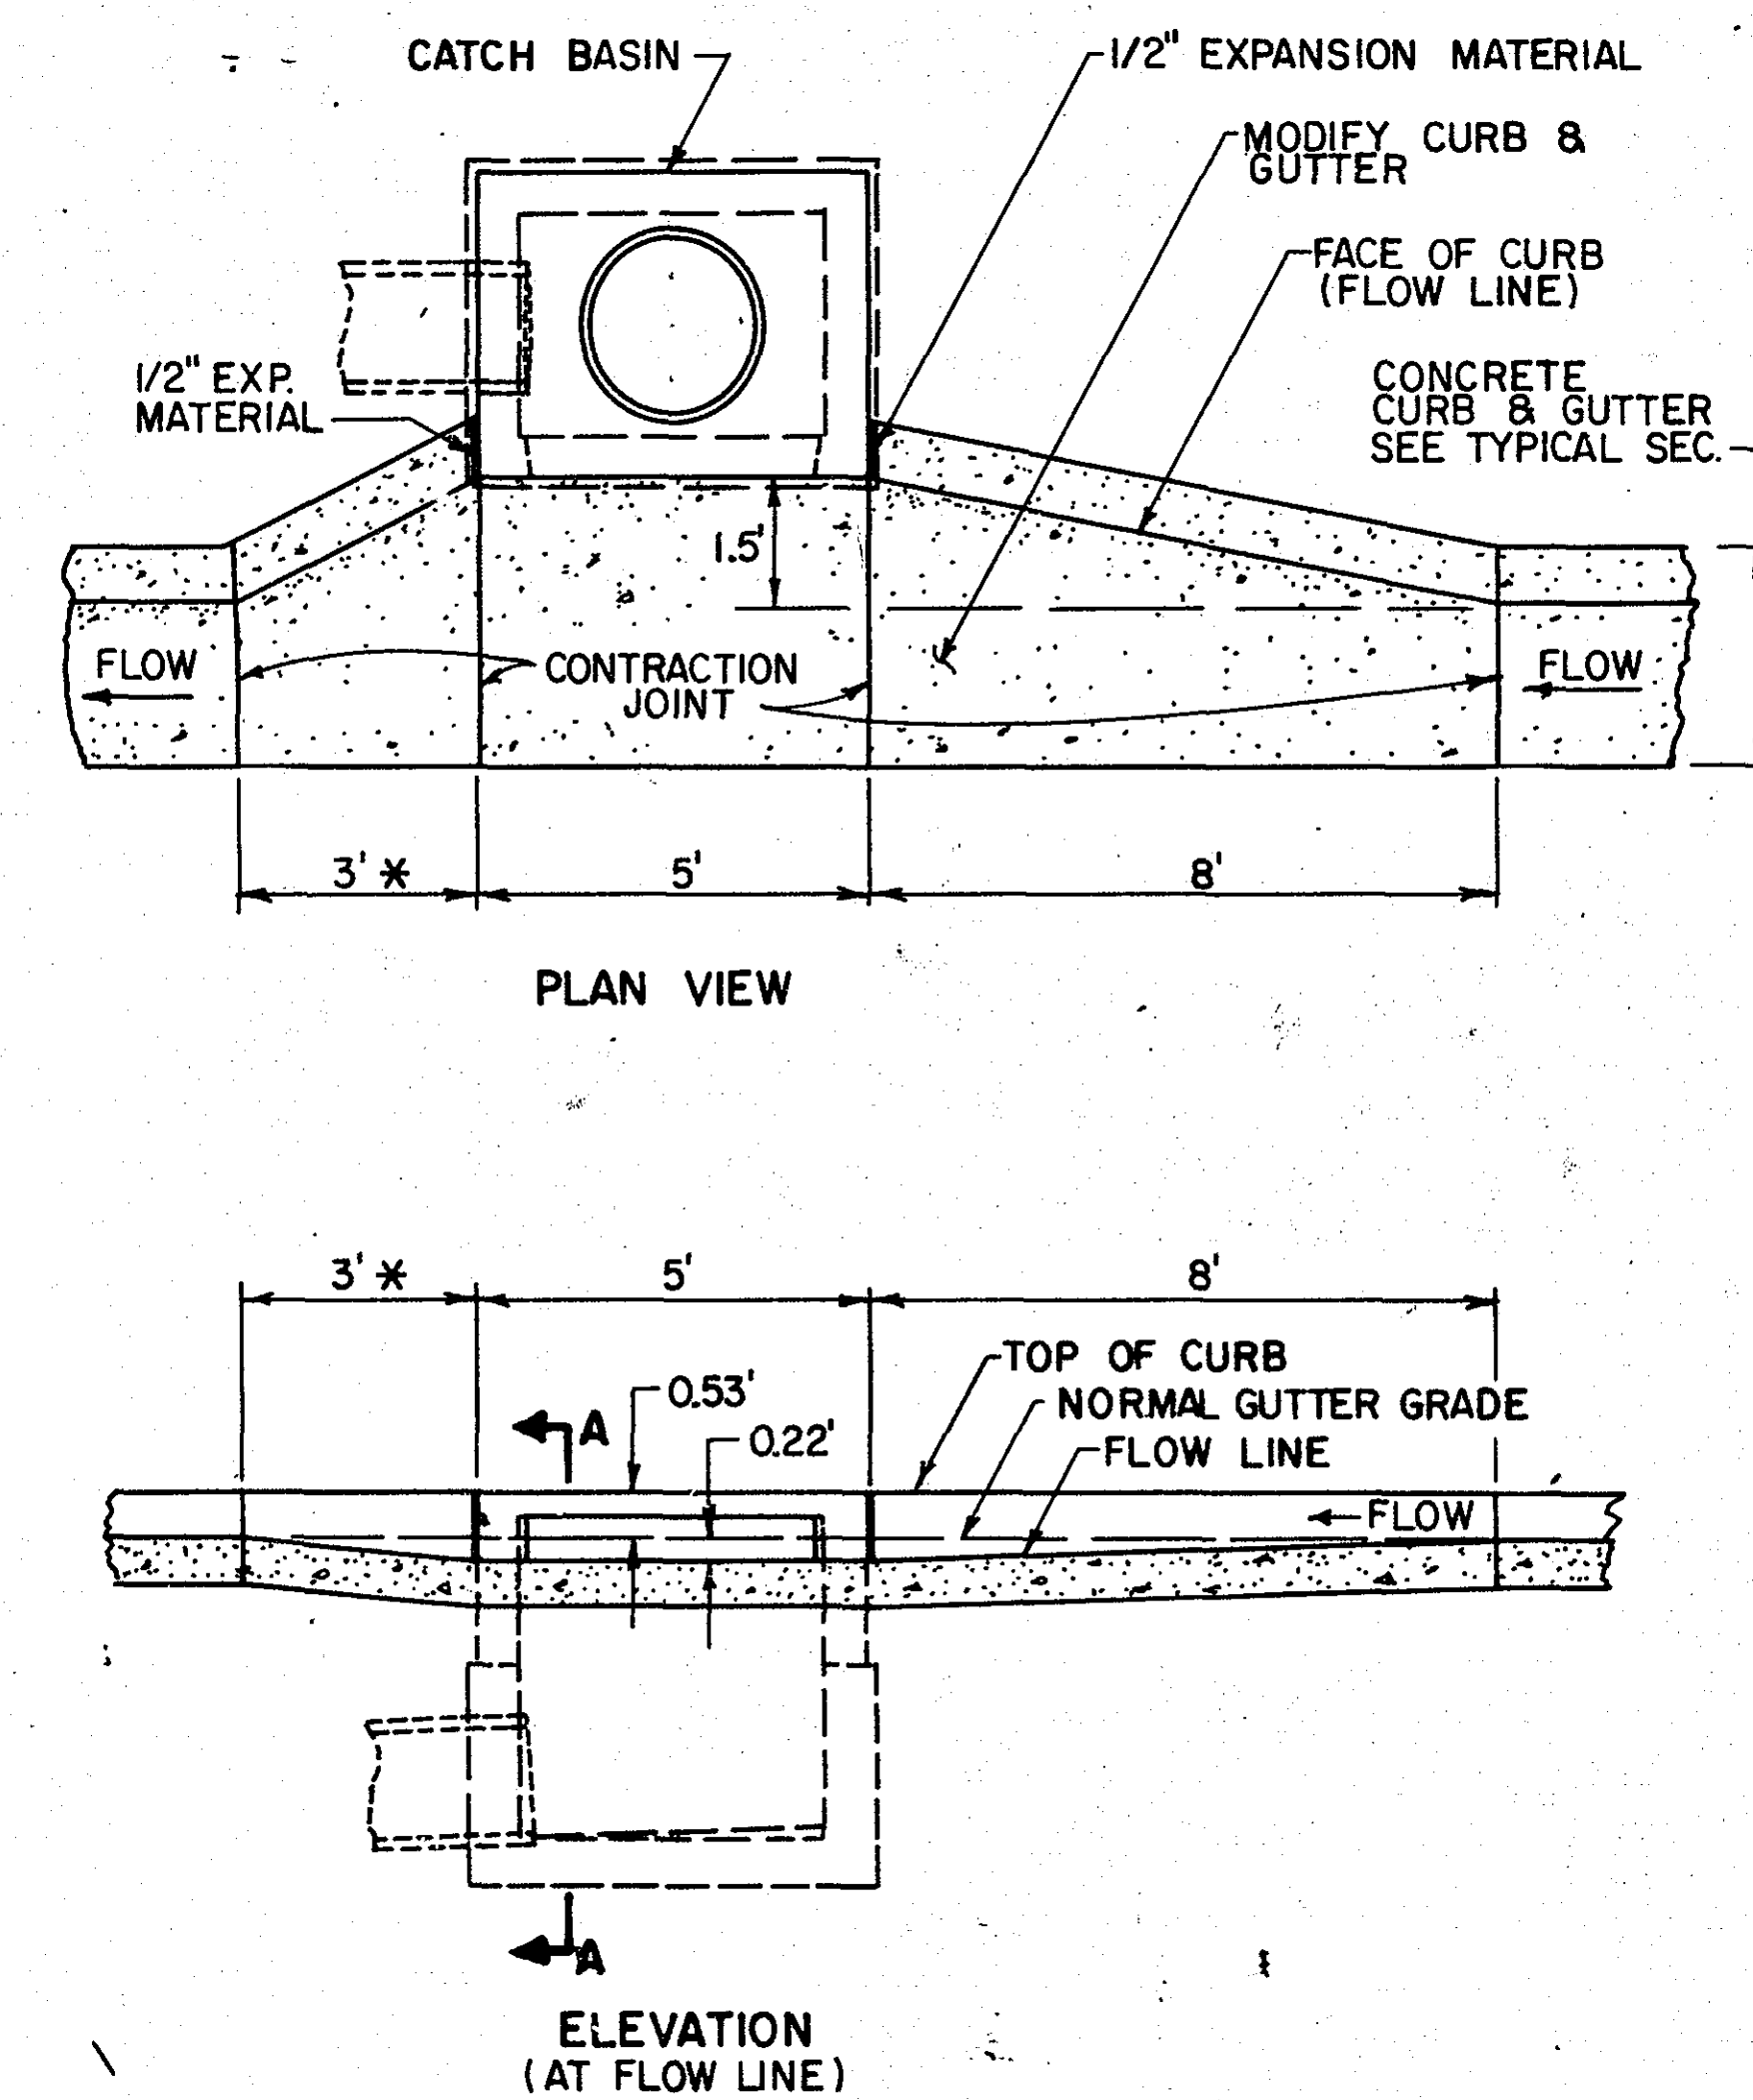

SECTION A-A




NOTES:

- * DIMENSION SHALL BE 8' WHEN
STRUCTURE INSTALLED AT LOW
POINT IN GRADE
- CATCH BASIN - DESIGN LP - SEE
MN/DOT STD. PL. NO. 4021C.
- TOP OF CATCH BASIN SHALL BE
INSTALLED AT SAME SLOPE AS BLVD.
GRADES AND TOP OF CURB GRADE
EACH SIDE OF STRUCTURE.
- ELEVATION OF STRUCTURE IS COM-
PUTED AT LOCATION SHOWN IN SEC.
A-A AT C. OF C.B. OPENING.


CASTING ASSEMBLY (FOR DESIGN SPECIAL 2 CATCH BASIN)

NOTES:


- MATERIALS: CAST GRAY
IRON, CLASS 30, MN/DOT
SPEC. REFERENCE 3321
- CURB BOX HEIGHT SHALL
BE ADJUSTABLE 6" TO 9"
- SEE CATCH BASIN-DESIGN
SPECIAL 2 DETAIL FOR CASTING
INSTALLATION DETAIL.

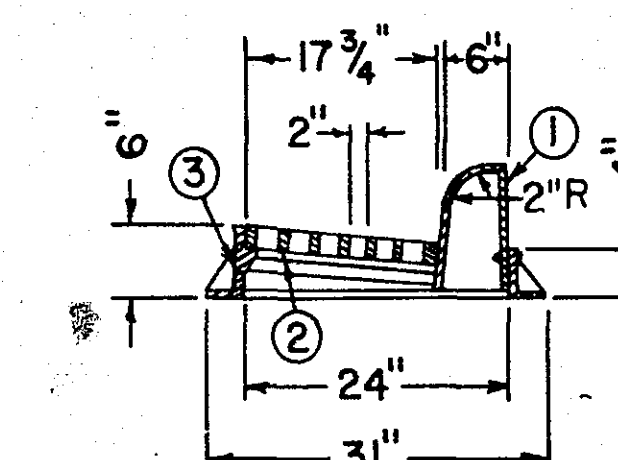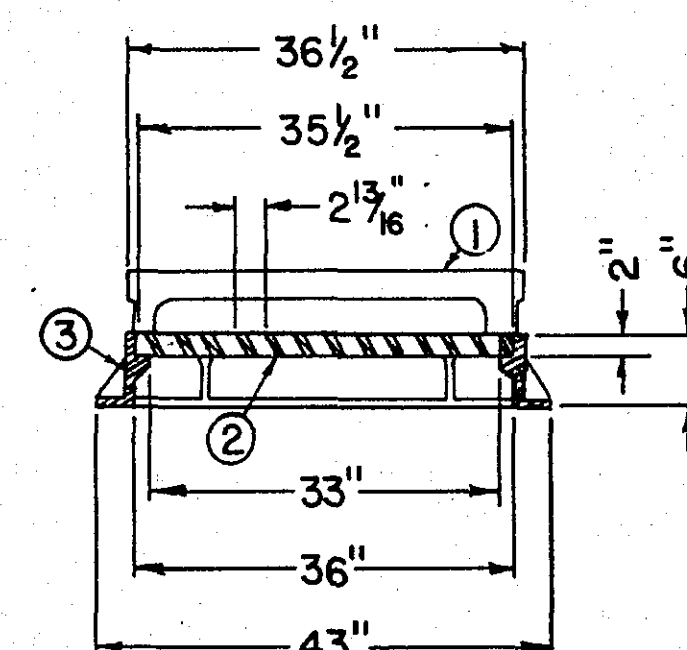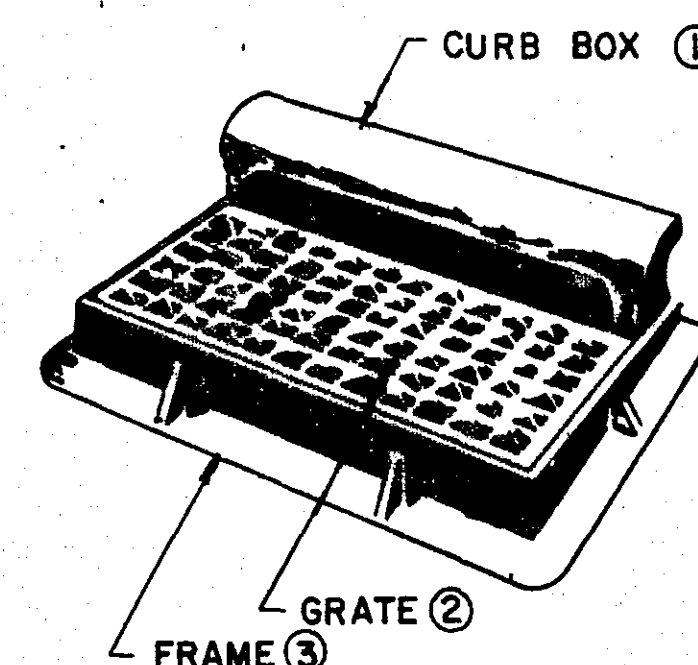


CATCH BASIN - DESIGN SPECIAL 2

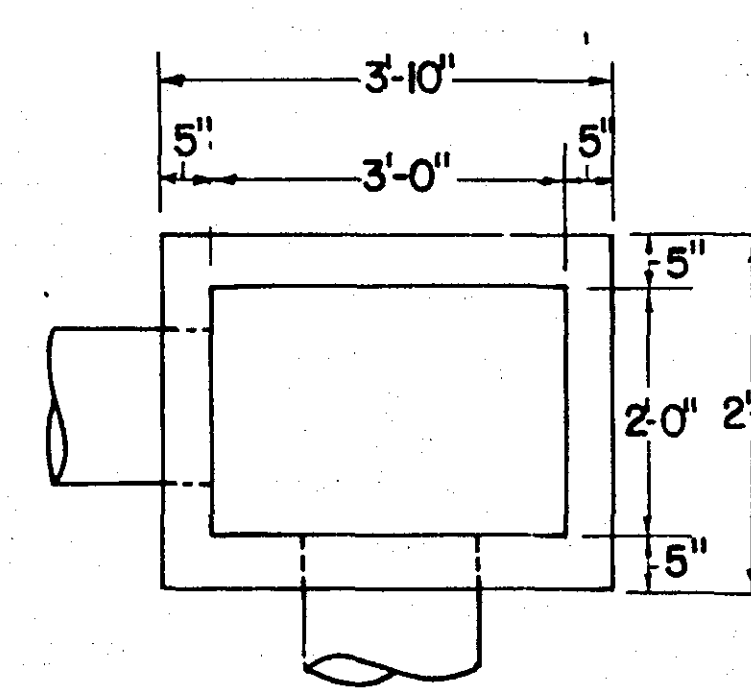


CATCH BASIN PLAN

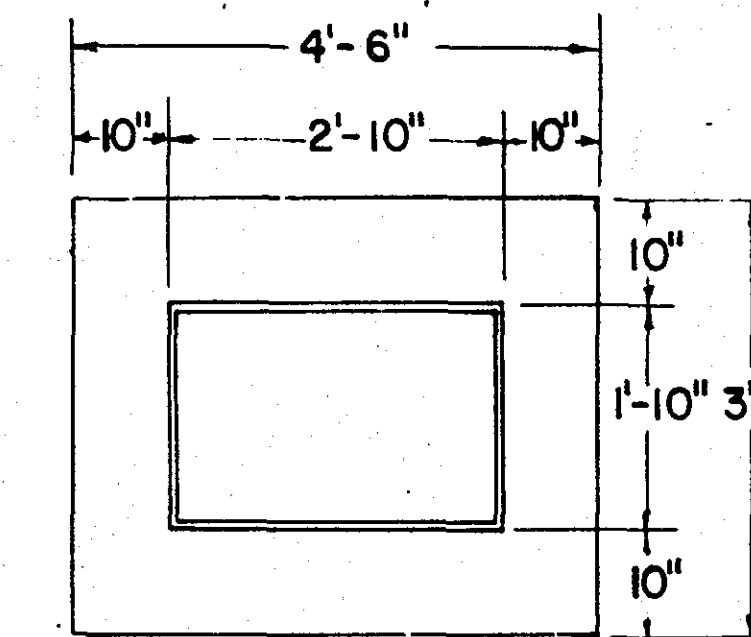

BASE SLAB PLAN


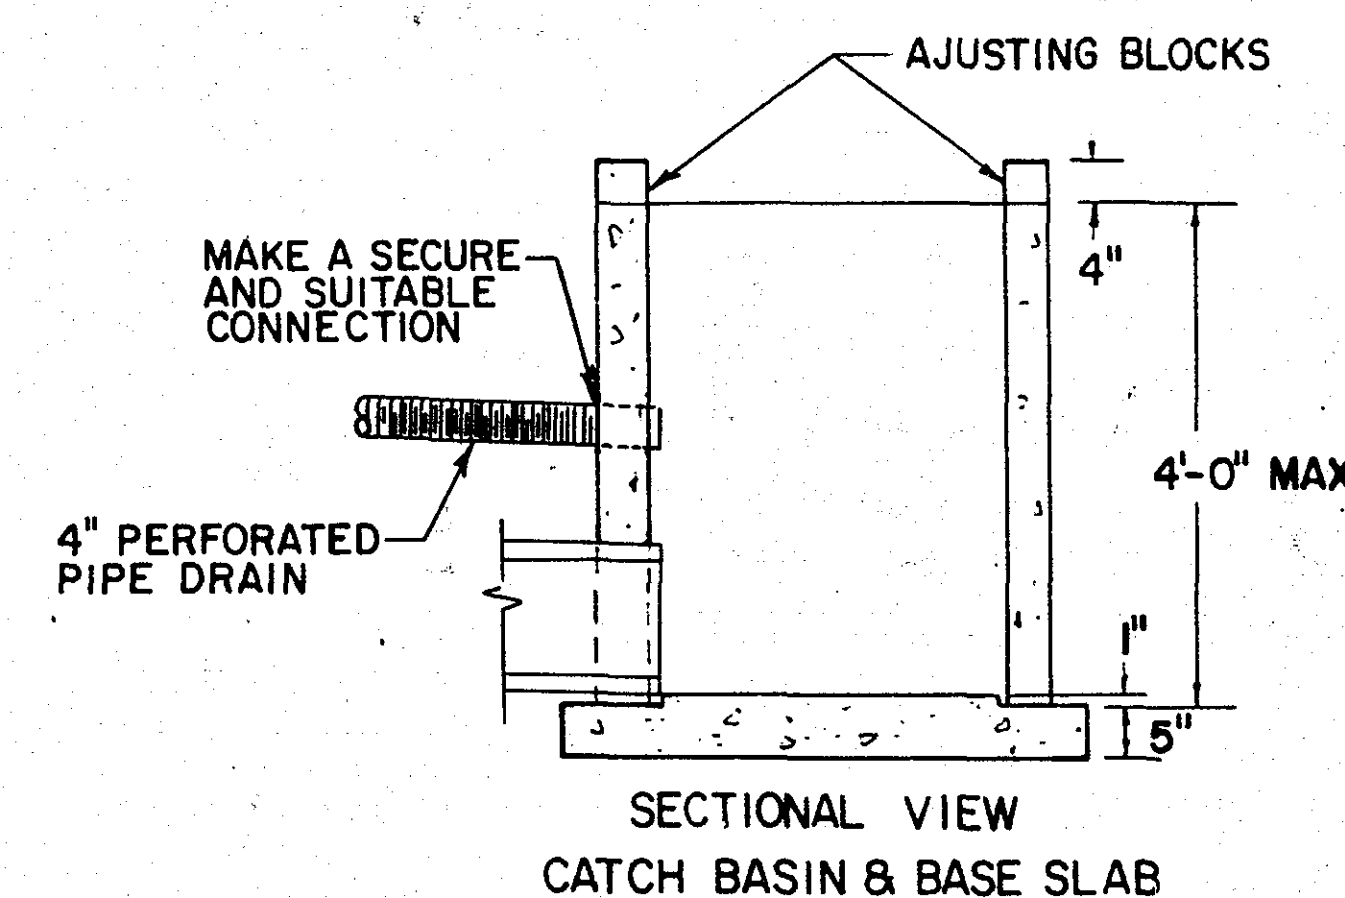


SECTIONAL VIEW
CATCH BASIN & BASE SLAB

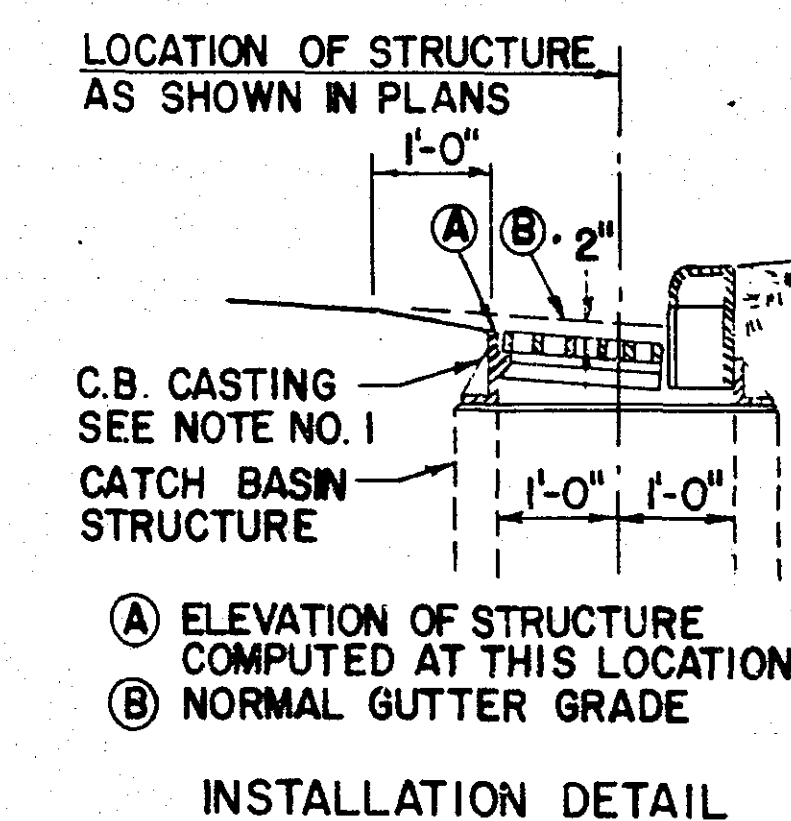

INSTALLATION DETAIL

- TO BE USED WITH NEENAH R-3067-L
OR EQUAL.
- PIPE CUT-OUTS TO BE LOCATED WHERE
REQUIRED.
- ALTERNATE CAST-IN-PLACE BASE SLAB
CAN BE USED.
- INSTALL AS PER MN/DOT STANDARD PLATE
NO. 7111E.
- REINFORCING: SINGLE LINE STEEL WIRE
FABRIC.
WALL = W3.5 X W3.0 HAVING AN AREA OF
NOT LESS THAN .21 SQ. IN. PER FOOT
OF HEIGHT.
BASE = W4.0 X W4.0 HAVING AN AREA OF
NOT LESS THAN .16 SQ. IN. PER FOOT
OF HEIGHT.
- ALTERNATE CONSTRUCTION - THE CATCH
BASIN MAY BE CONSTRUCTED OF BLOCKS
OR BRICKS CONFORMING TO THE REQUIRE-
MENTS OF MN/DOT SPEC. 2506 AND AS
DIRECTED BY THE ENGINEER.

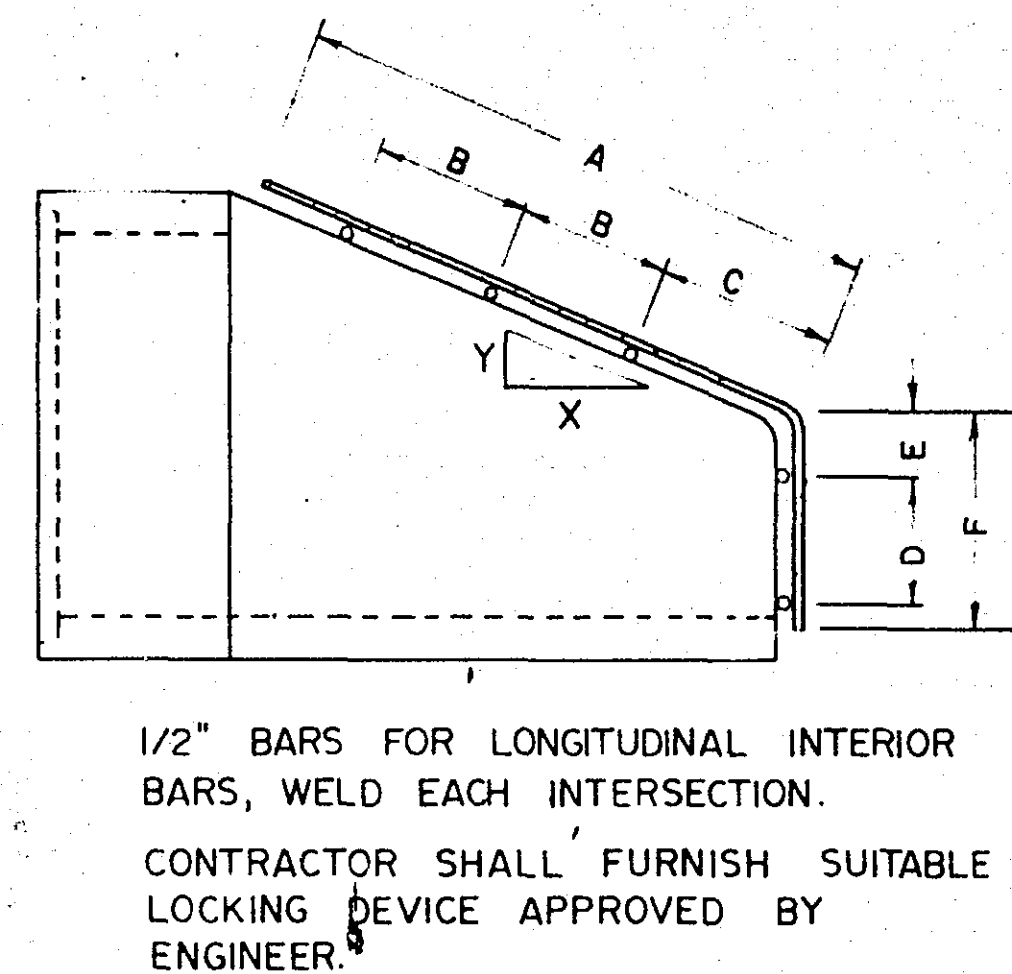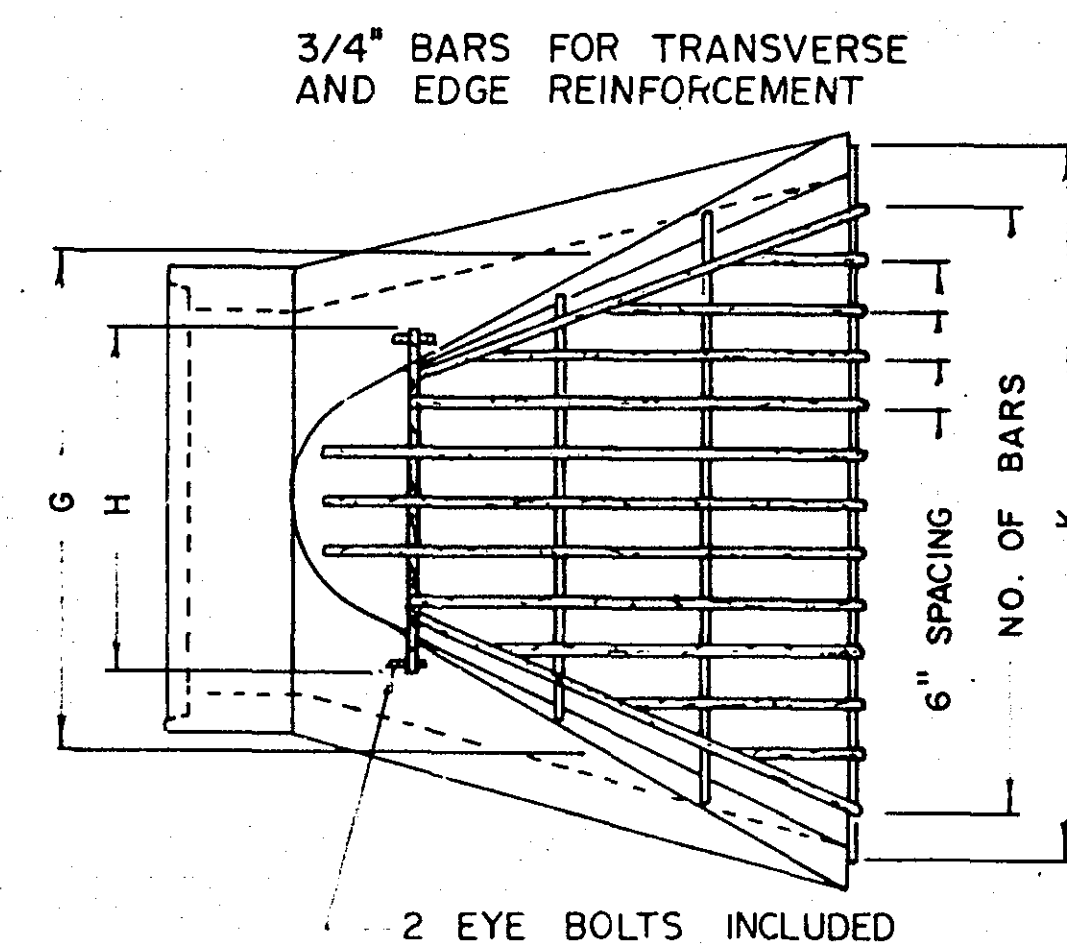

SIZE	NO. OF BARS	SLOPE	A	R	C	D	E	F	G	H	K
12"	5	3 to 1	24	10	10	5	2	8	24		30
15"	6	"	24	10	10	6	2	10	26		34
18"	7	"	24	10	10	7	3	12	28		40
21"	8	"	36	16	16	7	3	12	34		50
24"	9	"	44	20	20	10	4	16	36		52
27"	10	"	50	23	23	10	4	16	38		58
30"	11	"	56	26	26	12	4	18	42		64
36"	13	"	64	32	32	12	4	18	48		76
42"	15	"	68	32	32	16	8	26	60		88
48"	16	"	76	36	36	14	10	28	62		92
54"	17	2.4 to 1	76	36	36	16	12	32	68		96

TRASH GUARD (GALVANIZED)
(FOR CONCRETE APRON)

1 ENTRANCE WIDTHS
RESIDENTIAL - 12' MIN.
22' MAX.
COMMERCIAL - 32' MAX. AT 90°
26' MAX. AT 60°

2 1/2" EXPANSION JOINT

3 PLACE JOINTS AS REQUIRED
FOR CONCRETE CONST.

4 FUTURE 6" SIDEWALK

ENTRANCE
END ENTRANCE
PROPERTY LINE OR
AS SHOWN IN PLANS

ENTRANCE
WIDTH

60° to 90°

CONCRETE
CURB & GUTTER

GUTTER TO BE PAVED
INTEGRAL WITH ENT
PAVEMENT

0.30' MIN.
0.08' GUTTER LINE

VARIES
3' MIN.

6" CONCRETE DRIVEWAY PAVEMENT
(THICKNESS SAME THROUGH WALK)

6" AGGREGATE BASE, CLASS 5

5 - 10% DESIRABLE, 15% MAX. DIFFERENCE
CONSTRUCT SAME AS ADJ. GUTTER SEC


TOPSOIL AND
SOD
(SEE TYP SEC.)

BITUMINOUS ENTRANCE DETAIL


-
- ① ENTRANCE WIDTHS
RESIDENTIAL 12' MIN.
22' MAX.
COMMERCIAL 32' MAX. AT 90°
26' MAX. AT 60°
- ② 1/2" EXPANSION JOINT
- ③ PLACE JOINTS AS REQUIRED FOR CONC CURB & GUTTER
- 45°
- ENTRANCE WIDTH ①
- END ENTRANCE AT PROPERTY LINE OR AS SHOWN IN PLAN
- TOPSOIL AND SOD (SEE TYPICAL SEC.)
- CONCRETE CURB & GUTTER
- 2" PLANT-MIXED BIT. SPEC. 2331 WEAR
2" PLANT-MIXED BIT. SPEC. 2331 BINDER
- 6" AGGREGATE BASE, CLASS 5
- 5-10% DESIRABLE 15% MAX. DIFFERENCE
- 0.30' MIN.
0.08' FACE OF CURB
VARIES
3' MIN.
- CONC. CURB & GUTTER
- 3' TAPER
15' MAX COMMERCIAL

TYPICAL SECTION
KEYSTONE RETAINING WALL


SCALE $3/8" = 1'-0"$

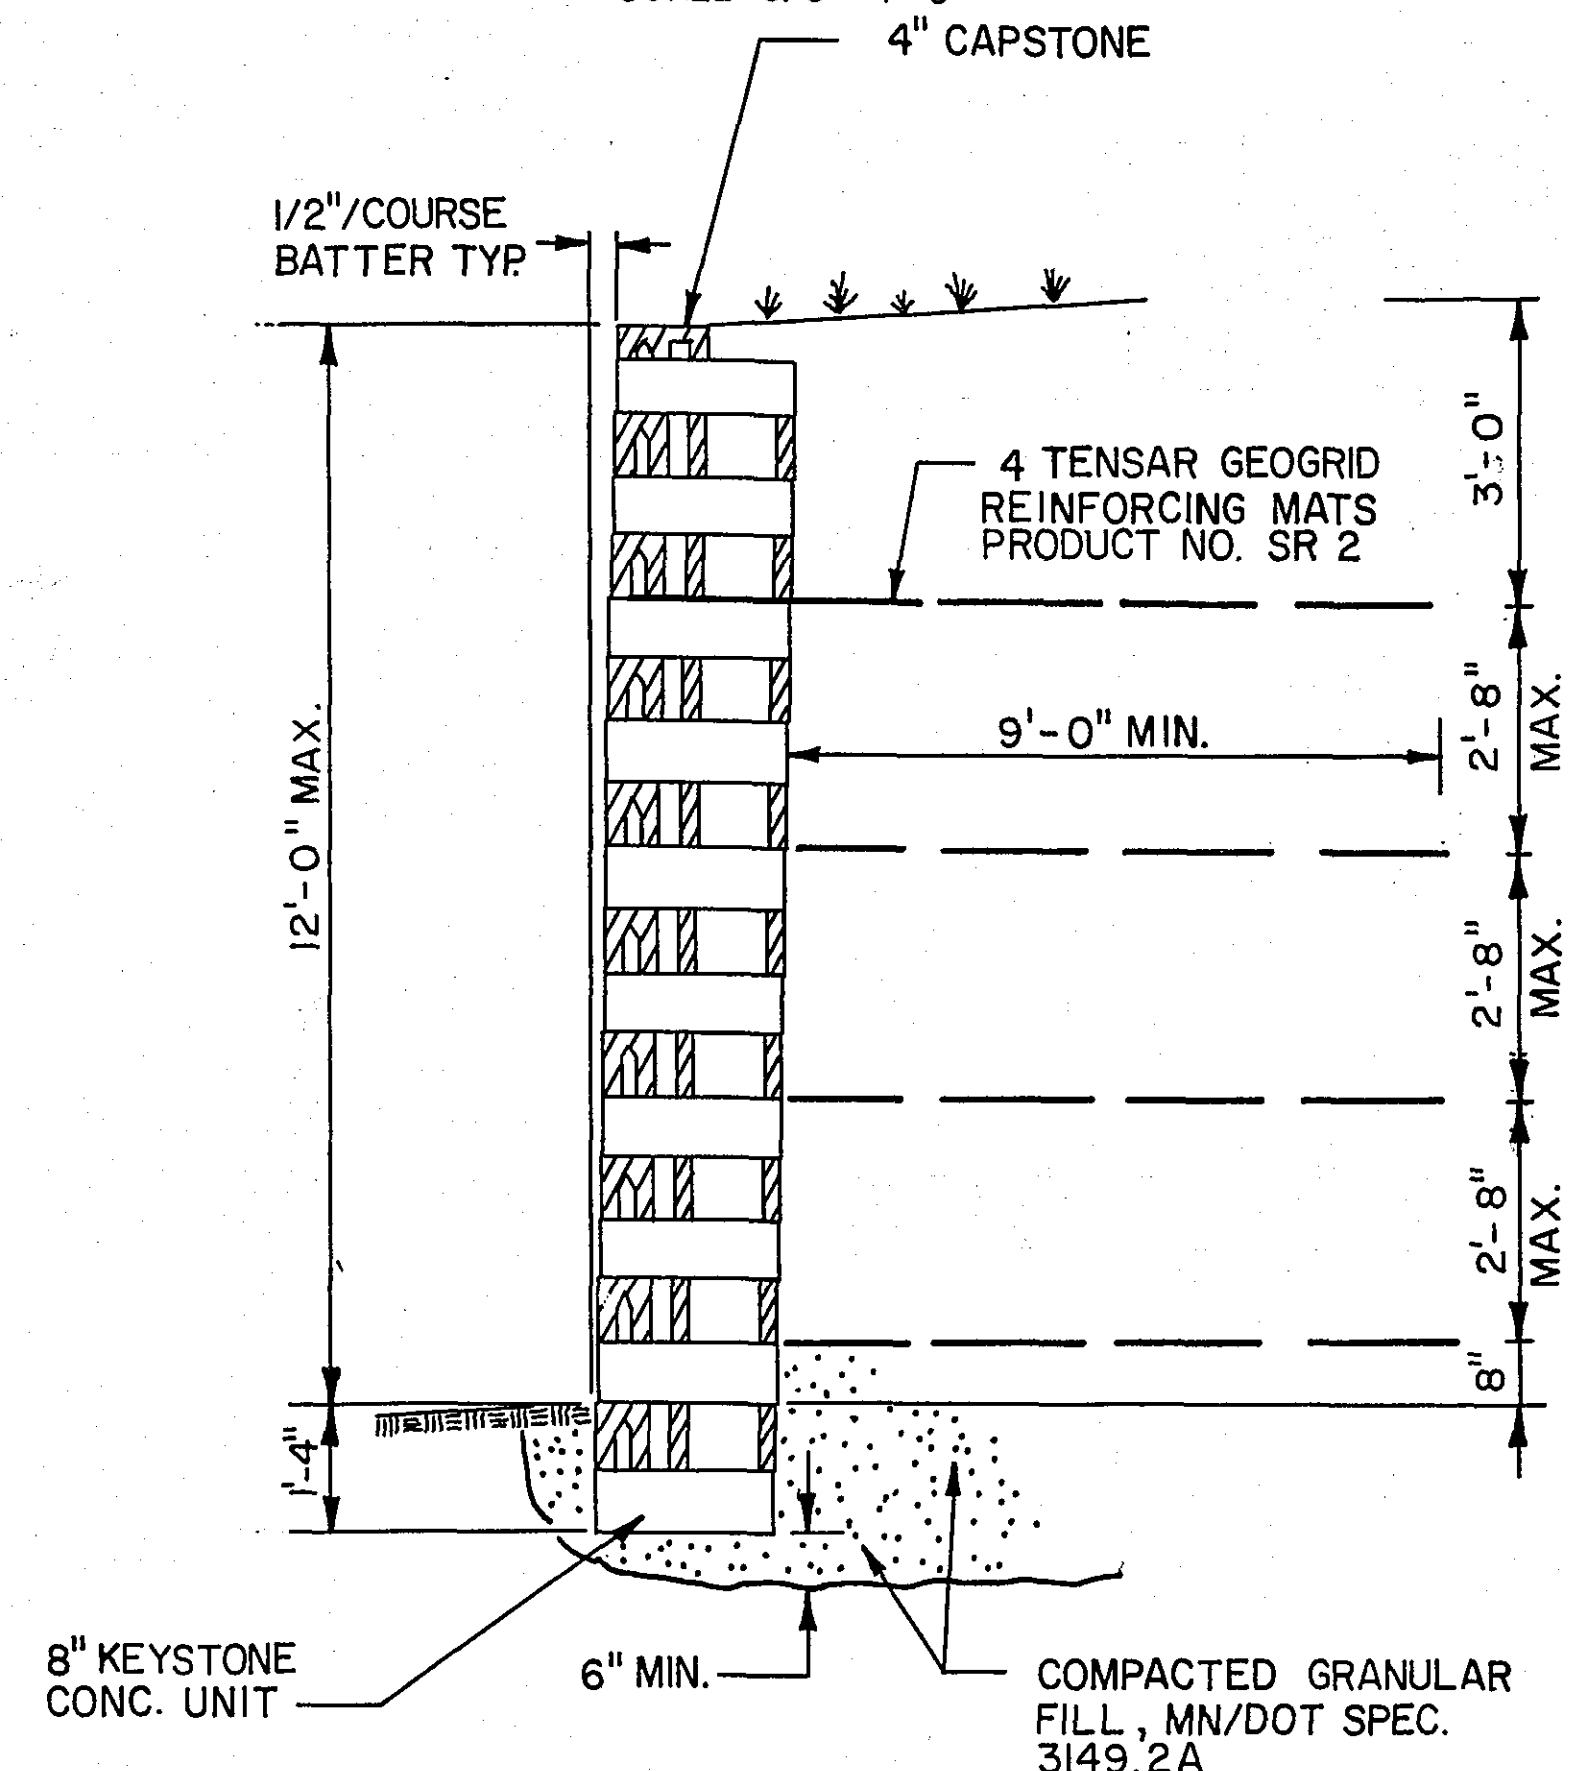[illegible]

RIPRAP DETAIL AT CMP OUTLET
STATION 9+70

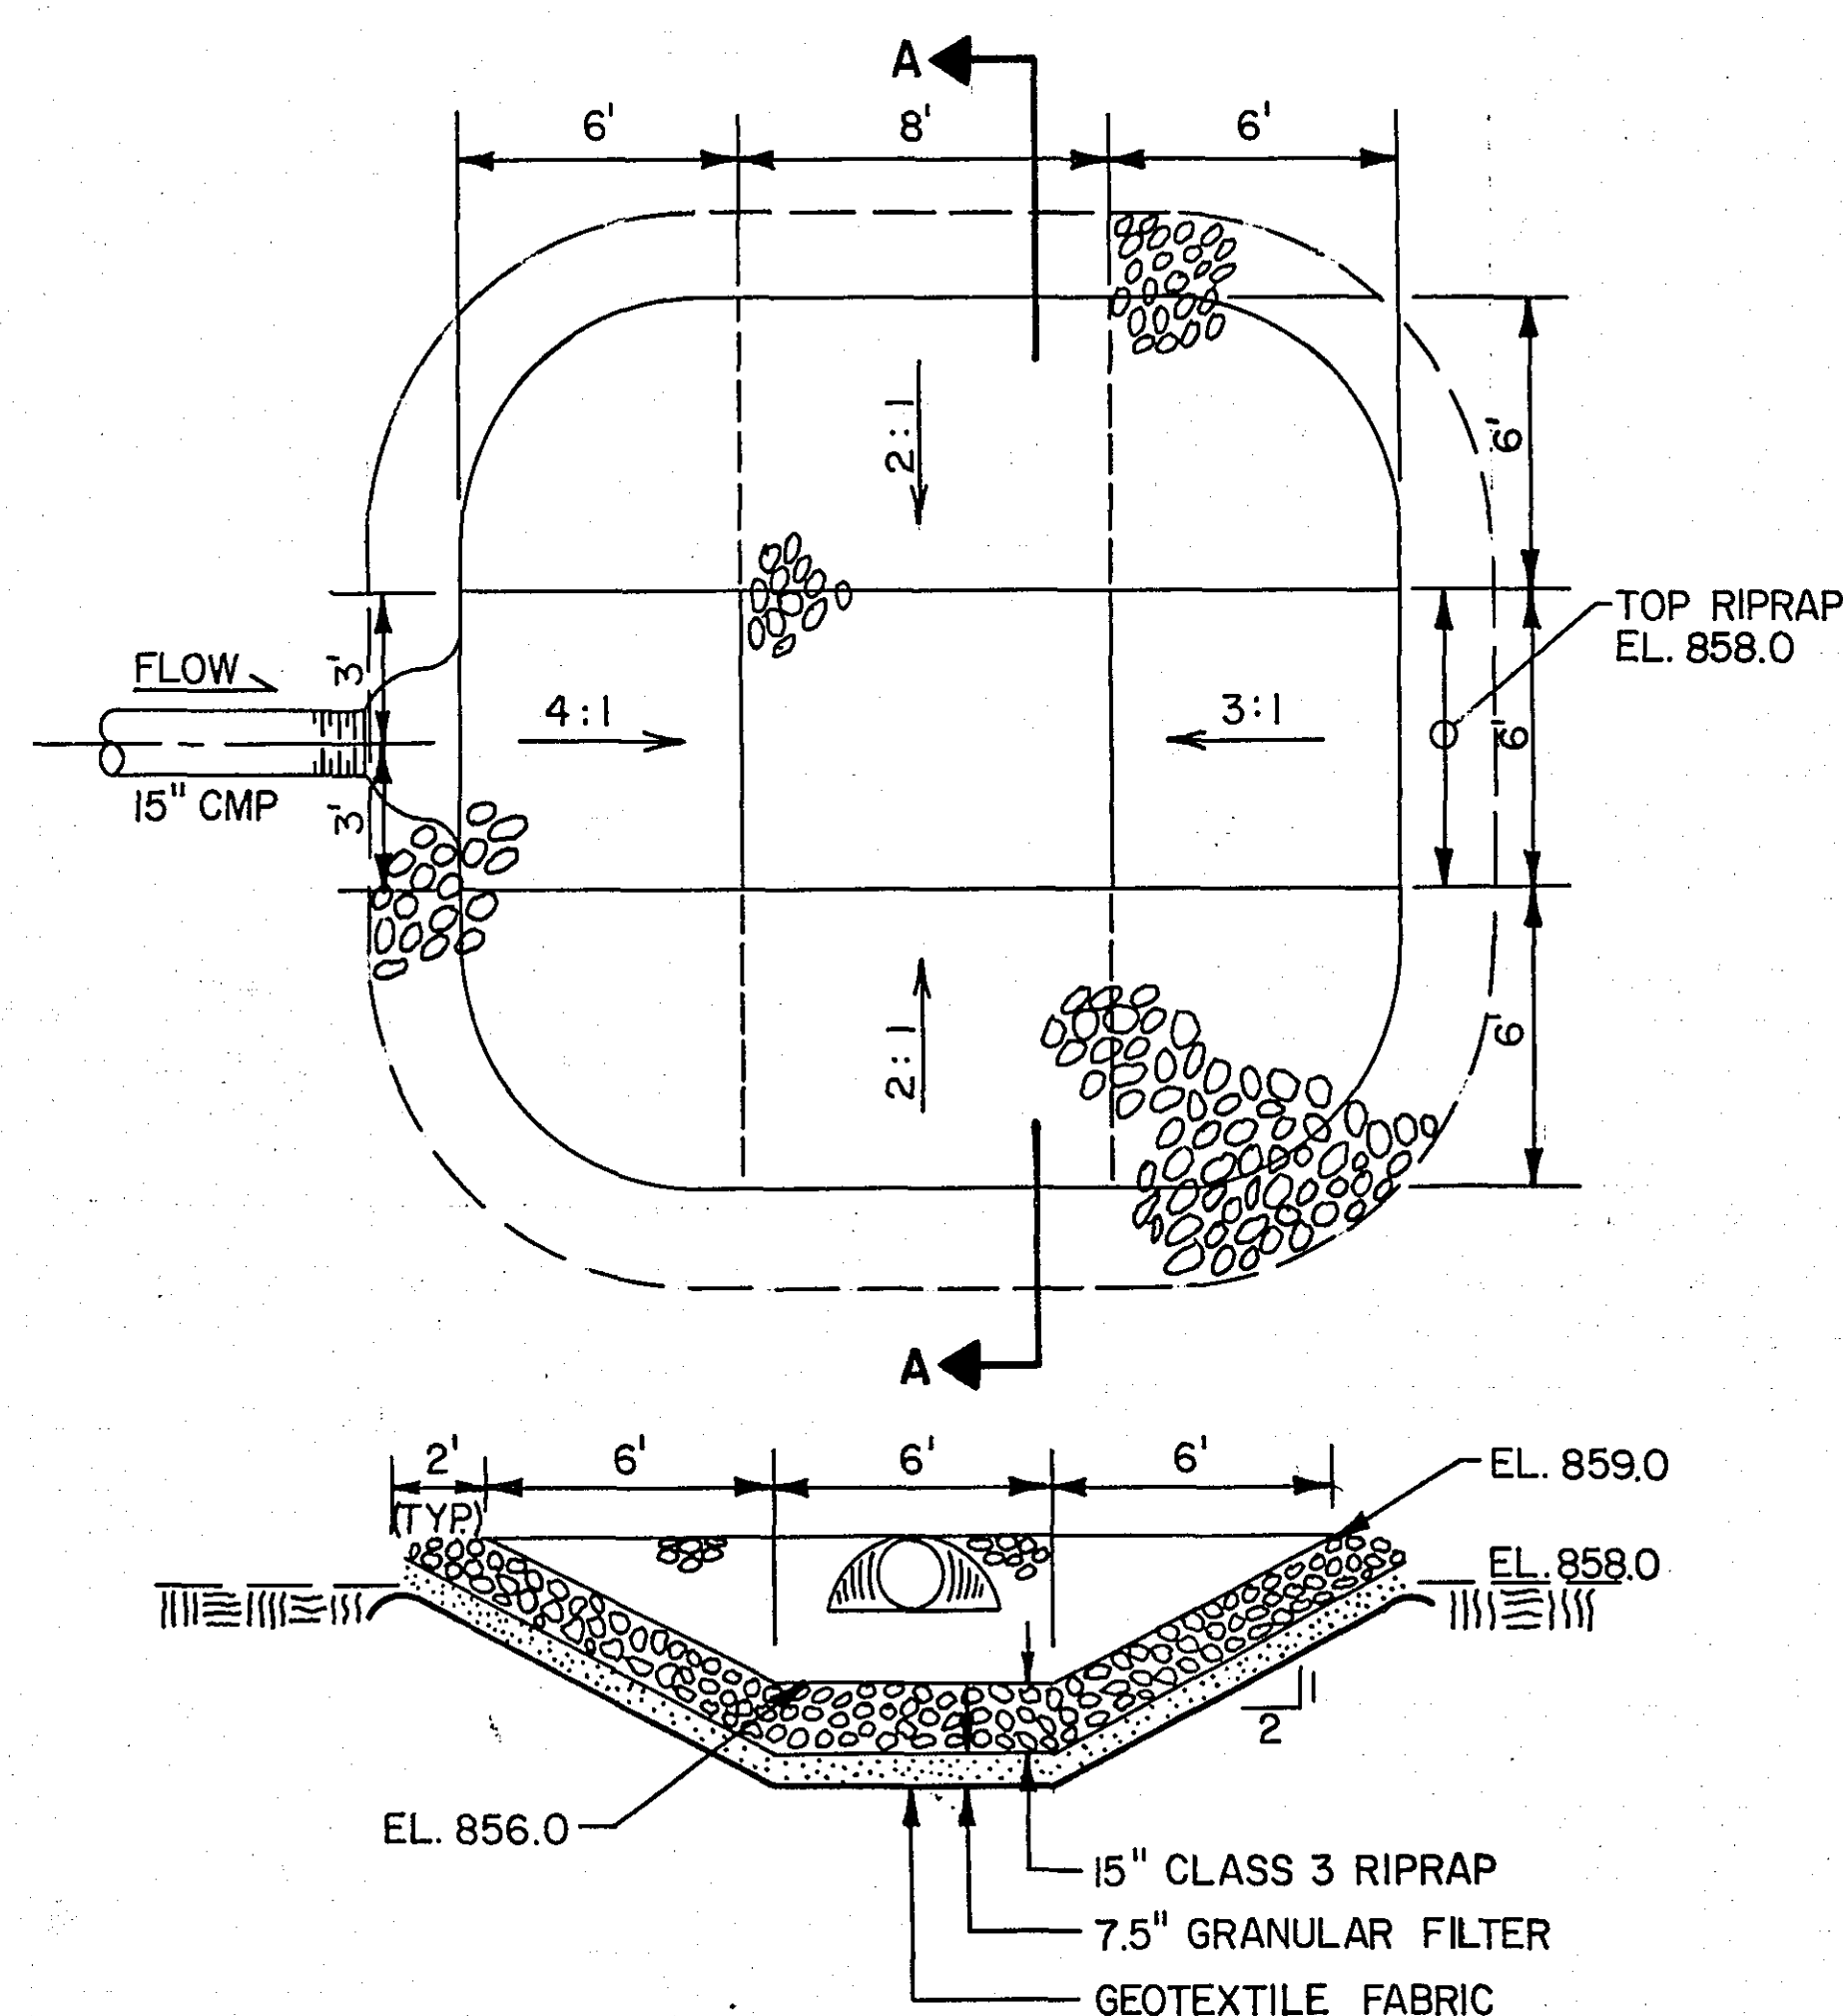

PERFORATED PIPE PLACEMENT DETAIL

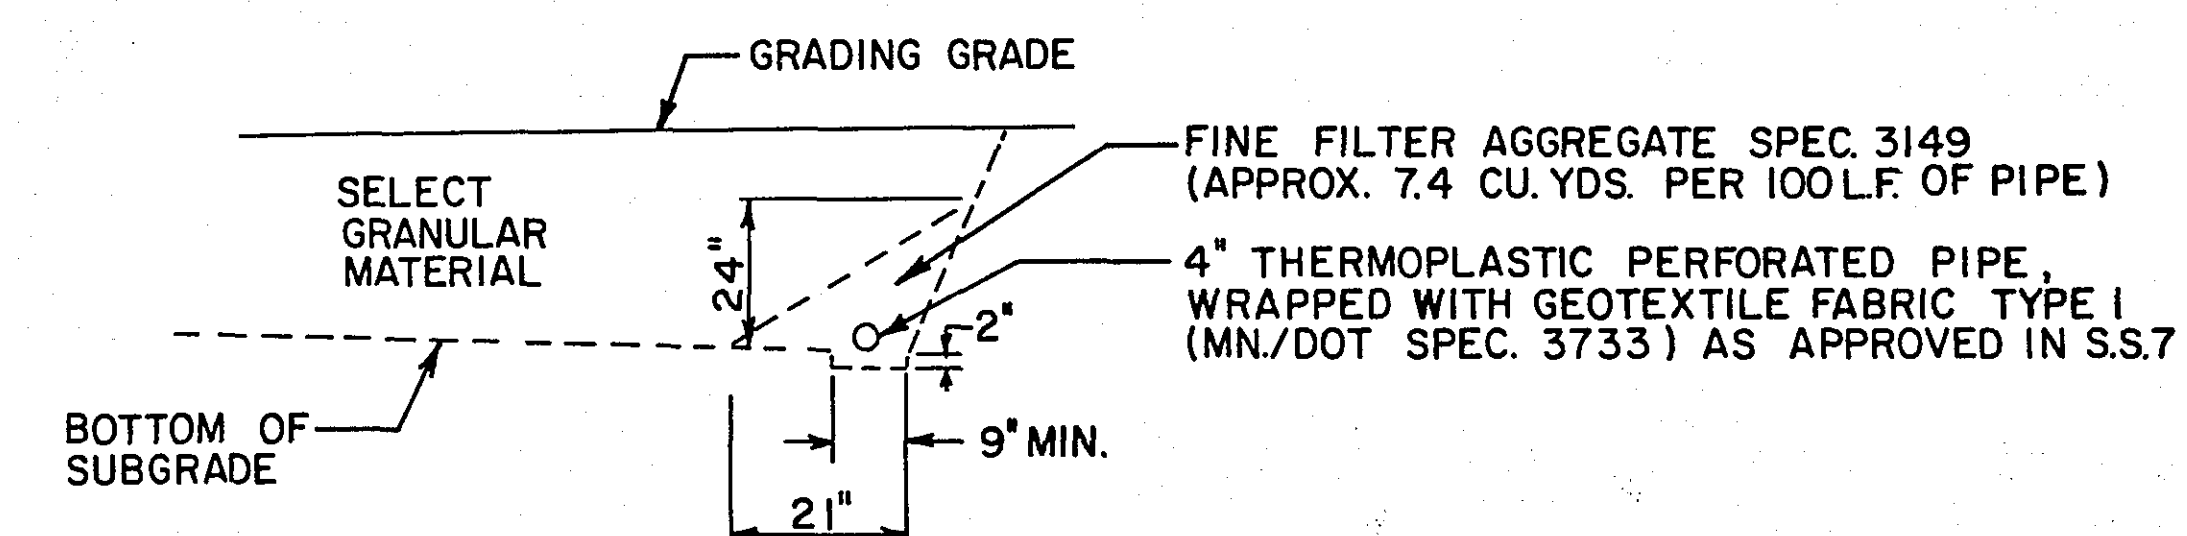

NOTE:
PAYMENT OF PERFORATED PIPE SHALL INCLUDE
FINE FILTER AGGREGATE & GEOTEXTILE FABRIC.

STANDARD PLATES

PLATE No.	DESCRIPTION
0005A	SPECIFICATION REFERENCE TO STANDARD PLATES
3000L	REINFORCED CONCRETE PIPE
3006F	GASKET JOINT FOR RC PIPE
3040F	CORRUGATED METAL PIPE CULVERT
3100G	CONCRETE APRON FOR REINFORCED CONCRETE PIPE
3123I	METAL APRON FOR CORRUGATED STEEL PIPE
3124B	METAL APRON CONNECTION
3134B	RIPRAP AT CMP OUTLETS
3145E	CONCRETE PIPE TIES
3221C	CORRUGATED STEEL PIPE COUPLING BANDS
4000I	MANHOLE OR CATCH BASIN (DESIGN A)
4002E	MANHOLE OR CATCH BASIN (DESIGN C)
4005K	MANHOLE OR CATCH BASIN (DESIGN F)
4010G	ADJUSTING RINGS
4011D	PRECAST CONCRETE BASE
4016D	CURB OPENING CATCH BASIN (DESIGN LP)
4101C	RING CASTING FOR MANHOLE OR CATCH BASIN
4110E	COVER CASTING FOR MANHOLE
4140D	SPECIAL GRATE CASTING FOR CATCH BASIN
4180H	MANHOLE OR CATCH BASIN STEP
7035J	CONCRETE WALK
7065C	BITUMINOUS CURB
7100F	CONCRETE CURB AND GUTTER
8000I	STANDARD BARRICADES
8307N	STEEL PLATE BEAM GUARD RAIL
8318C	GUARDRAIL ANCHORAGE PLATE FOR BRIDGES
9102D	SODDING AT PIPE CULVERT ENDS
9322J	CHAIN LINK FENCE

CLEAR AND GRUB CHART

STATION	LT	RT	DESCRIPTION
3+60		25'-40'	BEGIN BRUSH
4+10		25'-40'	END BRUSH
4+10		25'-40'	BEGIN WOODS (13 TREES)
5+10		25'-60'	END WOODS (13 TREES)
4+50	34'		10" TREE
4+80	30'		8" TREE
5+00	32'		15" TREE
5+15	32'		12" TREE
5+30		30'	8" TREE
5+50	40'		2-36" WILLOWS
5+60	35'		4 TREES
6+00	25'		24" TREE
6+50	25'-80'		BEGIN WOODS
9+00	25'-105'		END WOODS
5+60		30'-60'	BEGIN WOODS
8+50		30'-110'	END WOODS
9+55		54'	TREE
9+75		40'	TREE
9+90		54'	TREE
9+95	47'-105'		BEGIN WOODS
10+10	30'-105'		WOODS
10+45	20'-35'		END WOODS
10+23		43'	TREE
10+28		51'	TREE
10+88	28'		30" TREE
12+20	40'-65'		BEGIN PINES
12+63	34'		STUMP
14+50	40'-55'		END PINES
14+50	40'-55'		BEGIN SMALL TREES
17+70	40'-55'		END SMALL TREES
18+32		35'-48'	HEDGE
19+10	38'		2 TREES
20+70		30'	4" TREE
21+25		38'	2-12" TREES
21+95	33'		TREE
22+70	32'		TREE

SALVAGES AND REMOVALS

STATION	LOCATION	SALVAGE CHAIN LINK FENCE	SALVAGE MAILBOX	SALVAGE MISC ITEMS	SALVAGE GUARD RAIL & POSTS	SALVAGE VEHICULAR GATE	REMOVE CMP	REMOVE CONCRETE WALK	REMOVE CONCRETE PAVEMENT	REMOVE CONCRETE SWALE	REMOVE CONCRETE DRIVEWAY	REMOVE BITUMINOUS DRIVEWAY	REMOVE RETAINING WALL	REMARKS
FROM - TO	LT. or RT.	LIN. FT.	EACH	EACH	LIN. FT.	EACH	LIN. FT.	SQ. FT.	SQ. FT.	LIN. FT.	SQ. FT.	SQ. FT.	SQ. FT.	
0+45-0+55	Q								300					10"x30'
0+87	18' RT					1								TO BE REPLACED BY OWNER
0+48-1+60	26' RT	112												TO BE REPLACED BY OWNER
0+38	Q						50							15" DIA.
0+60-0+90	24' LT										360			12"x30'
1+10-1+40	24' LT										300			10"x30'
0+80-0+95	18' RT											170		1908 RICE ST.
1+69	2' LT			CASTING										
6+57	57' LT			CASTING										
6+90	55' LT			F.E.S.										
6+90	60' RT			F.E.S.										
7+20-8+60	18' LT				140									
7+20-8+60	16' RT				140									
8+18	56' LT			CASTING										
9+50-10+30	62' RT	88												
10+05	30' RT						30							12" DIA.
9+93-10+85	18' RT				92									
10+07-11+53	18' LT				146									
10+00-11+07	20'-80' RT									160				
11+37-11+70	20'-80' RT									80				
11+25	62' RT					1								
11+10-11+35	20' RT											1750		
12+00	34' LT					2								
11+80	Q						75							15" DIA.
11+96-12+18	26' LT											2000		20"x100'
10+00-11+00	33'-100' LT	150												
11+00-21+50	33' LT	1050												
11+40-13+25	20' RT													
17+48-17+56	18' RT										240		800	STONE 8"x30'
17+80	20' RT		1											
18+25	Q			CASTING										
18+26	24' LT			HYDRANT										DELIVER TO S.P.W.U.
18+55	20' RT		1											
18+57	20'-48' RT							84						3"x28'
19+48	Q			CASTING										
19+50	33' LT					1								
21+03	18' RT							100						STONE STEPS (4"x25')
20+28	20' RT		1											
21+10	18' RT		2											
21+35	24' RT												100	ALONG DRIVEWAY
21+83	Q			CASTING										
22+00	20' RT		2											
22+09-22+22	17' RT										260			13"x20'
22+78	18' RT		1											
22+90-23+00	18' RT											140		10"x14'
23+30	20' RT		2											
22+80-22+92	16' LT										240			12"x20'

WATER UTILITIES

STATION	LOCATION	ITEM	REMARKS
0+29	41' RT	HYD & G.V.	FURNISH & INSTALL
0+35	33' LT	12" B.F. VALVE	FURNISH & INSTALL
0+35	30' RT	12" B.F. VALVE	FURNISH & INSTALL
0+29	47' LT	HYD & G.V.	FURNISH & INSTALL
0+50	15' LT	12" B.F. VALVE	FURNISH & INSTALL
2+41	25' LT	8" G.V.	FURNISH & INSTALL
4+05	25' LT	8" G.V.	FURNISH & INSTALL
5+54	25' LT	8" G.V.	FURNISH & INSTALL
5+71	23' LT	HYD. & 6" G.V.	FURNISH & INSTALL (8'-0" BURY HYD.)
8+00	30' LT	AIR VENT	INSTALL (BY S.P.W.U.)
8+00	30' LT	2 G.V. BOXES	ADJUST
9+38	92' LT	6" G.V.	FURNISH & INSTALL
9+38	95' LT	MH	FURNISH & INSTALL
10+93	22' LT	12" B.F. VALVE	FURNISH & INSTALL
10+73	50' LT	MH	RECONSTRUCT (BY S.P.W.U.)
10+98	25' LT	12" B.F. VALVE	FURNISH & INSTALL
12+97	24' LT	G.V.	REMOVE
12+97	29' LT	6" G.V.	FURNISH & INSTALL
18+23	12' LT	G.V.	ADJUST

WATER UTILITIES

STATION	LOCATION	ITEM	REMARKS
18+26	24' LT	HYD.	SALVAGE
18+26	18'&27' LT	G.V. & HYD.	FURNISH & INSTALL
19+37	40' RT	G.V.	ADJUST
23+85	12' LT	G.V.	ADJUST
18+27	45' RT	CURB STOP BOX	ADJUST-UP 0.6'
21+78	28' LT	CURB STOP BOX	ADJUST-DOWN 0.5'
22+65	26' LT	CURB STOP BOX	ADJUST-DOWN 0.5'

SILT FENCE INSTALLATION

STATION	LOCATION	QUANTITY	REMARKS
3+65 to 9+10	110' RT	695'	EXTEND SILT FENCE UNDER BRIDGE
6+00 to 9+10	100' LT	410'	EXTEND SILT FENCE UNDER BRIDGE
9+45 to 12+00	110' LT	375'	EXTEND SILT FENCE UNDER BRIDGE
9+45 to 10+80	110' RT	255'	EXTEND SILT FENCE UNDER BRIDGE

DRAINAGE CHART

						ELEVATION				FURNISH AND INSTALL PIPE SEWER												DRAINS TO		REMARKS								
STATION	LOCATION (From ROW @)	No.	TYPE	DESIGN	CONSTRUCTION HEIGHT Lin. Ft.	CASTING ASSEMBLY	PROFILE	ORIGINAL GRATE	NEW GRATE	INVERT	ADJUST CASTING ASSEMBLY	RECONSTRUCT Lin. Ft.	INSTALL CASTING ASSEMBLY	REINF. CONC. PIPE				D.I.P.		PVC	CMP				APRON	CLASS	STRUCTURE No.	INVERT ELEVATION				
														12"	15"	18"	36"	8"	10"		8"	15"	18"									
EXISTING STRUCTURES																																
0+46	1' LT	1-24	MH	SANITARY			861.86	862.07	861.82	850.18	X		①																ADJUST			
1+69	2' LT	1-23	MH	SANITARY			863.42	863.56	863.38	849.60	X		①																ADJUST			
1+69	54' LT	1-22	MH	SANITARY			863.42	865.8±		849.23											52'								PROTECT. CONNECT TO W/8" PVC			
4+09	54' LT	1-21	MH	SANITARY			871.38	869.8±		848.03																			REMOVE			
6+57	56' LT	1-20	MH	SANITARY			880.92	866.90	874.6	847.06		13.6	①																RECONSTRUCT			
6+57	105' RT	1-19	MH	SANITARY			880.92	855.85		841.86																			PROTECT			
7+74	15' LT	7	MH	GAS			886.04	882.57	885.54	874.0																			RECONSTRUCT-BY OTHERS (TOP GAS-876.4)			
8+20	56' LT	1-25	MH	SANITARY			887.66	870.49	881.0	847.45		15.8	①								84'								RECONSTRUCT. CONNECT TO W/10" PVC			
10+73	50' LT	9	MH	WATER			893.45	880.80	889.5				①																RECONSTRUCT - BY OTHERS			
11+82	18' RT	9A	SI	STORM			893.86	890.32																					REMOVE SIDE INLET			
11+95	16' LT	10	MH	GAS			893.80	891.80	893.56	882.1			①																RECONSTRUCT-BY OTHERS (TOP GAS-885.8)			
18+25	CENTERLINE	4-35	MH	SANITARY			899.29	899.25	899.25	889.78		5.3	①																RECONSTRUCT			
19+49	CENTERLINE	4-34	MH	SANITARY			899.79	899.55	899.75	889.02		6.7	①																RECONSTRUCT			
21+83	CENTERLINE	4-33	MH	SANITARY			898.75	898.31	898.71	887.82		7.0	①																RECONSTRUCT			
24+10	29' LT	14	MH	STORM																									(A)			
24+19	CENTERLINE	4-31	MH	SANITARY																									OK			
PROPOSED STRUCTURES																																
0+64	21.5' RT	101	CB	LP4-4		C	861.99		862.04	857.60						20'						54'			15"	CMP	CB-33B,DITCH		(B)			
0+64	27.5' LT	102	CB	LP4-4		C	861.99		862.04	857.18						53'											101					
4+50	21.5' RT	103	CB	LP4-5		C	871.15		871.20	864.96						386'											101					
4+50	21.5' LT	104	CB	LP4-5		C	871.15		871.20	865.50						47'											103					
6+90	55' LT		F.E.				882.44			860.87																			(C)			
6+90	60' RT		F.E.				882.44			858.76																			(C)			
8+87	CENTERLINE		CULVERT				890.36			851.36																			(D)			
9+75	78' RT	105	MH	A or F	9.3	A	891.92		865.0	855.70														2-36"	RCP							
10+13	22' RT	106	MH	A or F	12.1	A	892.65		891.5	879.41														15"	CMP							
10+16	15' RT	107	CB	SP-2	5.0	B	892.69		892.32	887.26																	105		2' SUMP			
10+34	25' LT	108	CB	SP-2	5.1	B	892.97		892.59	887.50						7'											106					
11+36	17' RT	109	MH	A or F	6.3	A	893.92		893.53	887.34						46'											107					
11+36	74' RT	110	SD	C		D	893.92		891.00	887.75						124'											106					
11+07	74' RT	111	SD	C		D	893.82		891.00	887.90						57'											109		LOCATE IN SWALE			
12+63	15.5' RT	112	CB	LP4-5		C	893.52		893.57	888.80						29'											110		LOCATE IN SWALE			
16+00	15.5' RT	113	CB	LP4-5		C	897.66		897.71	893.00						126'											109	887.35				
16+00	27.5' LT	114	CB	LP4-4		C	897.66		897.71	893.52						337'											112	888.85				
12+63	27.5' LT	112A	CB	LP4-4		C	893.52		893.57	889.32						47'											113	893.05				
19+03	20' RT	116	CB	LP4-5		C	899.68		899.73	894.56						47'											112	888.85				
19+75	21.5' RT	117	CB	LP4-5		C	899.69		899.74	895.06						303'											113	893.05				
23+69	21.5' LT	118	CB	LP4-4		C	896.29		896.34	891.96						92'											116	894.60				
23+69	21.5' RT	119	CB	LP4-4		C	896.29		896.34	892.21						41'											14					
																46'											118		CONNECT INTO EX. MH			
1+80	27' RT	1	MH	A OR F	14.3	A	863.67		863.80	849.45																						
3+75	27' RT	2	MH	A OR F	20.1	A	868.58		868.70	848.63																						
6+75	27' RT	3	MH	A OR F	36.0	A	880.55		880.70	844.68																						
8+05	27' RT	4	MH	A OR F	40.2	A	887.20		887.20	847.09																						
TOTALS														0'	1788'	20'	200'	282'	232'	276'	139'	0'										

- Ⓐ MANHOLE LOCATION APPROXIMATE. CASTING IS COVERED BY BITUMINOUS SURFACING.
- Ⓑ TEMPORARY OUTLET THROUGH 15" CMP UNTIL 18" RCP IS INSTALLED IN RICE STREET IN FUTURE. PLACE 3 CY RIPRAP AT OUTLET.
- Ⓒ REMOVE EXISTING FLARED END SECTION, BULKHEAD PIPE.
- Ⓓ REMOVE EXISTING PIPE. REPLACE WITH 36" RCP FROM STA. 8+50, 90'R TO STA. 9+30, 100' L AND 2-36" FLARED END SECTIONS.
- ① FURNISH AND INSTALL NEW CASTING ASSEMBLY.
- ② SALVAGE CASTINGS, BULKHEAD PIPES, AND REMOVE MANHOLE

REVISED 5/22/92 W.R.L. , B.J.

28-117

© BONESTROO, ROSENE, ANDERLIK
AND ASSOCIATES, INC. 1989

I HEREBY CERTIFY THAT THIS PLAN WAS PREPARED BY ME OR UNDER MY
DIRECT SUPERVISION AND THAT I AM A DULY REGISTERED PROFESSIONAL
ENGINEER/ARCHITECT UNDER THE LAWS OF THE STATE OF MINNESOTA.
DATE 5/22/92 REG. NO. 16642 Thomas J. Peterson

SURVEY HBR
DRAWN OFD
DESIGN TWP
APPROVED MLS

REVISIONS



BONESTROO, ROSENE, ANDERLIK & ASSOC., INC.
Engineers & Architects
St. Paul, Minnesota

RAMSEY COUNTY, MINNESOTA

DATE: OCT. 19, 1989 COMM. 21802

ROSELAWN AVENUE
DRAINAGE CHART
RICE ST. to JACKSON ST.
S.A.P. No. 62-626-04

SHEET
7
24



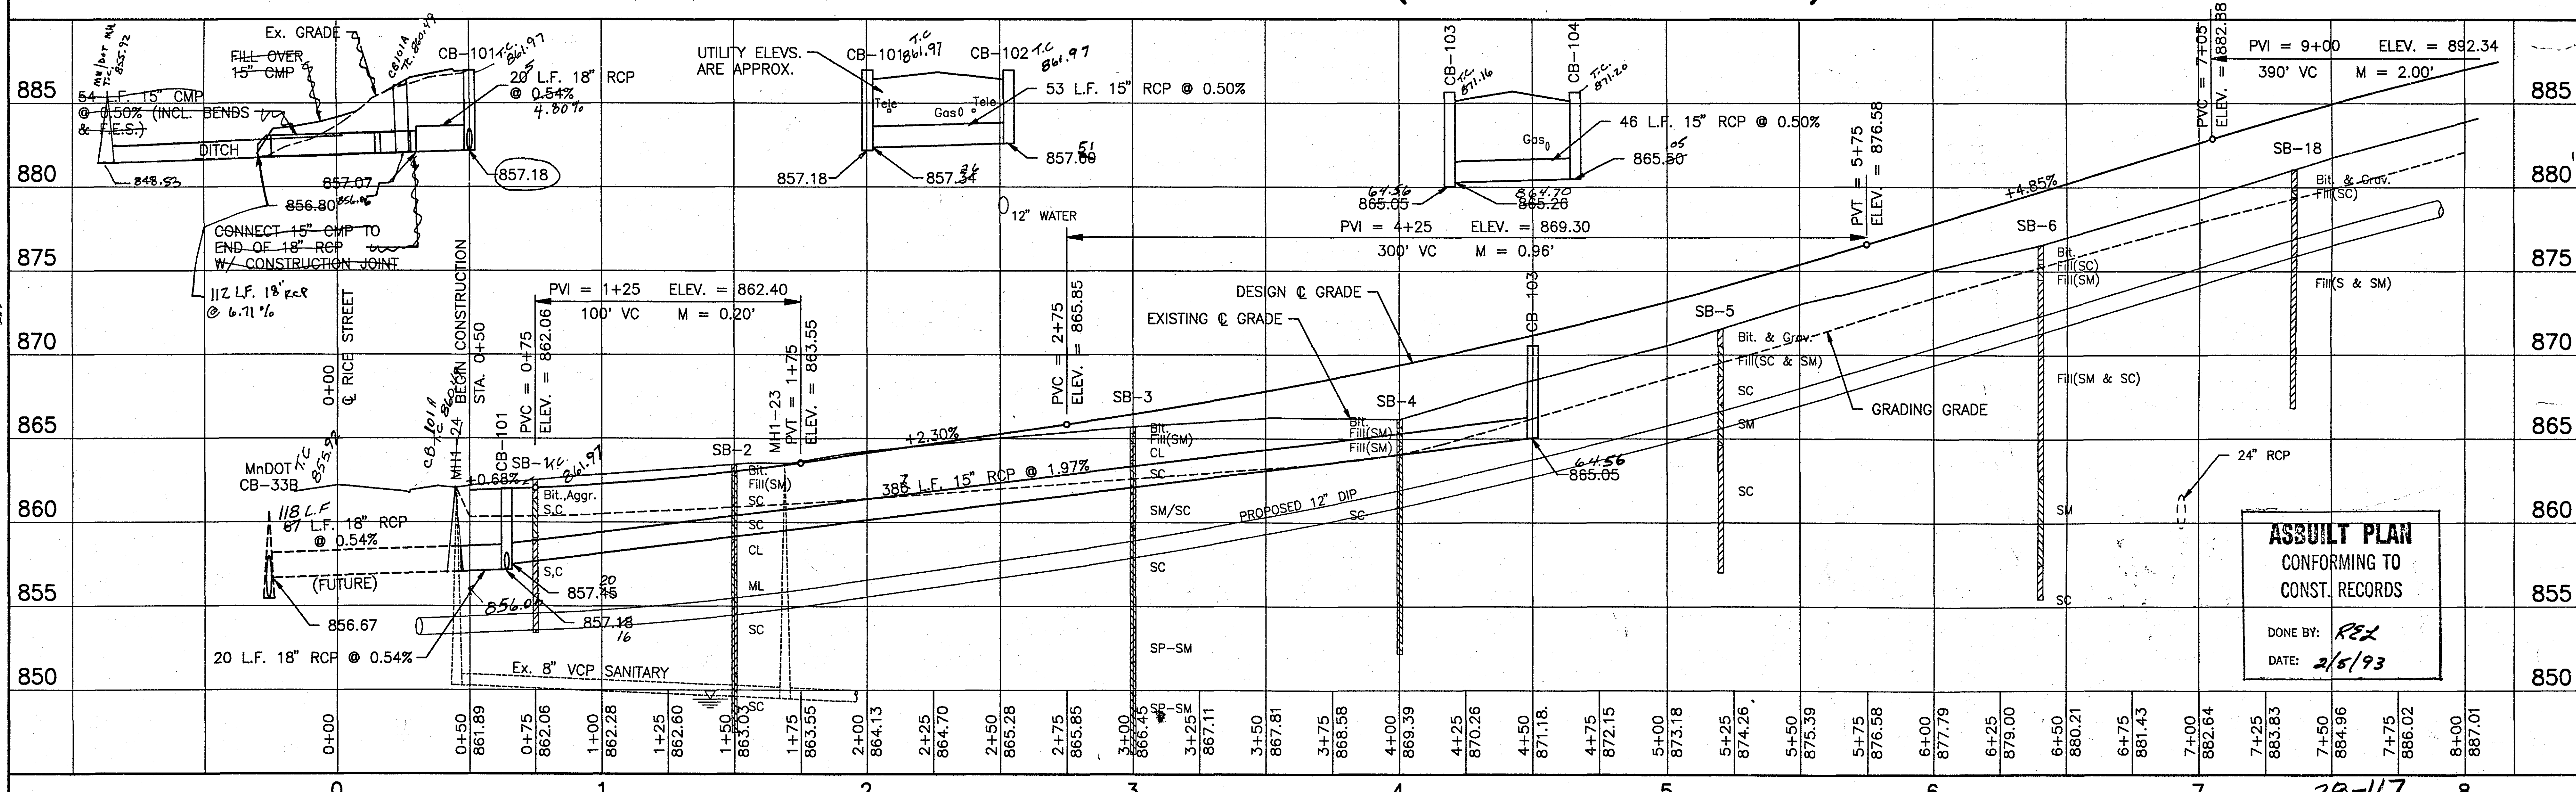
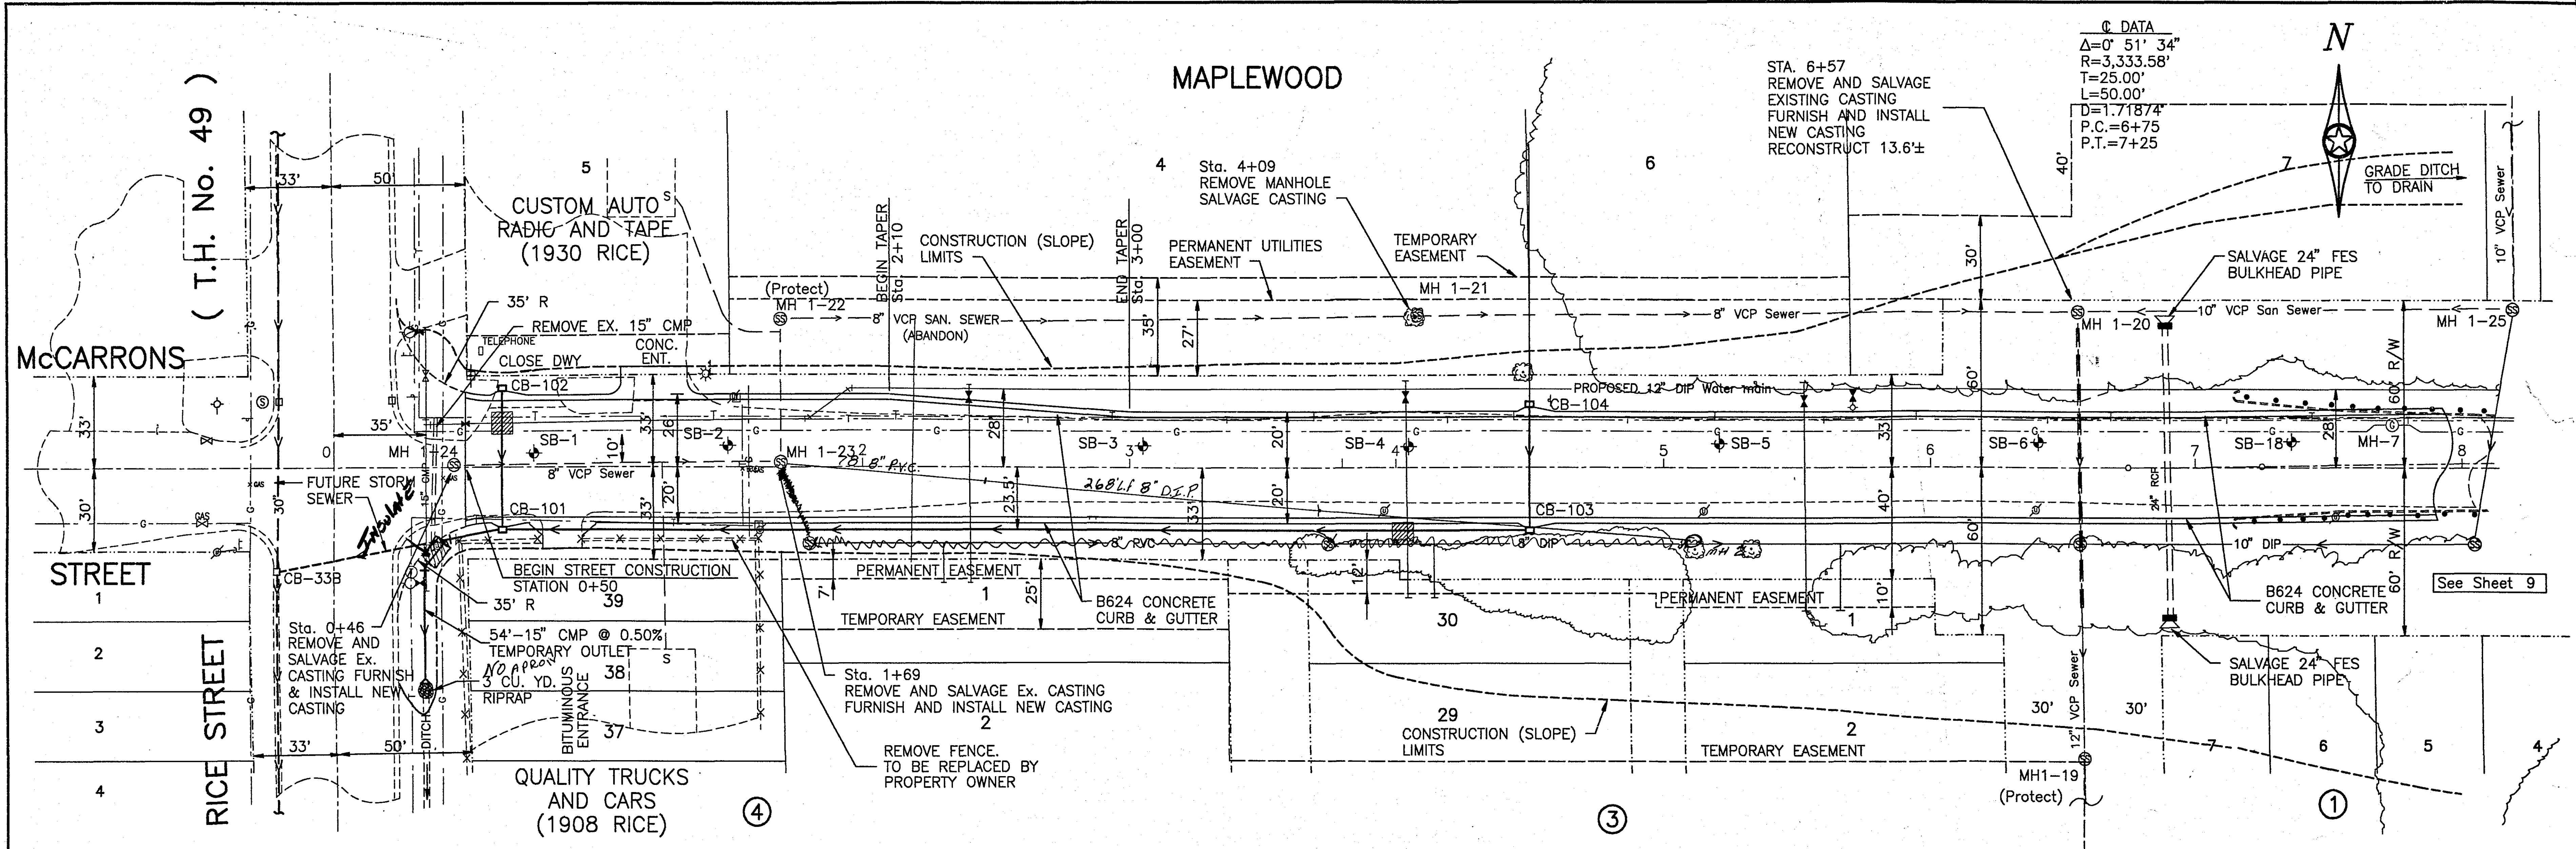


STA. 18+23±
ADJUST VALVE BOX
3.0 LF VALVE NUT EXTENSION
5 LF WATER SERVICE TRENCH EXC.

LIME SLUDGE
BASIN

Q DATA
Δ=0° 51' 34"
R=3,333.58'
T=25.00'
L=50.00'
D=1.71874'
P.C.=19+75
P.T.=20+25

NOTE:
7 EA. ADJUST VALVE BOXES (CURB STOP BOXES)
HOUSES BETWEEN BEAUMONT ST. AND JACKSON ST.

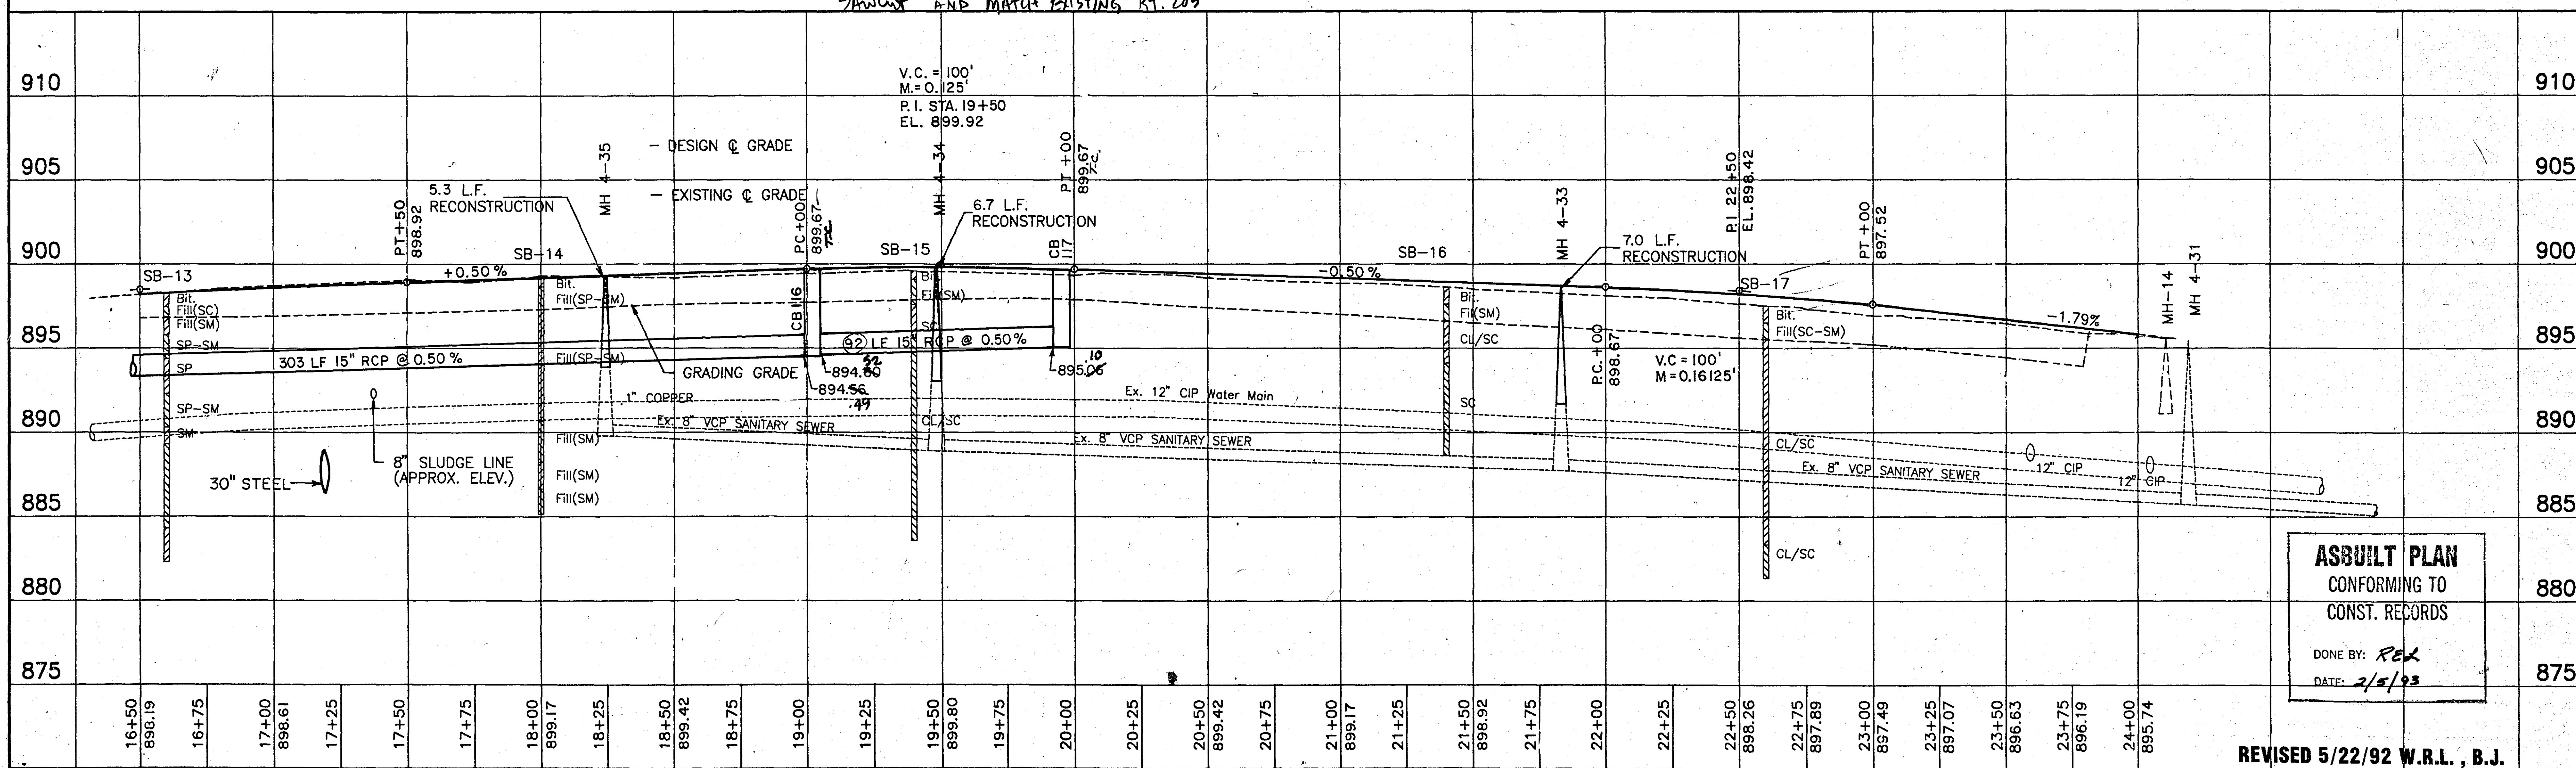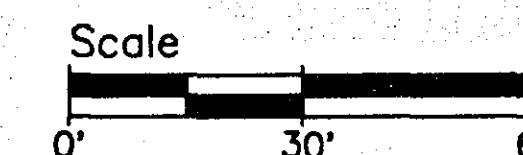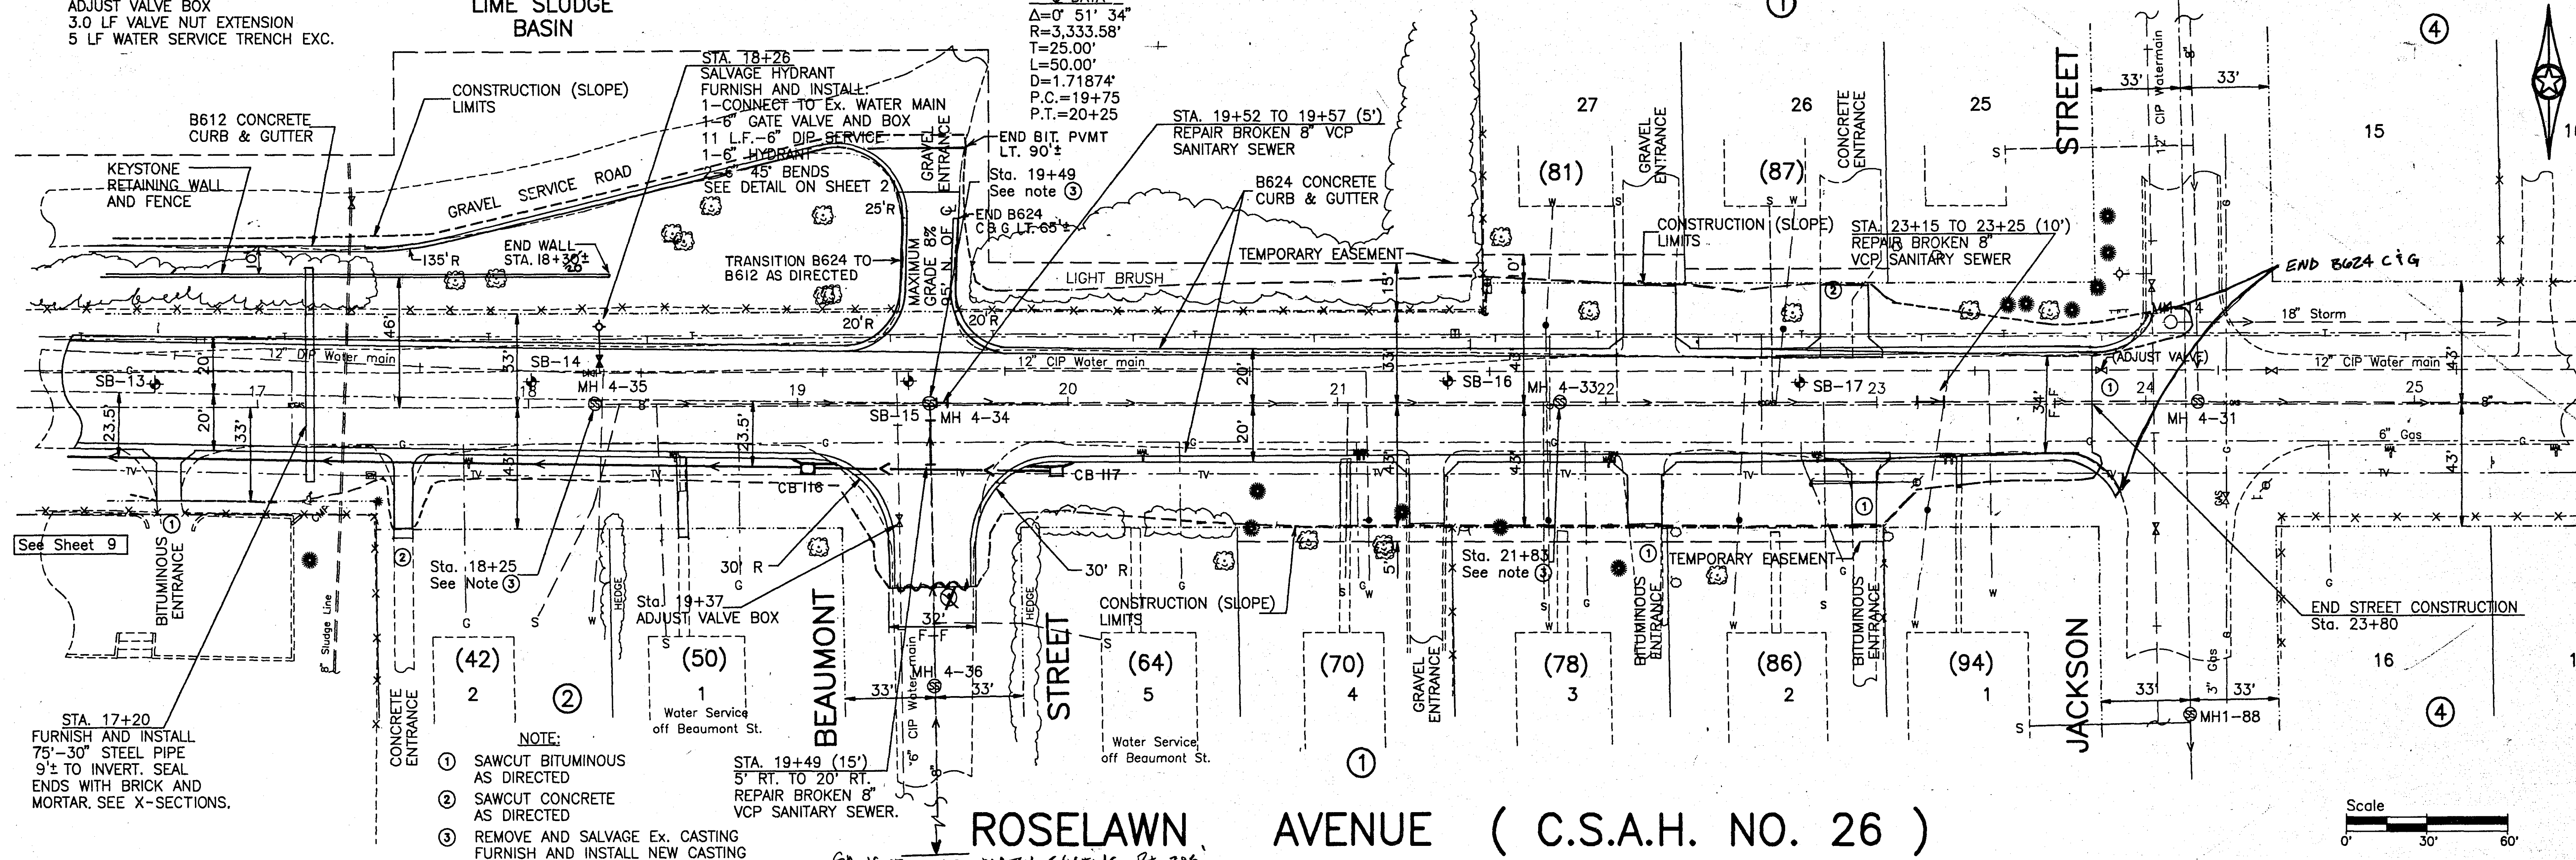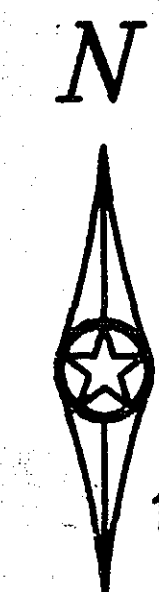

ASBUILT PLAN
CONFORMING TO
CONST. RECORDS
DONE BY: *REL*
DATE: *2/5/93*

REVISED 5/22/92 W.R.L., B.J.

© BONESTROO, ROSENE, ANDERLIK,
1990

I HEREBY CERTIFY THAT THIS PLAN WAS PREPARED BY ME, "UNDER MY
DIRECT SUPERVISION AND THAT I AM A DULY REGISTERED PROFESSIONAL
ENGINEER/ARCHITECT, UNDER THE LAWS OF THE STATE OF MINNESOTA.
DATE: *5/20/90* REG. NO. *16610* *Thomas W. Peterson*



SURVEY HBR
DRAWN DFD
DESIGN TWP
APPROVED MLS


BONESTROO, ROSENE, ANDERLIK & ASSOC., INC.
Engineers & Architects
St. Paul, Minnesota

RAMSEY COUNTY, MINNESOTA
DATE: OCT. 19, 1989 COMM. 21802

ROSELAWN AVENUE
STREET & STORM SEWER CONSTRUCTION
RICE ST. TO JACKSON ST.
S.A.P. No. 62-626-04

SHEET
10
24

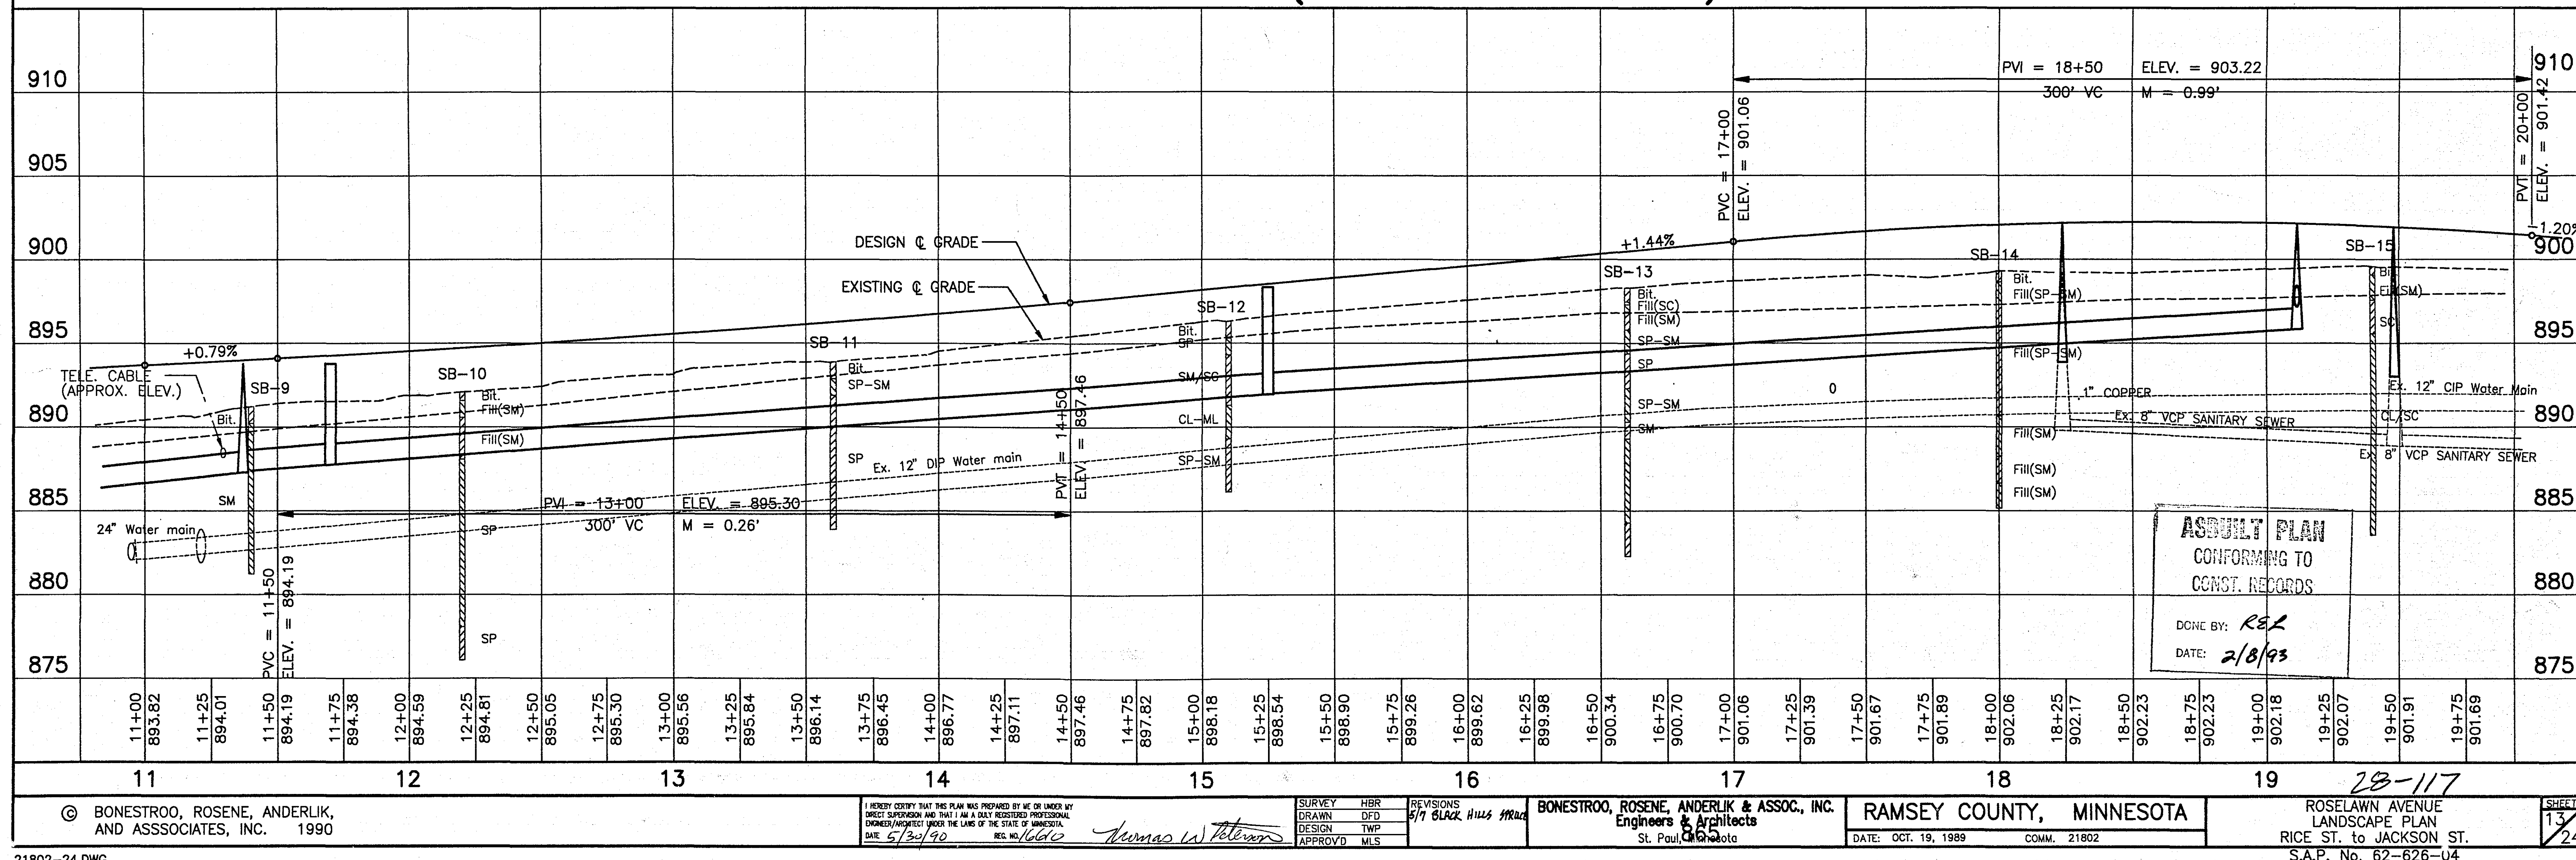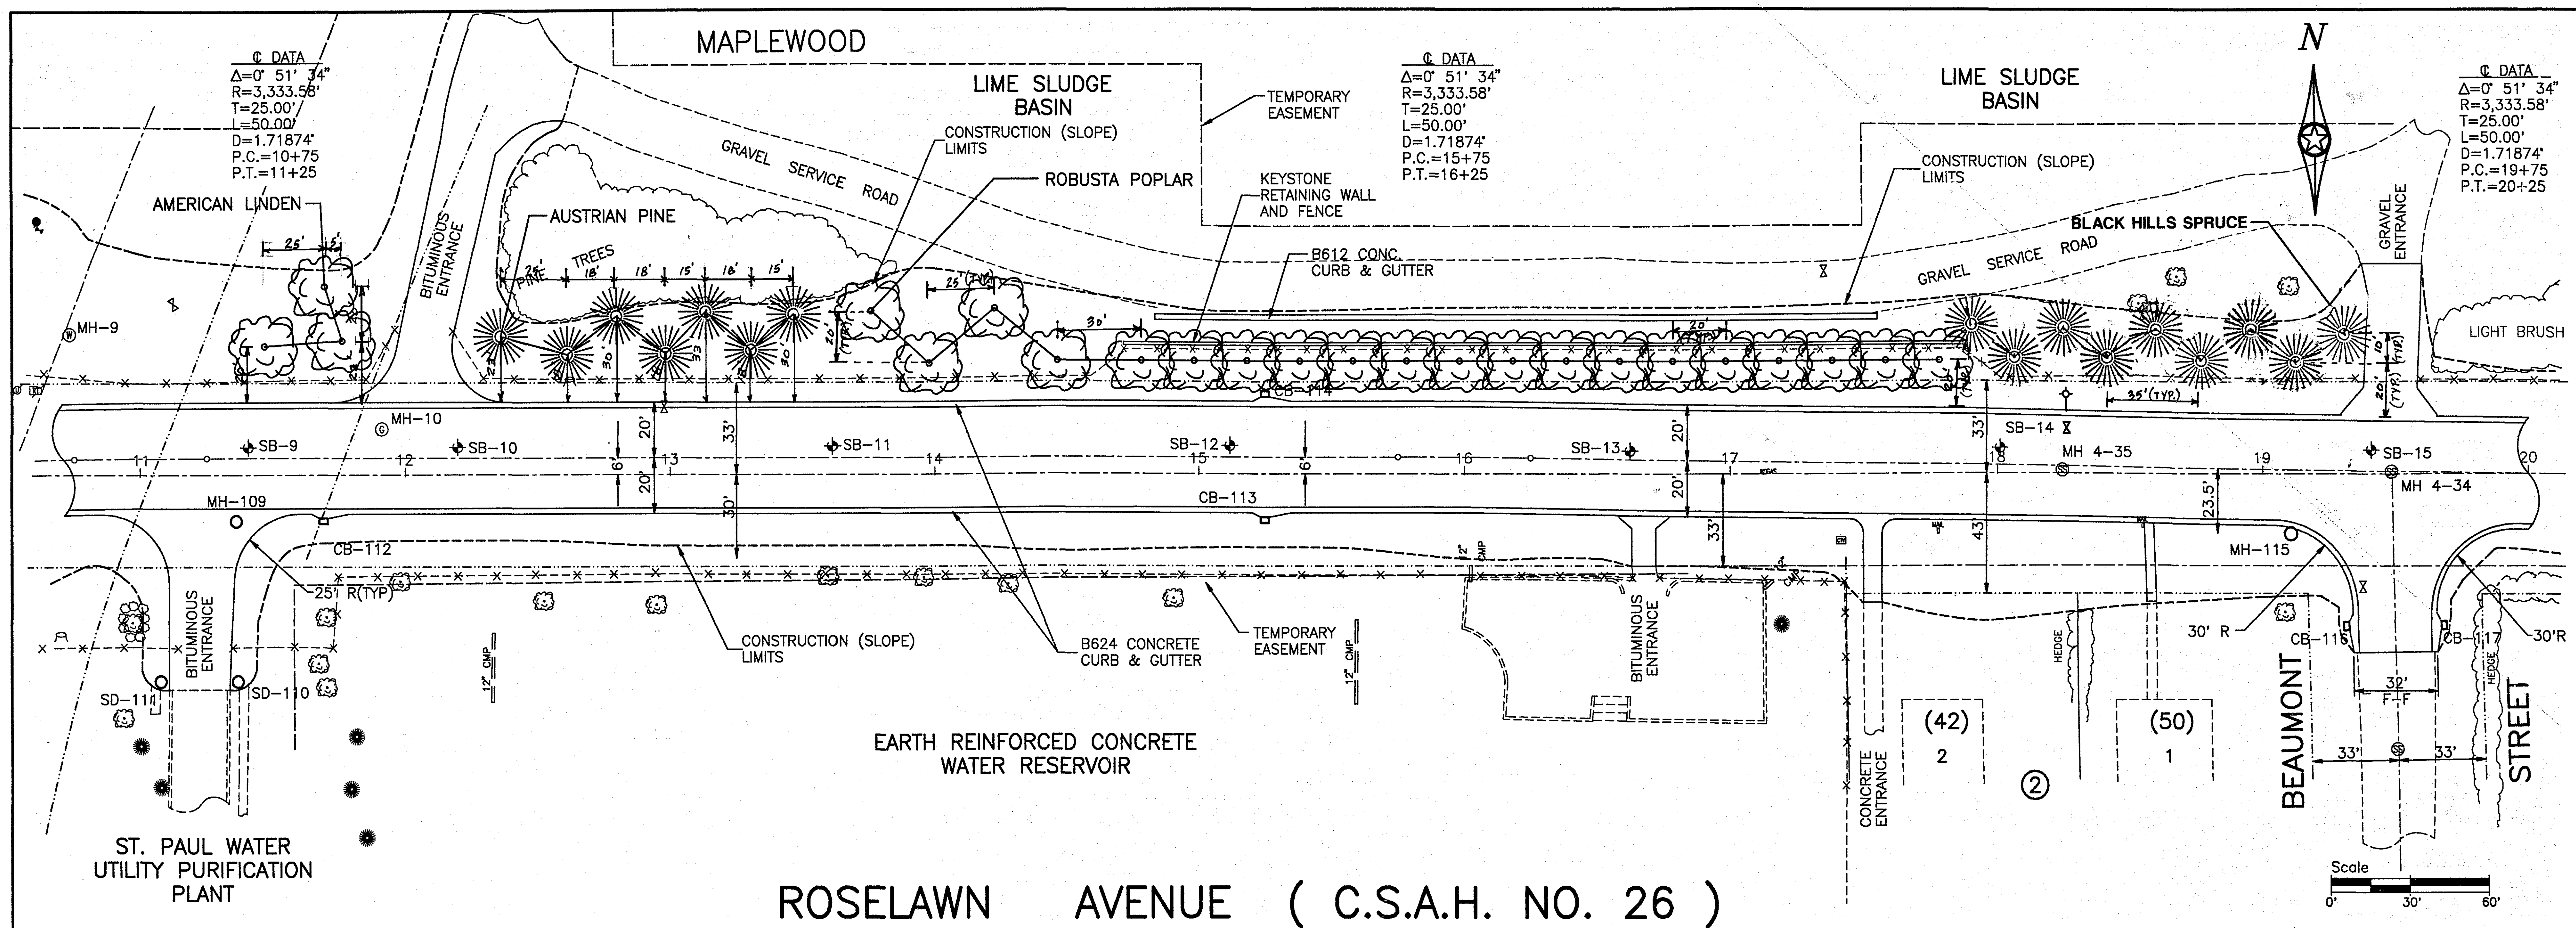

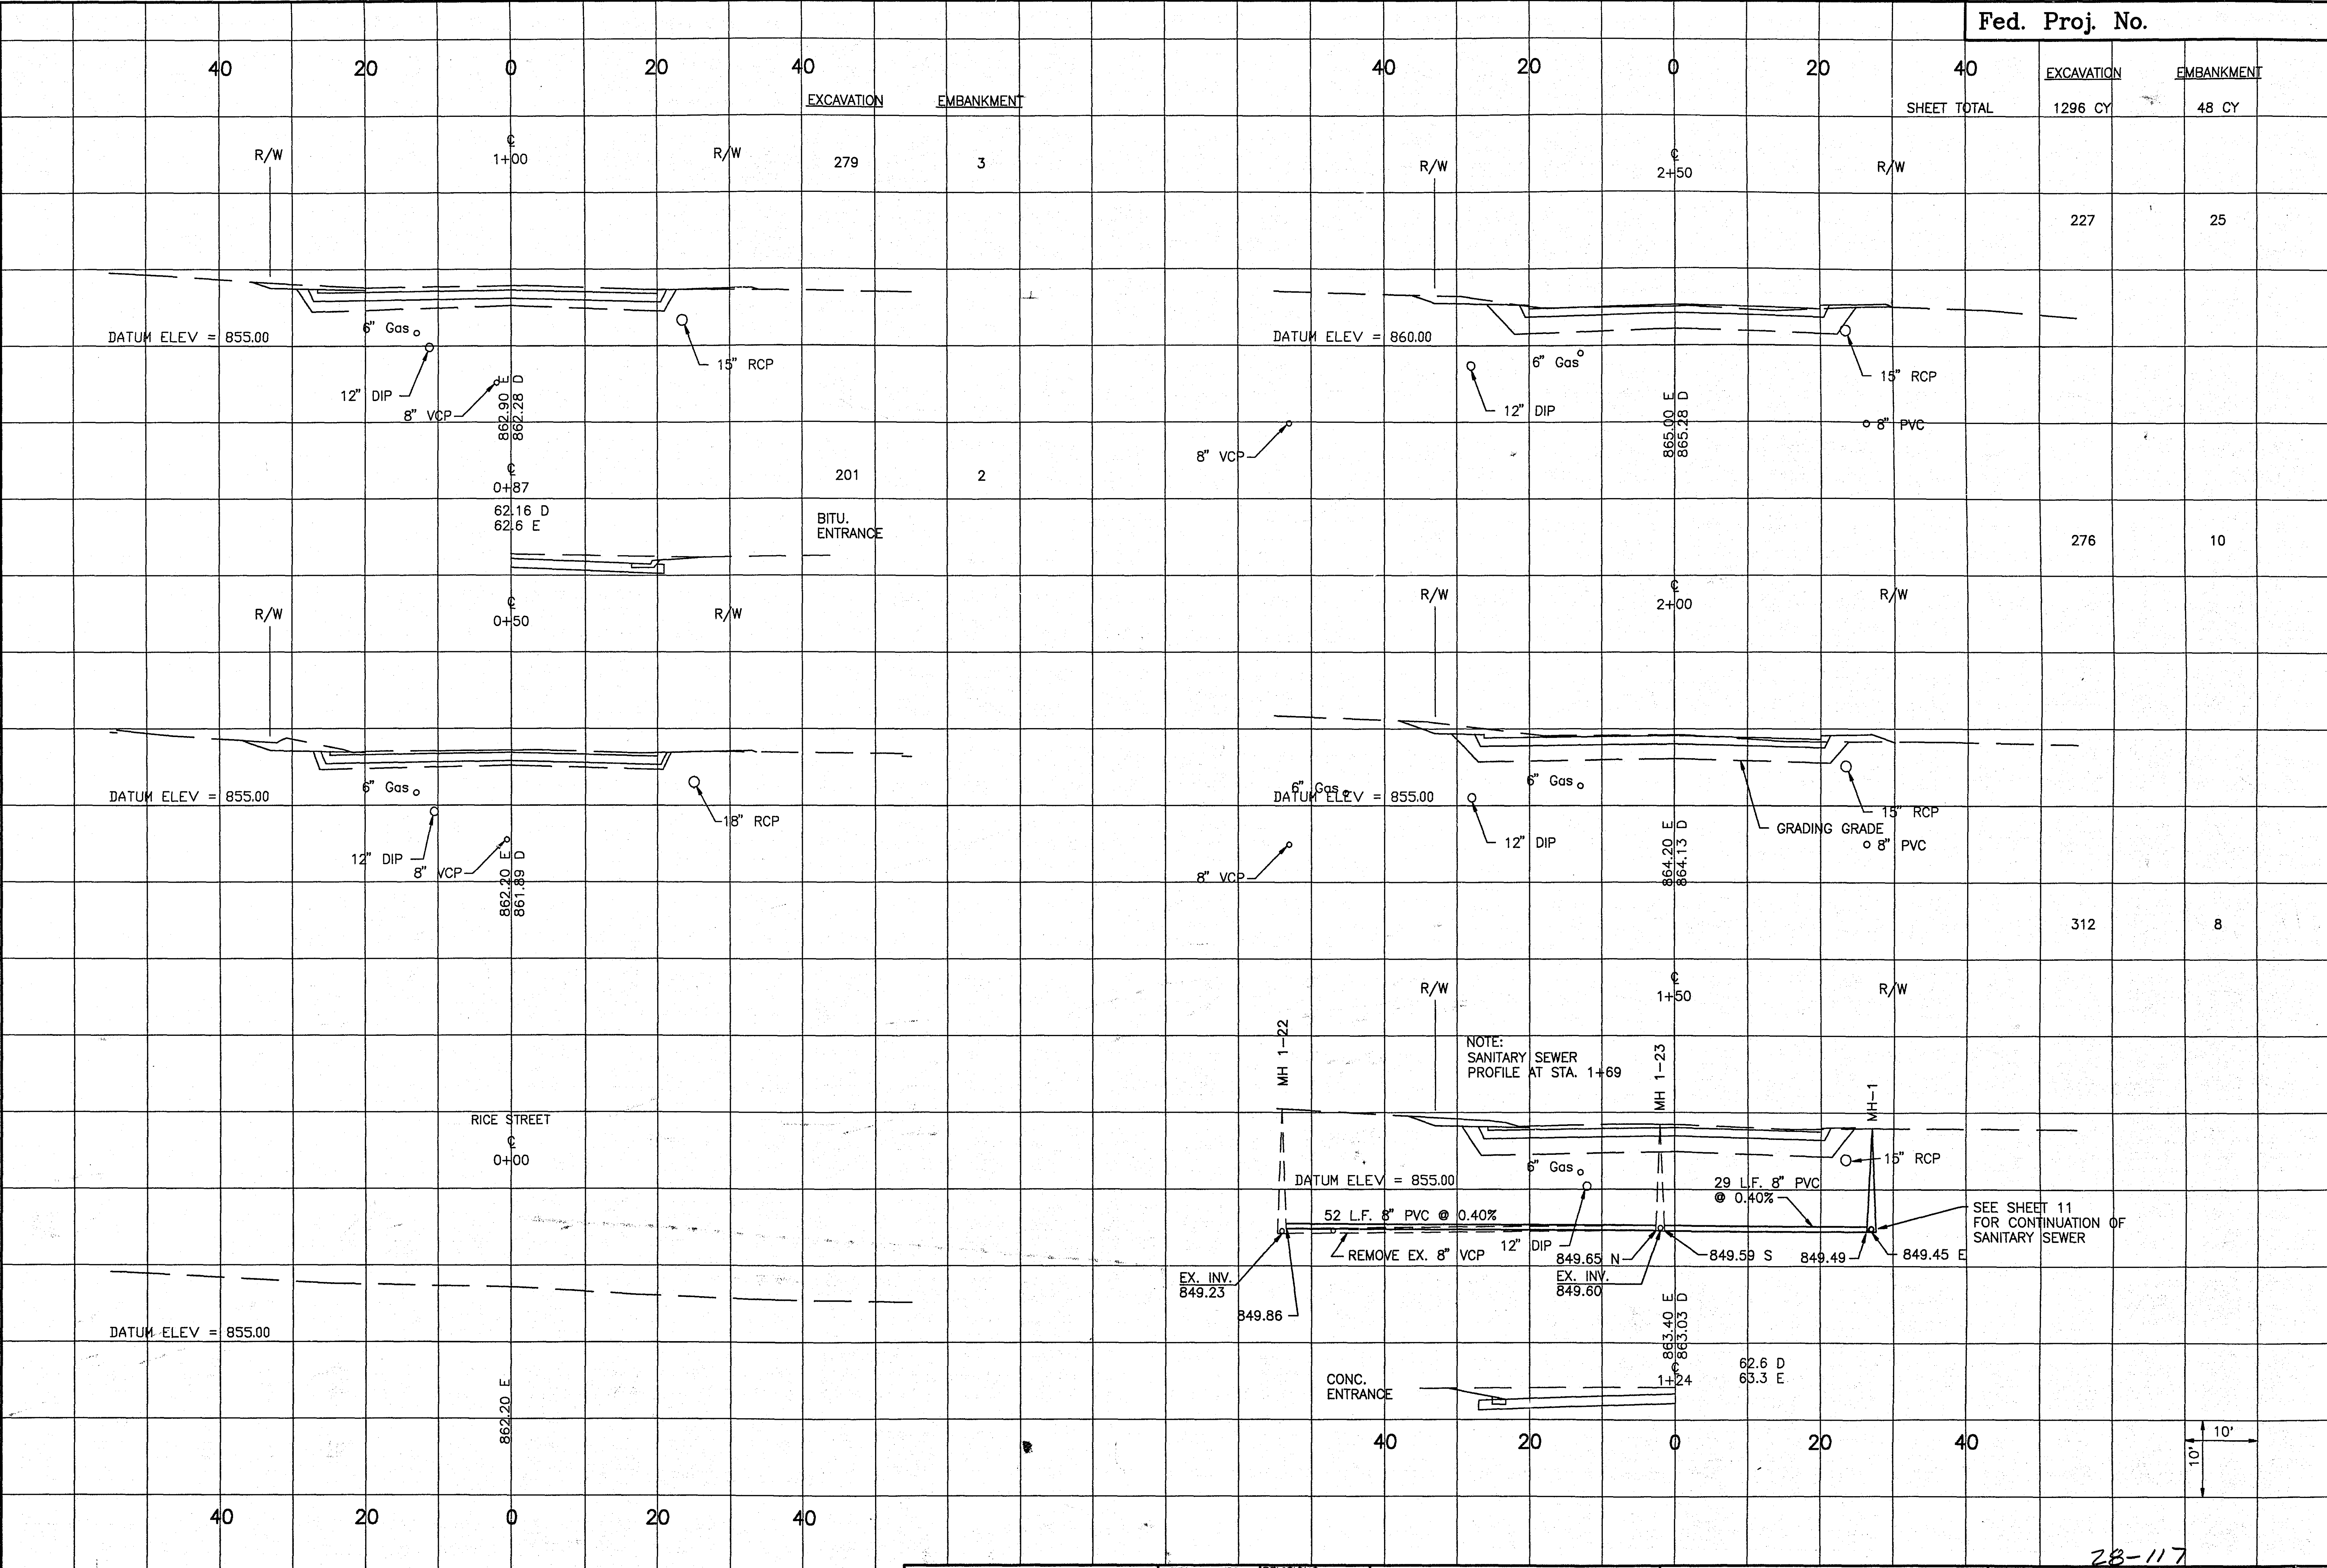

Fed. Proj. No.

EXCAVATION EMBANKMENT

SHEET TOTAL

1296 CY

48 CY

227

25

276

10

312

8

NOTE:
SANITARY SEWER
PROFILE AT STA. 1+69

SEE SHEET 11
FOR CONTINUATION OF
SANITARY SEWER

©BONESTROO, ROSENE, ANDERLIK &
ASSOCIATES, INC. 1989

SURVEY HBR
DRAWN OFD
DESIGN TWP
APPROVED MLS

REVISIONS

BONESTROO, ROSENE, ANDERLIK & ASSOC., INC.
ENGINEERS & ARCHITECTS
St. Paul, Minnesota

RAMSEY COUNTY, MINNESOTA


DATE: OCT. 19, 1989

COMM. 21802


28-117
ROSELAWN AVENUE
X-SECTIONS
Sta. 0+00 to Sta. 2+50

S.A.P. 62-626-04


SHEET
14
24

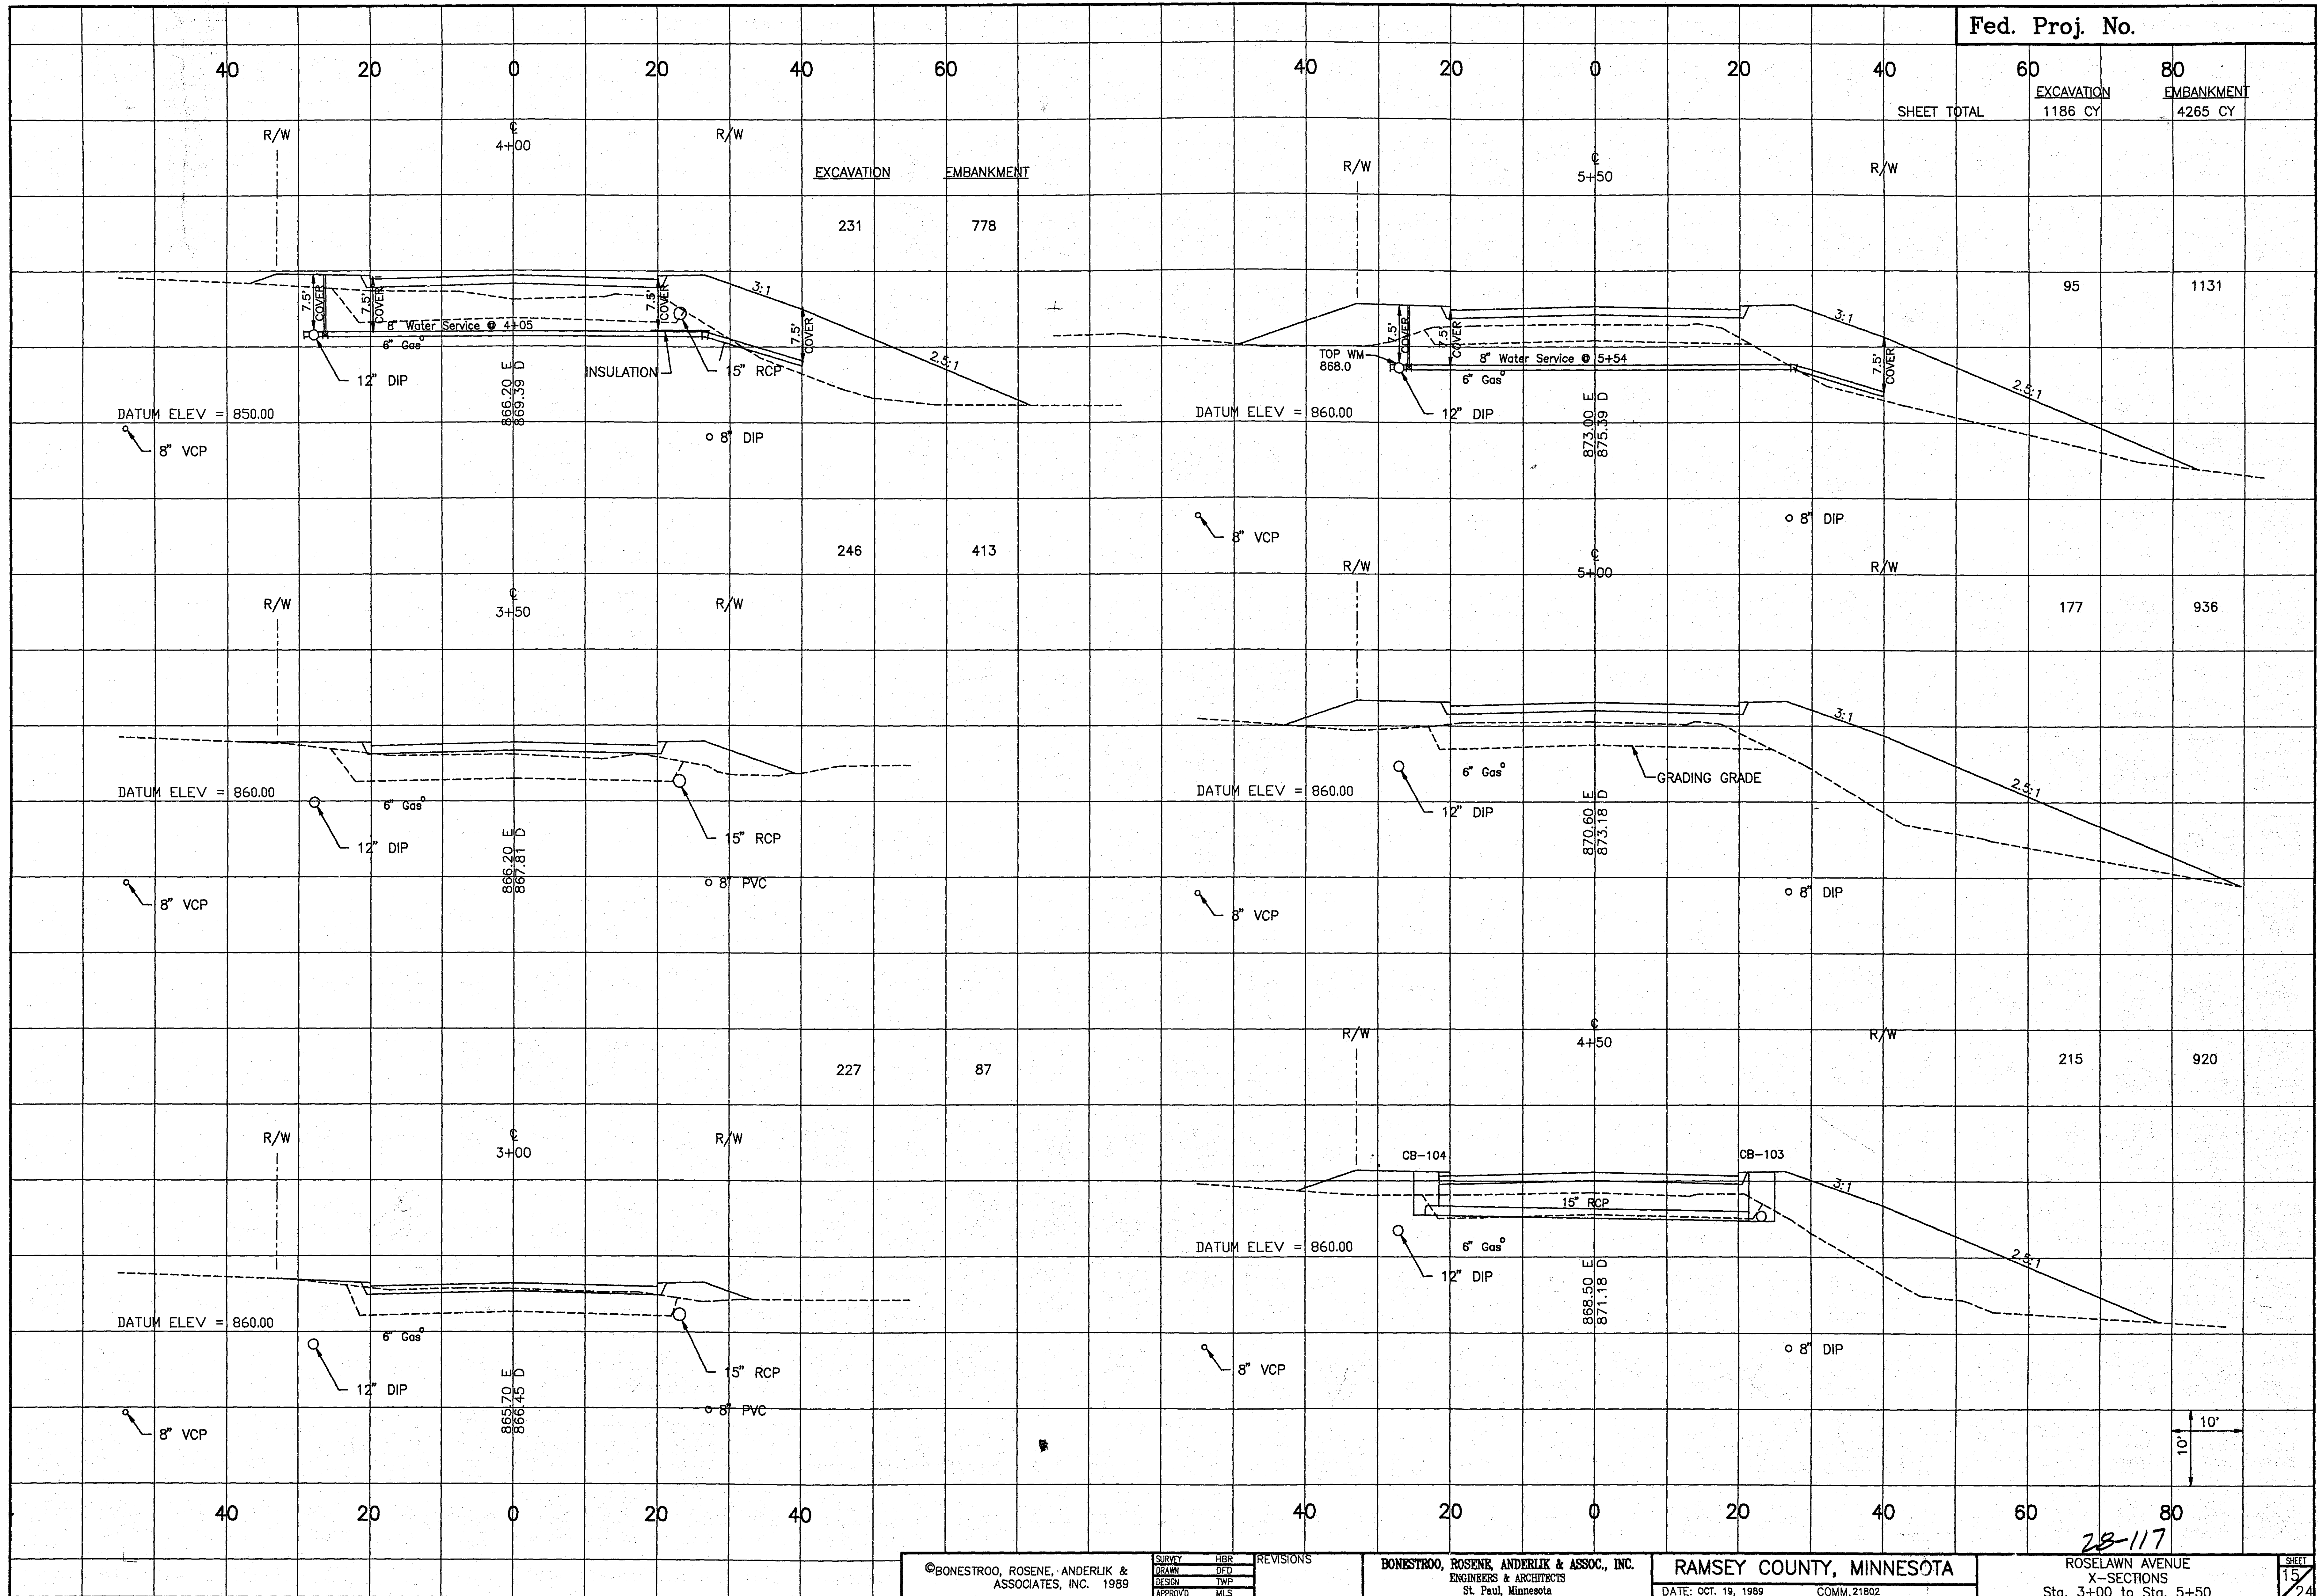


EXCAVATION	EMBANKMENT
347 CY	8550 CY

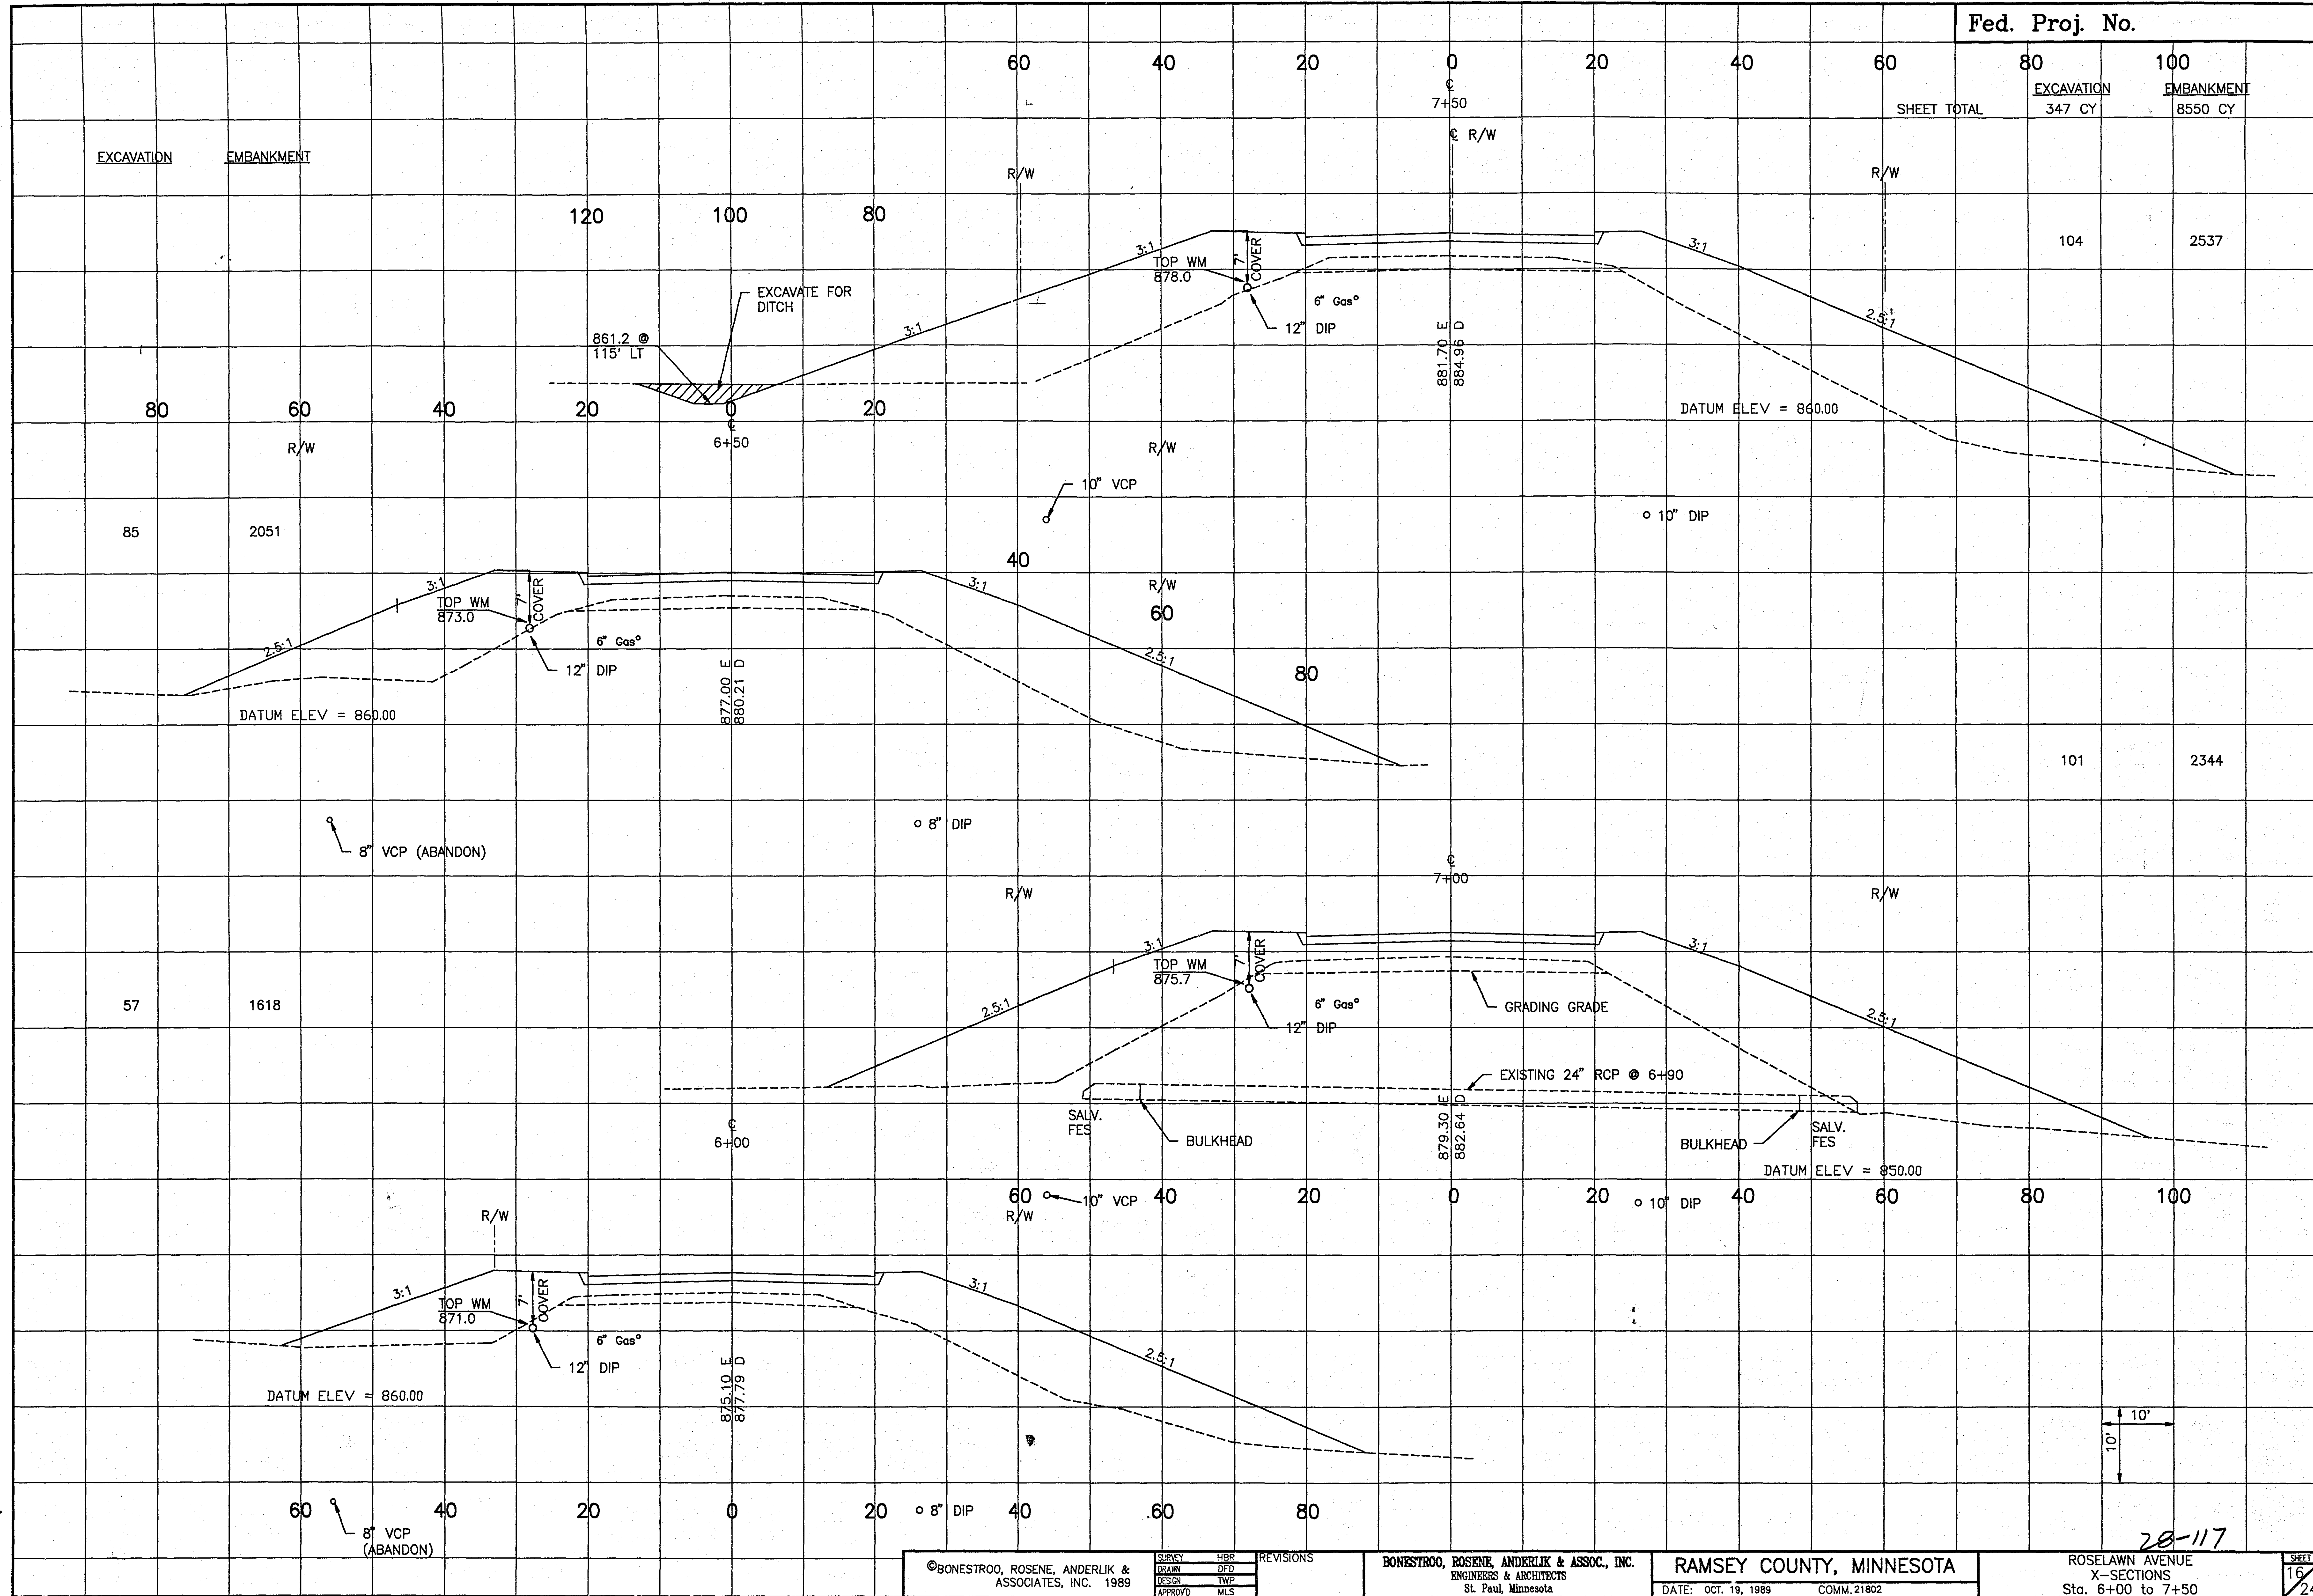

20-117

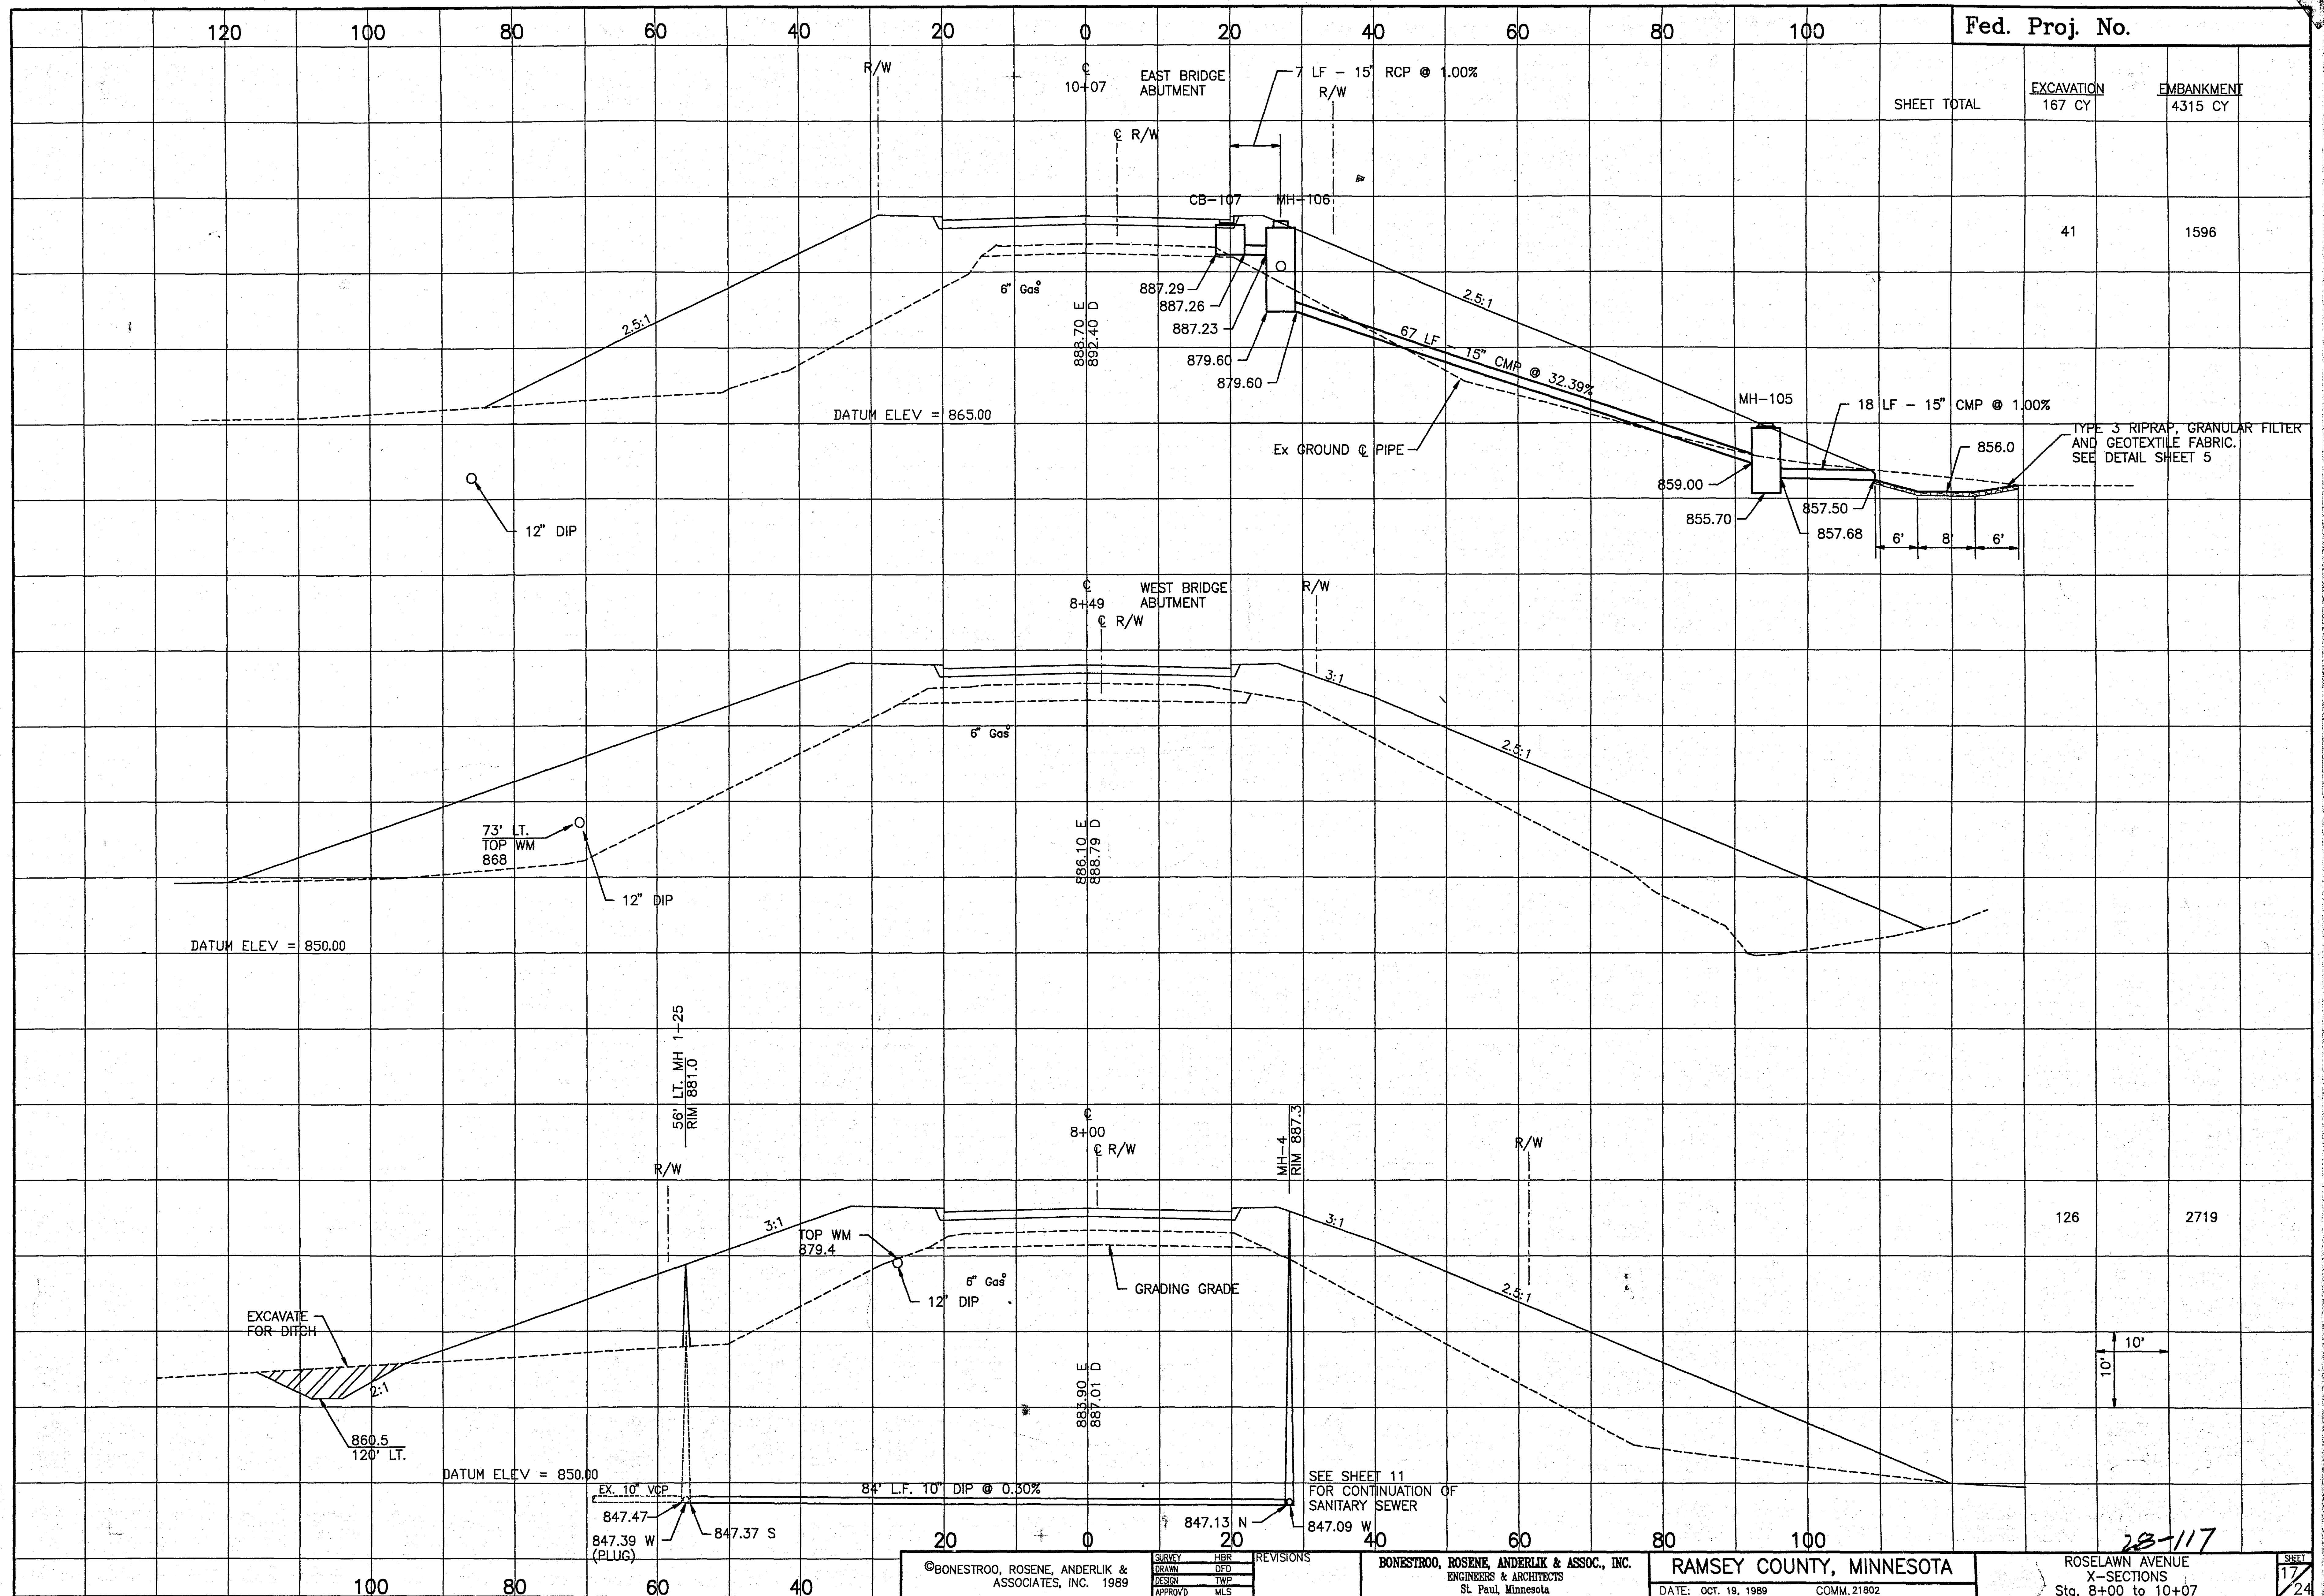

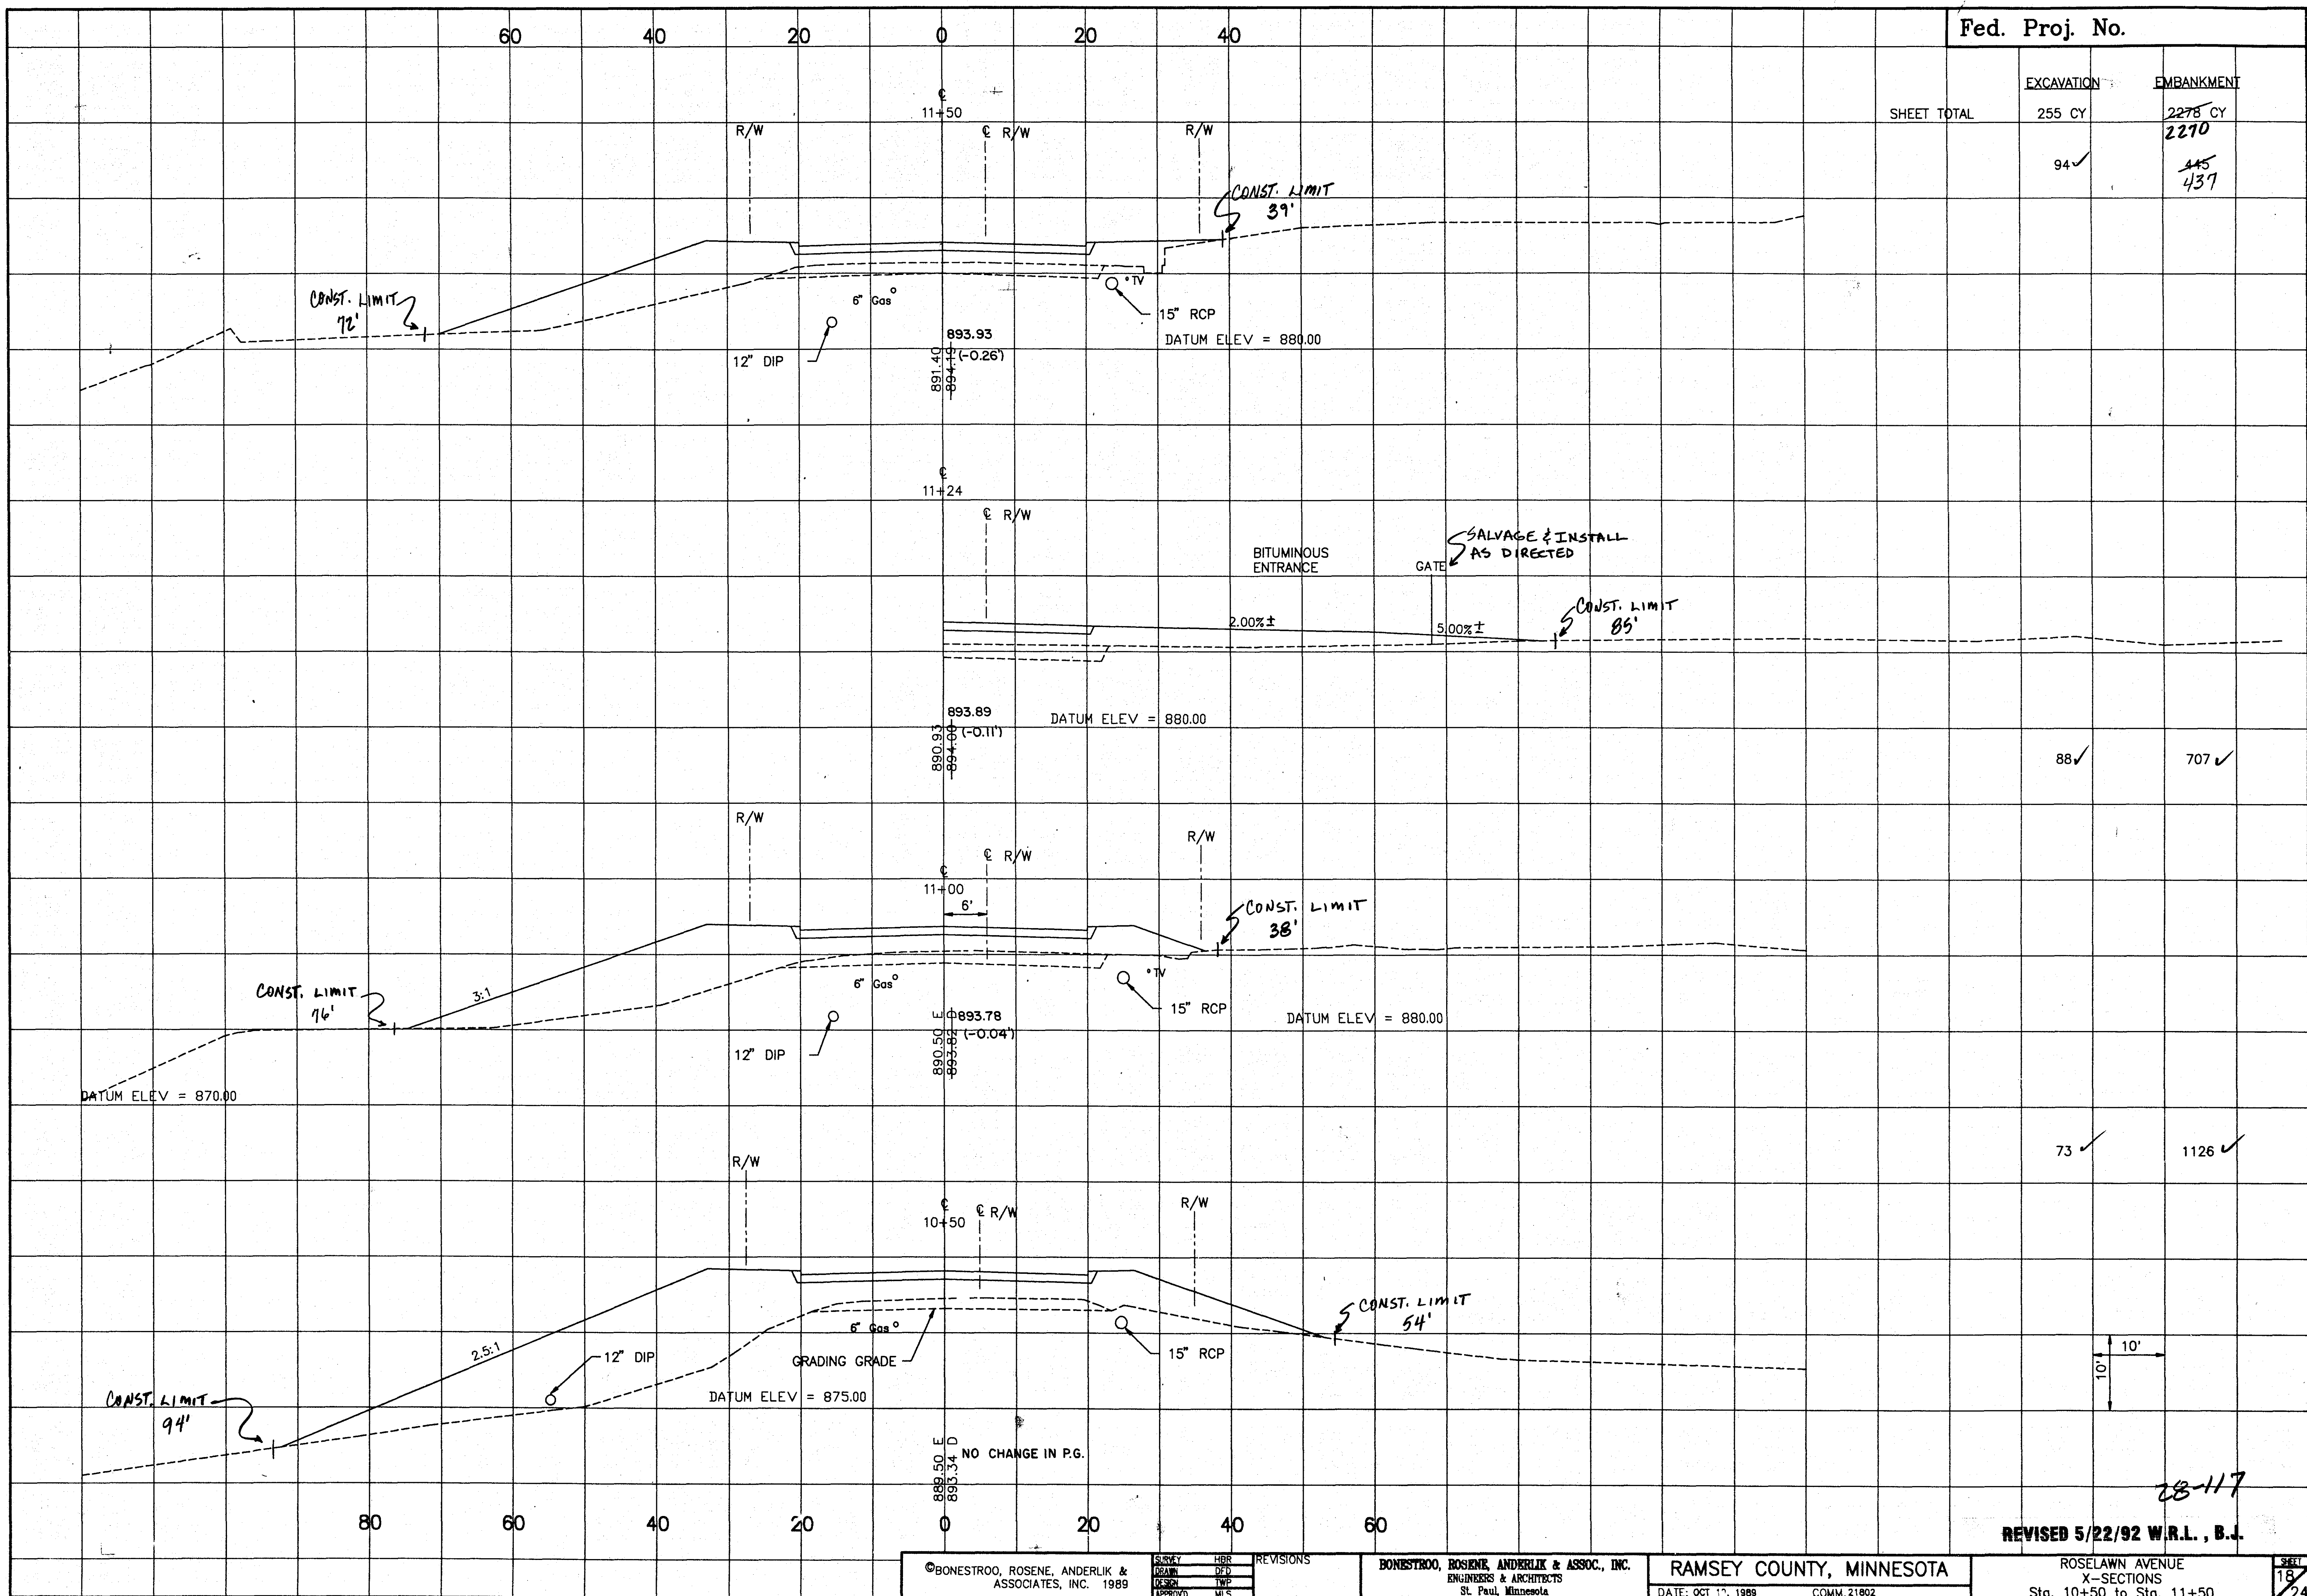

Fed. Proj. No.

EXCAVATION EMBANKMENT

SHEET TOTAL

255 CY

2278 CY

94✓

2270
445
437

88✓

707✓

73✓

1126✓

REVISED 5/22/92 W.R.L., B.J.

©BONESTROO, ROSENE, ANDERLIK & ASSOCIATES, INC. 1989

REVISIONS
SURVEY HBR
DRAWN DFD
DESIGN TWP
APPROVED MJS

BONESTROO, ROSENE, ANDERLIK & ASSOC., INC.
ENGINEERS & ARCHITECTS
St. Paul, Minnesota


RAMSEY COUNTY, MINNESOTA

DATE: OCT 11, 1988

COMM. 21802

ROSELAWN AVENUE
X-SECTIONS
Sta. 10+50 to Sta. 11+50
S.A.P. 62-626-04

SHEET
18
24

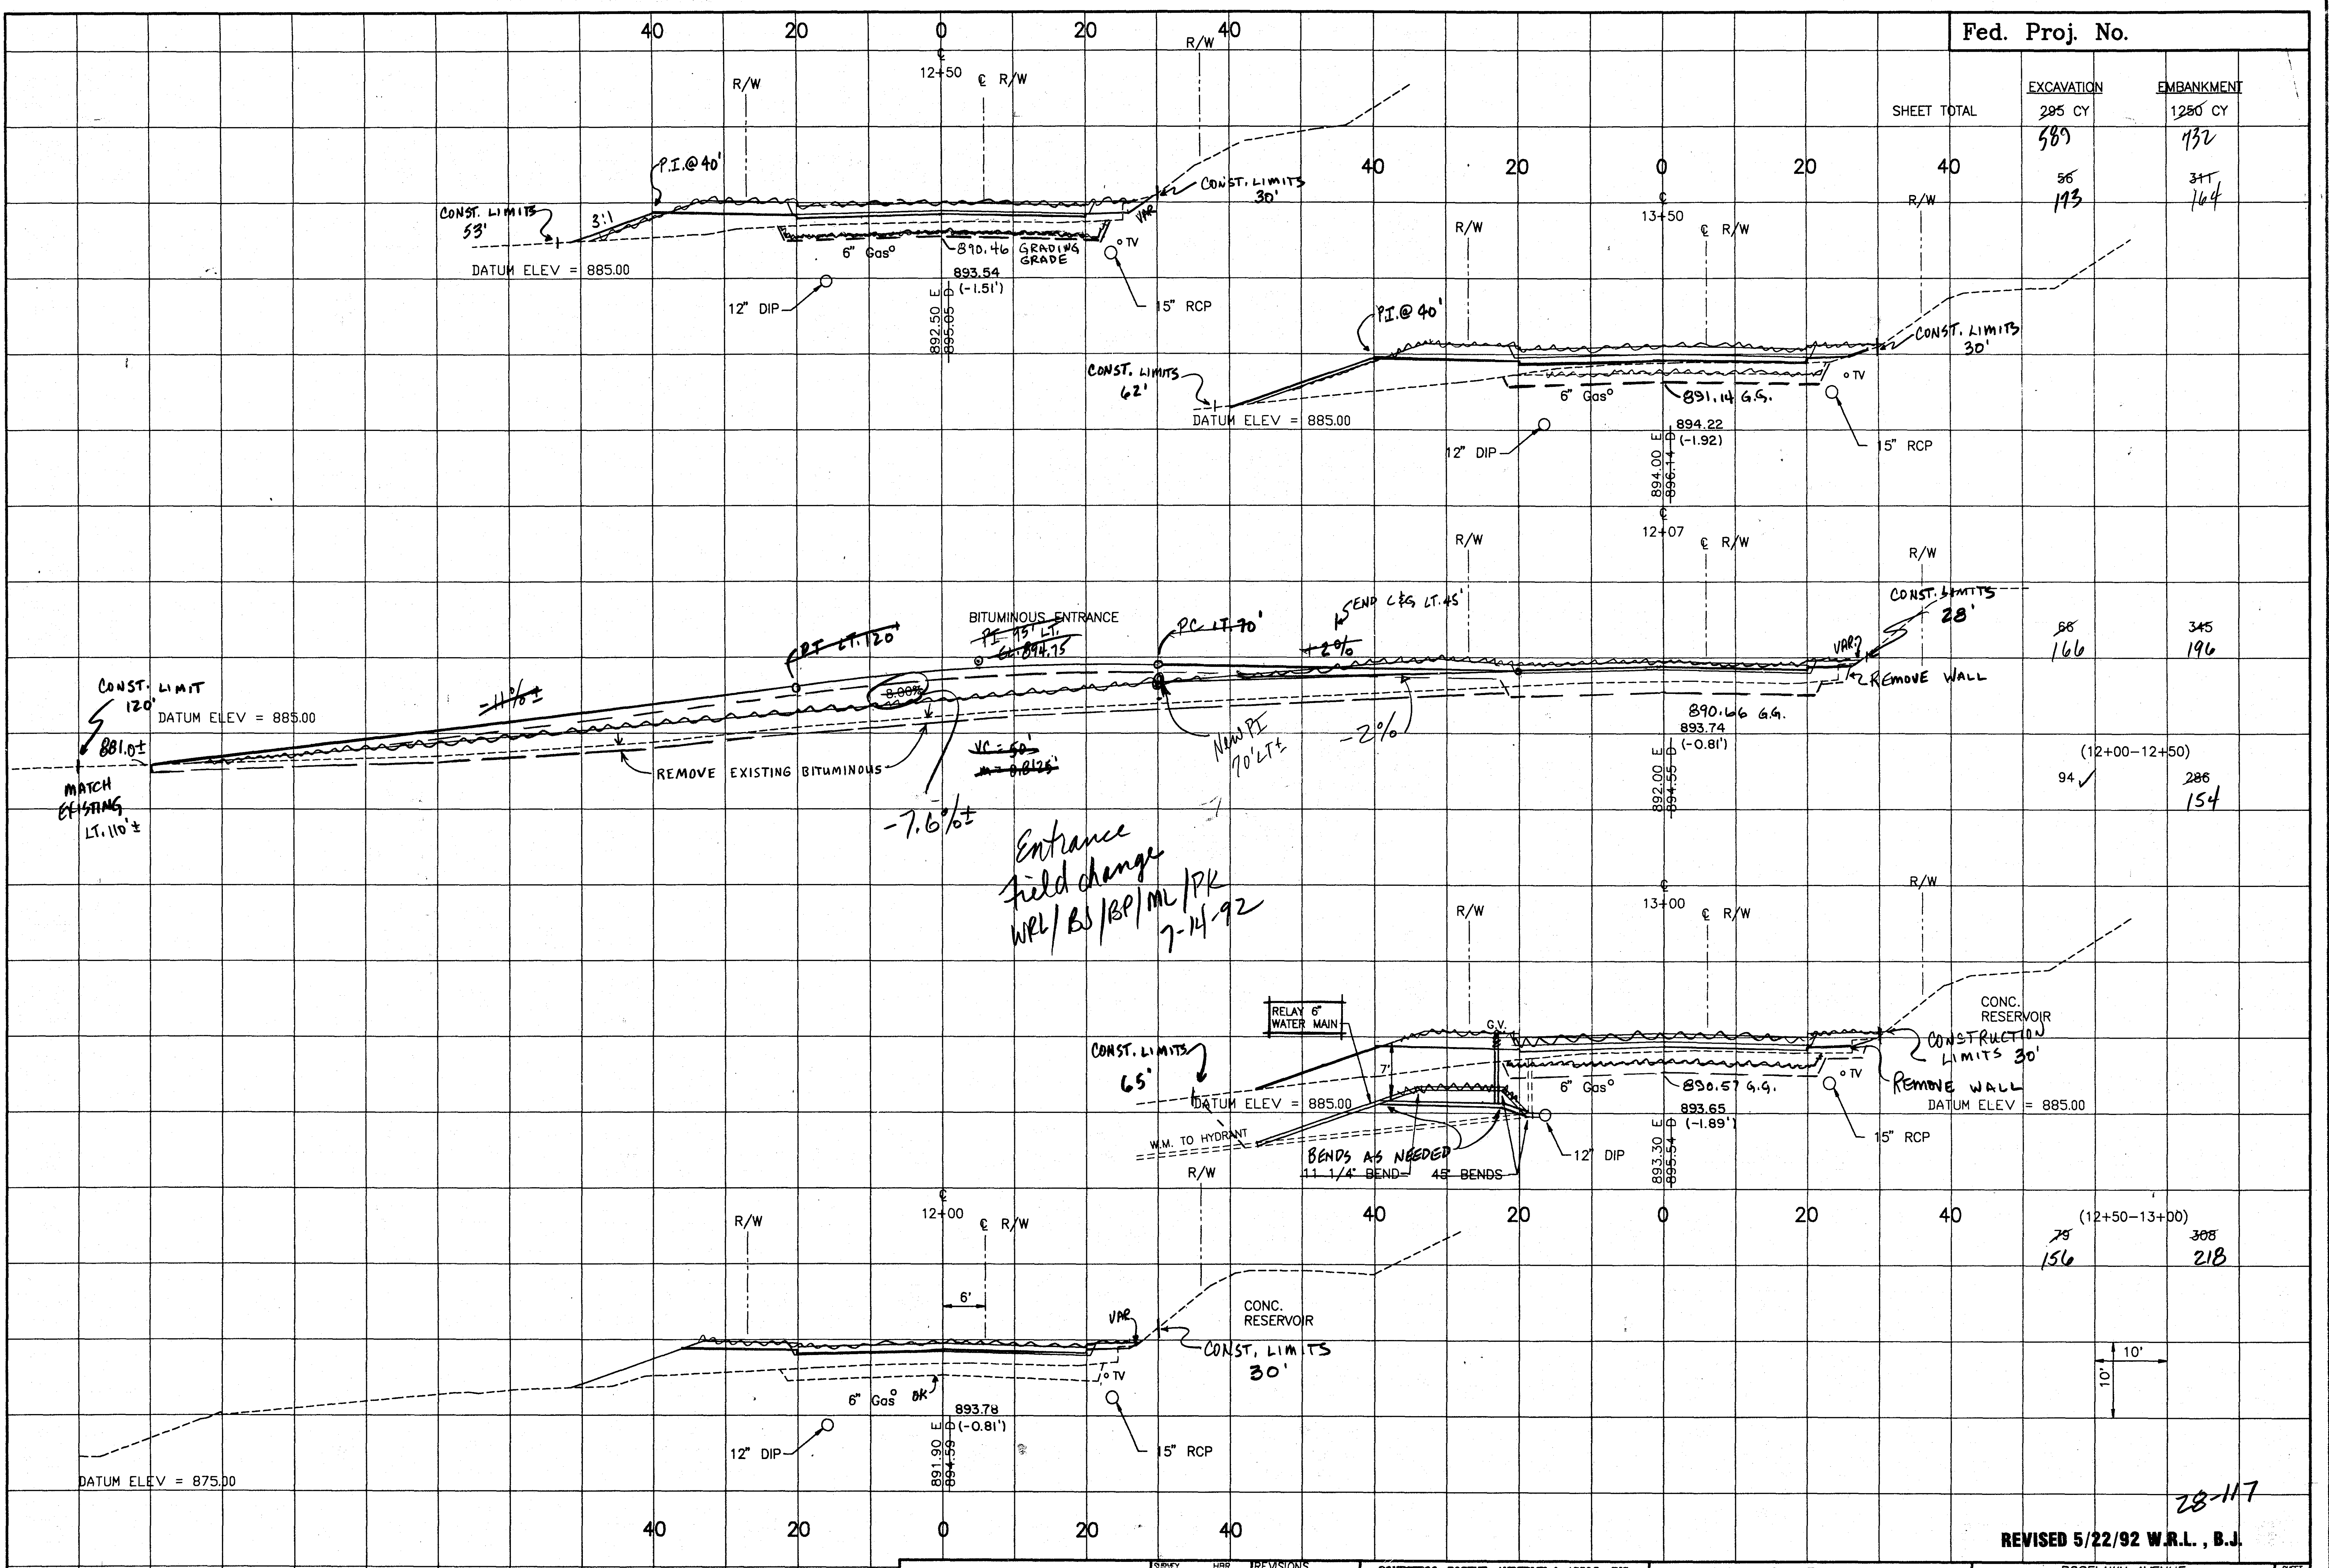

	EXCAVATION	EMBANKMENT
SHEET TOTAL	295 CY	1280 CY
	589	132
	56	311
	173	164

88	166	345	196
(12+00-12+50)	94	286	154

79	156	308	218
(12+50-13+00)			

Entrance
field change
WRL/BS/BP/ML/PK
7-14-92

28-117

REVISED 5/22/92 W.R.L., B.J.


©BONESTROO, ROSENE, ANDERLIK & ASSOCIATES, INC. 1989


REVISIONS	DATE	BY	CHKD
1		WRL	BS
2		BP	ML
3		PK	

BONESTROO, ROSENE, ANDERLIK & ASSOC., INC.
ENGINEERS & ARCHITECTS
St. Paul, Minnesota


RAMSEY COUNTY, MINNESOTA
DATE: OCT. 19, 1989 COMM. 21802

ROSELAWN AVENUE
X-SECTIONS
Sta. 12+00 to Sta. 13+50
S.A.P. 62-626-04

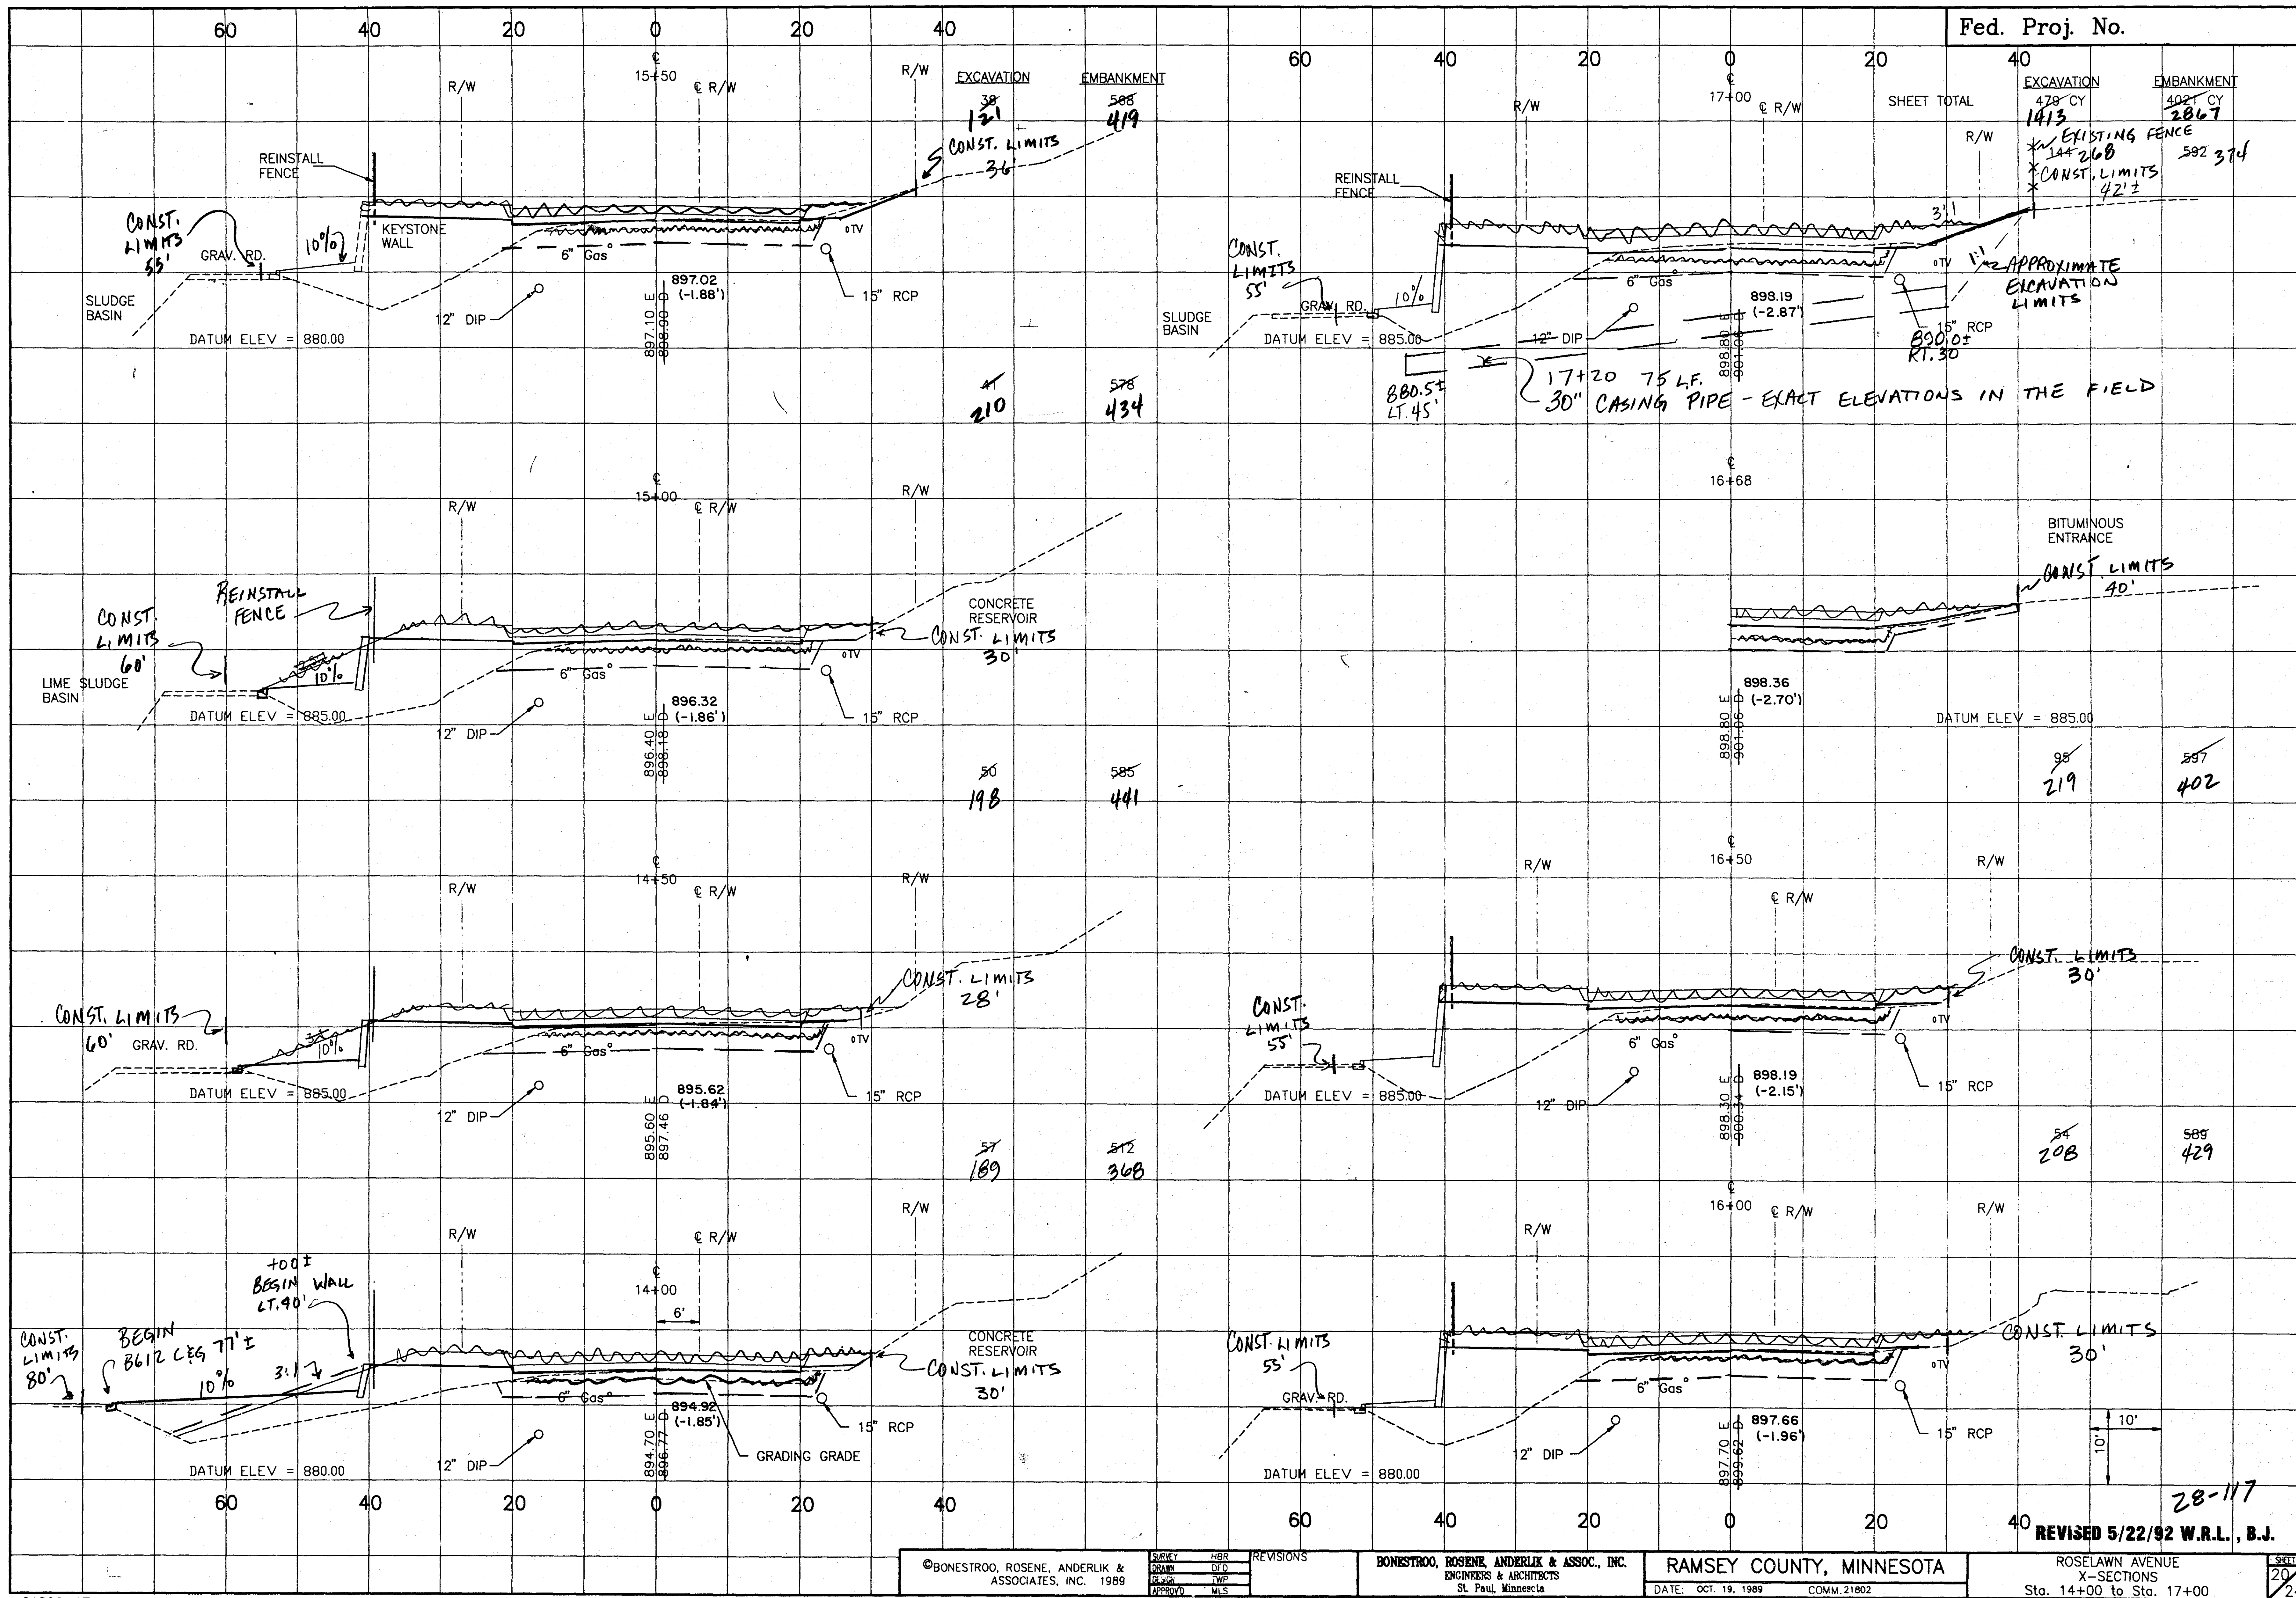

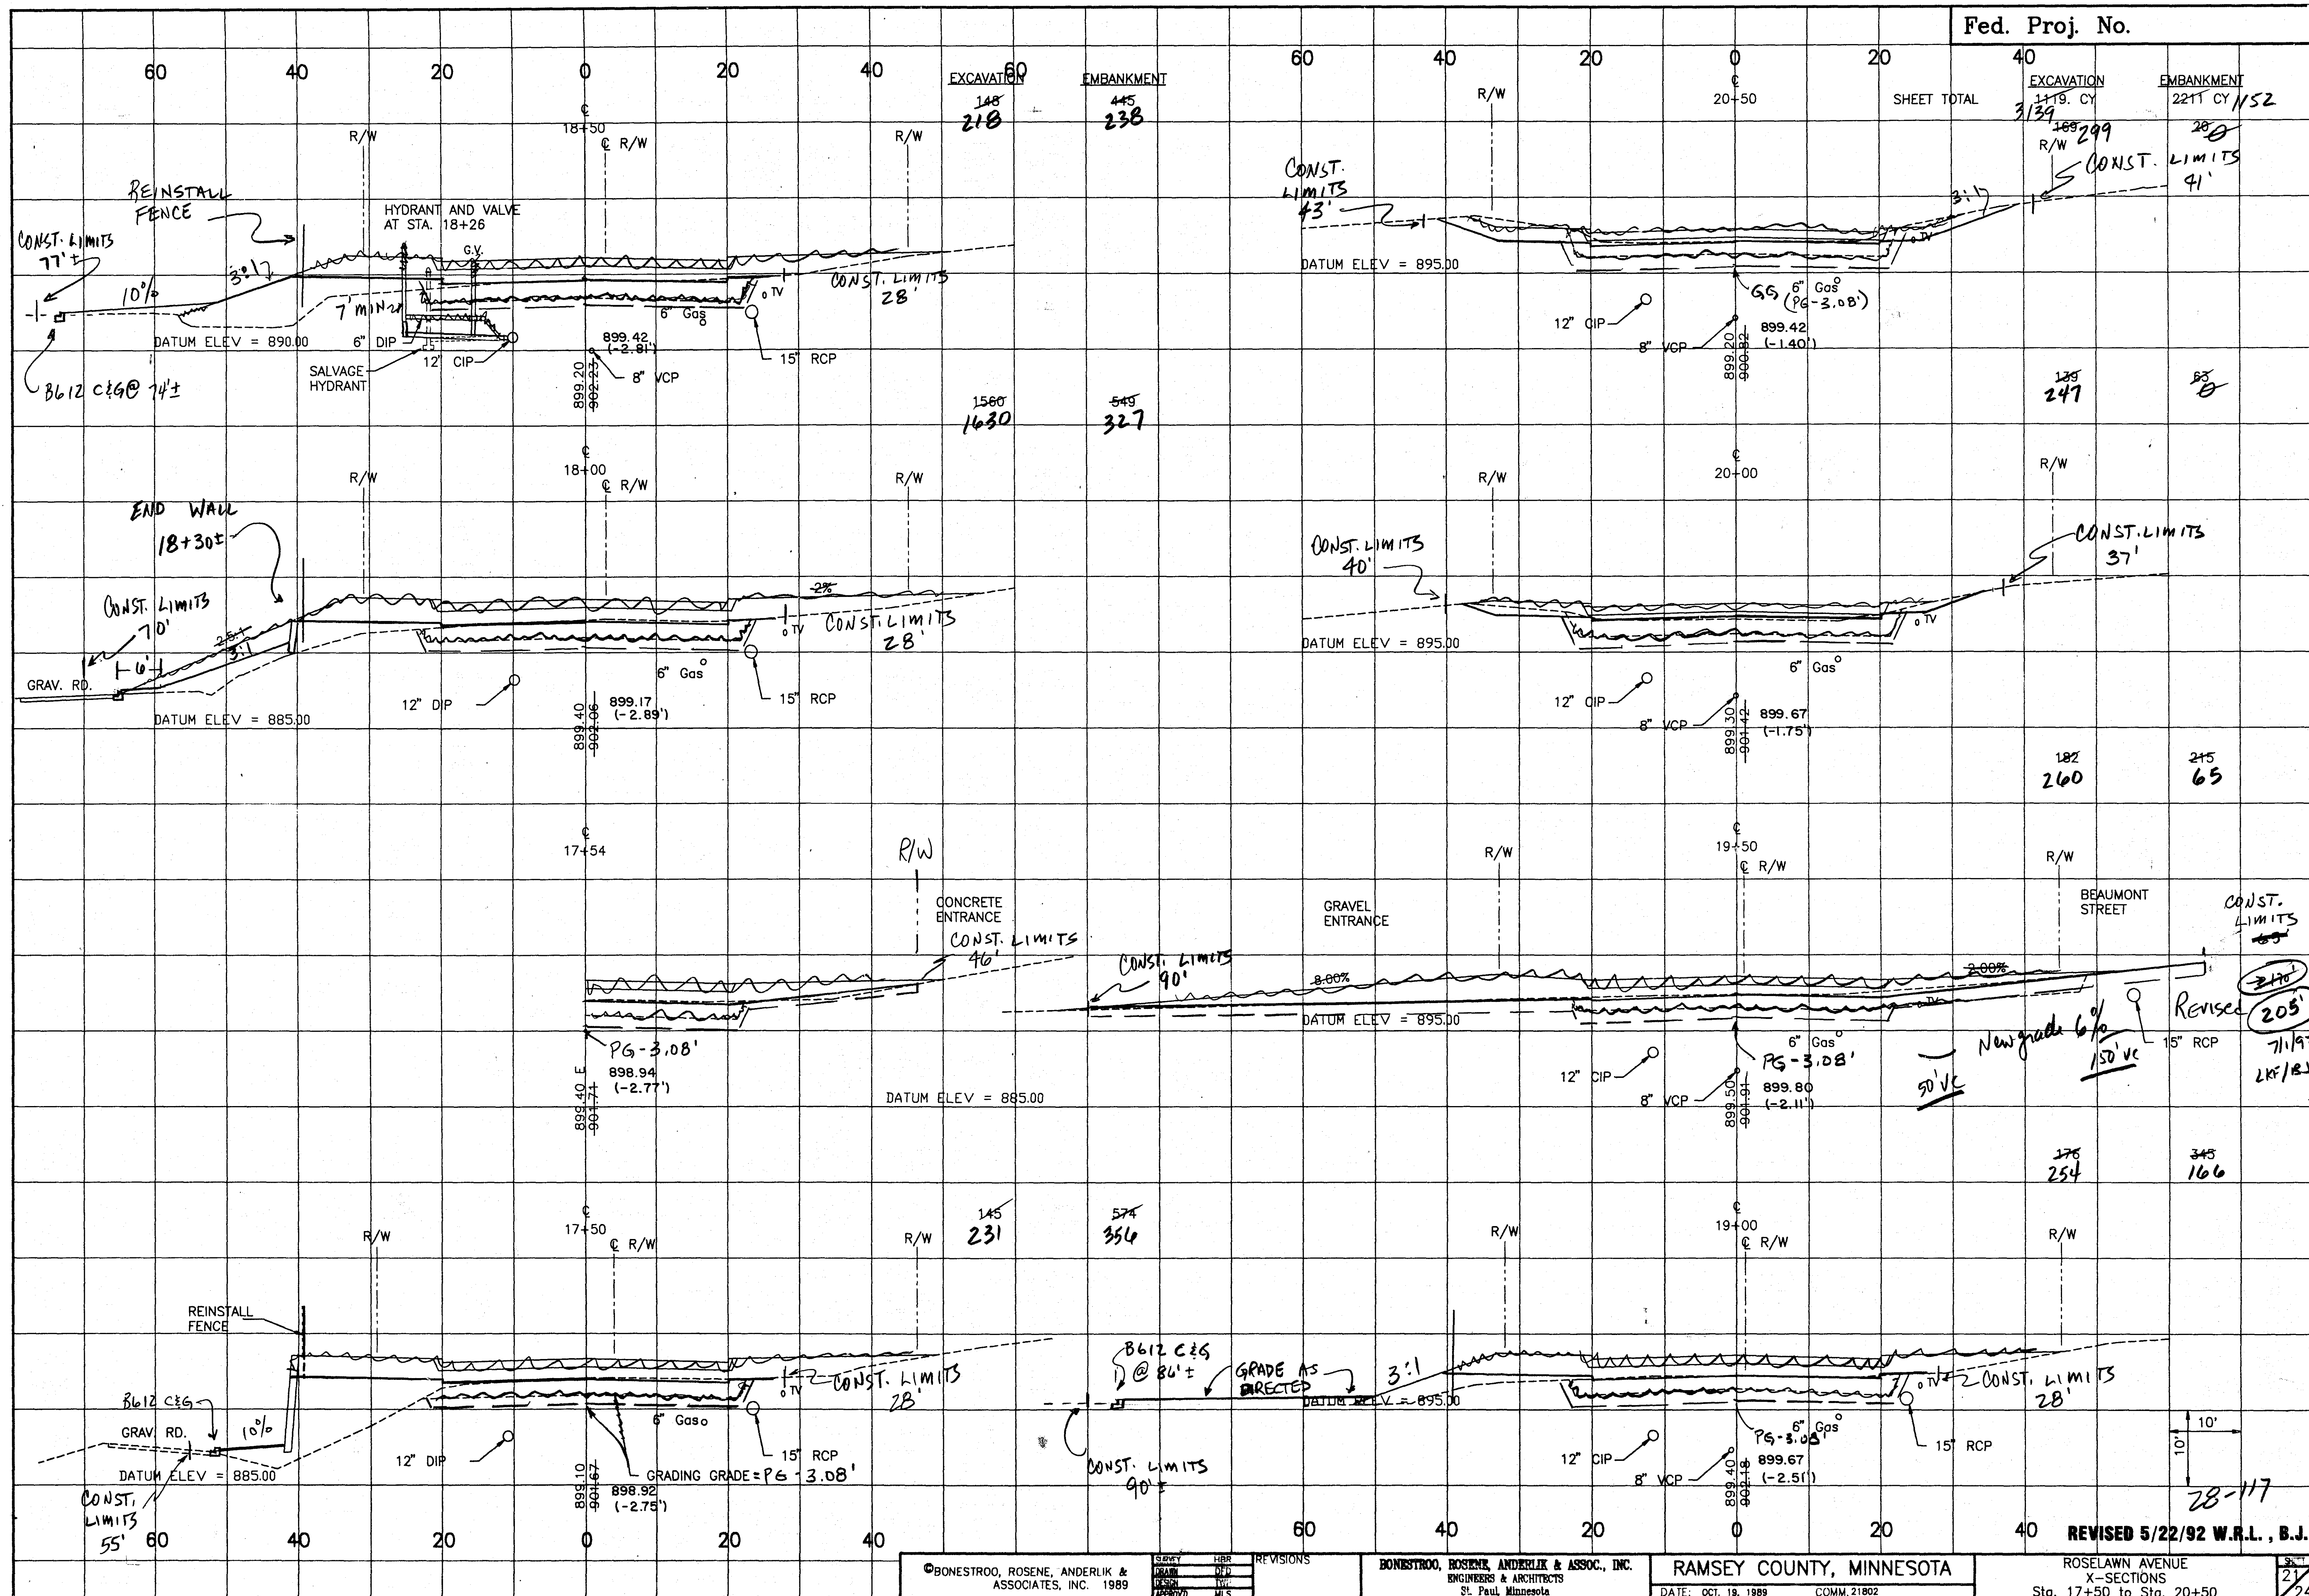

EXCAVATION	EMBANKMENT
1001 CY	5 CY
1343	0

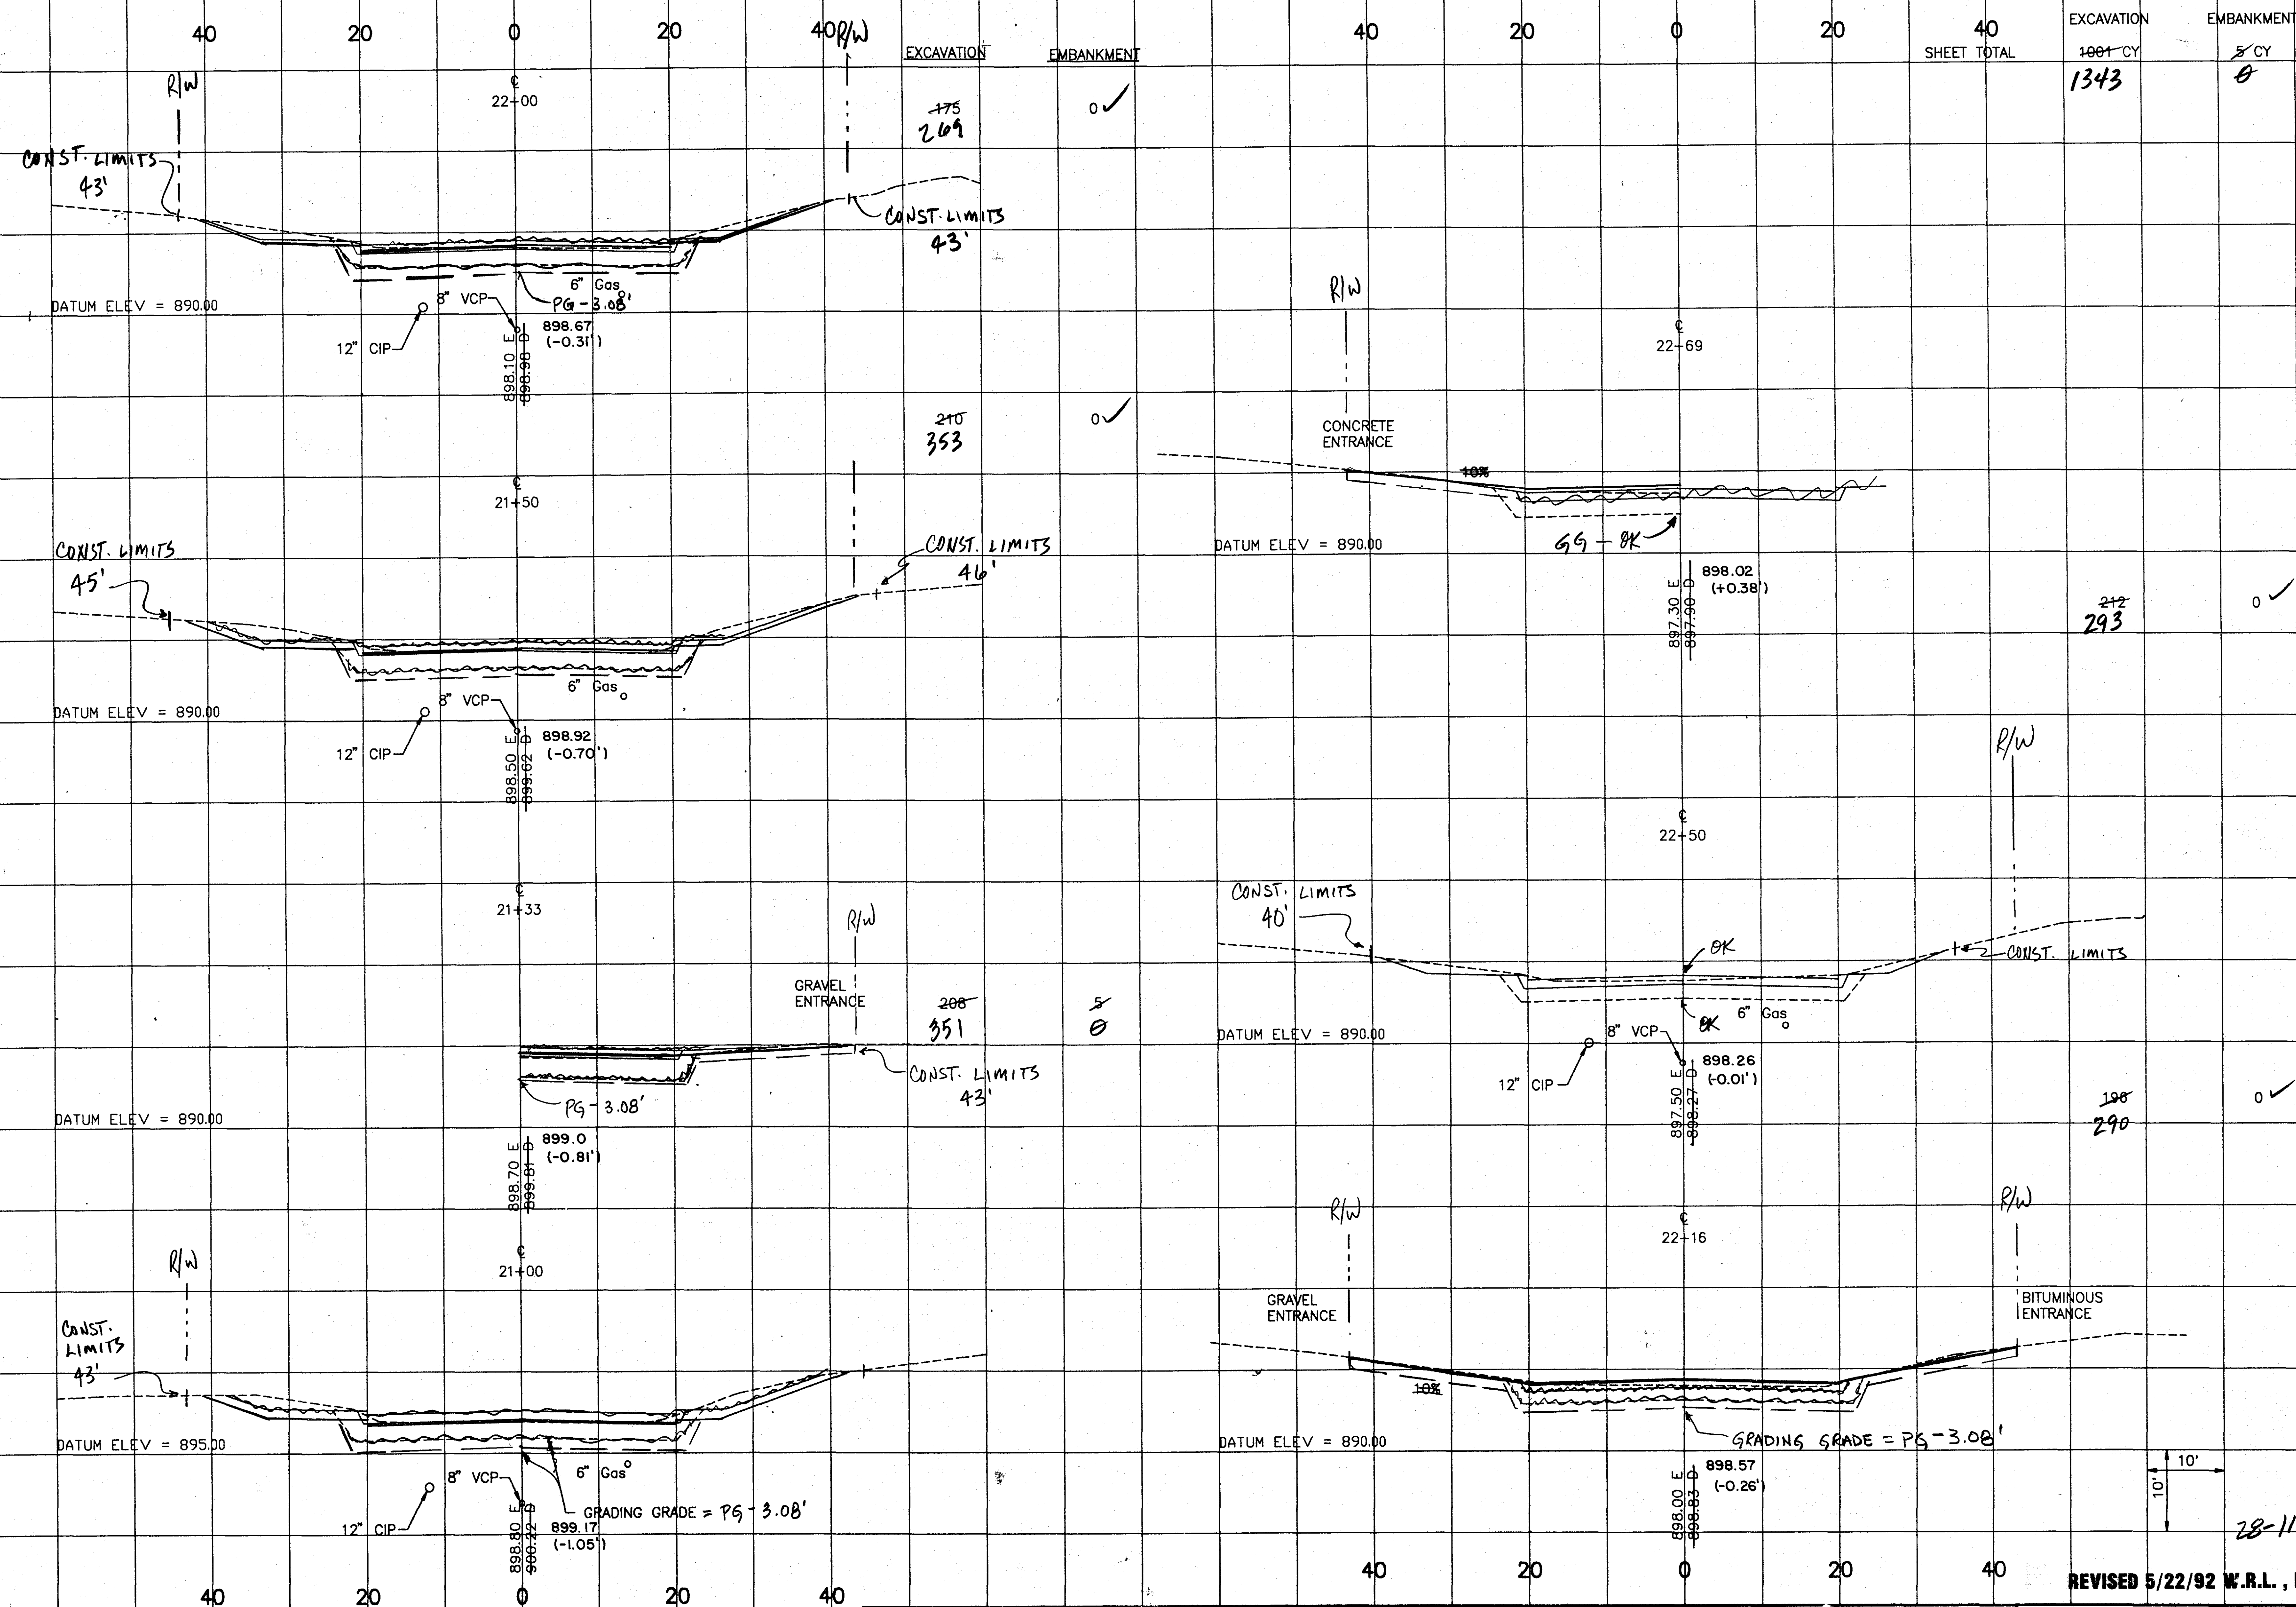

Fed. Proj. No.

	EXCAVATION	EMBANKMENT
SHEET TOTAL	383 CY	0 ✓
	426	
PROJECT TOTALS	6445 CY	28943 CY

REVISED EARTHWORK SUMMARY 5/22/92


ORIGINAL QUANTITIES	ELC.	EMBANKMENT
	6445 CY	24943 CY
REVISIONS 5/22	+3714 CY	- 2597 CY
	10,159 CY	24,346 CY

COMMON ELC.
 $3714 \text{ CY} \div 2 (\text{SHRINKAGE \& UNSUITABLE}) = 1857 \text{ CY}$
 MATERIAL



∴ 1857 CY USABLE AS EMBANKMENT

EMBANKMENT
 $2597 \text{ CY} \times 1.3 (\text{COMPACTION}) = 3376 \text{ CY}$
 ∴ 3376 CY (LV) LESS COMMON BORROW

COMMON BORROW	
QUANTITY IN PLANS	32000 CY (LV)
REVISED EMBANKMENT	- 3376 CY (LV)
	28,624 CY (LV)
REVISED EXCAVATION	- 1,857 CY (LV)
TOTAL COMMON BORROW	26,767 CY (LV)

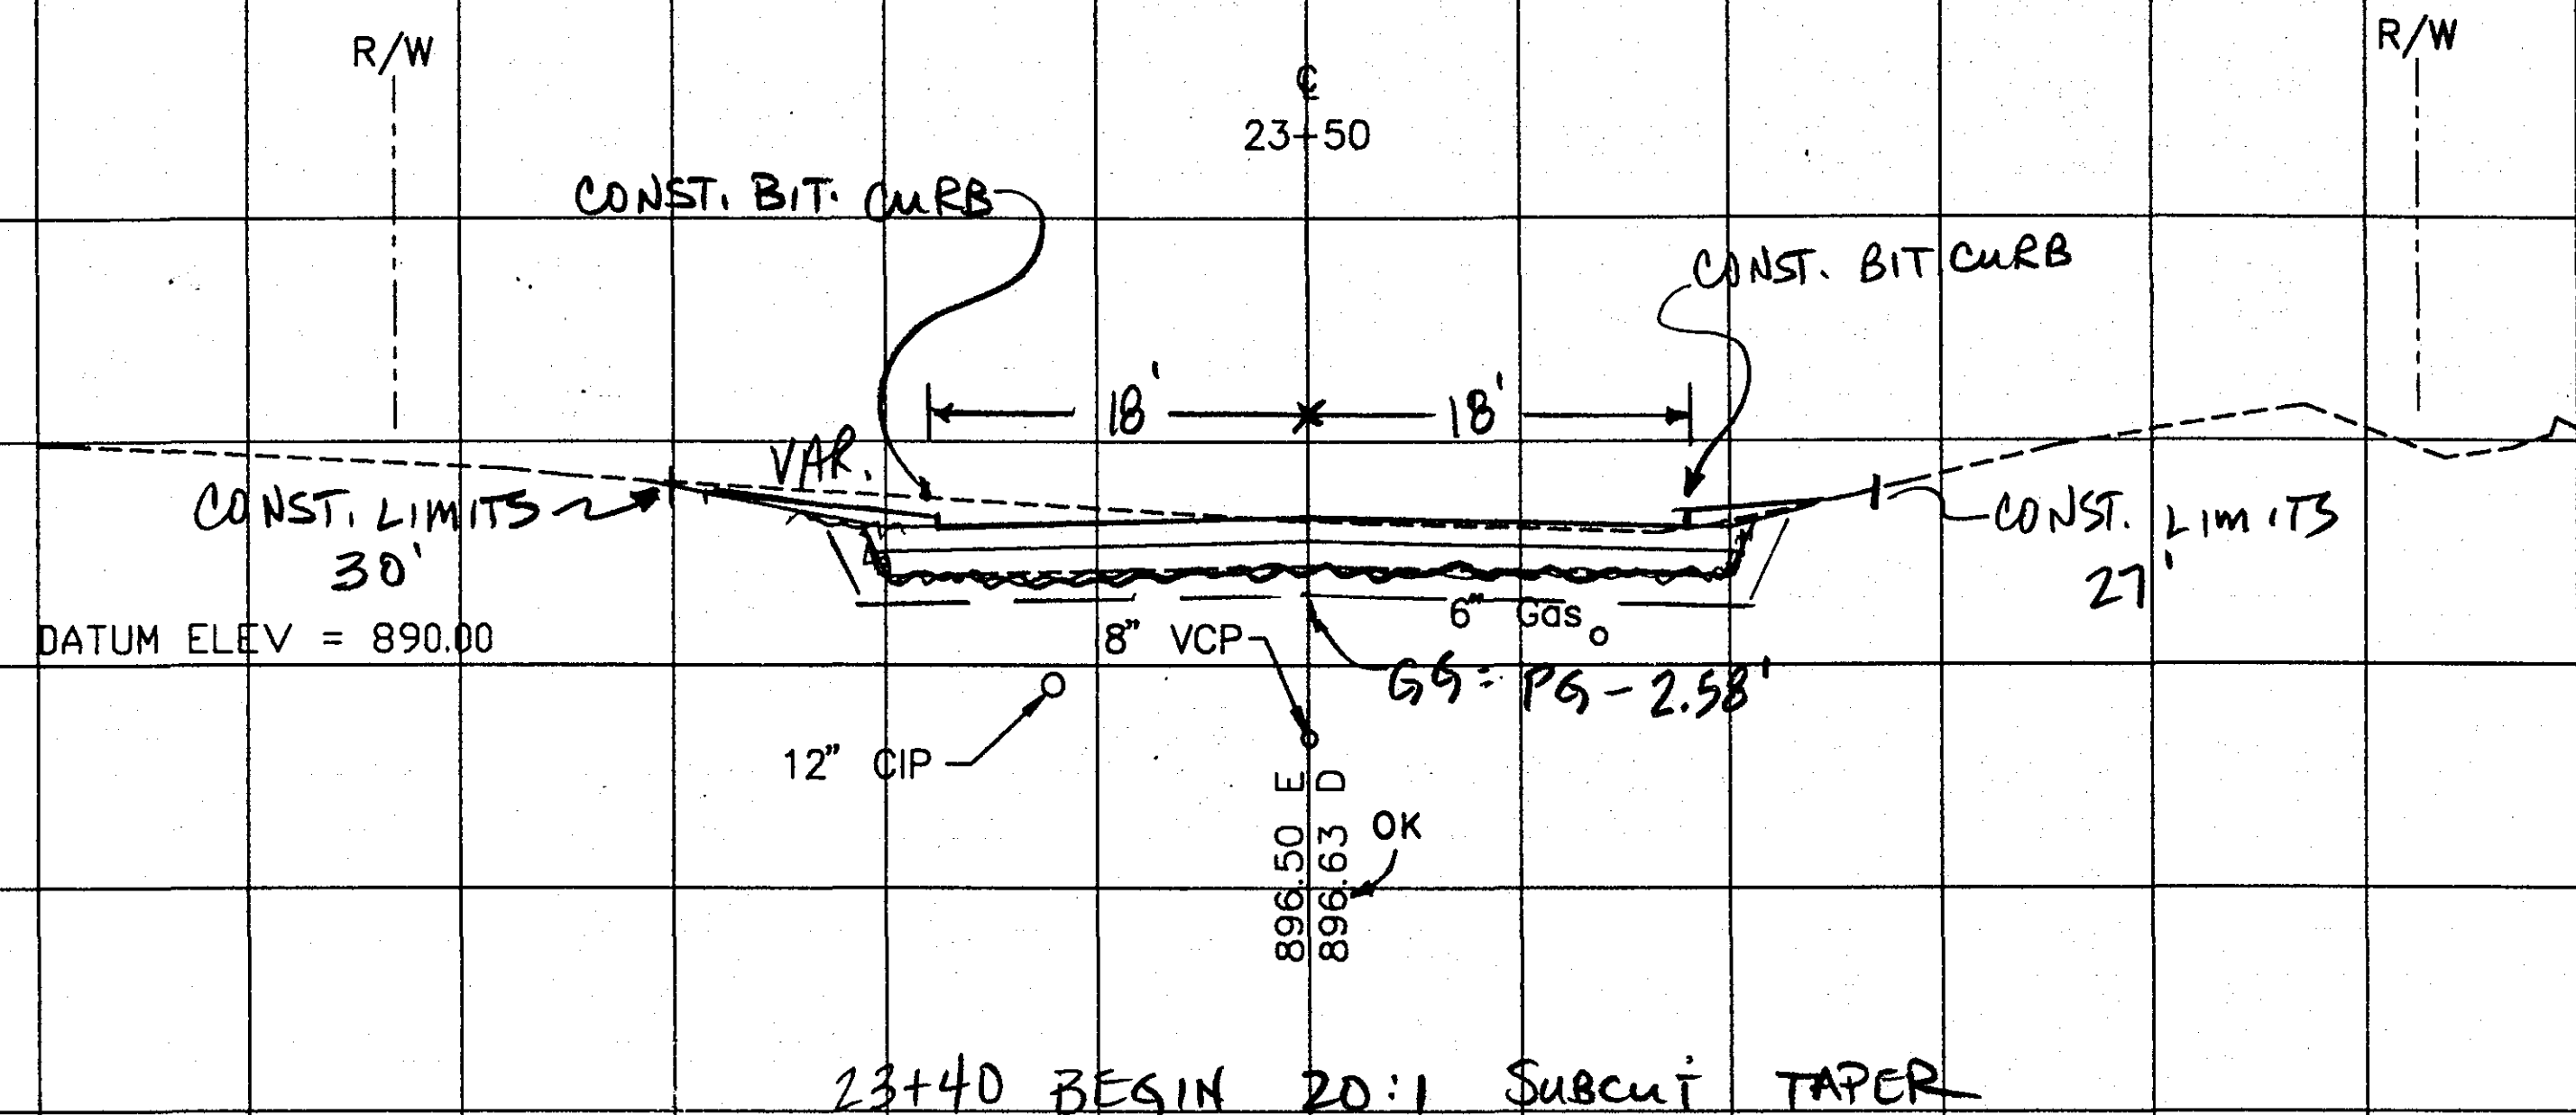

178
252

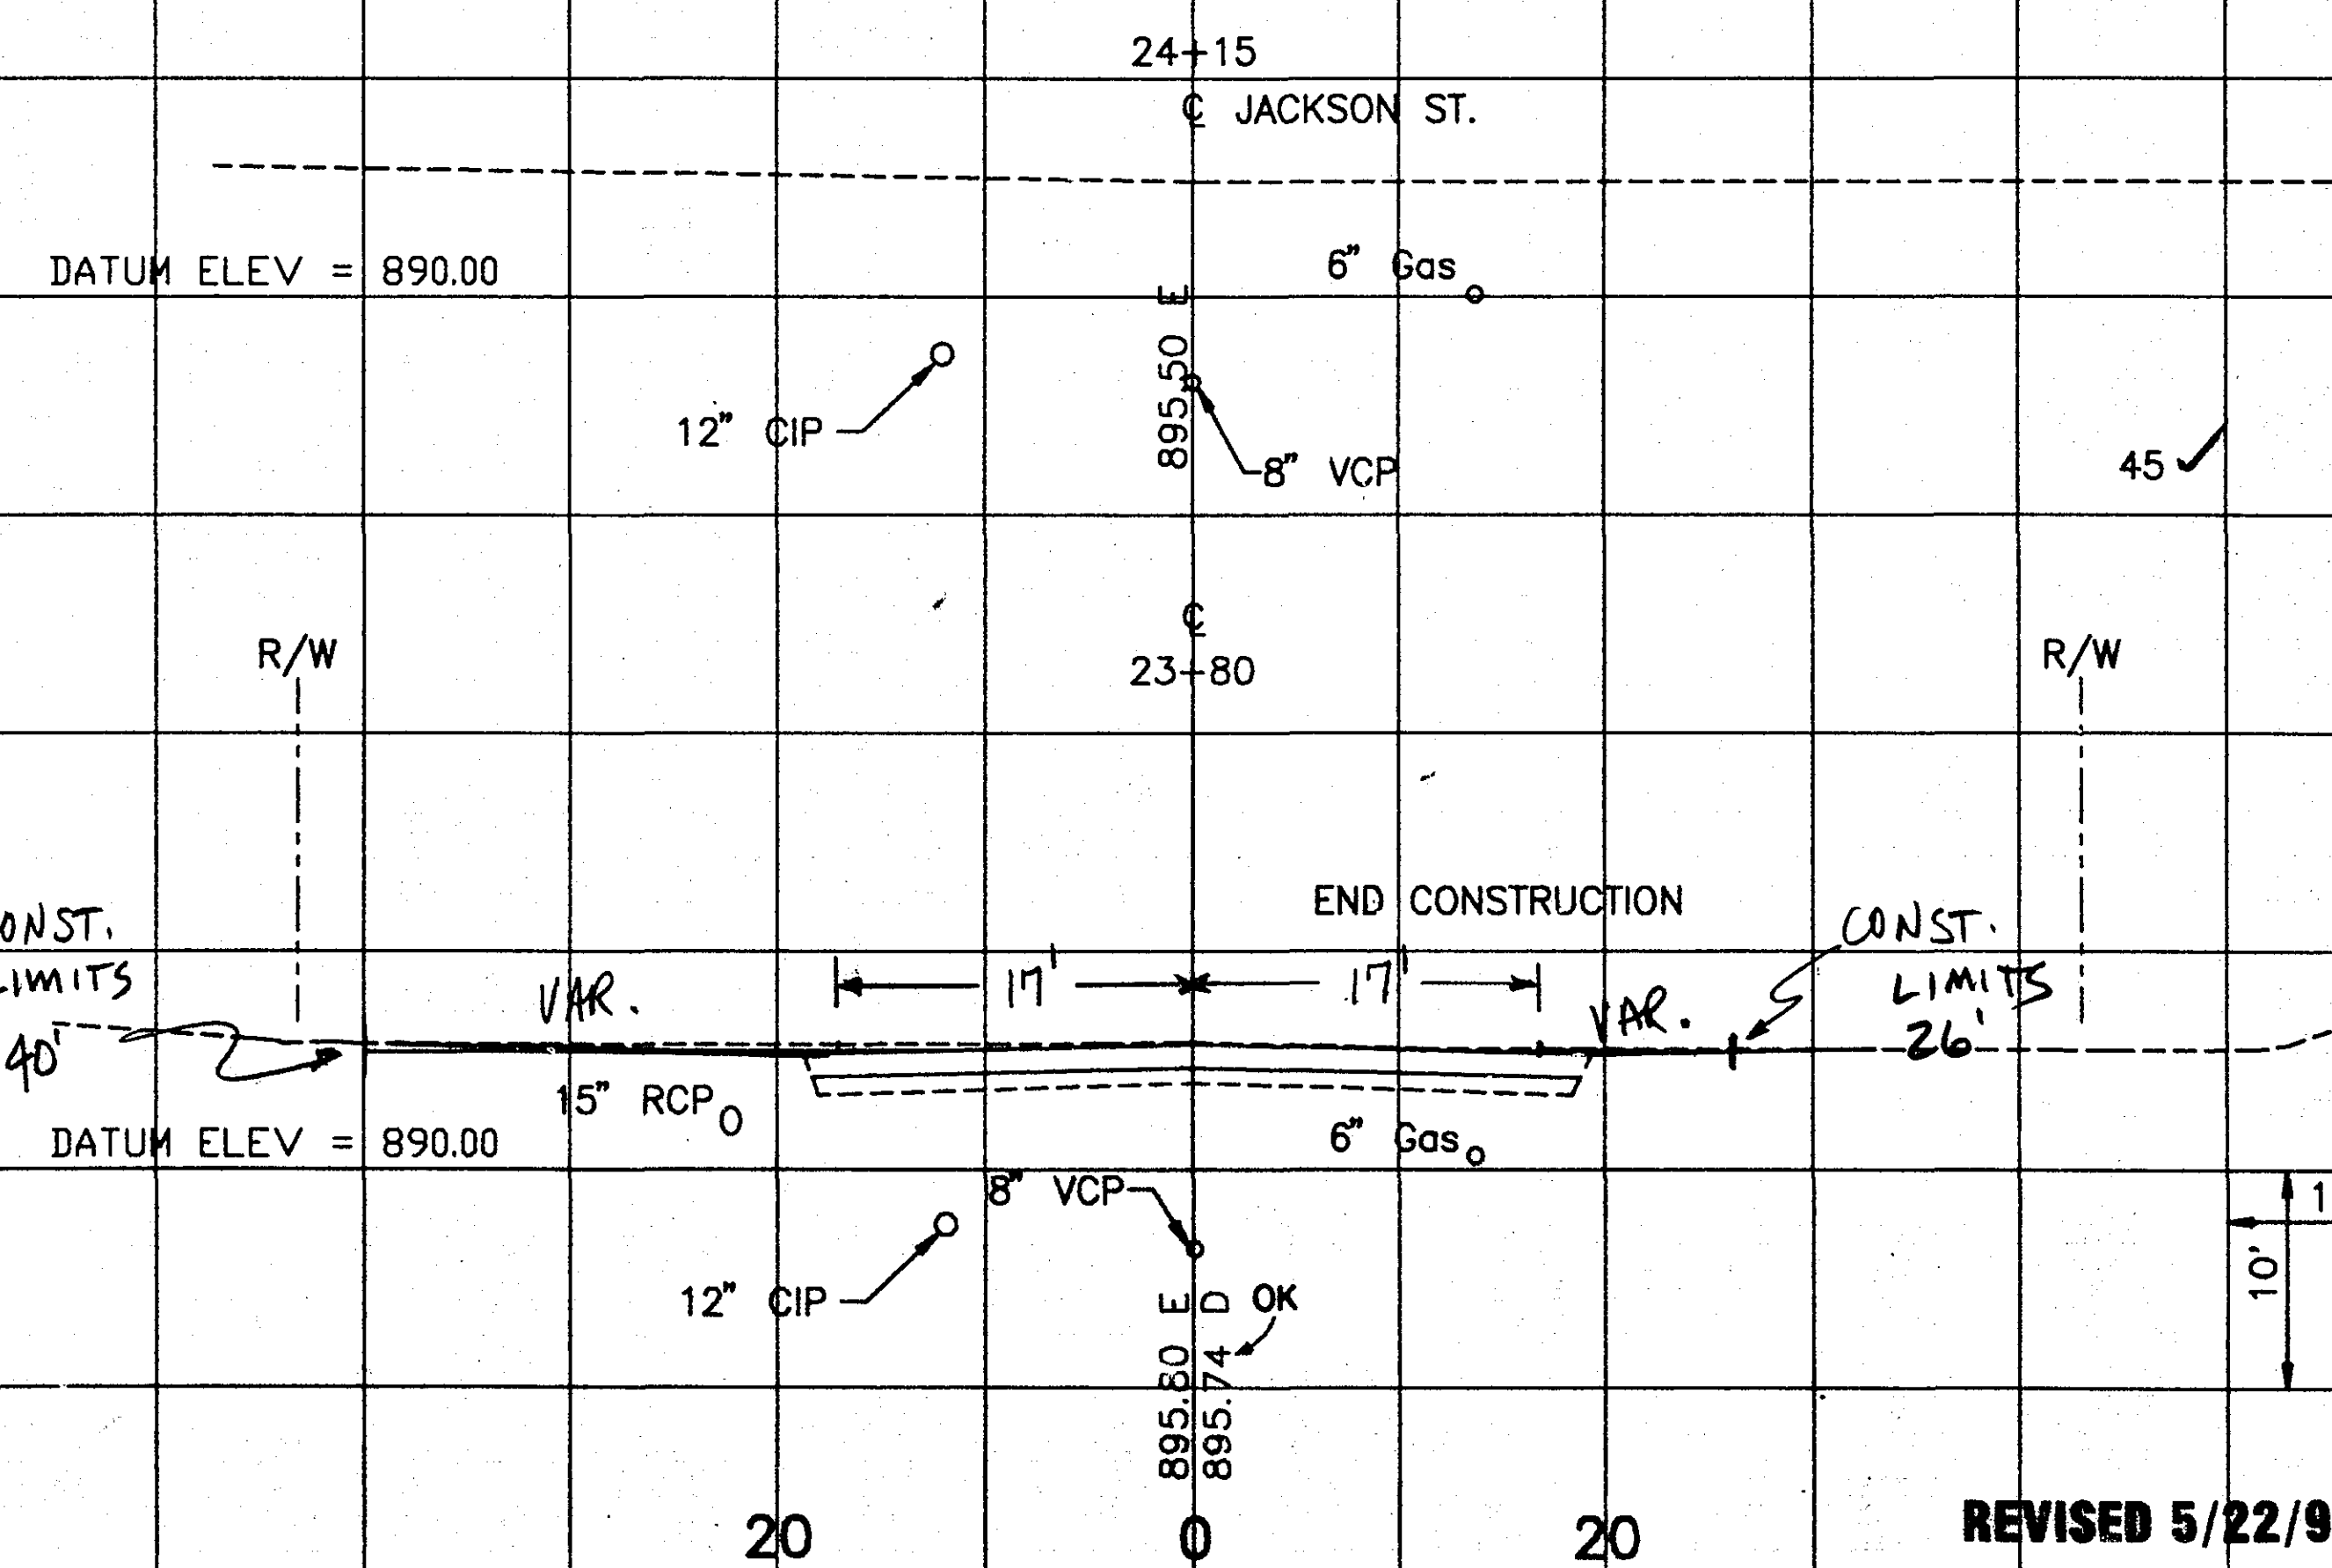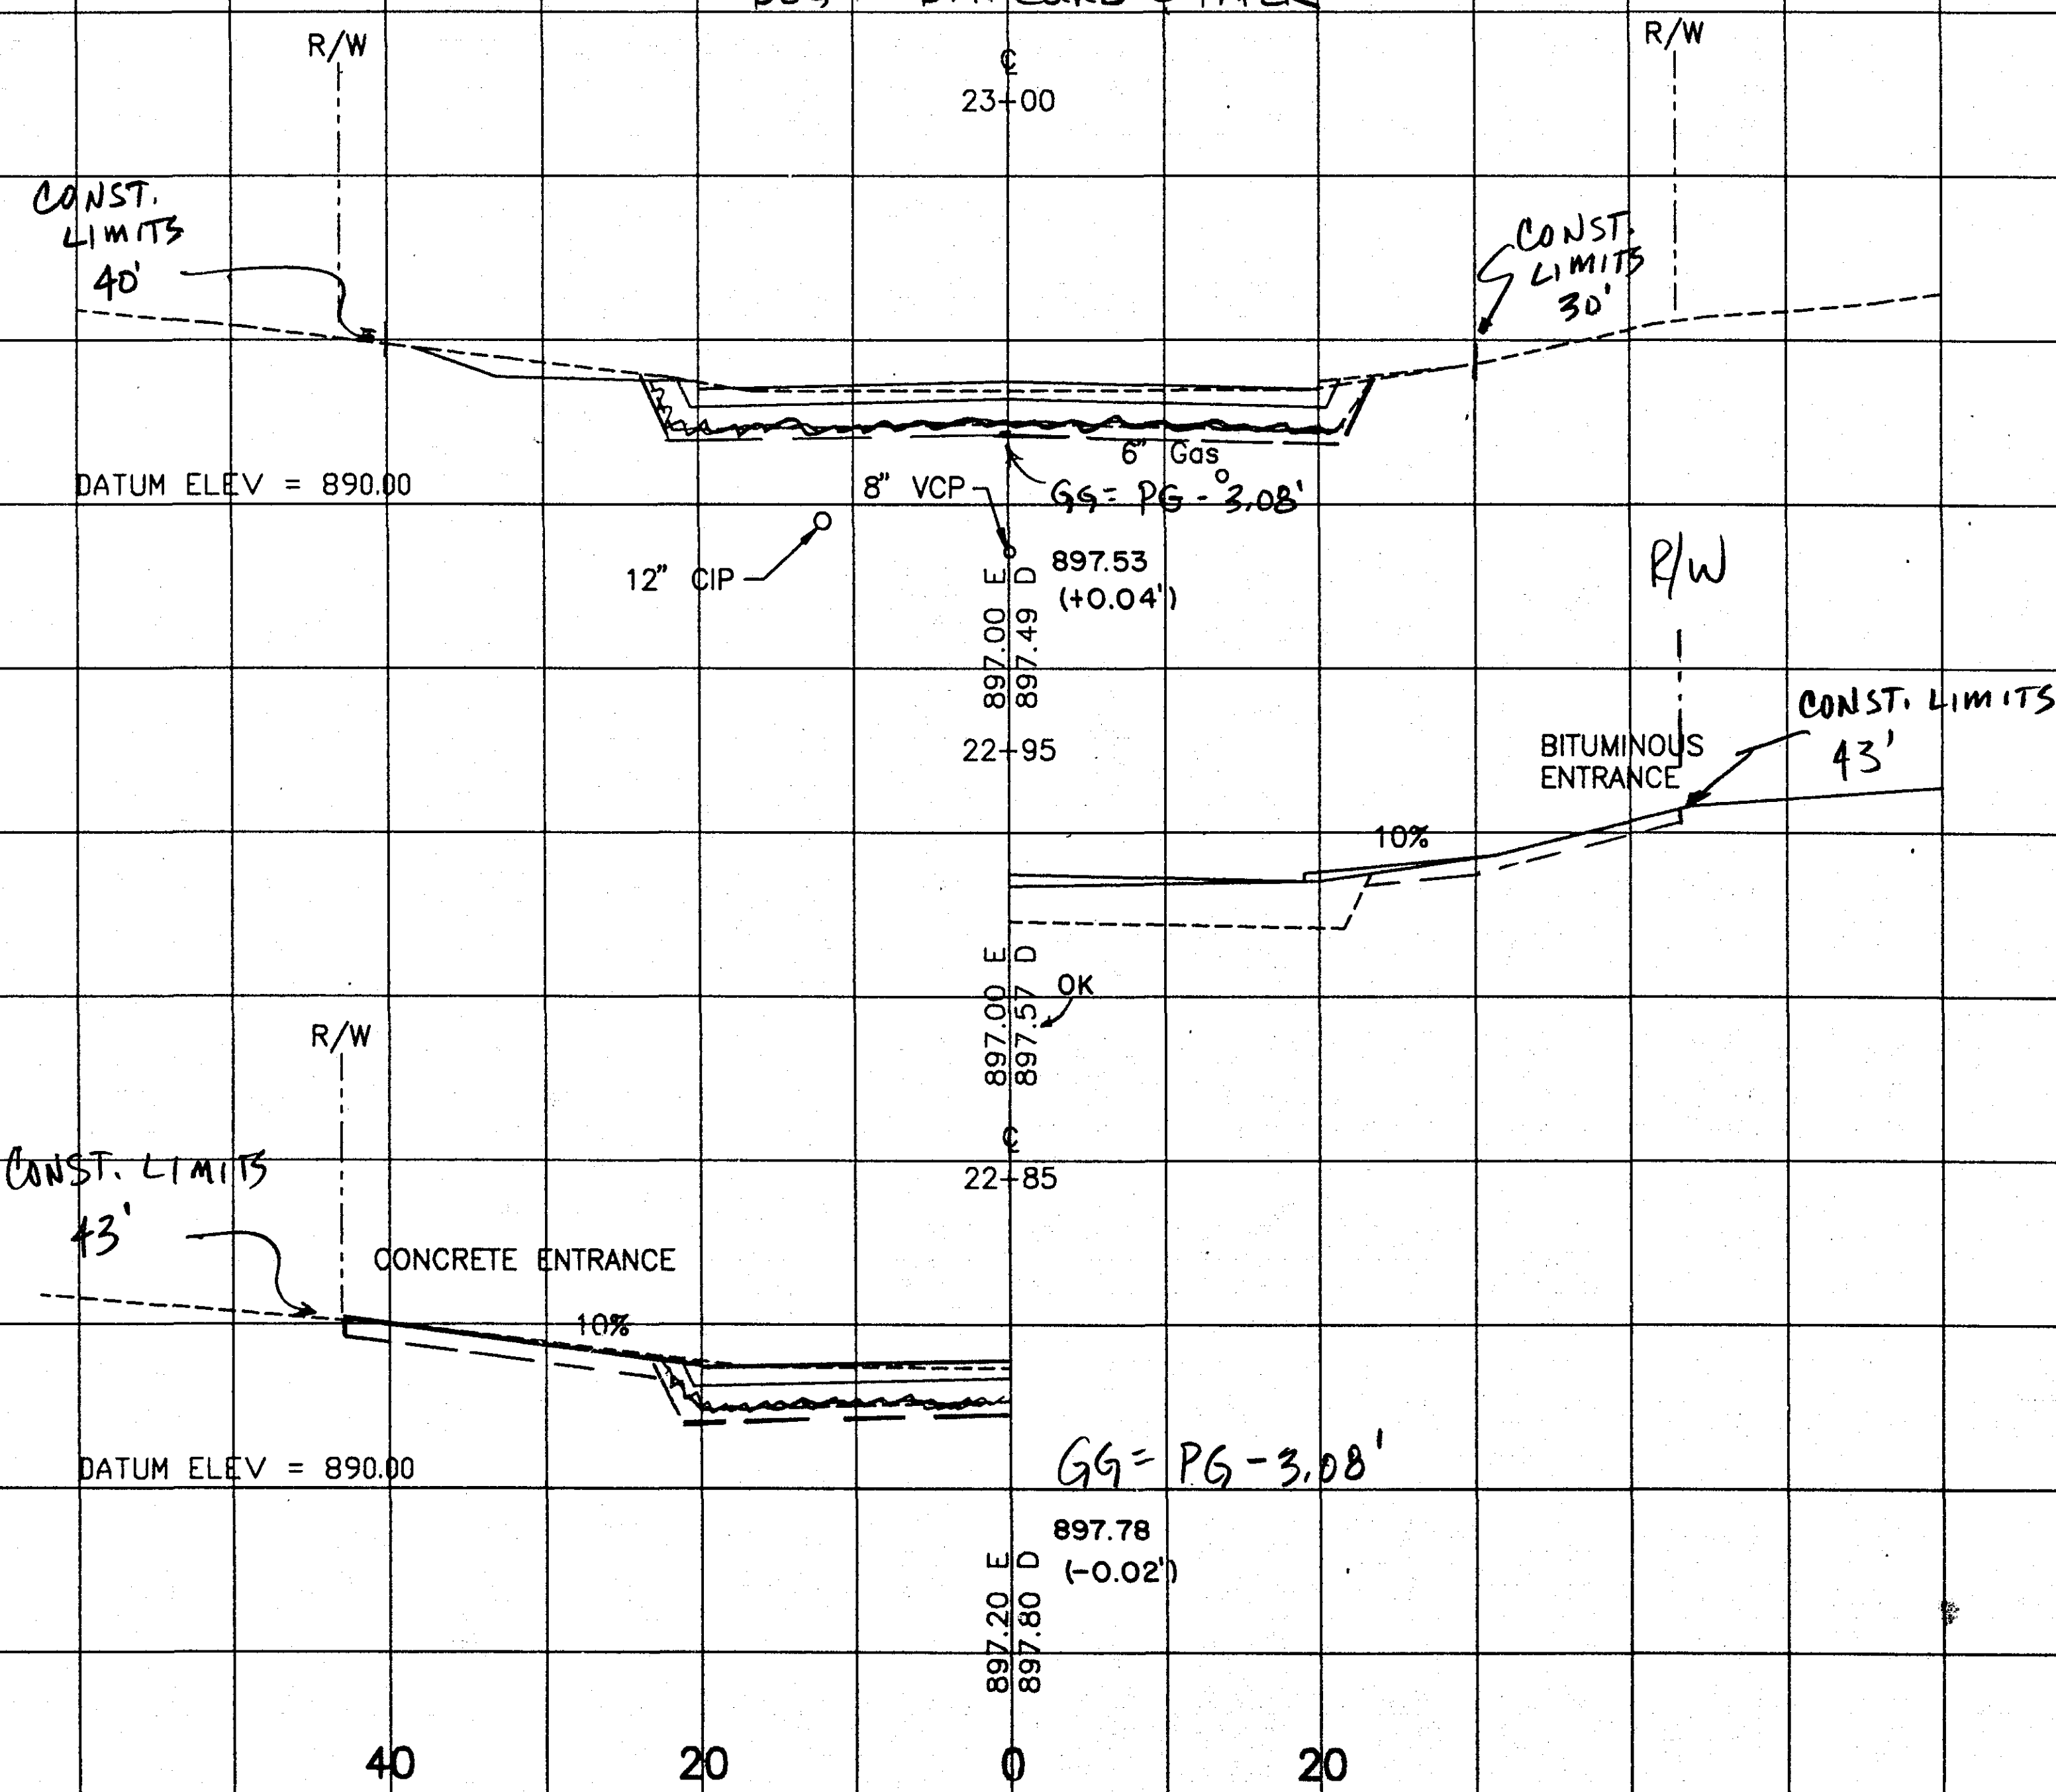

28-117

REVISED 5/22/92 W.R.L., B.J.

©BONESTROO, ROSENE, ANDERLIK & ASSOCIATES, INC. 1989

REVISIONS	
1	HER
2	JPC
3	TWP
4	MLS

BONESTROO, ROSENE, ANDERLIK & ASSOC., INC.
 ENGINEERS & ARCHITECTS
 St. Paul, Minnesota

RAMSEY COUNTY, MINNESOTA
 DATE: OCT. 19, 1989 COMM. 21802

ROSELAWN AVENUE
 X-SECTIONS
 Sta. 22+79 to Sta. 24+15
 S.A.P. 62-626-04

DESIGN DATA

1983 (AND CURRENT INTERIM) AASHTO DESIGN SPECIFICATIONS.

DESIGN LOADING HS25 LIVE LOAD.

LOAD FACTOR DESIGN METHOD.

DEAD LOAD INCLUDES 17 P.S.F. ALLOWANCE FOR FUTURE WEARING COURSE MODIFICATIONS.

MAXIMUM ALLOWABLE DESIGN STRESSES:

REINFORCED CONCRETE
 $f'_c = 4,000$ P.S.I. $n = 8$
 $f_y = 60,000$ P.S.I. REINFORCEMENT.

PRESTRESSED CONCRETE
 $f'_c = 6,000$ P.S.I. $n = 6$
 $f'_s = 270,000$ P.S.I. STRAND LOW LAX

DECK AREA = ____ SQ. FT.

5300 PROJECTED ADT FOR YEAR 2007

OPERATING RATING HS

LIST OF SHEETS

1	GENERAL PLAN & ELEVATION
2	BRIDGE LAYOUT
3	ABUTMENT PLAN & ELEVATION
4	ABUTMENT REINFORCEMENT
5	ABUTMENT DETAILS
6	PIER PLAN & ELEVATIONS
7	PIER REINFORCEMENT & DETAILS
8	FRAMING PLAN
9	36" PRESTRESSED CONC. BEAM, TYPE 36-50
10	36" PRESTRESSED CONC. BEAM, TYPE 36-53
11	BRIDGE DECK PLAN
12	CONCRETE PARAPET & PIPE RAILING
13	PIPE & CONCRETE RAILING - TYPE J
14	WATERPROOF EXPANSION DEVICE
15	WATERPROOF EXPANSION DEVICE
16	SNOW PLOW PROTECTION
17	BRIDGE NAMEPLATE/SOLE PLATE
18	CURVED PLATE BEARING ASSEMBLIES
19	INTERMEDIATE DIAPHRAGM/END DIAPHRAGM
20	CONTRACTION JOINT/ FENCE POST ANCHOR
21	BRIDGE SURVEY

BONESTROO, ROSENE, ANDERLUK & ASSOC., INC.
 Engineers & Architects
 St. Paul, Minnesota

I HEREBY CERTIFY THAT THIS PLAN WAS PREPARED BY ME OR UNDER MY DIRECT SUPERVISION AND THAT I AM A DULY REGISTERED PROFESSIONAL ENGINEER UNDER THE LAWS OF THE STATE OF MINNESOTA.

SIGNED _____
 DATE: _____ REG. NO. _____

B.M. ELEV. _____ (M.S.L. 1929 ADJ.)
 SEE BRIDGE SURVEY SHEET No. _____

ROSELAWN AVENUE (CSAH 26)
 MINNESOTA
 DEPARTMENT OF TRANSPORTATION

BRIDGE No. 62559

ROSELAWN AVE (CSAH 26) OVER SOO LINE RAILROAD. .2 MILES E. OF T.H. 49 (RICE ST.) IN MAPLEWOOD. PRESTRESSED CONCRETE BEAM SPANS, 44'-0" ROADWAY, 24.7' SKEW.

GENERAL PLAN AND ELEVATION

SEC. 18 T 29 N R 22 W
 MAPLEWOOD CITY RAMSEY COUNTY

APPROVED: _____

BRIDGE ENGINEER _____ DEPUTY DIV. DIRECTOR

DES: MTR DR: LHK

CHK: _____

CONSTRUCTION NOTES

THE 1988 EDITION OF THE MINNESOTA DEPARTMENT OF TRANSPORTATION "STANDARD SPECIFICATIONS FOR CONSTRUCTION" SHALL GOVERN.





BRIDGE SEAT REINFORCEMENT SHALL BE CAREFULLY PLACED TO AVOID INTERFERENCE WITH DRILLING HOLES FOR ANCHOR RODS. THE SUPERSTRUCTURE BEAMS SHALL BE ERECTED IN FINAL POSITION PRIOR TO DRILLING HOLES FOR AND PLACING ANCHOR RODS.

THE FIRST DIGIT OR THE FIRST TWO DIGITS OF EACH BAR MARK INDICATE THE BAR SIZE.

BAR MARKED WITH THE SUFFIX "E" SHALL BE EPOXY COATED IN ACCORDANCE WITH 3301.

RESTORE SIDE DITCHES AFTER PLACEMENT OF SLOPE PAVING TO PROVIDE DRAINAGE AS DIRECTED BY THE ENGINEER. RESTORATION COSTS SHALL BE INCLUDED IN PRICE BID FOR STRUCTURE EXCAVATION.

CONSTRUCTION OF EACH ABUTMENT SHALL NOT BE STARTED UNTIL THE APPROACH FILL AT THE ABUTMENT HAS BEEN CONSTRUCTED TO THE FULL HEIGHT AND CROSS SECTION.

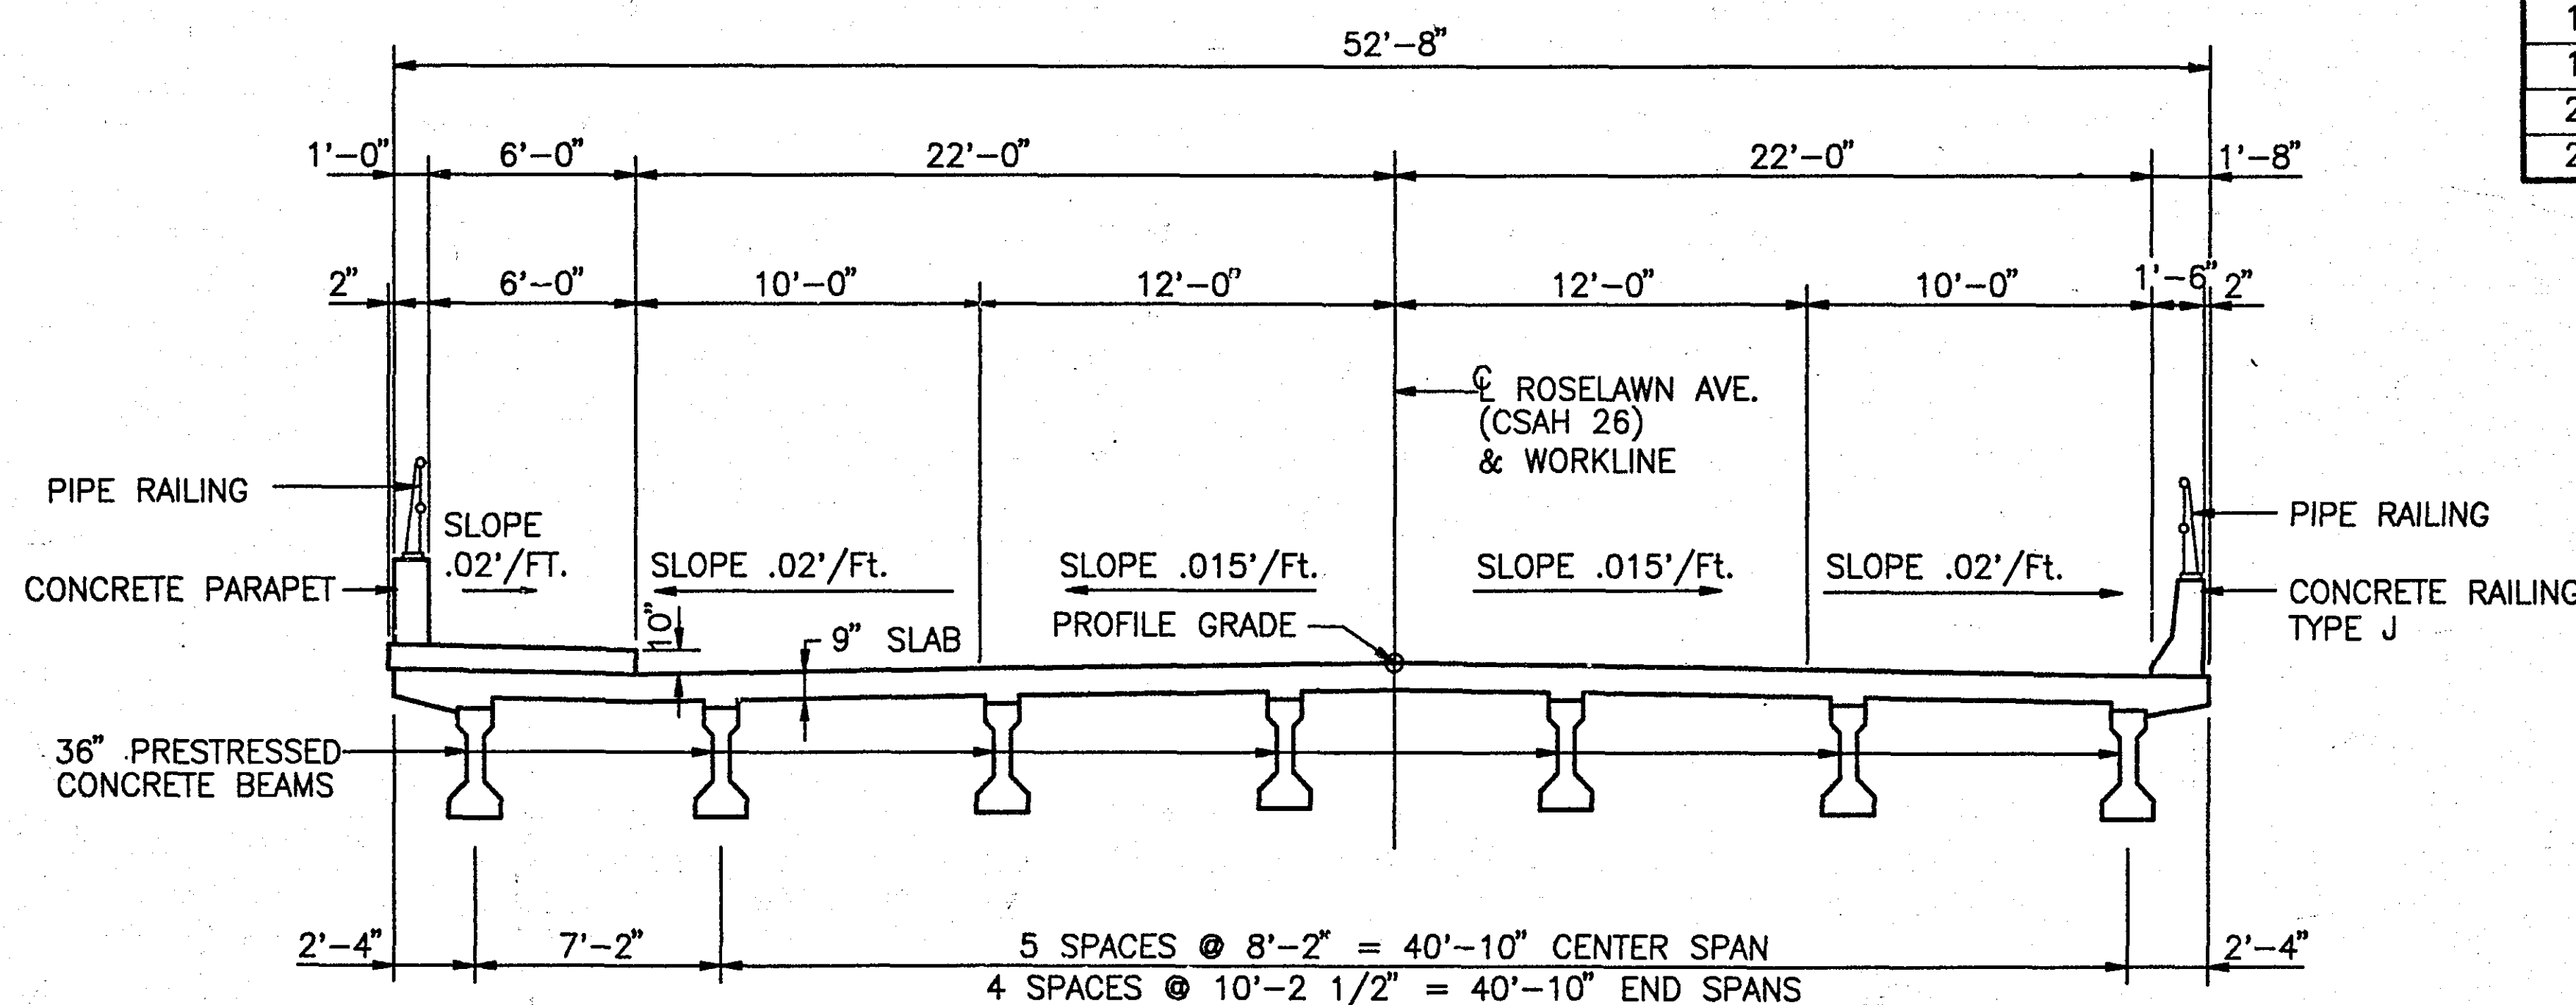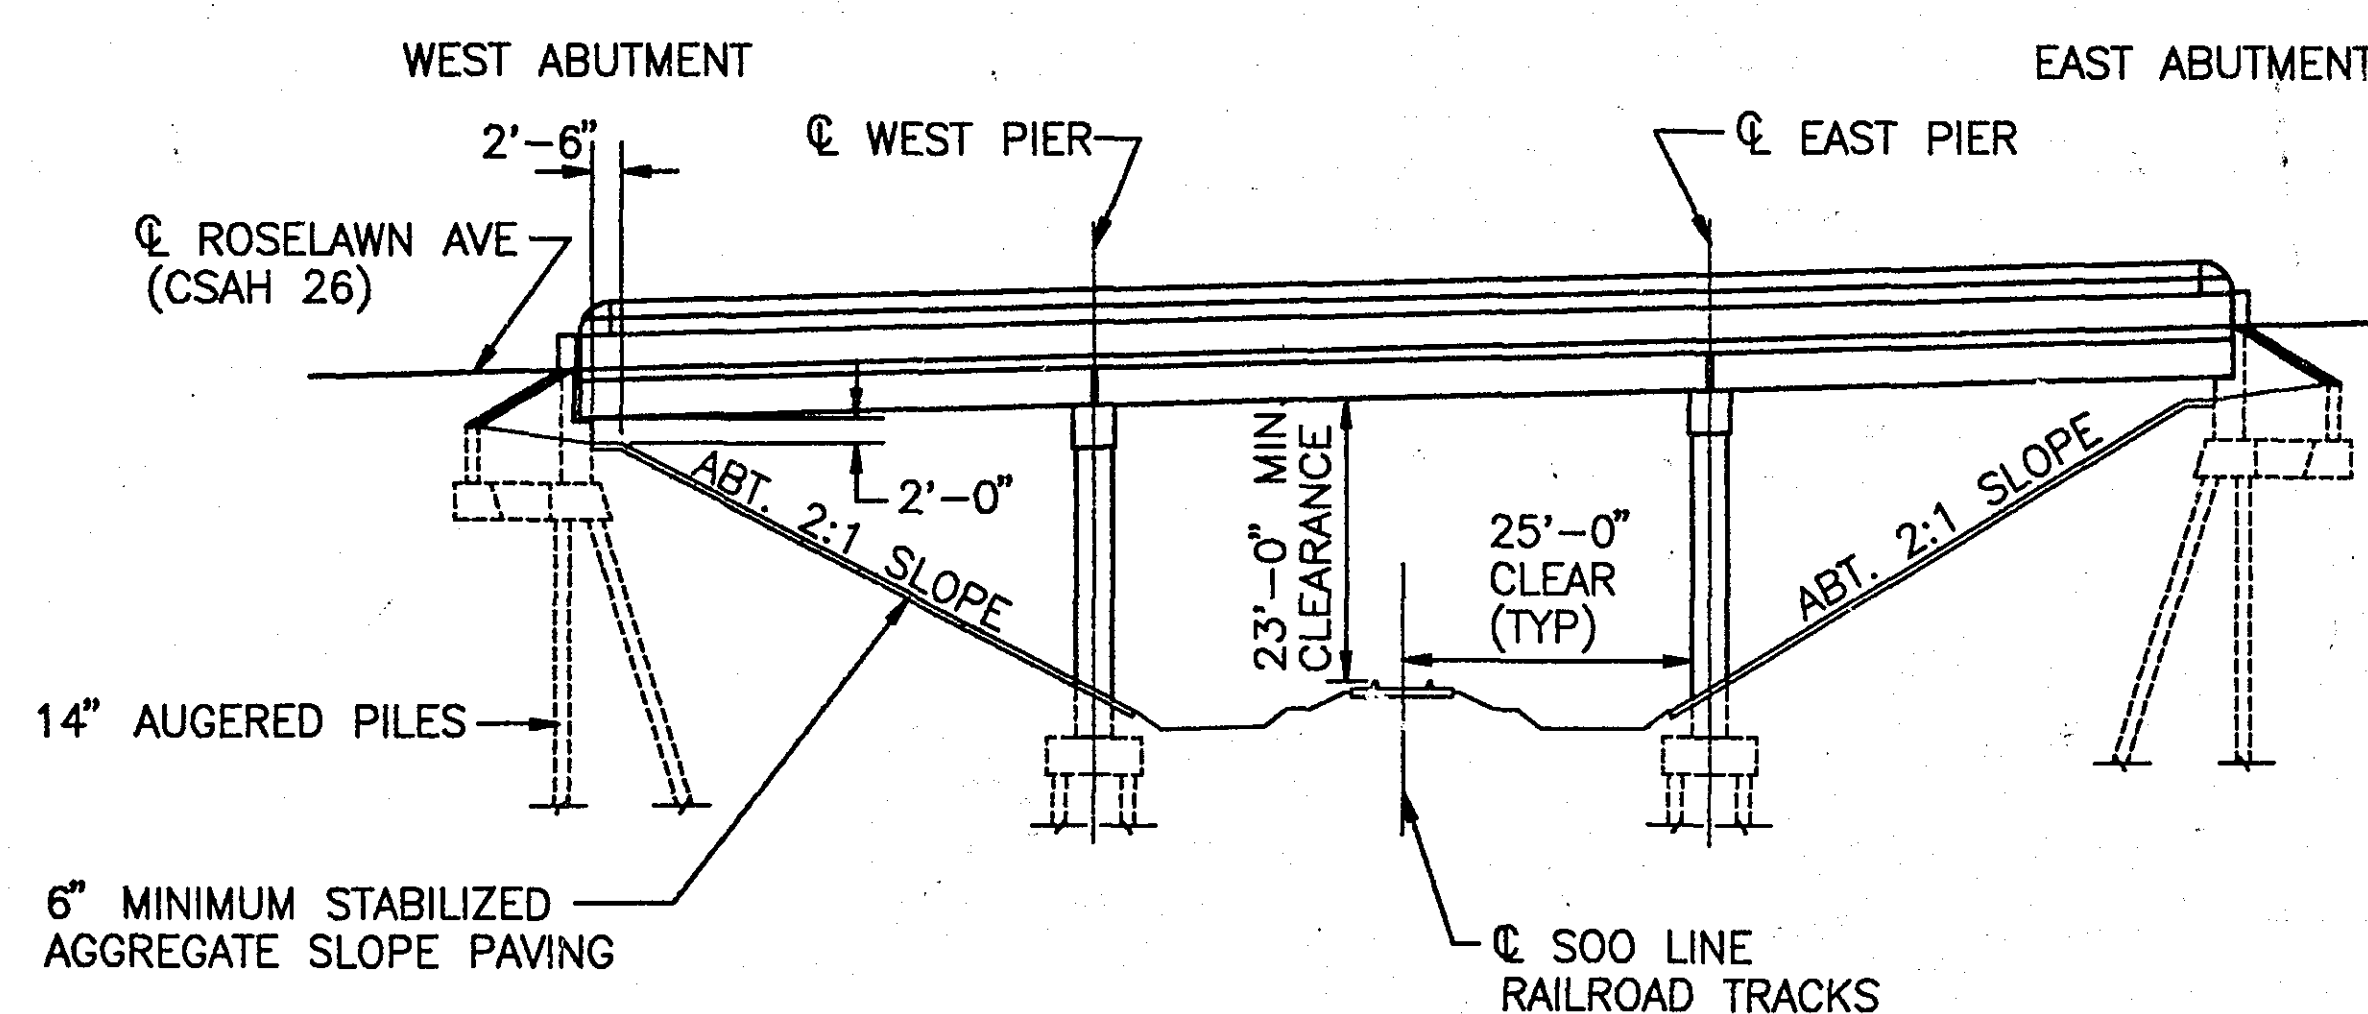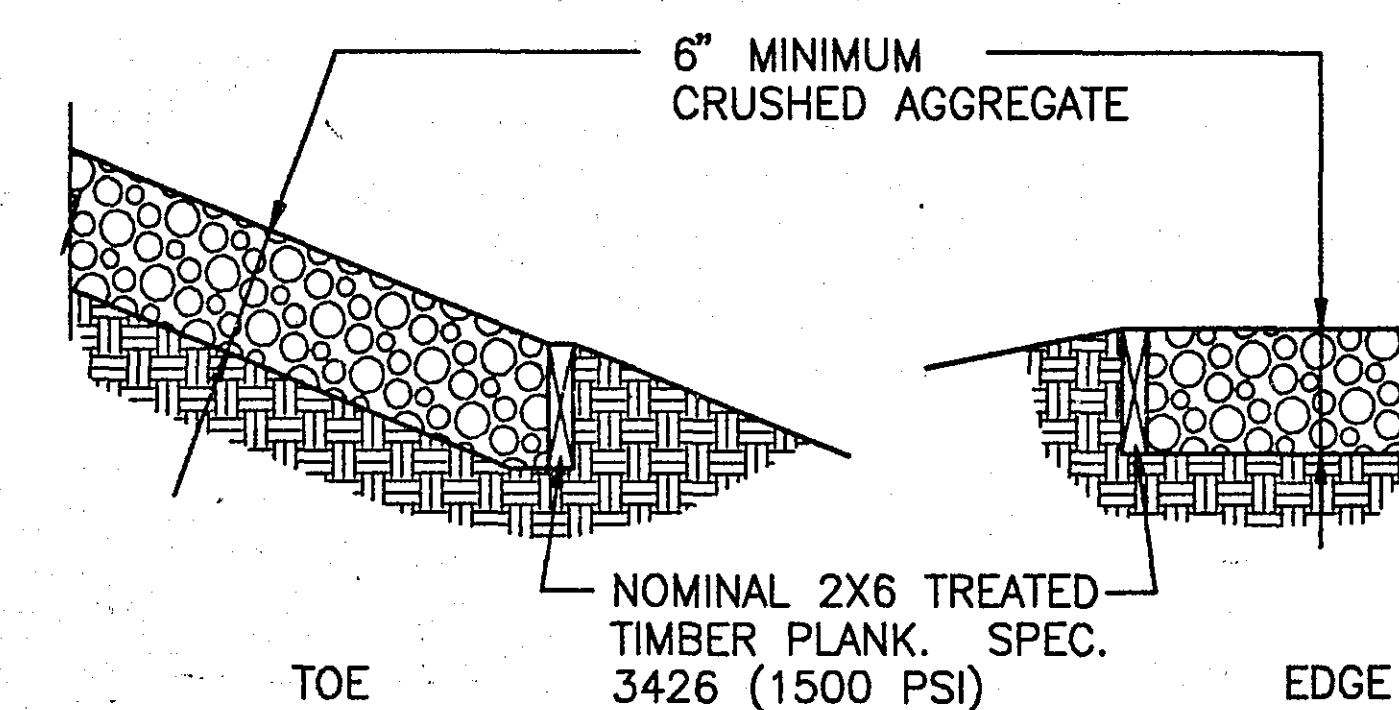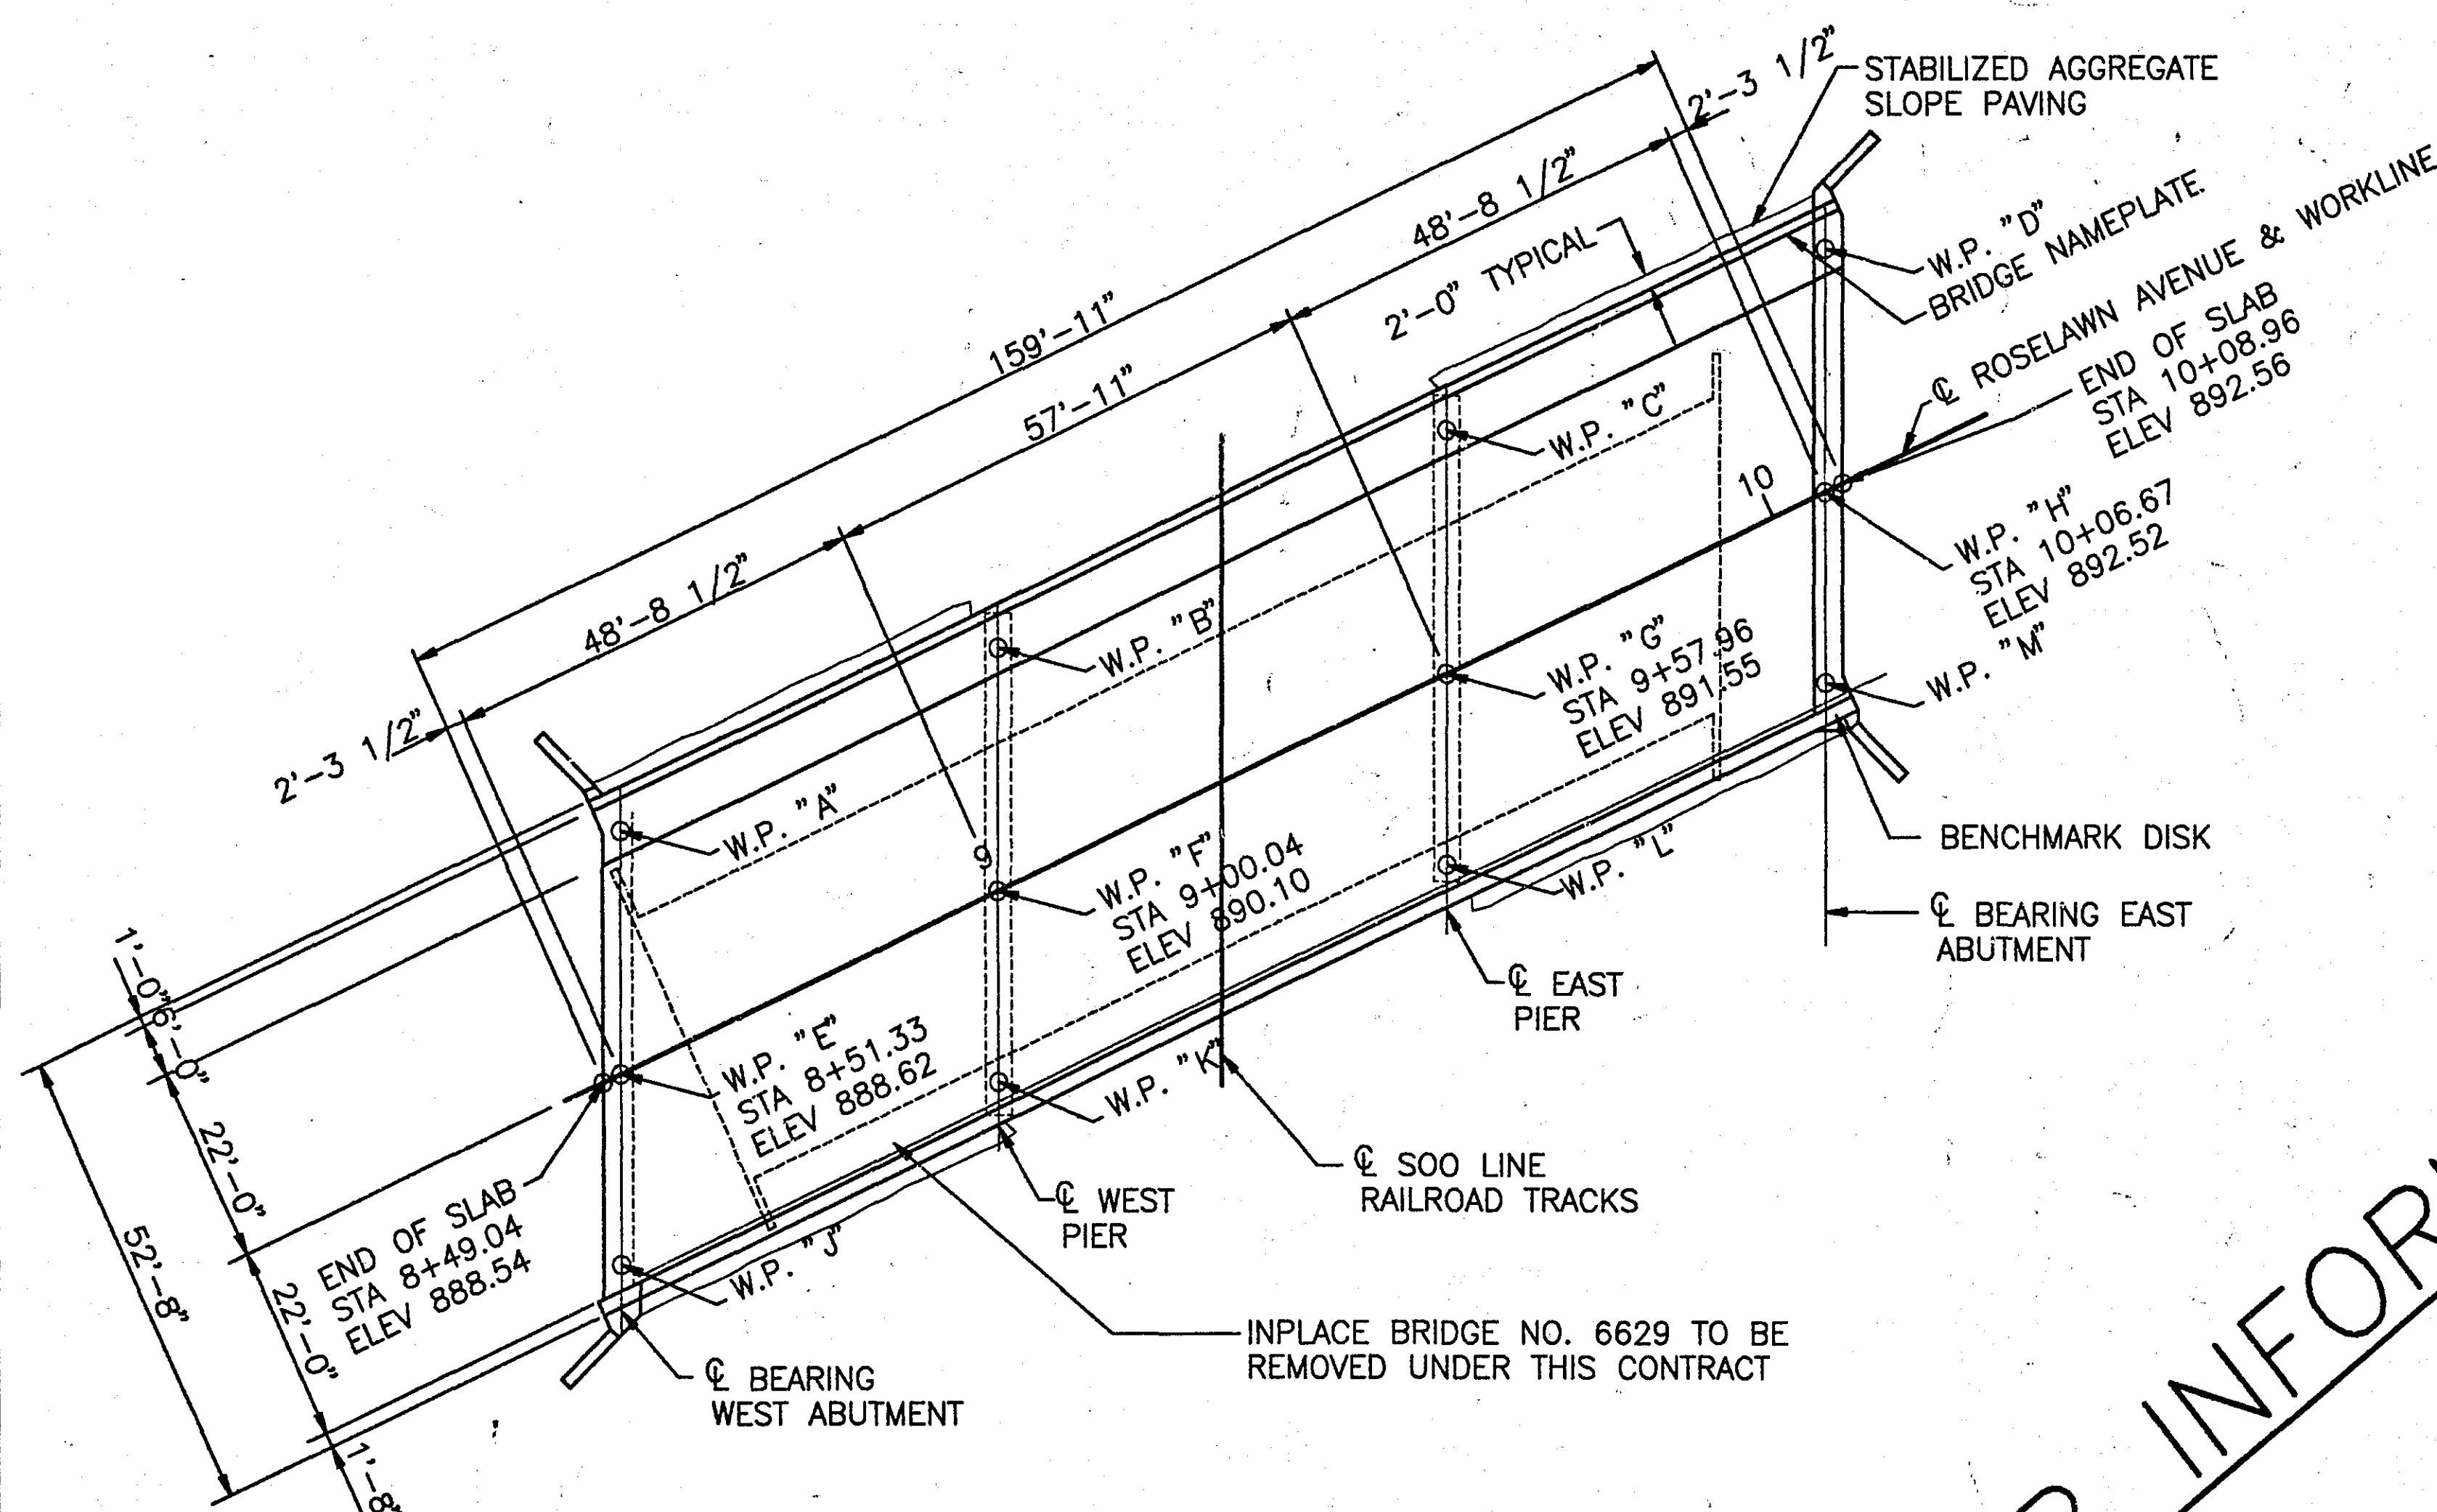

SCHEDULE OF QUANTITIES FOR ENTIRE BRIDGE

ITEM NO.	2401.501	2401.501	2401.512	2401.513	2401.513	2401.515	2401.541	2401.541	2402.585	2402.591	2402.595	2405.502	2405.502	2405.511	2442.501	2514.503	0401.601	0452.604
ITEM	STRUCTURE CONCRETE (1A43)	STRUCTURE CONCRETE (3Y43)	BRIDGE SLAB CONCRETE (3X33)	TYPE F RAILING CONCRETE (3X46)	TYPE J RAILING CONCRETE (3X46)	SIDEWALK CONCRETE (3X46)	REINFORCEMENT BARS	REINFORCEMENT BARS (EPOXY COATED)	PIPE RAILING	EXPANSION JOINT DEVICES, TYPE 3	BEARING ASSEMBLY	PRESTRESSED CONCRETE BEAMS, TYPE 36-50	PRESTRESSED CONCRETE BEAMS, TYPE 36-58	DIAPHRAGMS FOR TYPE 28-43 PRESTRESSED BEAMS	REMOVE OLD BRIDGE	AGGREGATE SLOPE PAVING	STRUCTURE EXCAVATION	14" AUGERED PILE, FURN'D & DRIVEN
UNIT	CU. YD.	CU. YD.	SQ. FT.	LIN. FT.	LIN. FT.	SQ. FT.	POUND	POUND	LIN. FT.	LIN. FT.	EACH	LIN. FT.	LIN. FT.	LIN. FT.	LUMP SUM	SQ. YD.	LUMP SUM	LIN. FT.
QUANTITY	(P)	(P)	(P)	(P)	(P)	(P)	(P)	(P)	(P)	(P)	(P)	(P)	(P)	(P)	(P)	(P)	(P)	(P)

Area No. . Job No. .

State Project No. 62-626-03

Sheet No. 24 of 24 Sheets