

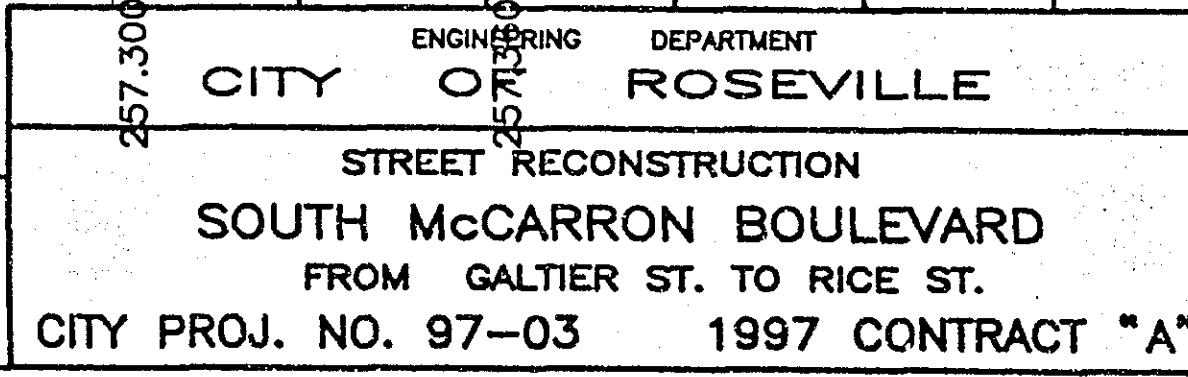


DATE 4/30/97 REG NO. 24490

NOTE: F & I NO PARKING SIGNS
SPACED EVERY 58m ON BOTH
SIDES OF THE STREET

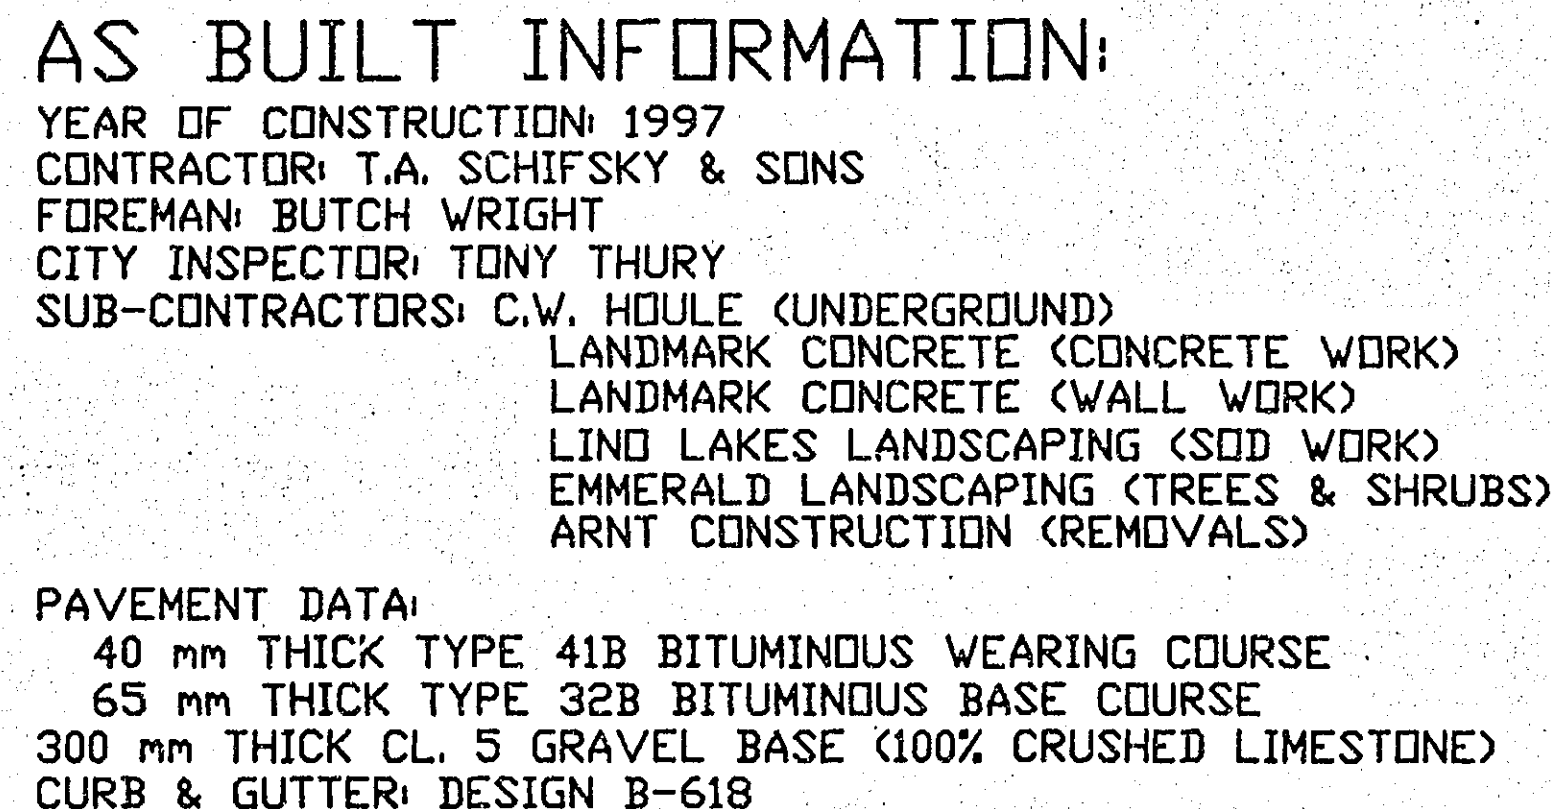

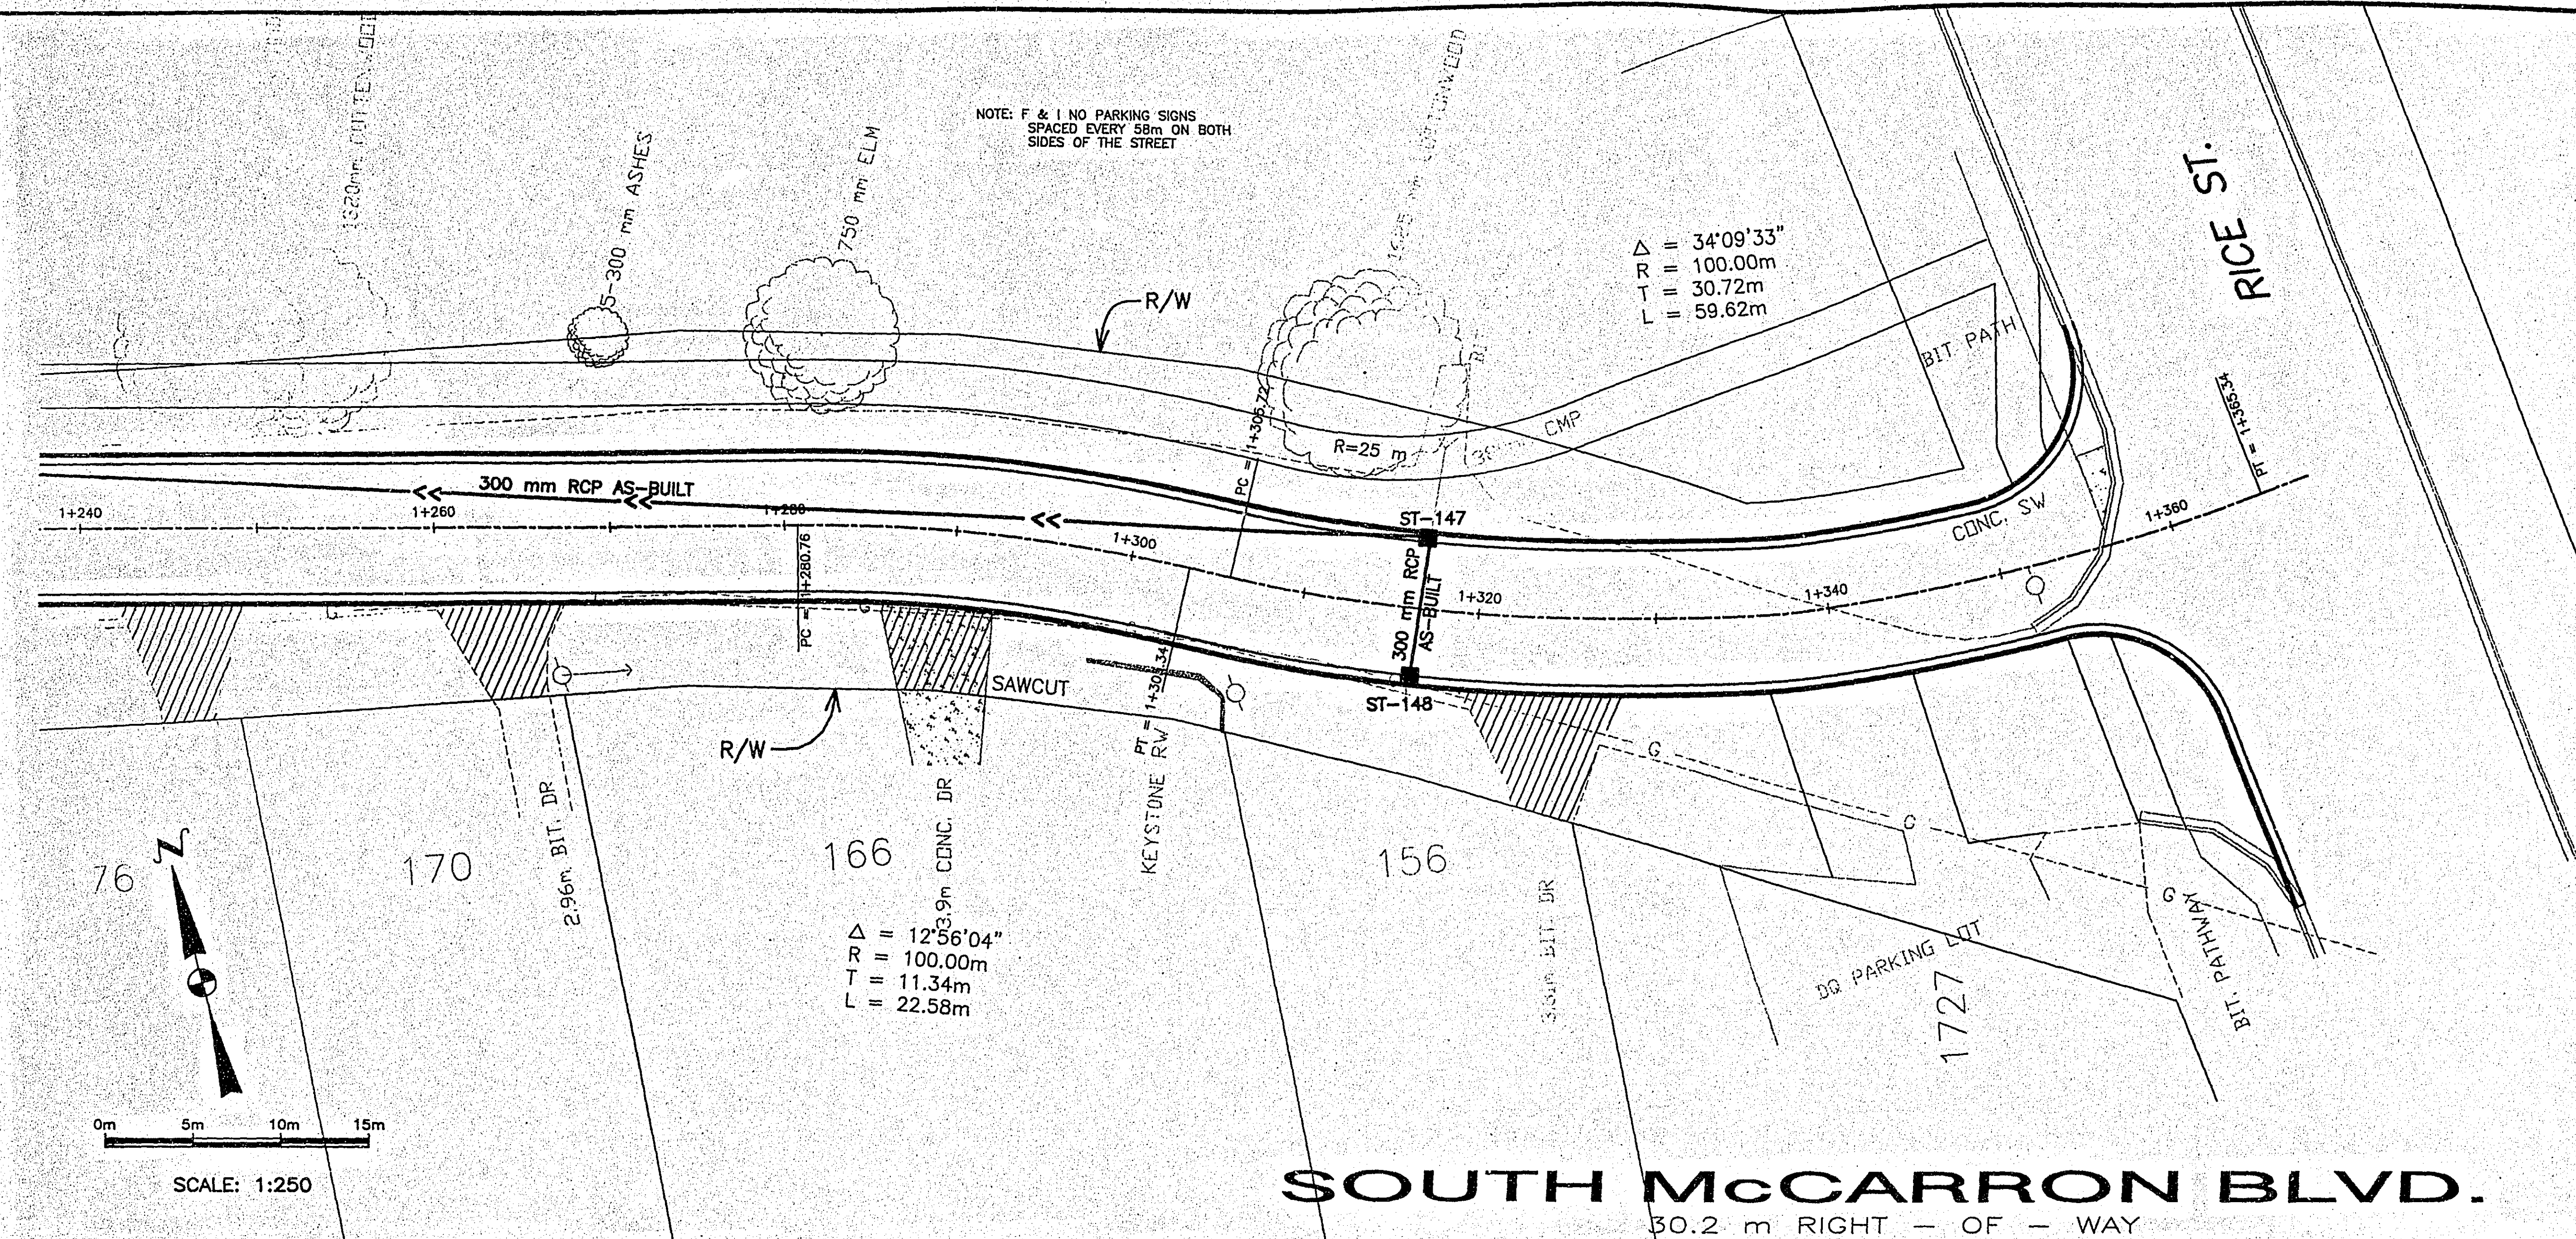

AS BUILT INFORMATION:

YEAR OF CONSTRUCTION: 1997
CONTRACTOR: T.A. SCHIFSKY & SONS
FOREMAN: BUTCH WRIGHT
CITY INSPECTOR: TONY THURY
SUB-CONTRACTORS: C.W. HOULE (UNDERGROUND)
LANDMARK CONCRETE (CONCRETE WORK)
LANDMARK CONCRETE (WALL WORK)
LIND LAKES LANDSCAPING (SOD WORK)
EMERALD LANDSCAPING (TREES & SHRUBS)
ARNT CONSTRUCTION (REMOVALS)


PAVEMENT DATA:
40 mm THICK TYPE 41B BITUMINOUS WEARING COURSE
65 mm THICK TYPE 32B BITUMINOUS BASE COURSE
300 mm THICK CL. 5 GRAVEL BASE (100% CRUSHED LIMESTONE)
CURB & GUTTER: DESIGN B-618

METRIC PROJECT
THIS PLAN HAS BEEN PREPARED USING
METRIC UNITS AND WILL BE CONSTRUCTED
USING METRIC MEASUREMENTS


I HEREBY CERTIFY THAT THIS PLAN WAS PREPARED BY ME OR
UNDER MY DIRECT SUPERVISION AND THAT I AM A DULY REGISTERED
PROFESSIONAL ENGINEER UNDER THE LAWS OF THE STATE OF MINNESOTA.



James W. Kline
ASSISTANT PUBLIC WORKS DIRECTOR
DATE 1/30/97 REG. NO. 24490

SOUTH McCARRON BLVD.
30.2 m RIGHT - OF - WAY

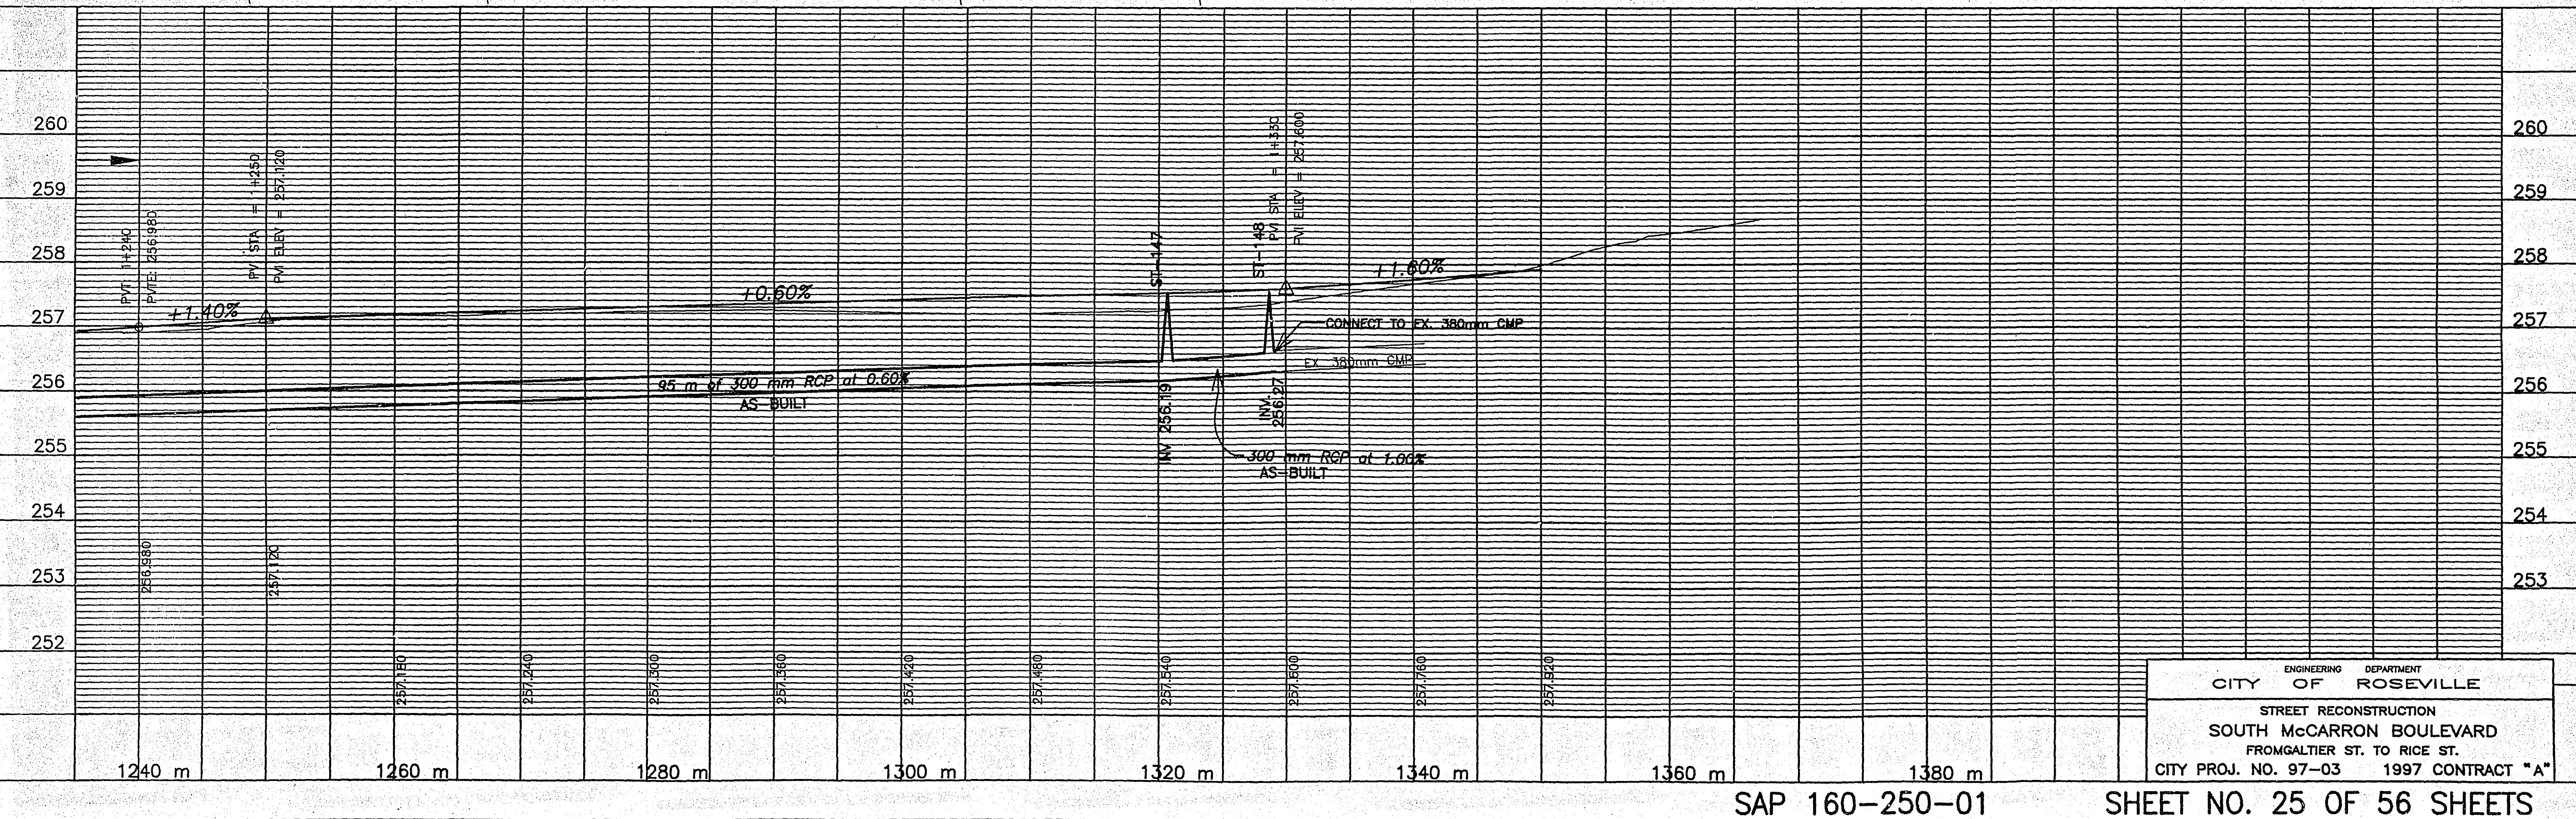

ENGINEERING DEPARTMENT
CITY OF ROSEVILLE
STREET RECONSTRUCTION
SOUTH McCARRON BOULEVARD
FROMGALTIER ST. TO RICE ST.
CITY PROJ. NO. 97-03 1997 CONTRACT "A"

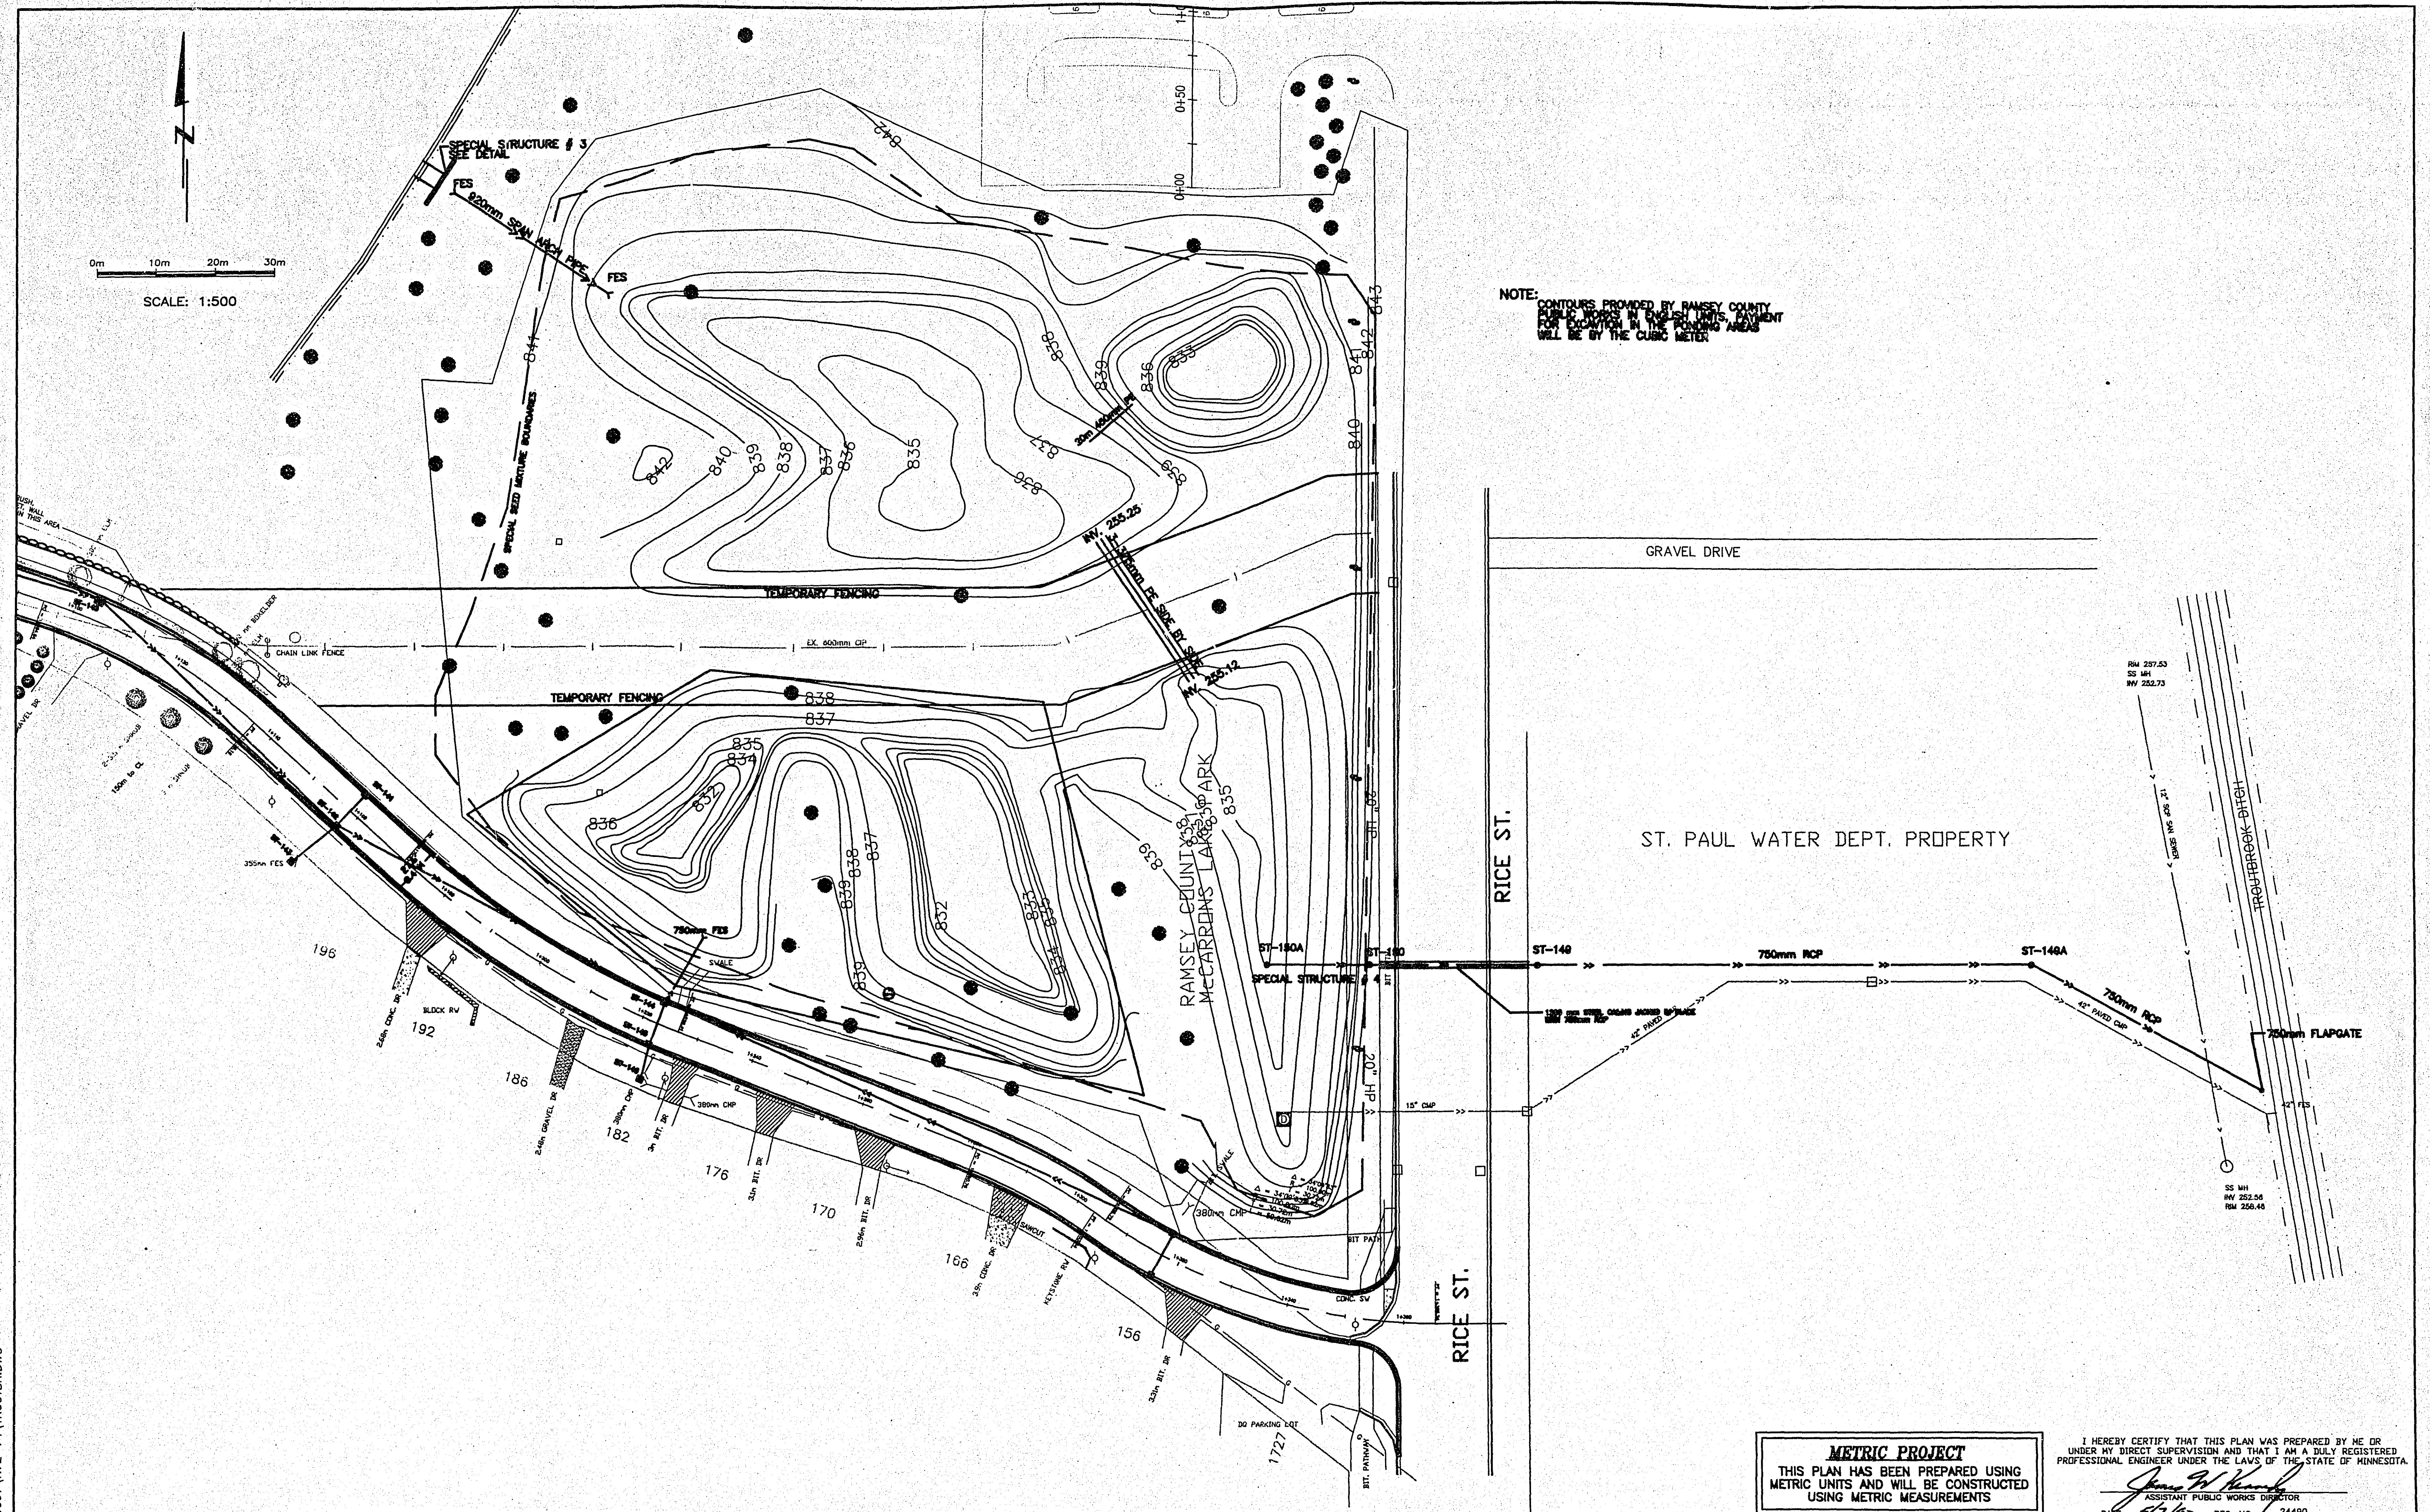

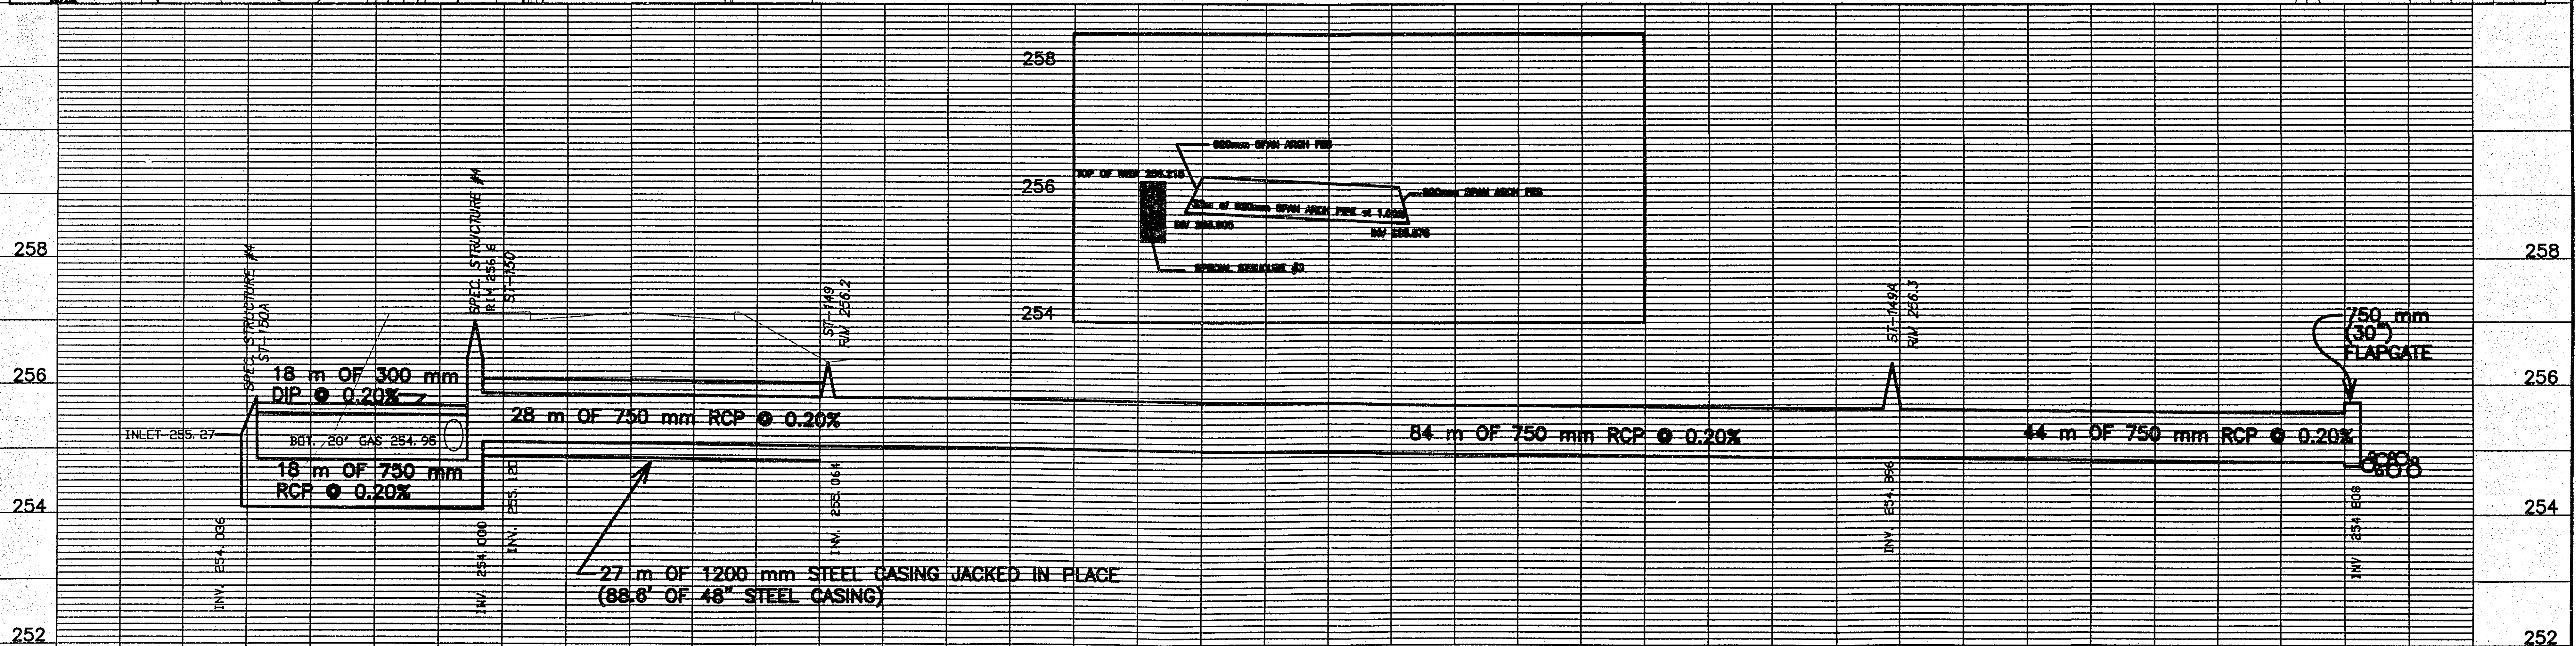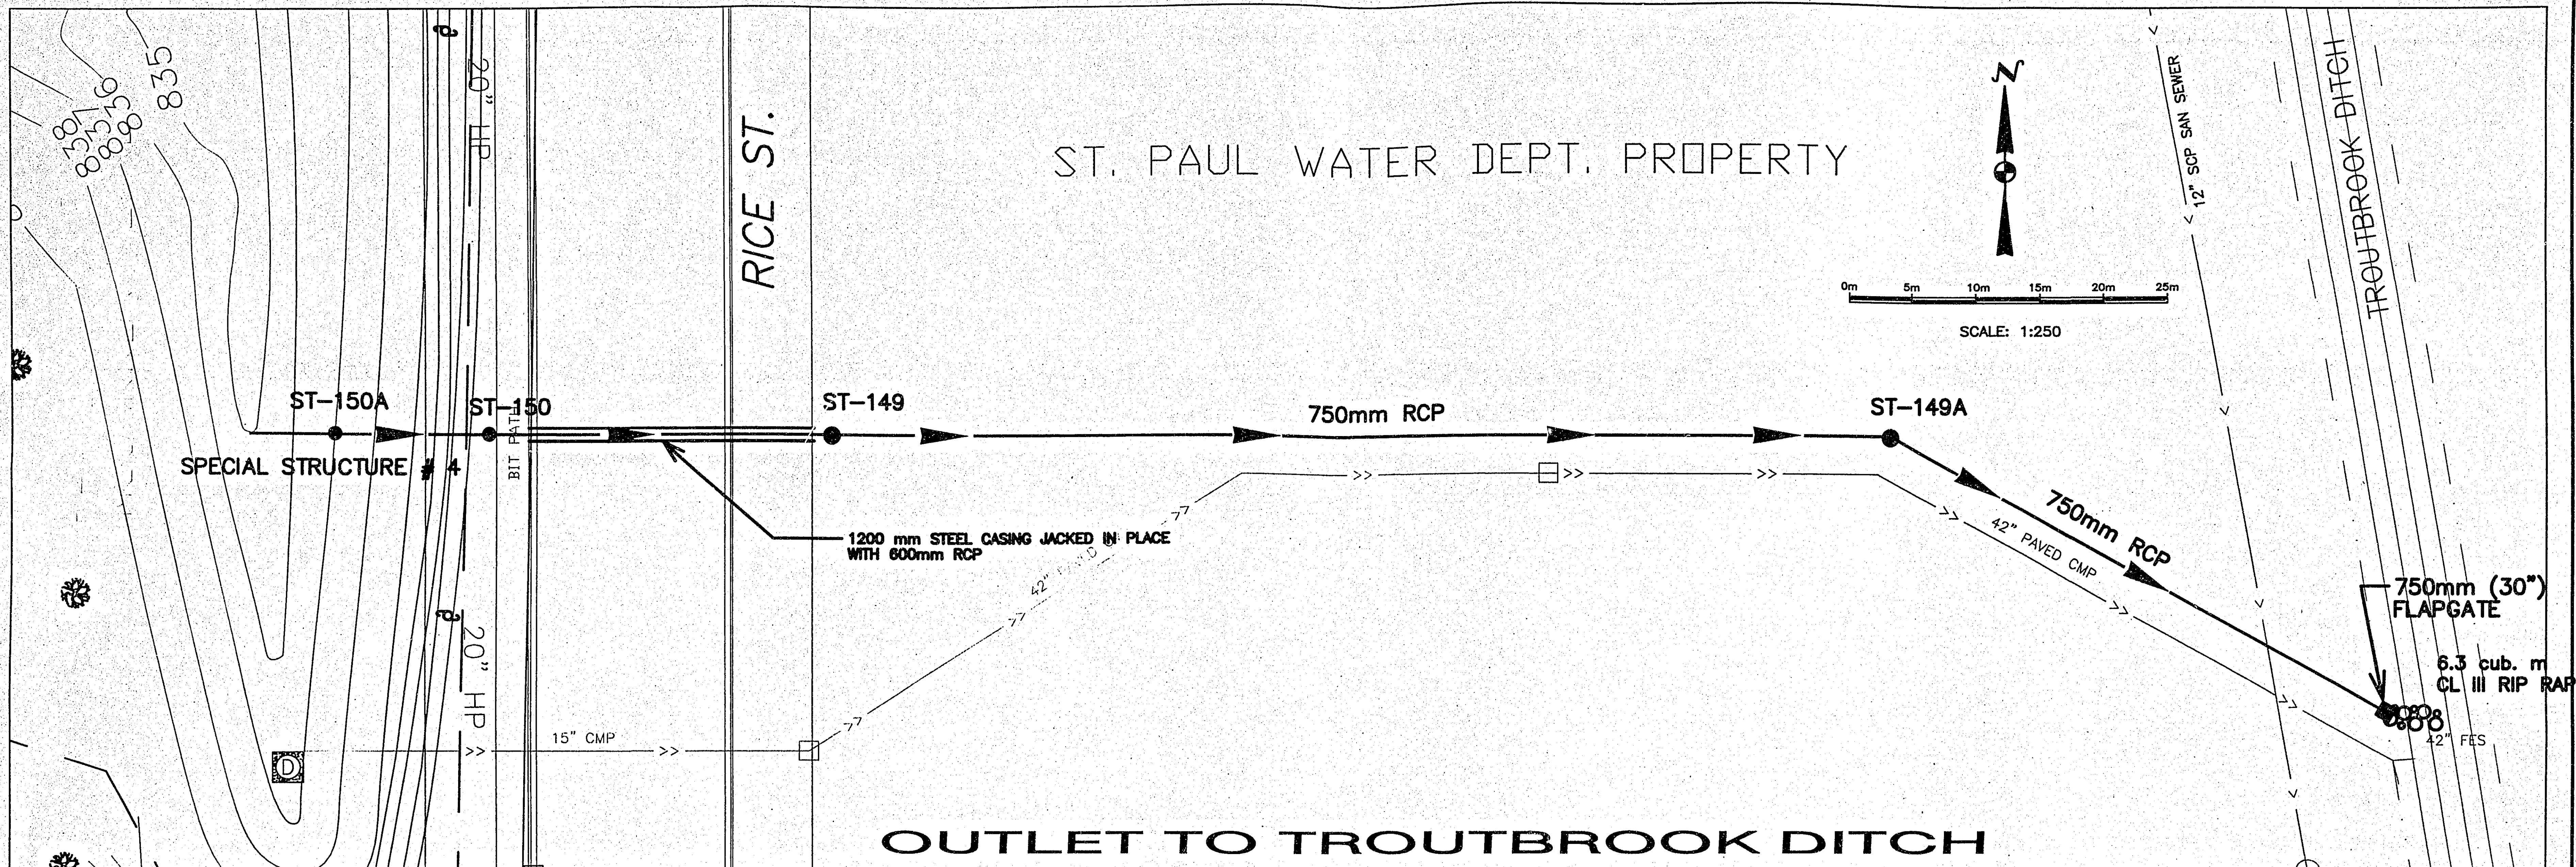

METRIC PROJECT
 THIS PLAN HAS BEEN PREPARED USING
 METRIC UNITS AND WILL BE CONSTRUCTED
 USING METRIC MEASUREMENTS

I HEREBY CERTIFY THAT THIS PLAN WAS PREPARED BY ME OR
 UNDER MY DIRECT SUPERVISION AND THAT I AM A DULY REGISTERED
 PROFESSIONAL ENGINEER UNDER THE LAWS OF THE STATE OF MINNESOTA.
 JAMES V. KENNEDY
 ASSISTANT PUBLIC WORKS DIRECTOR
 DATE 4/30/97 REG. NO. 24490

ENGINEERING DEPARTMENT
 CITY OF ROSEVILLE
 STORM SEWER CONSTRUCTION
 ST. PAUL WATER DEPT. PROPERTY
 FROM RICE ST. TO TROUTBROOK DITCH
 CITY PROJ. NO. 97-03 1997 CONTRACT "A"

G:\DATA\1997\N72-7A\ROUTER