

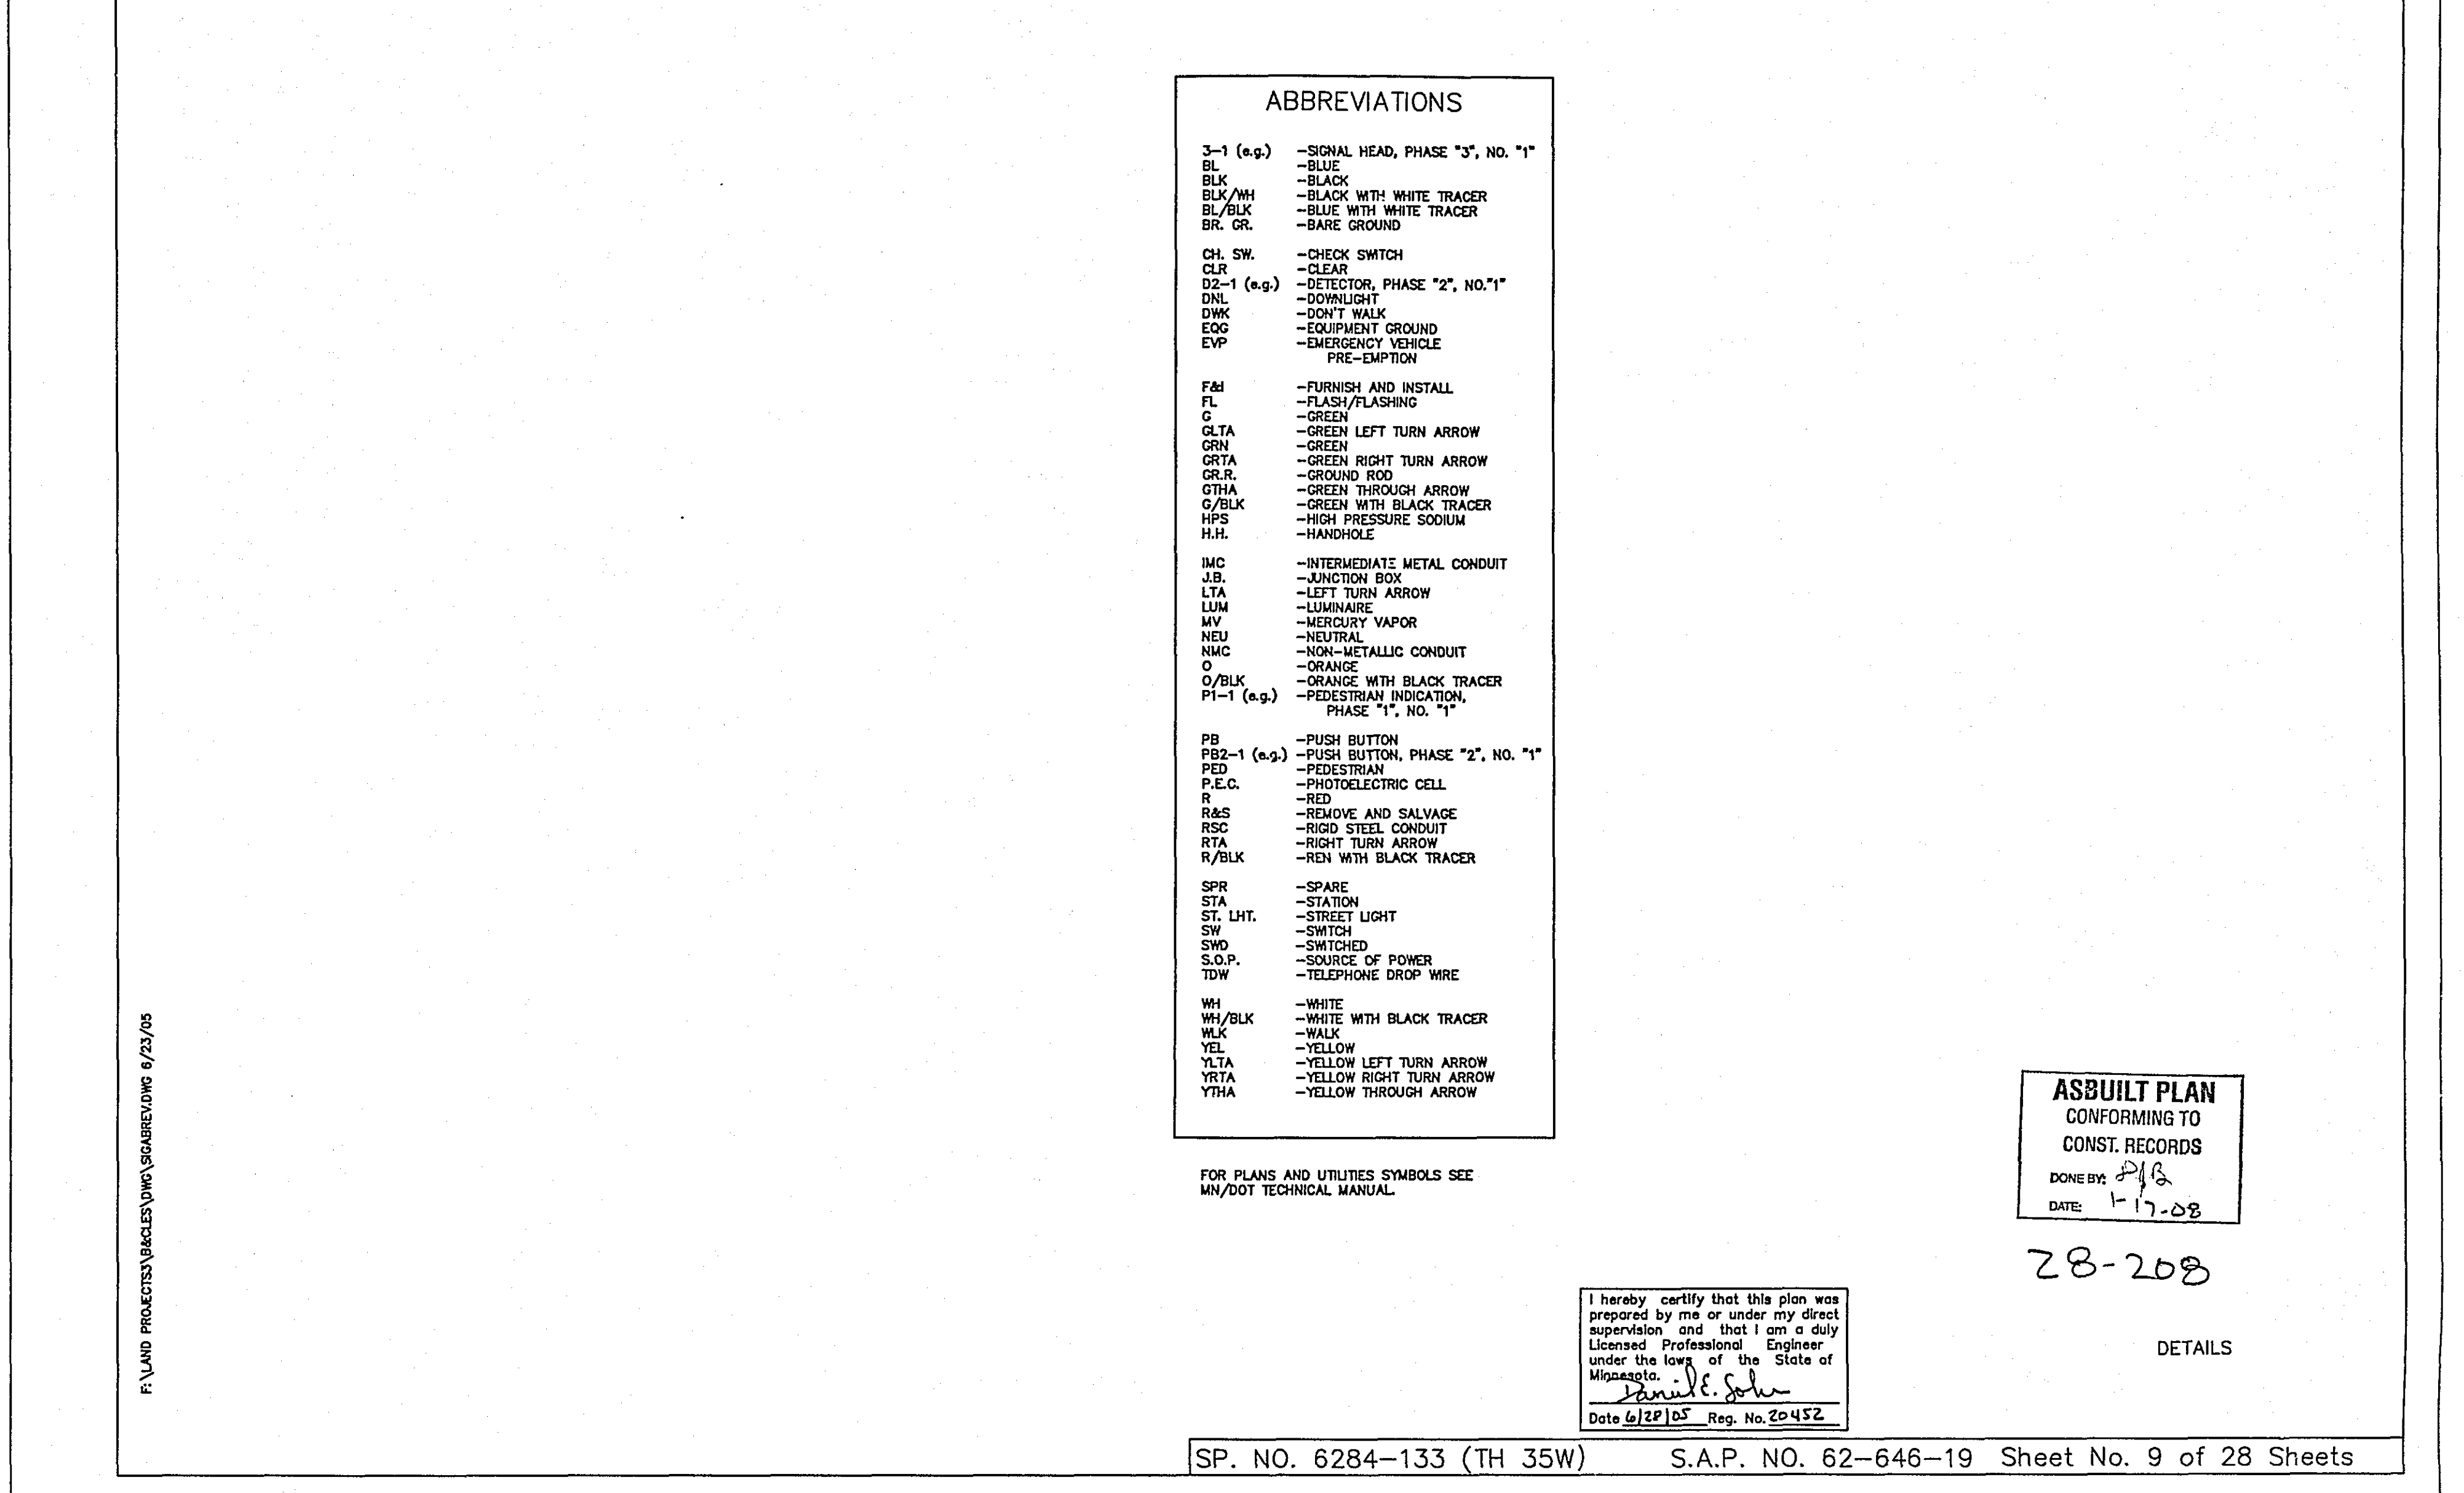
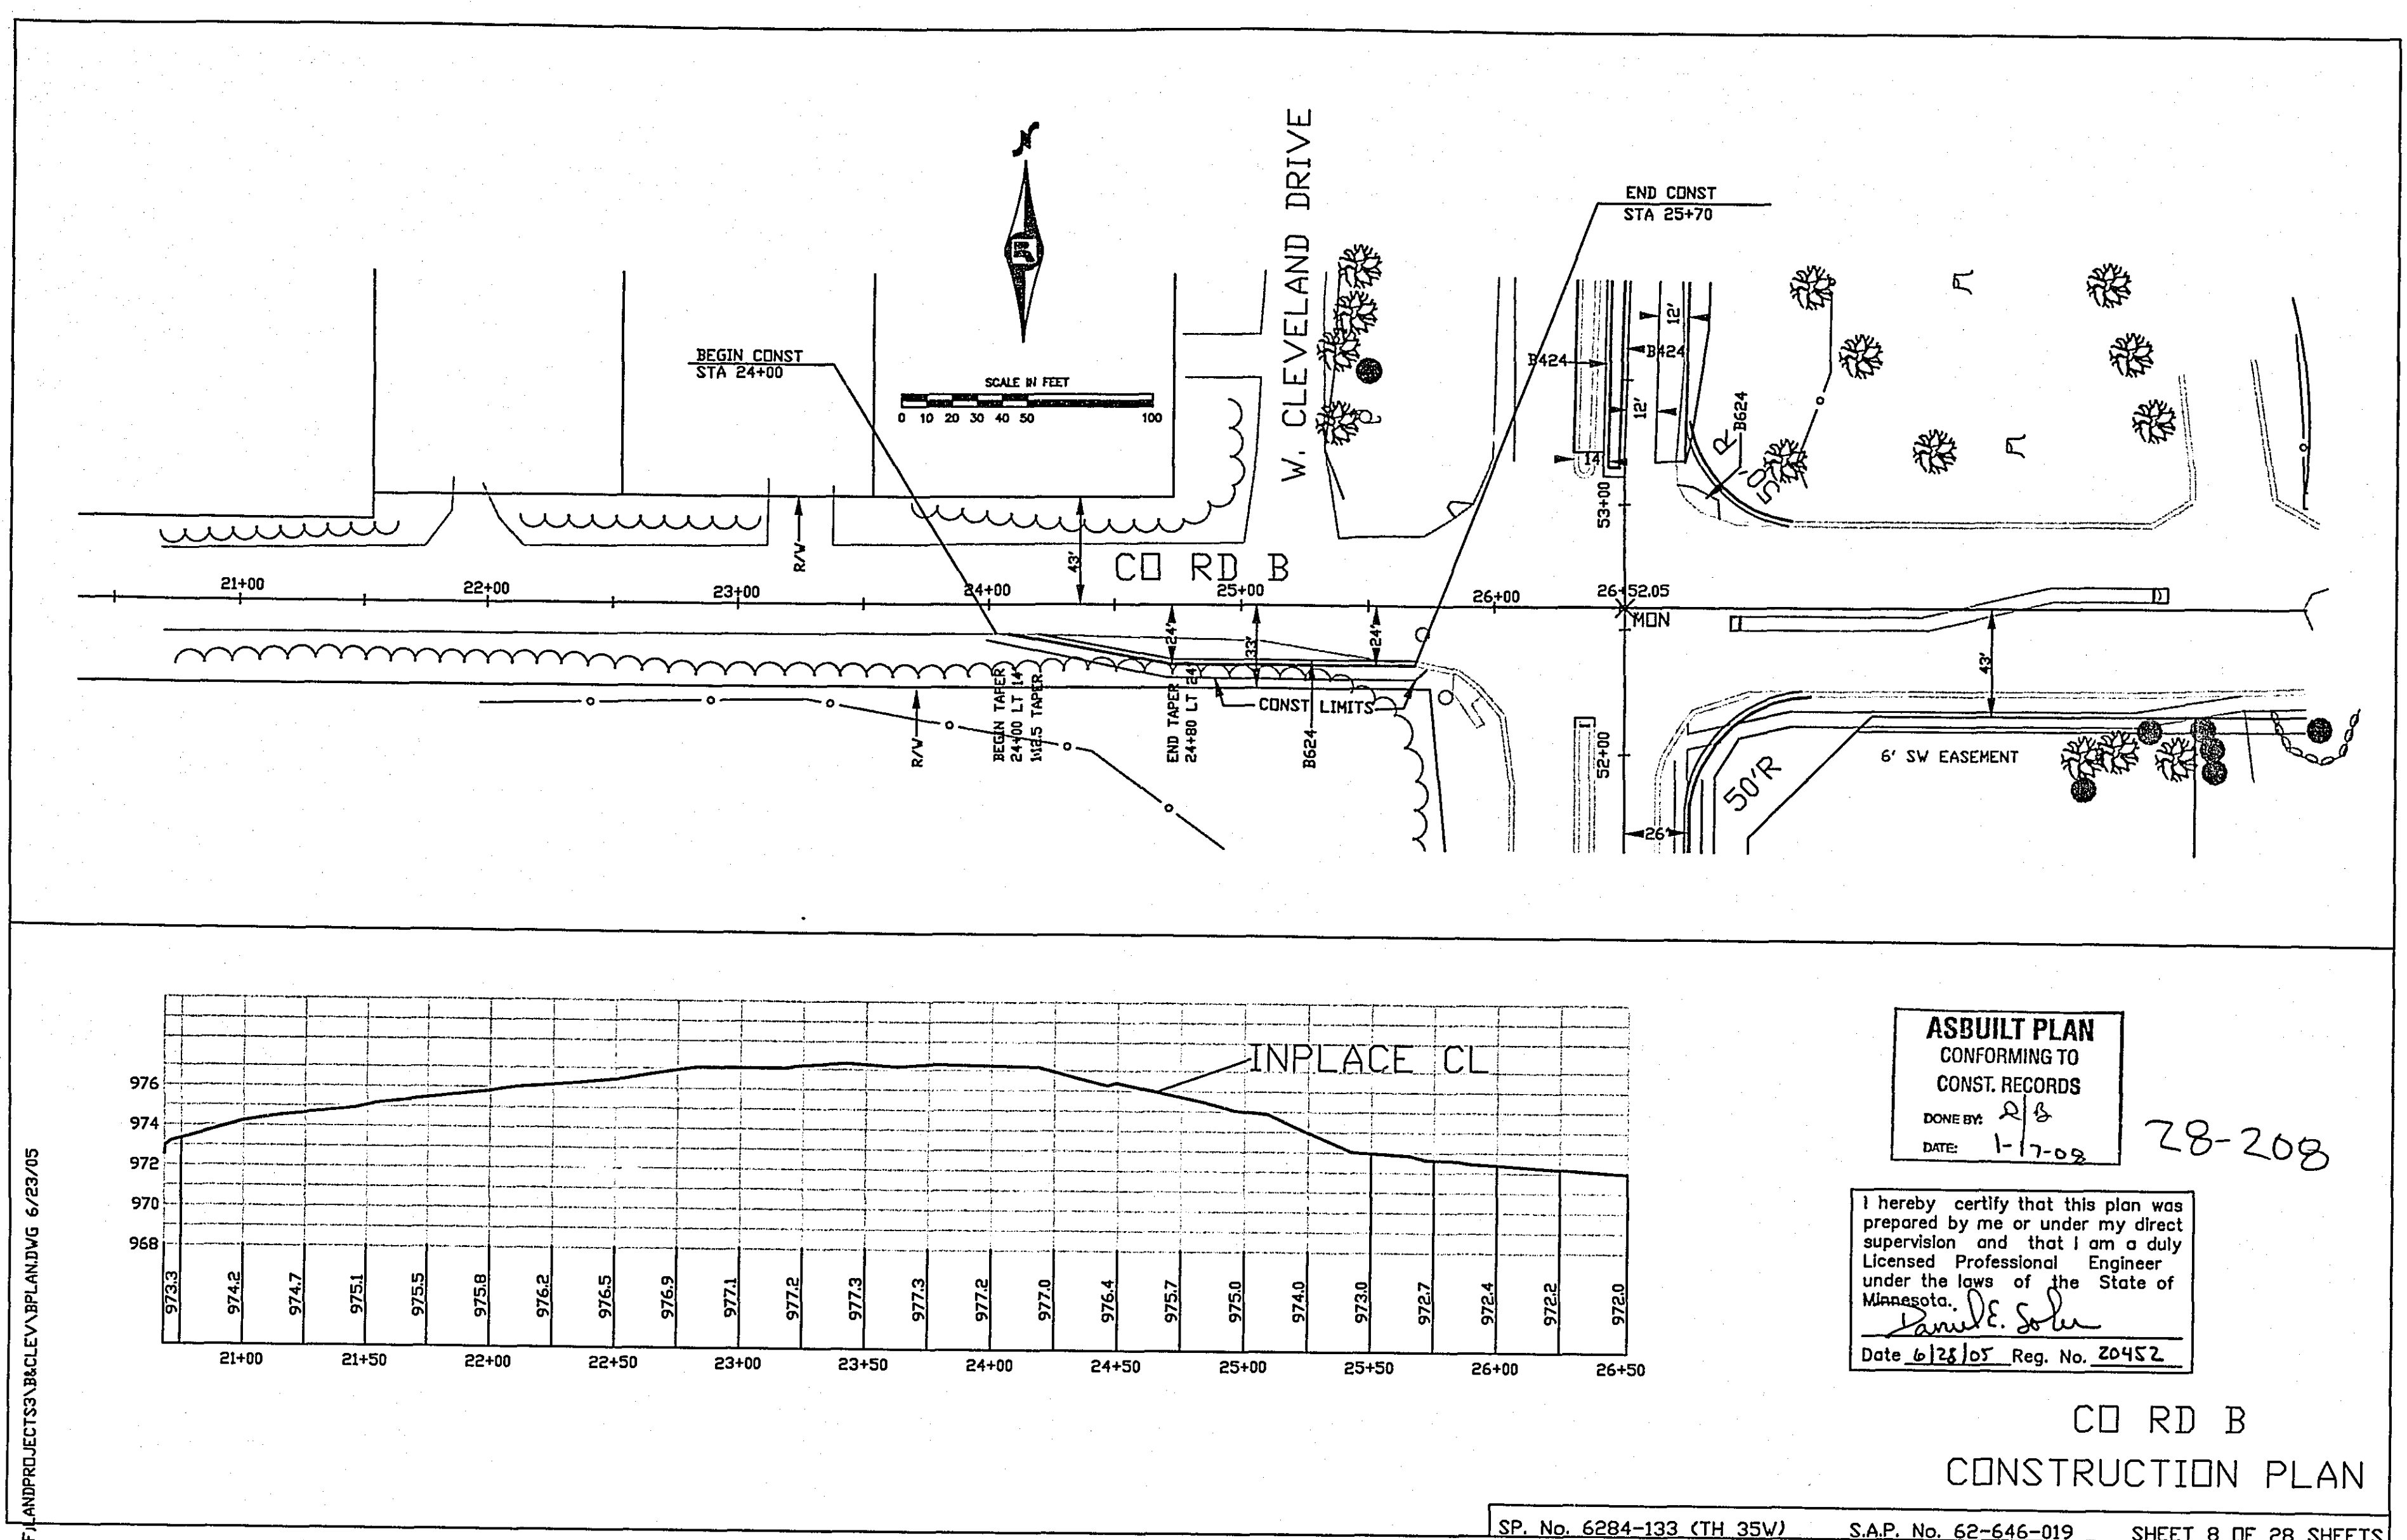





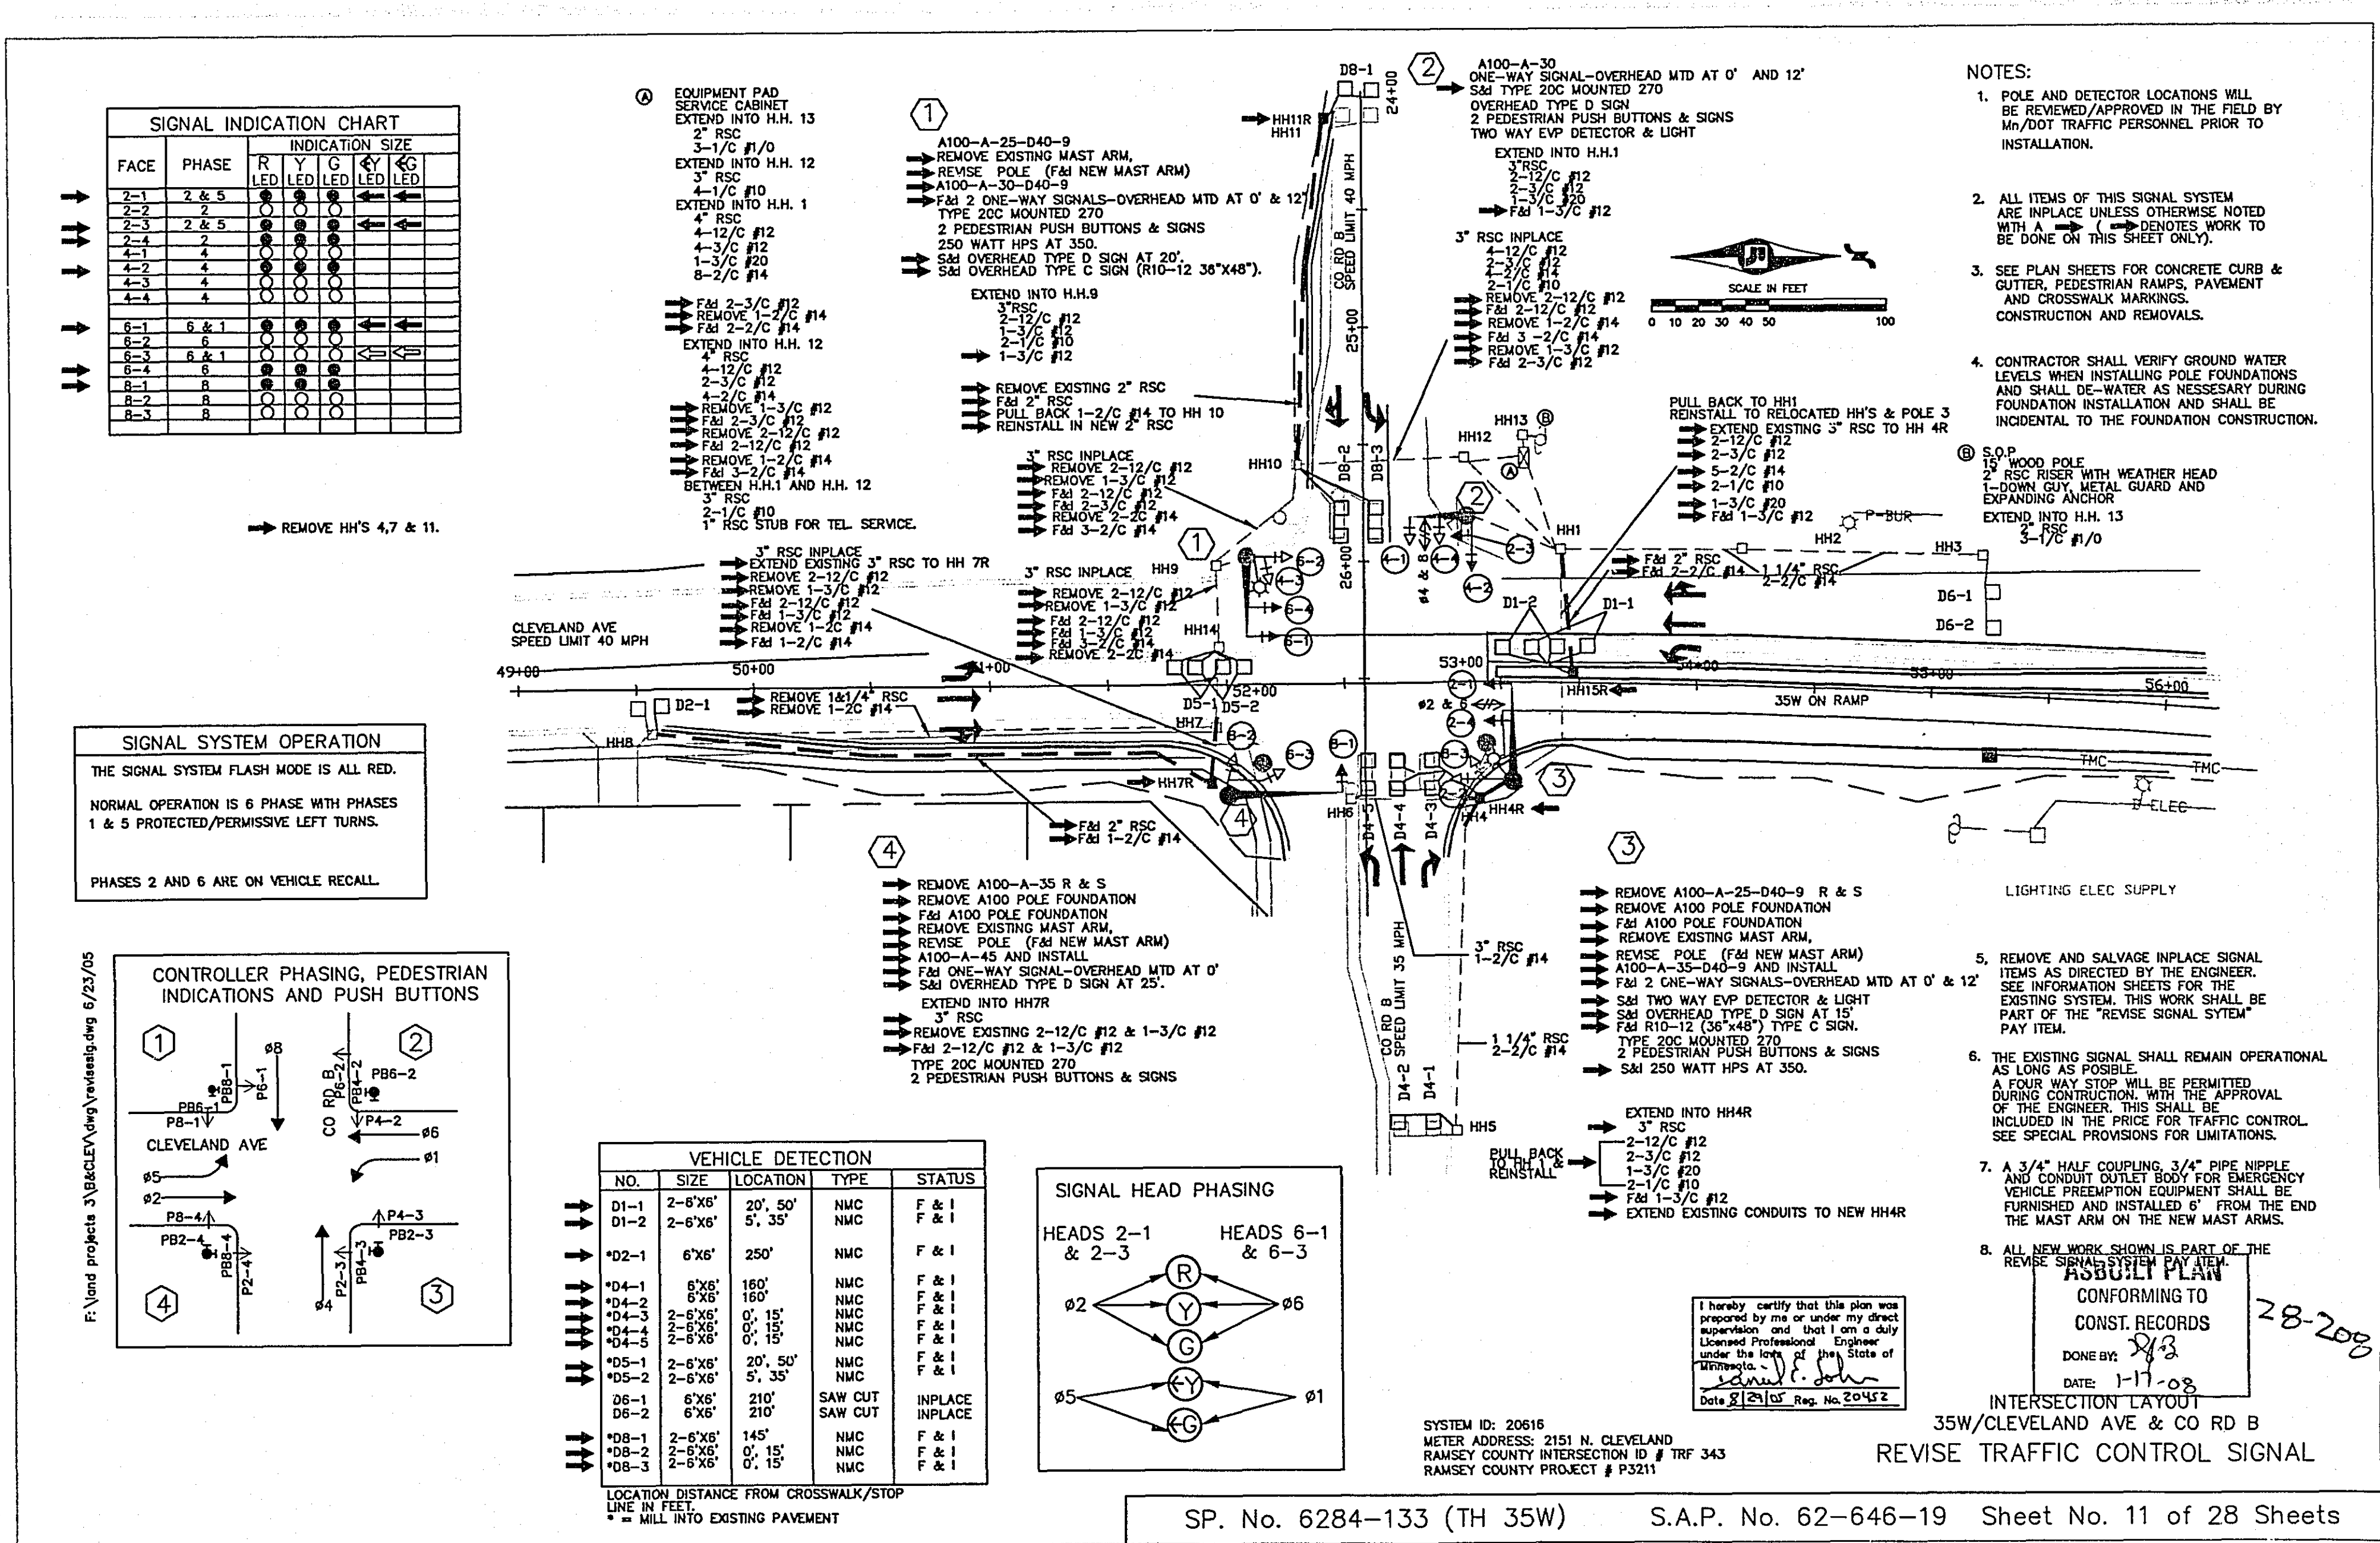






ABBREVIATIONS


3-1 (e.g.)	-SIGNAL HEAD, PHASE "3", NO. "1"
BL	-BLUE
BLK/WH	-BLACK WITH WHITE TRACER
BLK/BLK	-BLUE WITH WHITE TRACER
BR. CL.	-BASE GRADE
CH. SW.	-CHECK SWITCH
CLR	-CLEAR
DD-1 (e.g.)	-DETECTOR, PHASE "2", NO. "1"
DNL	-DOWNLIGHT
DOT	-DOT MARK
ECC	-EQUIPMENT GROUND
EVP	-EMERGENCY VEHICLE
PRE-EMPT	-PRE-EMPTION
FAI	-FURNISH AND INSTALL
FL	-FLASH/FLASHING
G	-GREEN
CLTA	-GREEN LEFT TURN ARROW
GRN	-GREEN
GRTA	-GREEN RIGHT TURN ARROW
GRS	-GROUND ROD
GTHA	-GREEN THROUGH ARROW
O/BLK	-GREEN WITH BLACK TRACER
HPS	-HIGH PRESSURE SODIUM
H.H.	-HANDHOLE
IMC	-INTERMEDIATE METAL CONDUIT
J.B.	-JUNCTION BOX
LTA	-LEFT TURN ARROW
LUM	-LUMINAIRE
MV	-MERCURY VAPOR
NEU	-NEUTRAL
NMC	-NON-METALLIC CONDUIT
O	-ORANGE
O/BLK	-ORANGE WITH BLACK TRACER
P1-1 (e.g.)	-PEDESTRIAN INDICATION, PHASE "1", NO. "1"
PB	-PUSH BUTTON
PB2-1 (e.g.)	-PUSH BUTTON, PHASE "2", NO. "1"
PE	-PEDESTRIAN
P.E.C.	-PHOTOELECTRIC CELL
R&S	-REMOVE AND SALVAGE
RSC	-ROAD STEEL CONDUIT
RTA	-RIGHT TURN ARROW
R/BLK	-RED WITH BLACK TRACER
SPR	-SPARK
STA	-STATION
ST. LHT.	-STREET LIGHT
SW	-SWITCH
SWO	-SWITCHED
S.O.P.	-SOURCE OF POWER
TDW	-TELEPHONE DROP WIRE
WH	-WHITE
WH/BLK	-WHITE WITH BLACK TRACER
WLK	-WALK
YEL	-YELLOW
Y/LTA	-YELLOW LEFT TURN ARROW
Y/RTA	-YELLOW RIGHT TURN ARROW
Y/TA	-YELLOW THROUGH ARROW

FOR PLANS AND UTILITIES SYMBOLS SEE MNDOT TECHNICAL MANUAL.

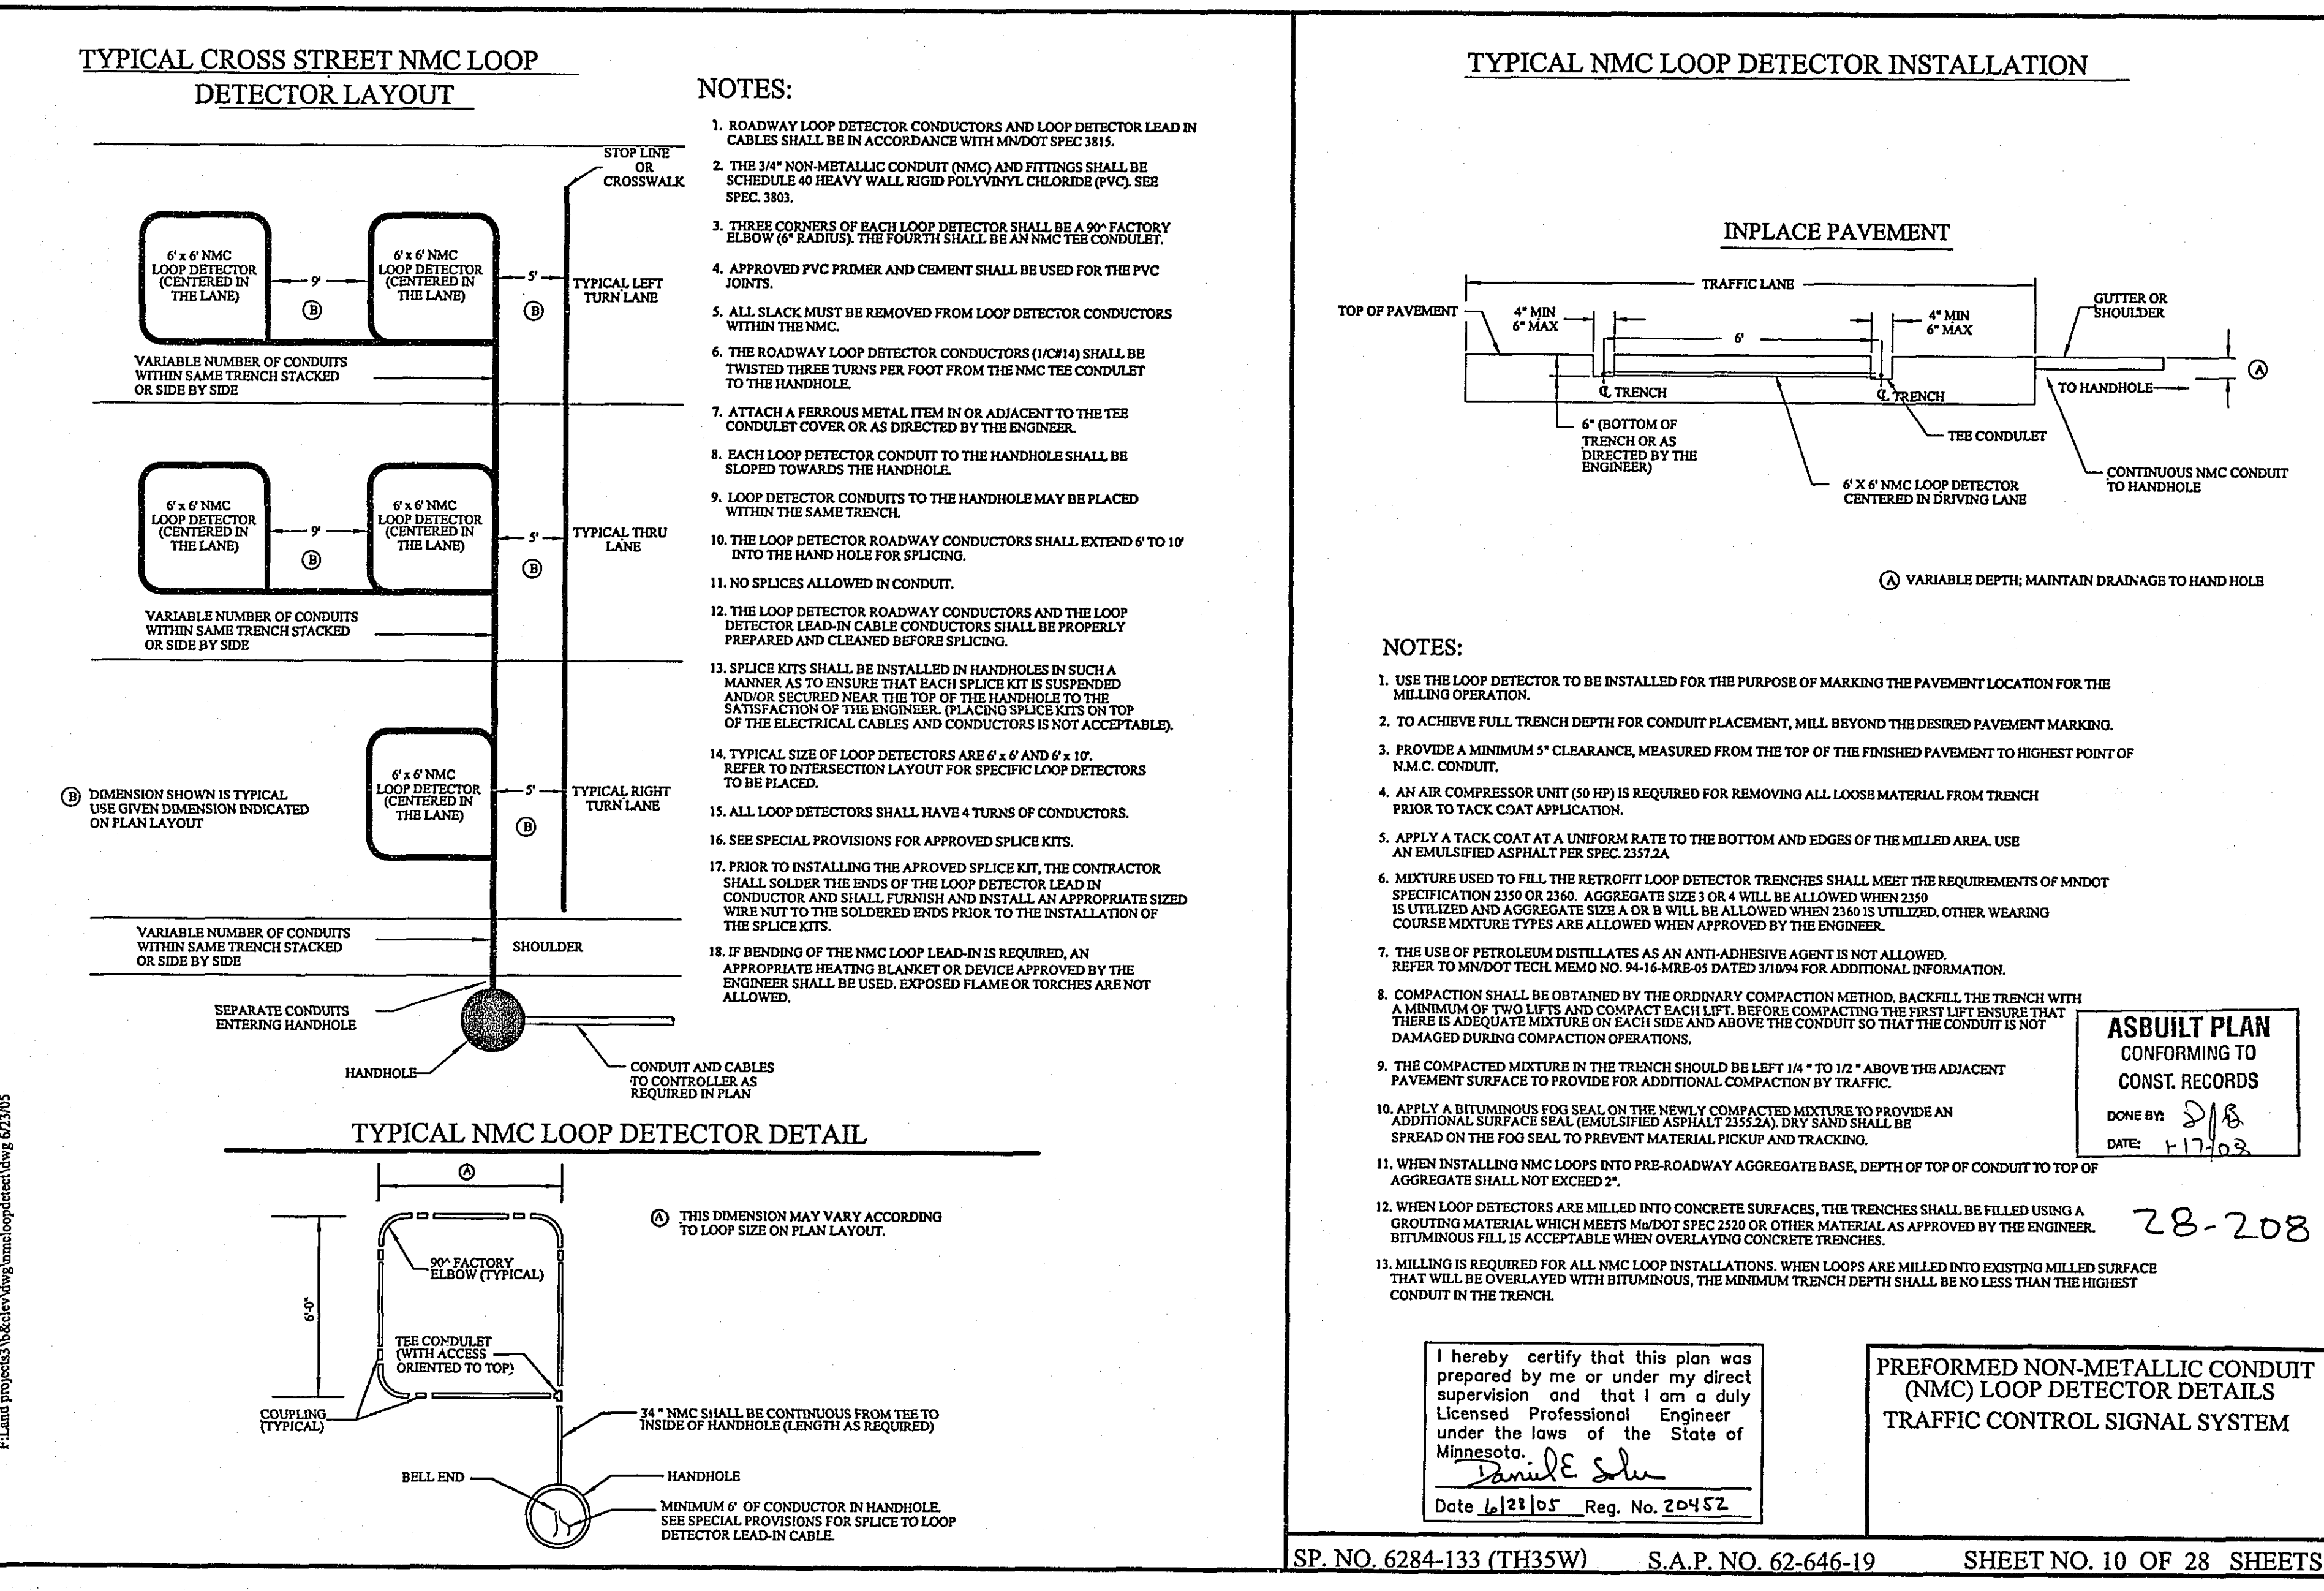

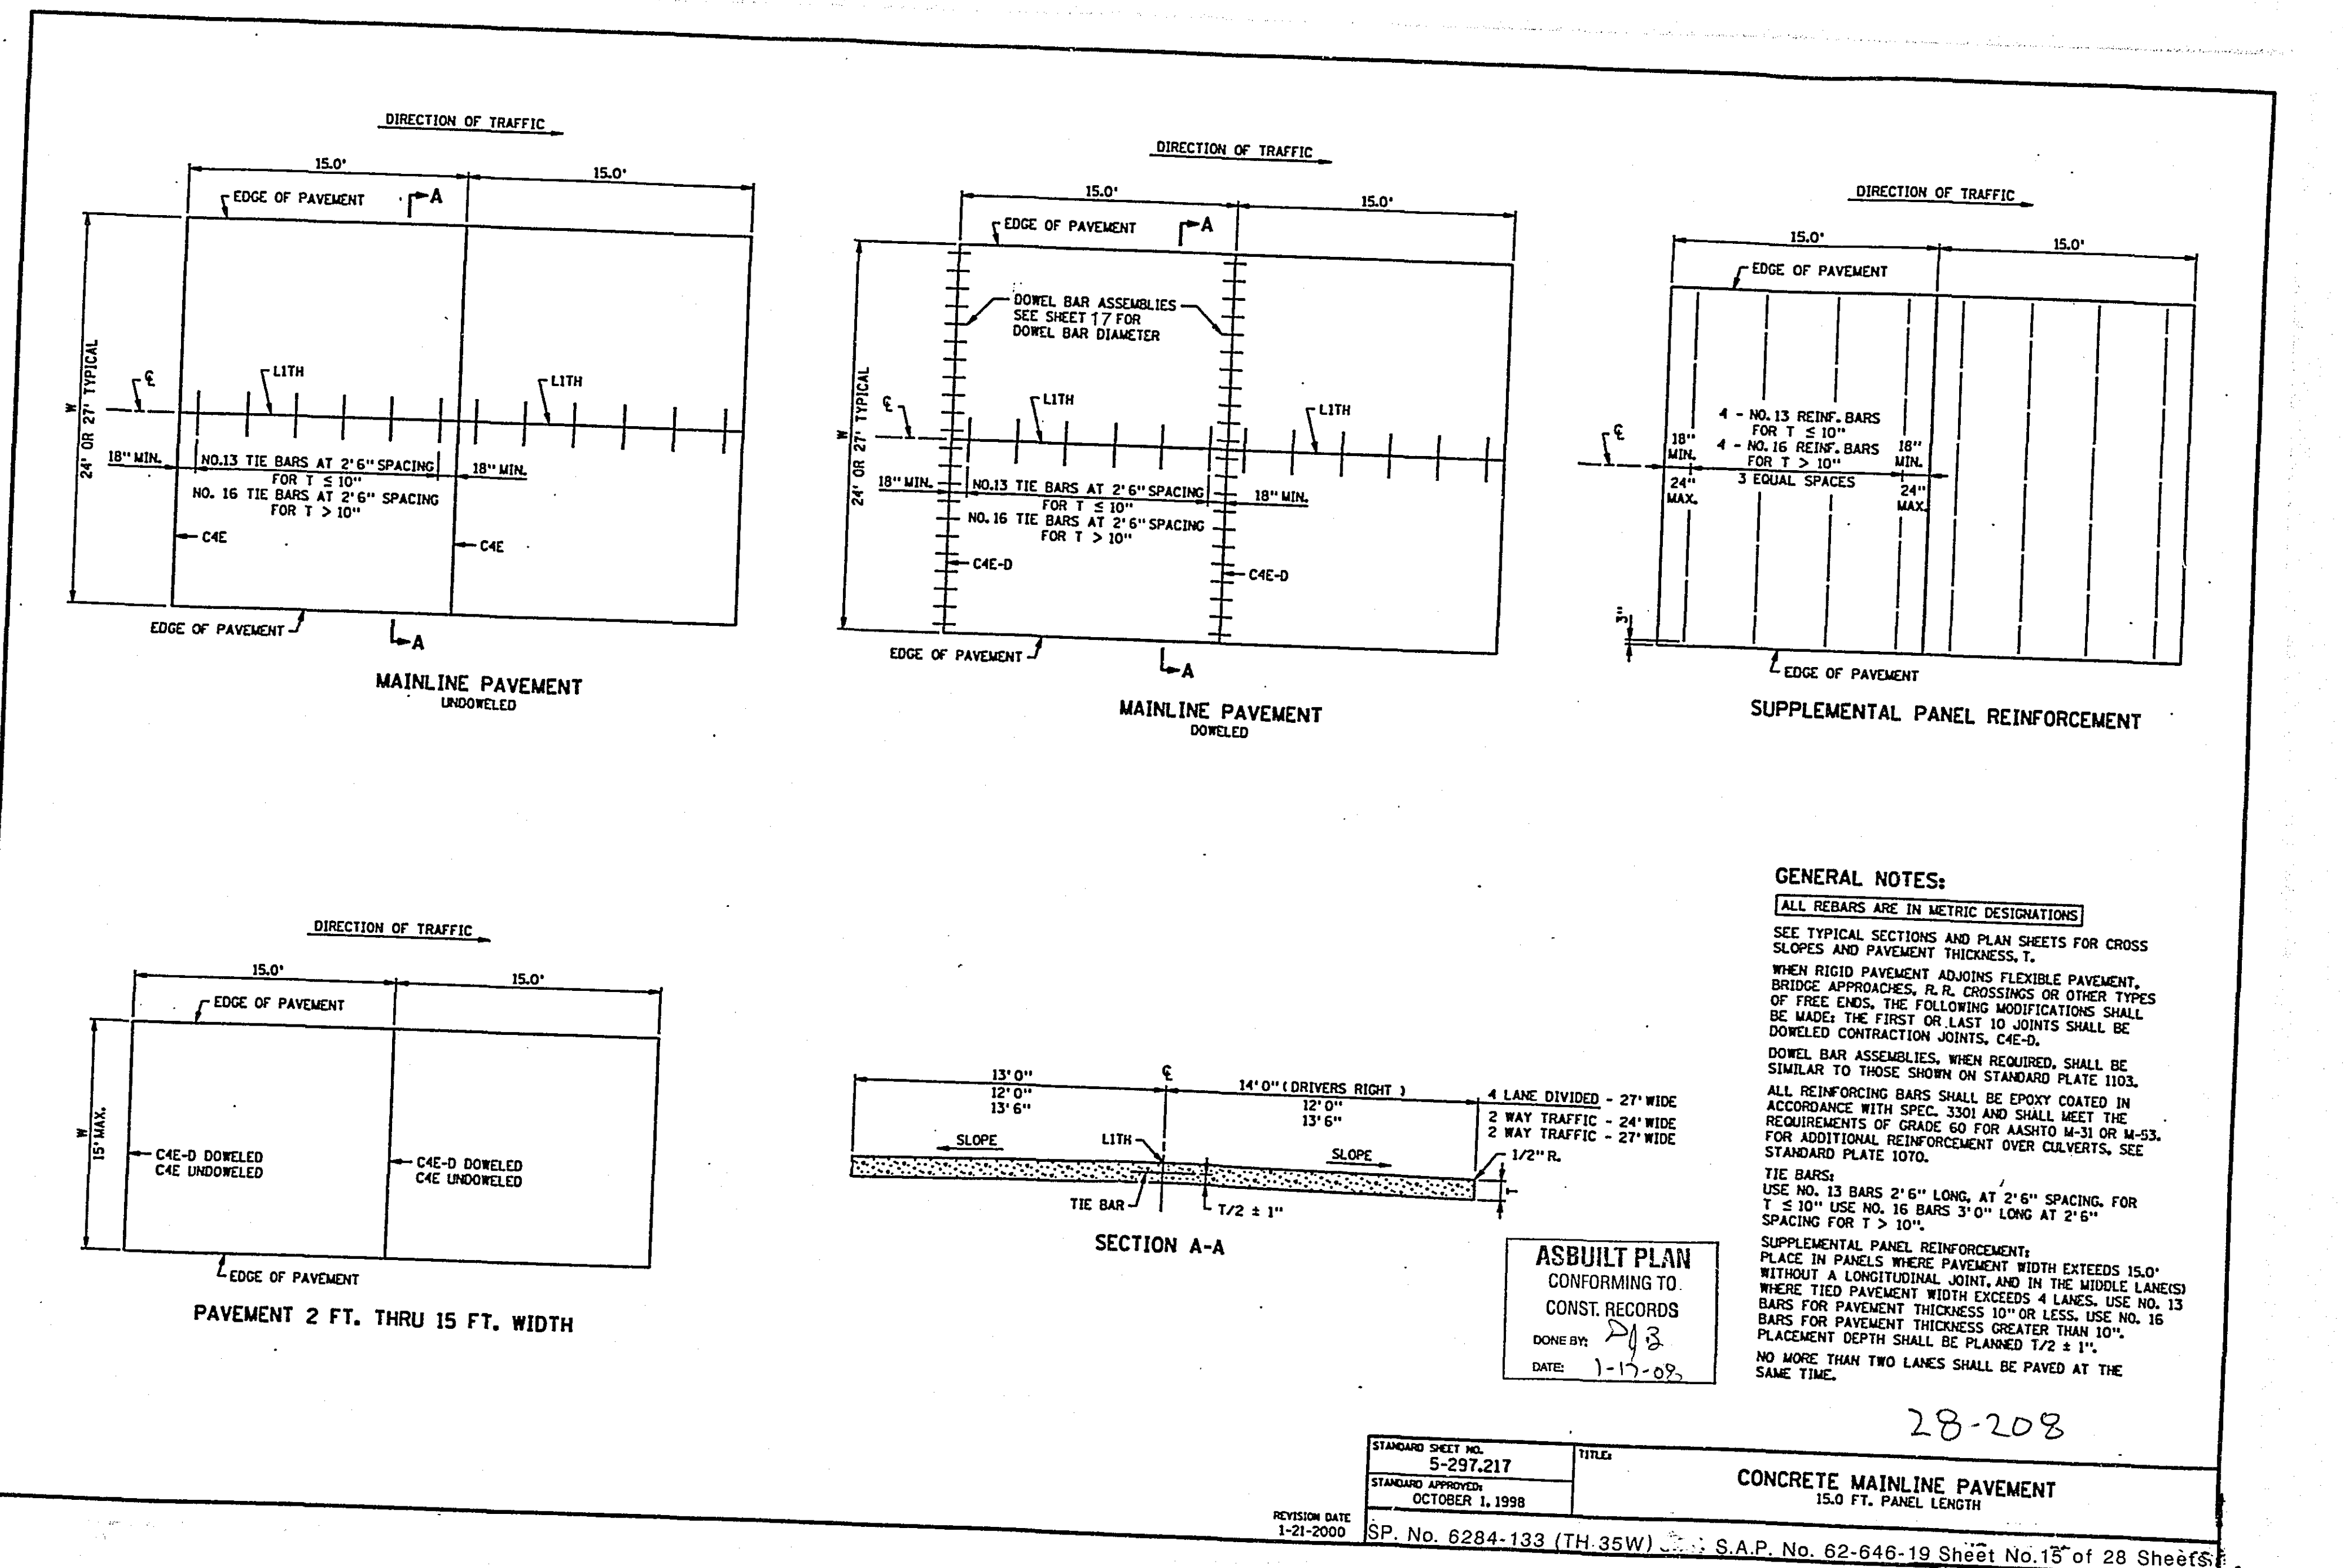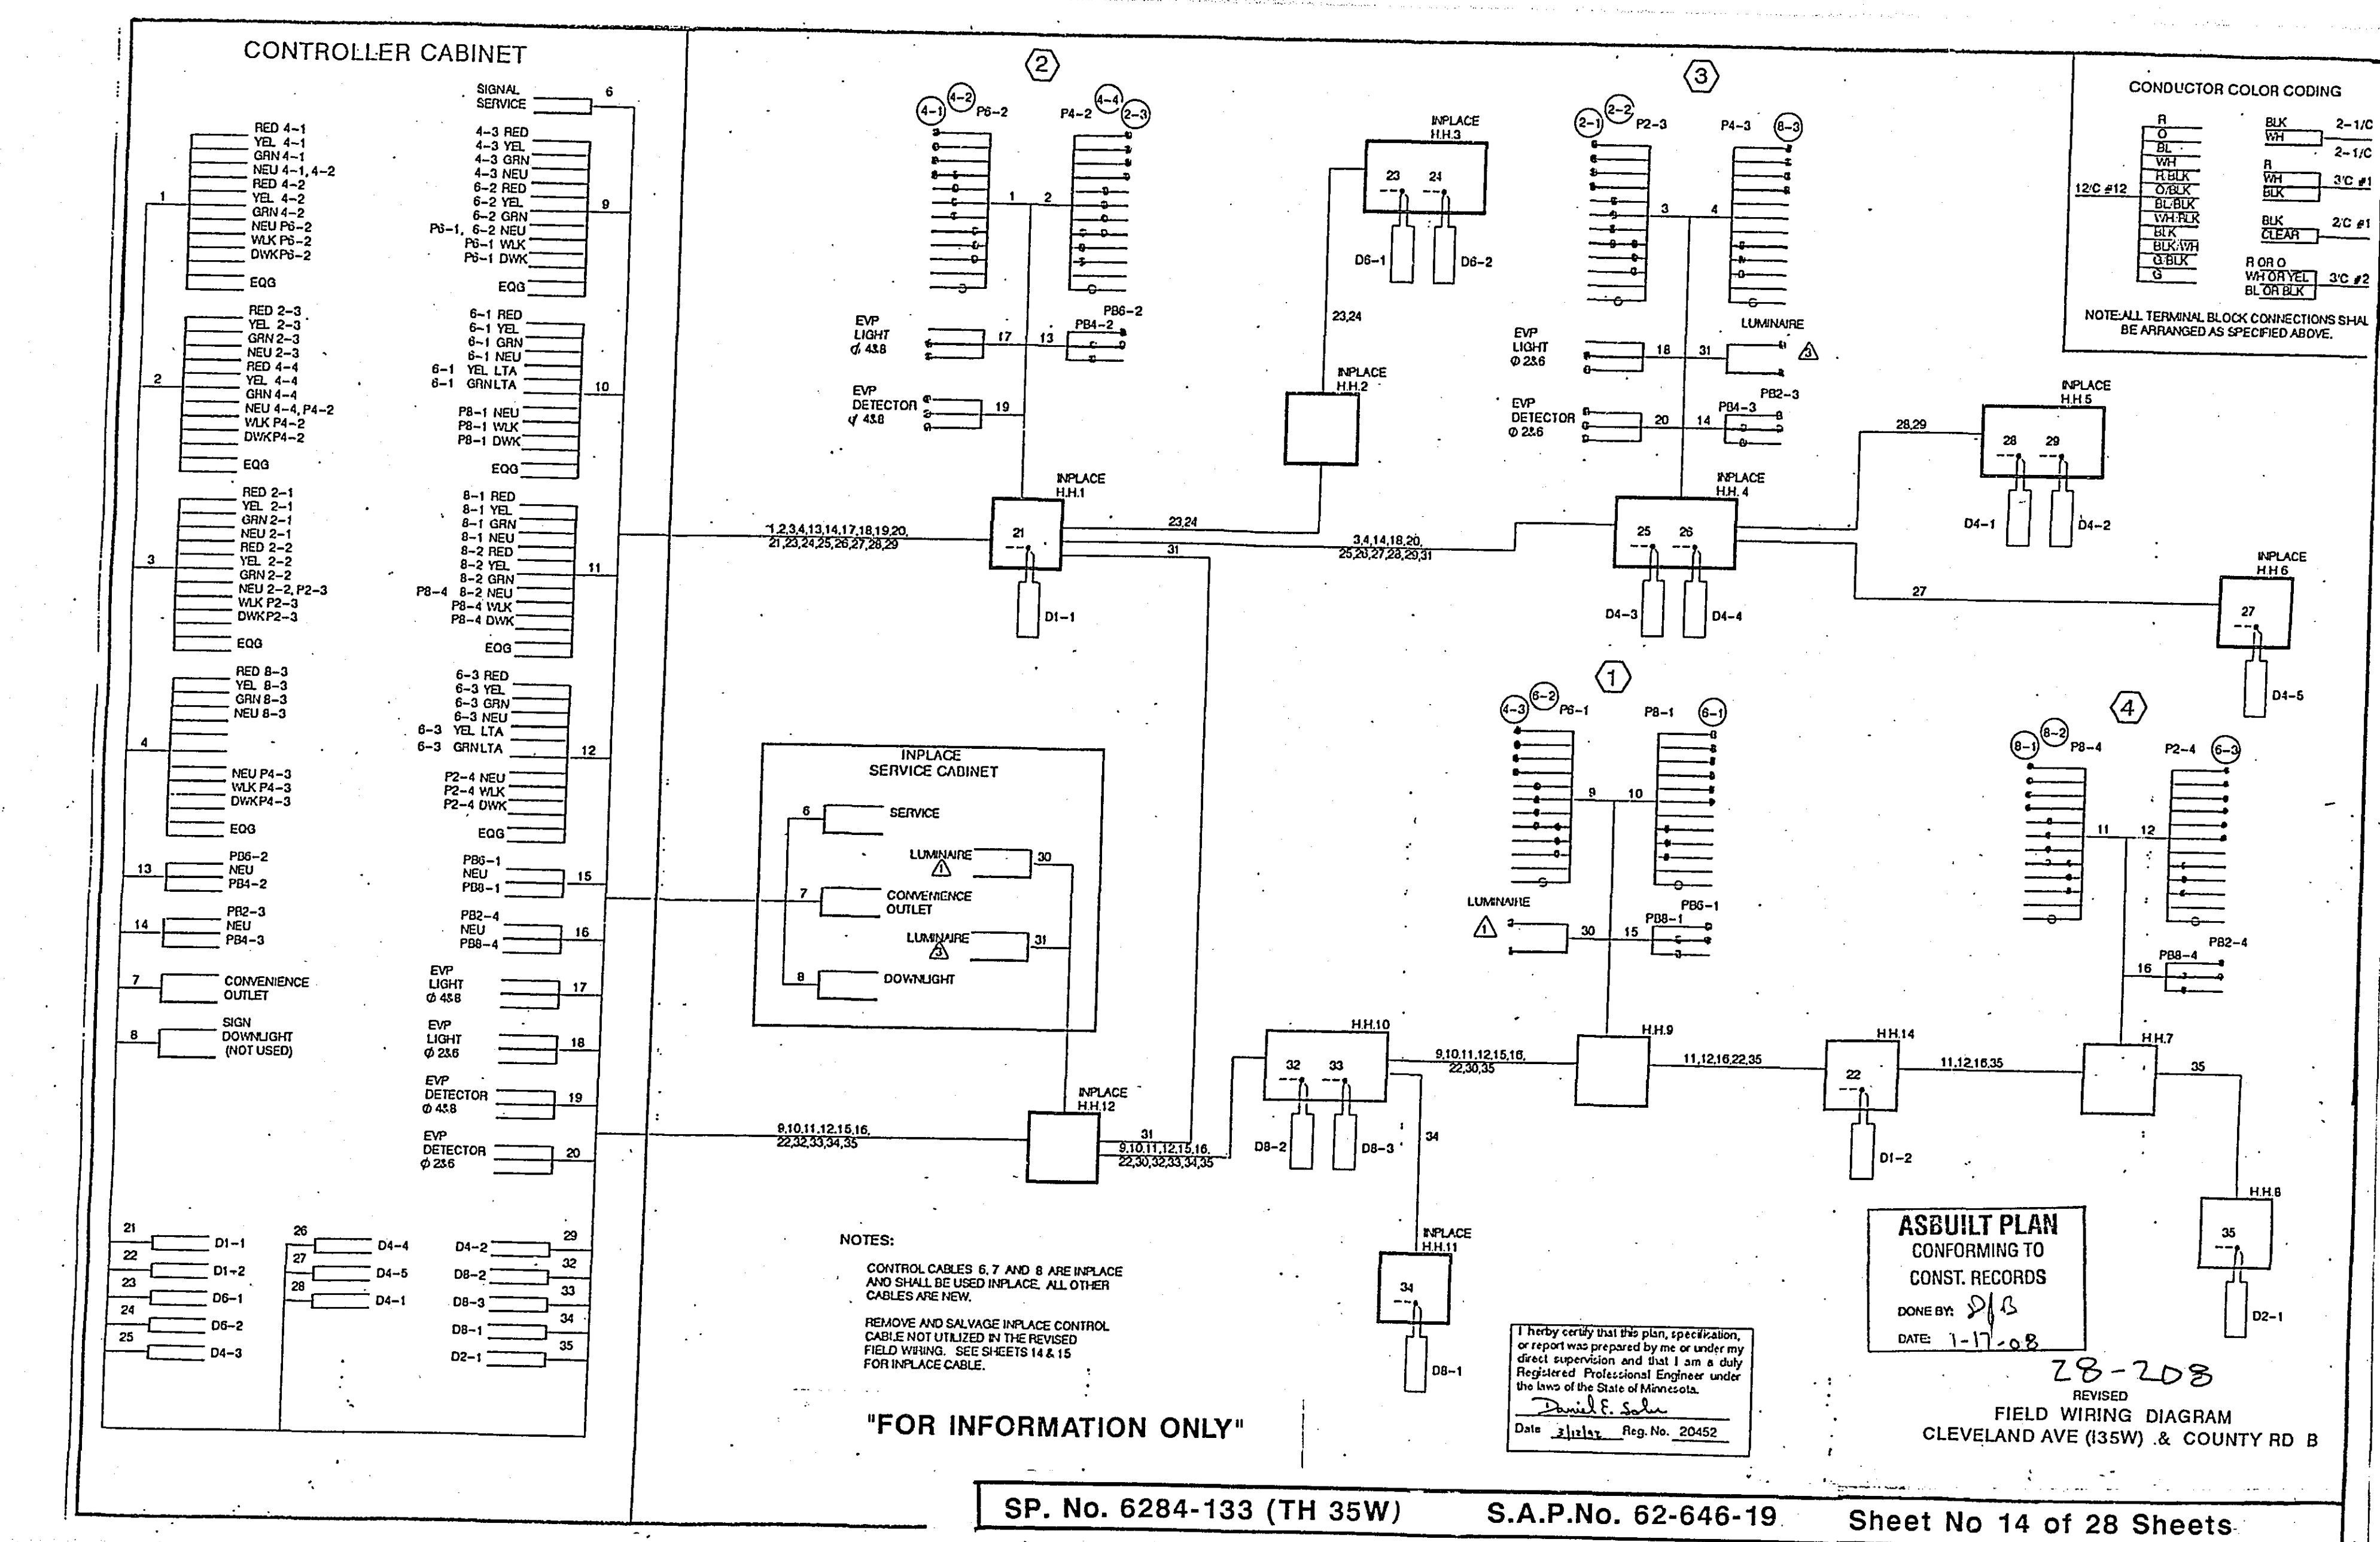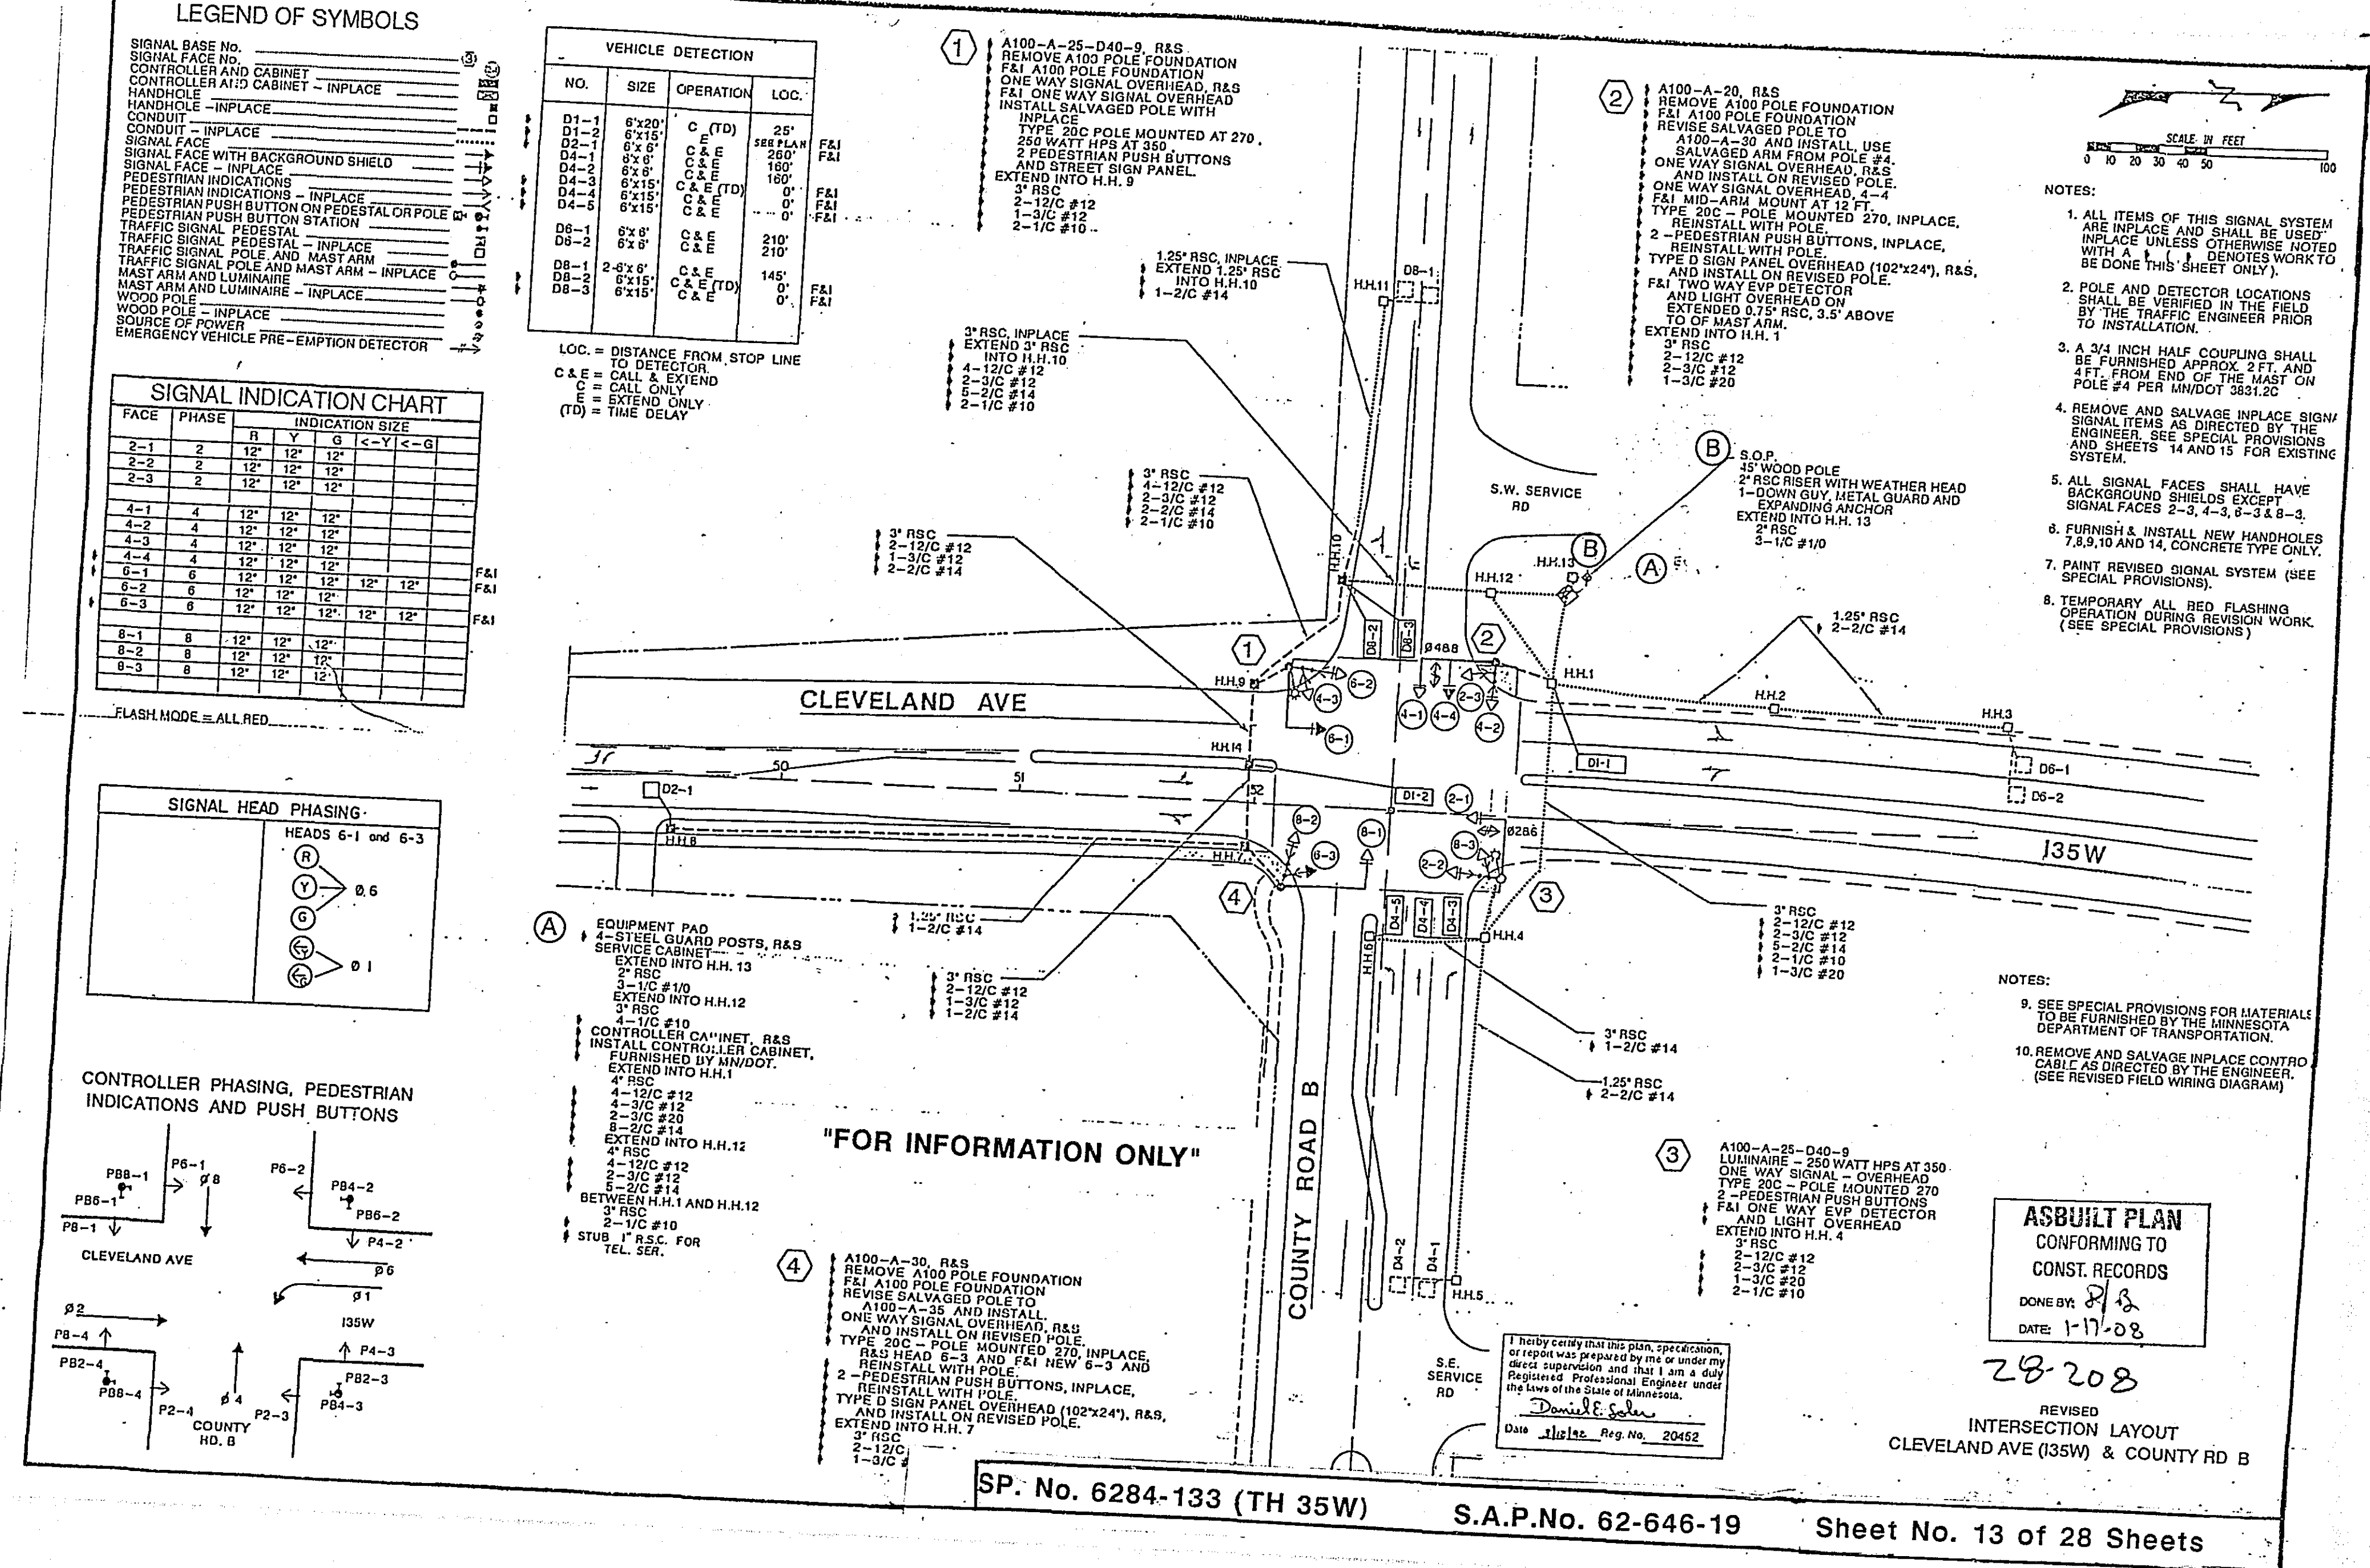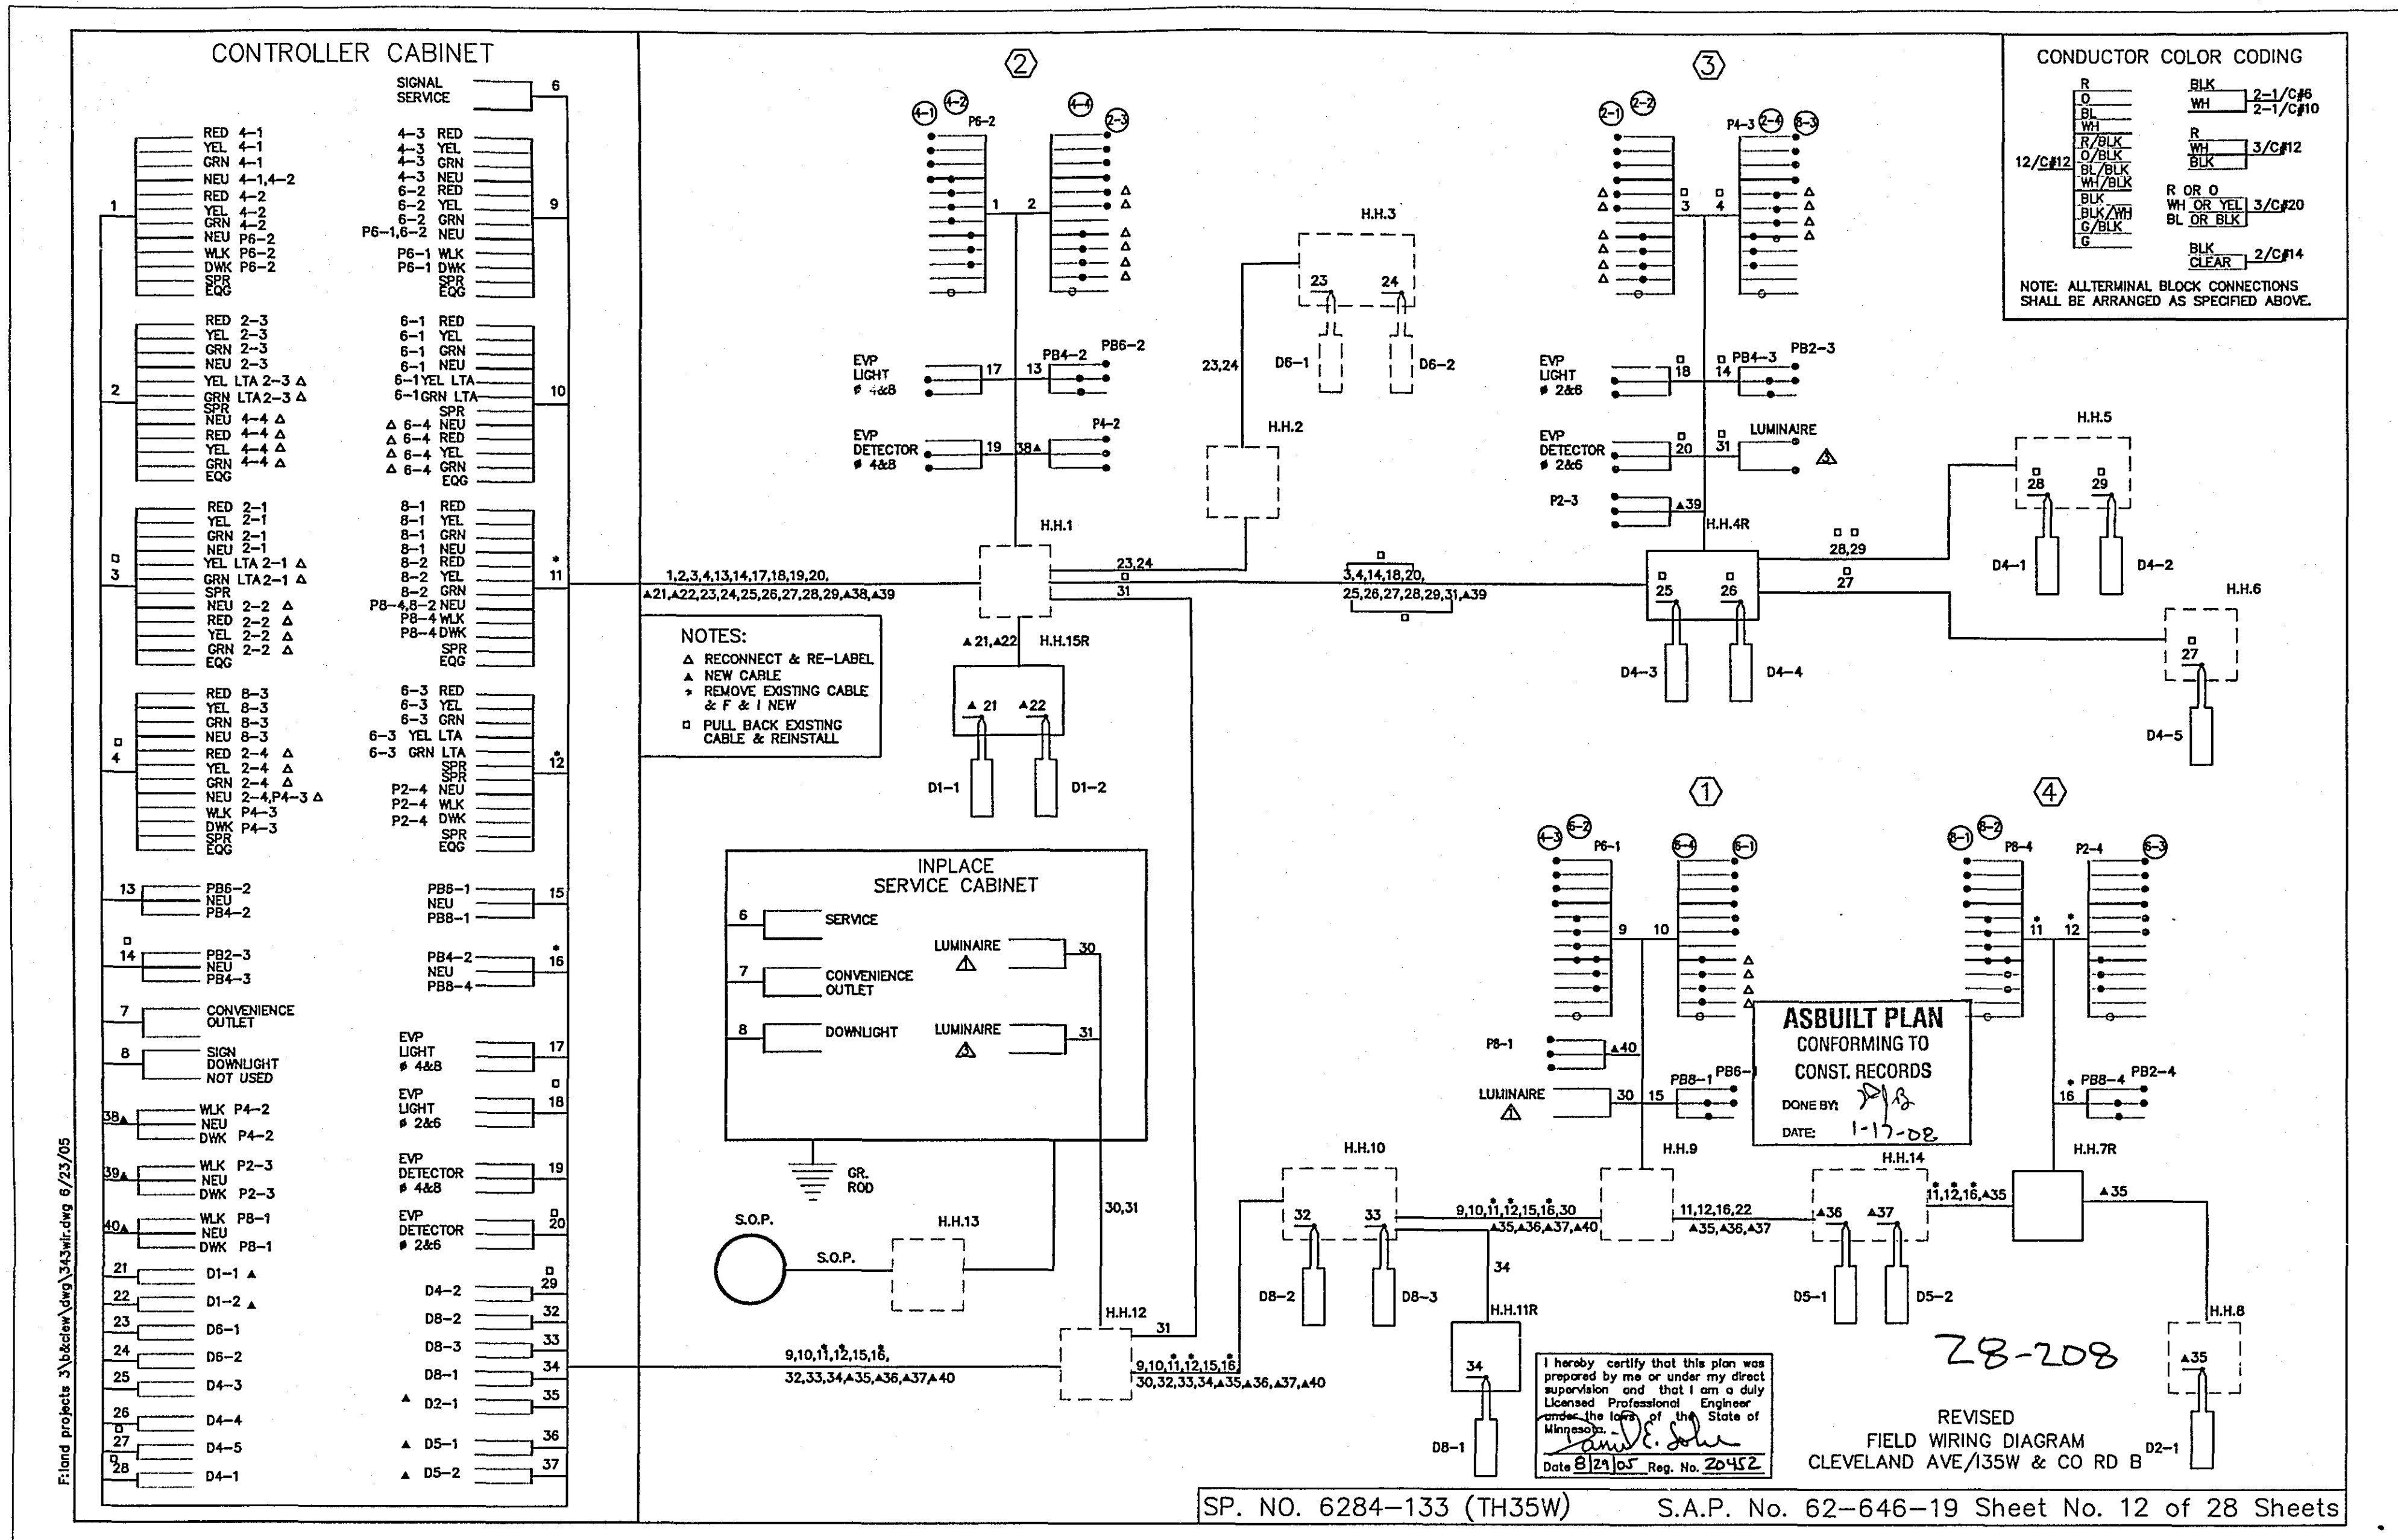

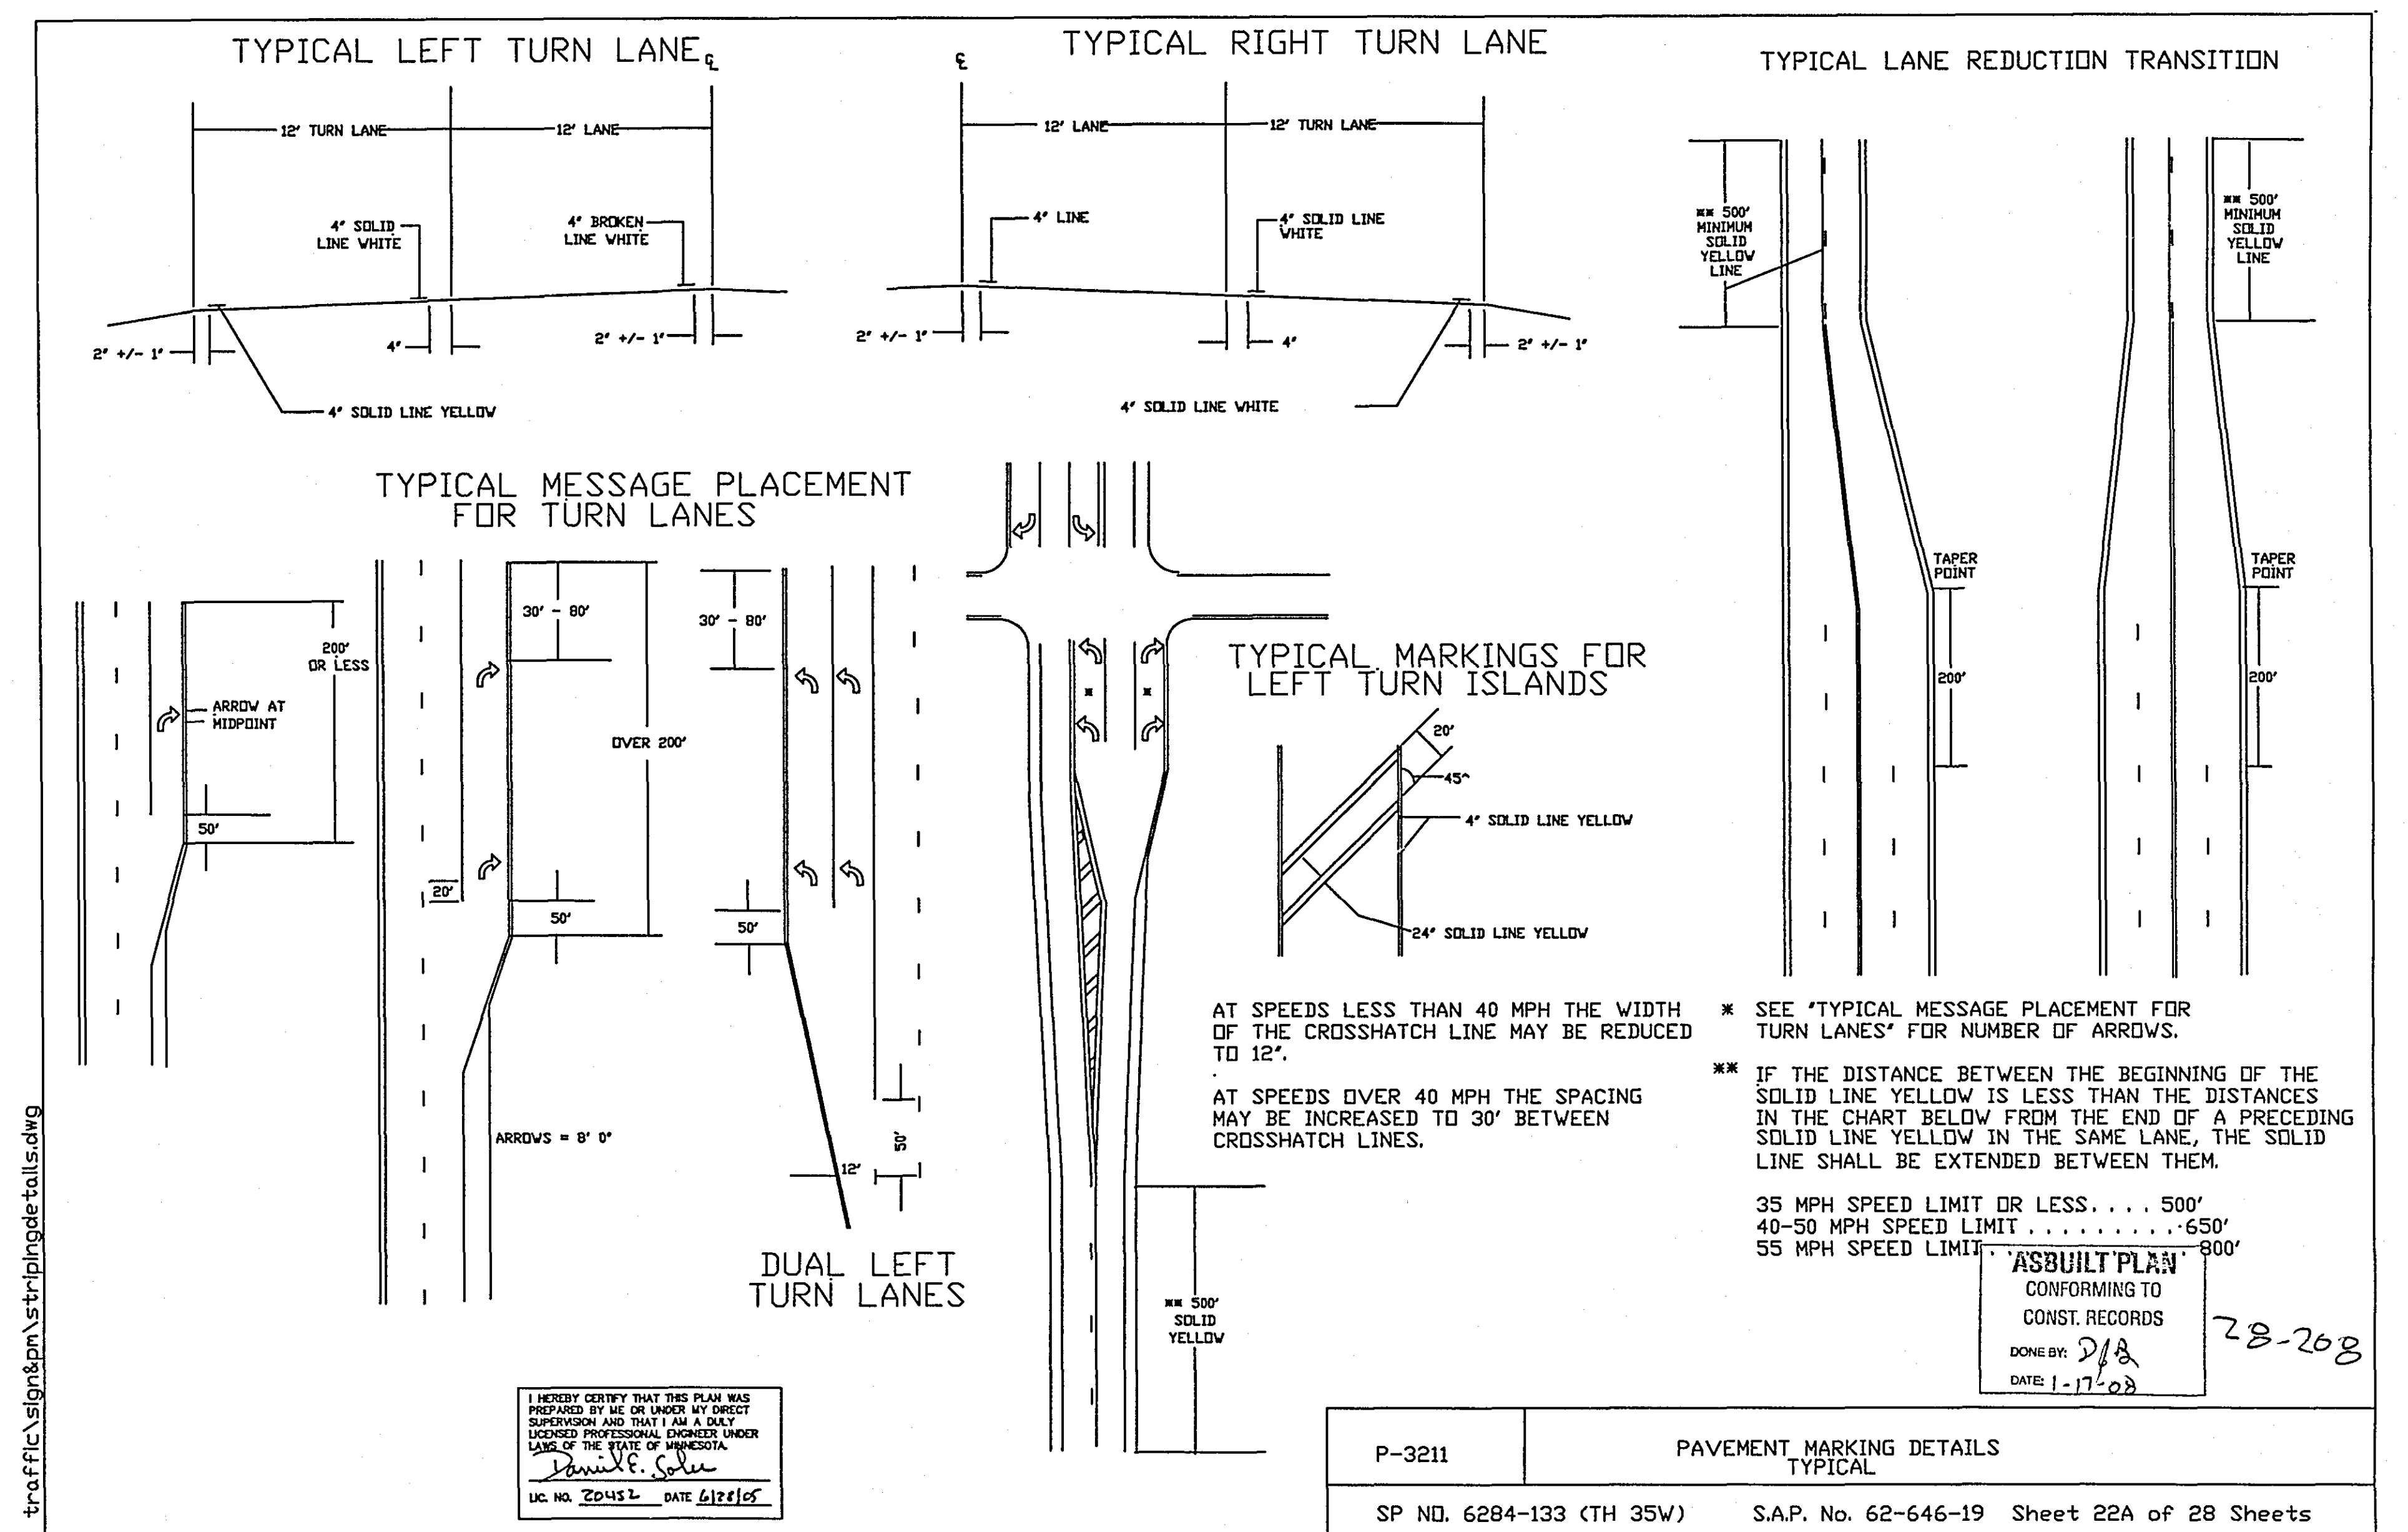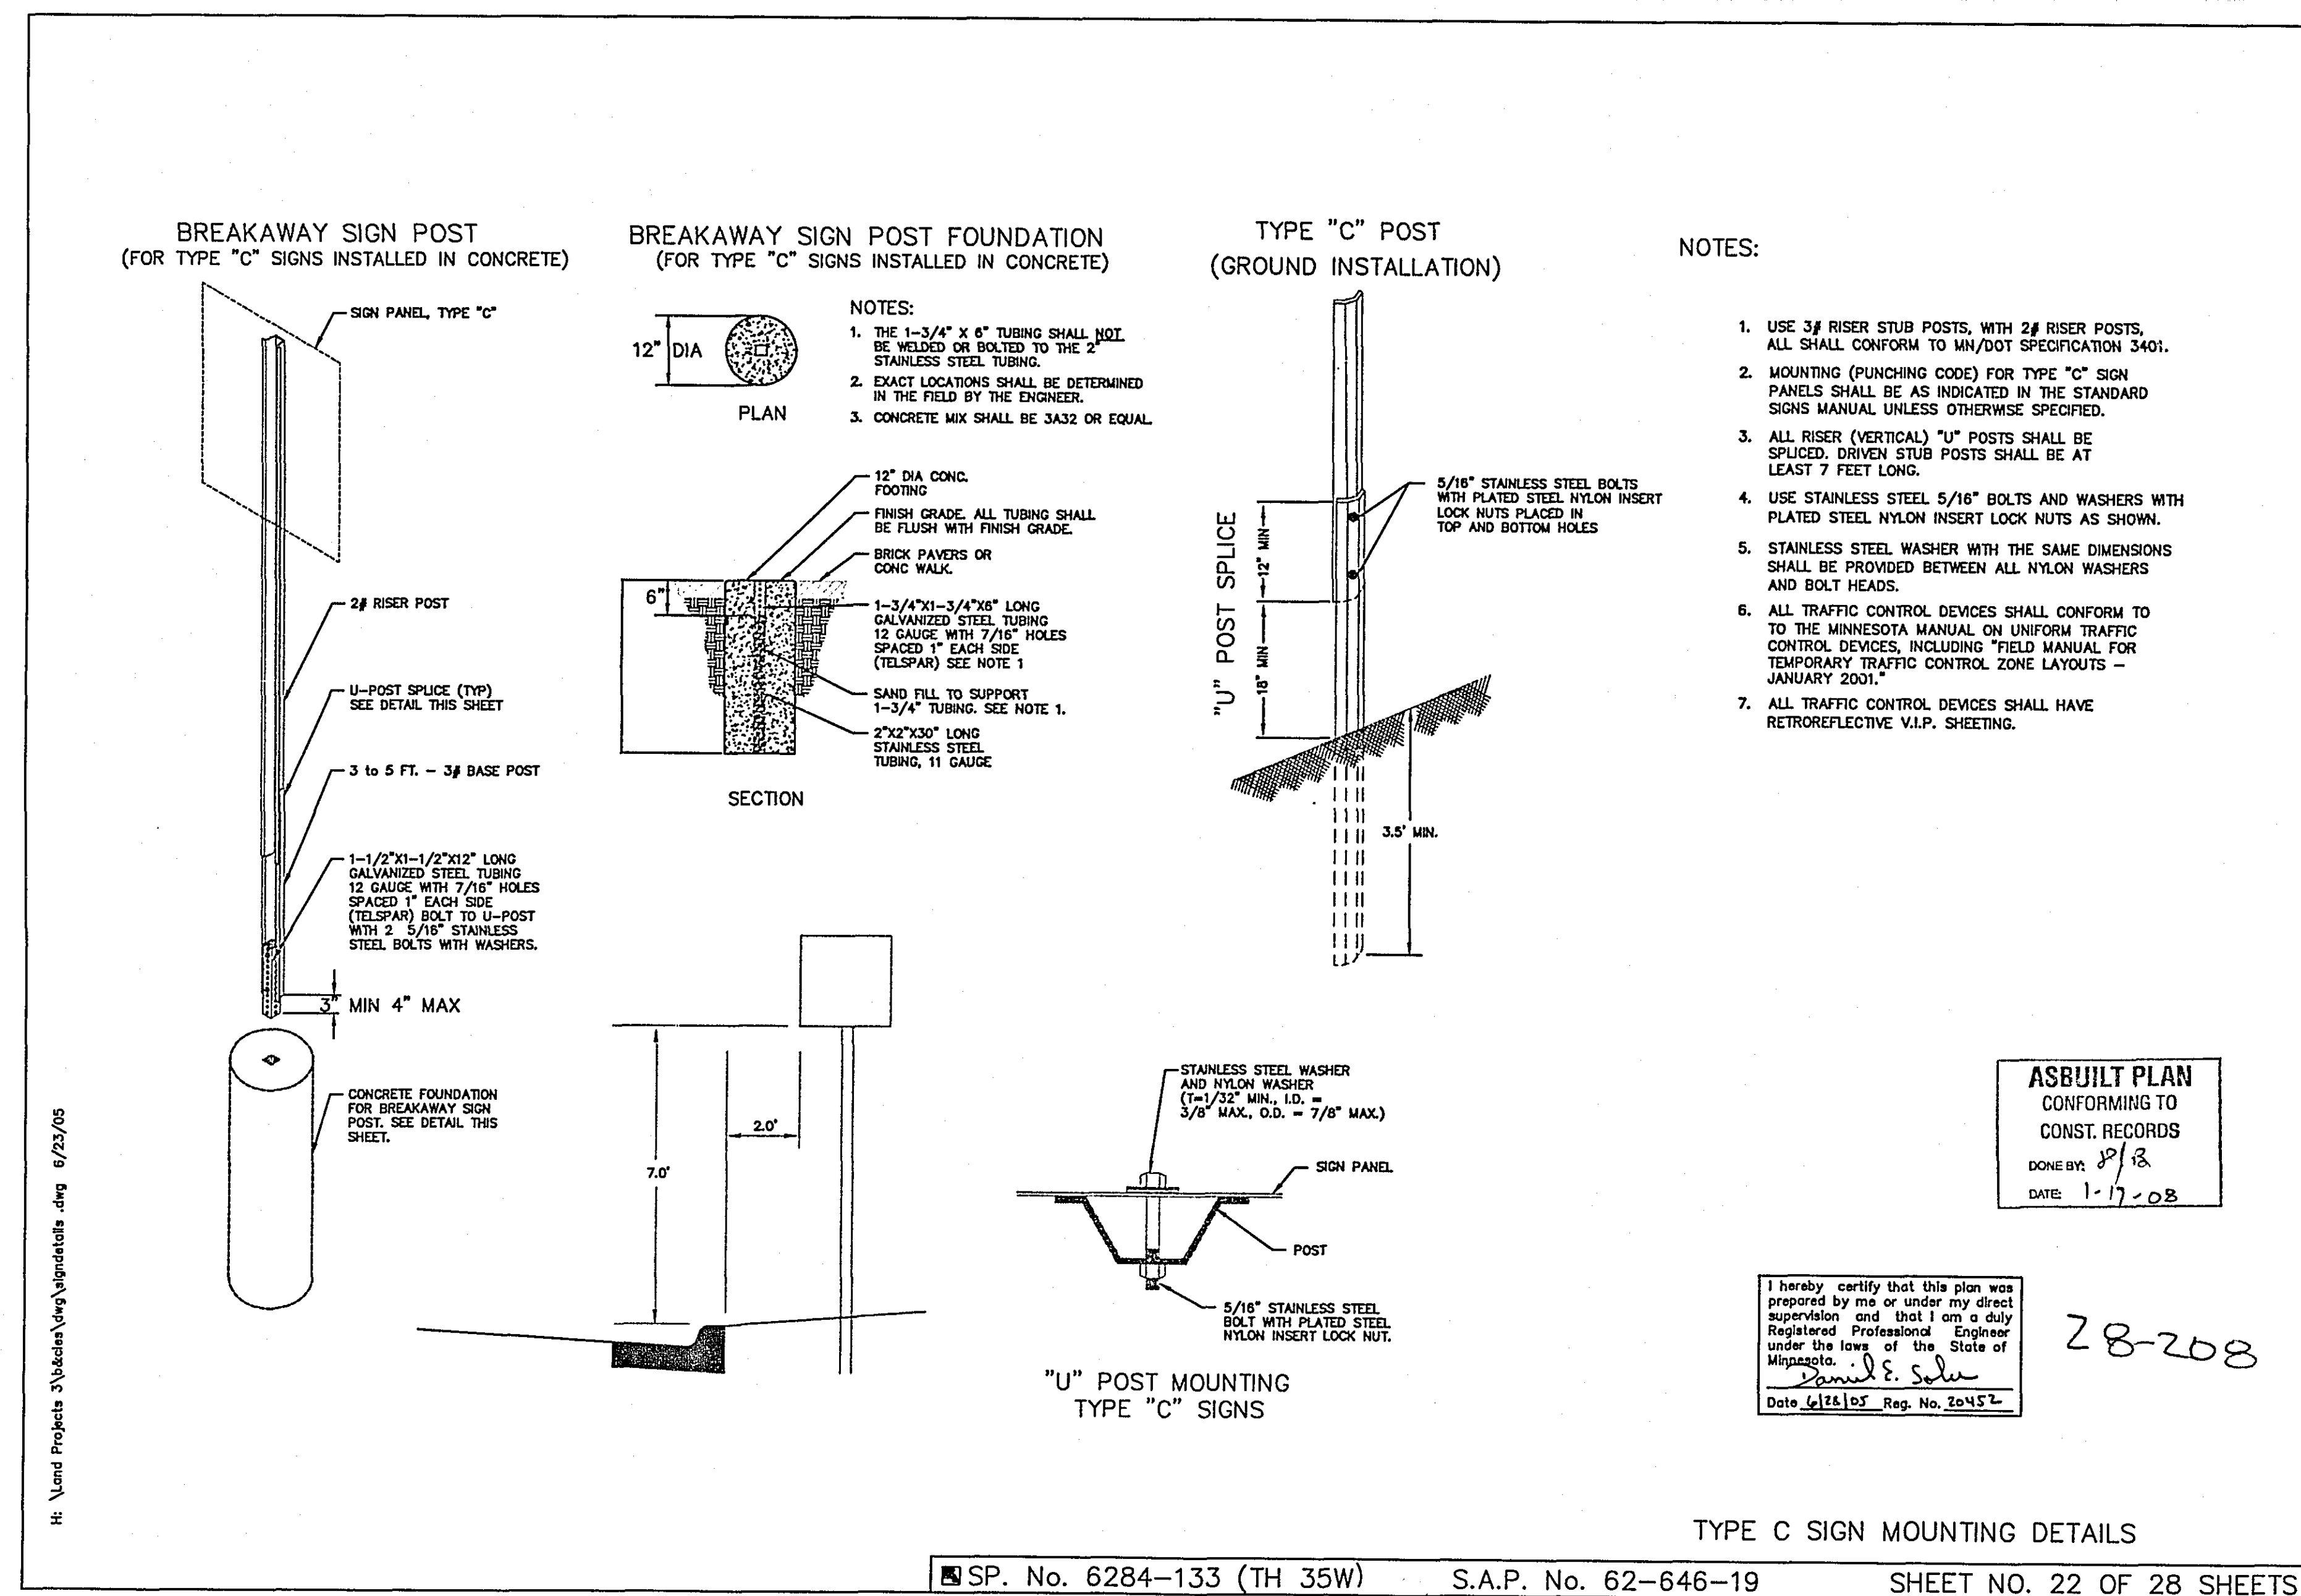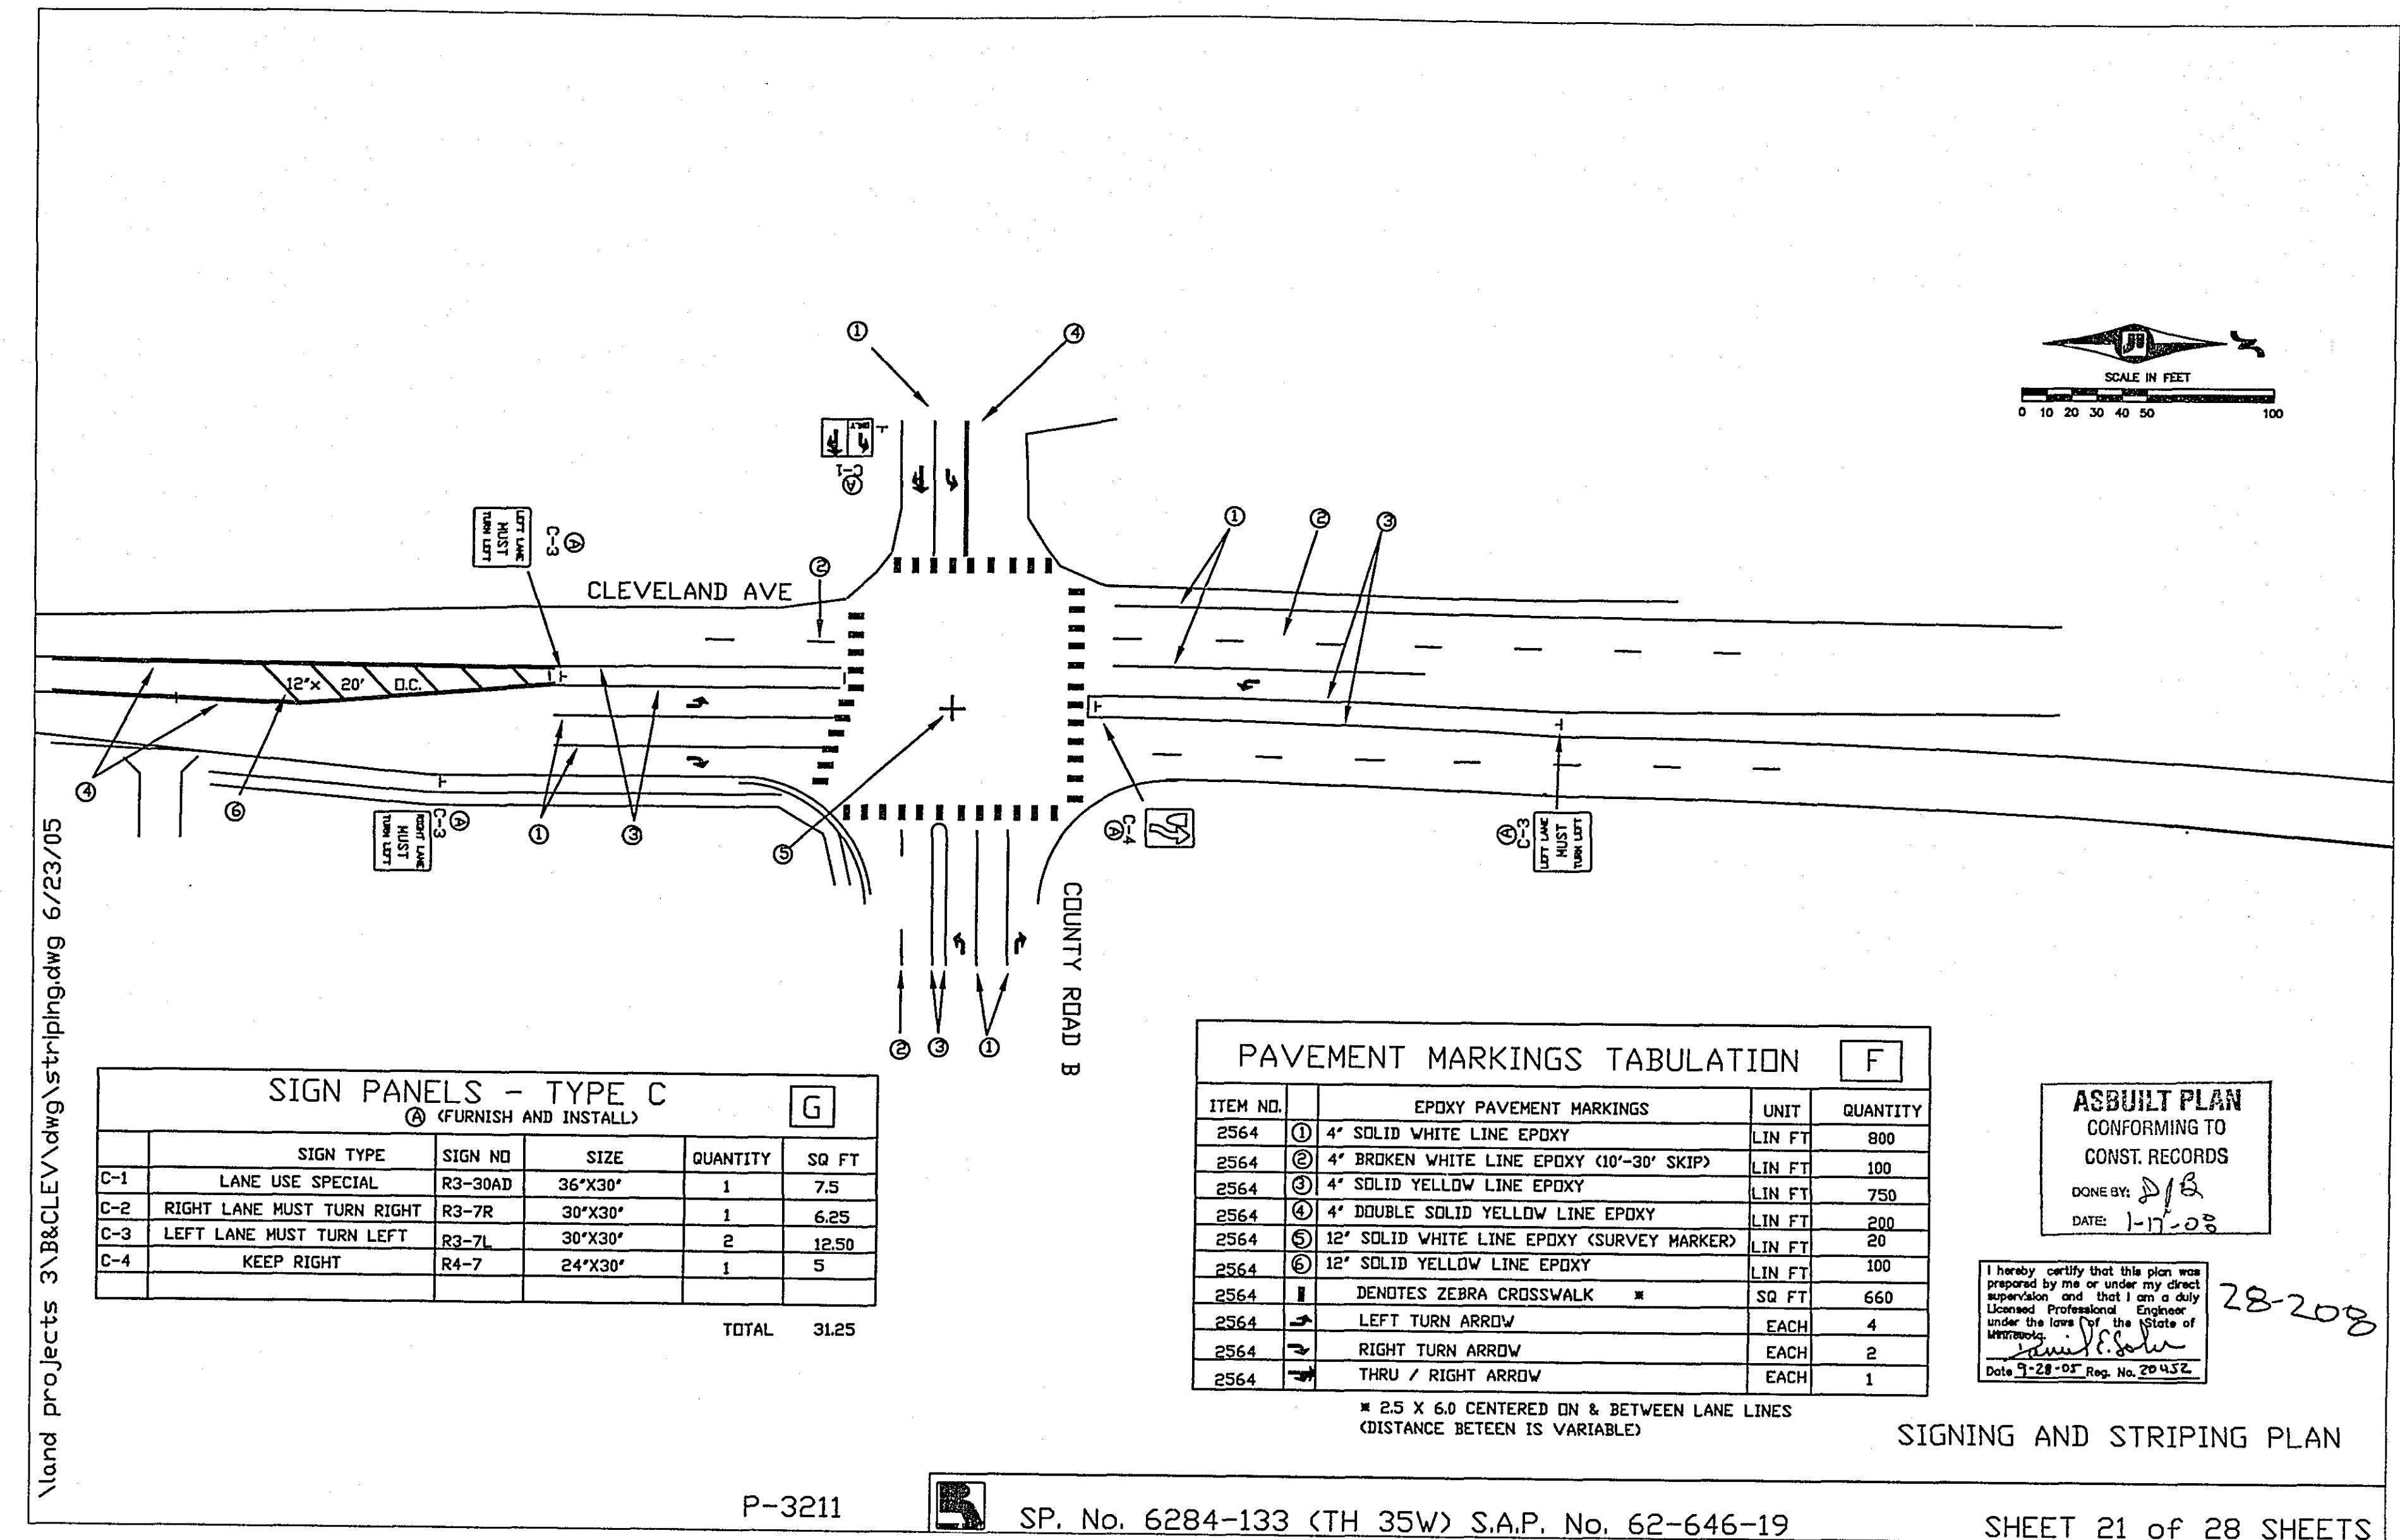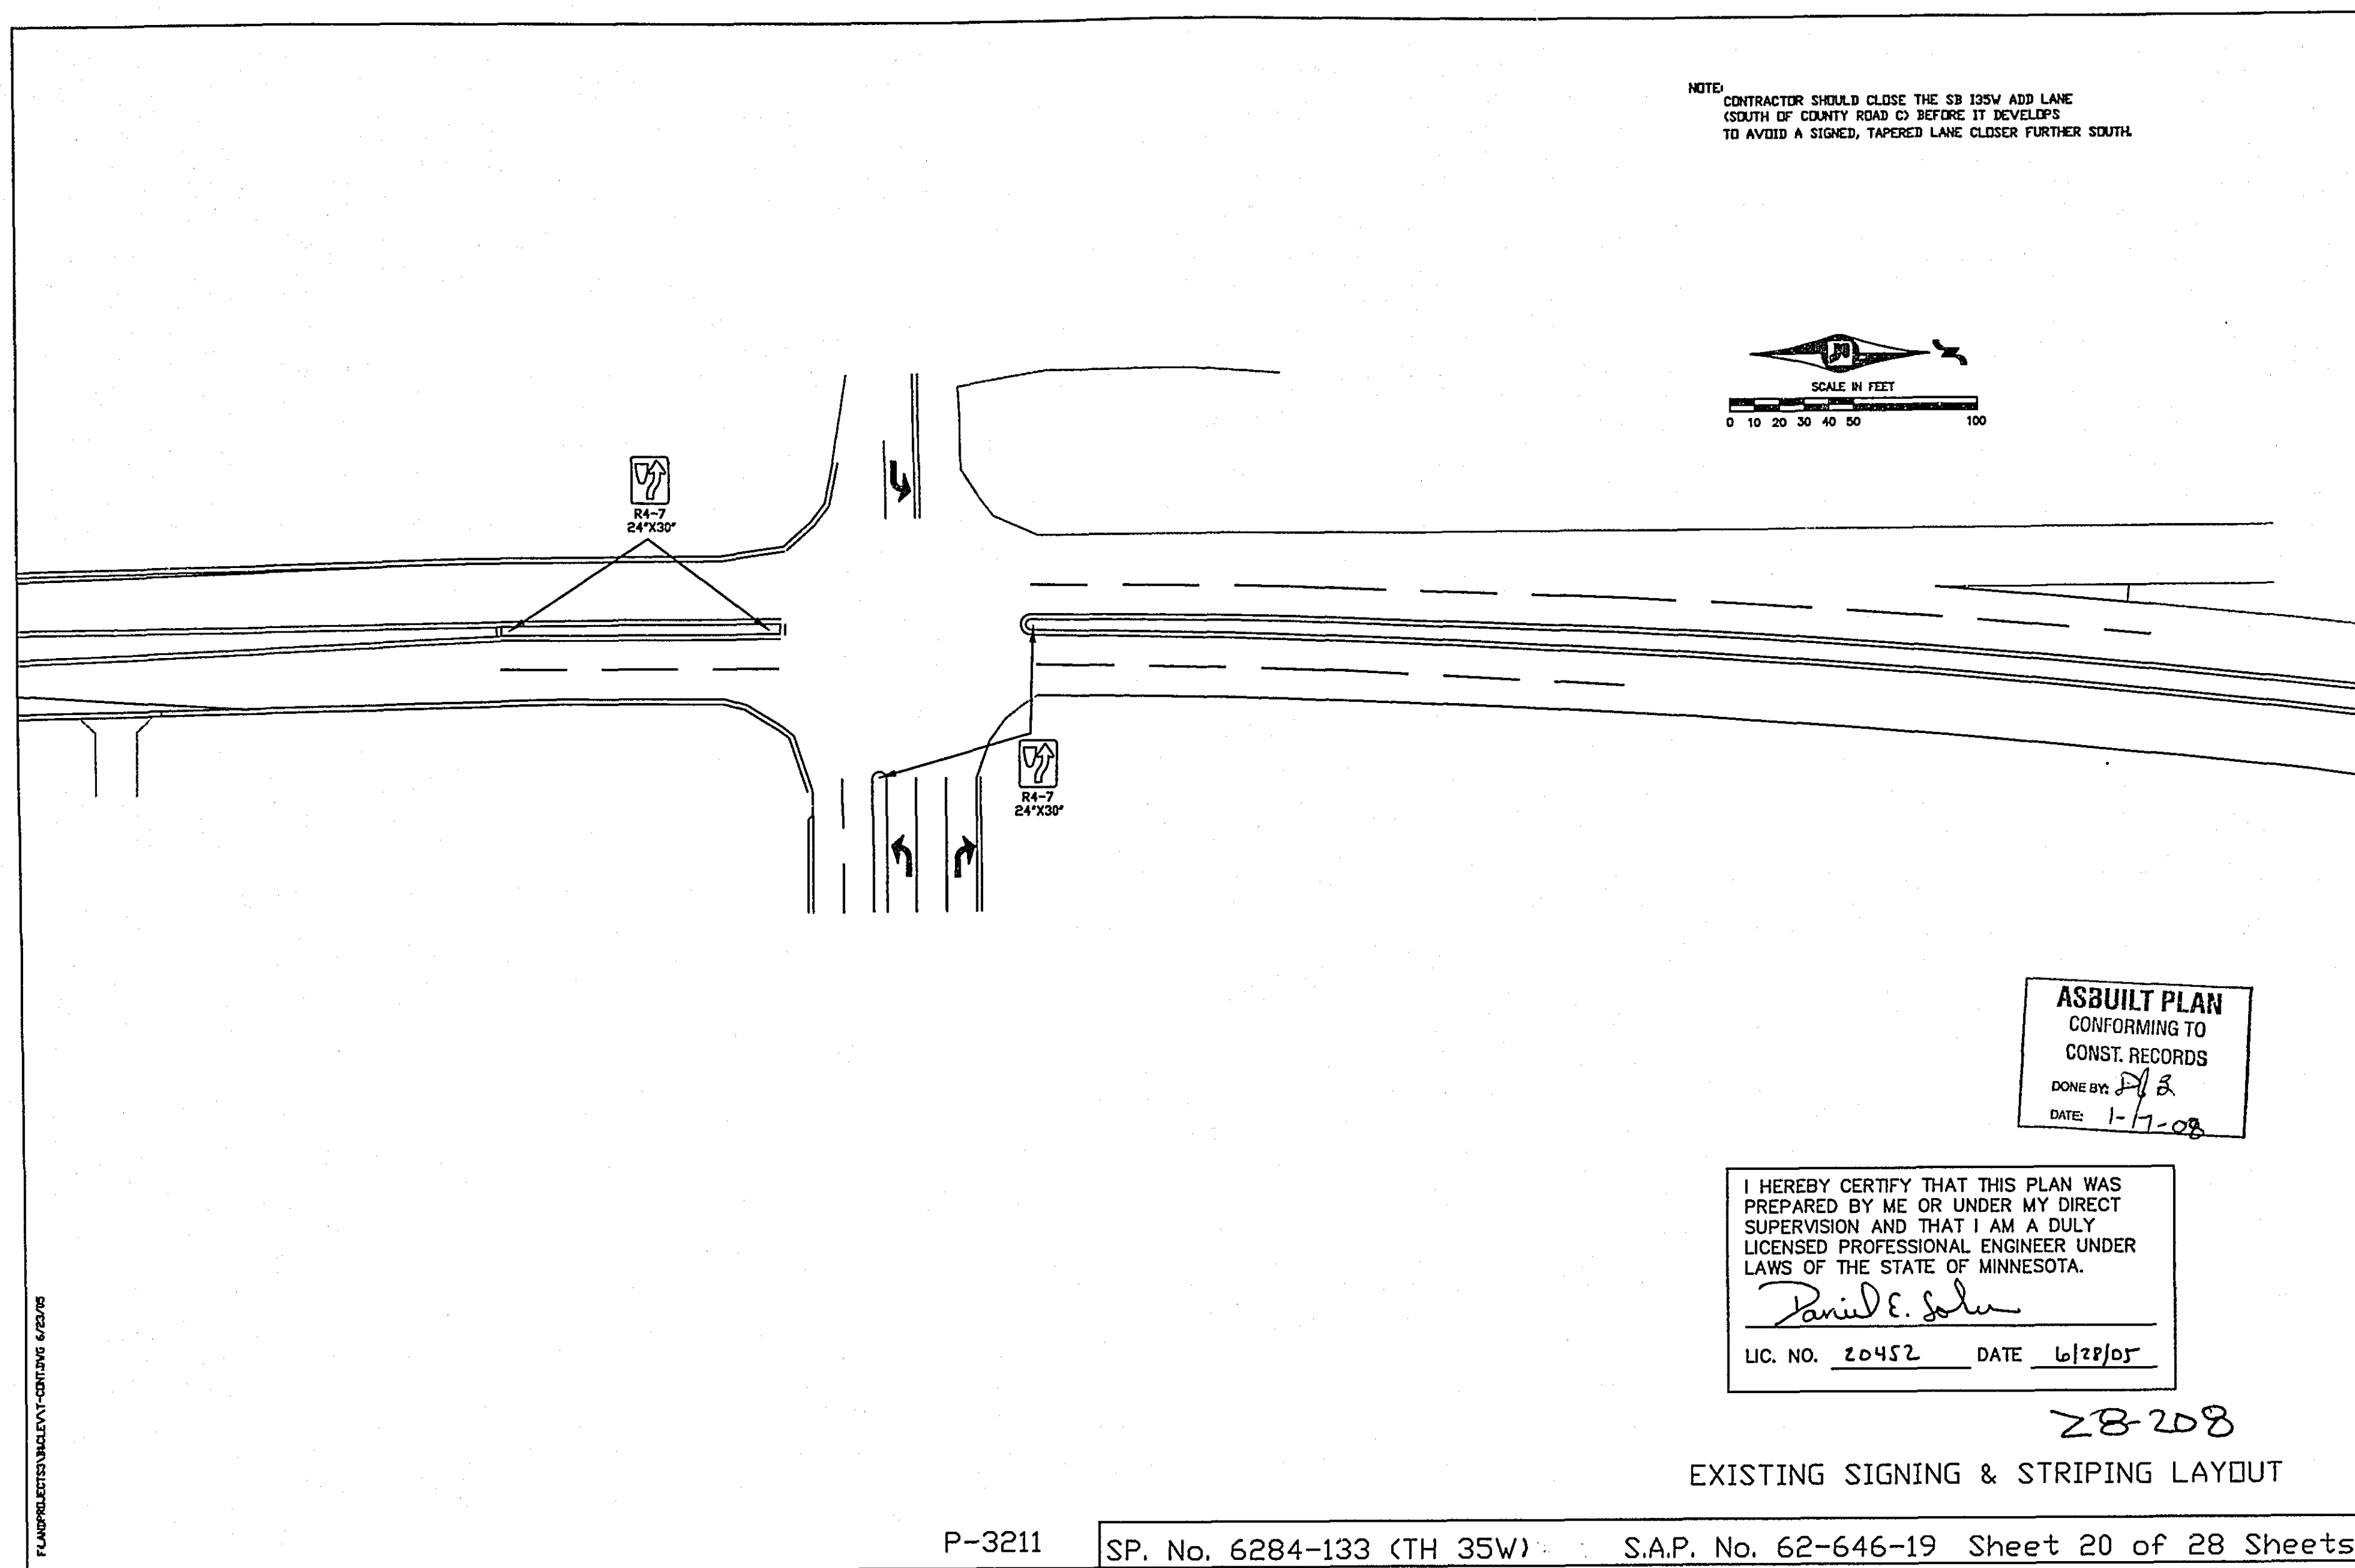


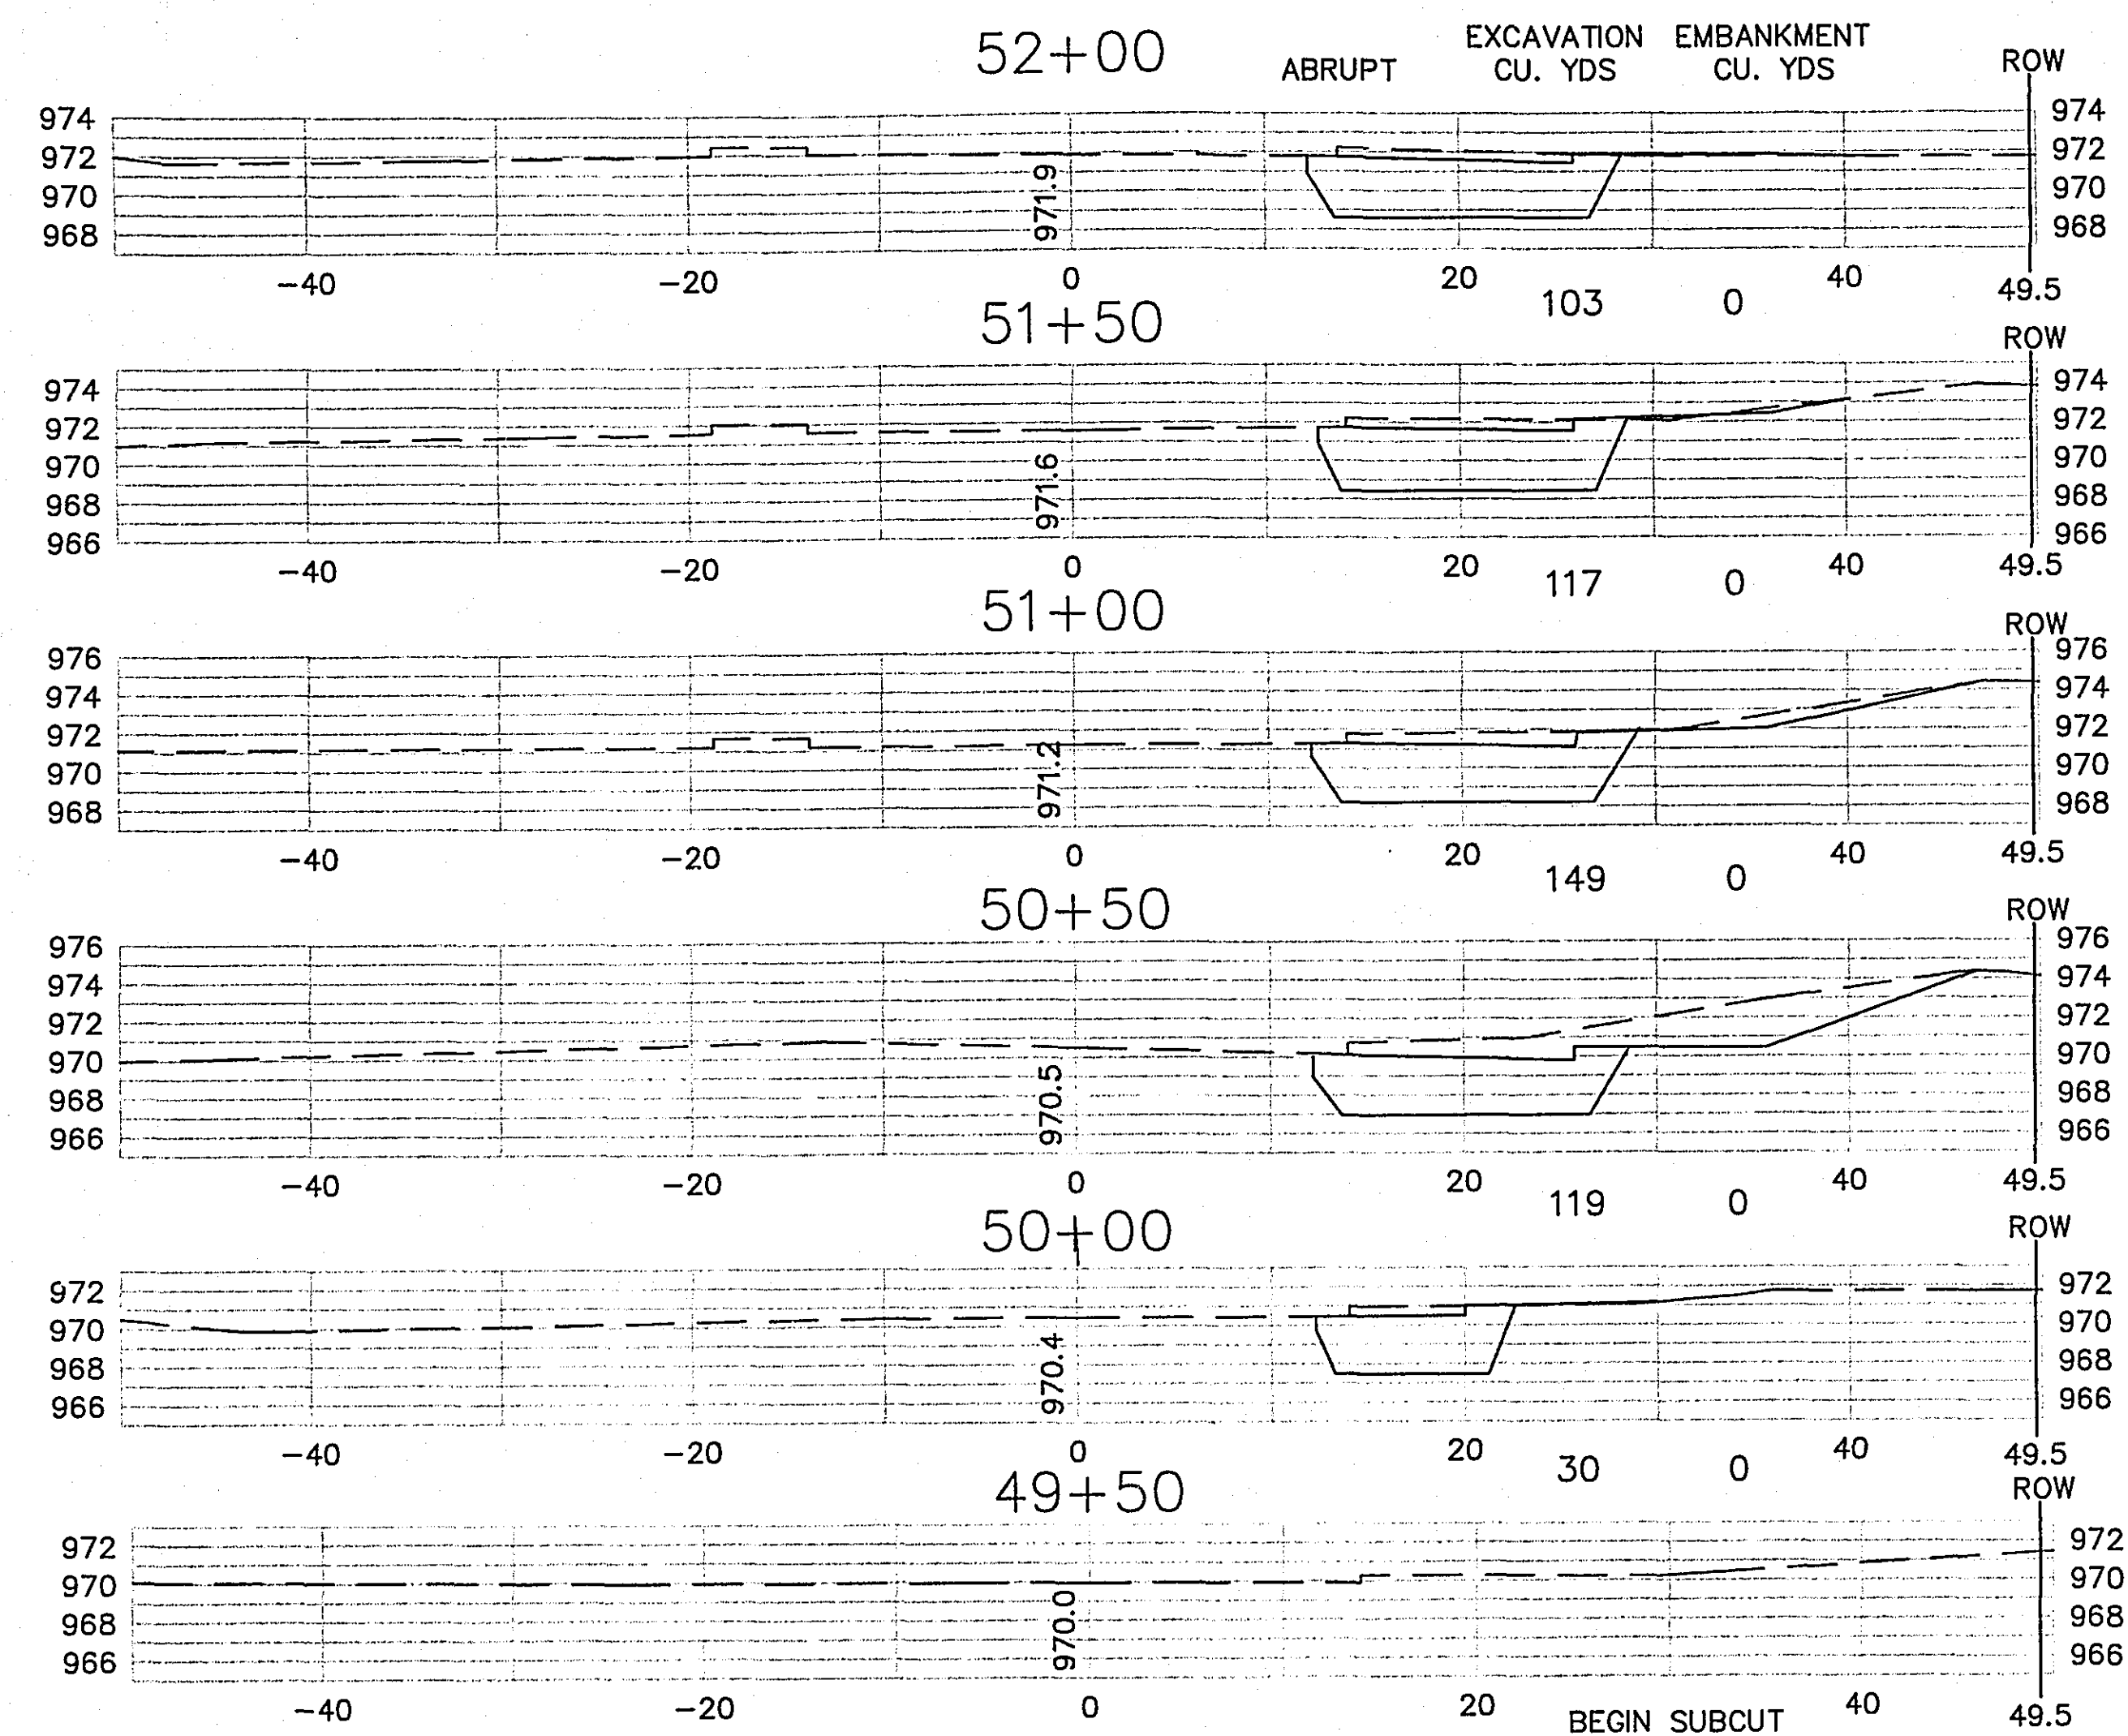

ASBUILT PLAN
CONFORMING TO
CONST. RECORDS
DONE BY: *[Signature]*
DATE: 1-17-08

28-208
CROSS SECTIONS
CLEVELAND AVE
STA 49+50 - 52+00


SP. No. 6284-133 (TH 35W) S.A.P. No. 62-646-19 Sheet No. 23 of 28 Sheets

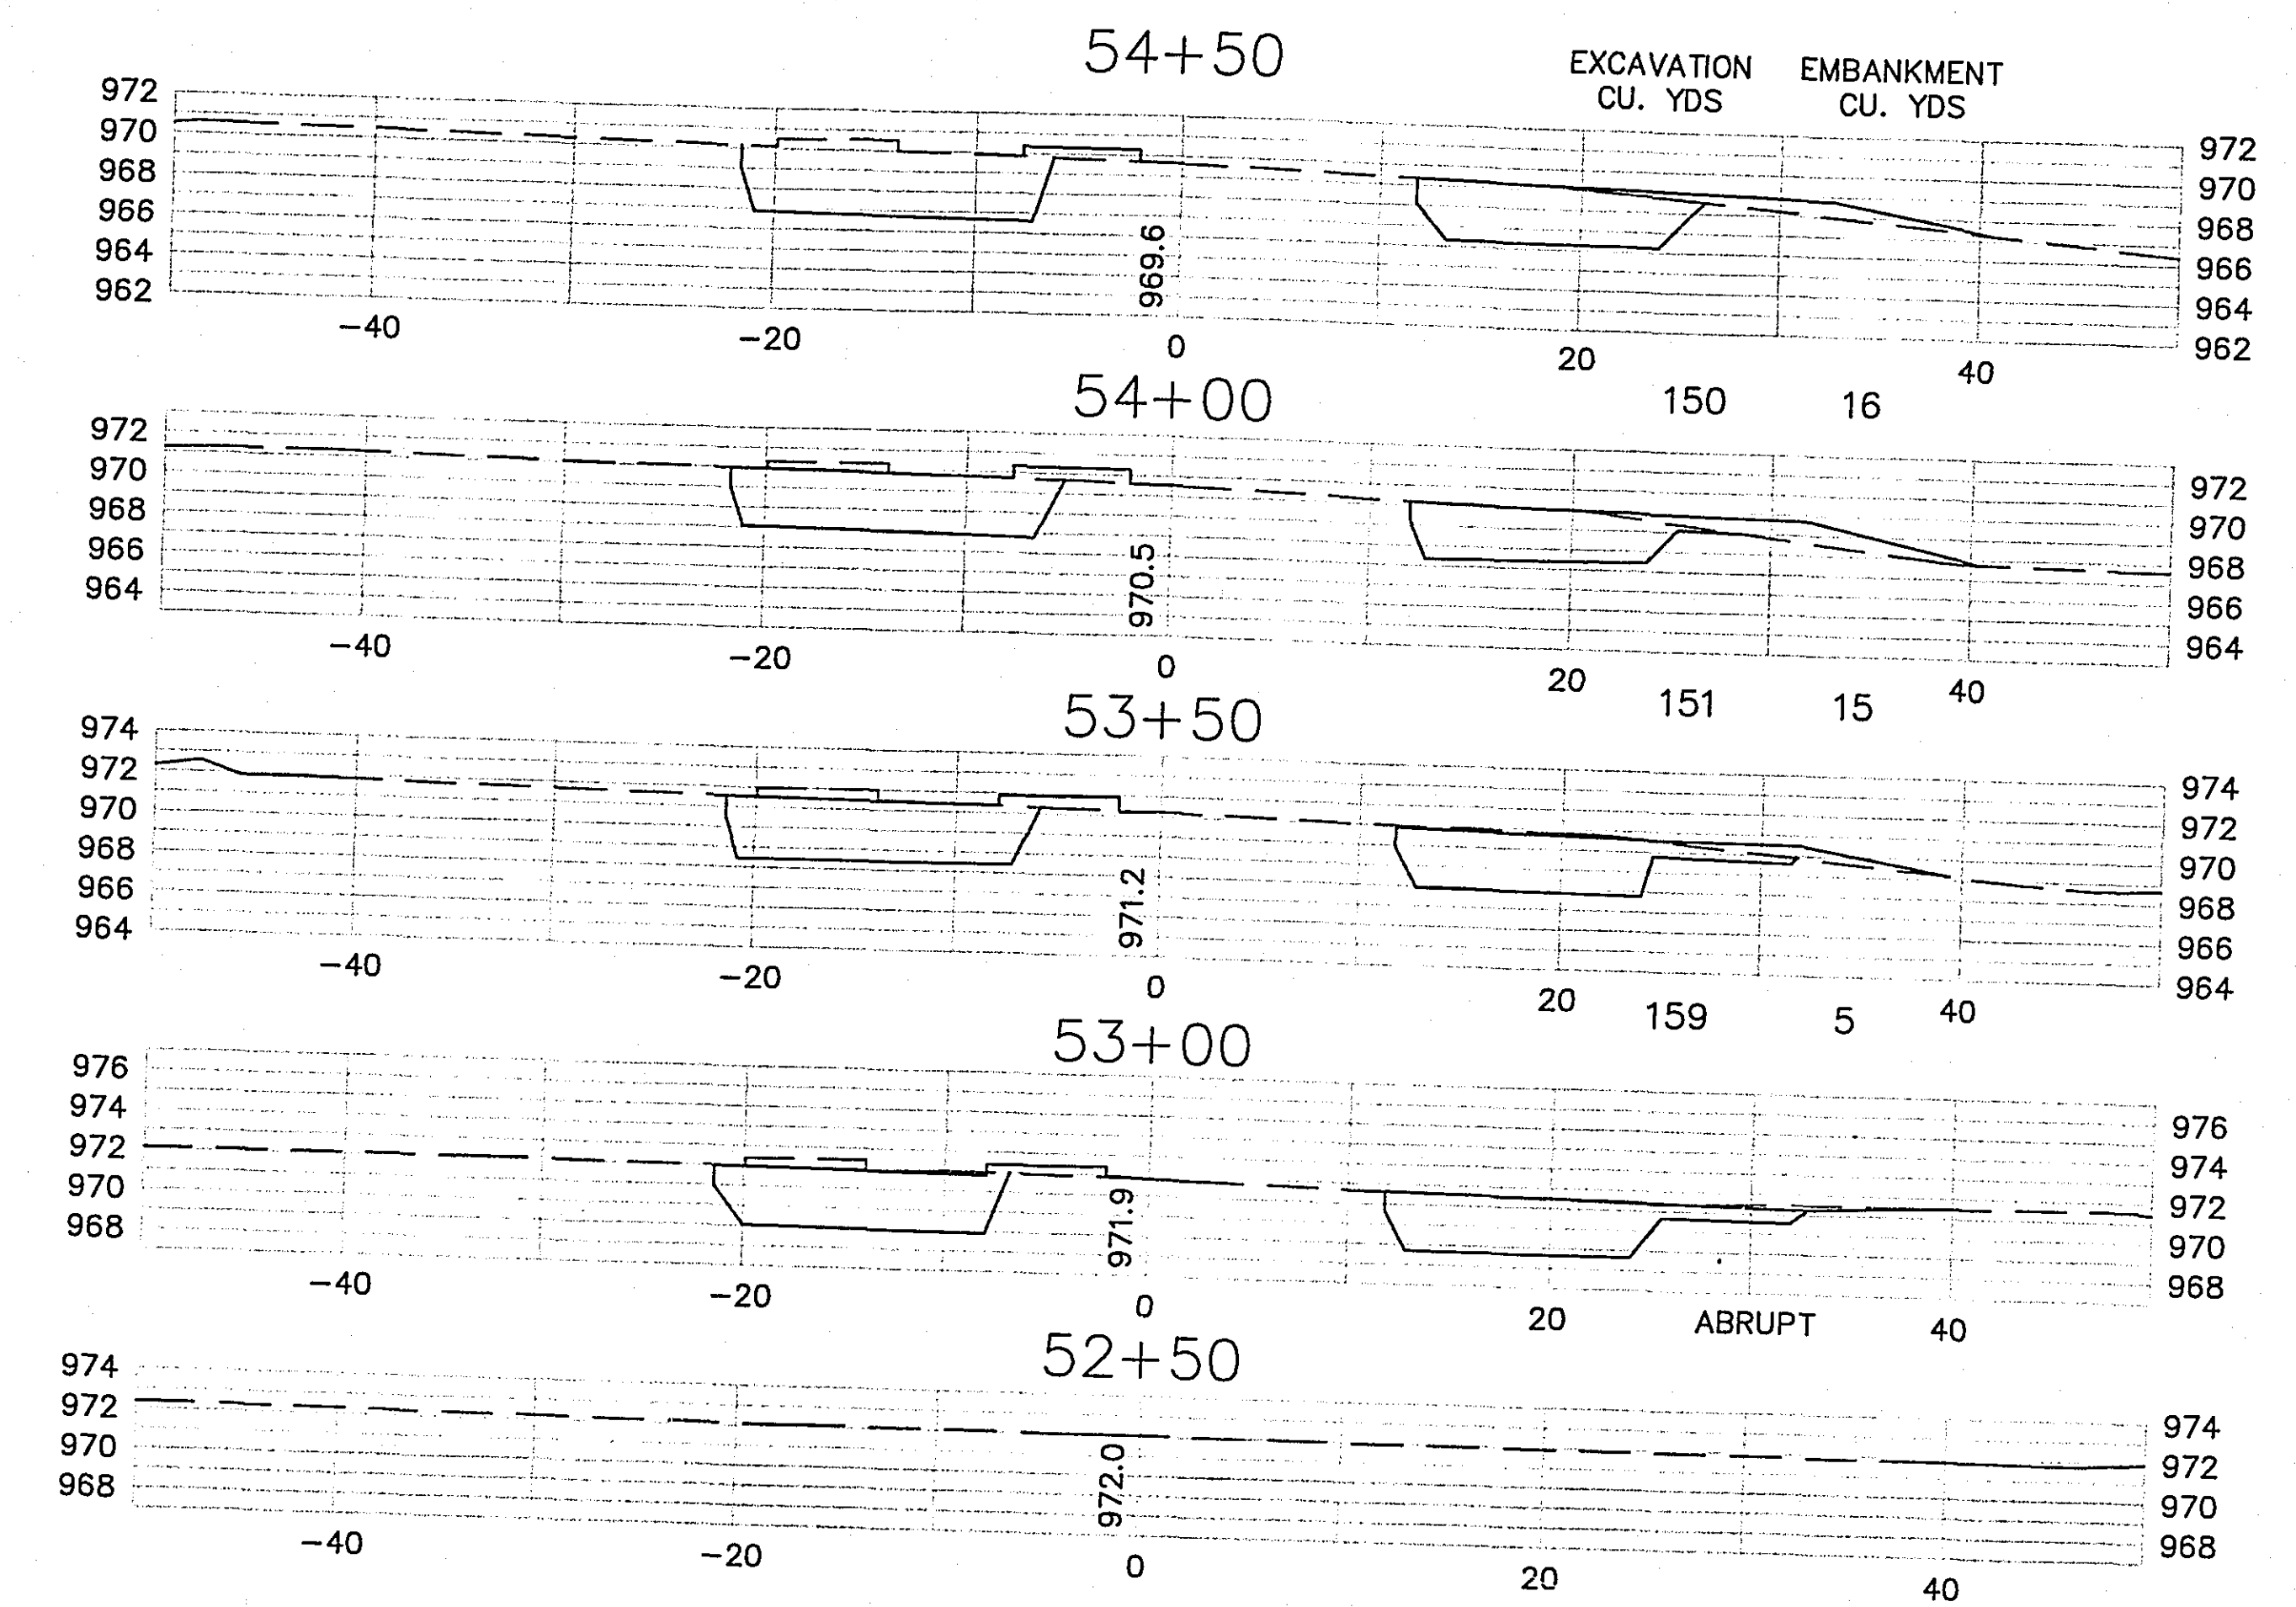

ASBUILT PLAN
CONFORMING TO
CONST. RECORDS
DONE BY: *[Signature]*
DATE: 1-17-08

28-208
CROSS SECTIONS
CLEVELAND AVE
STA 52+50 - 54+50


SP. No. 6284-133 (TH 35W) S.A.P. No. 62-646-19 Sheet No. 24 of 28 Sheets

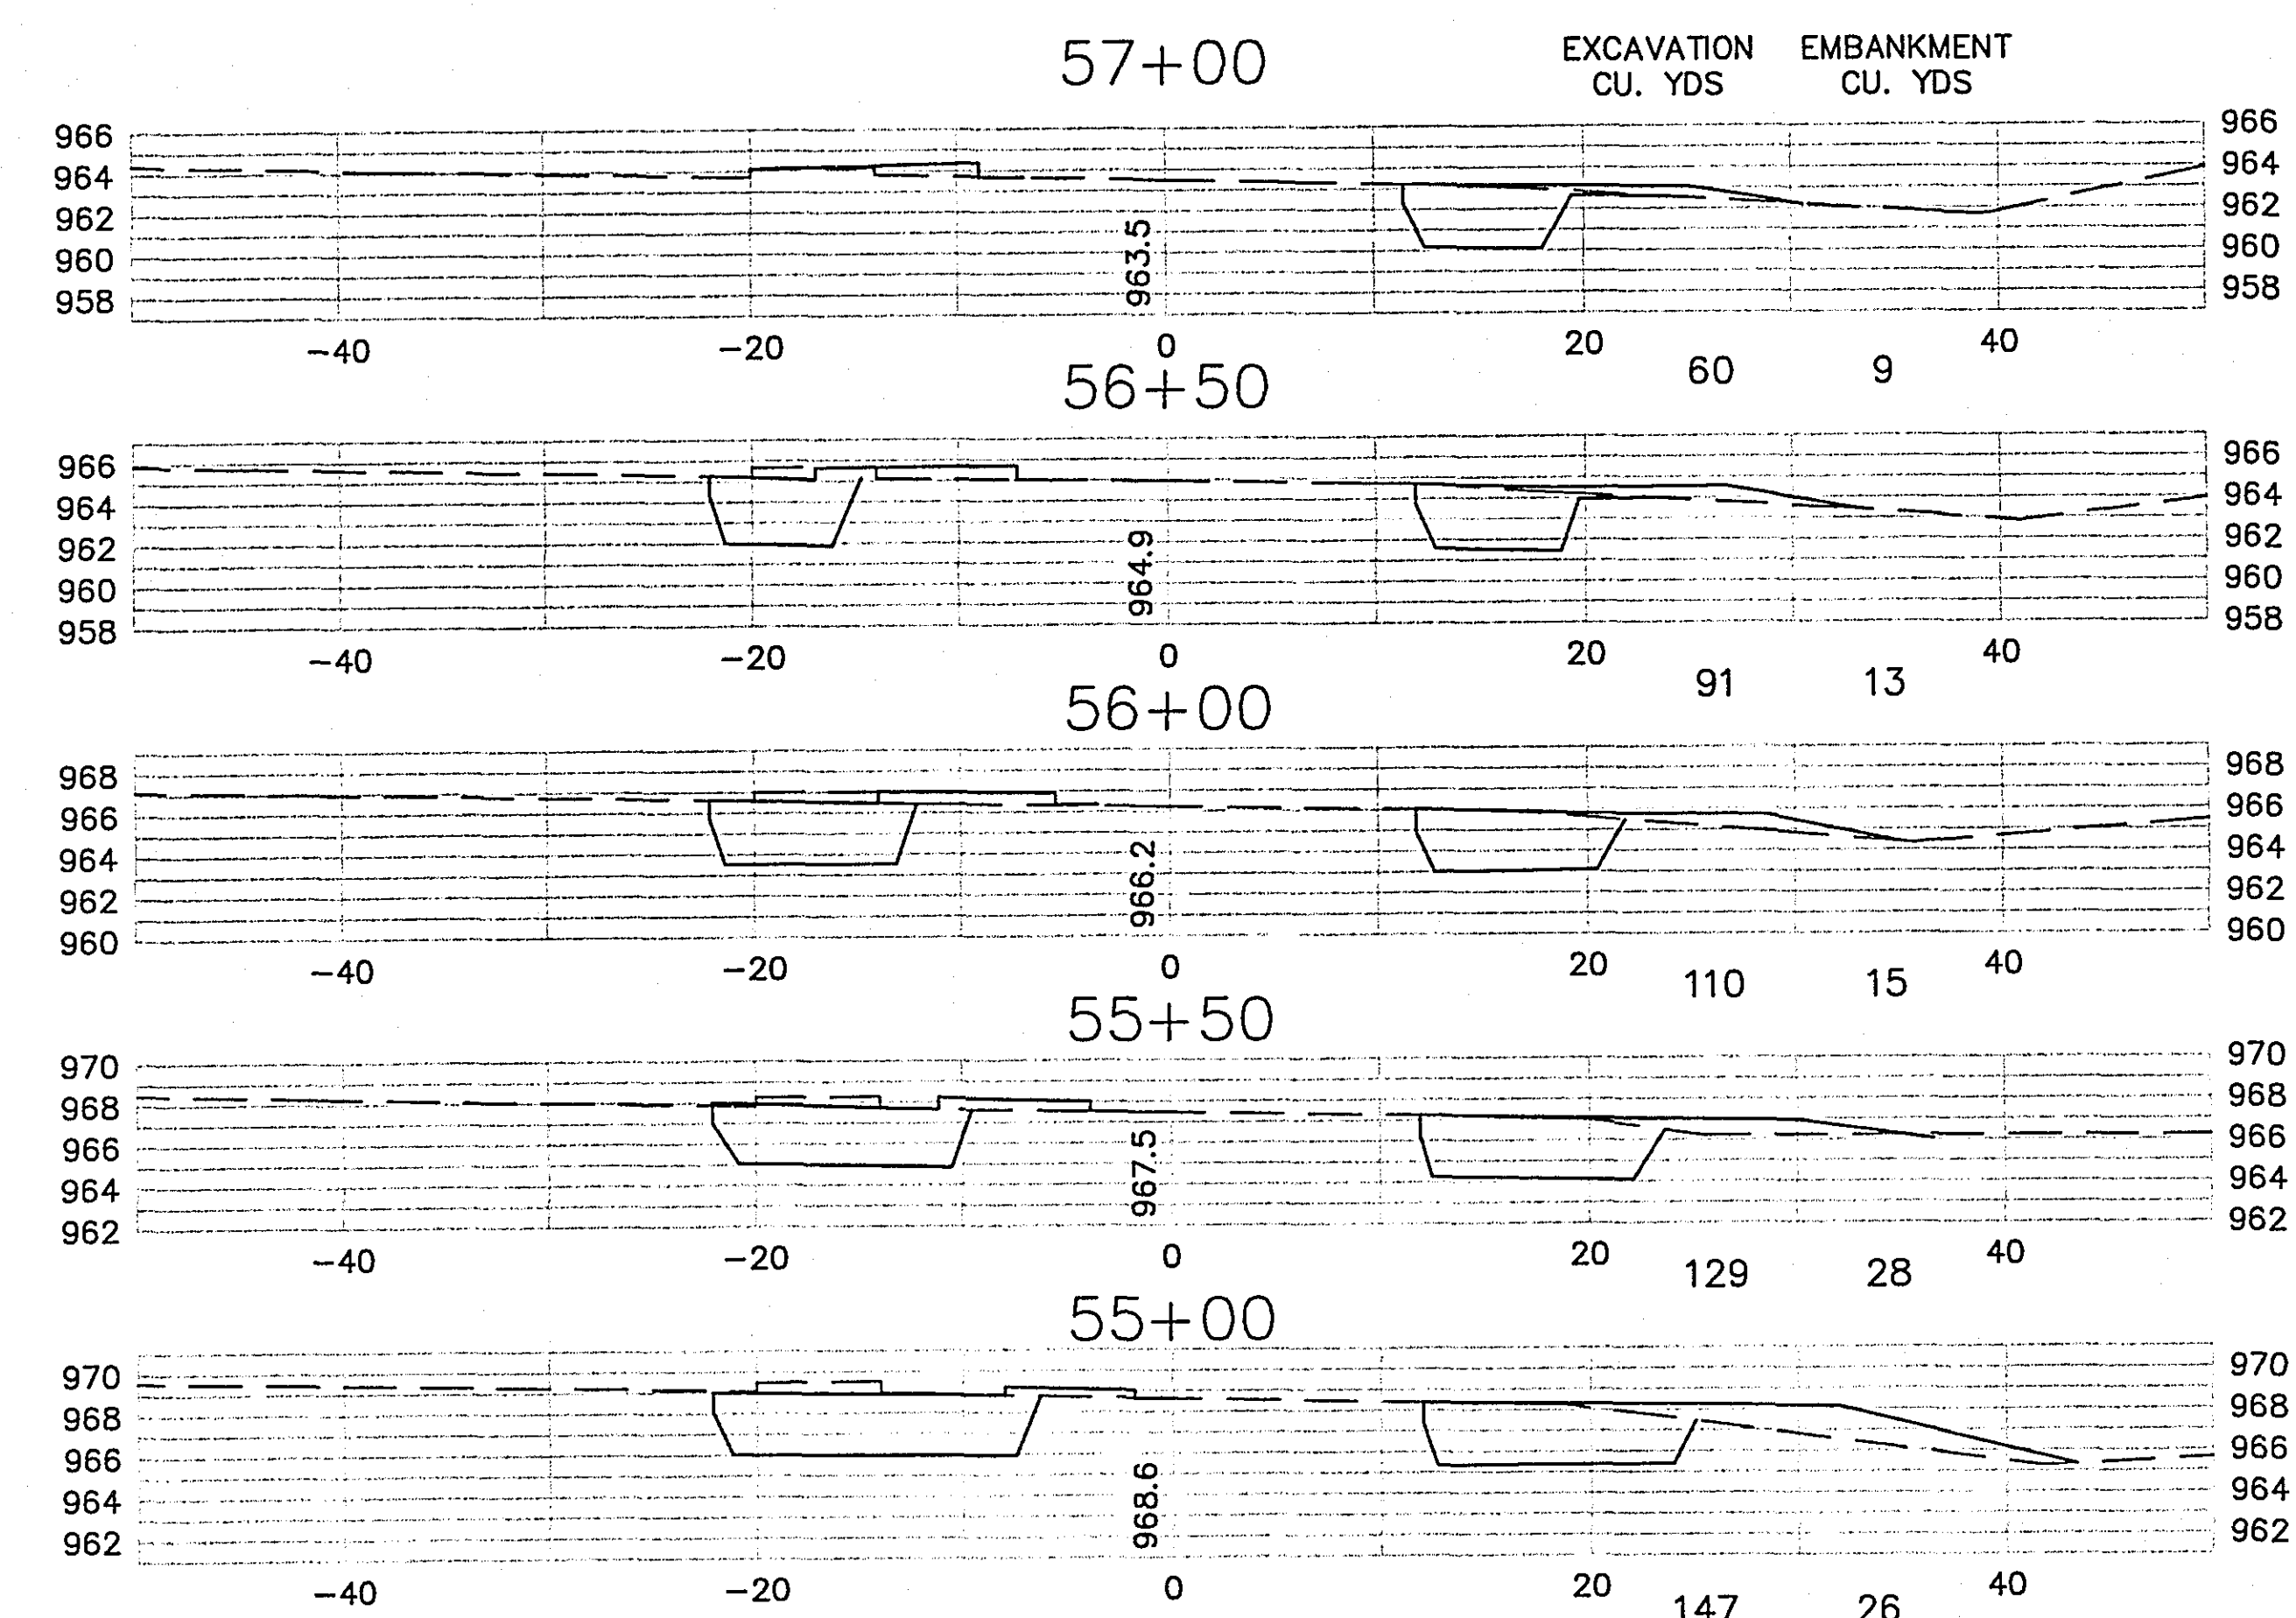

ASBUILT PLAN
CONFORMING TO
CONST. RECORDS
DONE BY: *[Signature]*
DATE: 1-17-08

28-208
CROSS SECTIONS
CLEVELAND AVE
STA 52+50 - 57+00

SP. No. 6284-133 (TH 35W) S.A.P. No. 62-646-19 Sheet No. 25 of 28 Sheets

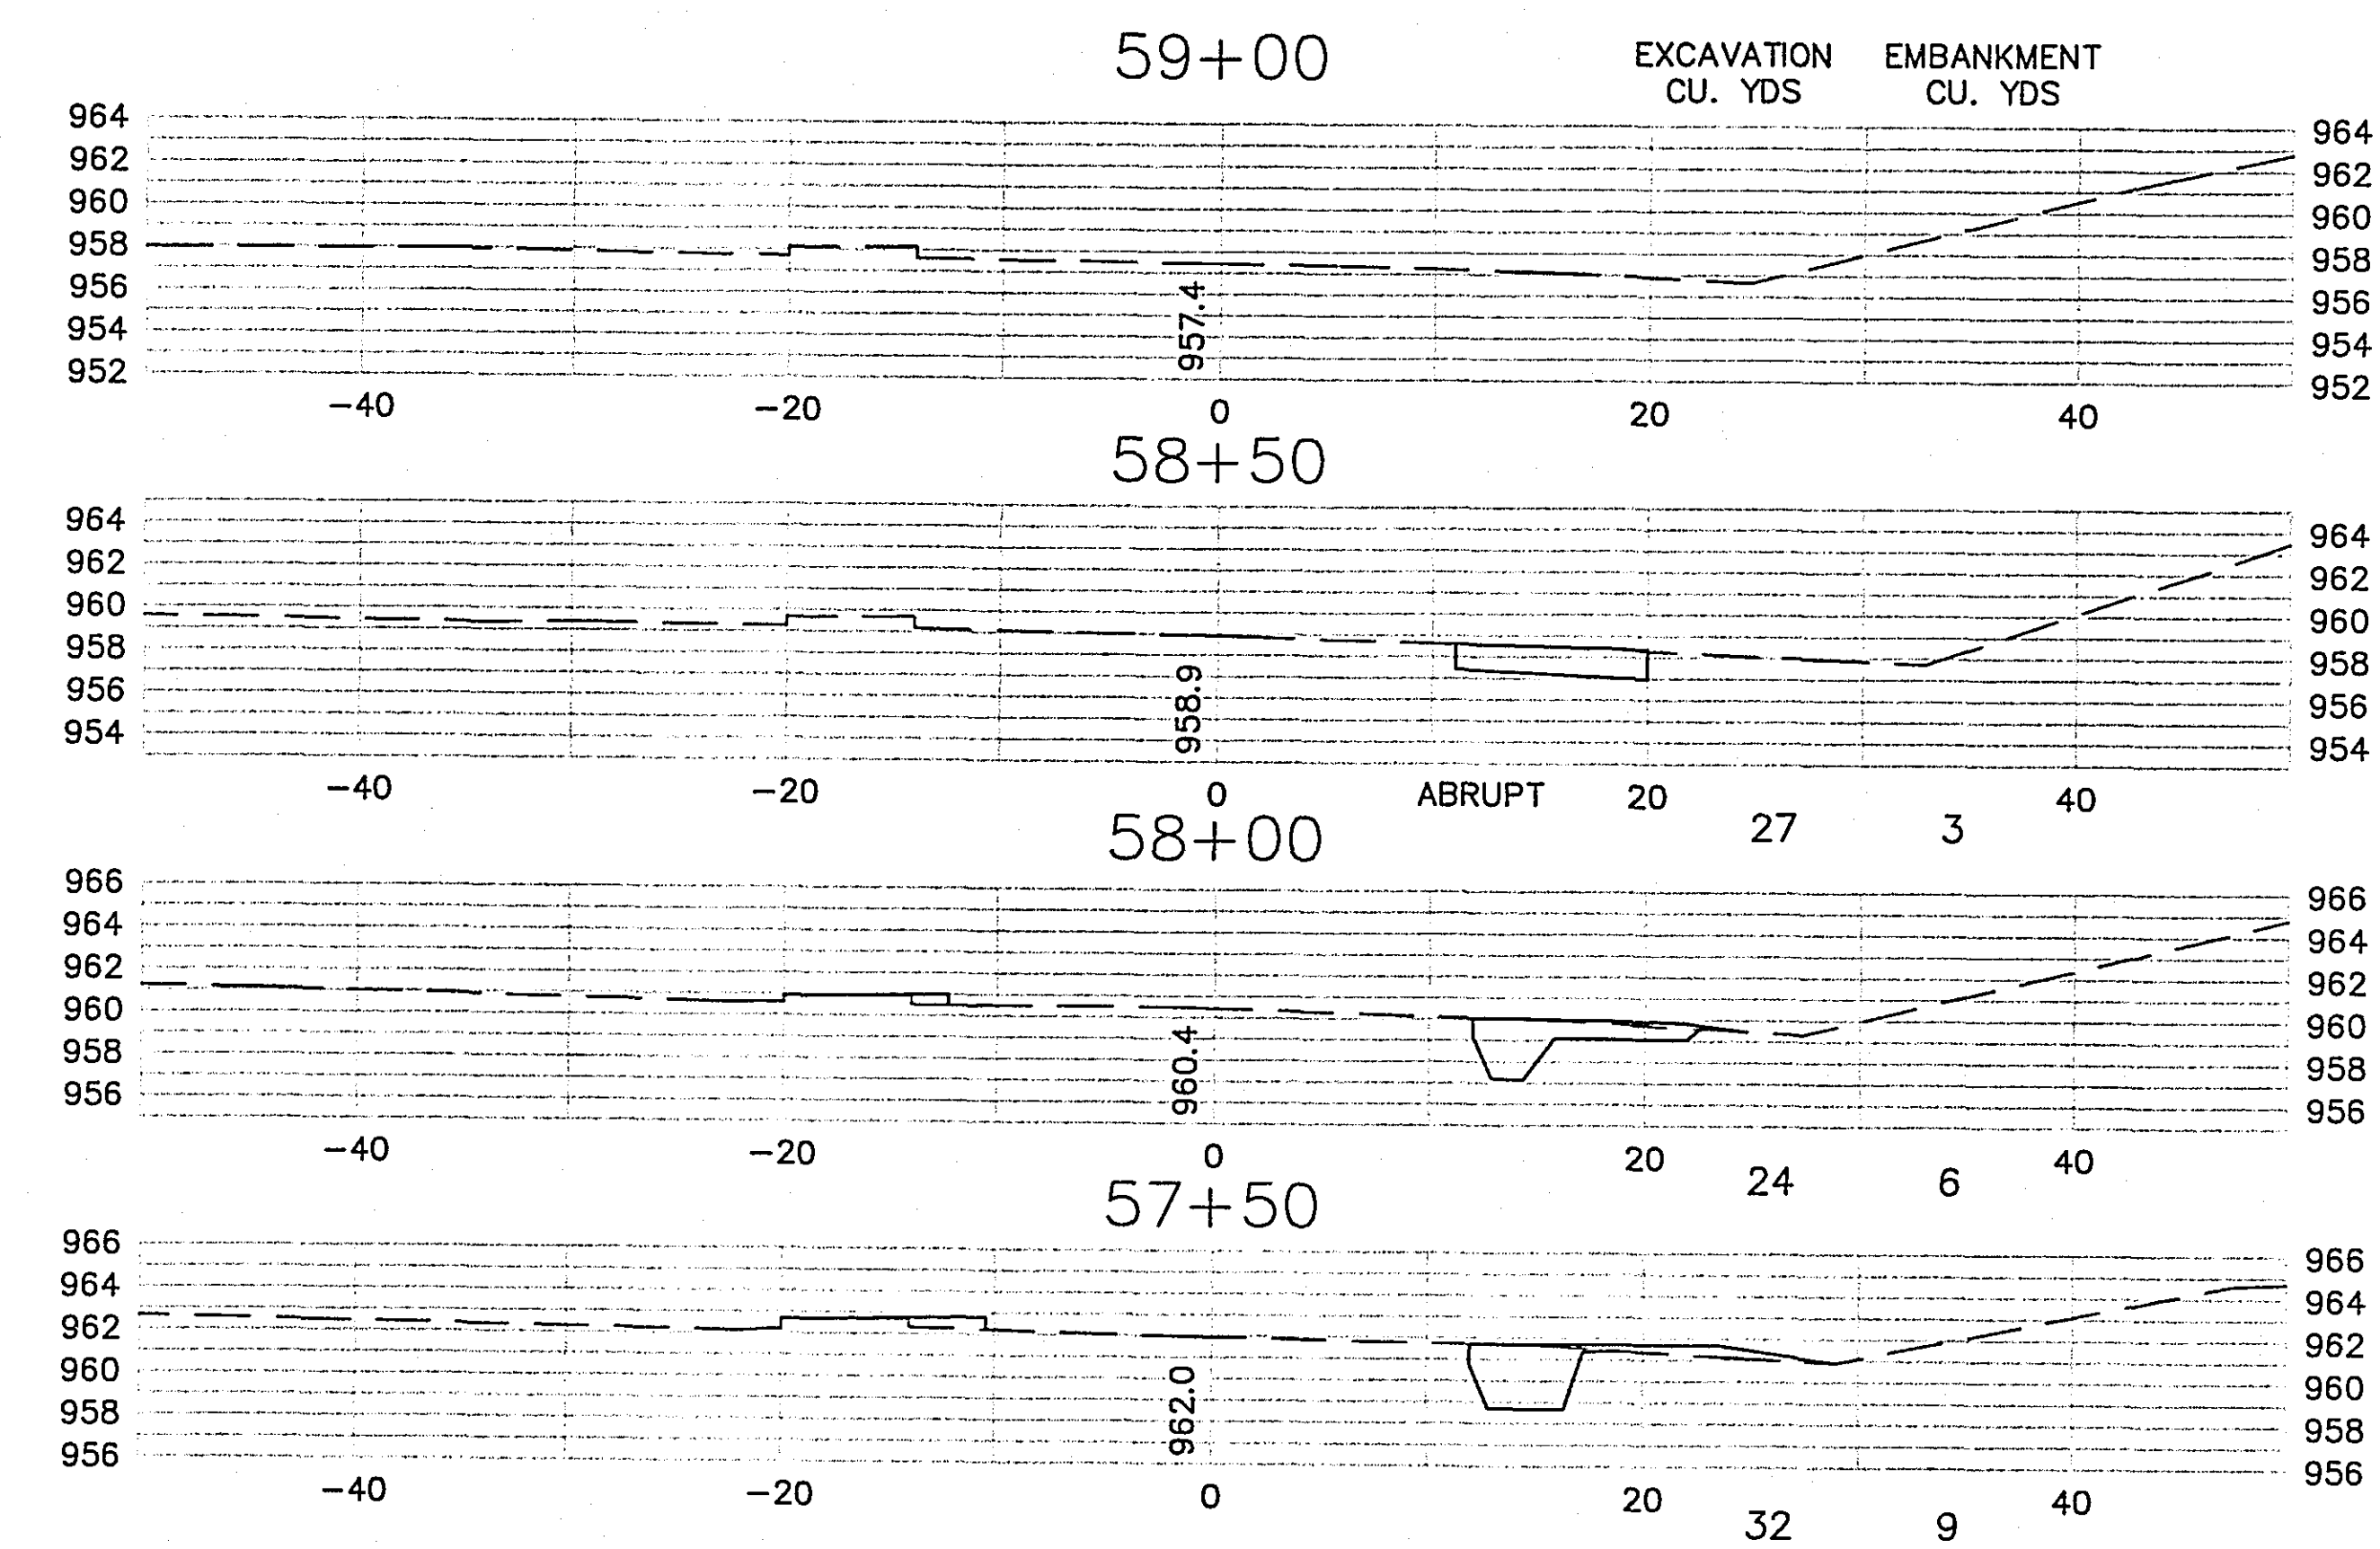

CLEVELAND AVE TOTALS
EXCAVATION CU. YDS 1598
EMBANKMENT CU. YDS 145


CO RD B TOTALS
184 12

PROJECT TOTALS
1782 157

ASBUILT PLAN
CONFORMING TO
CONST. RECORDS
DONE BY: *[Signature]*
DATE: 1-17-08

28-208
CROSS SECTIONS
CLEVELAND AVE
STA 57+50 - 59+00

SP. No. 6284-133 (TH 35W) S.A.P. No. 62-646-19 Sheet No. 26 of 28 Sheets

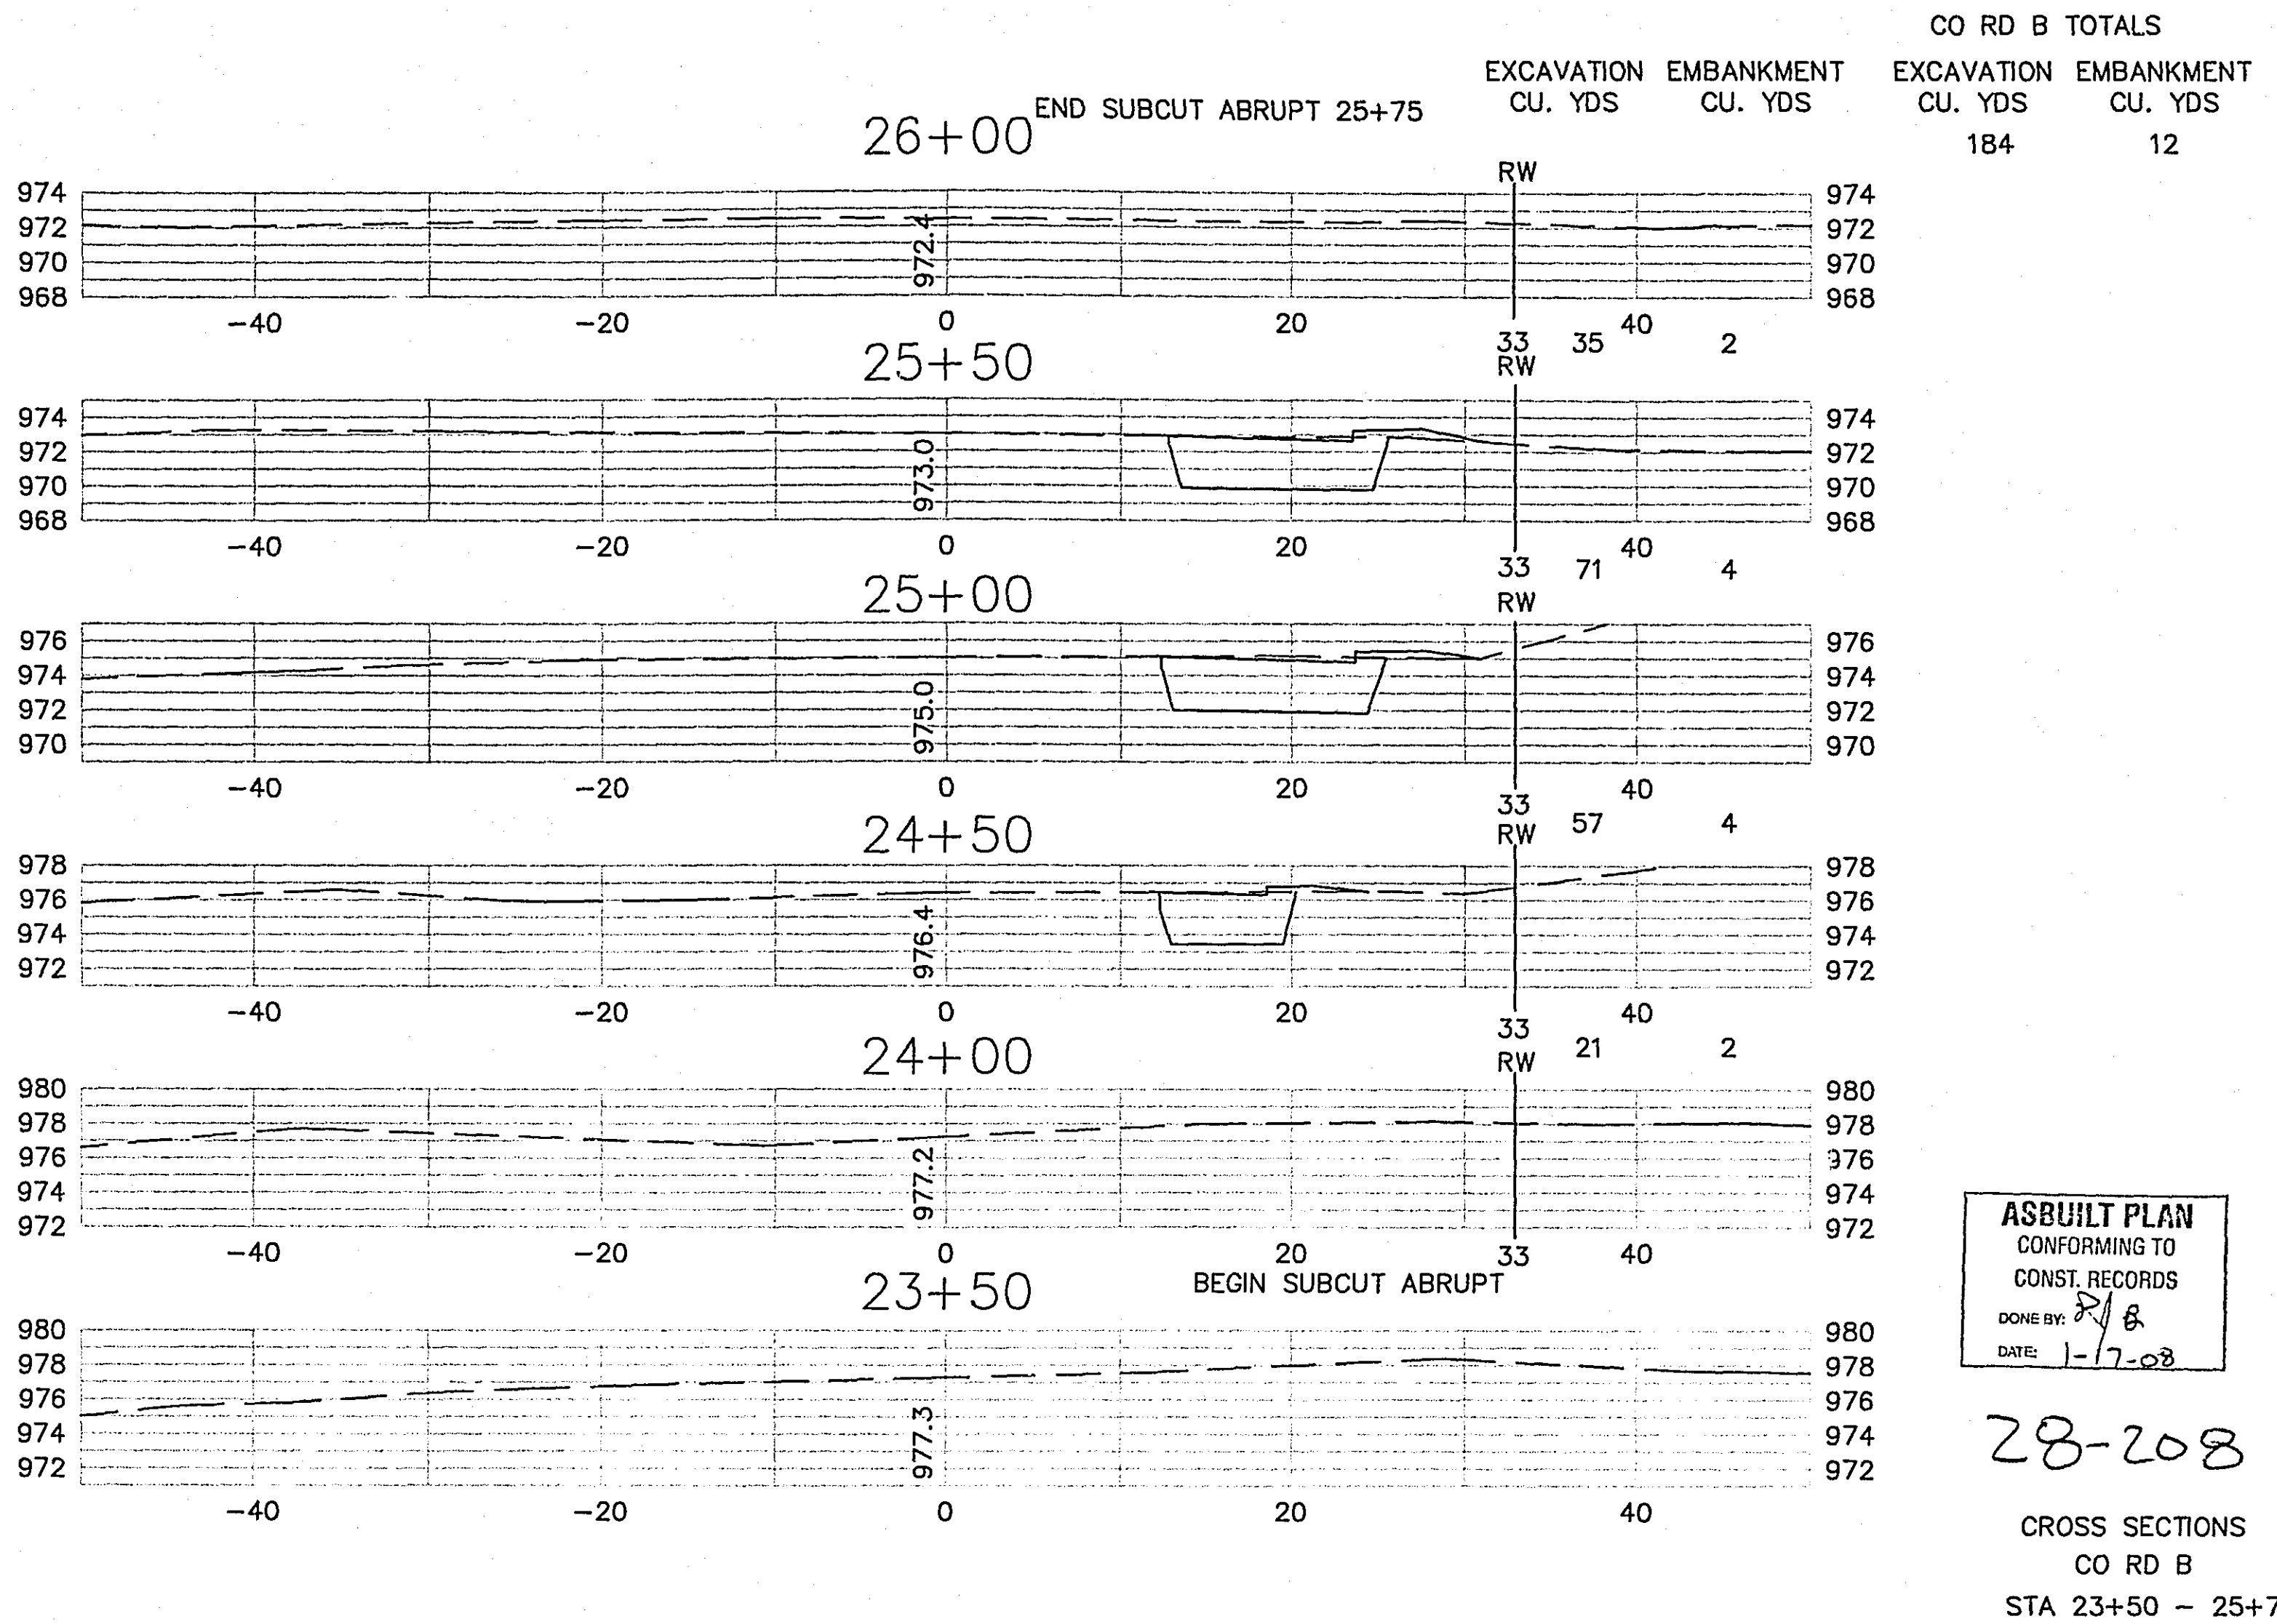

SP. No. 6284-133 (TH 35W) S.A.P. No. 62-646-19 Sheet No. 27 of 28 Sheets

