


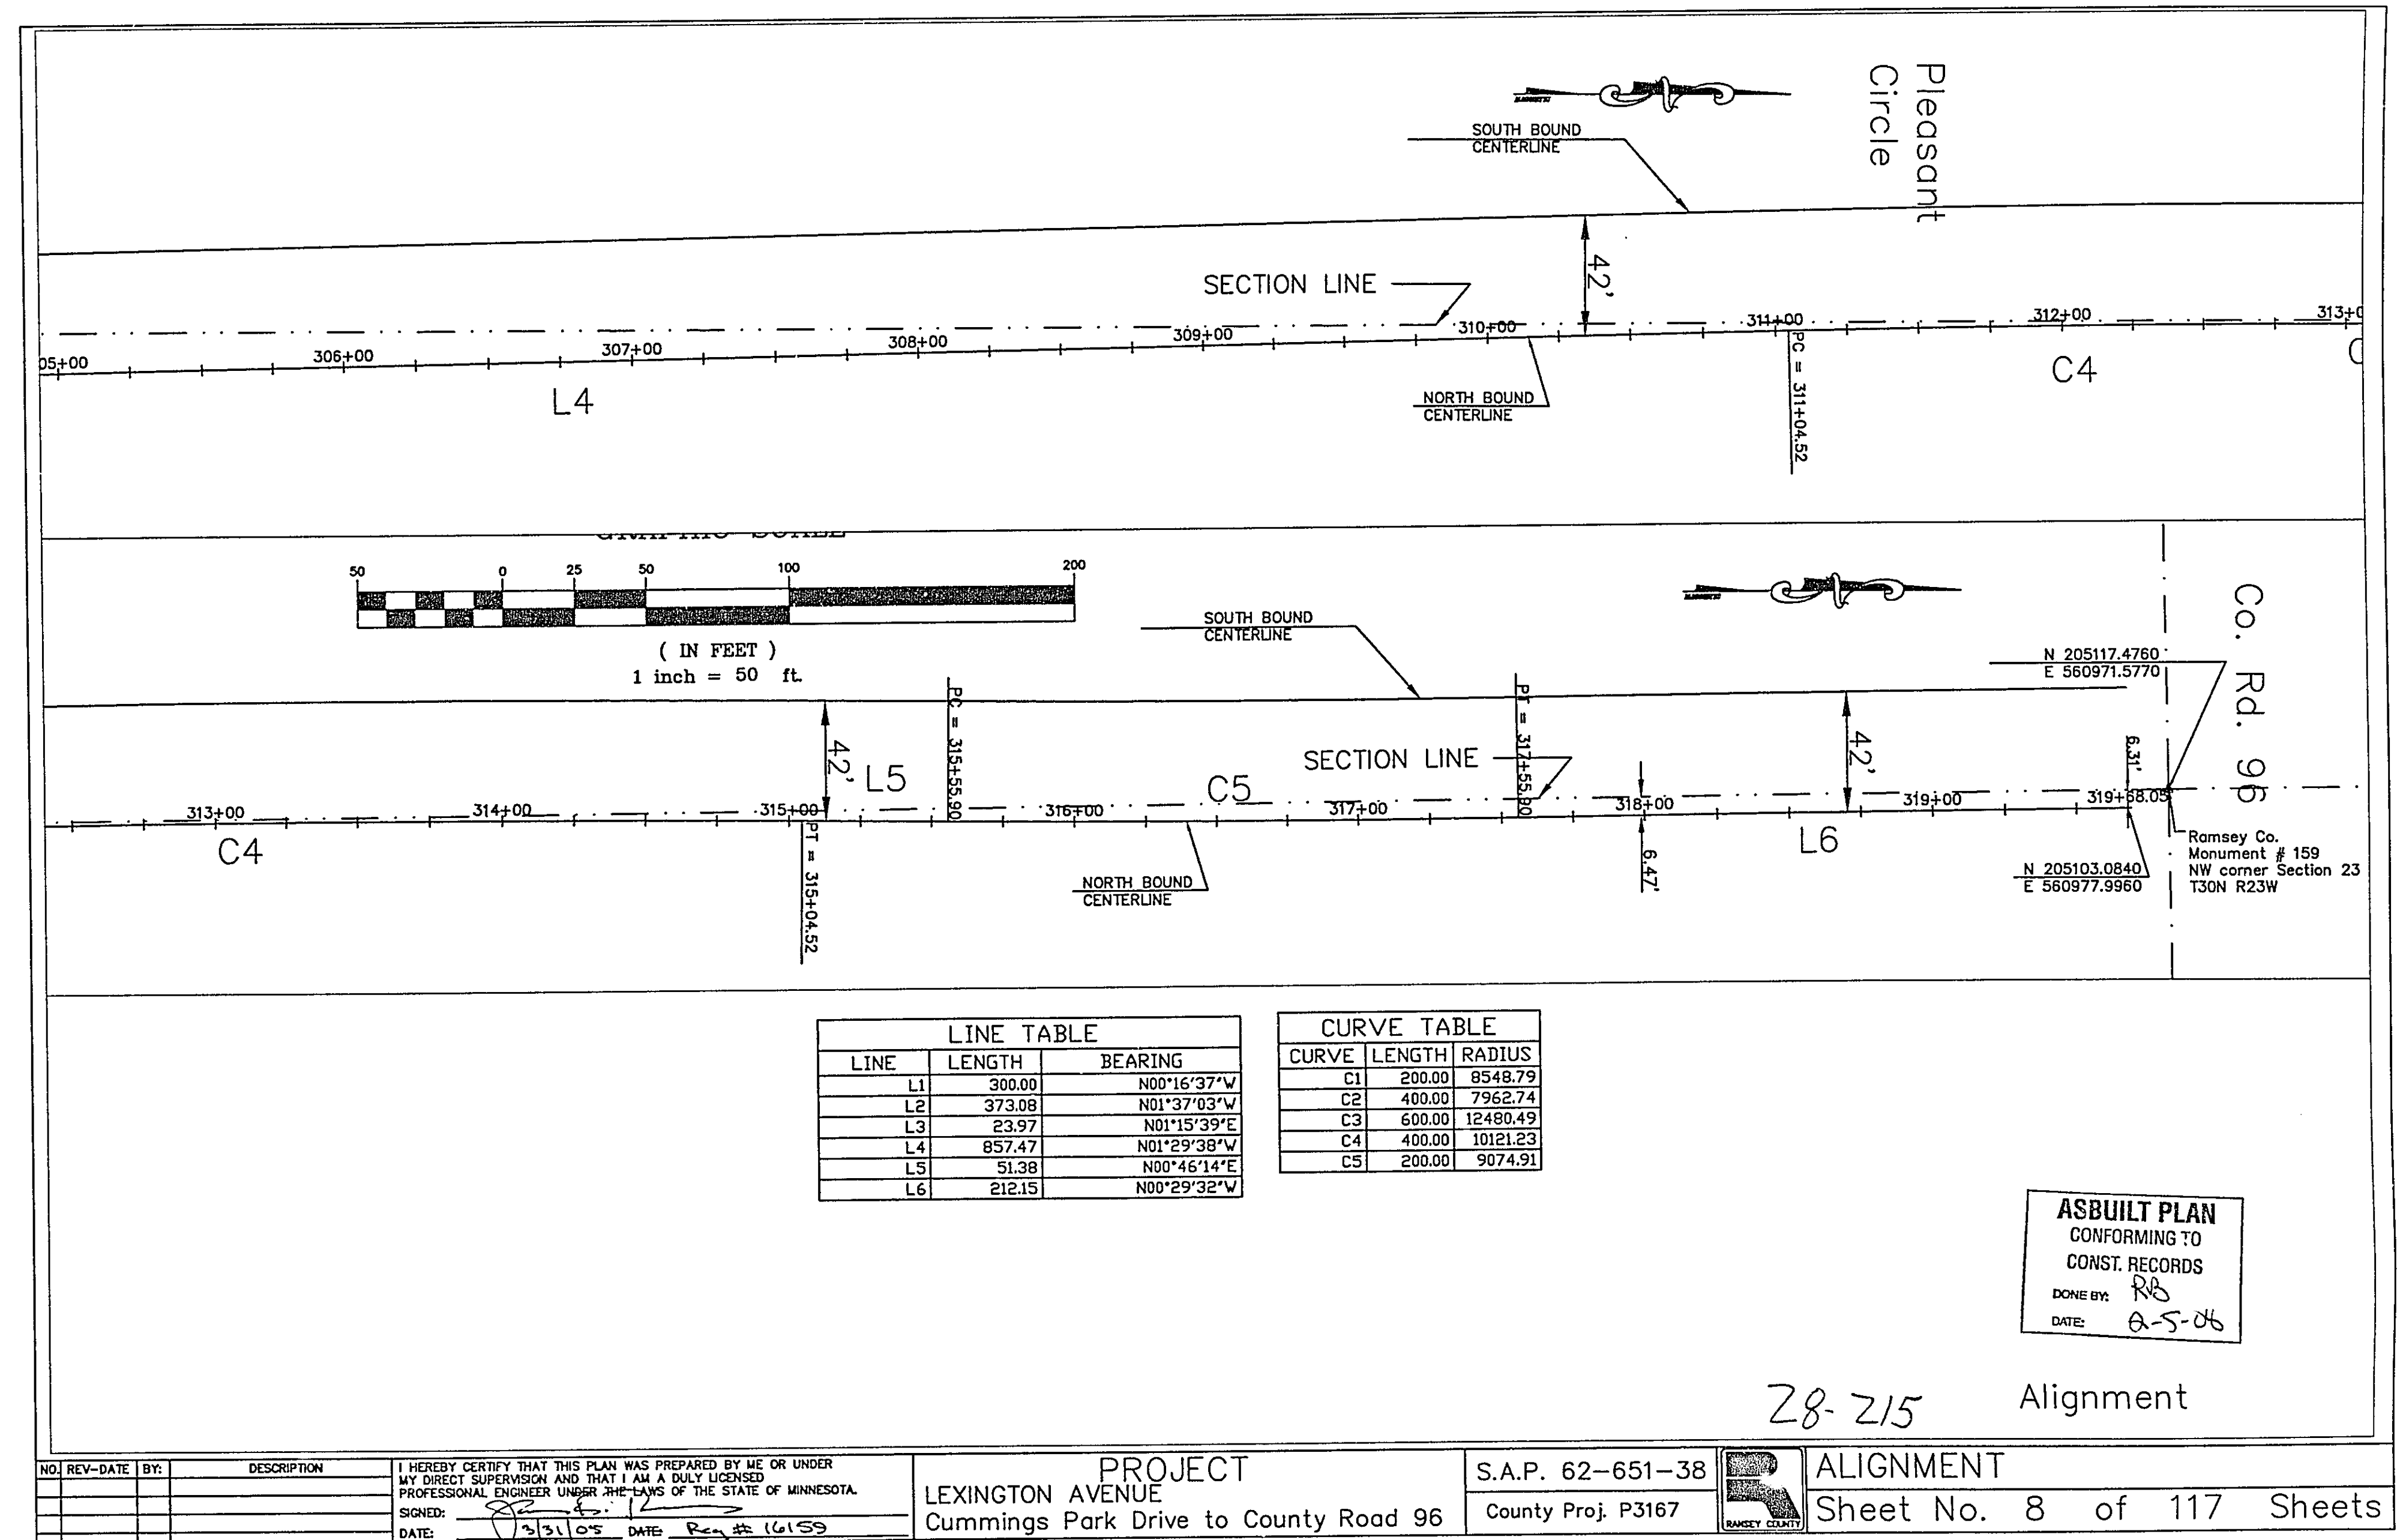
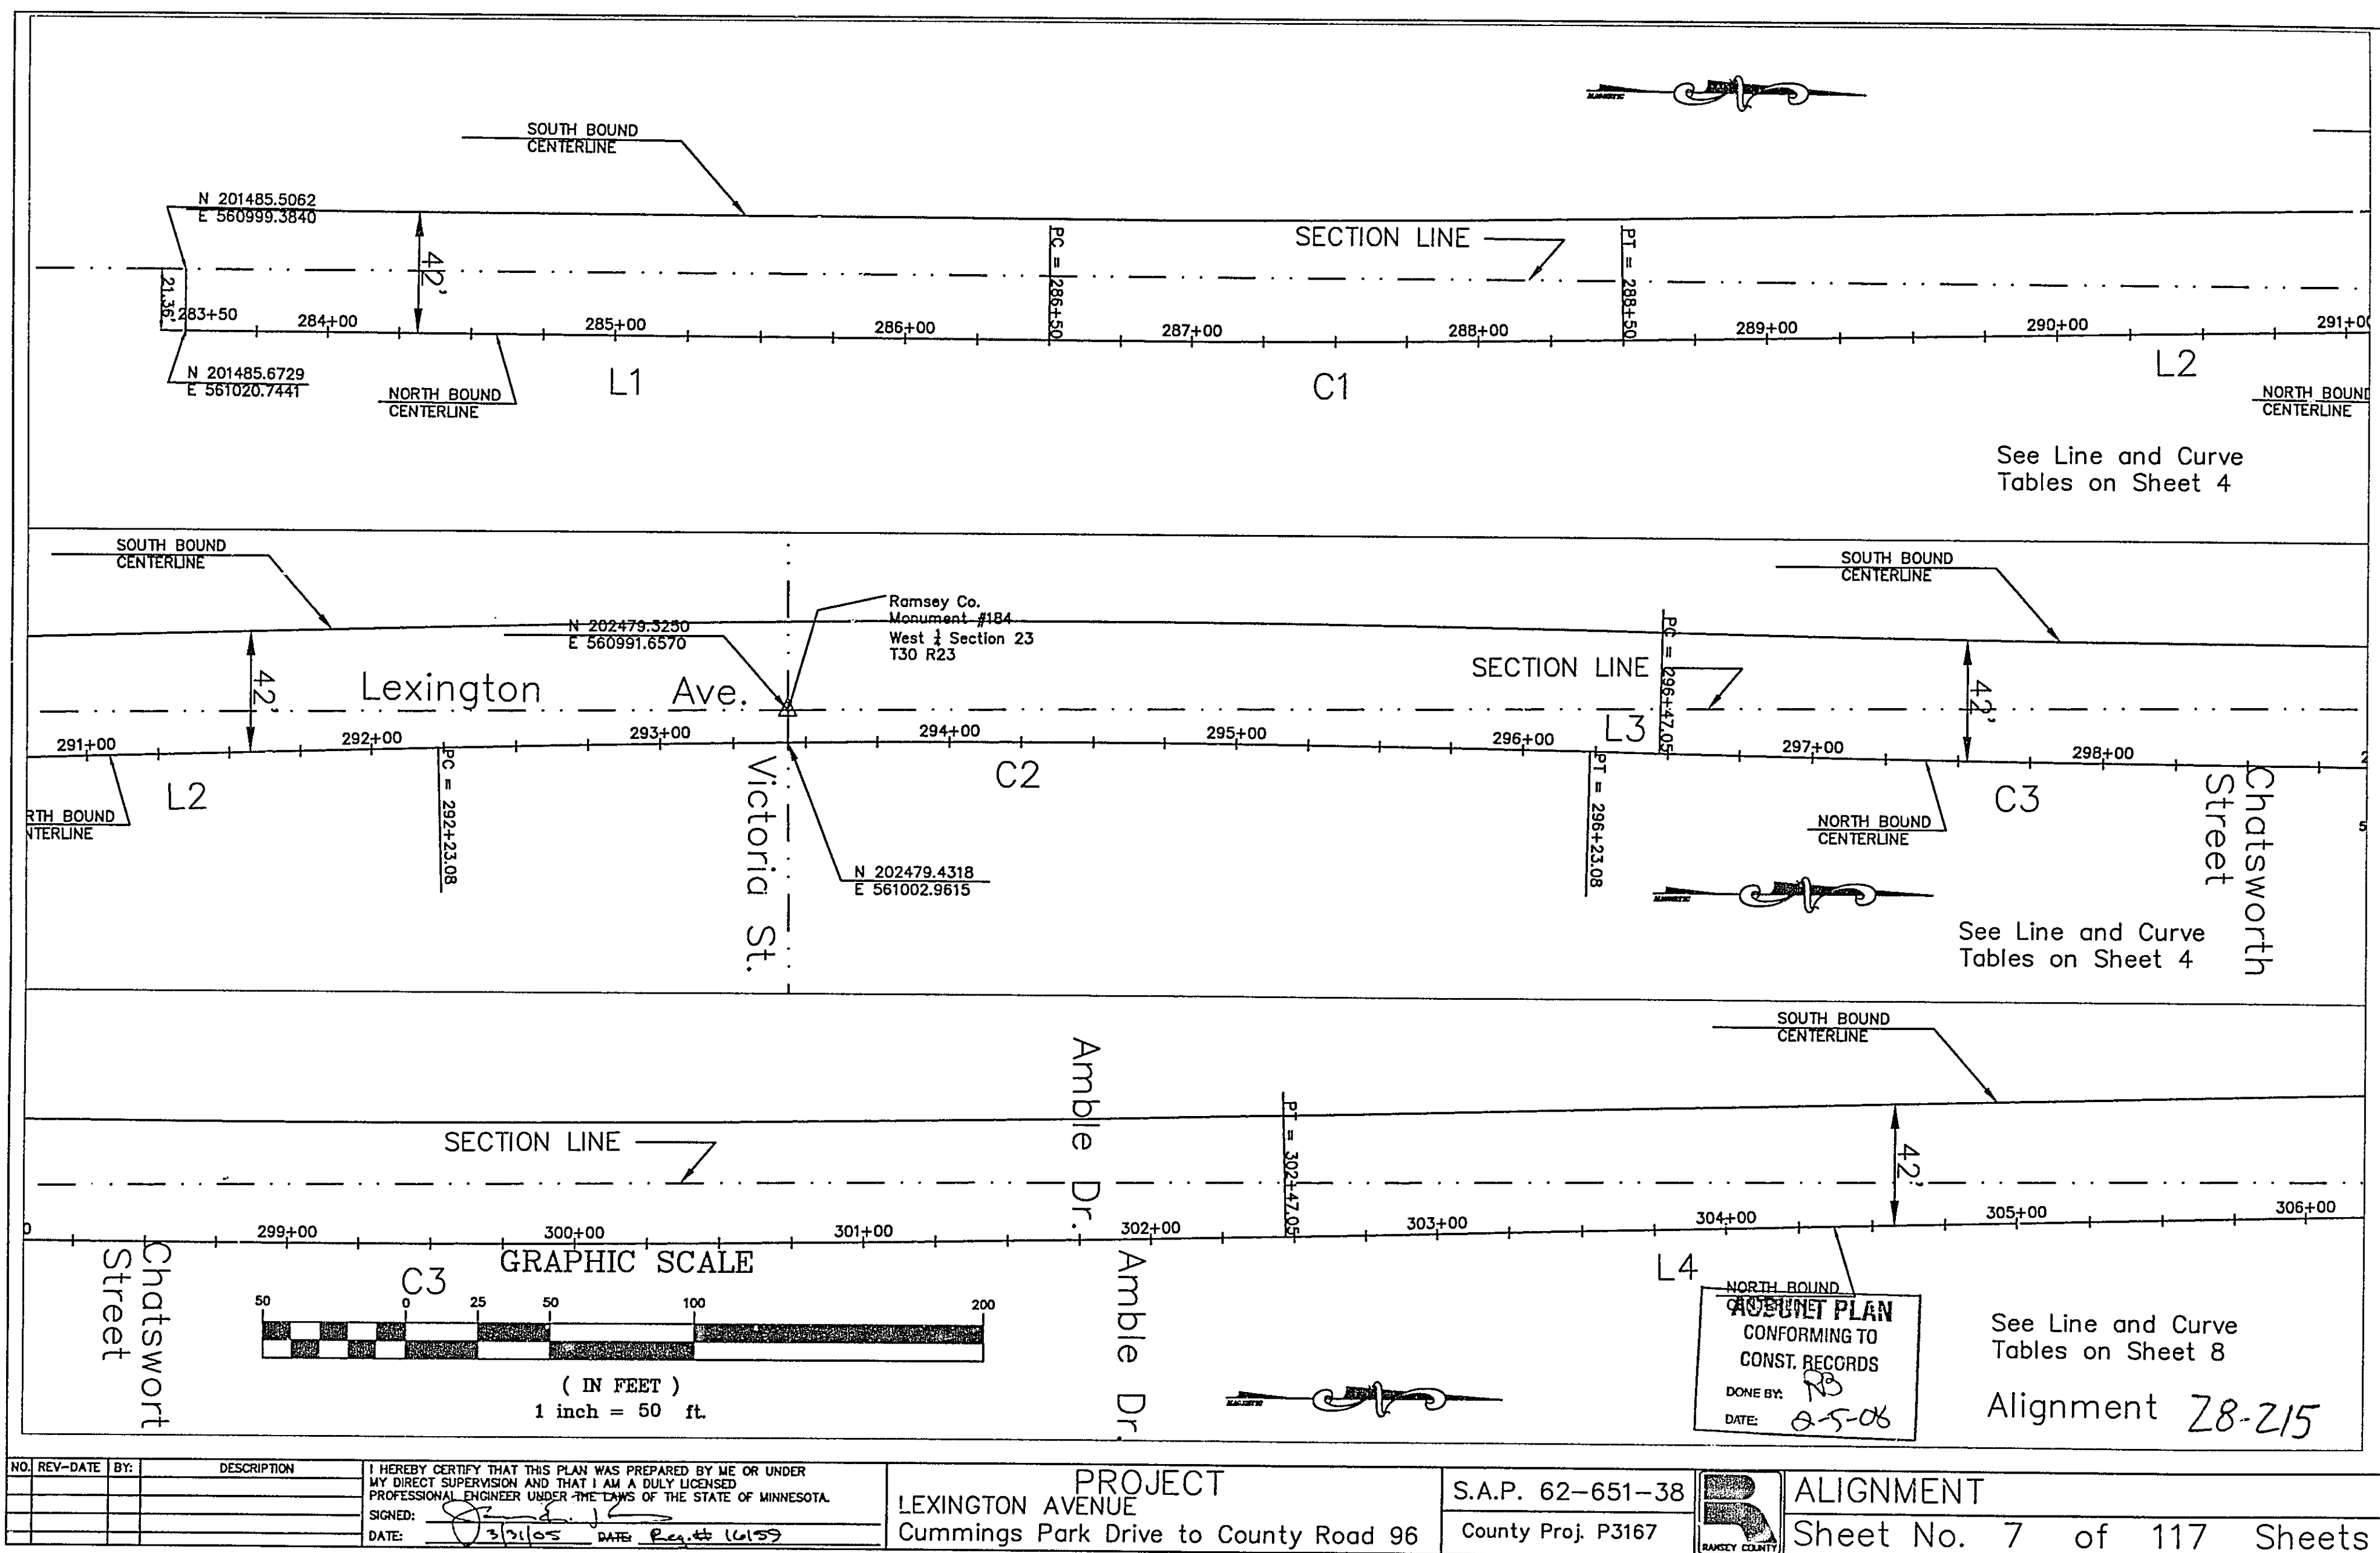


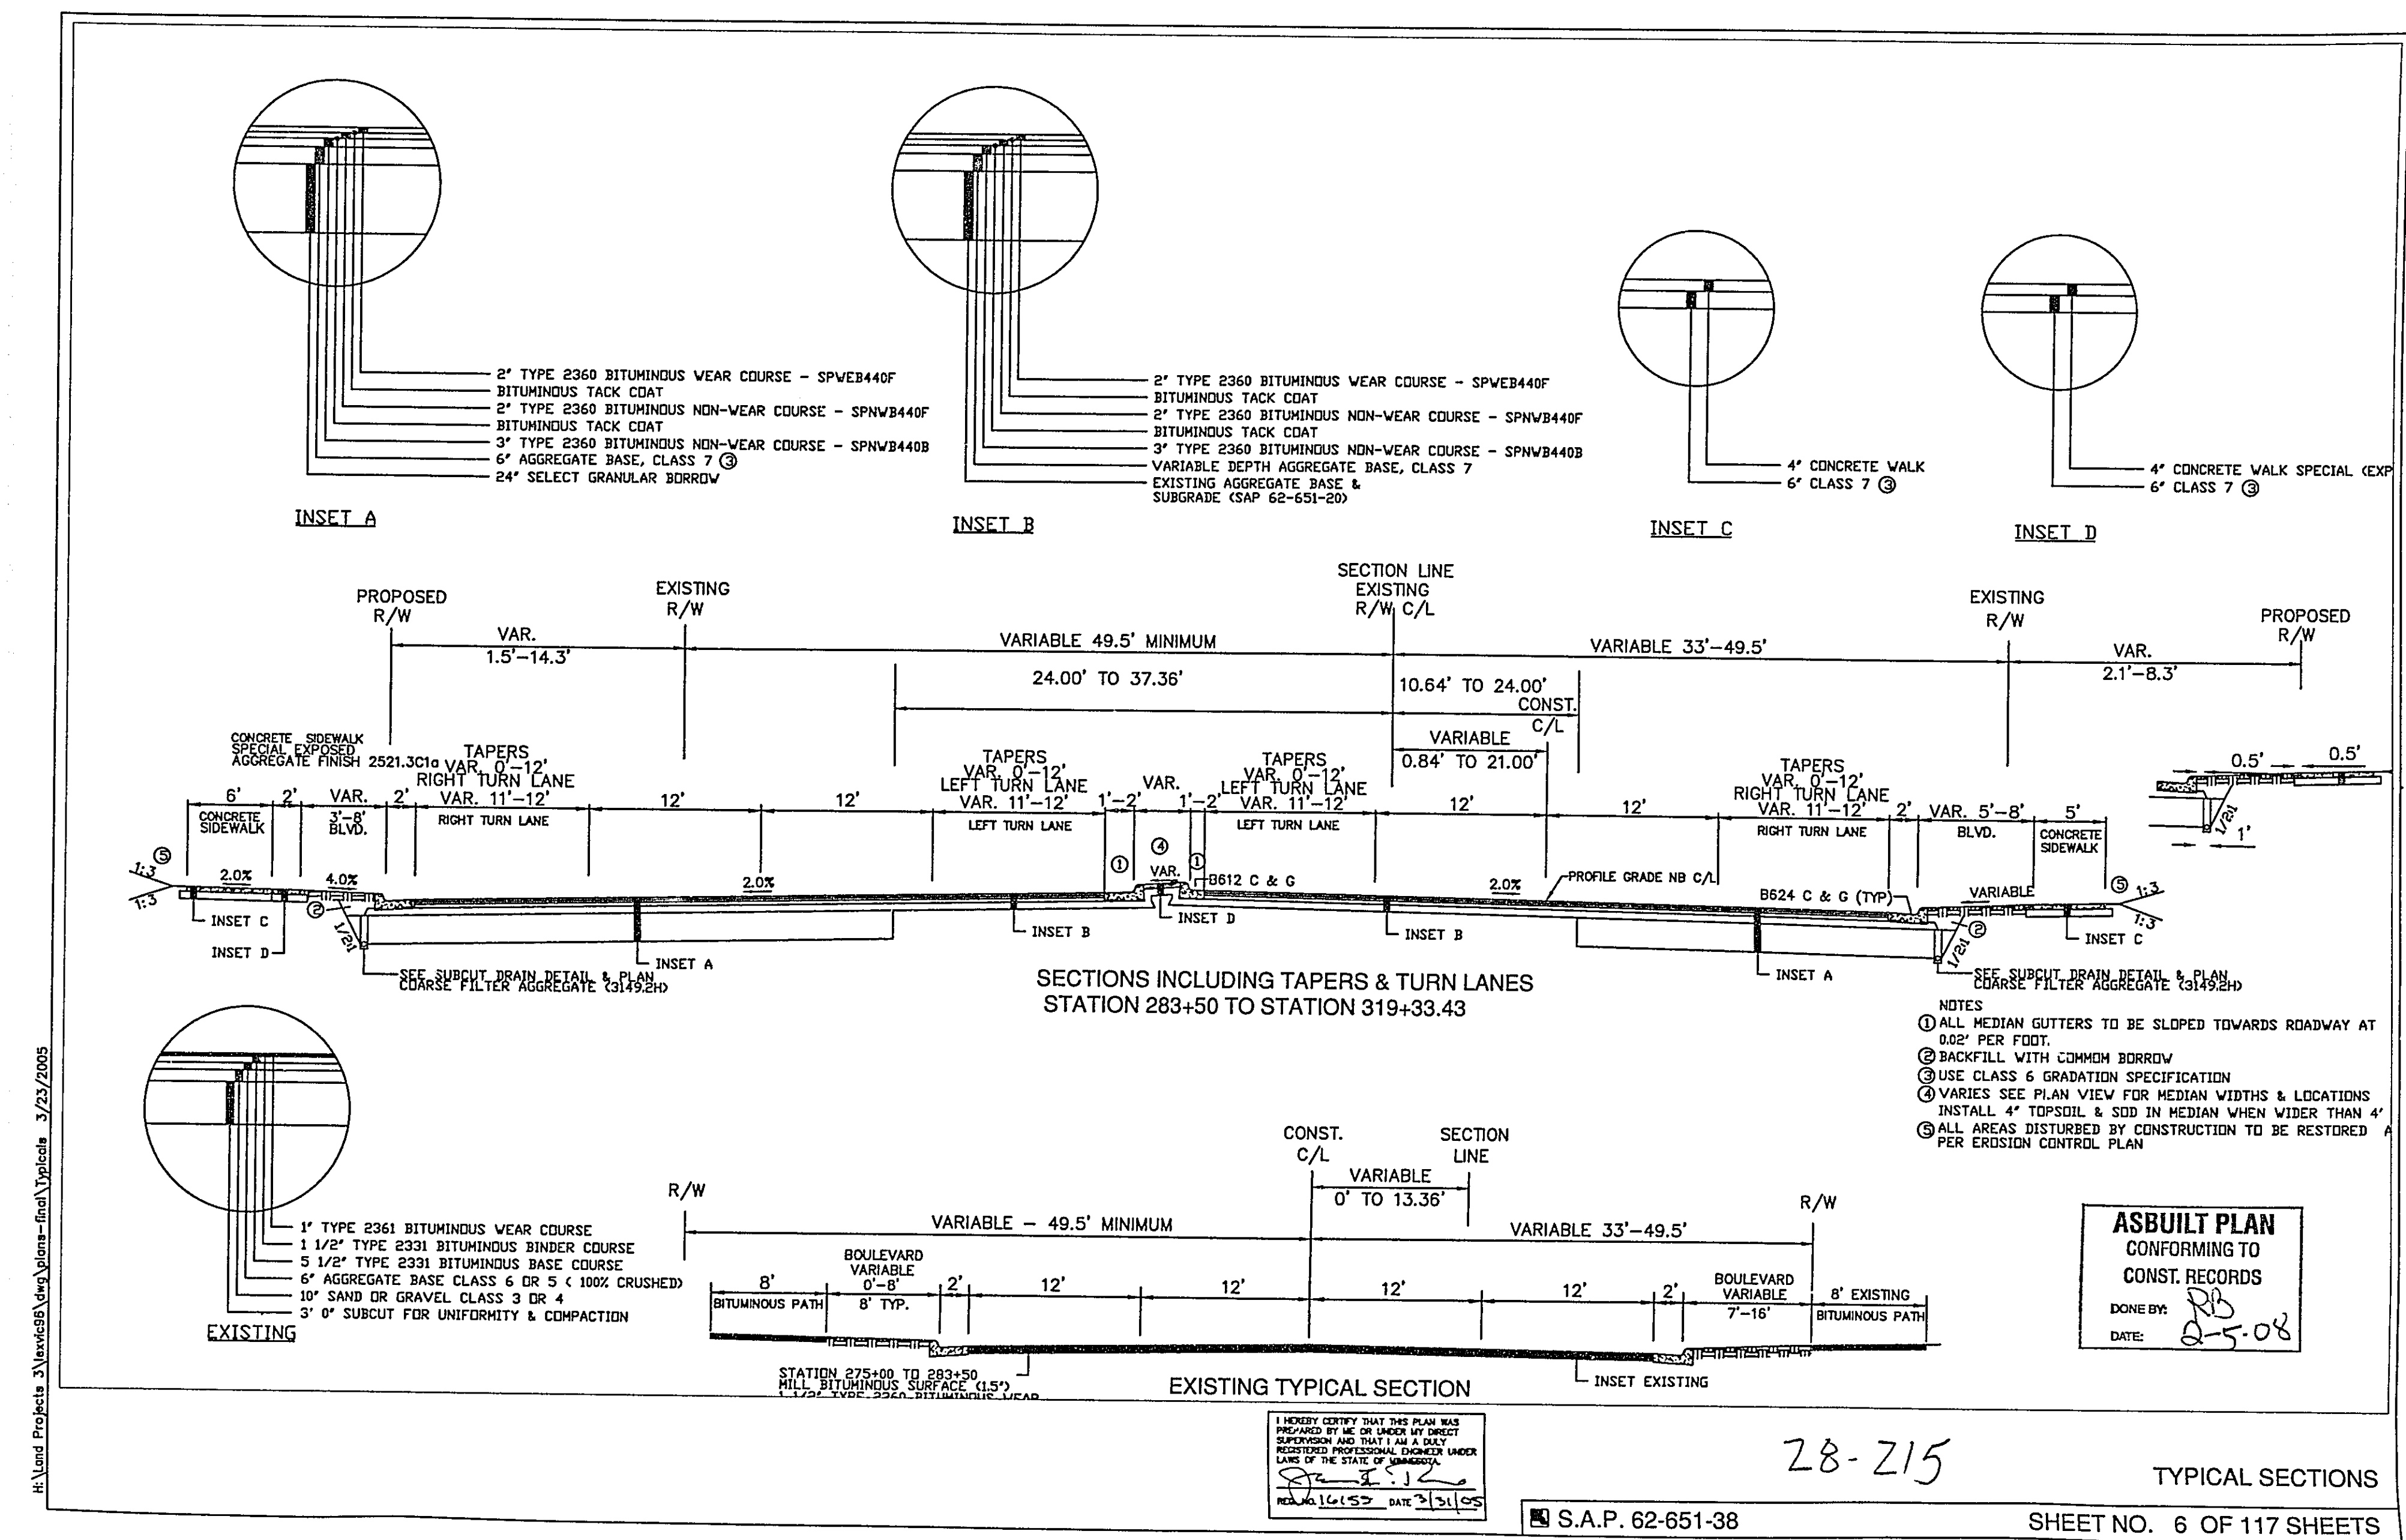

Journal of Management Inquiry 22(1) 3-15
© The Author(s) 2013
Reprints and permissions: sagepub.com/journalsPermissions.nav
DOI: 10.1177/1056492613500591
<http://jmi.sagepub.com>

[illegible]

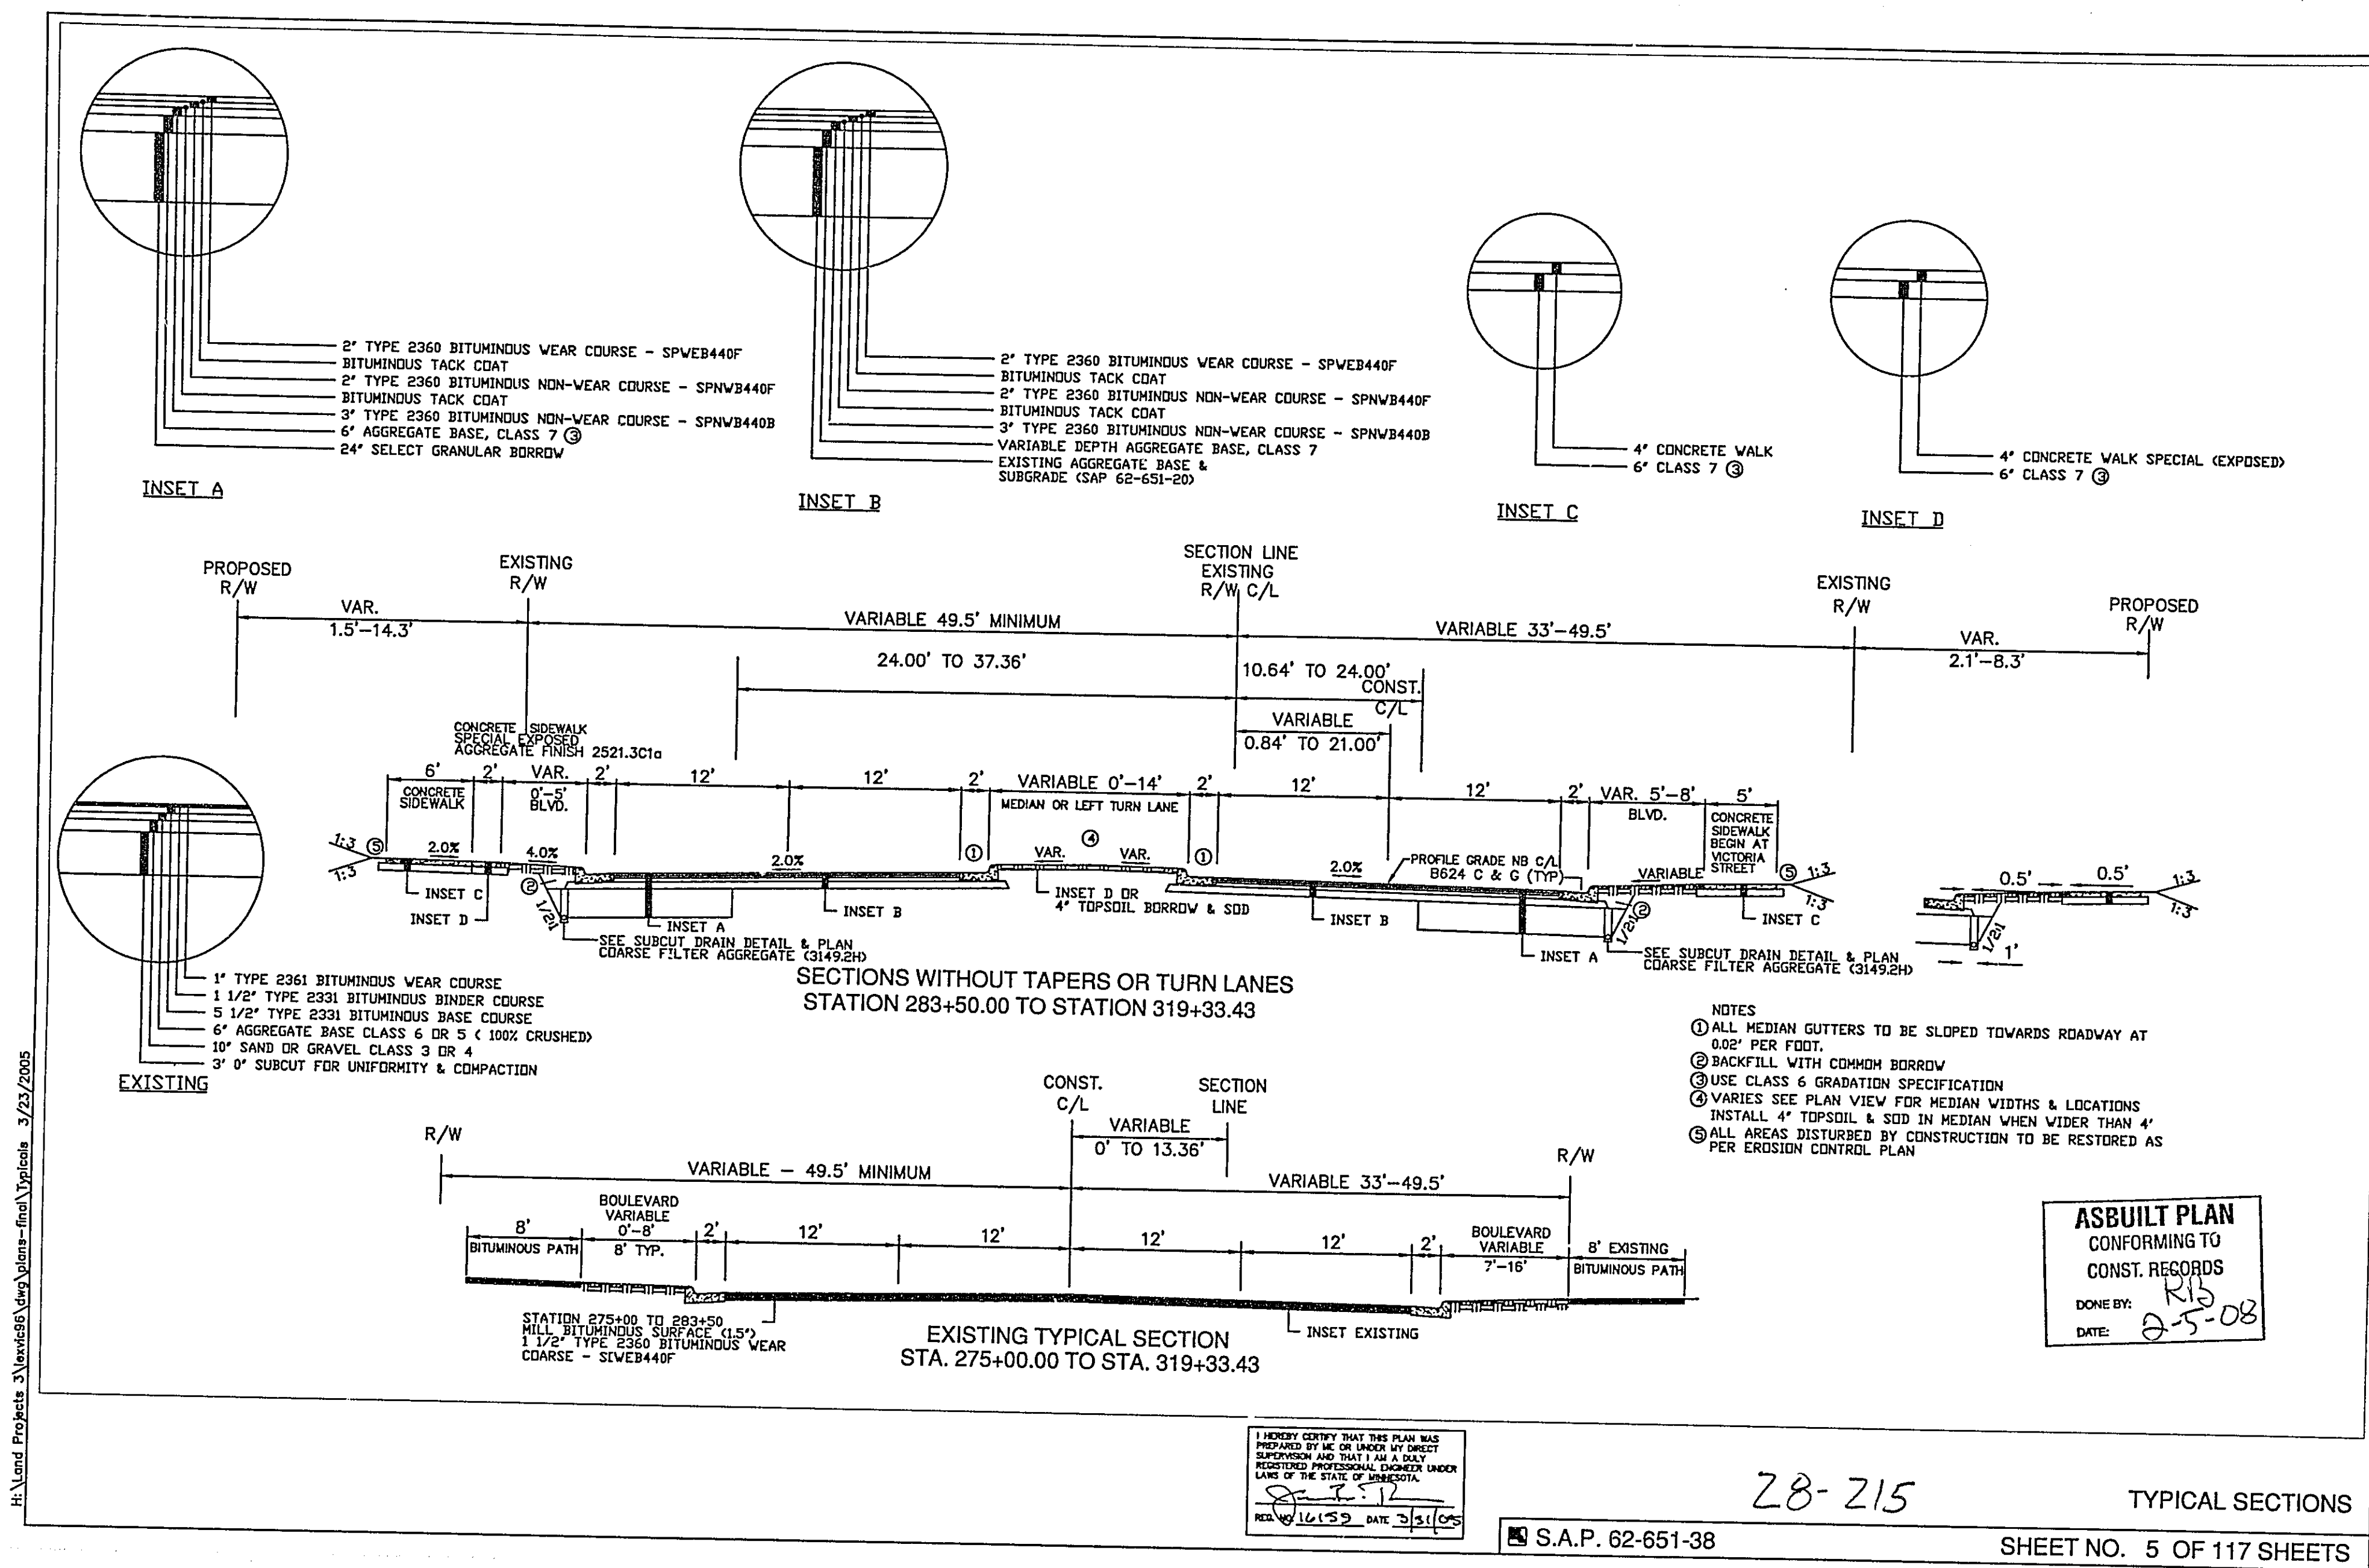


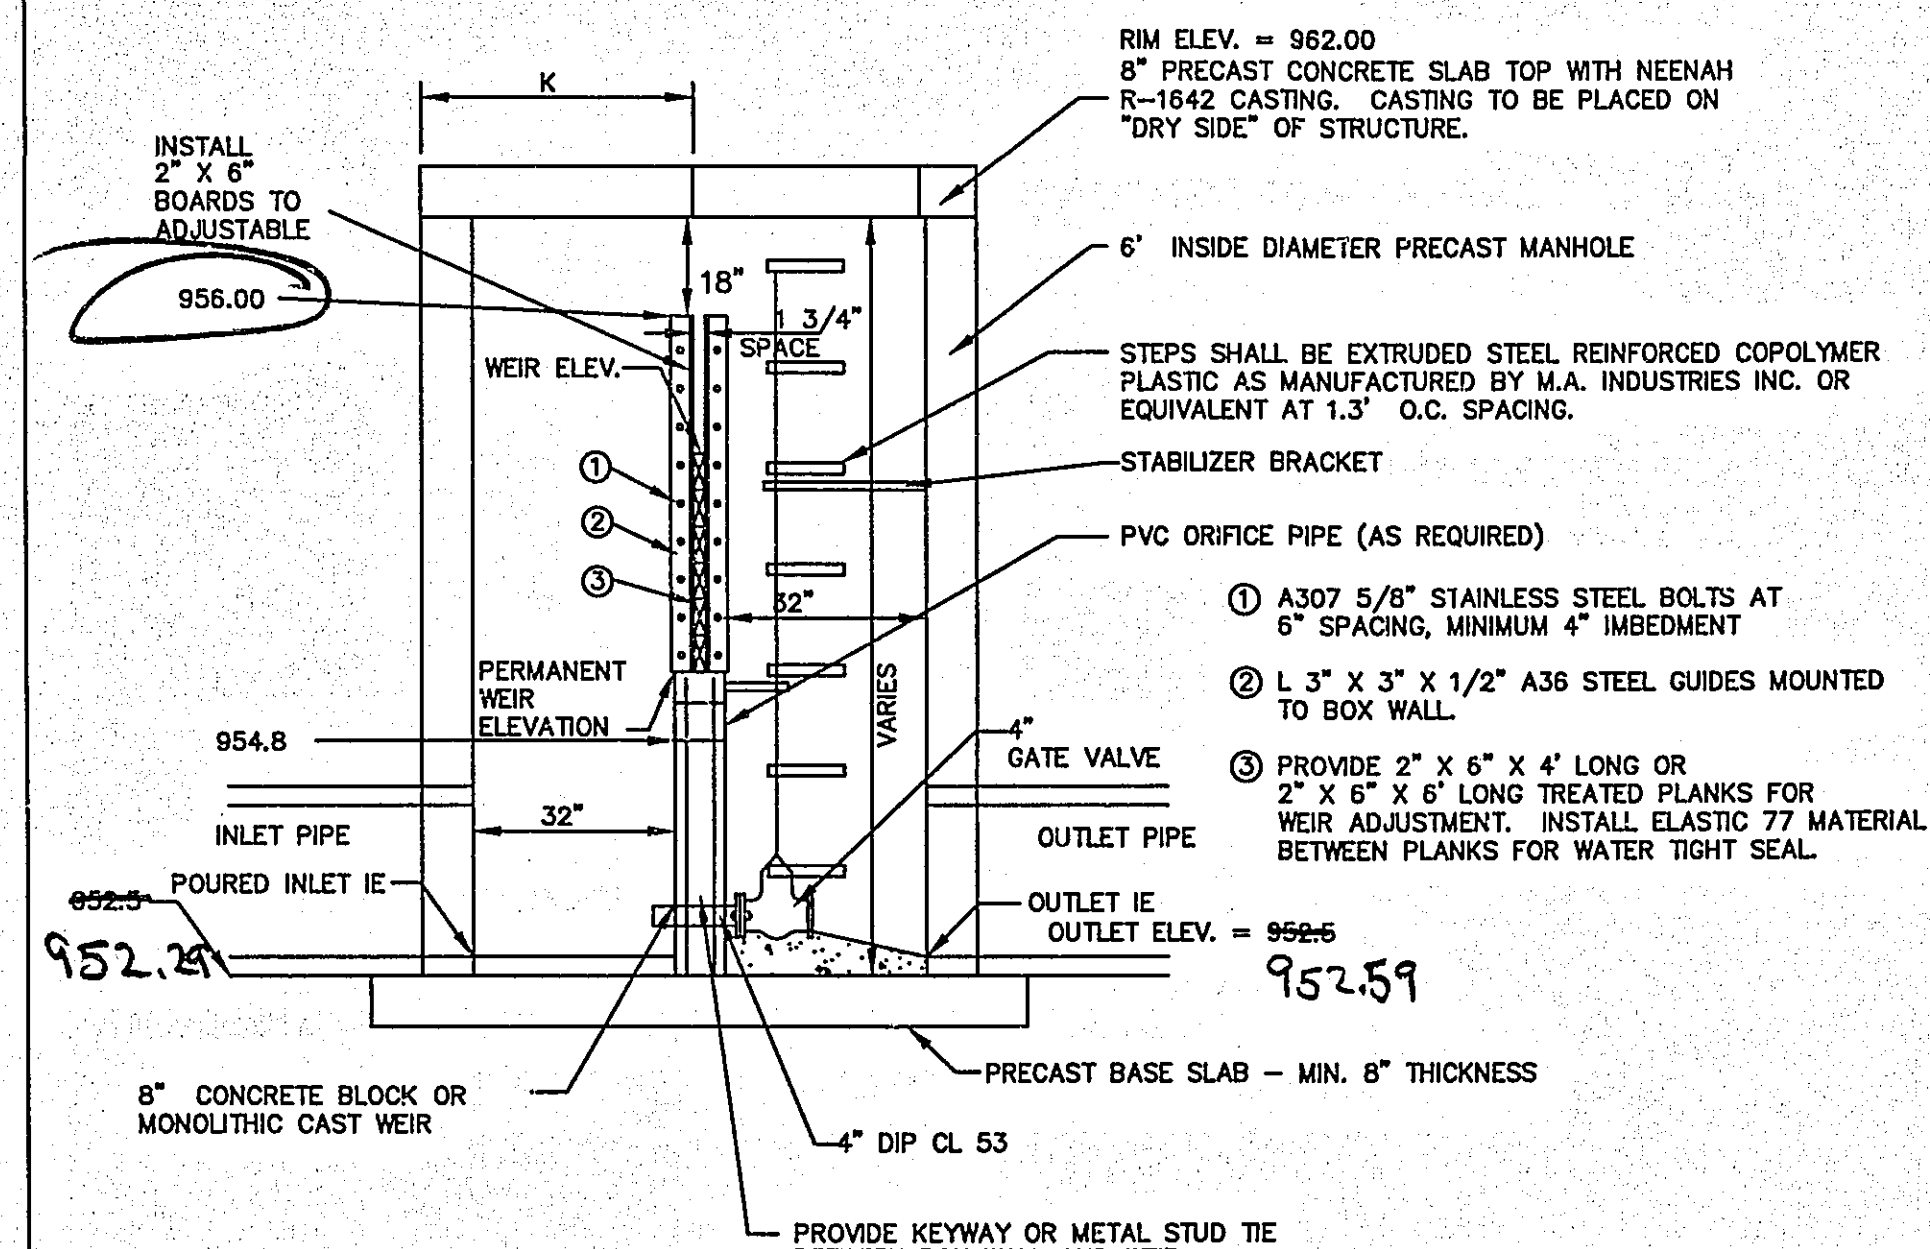

3/4" BARS FOR TRANSVERSE AND EDGE REINFORCEMENT


2 EYE BOLTS INCLUDED

NO. OF BARS	X-Y	A	B	C	D	E	F	G	H	I	J	K
1	1.5	1.5	1.5	1.5	1.5	1.5	1.5	1.5	1.5	1.5	1.5	1.5
2	3.0	3.0	3.0	3.0	3.0	3.0	3.0	3.0	3.0	3.0	3.0	3.0
3	4.5	4.5	4.5	4.5	4.5	4.5	4.5	4.5	4.5	4.5	4.5	4.5
4	6.0	6.0	6.0	6.0	6.0	6.0	6.0	6.0	6.0	6.0	6.0	6.0
5	7.5	7.5	7.5	7.5	7.5	7.5	7.5	7.5	7.5	7.5	7.5	7.5
6	9.0	9.0	9.0	9.0	9.0	9.0	9.0	9.0	9.0	9.0	9.0	9.0
7	10.5	10.5	10.5	10.5	10.5	10.5	10.5	10.5	10.5	10.5	10.5	10.5
8	12.0	12.0	12.0	12.0	12.0	12.0	12.0	12.0	12.0	12.0	12.0	12.0
9	13.5	13.5	13.5	13.5	13.5	13.5	13.5	13.5	13.5	13.5	13.5	13.5
10	15.0	15.0	15.0	15.0	15.0	15.0	15.0	15.0	15.0	15.0	15.0	15.0
11	16.5	16.5	16.5	16.5	16.5	16.5	16.5	16.5	16.5	16.5	16.5	16.5
12	18.0	18.0	18.0	18.0	18.0	18.0	18.0	18.0	18.0	18.0	18.0	18.0
13	19.5	19.5	19.5	19.5	19.5	19.5	19.5	19.5	19.5	19.5	19.5	19.5
14	21.0	21.0	21.0	21.0	21.0	21.0	21.0	21.0	21.0	21.0	21.0	21.0
15	22.5	22.5	22.5	22.5	22.5	22.5	22.5	22.5	22.5	22.5	22.5	22.5
16	24.0	24.0	24.0	24.0	24.0	24.0	24.0	24.0	24.0	24.0	24.0	24.0
17	25.5	25.5	25.5	25.5	25.5	25.5	25.5	25.5	25.5	25.5	25.5	25.5
18	27.0	27.0	27.0	27.0	27.0	27.0	27.0	27.0	27.0	27.0	27.0	27.0
19	28.5	28.5	28.5	28.5	28.5	28.5	28.5	28.5	28.5	28.5	28.5	28.5
20	30.0	30.0	30.0	30.0	30.0	30.0	30.0	30.0	30.0	30.0	30.0	30.0

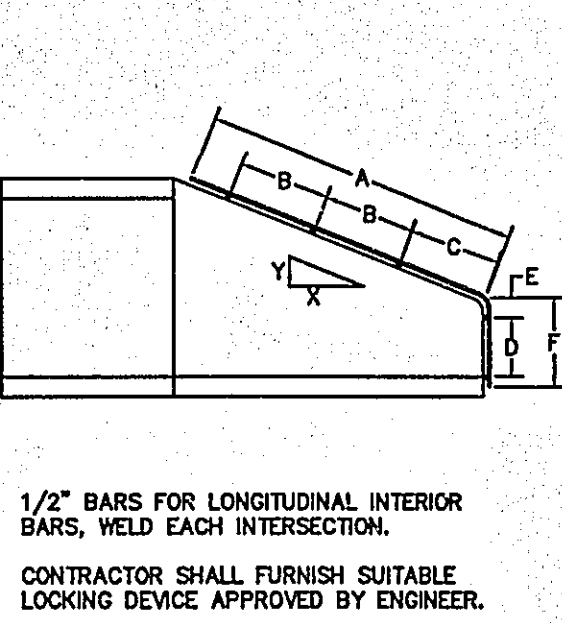

TRASH GUARD (GALVANIZED)
(FOR CONCRETE APRON)


4" LONGITUDINAL TP OR P.E. PIPE DETAIL - SUBCUT DRAINAGE

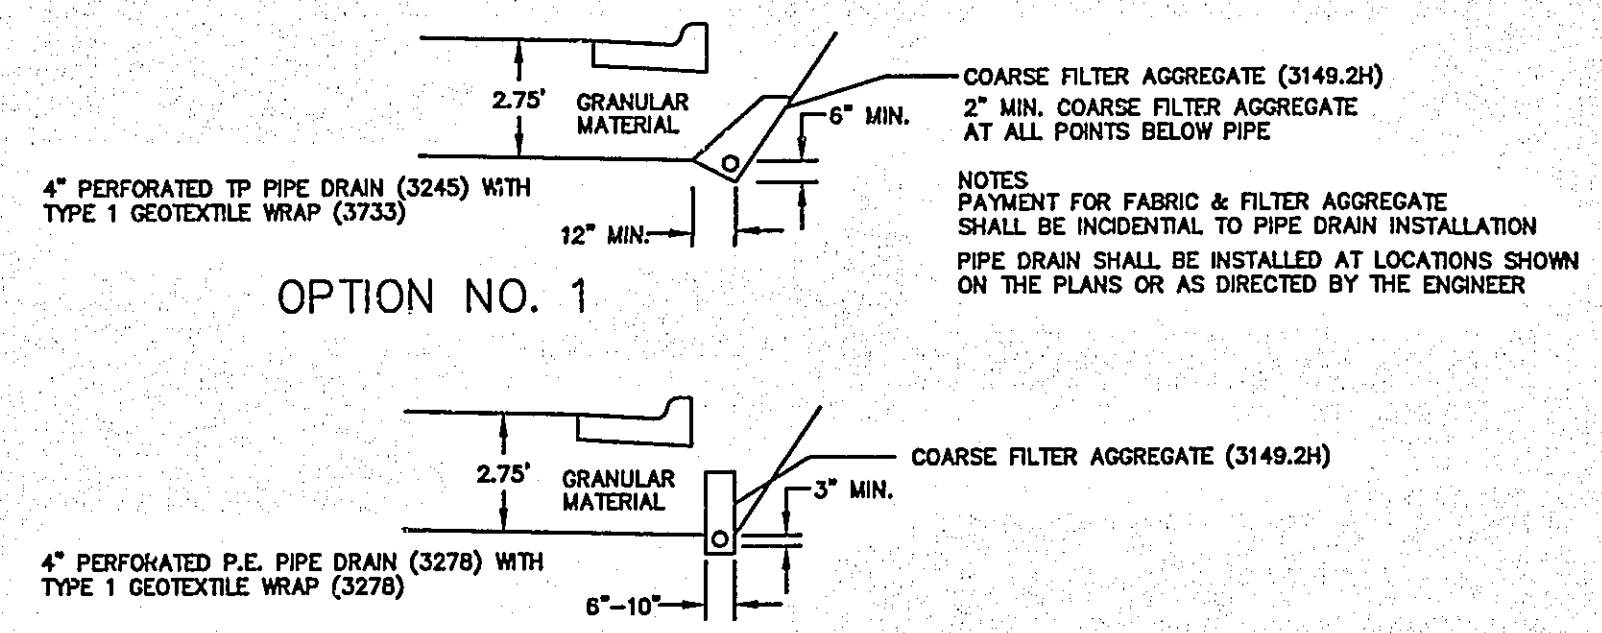

SUBCUT DRAIN DETAILS
(2 OPTIONS)

STORM SEWER DETAILS

S.A.P. No. 62-651-38 Sheet No. 19 of 117 Sheets

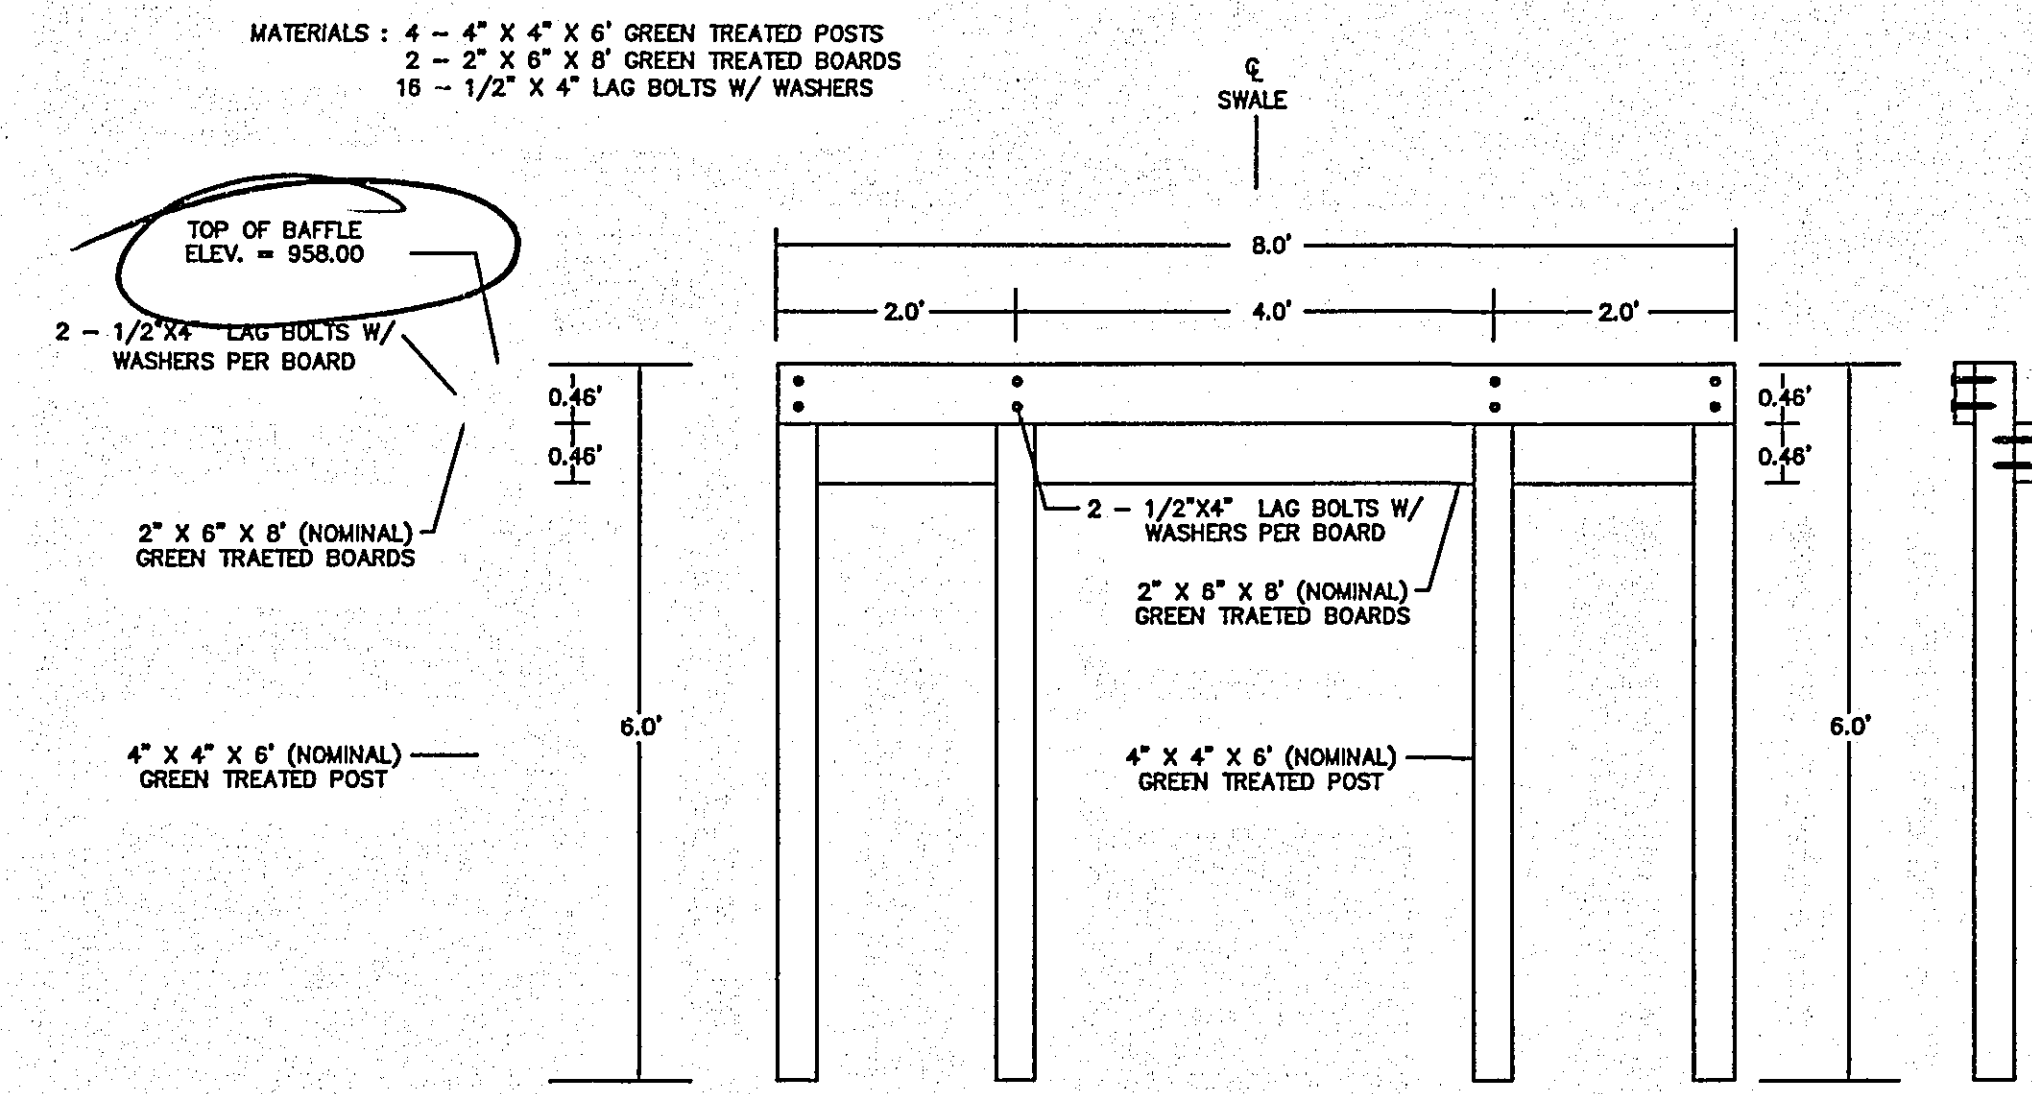



ASBUILT PLAN
CONFORMING TO
CONST. RECORDS
DONE BY: RB
DATE: 2-5-08





28-215



I hereby certify that this plan was prepared by me or under my direct supervision and that I am a duly Licensed Professional Engineer under the laws of the State of Minnesota.
R.B.
Date: 2/5/08 Reg. No. 16153





DETAILS


S.A.P. No. 62-651-38 Sheet No. 19A of 117 Sheets

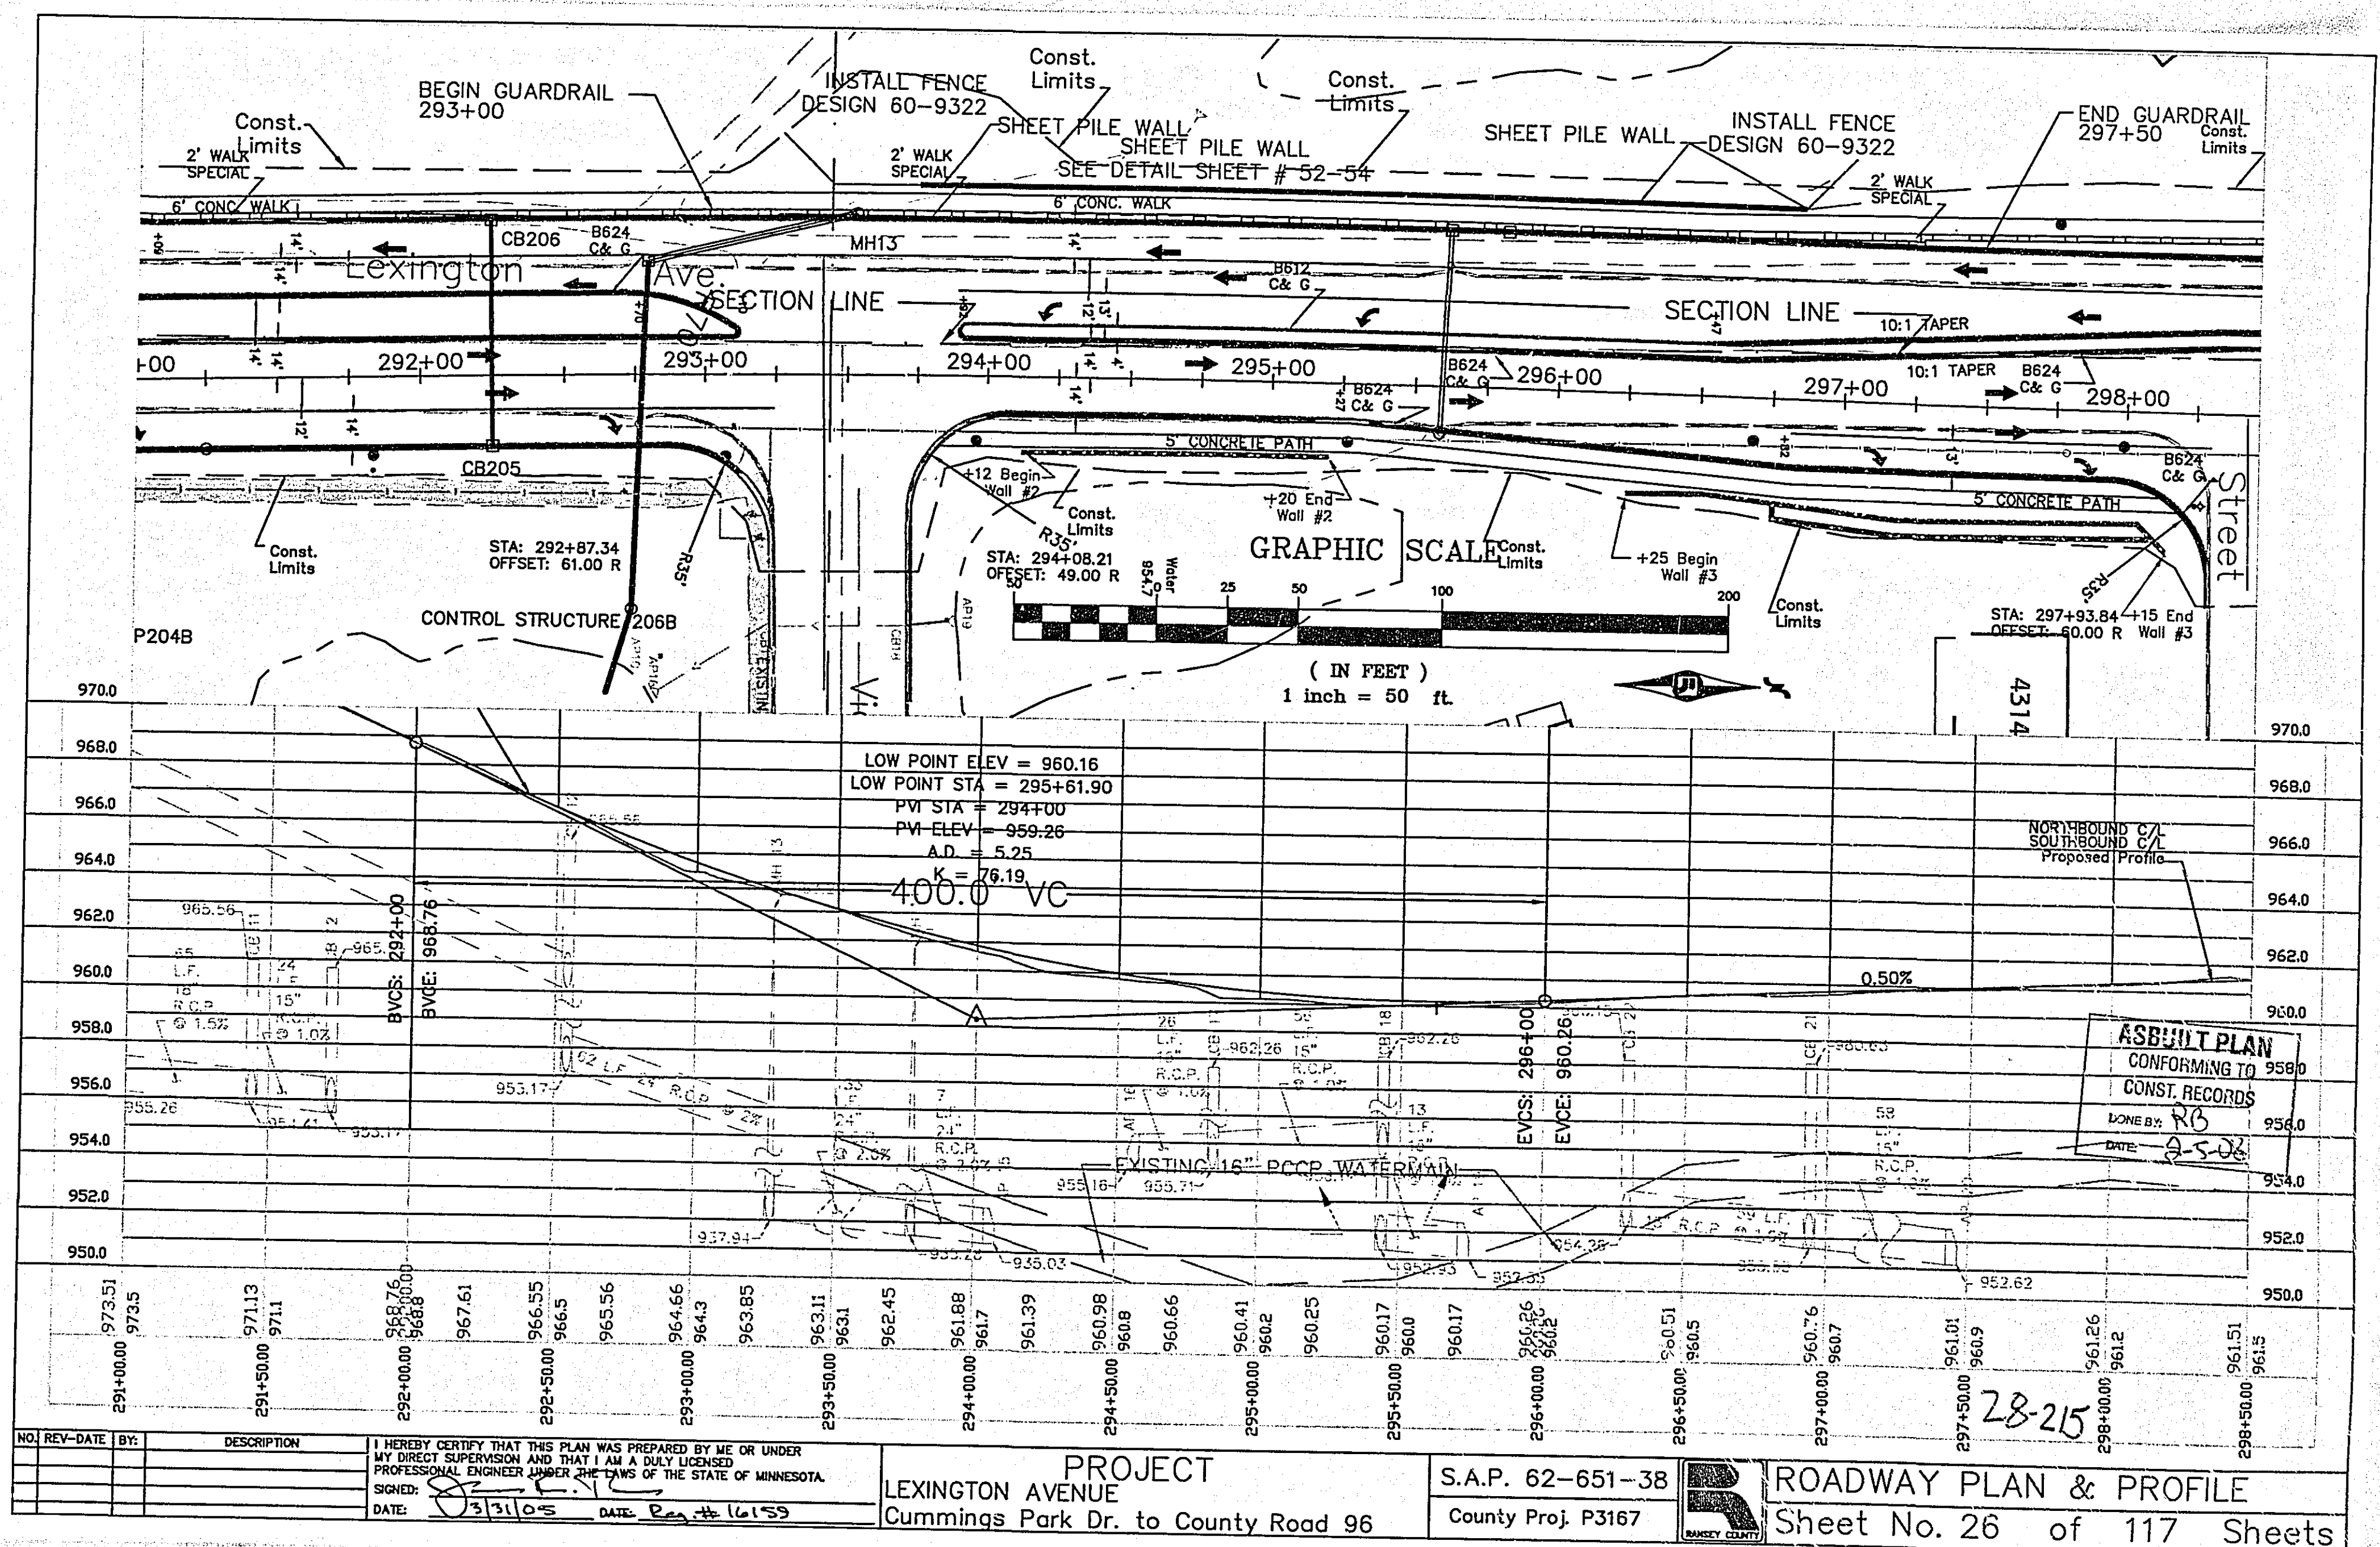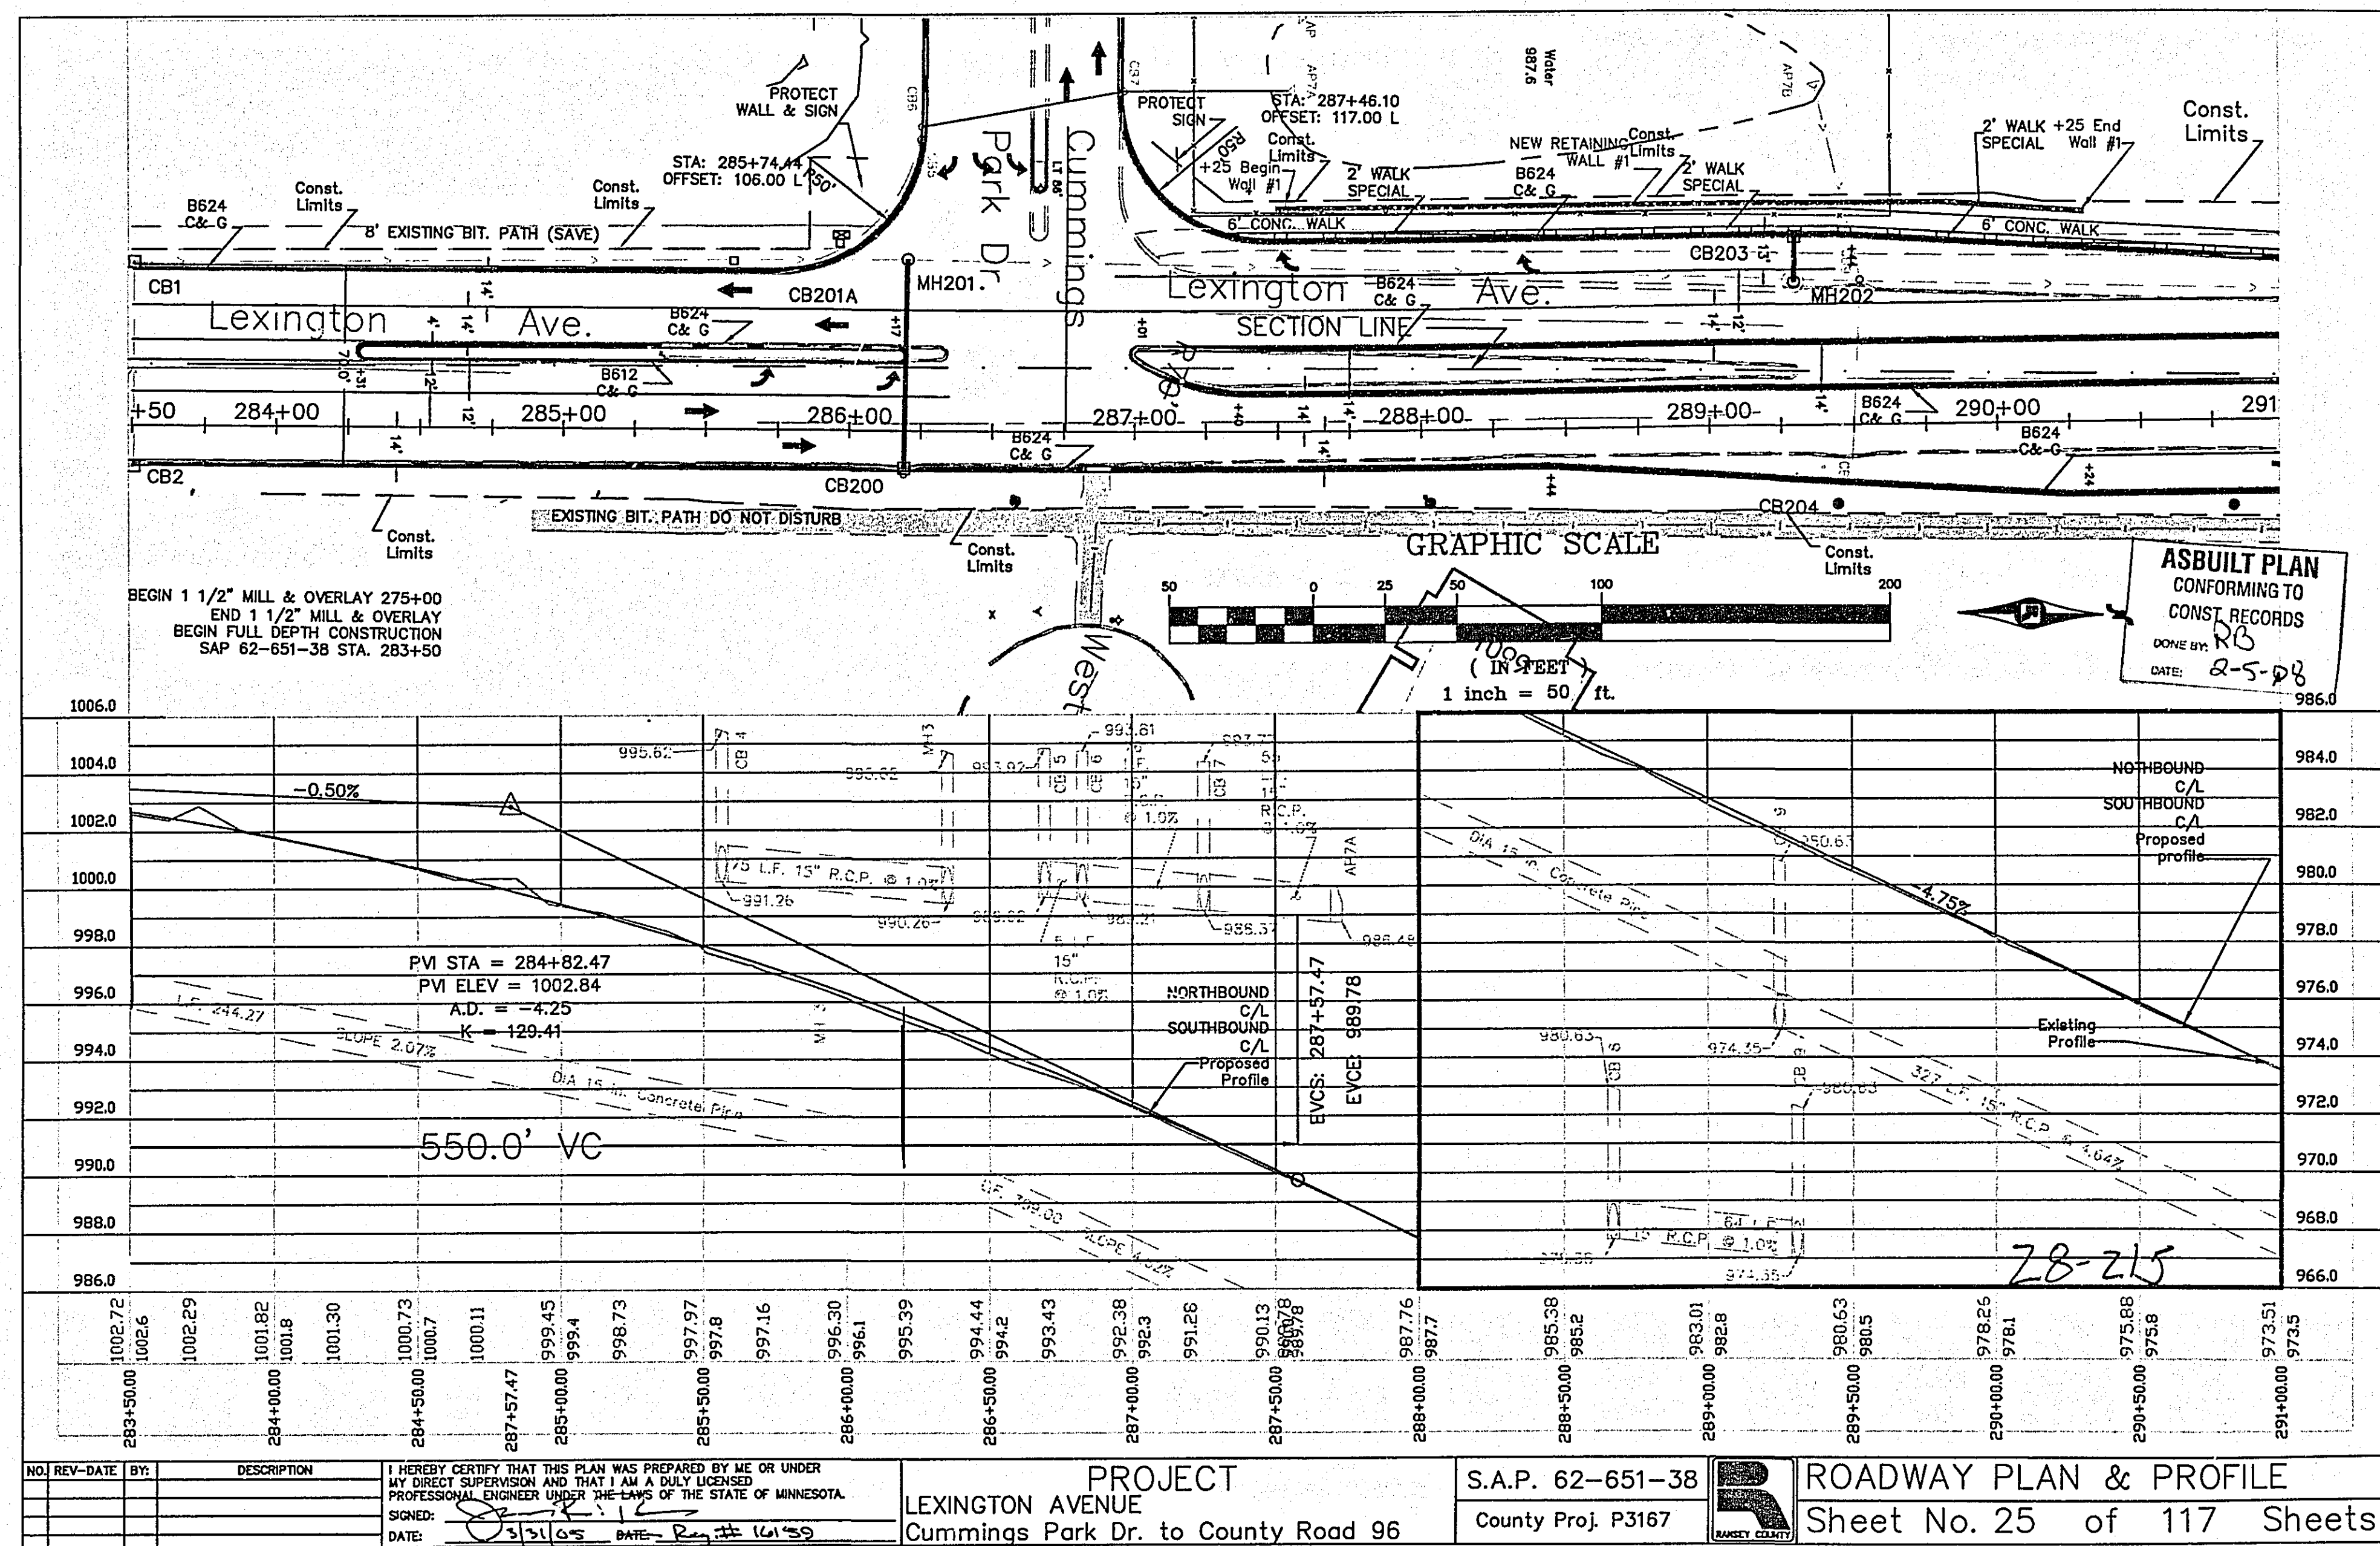

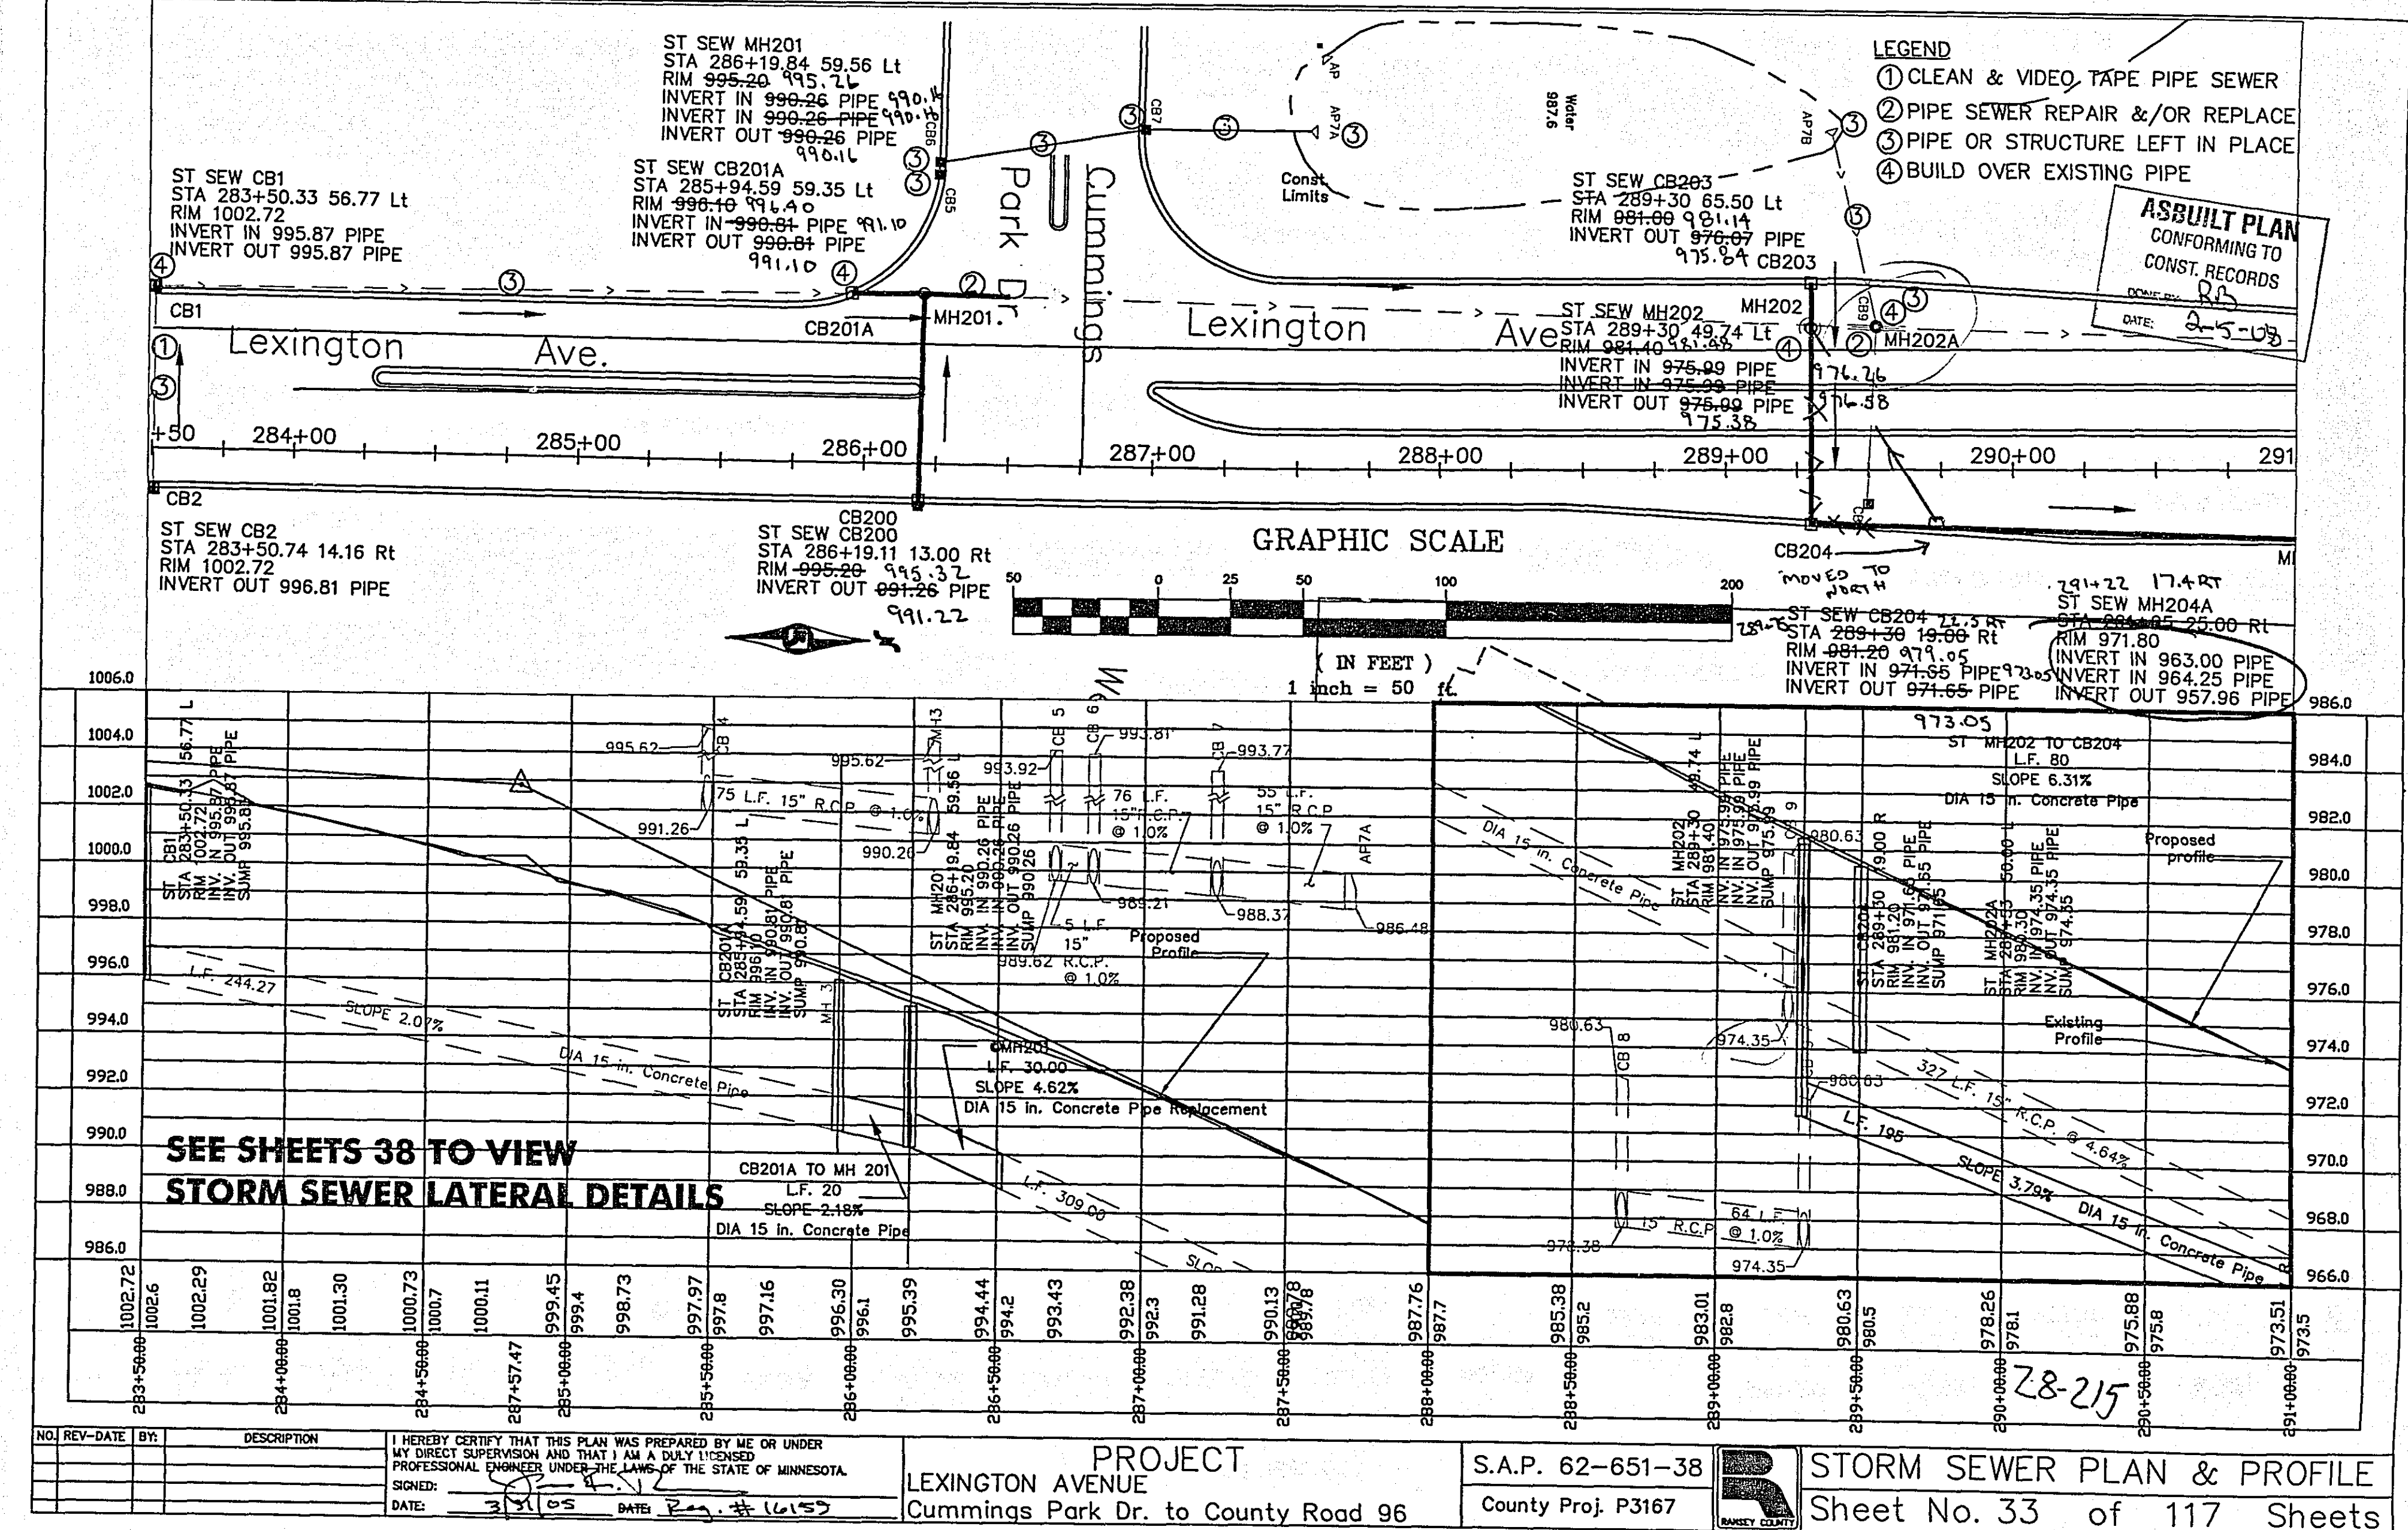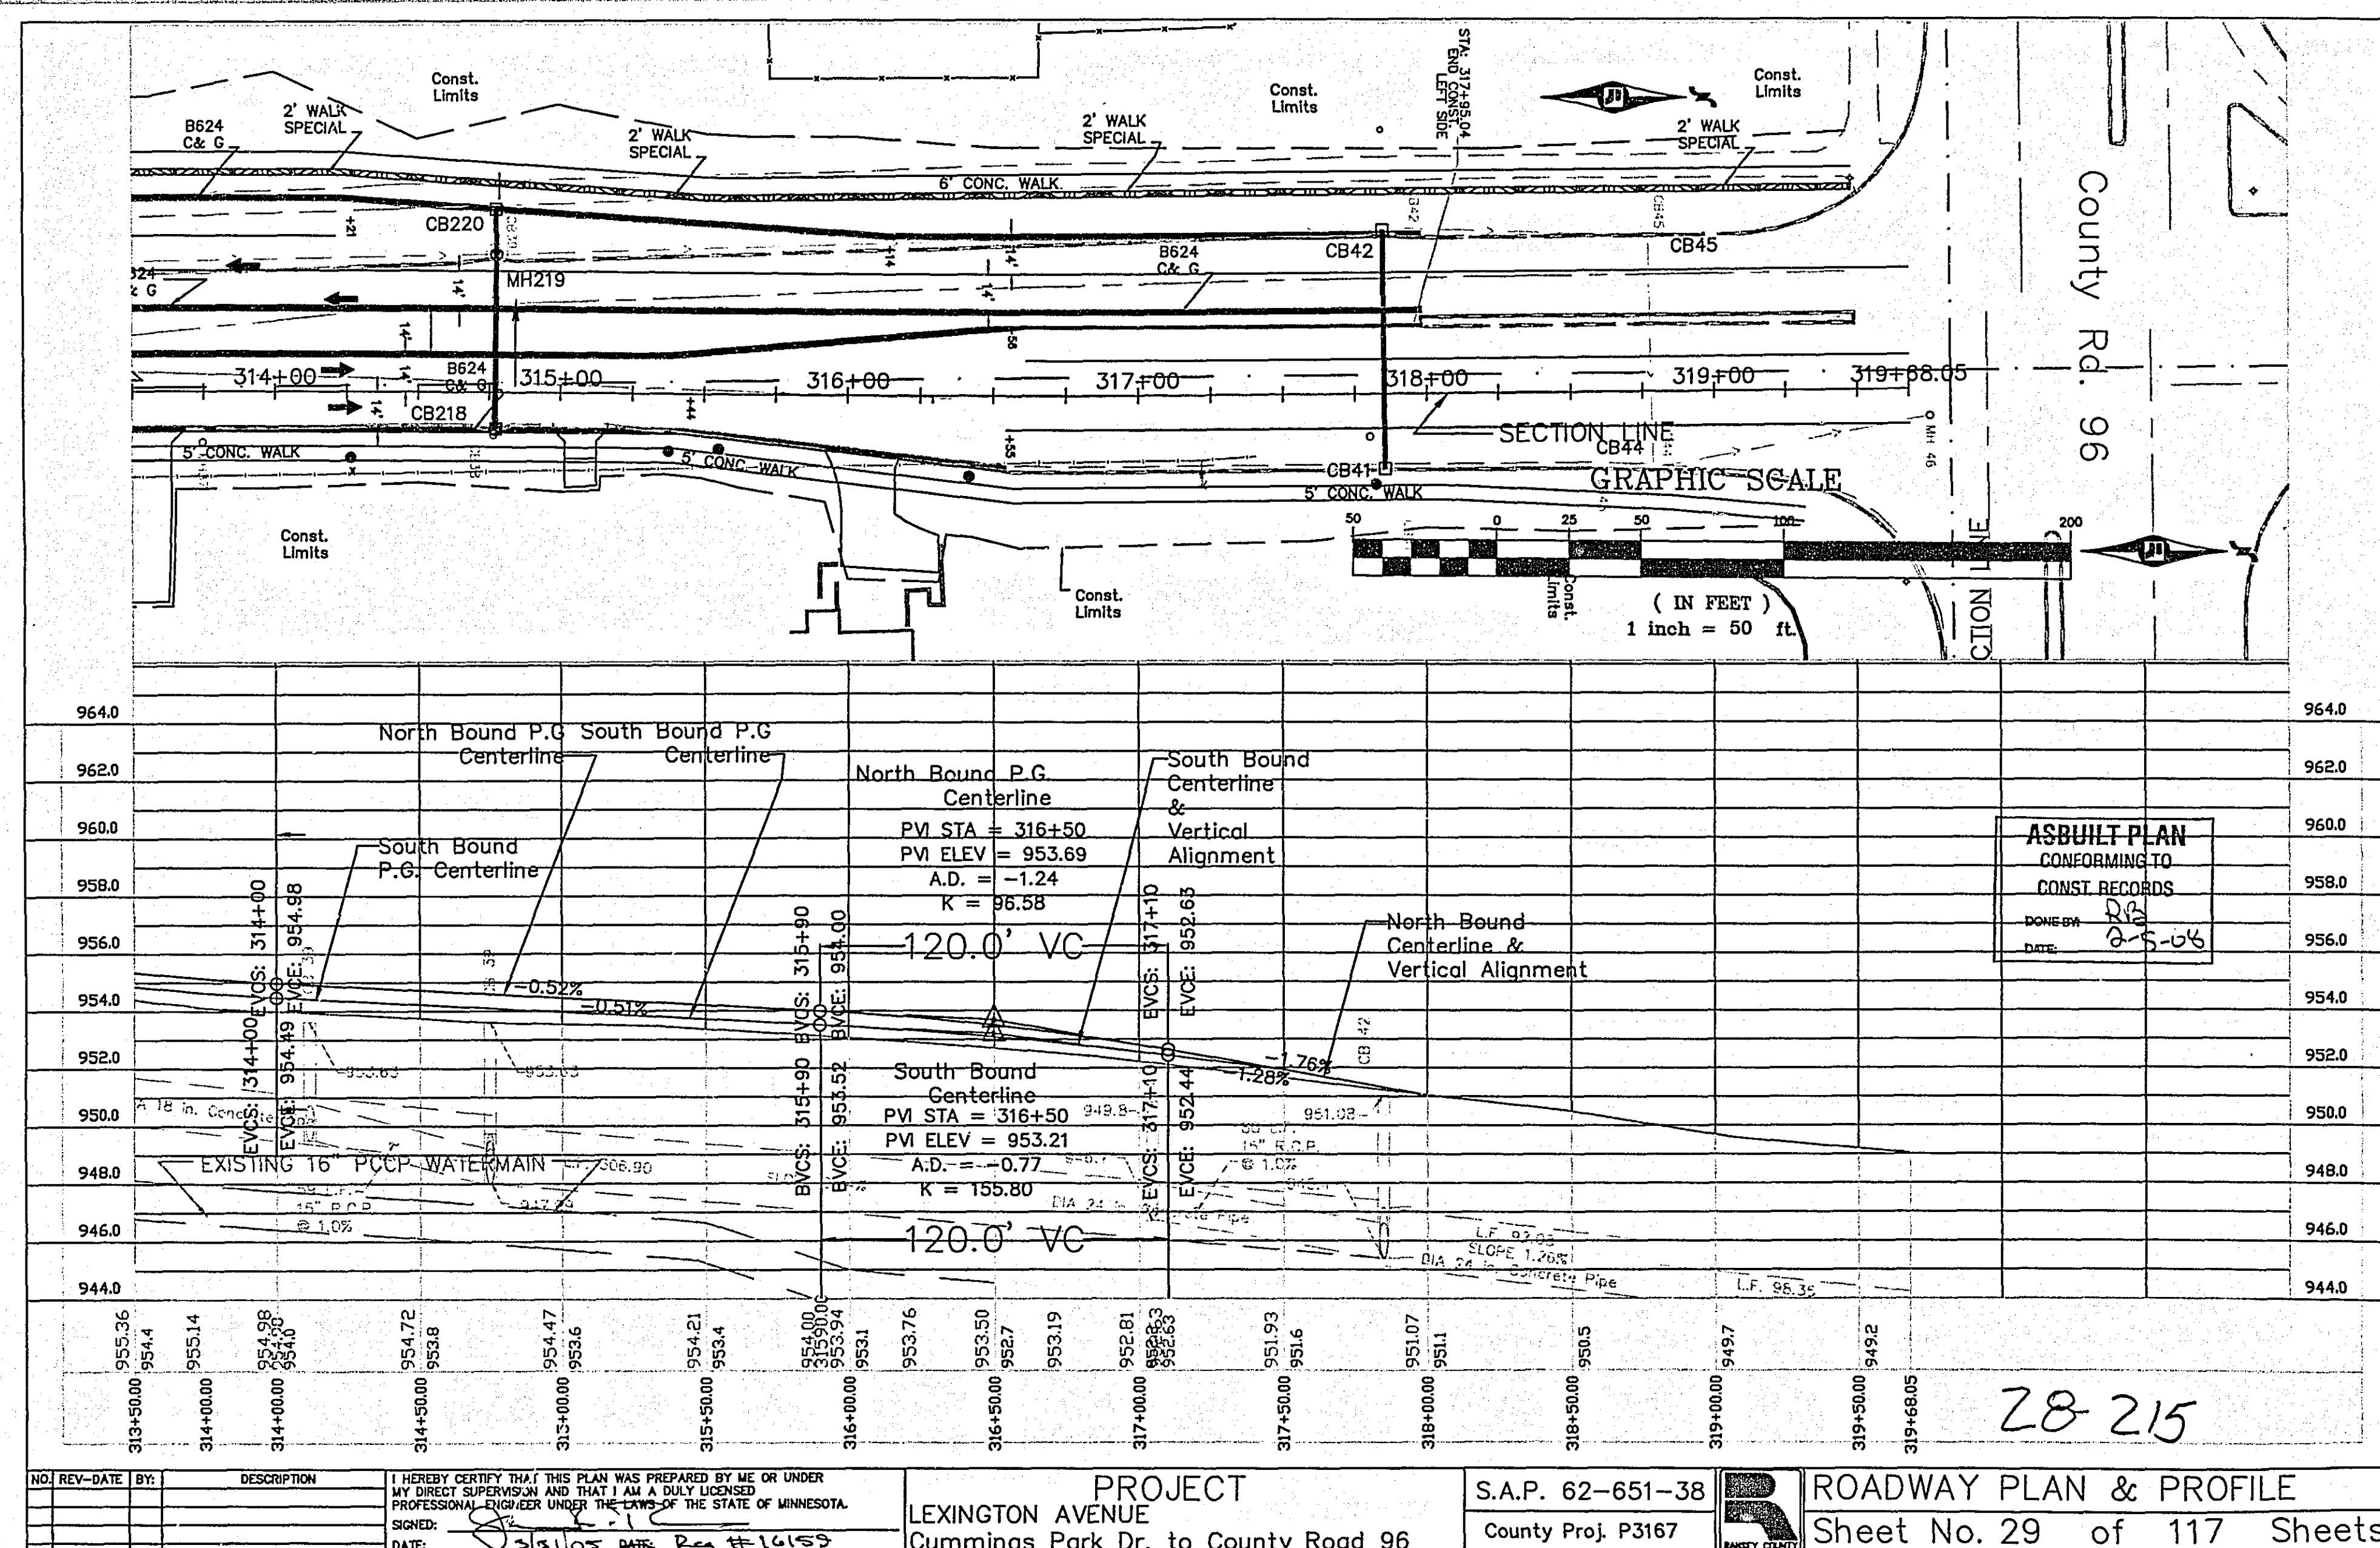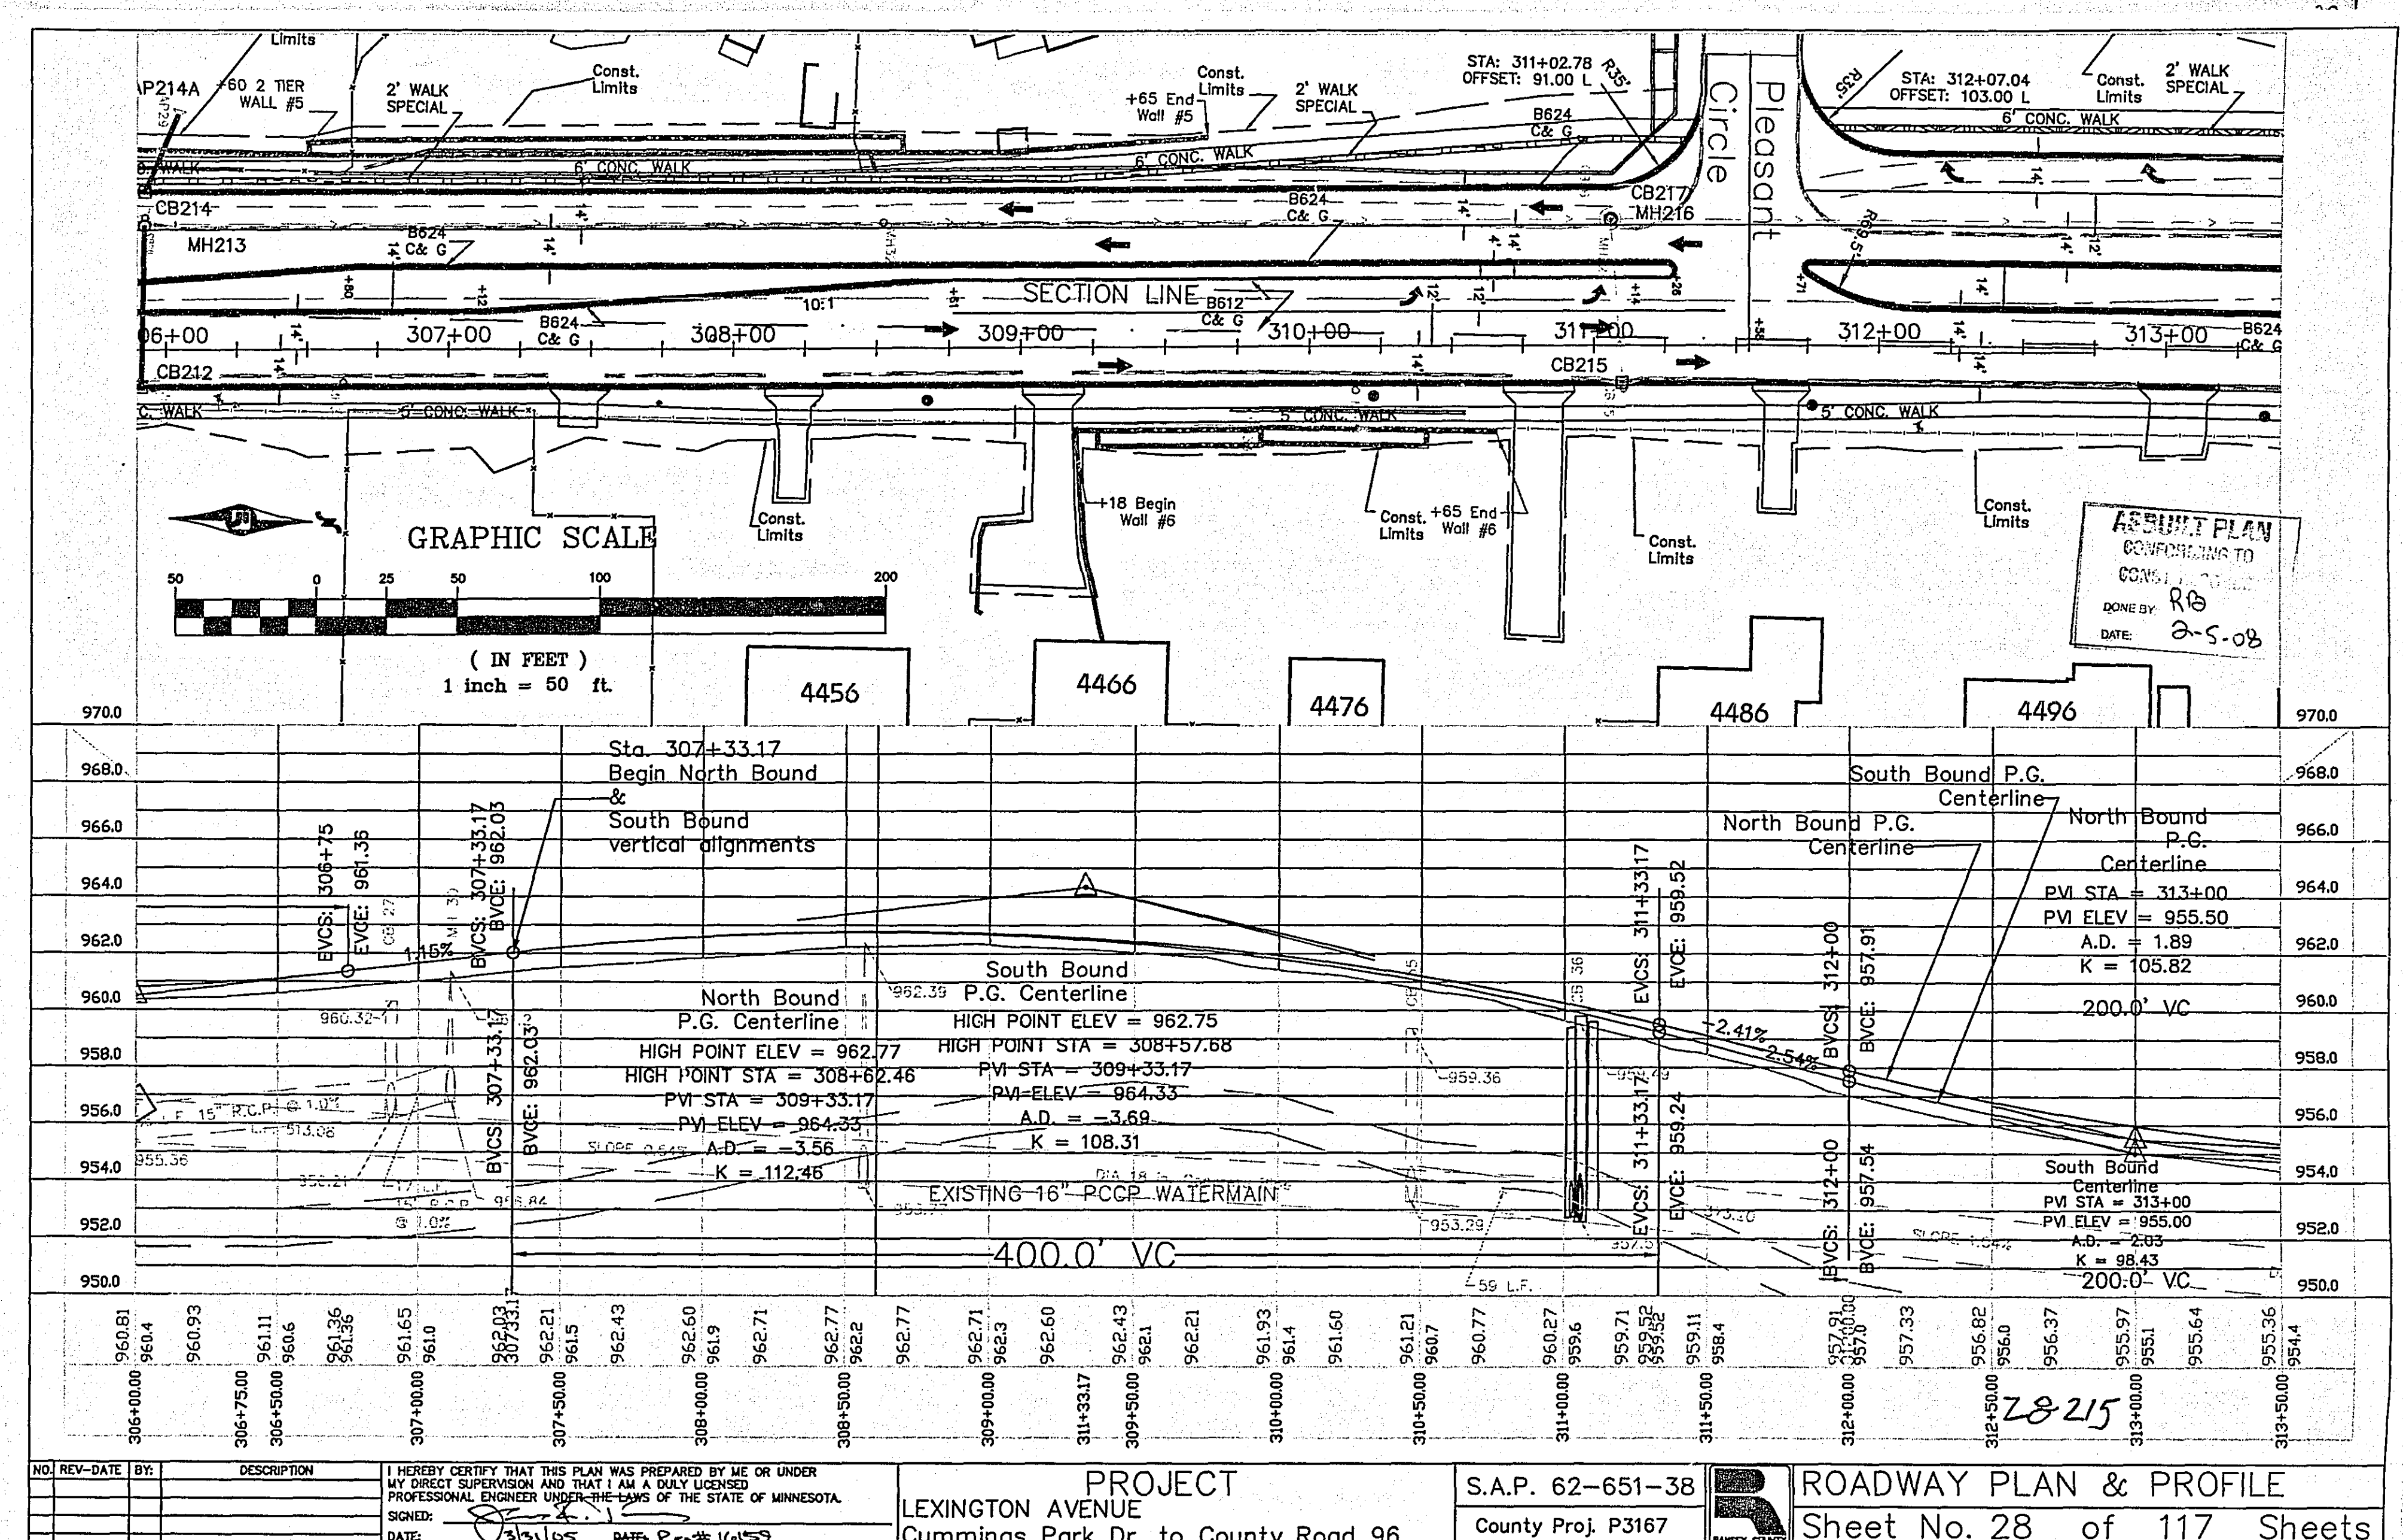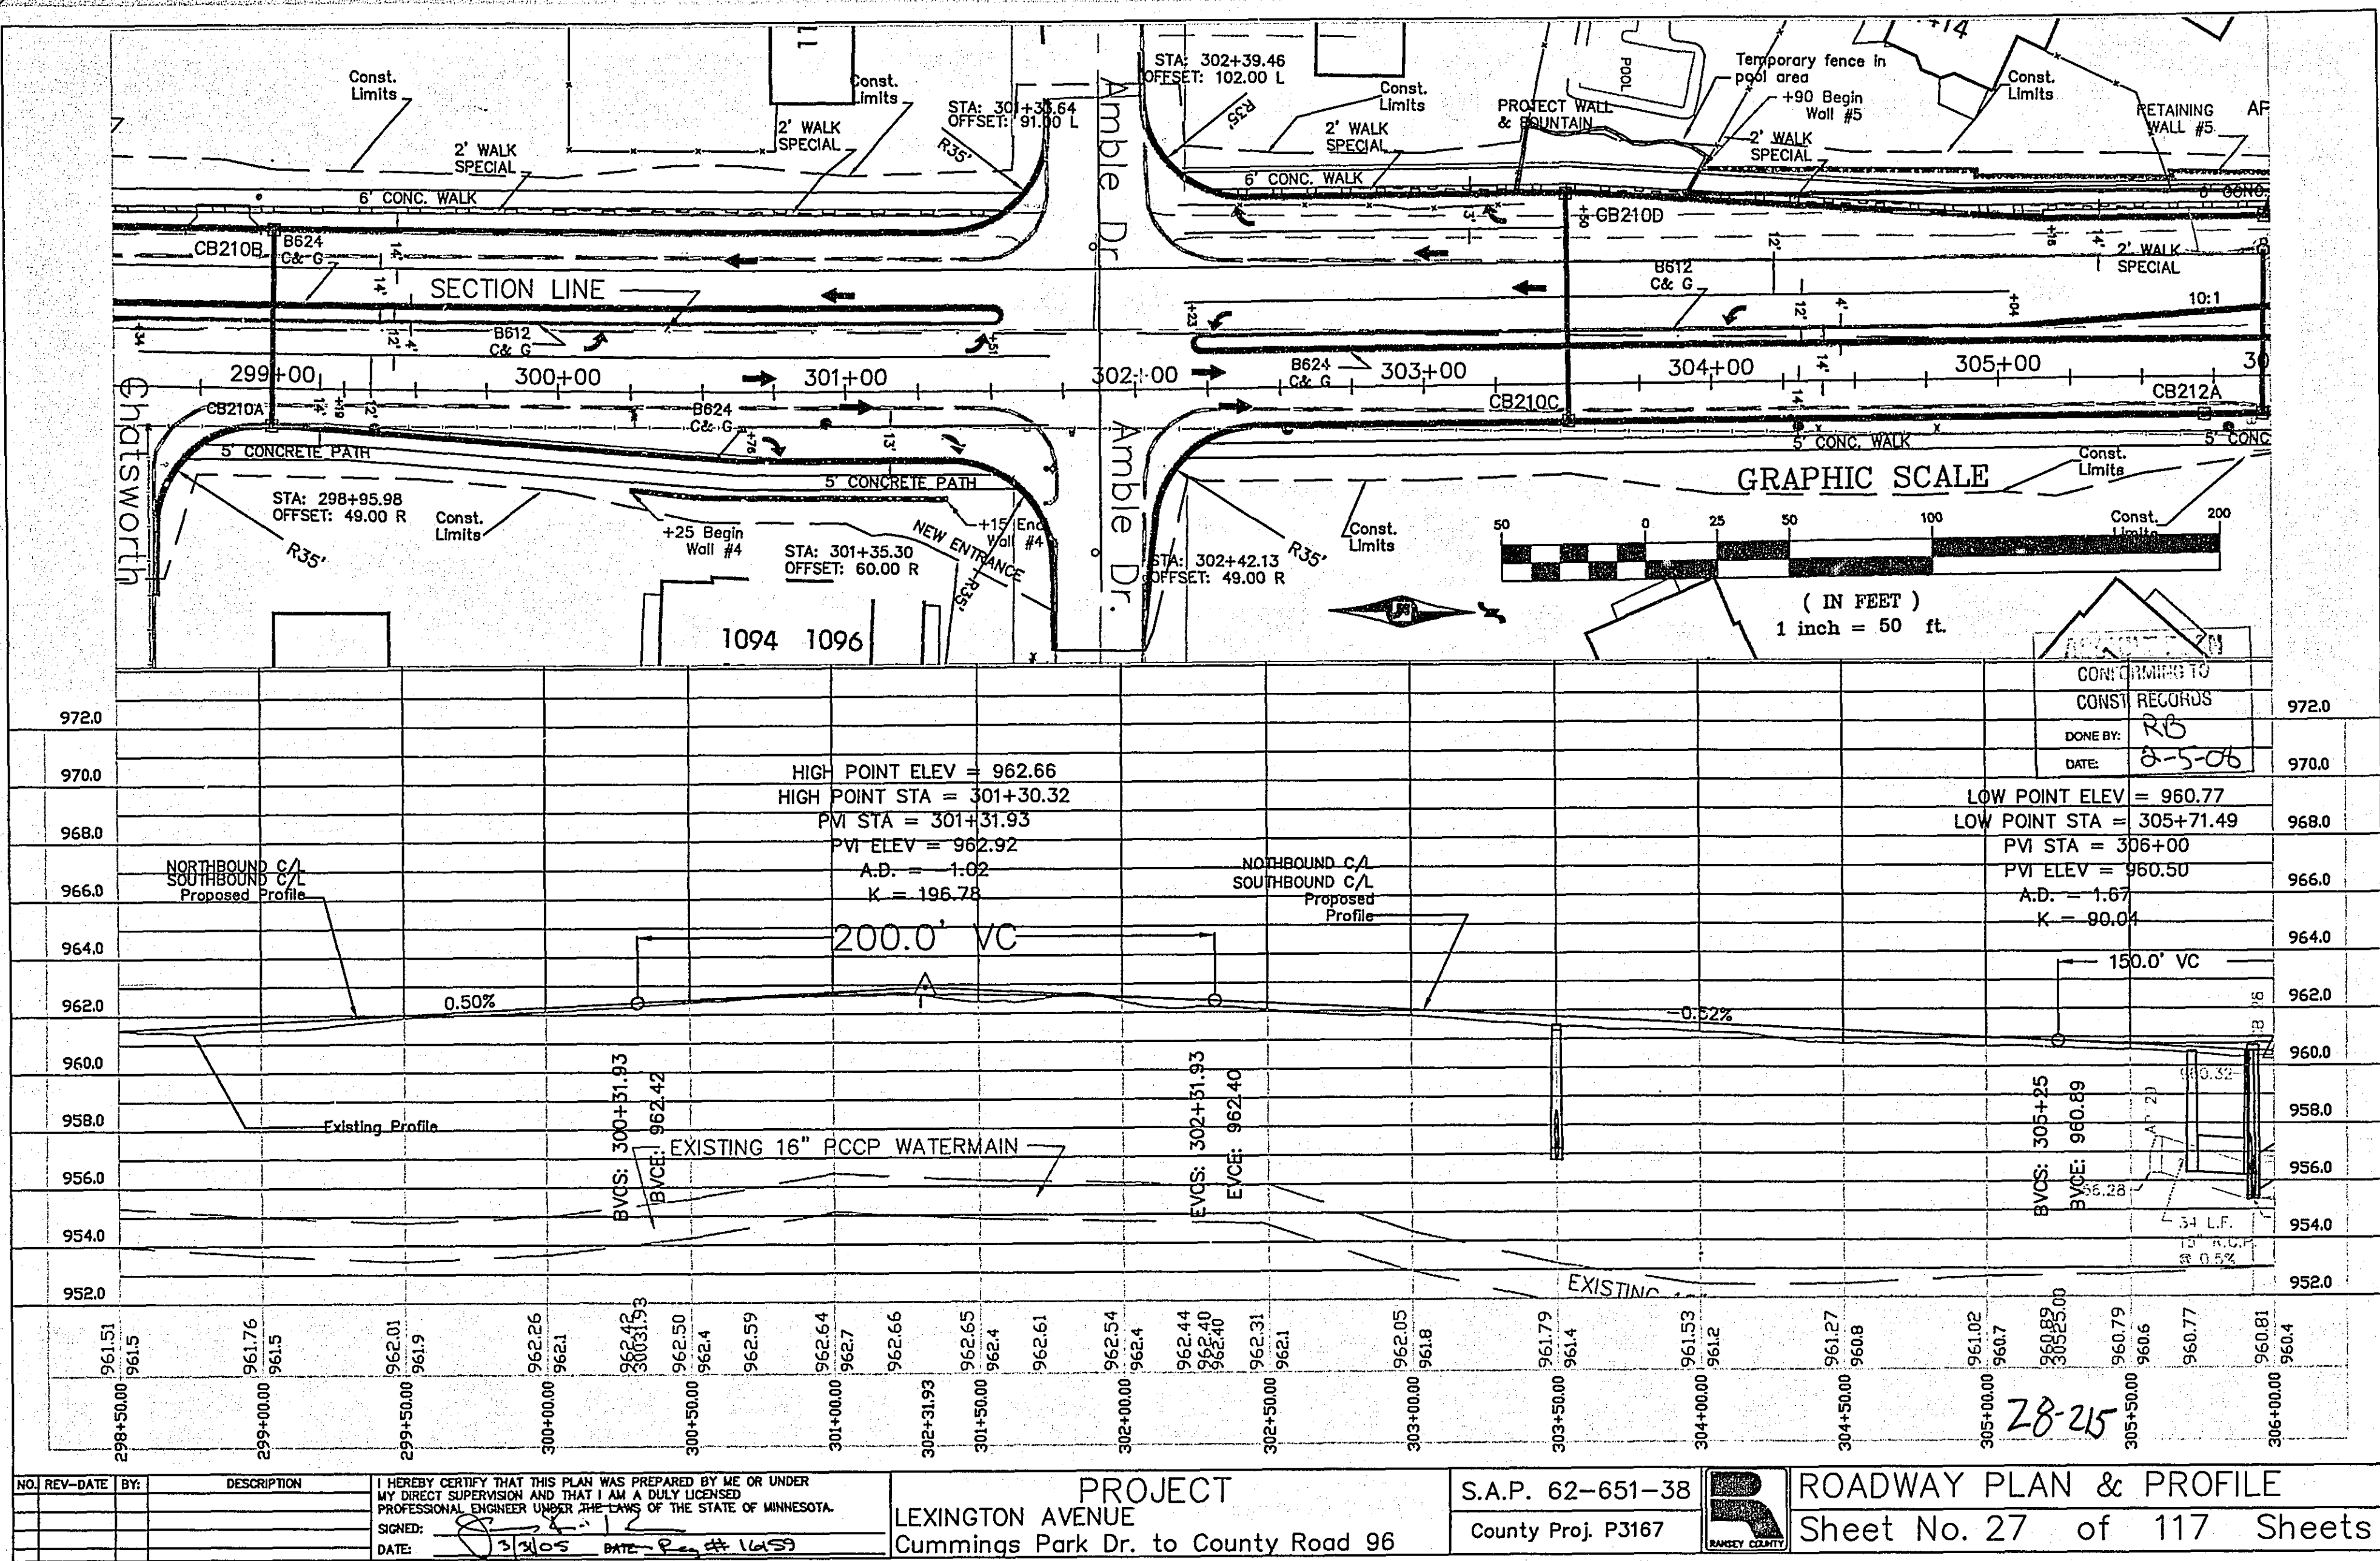

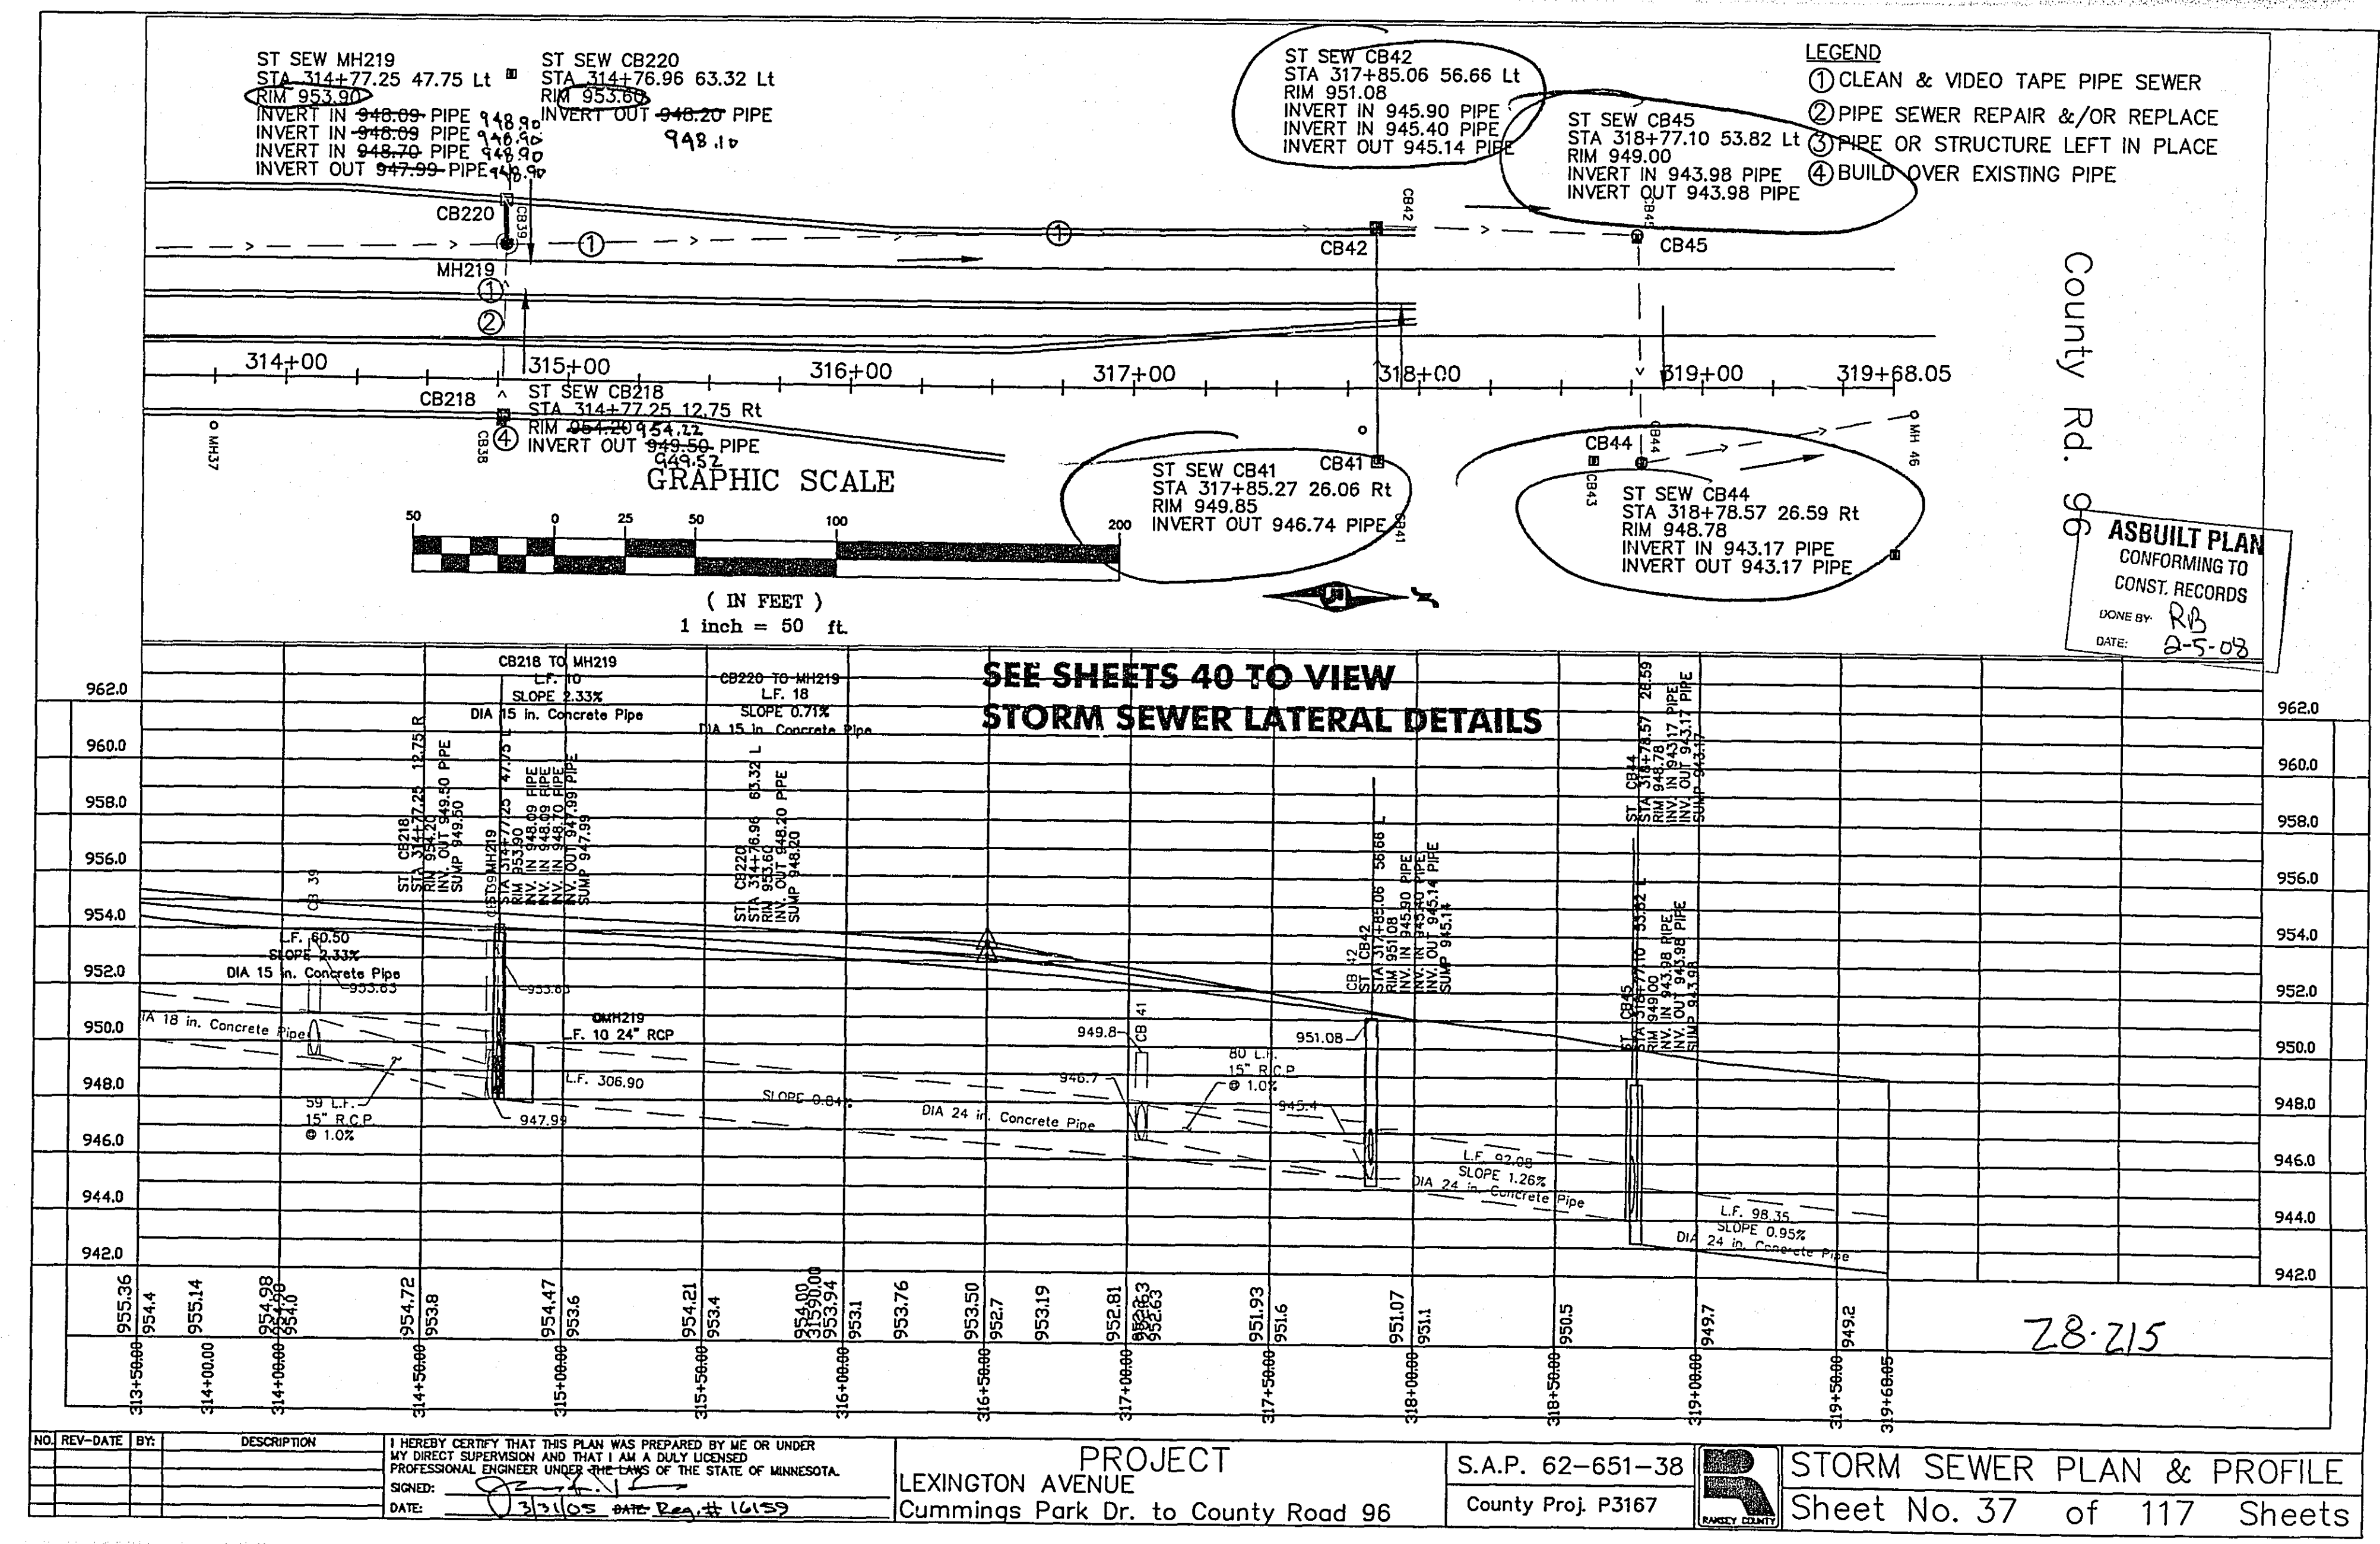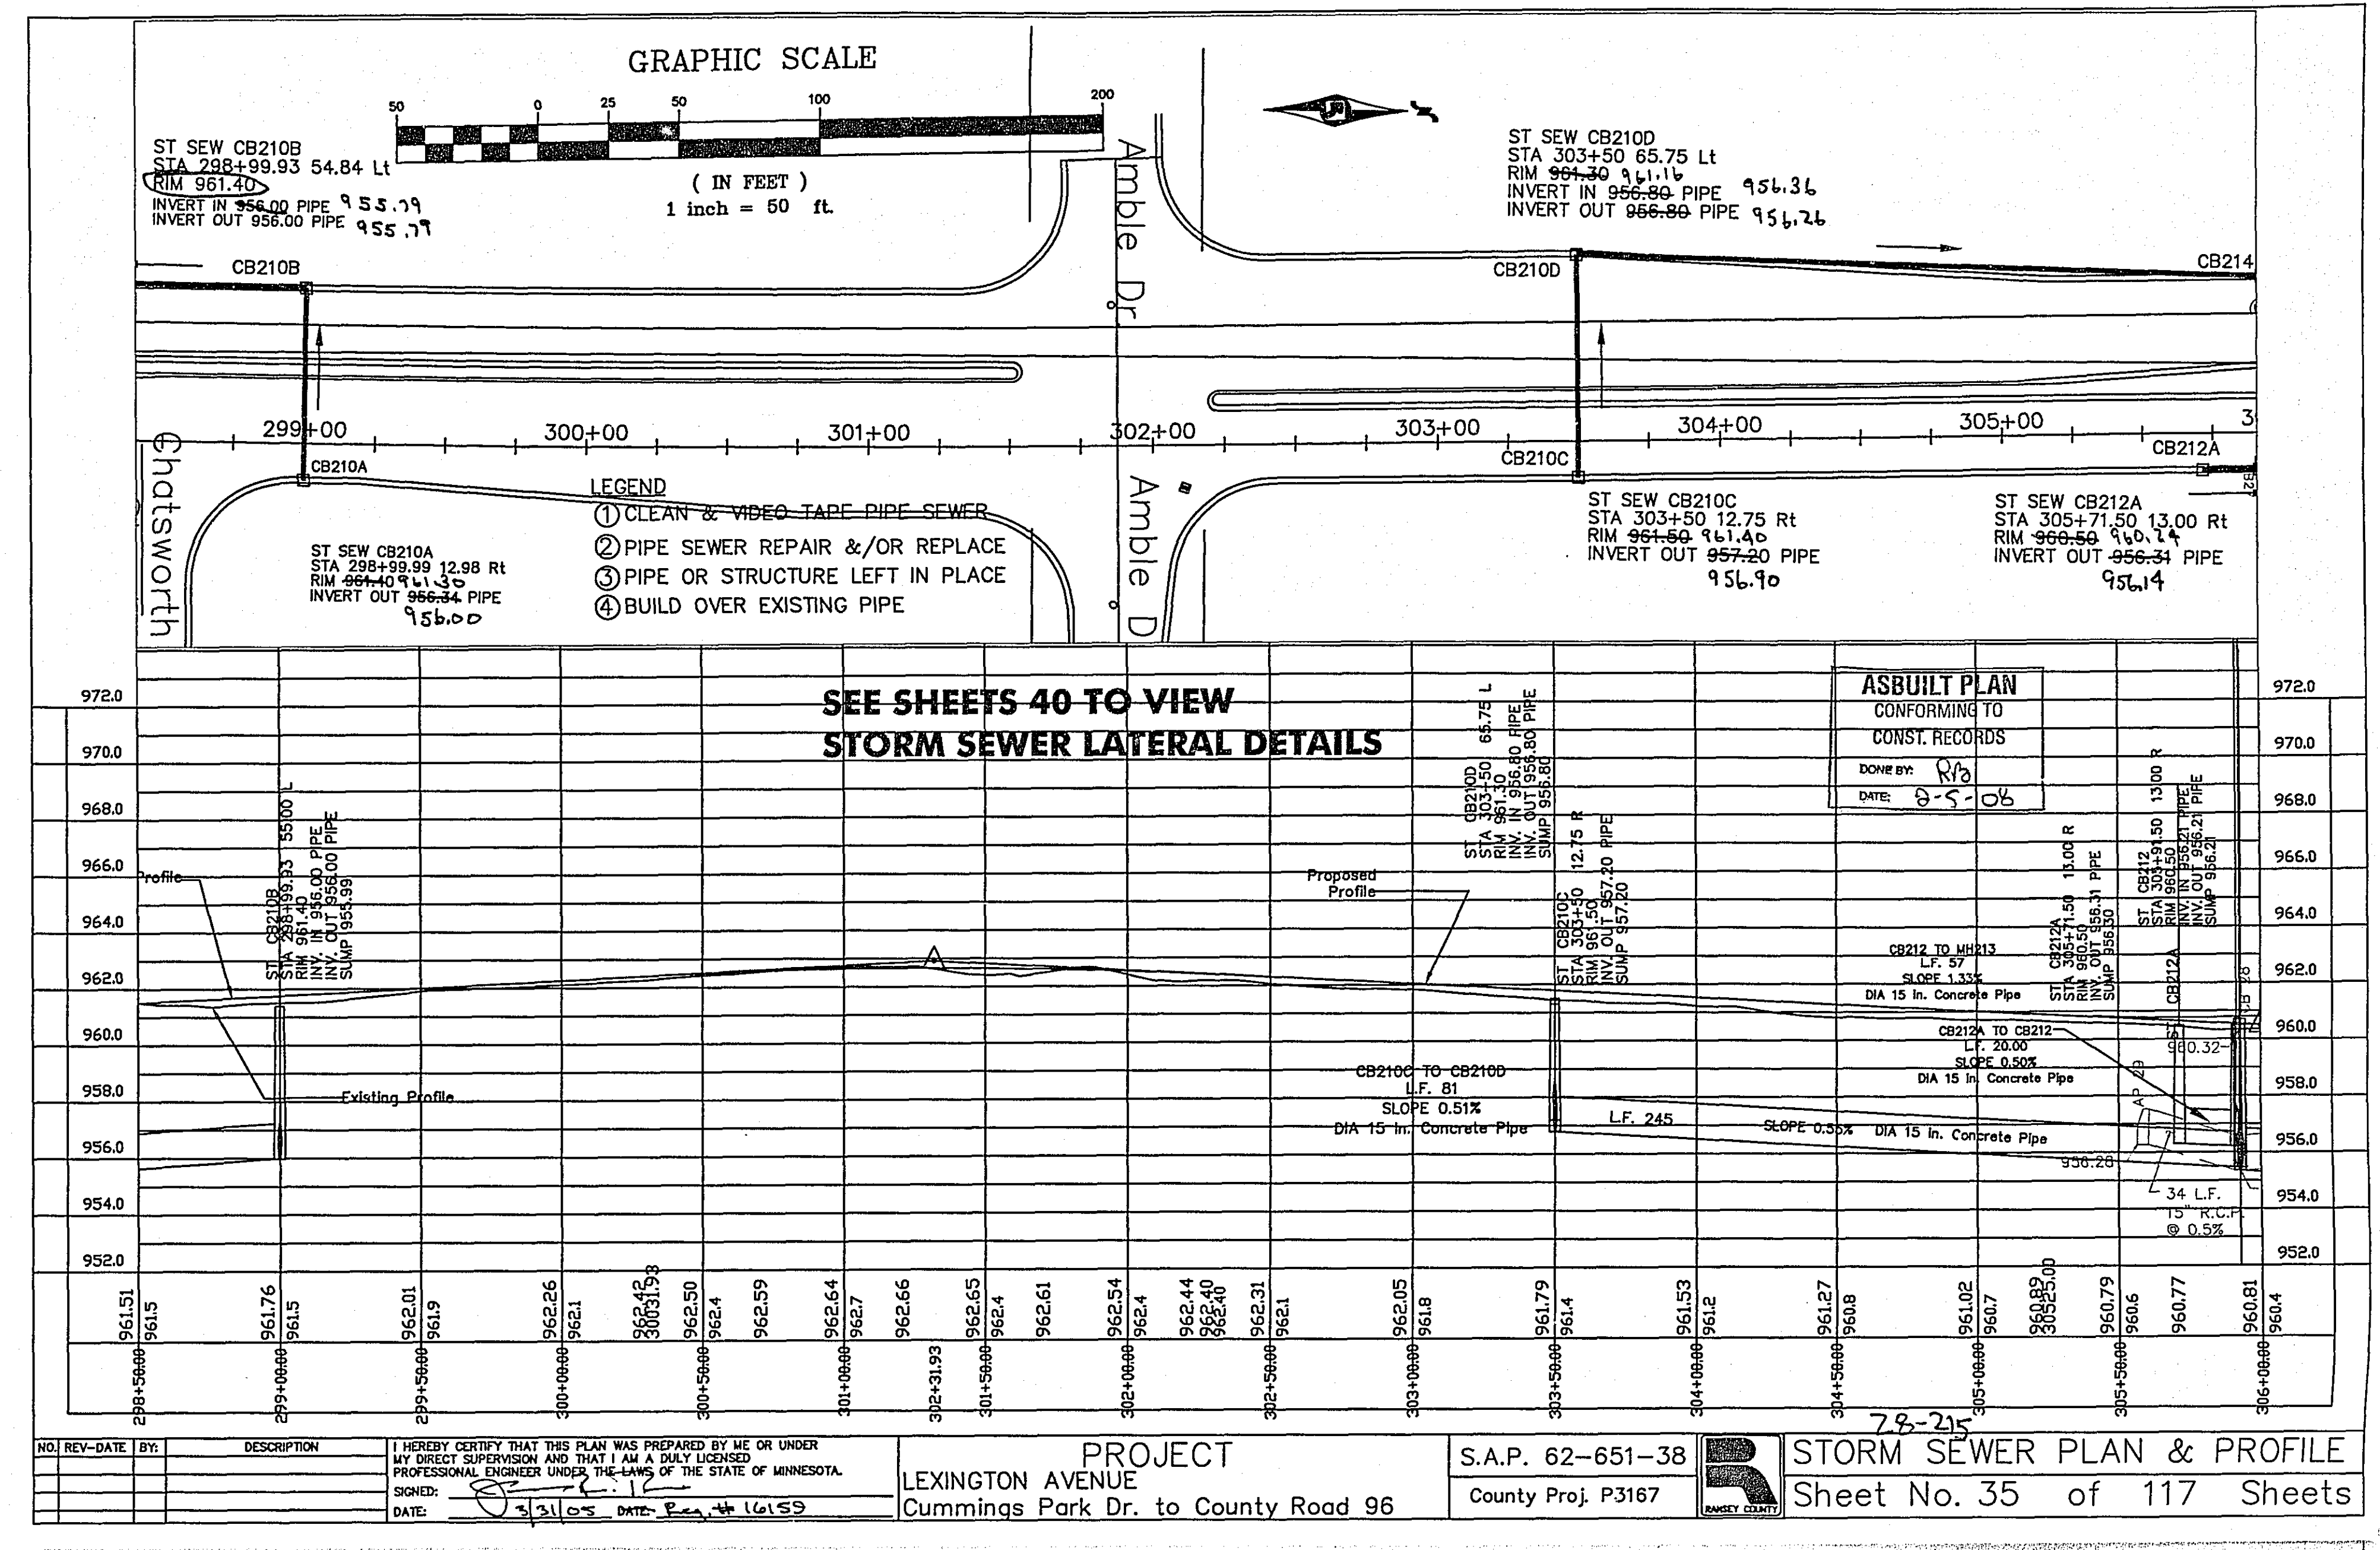

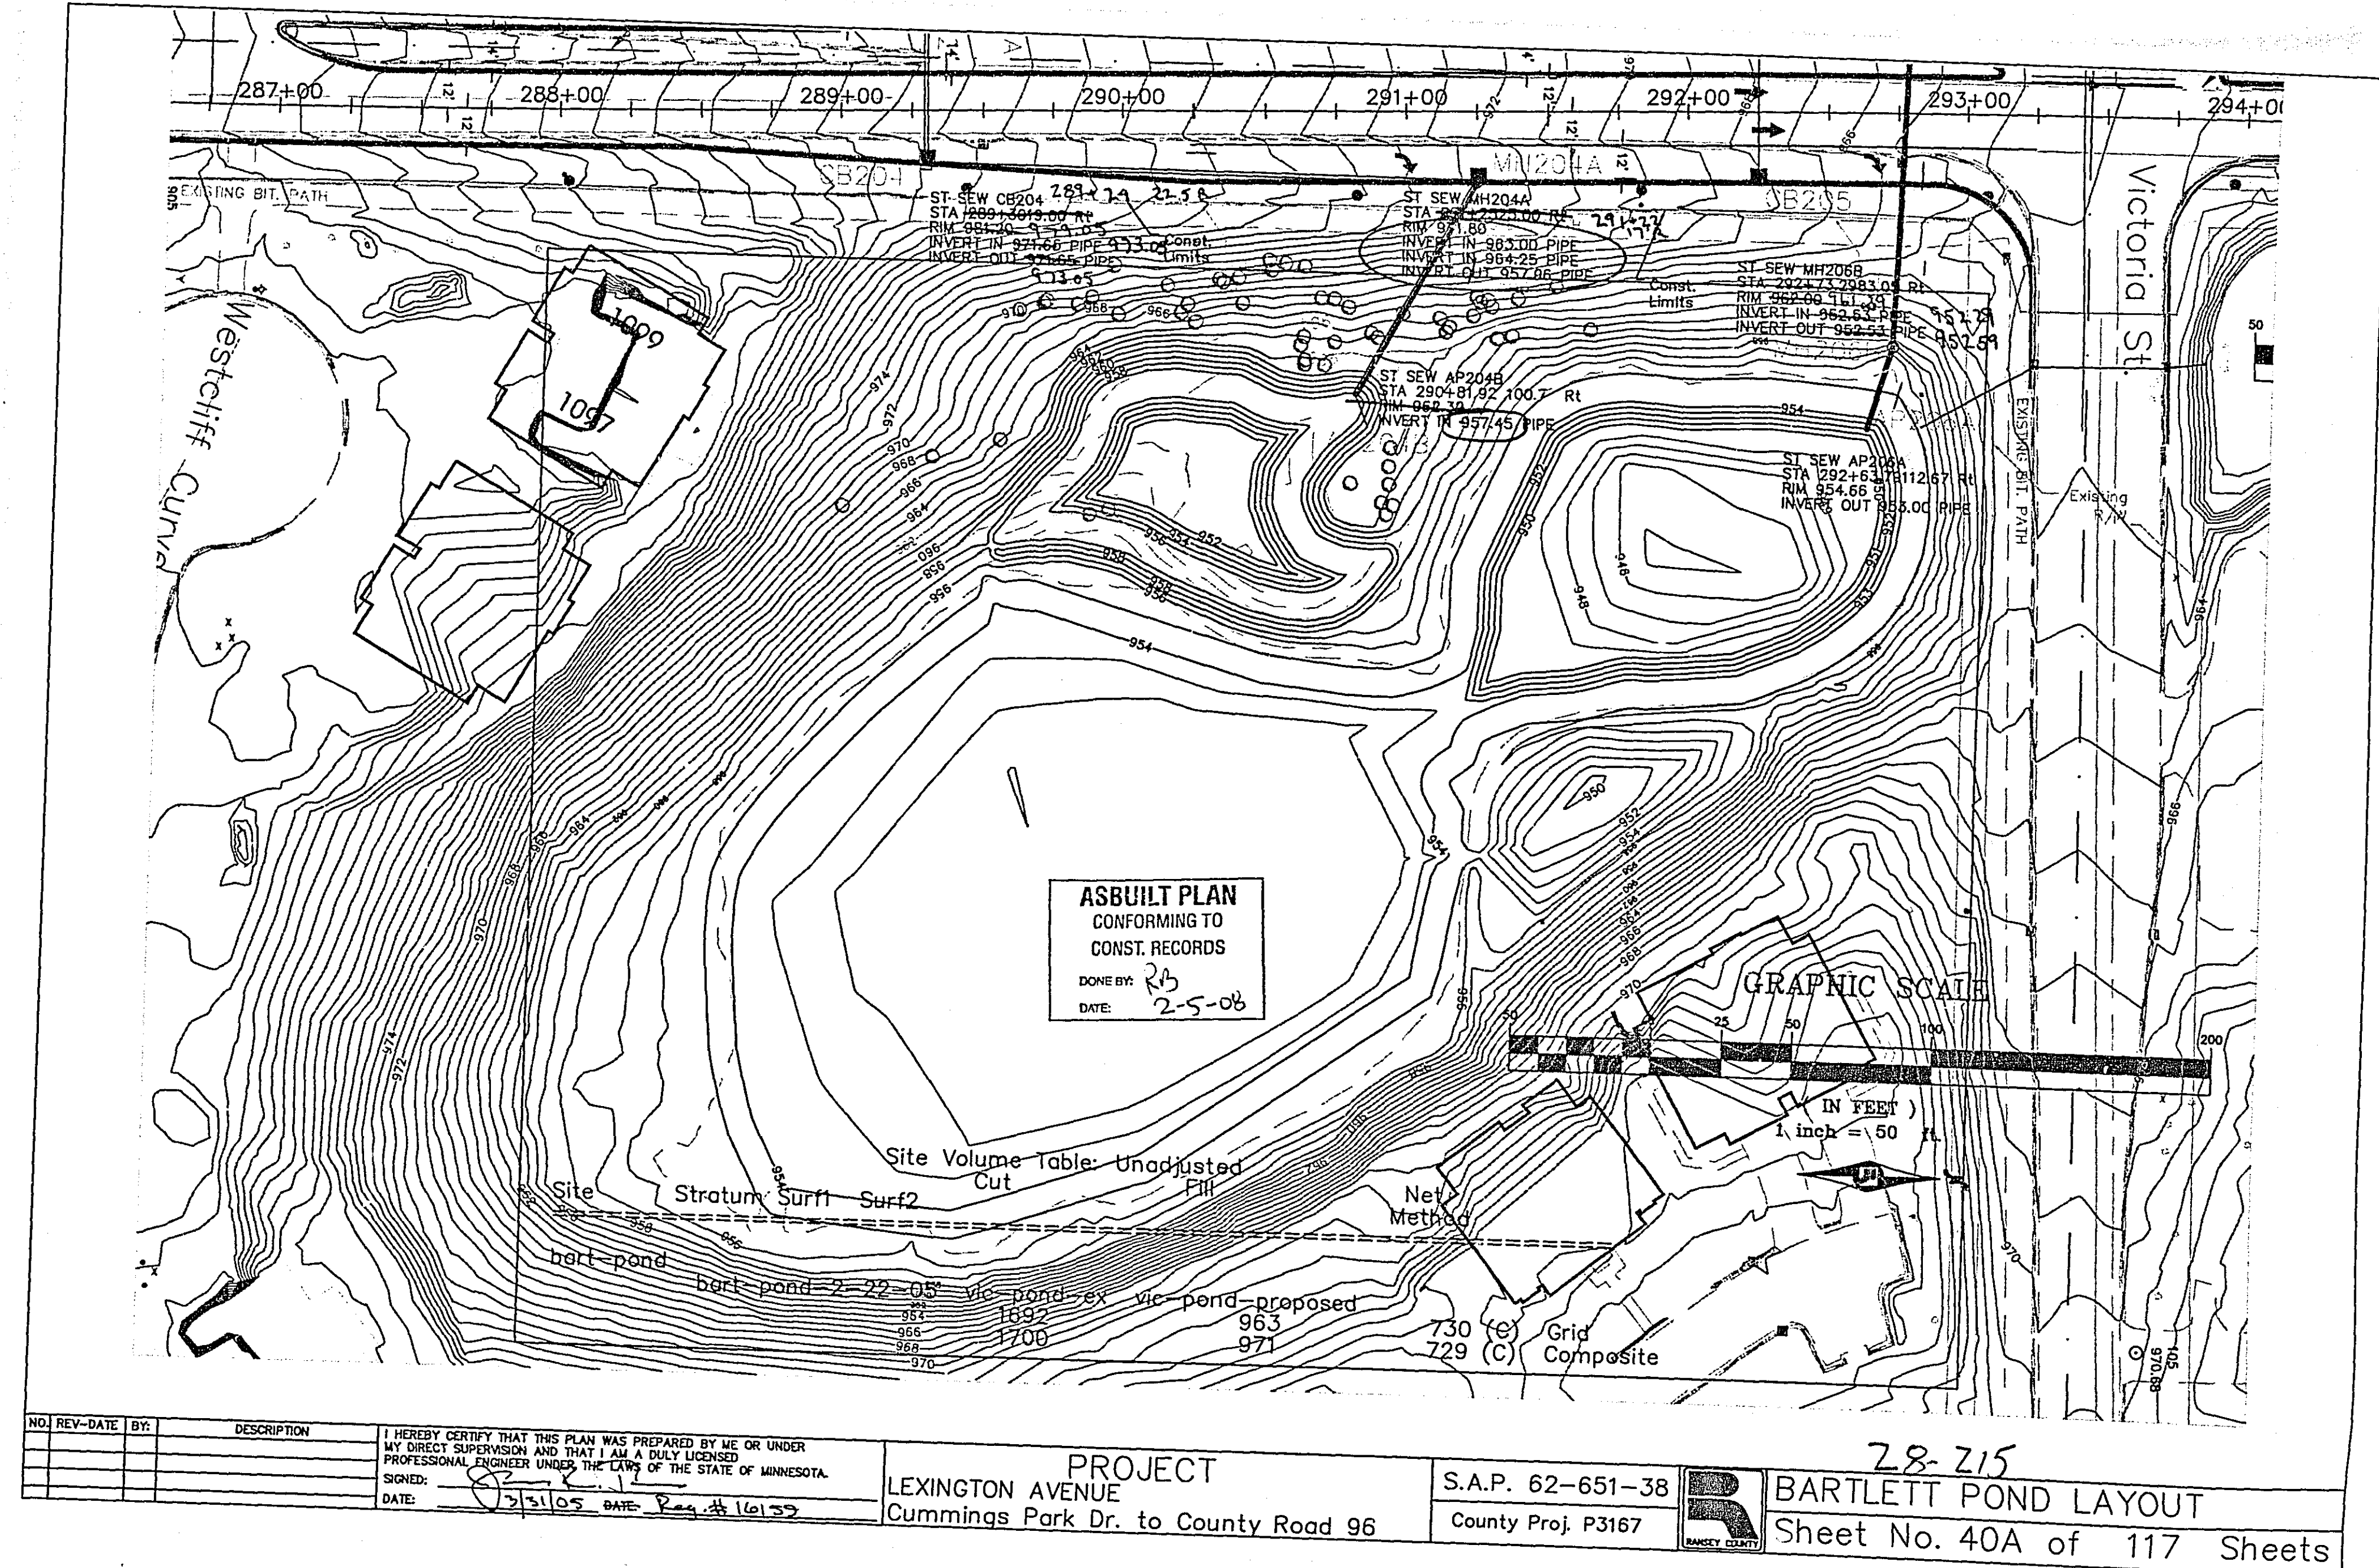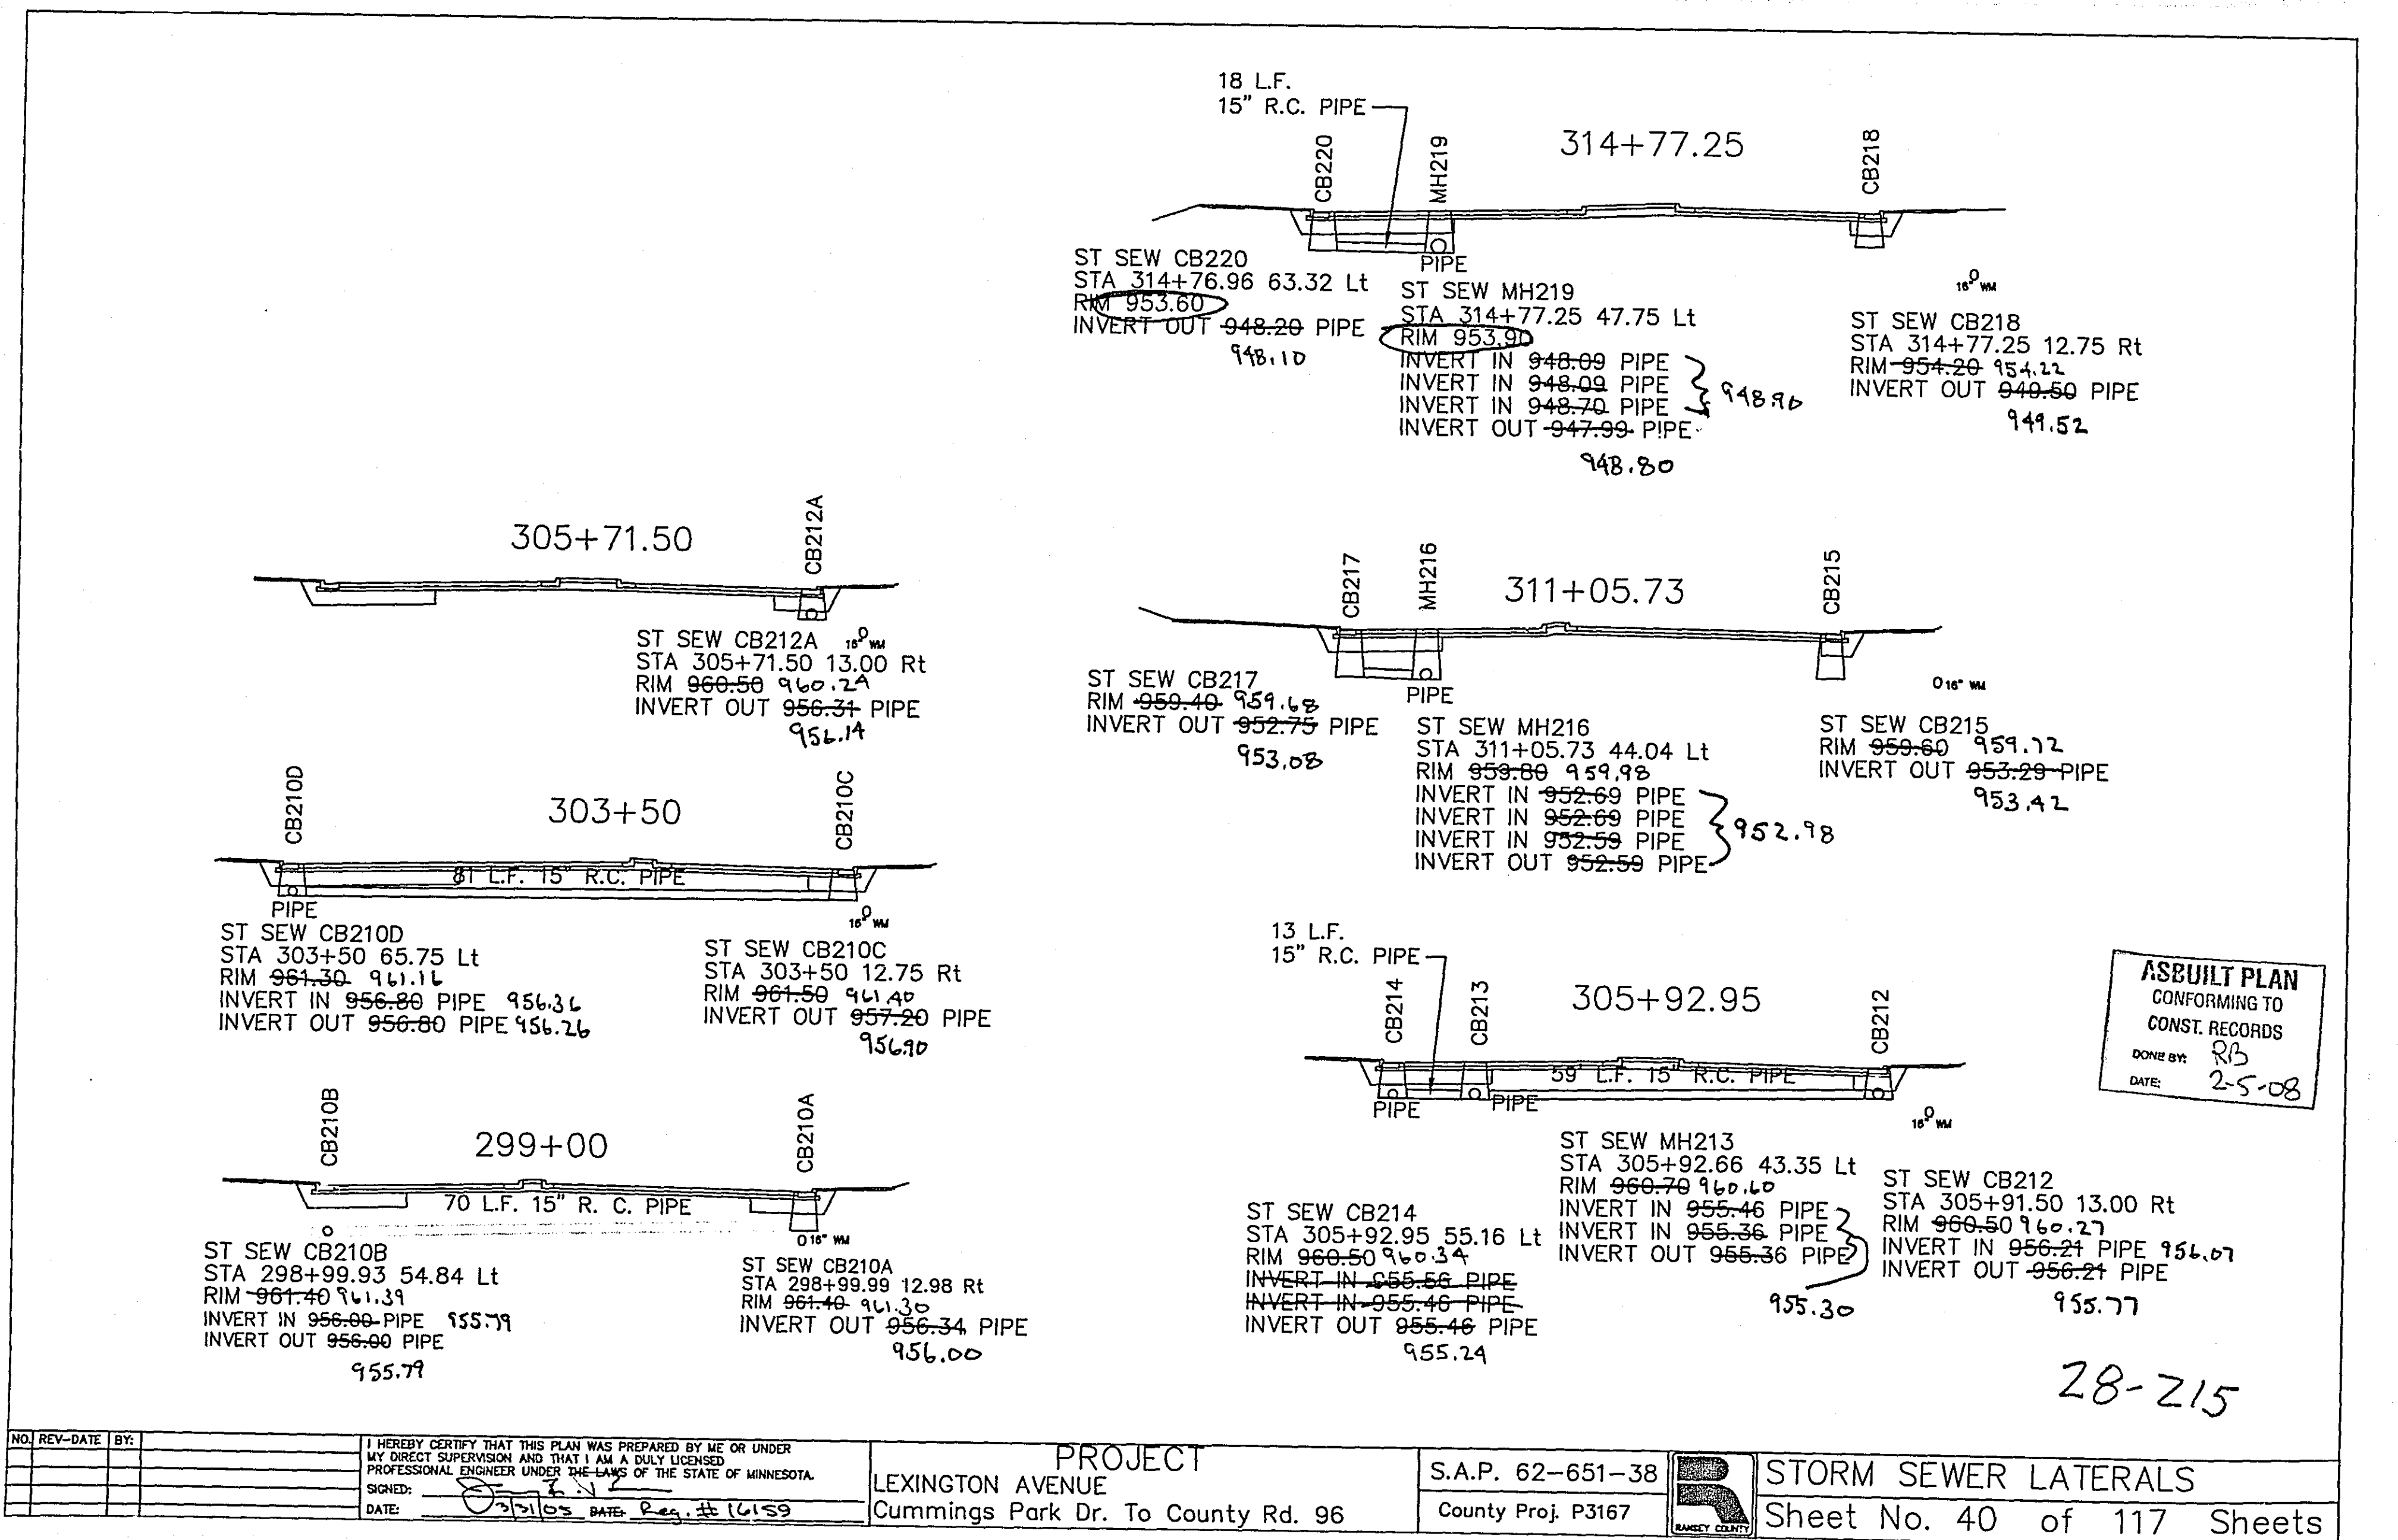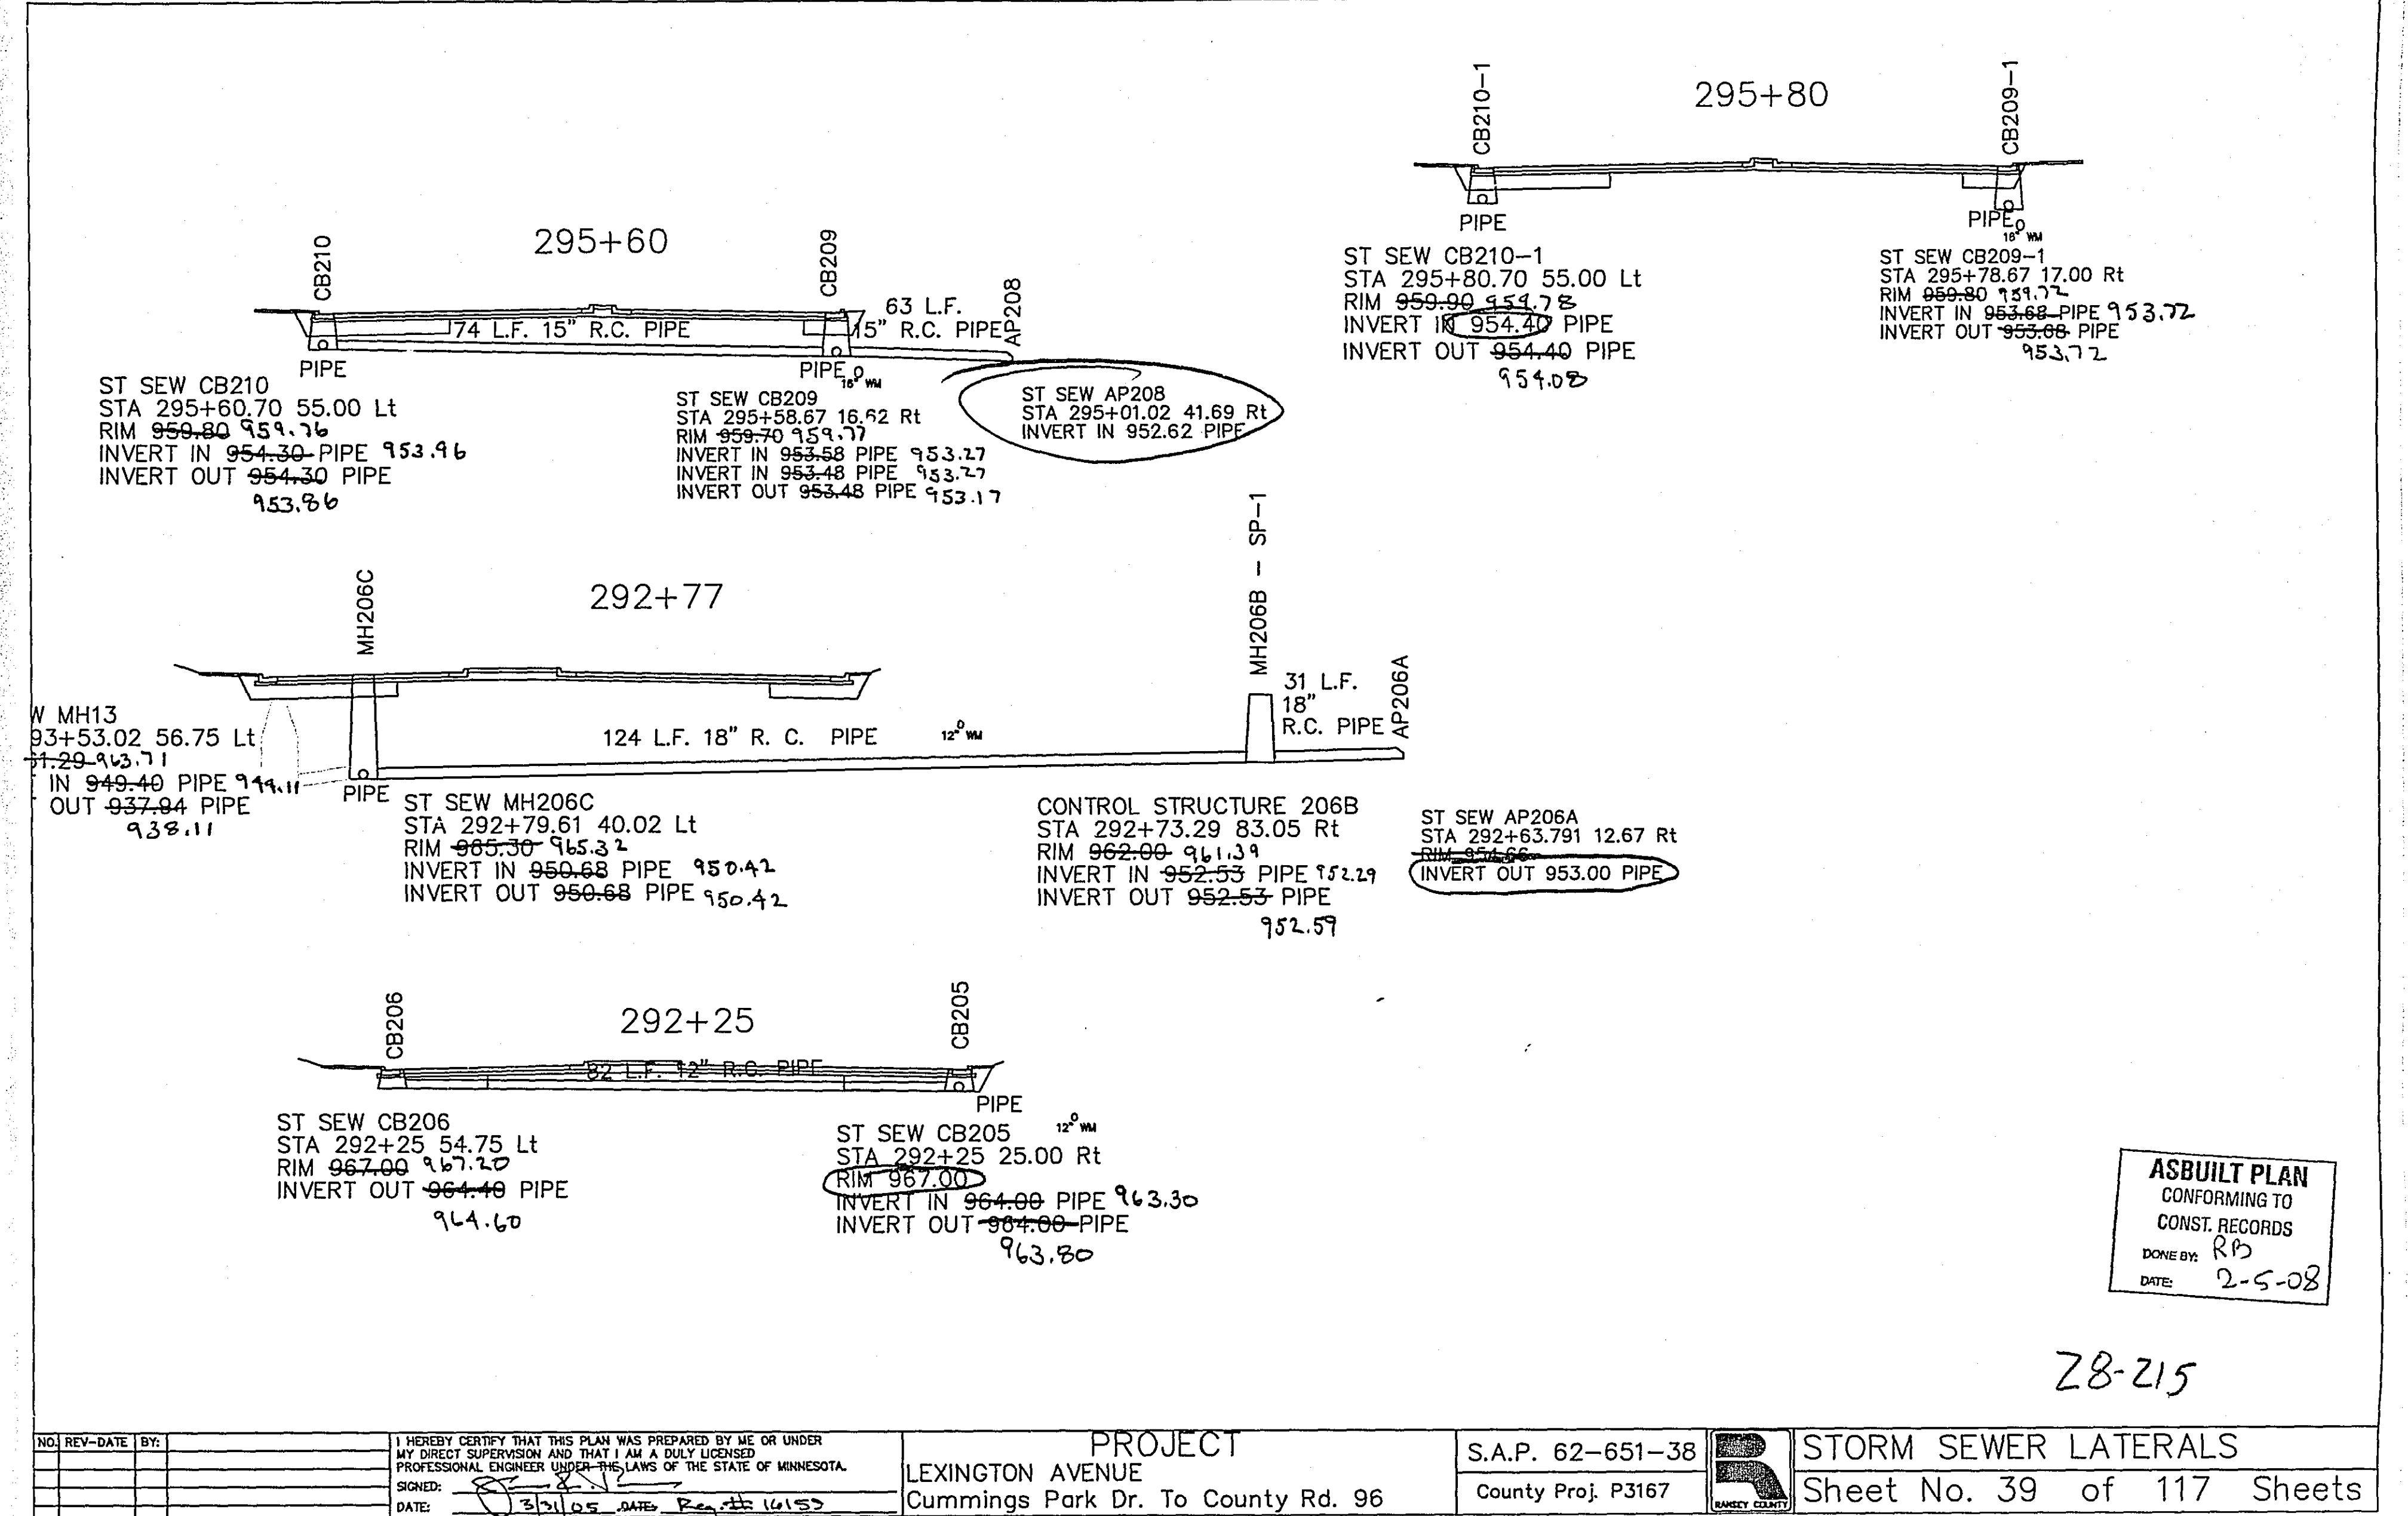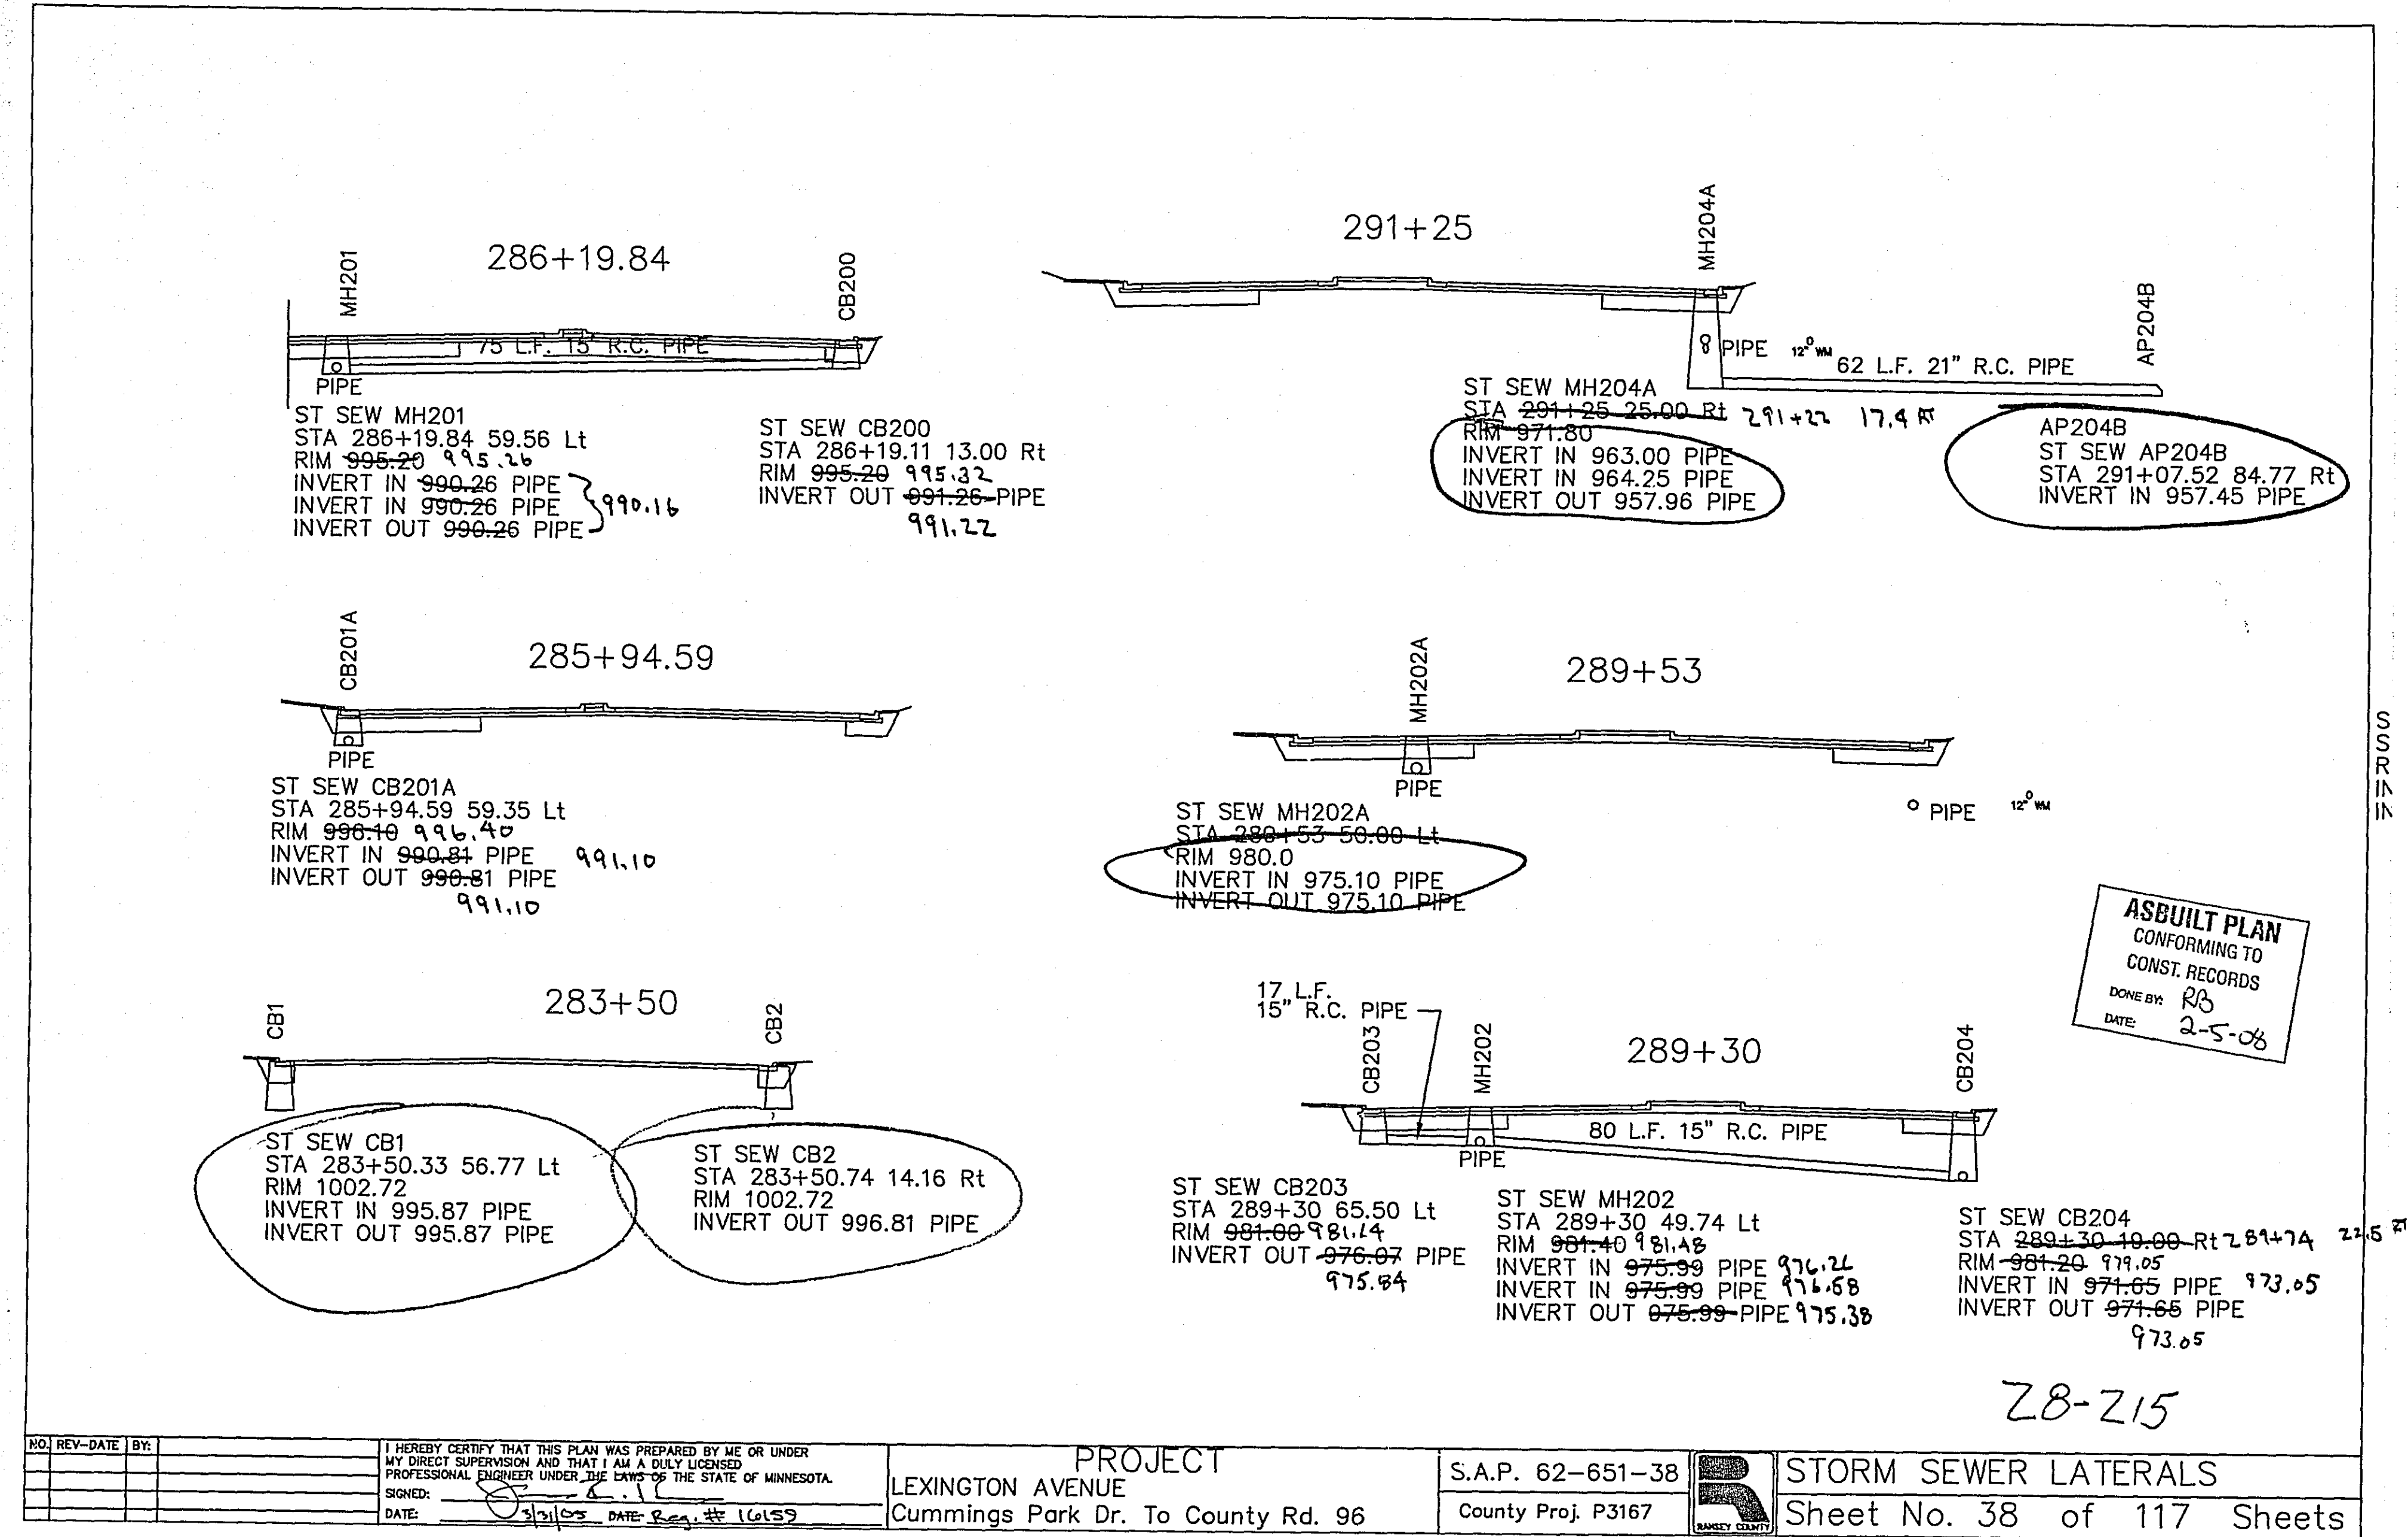



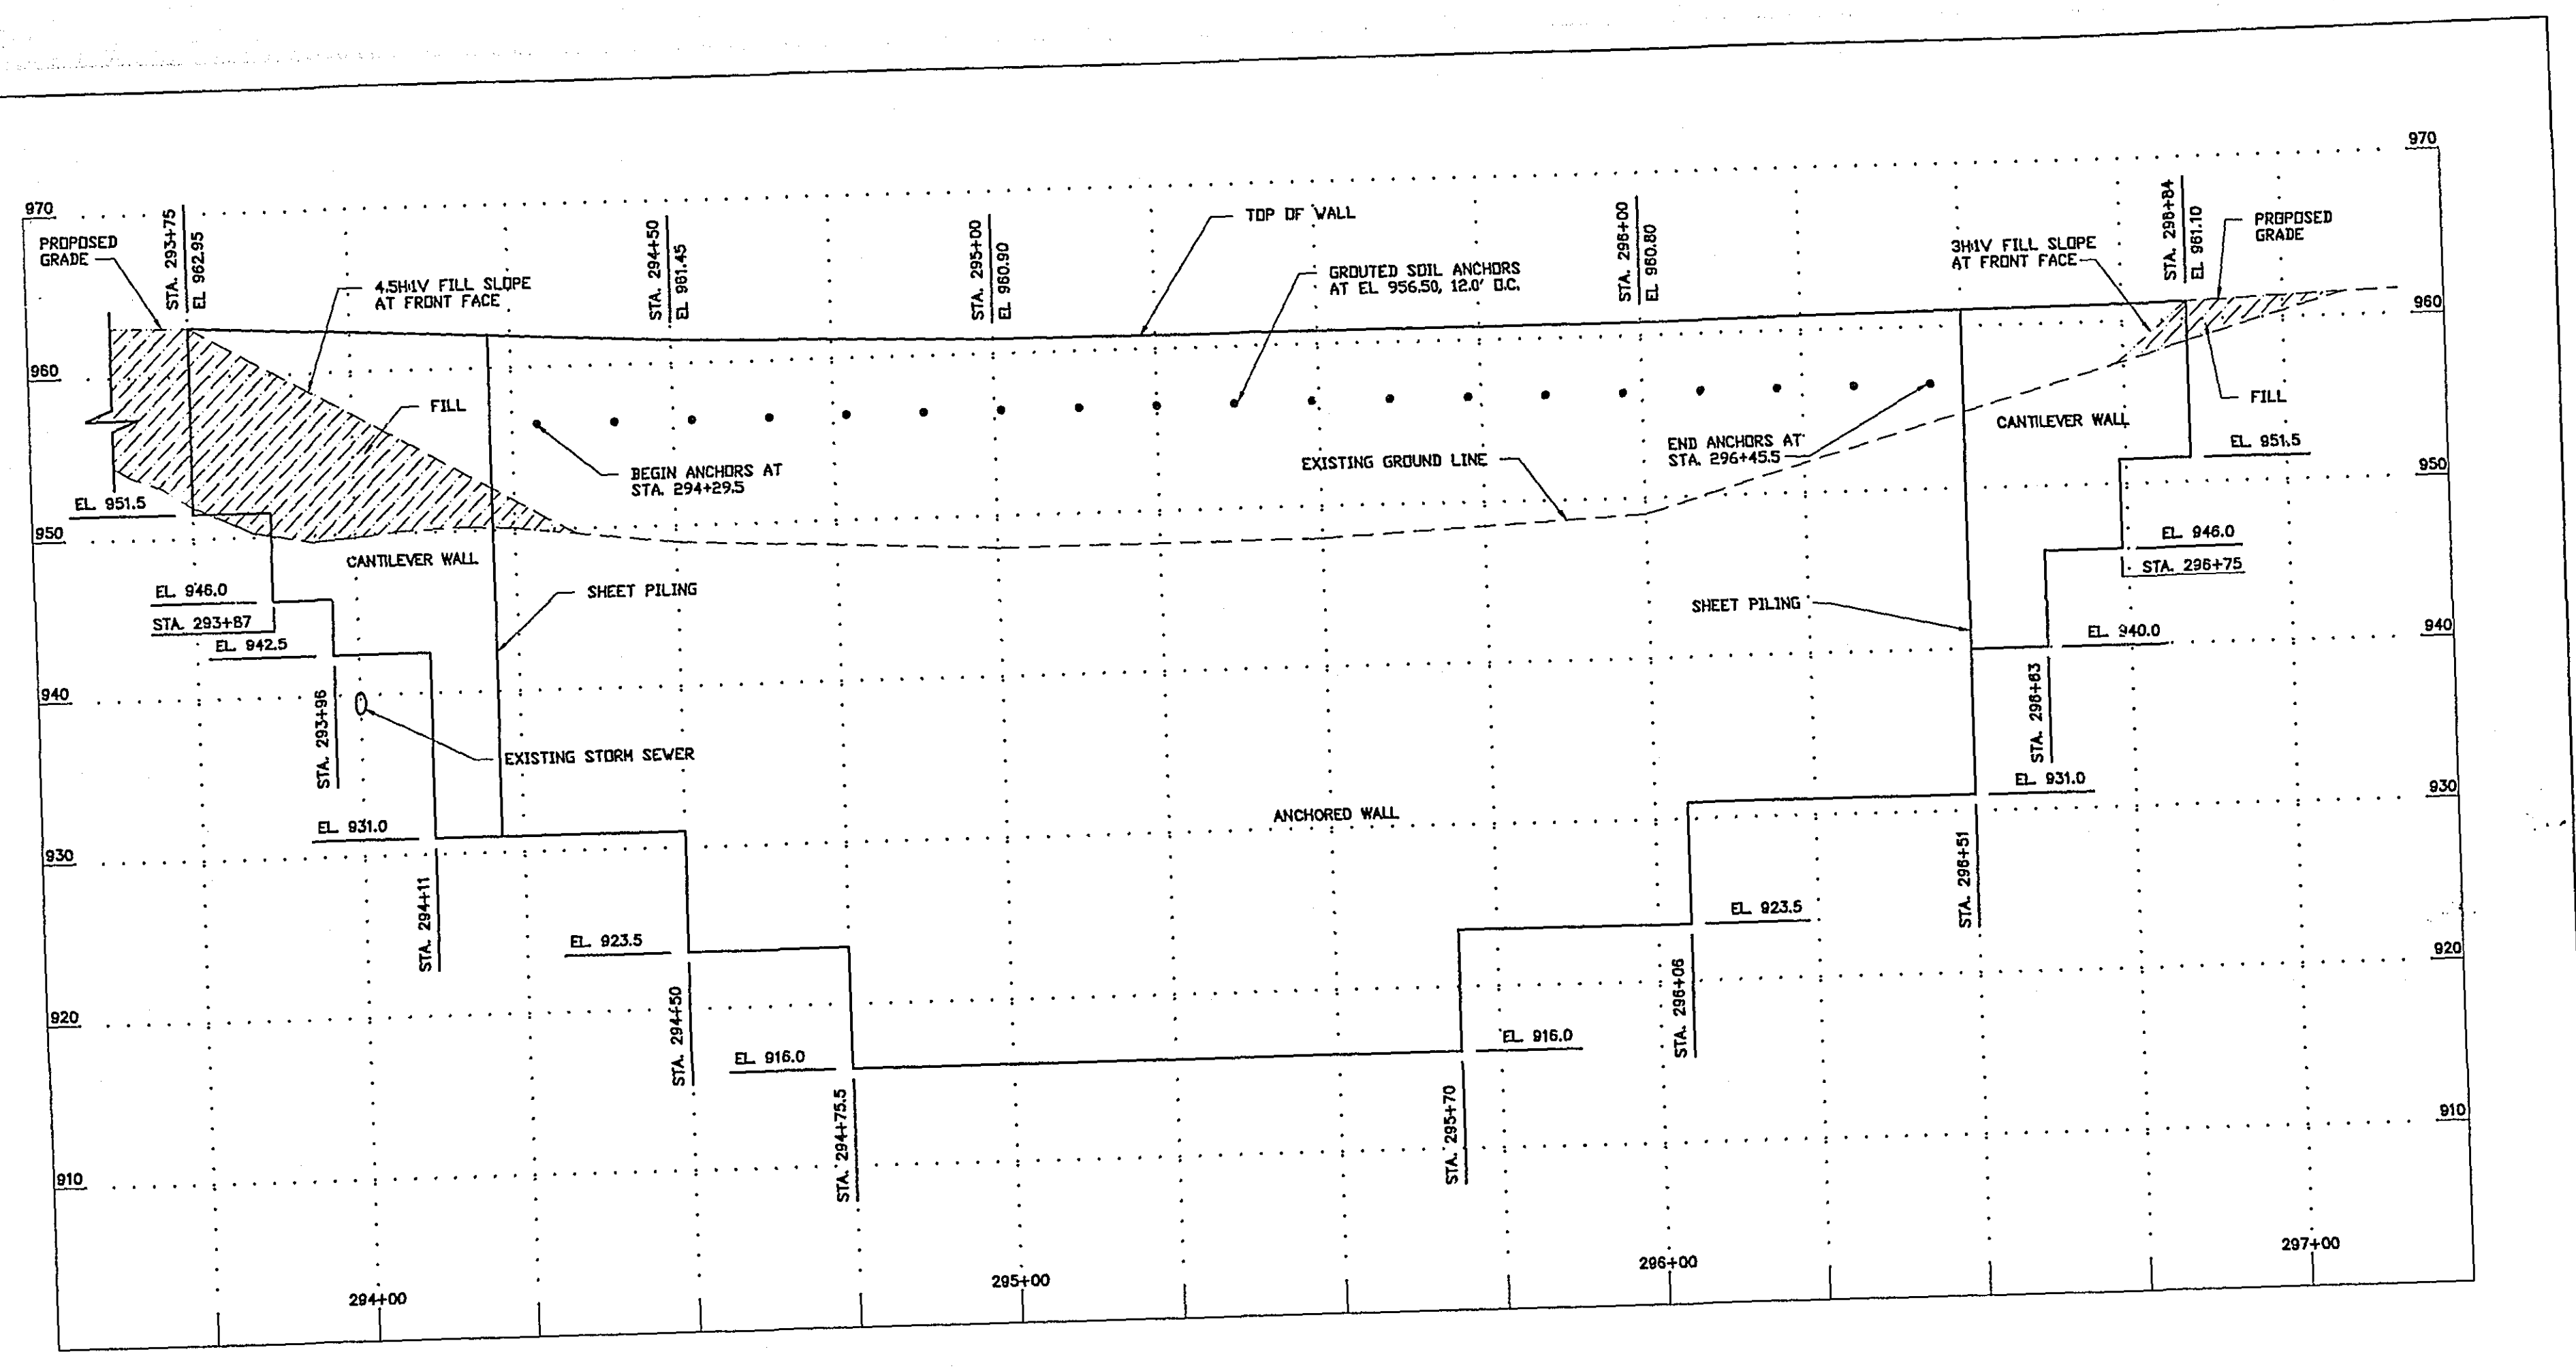


ITEM NO.	MATERIAL	UNITS	QUANTITY
2452.618	STEEL SHEET PILING	SF	10230
2452.602	GRADED SOIL ANCHOR	EA	19
2461.607	CELLULAR CONCRETE	CY	530

- NOTES:**
- ELEVATION VIEW IS FROM BEHIND THE WALL LOOKING EAST.
 - FIELD VERIFY DEPTH AND ALIGNMENT OF EXISTING STORM SEWER PRIOR TO DRIVING STEEL SHEET PILING.
 - DRIVE STEEL SHEET PILING FROM STA. 293+75 TO 293+96 AFTER PLACEMENT OF FILL TO A MINIMUM EL. 955.5.


ASBUILT PLAN
CONFORMING TO
CONST. RECORDS
DATE: 2-5-08

NO. REV. DATE BY	1. I HEREBY CERTIFY THAT THIS PLAN WAS PREPARED BY ME OR UNDER MY DIRECT SUPERVISION AND THAT I AM A DULY LICENSED PROFESSIONAL ENGINEER UNDER THE LAWS OF THE STATE OF MINNESOTA.	PROJECT LEXINGTON AVENUE Cummings Park Dr. To County Rd. 96	S.A.P. 62-651-38 County Proj. P3167	SHEET PILE WALL ELEVATION Sheet No. 52 of 117 Sheets
01 03/20/08 WSM	SIGNED: <i>Wayne S. Wambold, P.E.</i> DATE: 03/22/08			

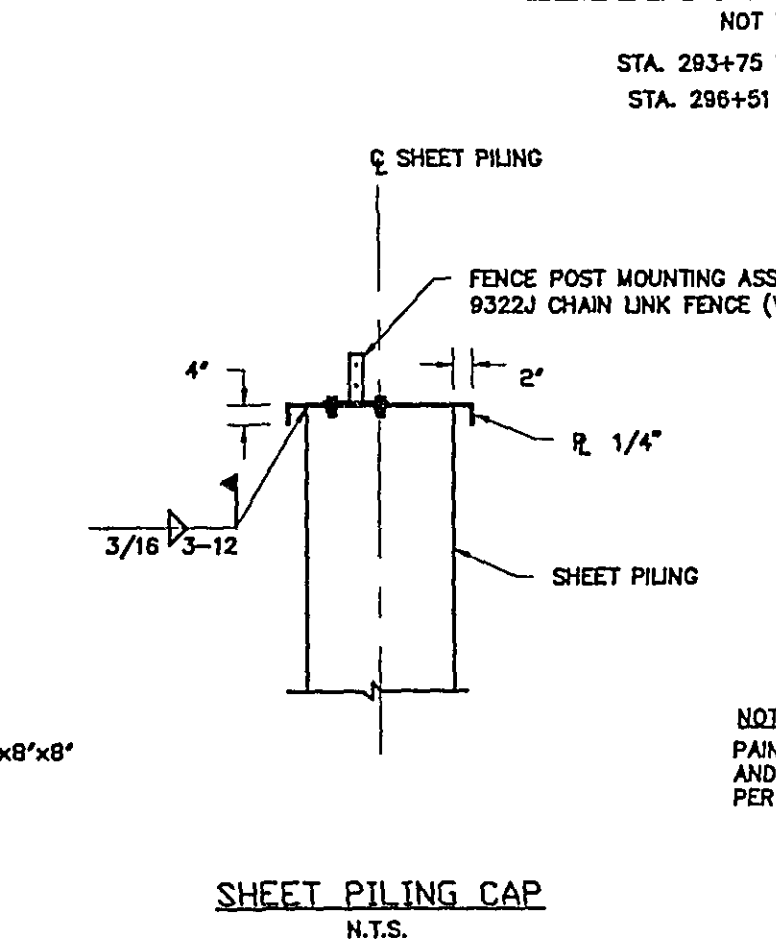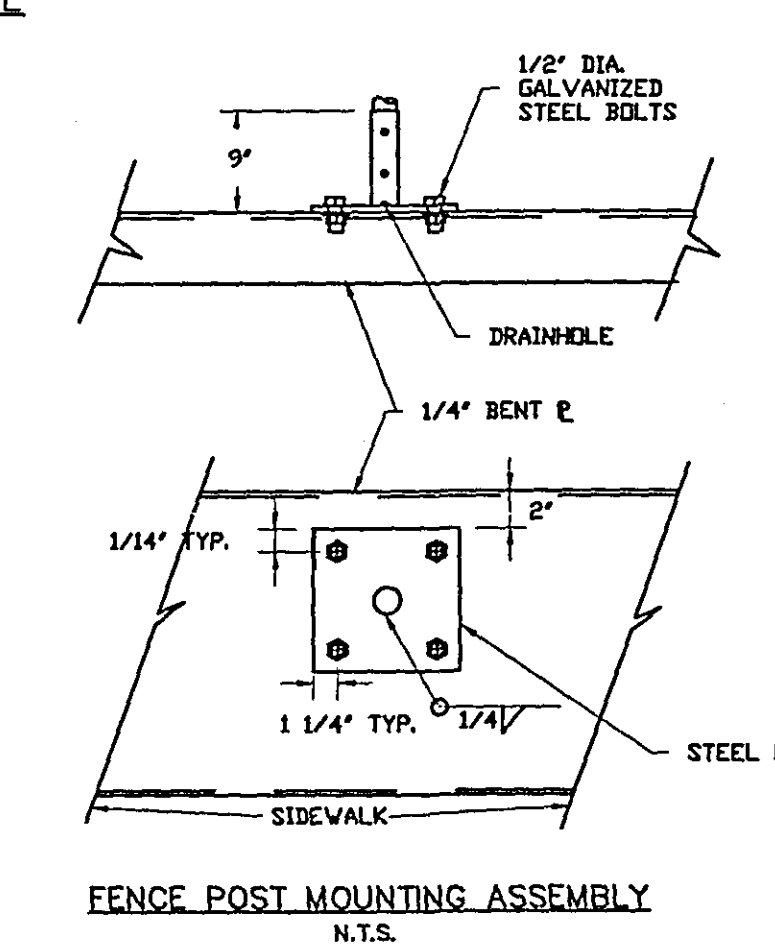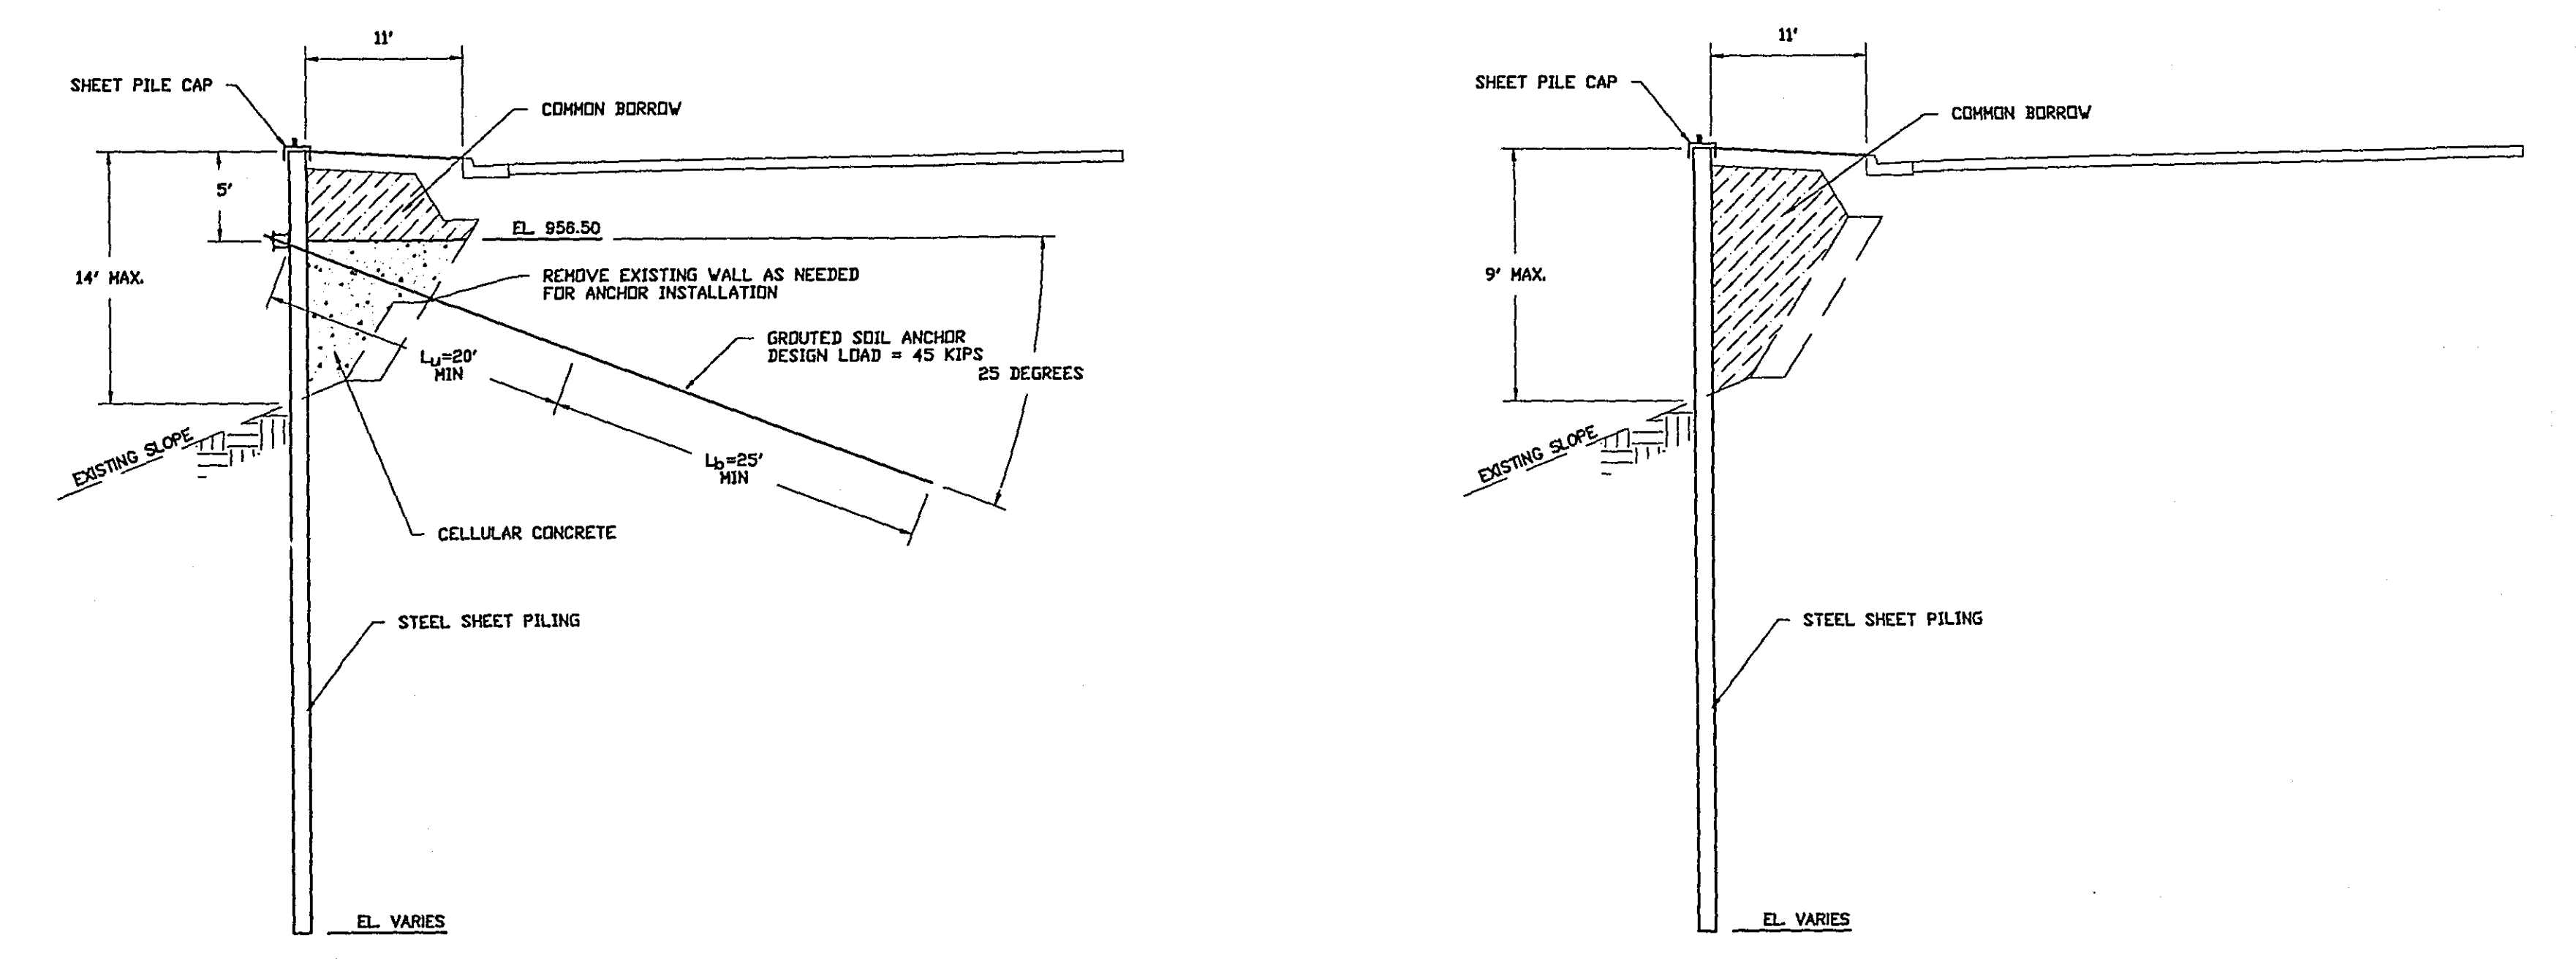


ASBUILT PLAN
CONFORMING TO
CONST. RECORDS
DATE: 2-5-08

NO. REV. DATE BY	1. I HEREBY CERTIFY THAT THIS PLAN WAS PREPARED BY ME OR UNDER MY DIRECT SUPERVISION AND THAT I AM A DULY LICENSED PROFESSIONAL ENGINEER UNDER THE LAWS OF THE STATE OF MINNESOTA.	PROJECT LEXINGTON AVENUE Cummings Park Dr. To County Rd. 96	S.A.P. 62-651-38 County Proj. P3167	SHEET PILE WALL DETAILS Sheet No. 53 of 117 Sheets
01 03/20/08 WSM	SIGNED: <i>Wayne S. Wambold, P.E.</i> DATE: 03/22/08			

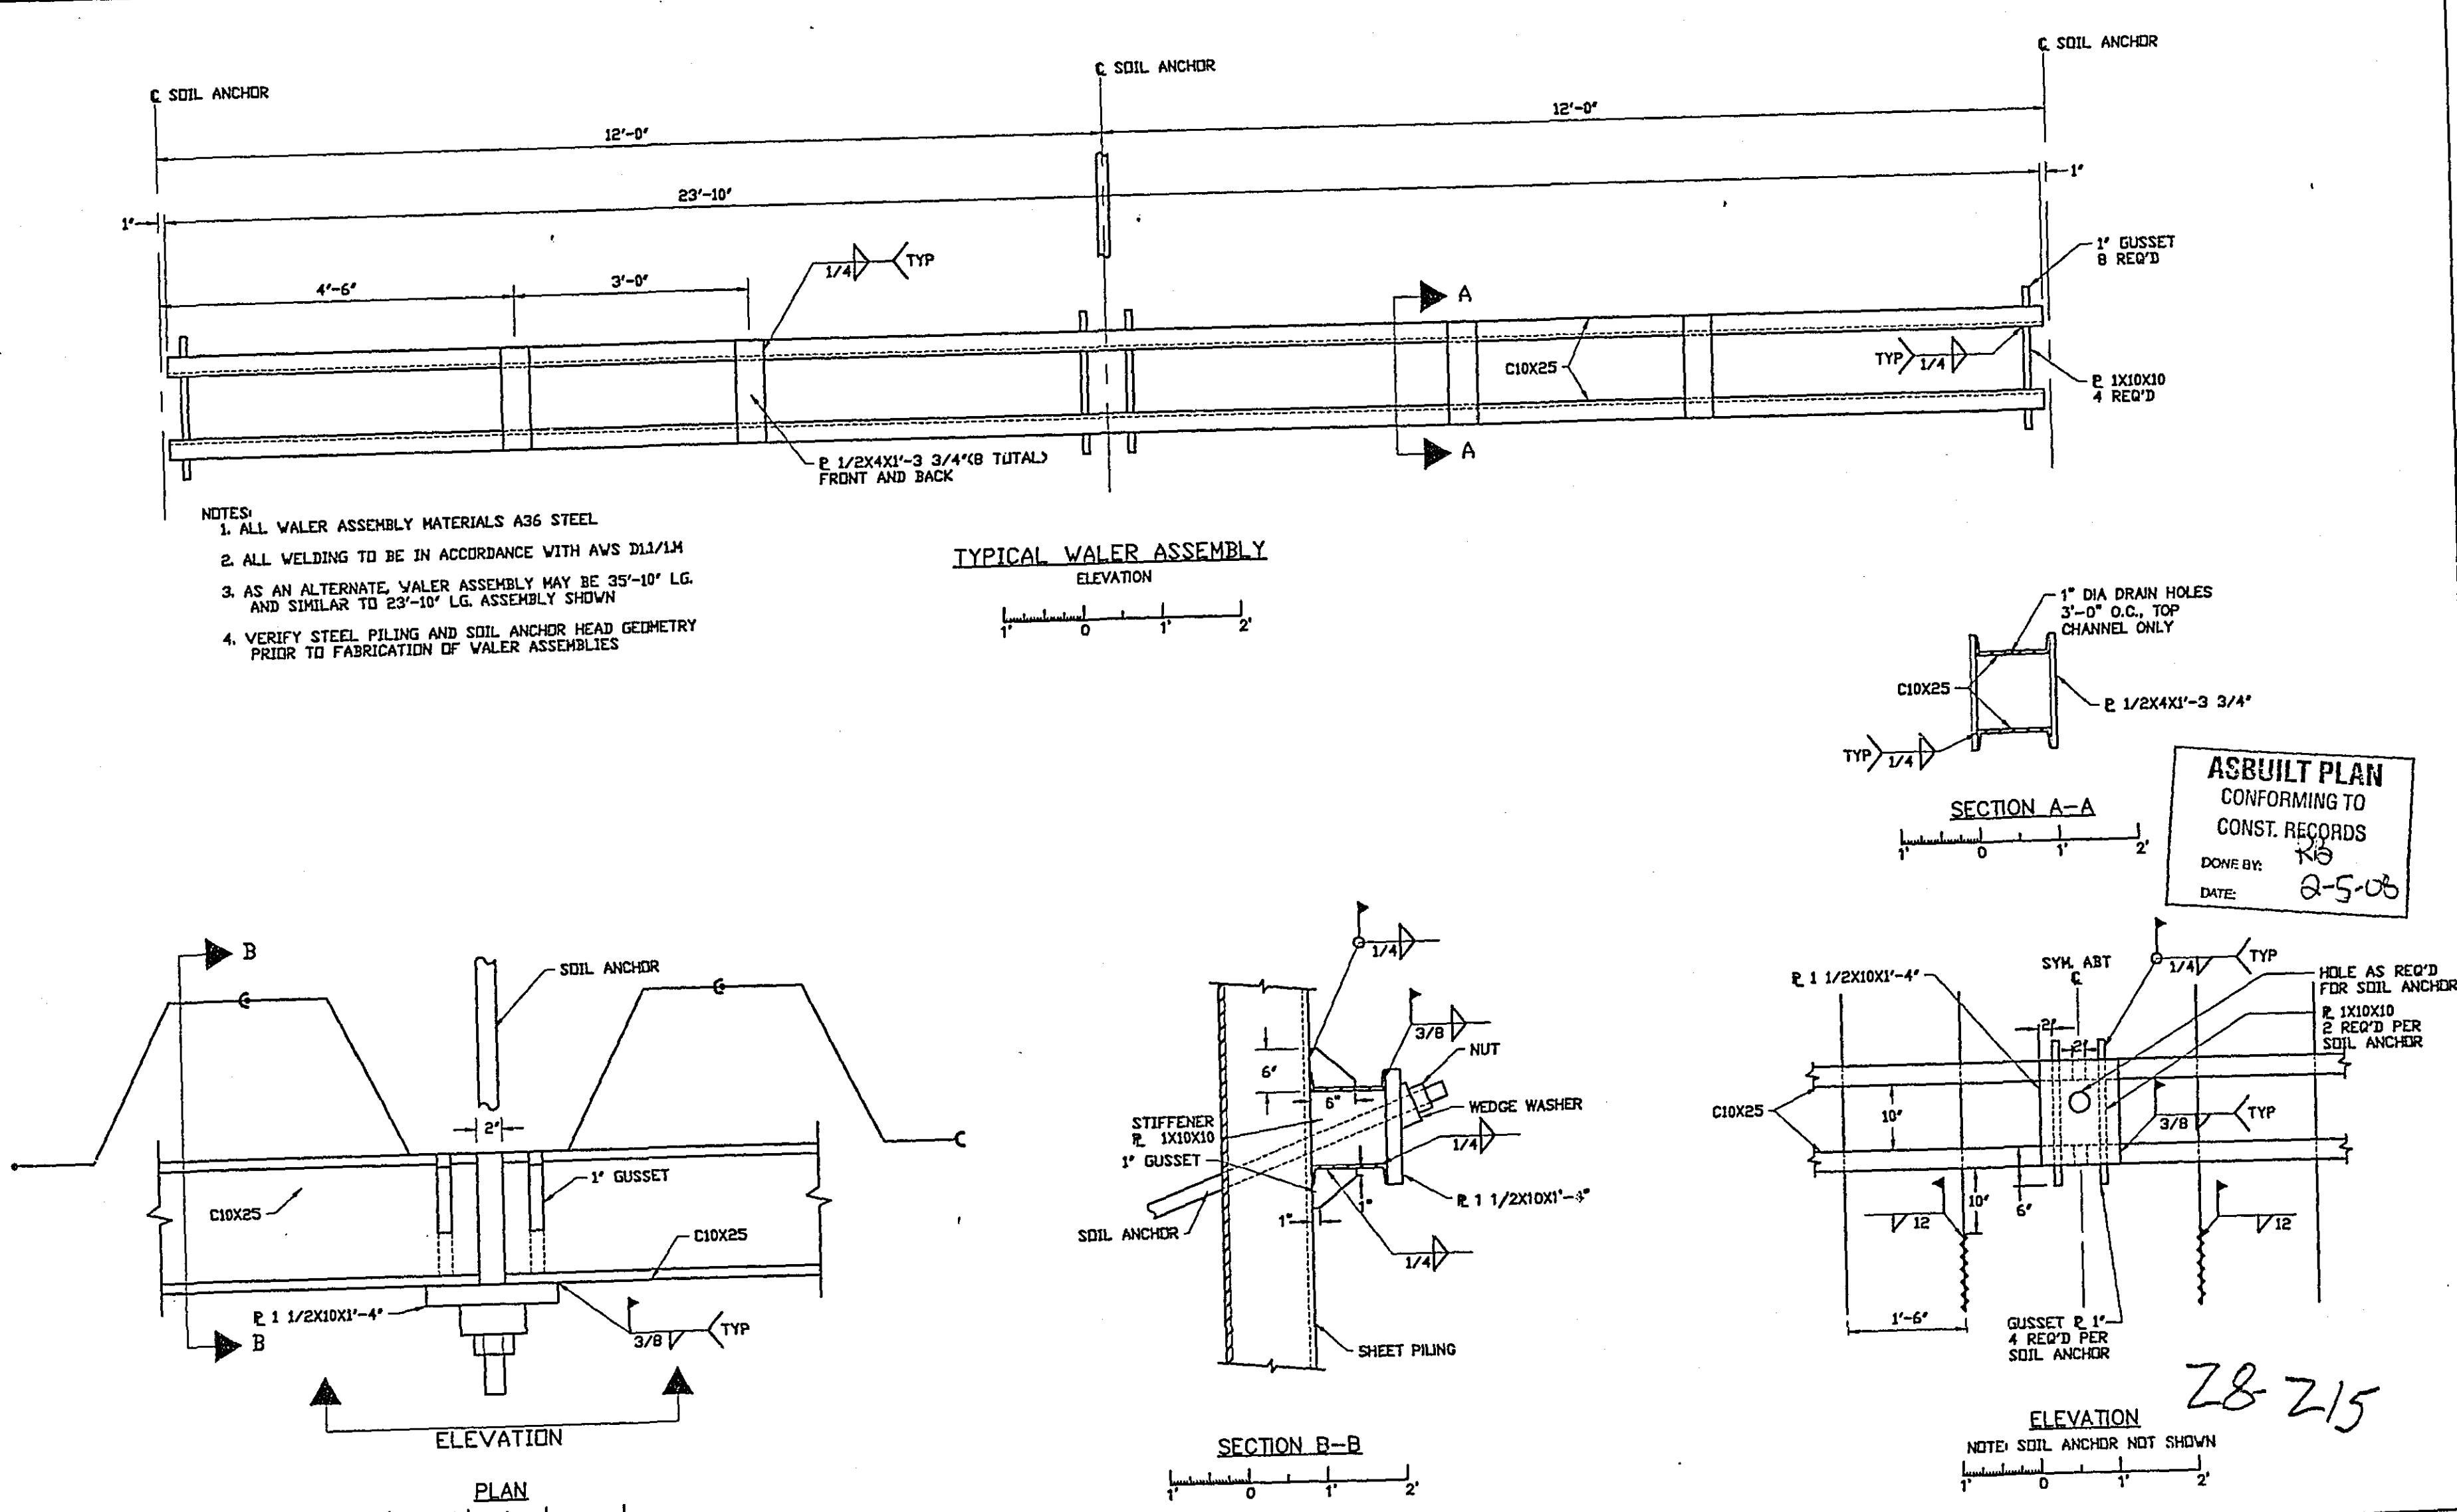

ASBUILT PLAN
CONFORMING TO
CONST. RECORDS
DATE: 2-5-08

NO. REV. DATE BY	1. I HEREBY CERTIFY THAT THIS PLAN WAS PREPARED BY ME OR UNDER MY DIRECT SUPERVISION AND THAT I AM A DULY LICENSED PROFESSIONAL ENGINEER UNDER THE LAWS OF THE STATE OF MINNESOTA.	PROJECT LEXINGTON AVENUE Cummings Park Dr. To County Rd. 96	S.A.P. 62-651-38 County Proj. P3167	SHEET PILE WALL DETAILS Sheet No. 54 of 117 Sheets
01 03/20/08 WSM	SIGNED: <i>Wayne S. Wambold, P.E.</i> DATE: 03/22/08			

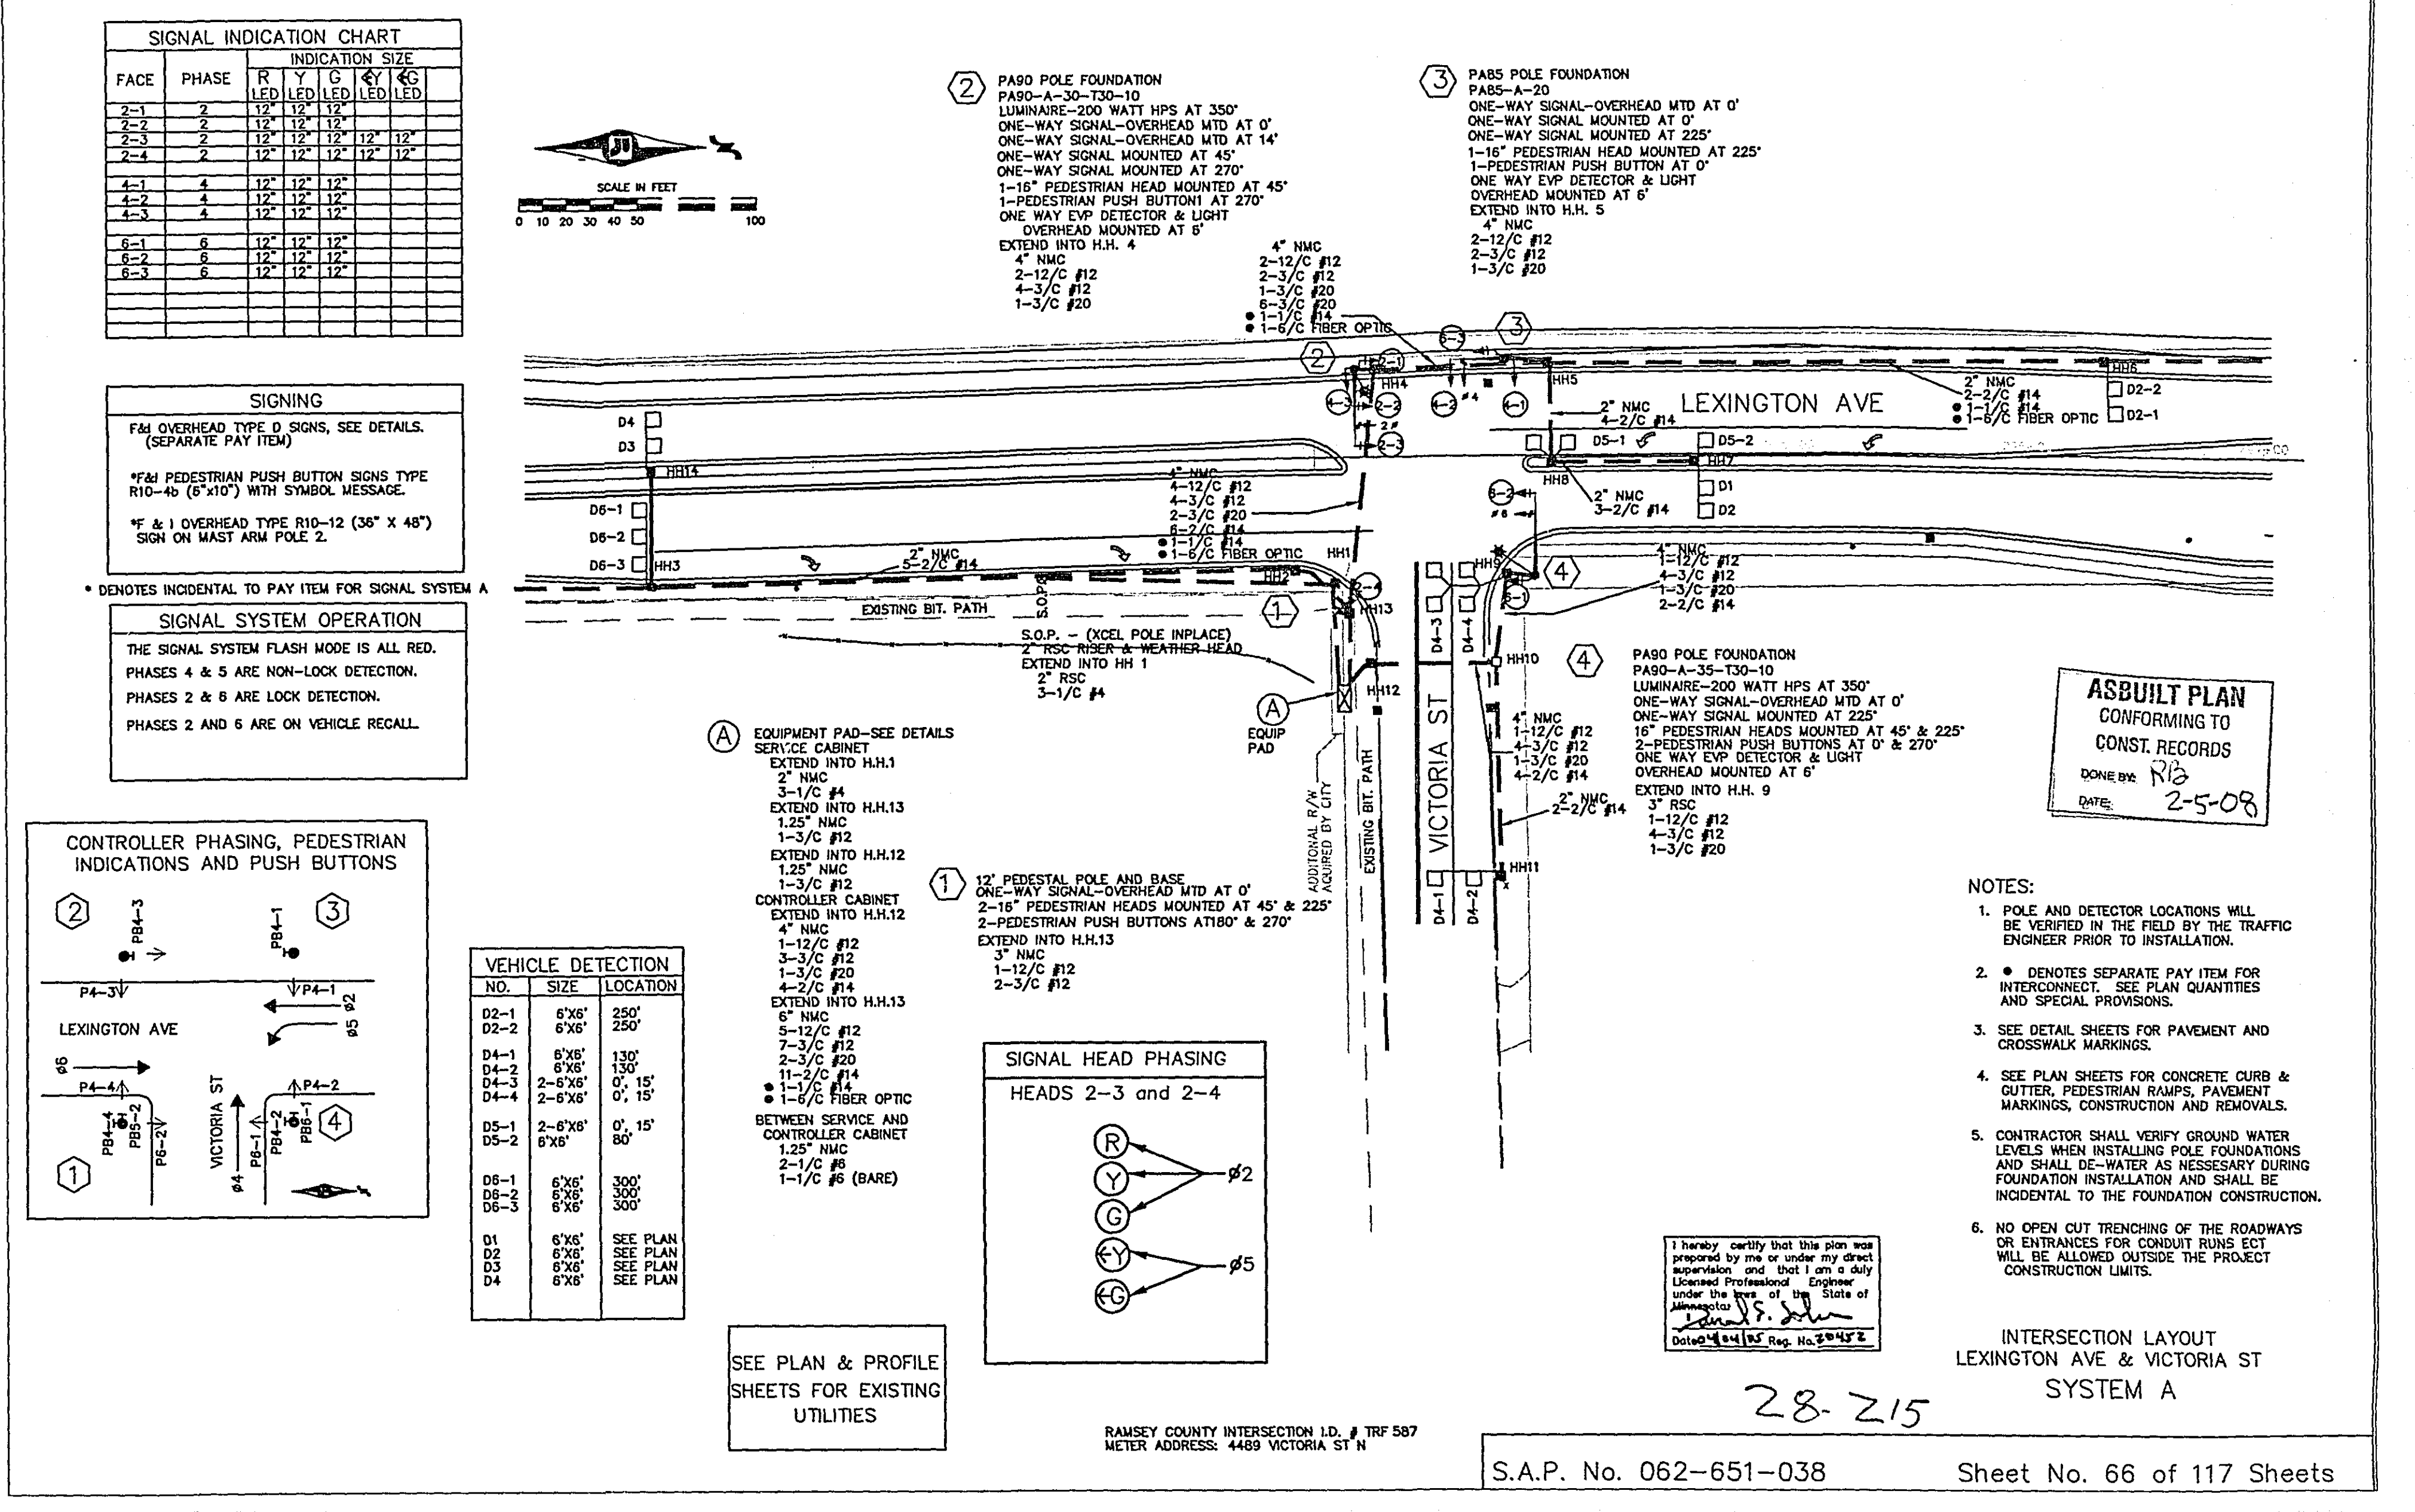

ASBUILT PLAN
CONFORMING TO
CONST. RECORDS
DATE: 2-5-08

NO. REV. DATE BY	1. I HEREBY CERTIFY THAT THIS PLAN WAS PREPARED BY ME OR UNDER MY DIRECT SUPERVISION AND THAT I AM A DULY LICENSED PROFESSIONAL ENGINEER UNDER THE LAWS OF THE STATE OF MINNESOTA.	PROJECT LEXINGTON AVENUE Cummings Park Dr. To County Rd. 96	S.A.P. 62-651-38 County Proj. P3167	SHEET PILE WALL DETAILS Sheet No. 55 of 117 Sheets
01 03/20/08 WSM	SIGNED: <i>Wayne S. Wambold, P.E.</i> DATE: 03/22/08			

