

STATEMENT OF ESTIMATED QUANTITIES												
CHART	NOTE	ITEM NO.	CONTRACT ITEM	UNIT	TOTAL QNTY	100% S.A.P. 62-615-25 RAMSEY CO. QUANTITY	100% S.A.P. 62-614-02 RAMSEY CO. QUANTITY	100% S.A.P. 209-020-08 VADNAIS HTS. QUANTITY	100% S.A.P. 62-615-25 STORM SEWER QUANTITY	100% S.A.P. 62-614-02 STORM SEWER QUANTITY	75% S.A.P. 209-020-08 25% S.A.P. 62-615-25 WALK/C&G QUANTITY	75% S.A.P. 209-020-08 25% S.A.P. 62-614-02 WALK/C&G QUANTITY
		2021.501	MOBILIZATION	LS	1	0.6						
		2031.501	FIELD OFFICE, TYPE SPECIAL-D	EACH	1	0.6	0.4					
A		2101.501	CLEARING	ACRE	0.16	0.09	0.07					
A		2101.502	GRUBBING	ACRE	44	32	12					
A		2101.506	GRUBBING	ACRE	0.16	0.09	0.07					
		2102.501	PAVEMENT MARKING REMOVAL	S.F.	60	60						
		2102.502	4" PAVEMENT MARKING REMOVAL	L.F.	1200	800	400					
J		2104.501	REMOVE RC PIPE CULVERT	L.F.	32	32						
J		2104.501	REMOVE RC PIPE SEWER	L.F.	10	10						
B		2104.501	REMOVE CONCRETE CURB & GUTTER	L.F.	2580	2580	10					
B		2104.501	REMOVE BITUMINOUS CURB	L.F.	972	916	56					
B		2104.503	REMOVE CONCRETE SIDEWALK	SF.	2326	2326						
B		2104.505	REMOVE CONCRETE PAVEMENT	S.Y.	835	835						
J		2104.509	REMOVE CATCH BASIN	EACH	4	4						
Q		2104.509	REMOVE MANHOLE	EACH	3	2	1					
G		2104.509	REMOVE HYDRANT	EACH	2	1	1					
F		2104.511	SAWING CONCRETE PAVEMENT	L.F.	73	73						
G		2104.513	SAWING BITUMINOUS PAVEMENT	L.F.	550	494	64					
B		2104.523	SALVAGE GATE VALVE & BOX	EACH	1	1						
G		2104.533	SALVAGE HYDRANT	EACH	1	1						
J		2104.533	SALVAGE APRON	EACH	1	1						
J		2104.533	SALVAGE CASTING	EACH	7	6	1					
D	(1)	2105.501	COMMON EXCAVATION (EV) (P)	C.Y.	9396	7539	1857					
D		2105.511	COMMON CHANNEL EXCAVATION (EV) (P)	C.Y.	25	25						
D		2105.552	SELECT GRANULAR BORROW (LV)(P)	C.Y.	3982	2357	1625					
D		2105.523	COMMON BORROW (LV) (P)	C.Y.	2499	243	2198					
L		2105.525	TOPSOIL BORROW (LV)	C.Y.	1448	781	687					
		2123.610	STREET SWEEPER (WITH PICKUP BROOM)	HR	200	120	80					
		2123.610	TRACTOR MOUNTED BACKHOE	HR	200	120	80					
(2)		2130.501	WATER	MSAL	200	120	80					
E		2211.503	AGG. BASE, CLASS 7 (CV)(P)	C.Y.	2874	2180.20	493.80					
		2232.501	MILL BITUMINOUS SURFACE (2.0")	S.Y.	1934	1934						
E		2350.501	LVWE 35035B WEAR COURSE MIXTURE	TON	67.2	55.76	11.44					
E		2350.502	LVNW 35035B NONWEAR COURSE MIX.	TON	67.2	55.76	11.44					
E		2361.501	BITUMINOUS MATERIAL FOR TACK COAT	GAL.	14618.4	11860.40	2758.00					
E		2369.501	SPWMB430B WEAR COURSE MIX - 4" DEPTH	TON	3188.86	2593.54	585.32					
E		2369.502	SPPNW430B NONWEAR COURSE MIX.	TON	2340.04	1915.14	520.90					
K		2501.515	15" R C PIPE APRON	EACH	1							
K		2501.515	24" R C PIPE APRON	EACH	2				1			
K		2501.515	36" R C PIPE APRON	EACH	1				2			
K		2501.602	TRASH GUARD FOR 15" PIPE APRON	EACH	1							

Construction Notes

The contractor shall cooperate with Ramsey County to perpetuate monumentation. Advance notice of any disturbance of monumentation should be made to the Ramsey County surveyor office at (651) 266-2625.

The contractor shall obtain from the utility companies the exact location of any underground utilities which may exist within or adjacent to the construction area.

Pedestrian curb ramps shall be installed at all street rail. The exact location shall be determined in the field by the engineer.

Top of "grading grade" is defined as the top of the embankment material or the bottom of the aggregate base course.

Strip topsoil from all areas to be disturbed by construction and stockpile (if practical) for replacement later as slope dressing.

Provide for removal and disposal of (outside the construction zone) any in-place surfacing and structures that will interfere with construction.

From a soils standpoint, traffic shall be maintained no closer than an imaginary 2' line drawn from the bottom of any excavation intersecting the surfacing.

The quality compaction method shall be used on this project for grading and base.

Provide drainage outlets for all sublots during construction. Ditches should be deeper than sublot to provide outlet drainage.

Provide a tack coat. Spec. 2357.2A, between bituminous courses.

Where the proposed sublot is located under in-place base and bituminous surfacing or concrete pavement, the ends of sublot shall be vertical for the depth of the bituminous or concrete and 2:1 in aggregate base.

Tapier outlets of sublot to a 20:1 slope unless otherwise directed.

Unsurfer grading material shall consist of topsoil, other organic soil and debris.

Since silt shall be installed at all fill slopes and may be required at other locations during construction as determined by the engineer. (Spec. 2573, 3886, 1707 7 1803.5)

**ASBUILT PLAN
CONFORMING TO
CONST. RECORDS**

ENGINE BY: *RJB*

DATE: *2-15-06*

728-217

I HEREBY CERTIFY THAT THIS PLAN WAS PREPARED BY ME OR UNDER MY DIRECT SUPERVISION AND THAT I AM A DULY REGISTERED PROFESSIONAL ENGINEER UNDER LAWS OF THE STATE OF MINNESOTA.

[Signature]

REC. NO. *01552* DATE *2/15/06*

ESTIMATED QUANTITIES
SHFIT, 3 of 85 SHEETS

QUANTITY NOTES	
(1)	includes bituminous removal and disposal
(2)	For dust control
(3)	All pedestrian ramps shall have a precast truncated dome area.
(4)	
(5)	
(6)	
(7)	
(8)	
(9)	
(10)	
(11)	
(12)	
(13)	
(14)	
(15)	
(16)	
(17)	

BASIS FOR ESTIMATED QUANTITIES	
2211.501	Aggregate Base - 3790 lbs / CY
2350.609	Blumious Mixtures - 110 lbs / SY / IN of thickness
2357.502	Bituminous material for tack coat estimated at 0.5 gals / SY per application
2575.502	Seed Mixture 26B estimated at 30 lbs per acre
2575.503	Seed Mixture 32B estimated at 30 lbs per acre
2575.532	Fertilizer application rates 400 lbs per acre

ASBUILT PLAN
CONFORMING TO
CONST. RECORDS
DATE BY: RB
2-15-08





28-217


I HEREBY CERTIFY THAT THIS PLAN WAS PREPARED BY ME OR UNDER MY DIRECT SUPERVISION AND THAT I AM A DULY REGISTERED PROFESSIONAL ENGINEER UNDER LAWS OF THE STATE OF MINNESOTA.

[Signature]


PEO. NO. 016150

DATE 3/15/08

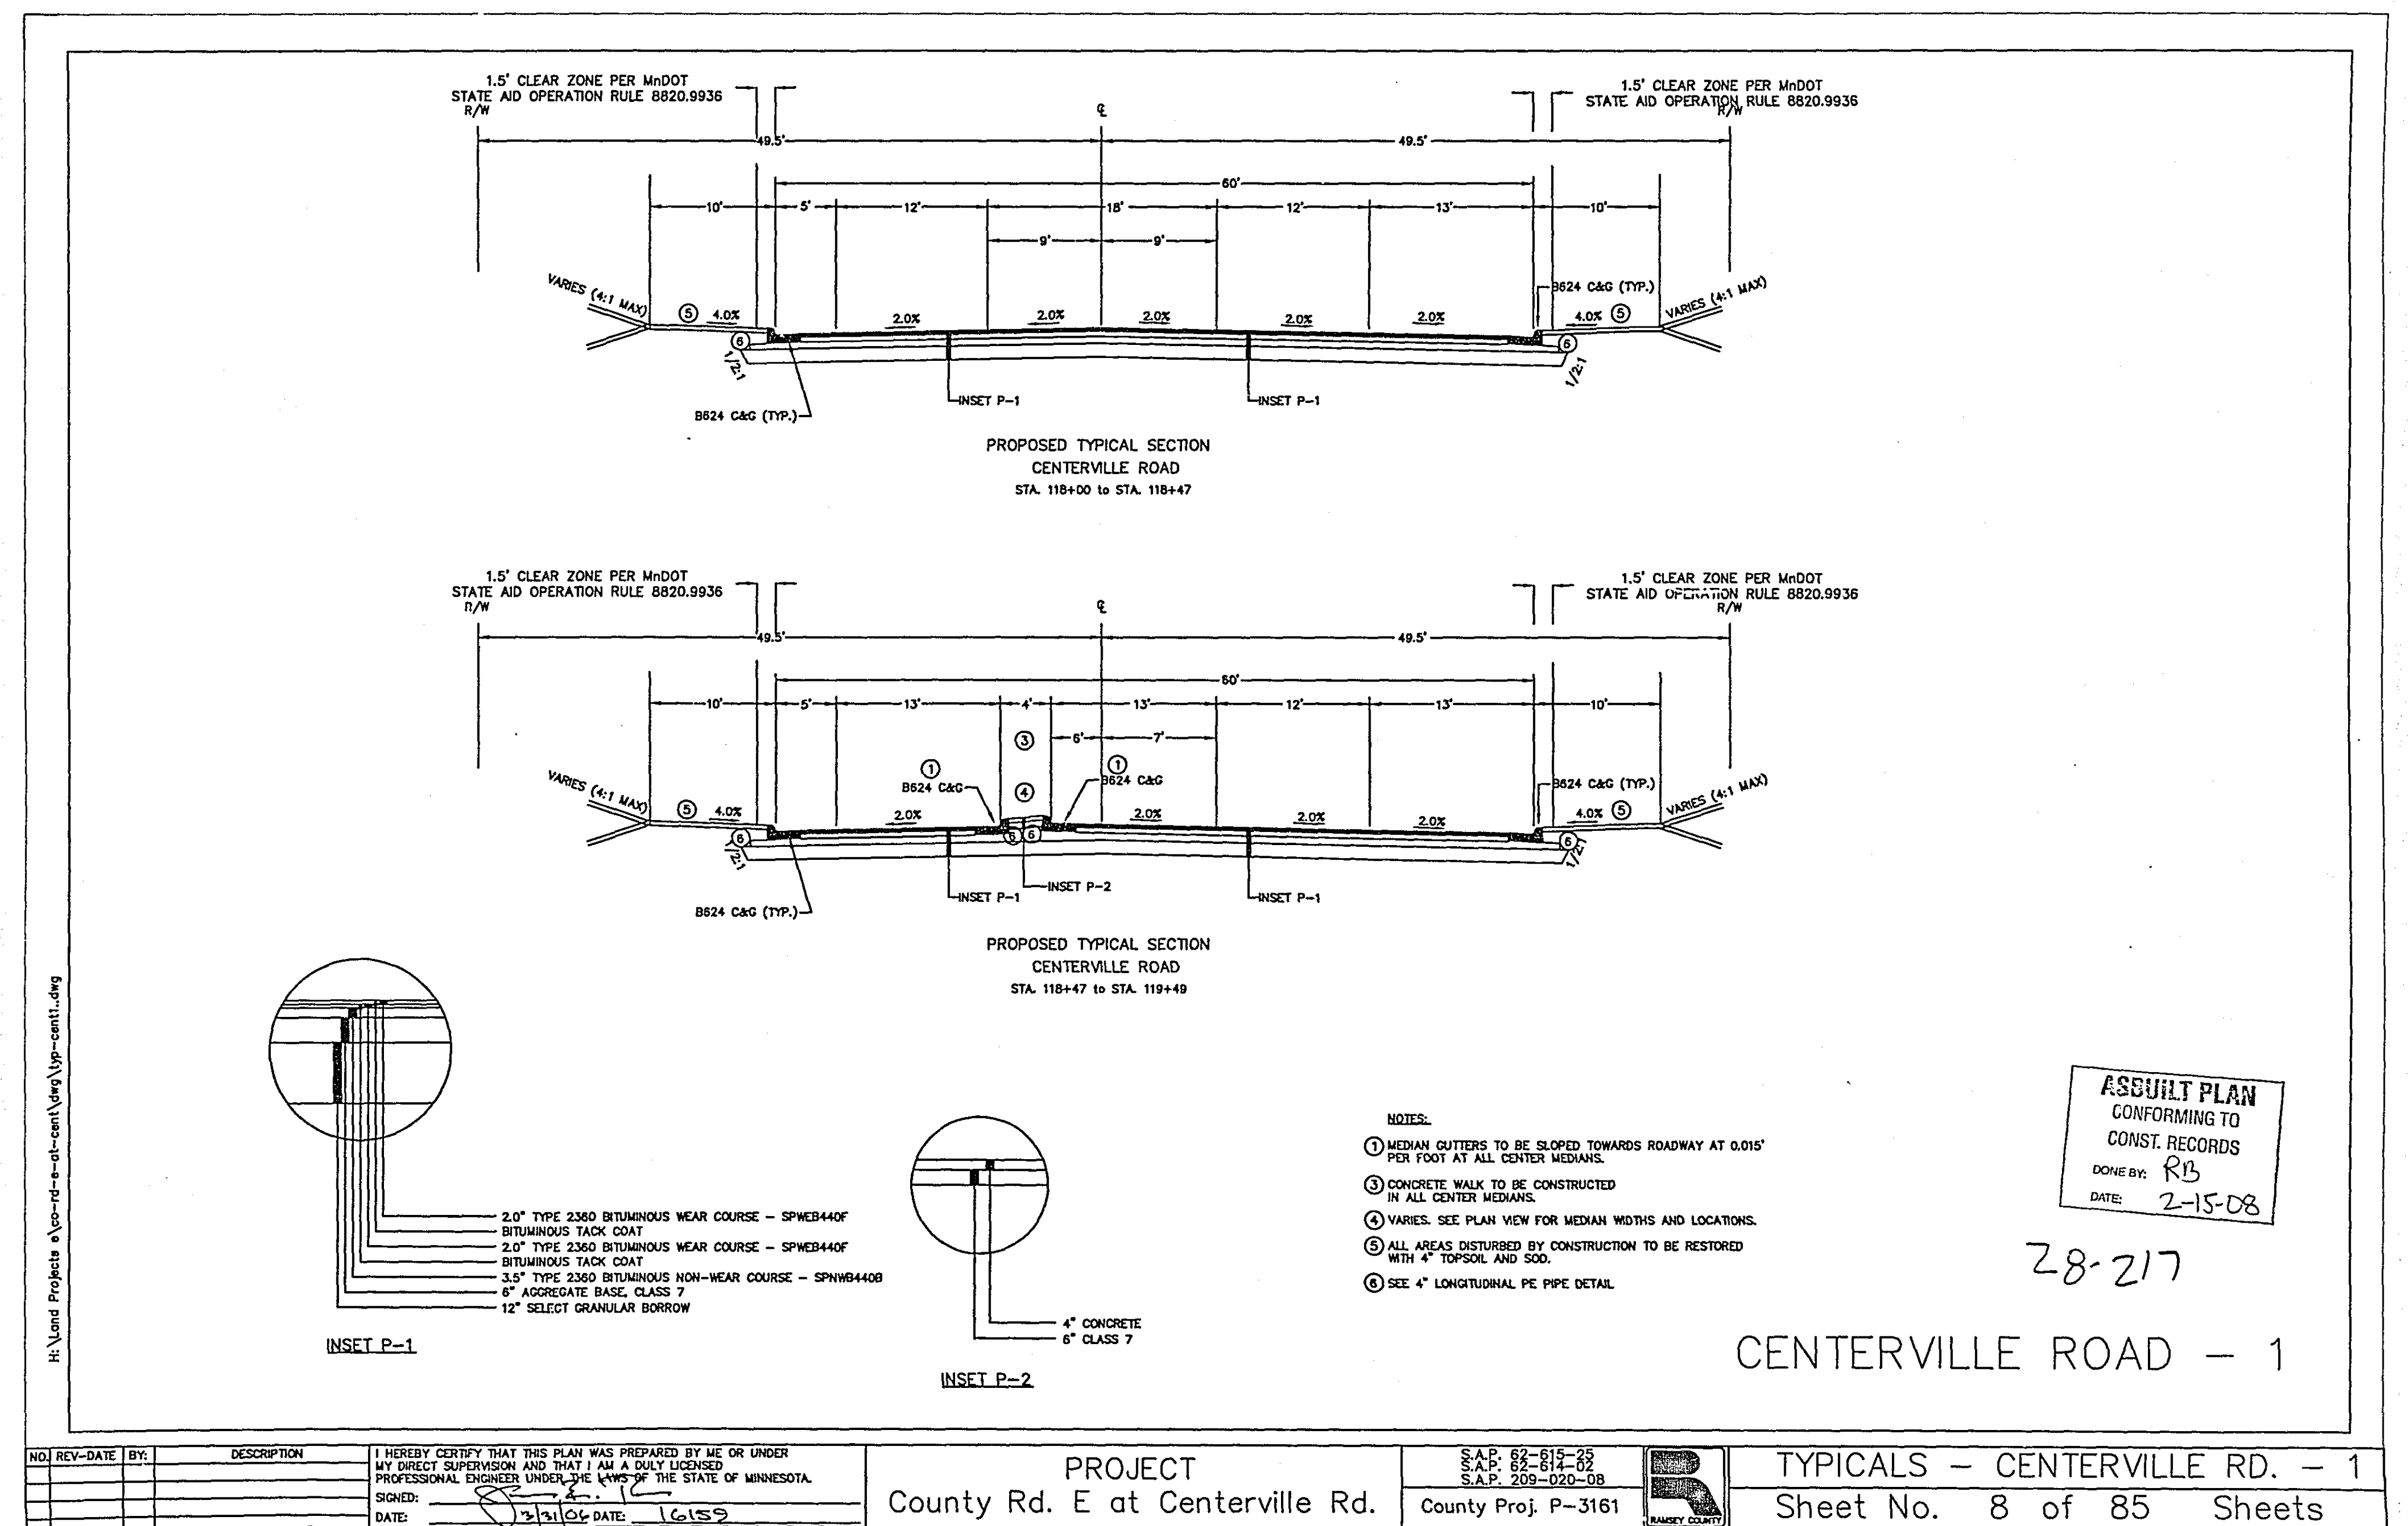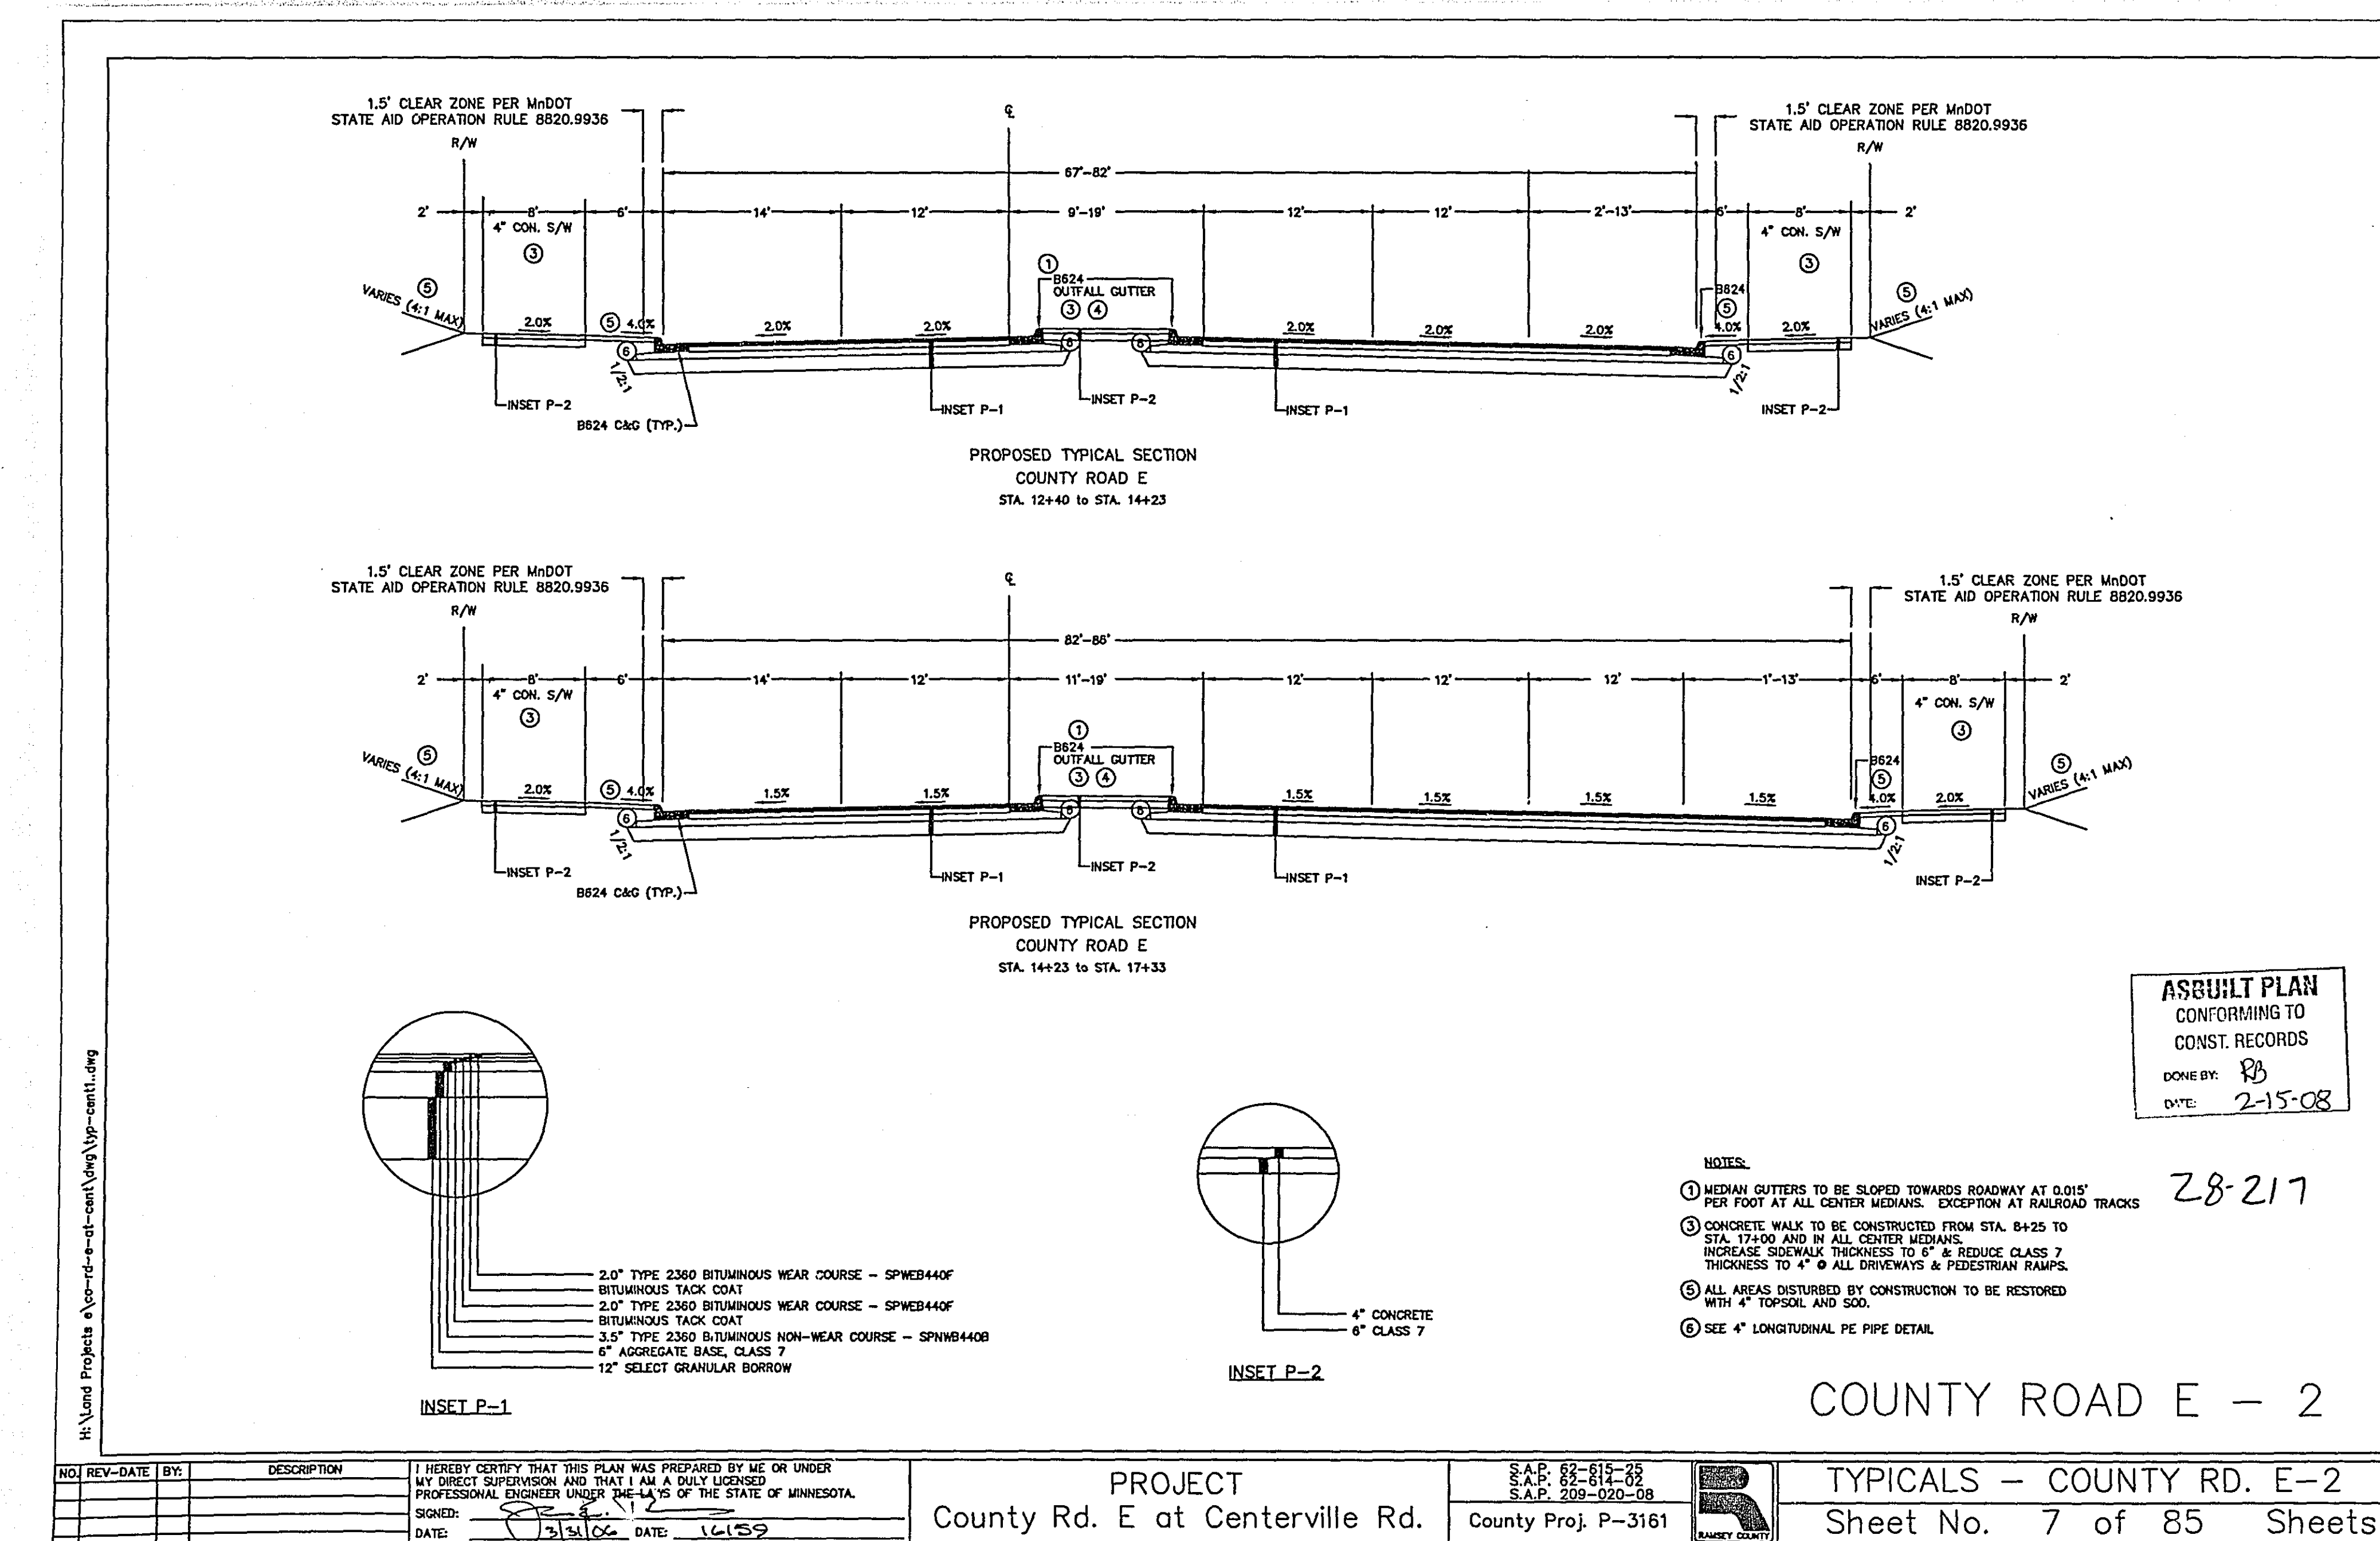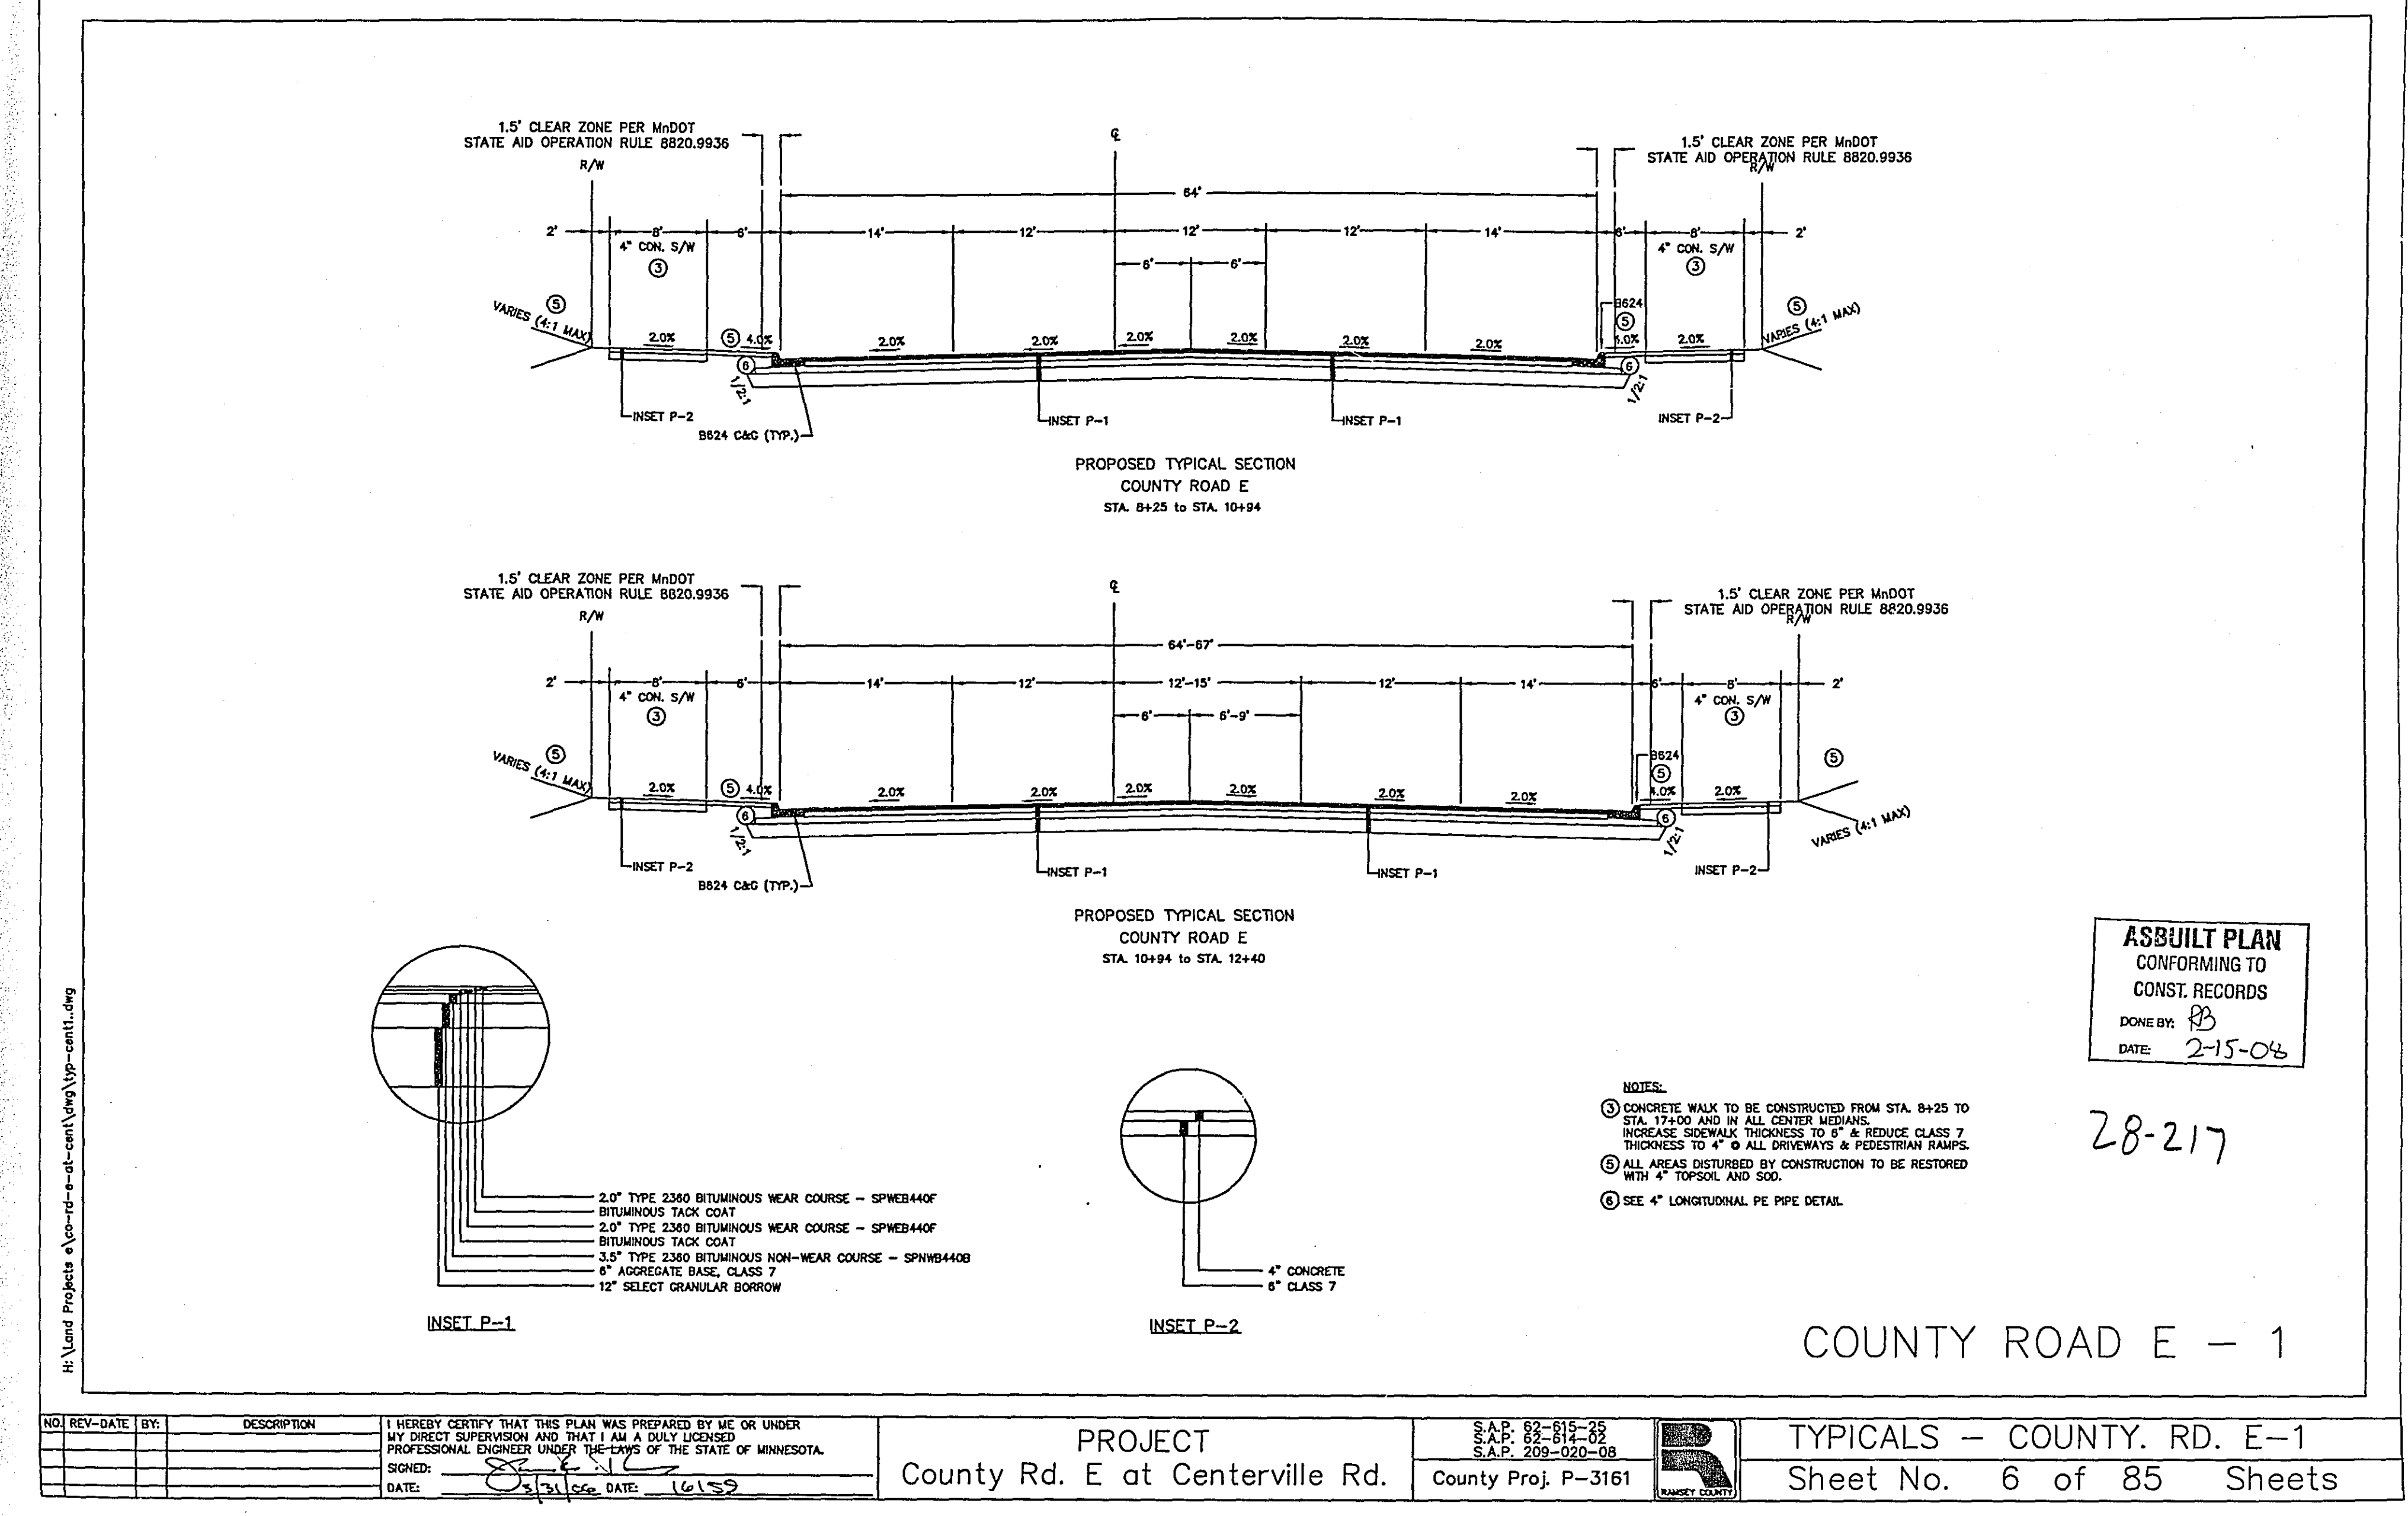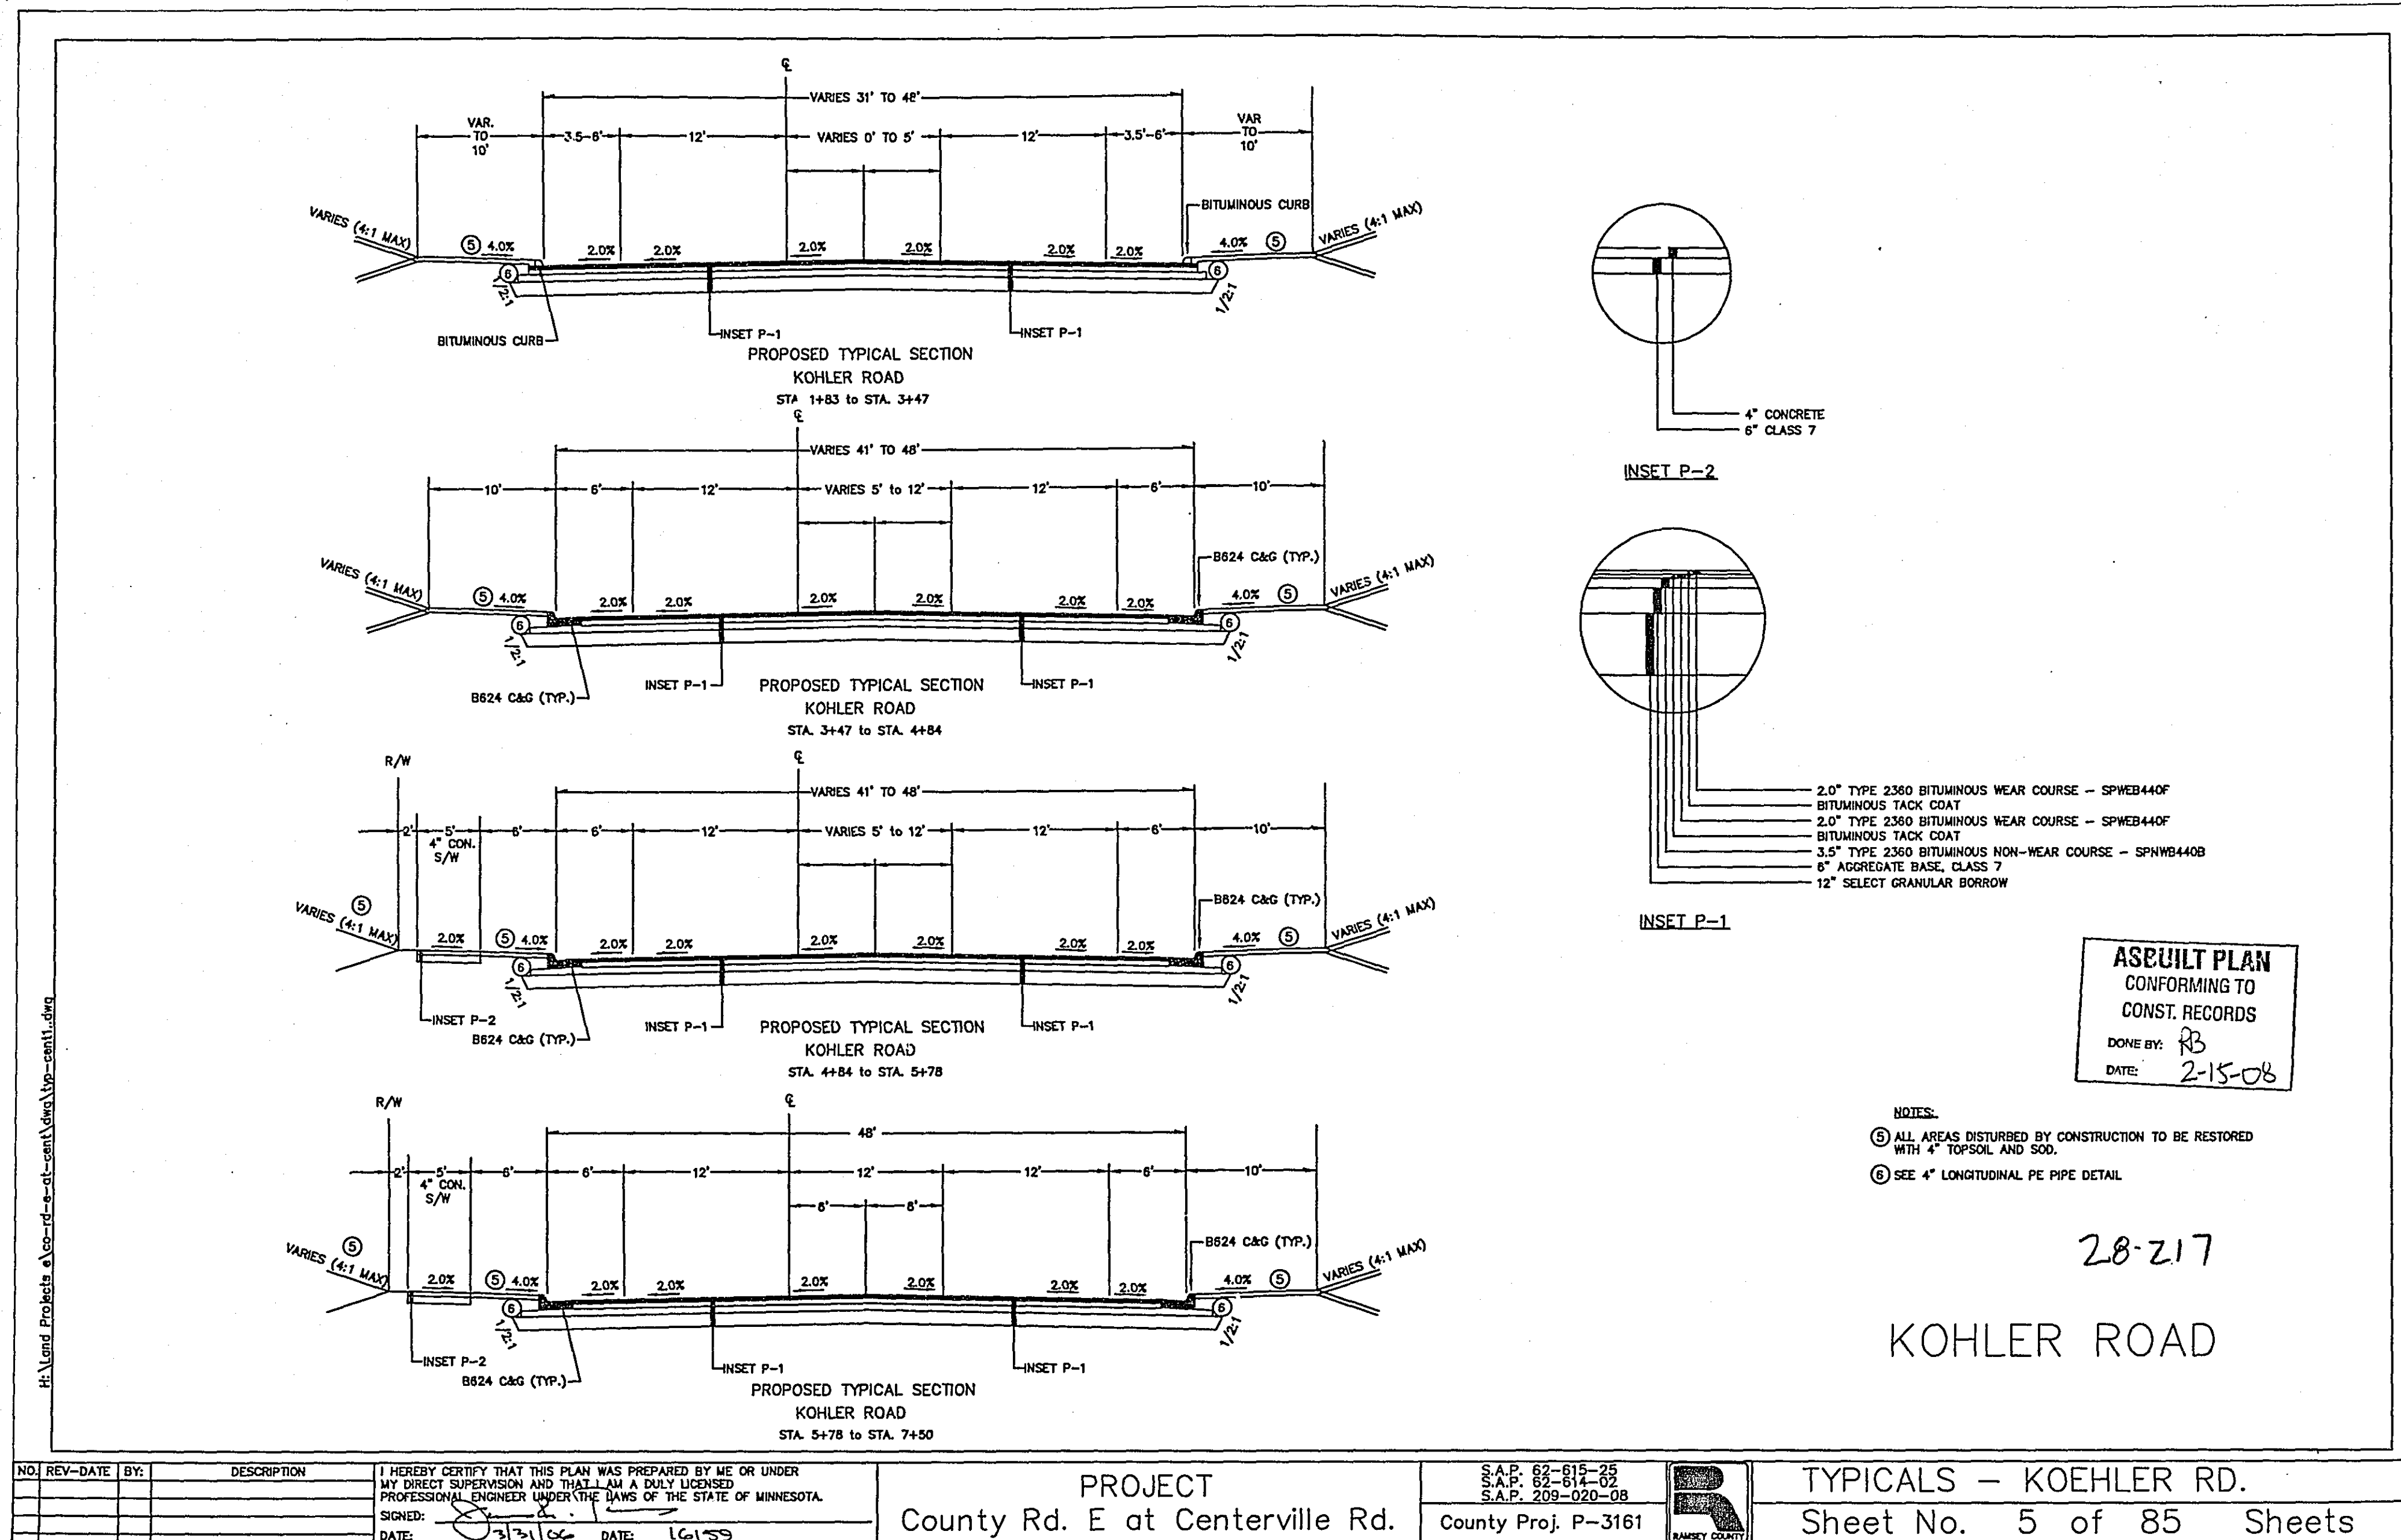


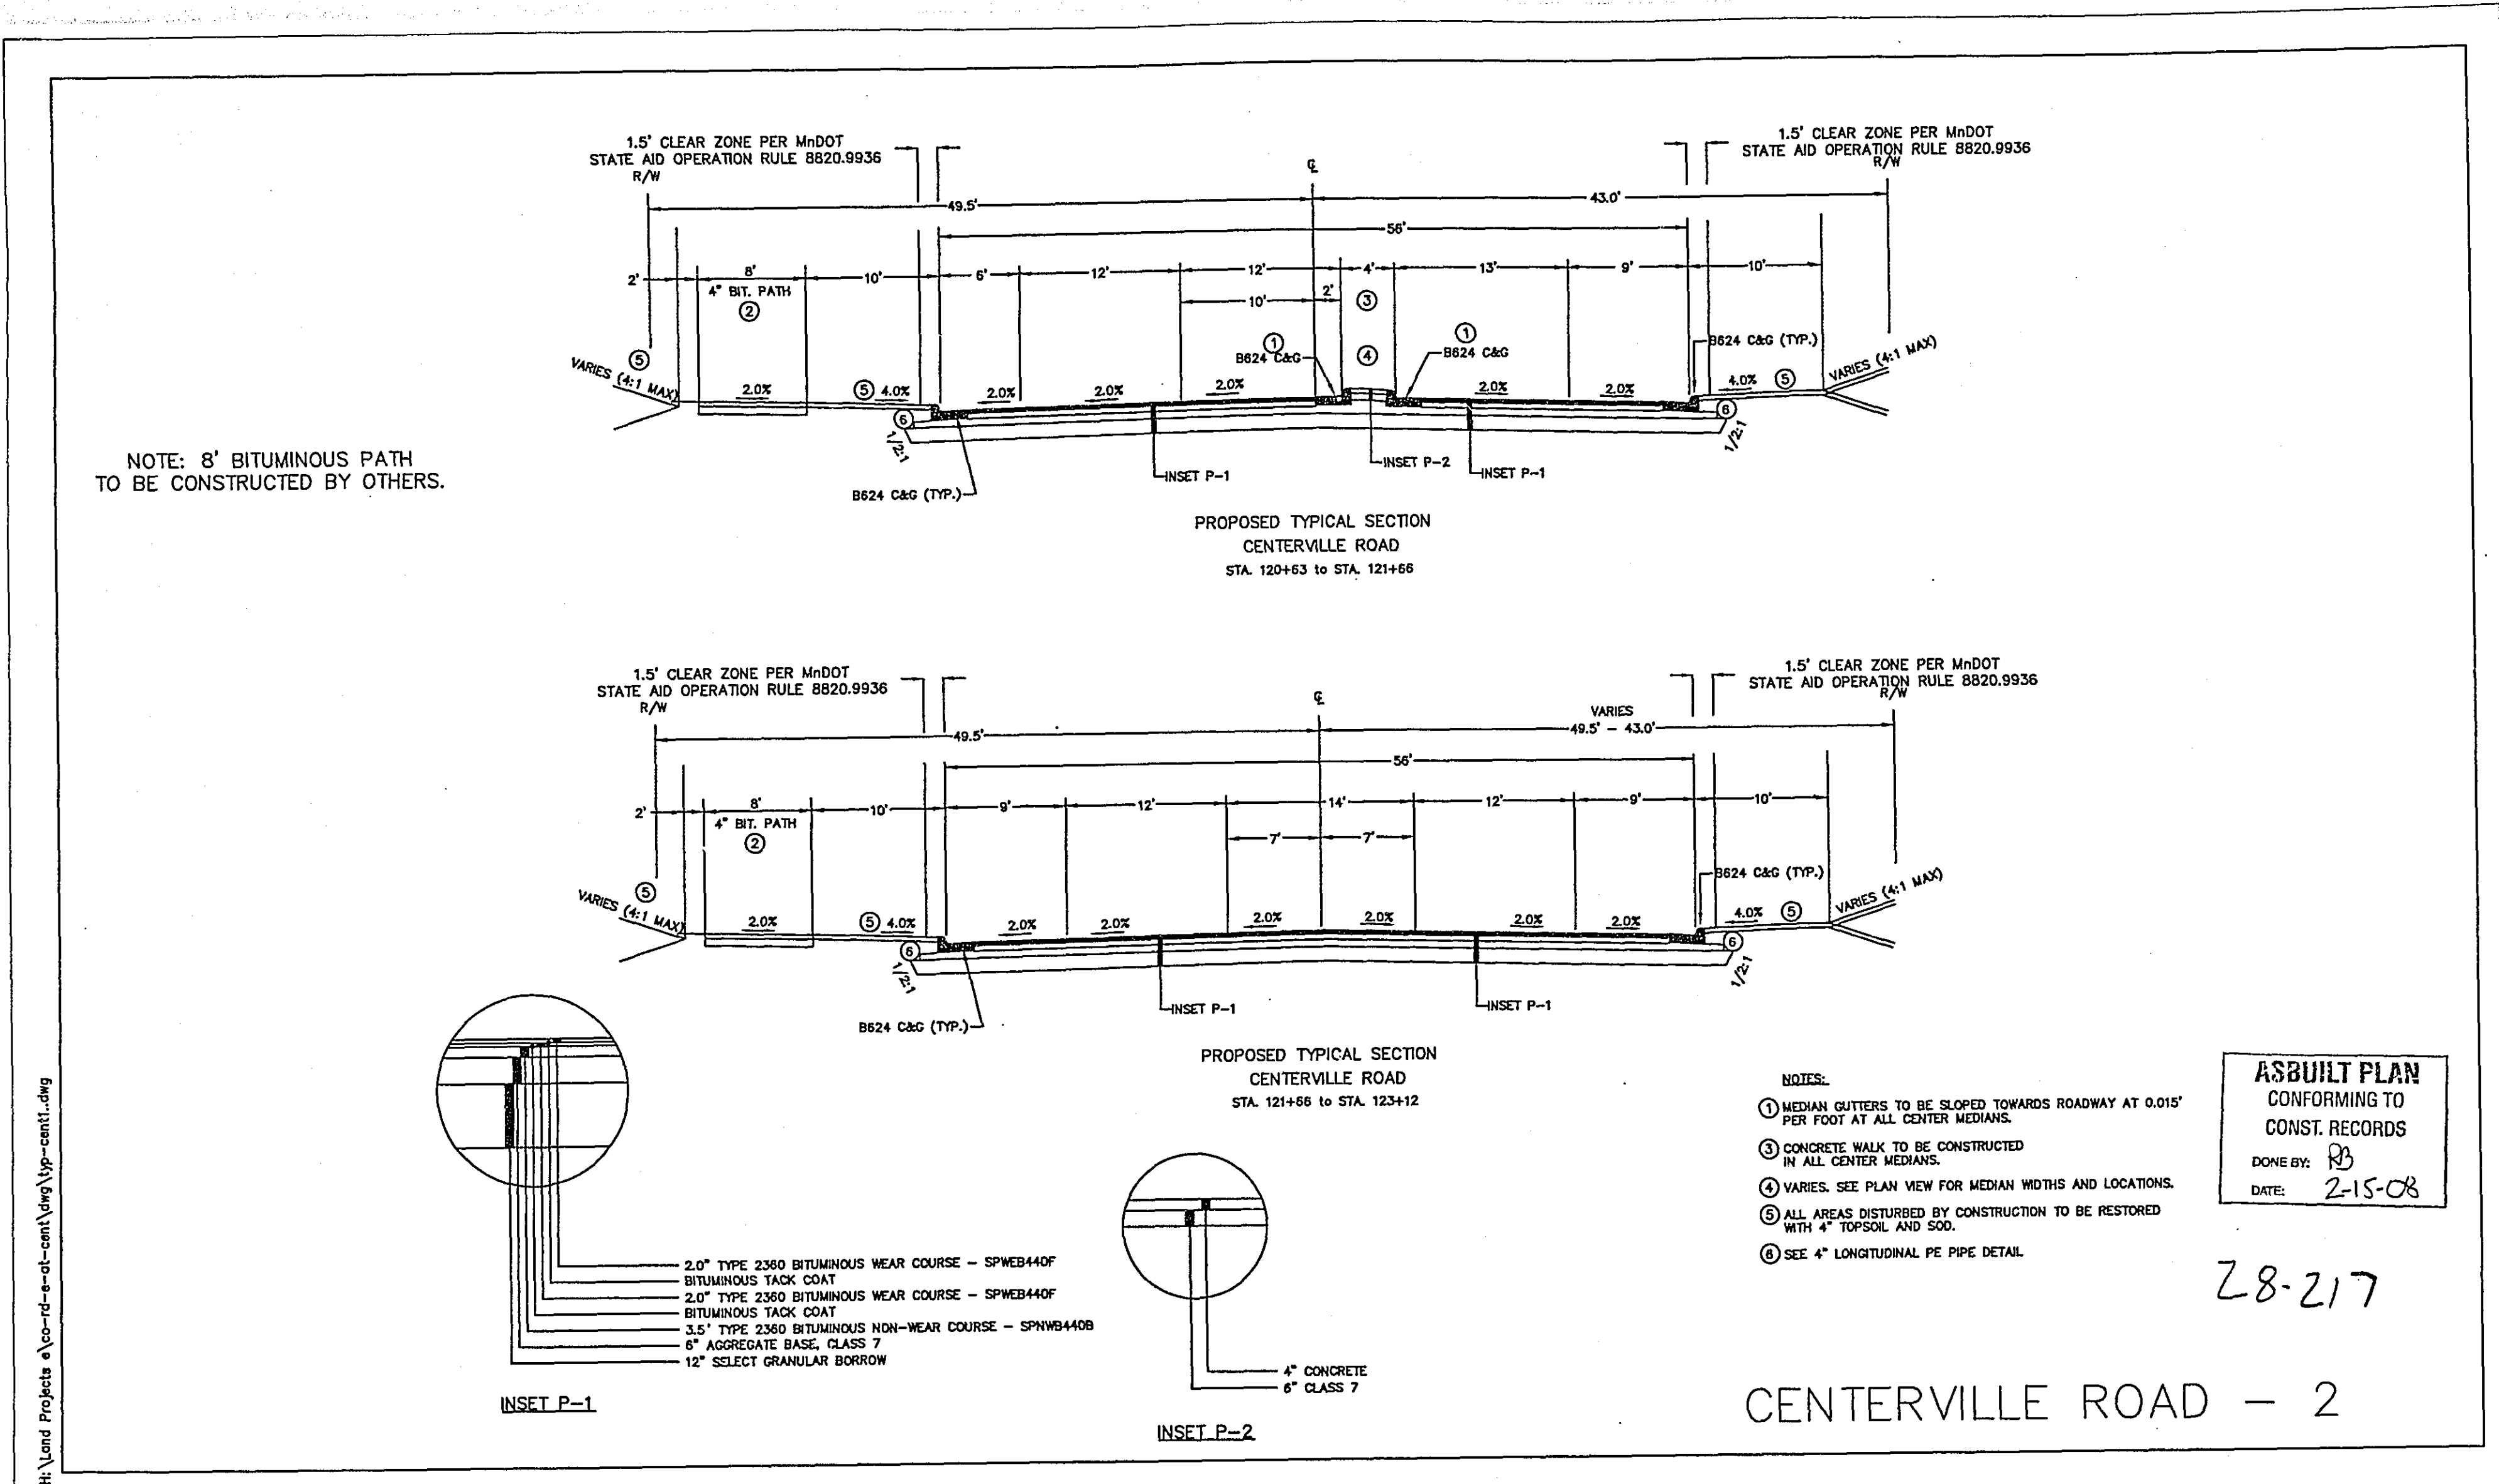

NO.	REV.	DATE	BY:	DESCRIPTION	PROJECT	S.A.P. 62-615-25 S.A.P. 62-614-02 S.A.P. 209-020-08	TYPICALS - CENTERVILLE RD.-2
1		2/15/08	RB	DATE: 2/15/08	County Rd. E at Centerville Rd.	County Proj. P-3161	Sheet No. 9 of 85 Sheets

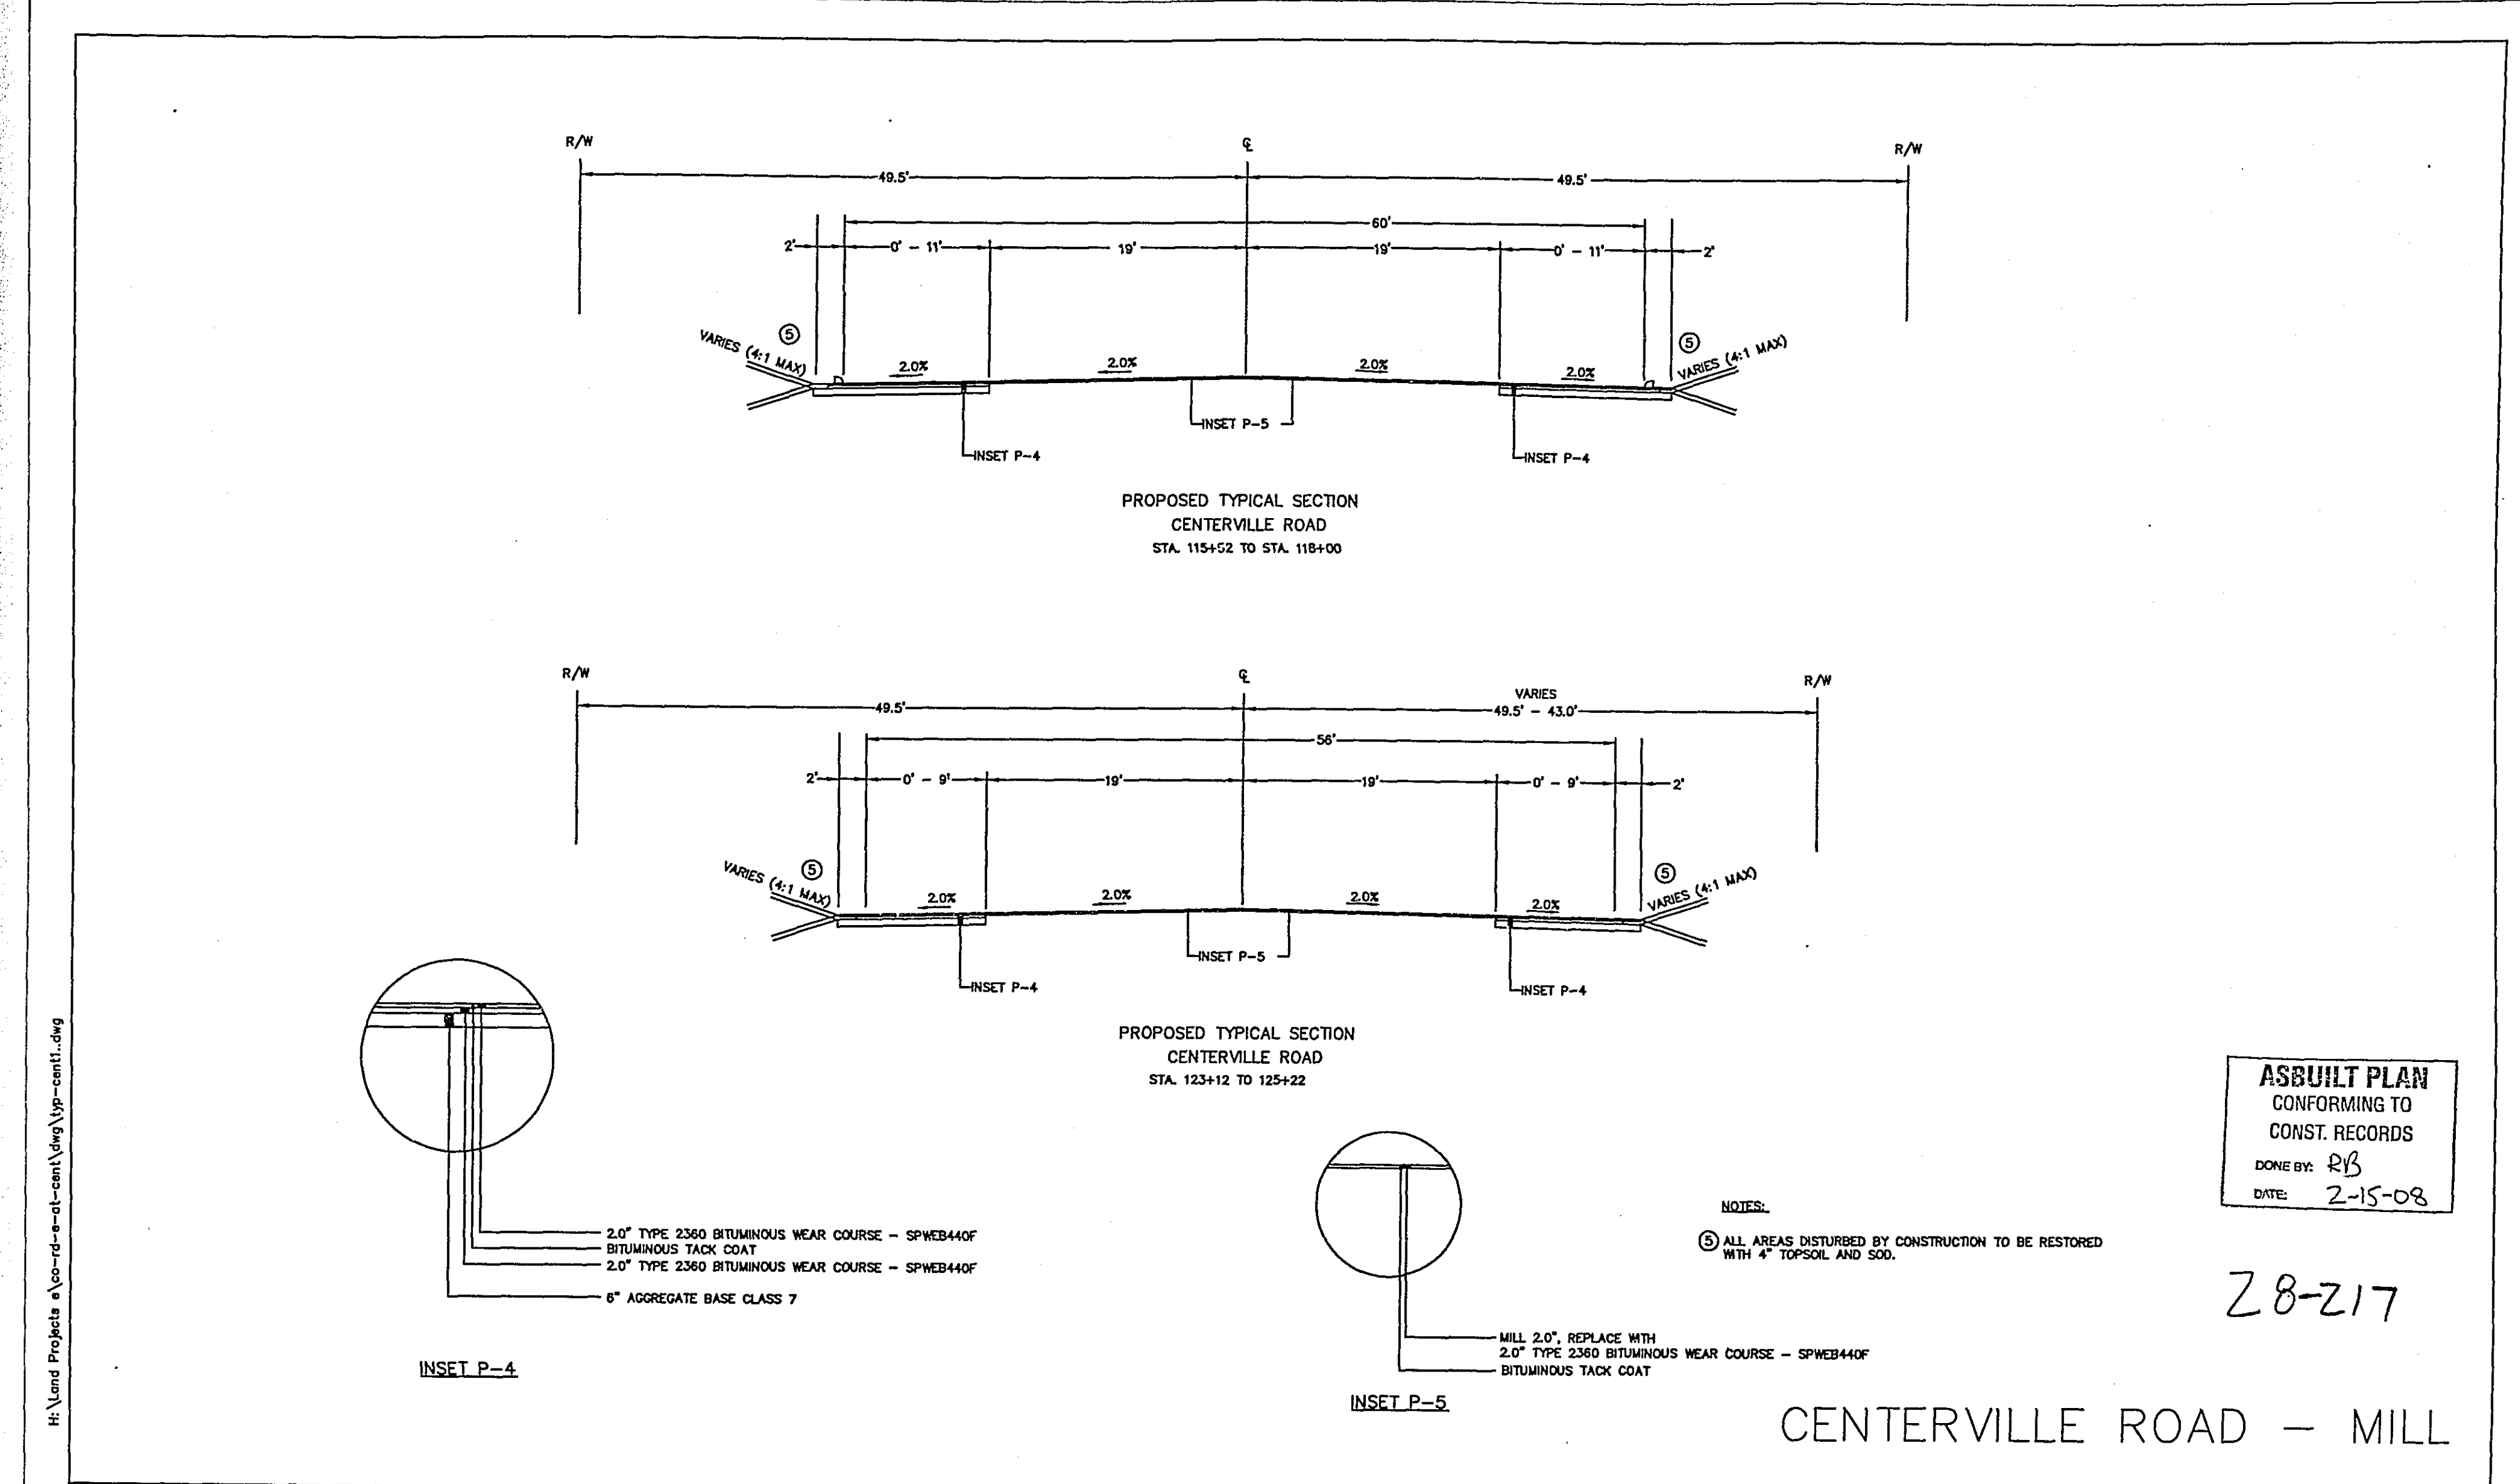

NO.	REV.	DATE	BY:	DESCRIPTION	PROJECT	S.A.P. 62-615-25 S.A.P. 62-614-02 S.A.P. 209-020-08	TYPICALS - CENTERVILLE RD.-MILL
1		2/15/08	RB	DATE: 2/15/08	County Rd. E at Centerville Rd.	County Proj. P-3161	Sheet No. 10 of 85 Sheets

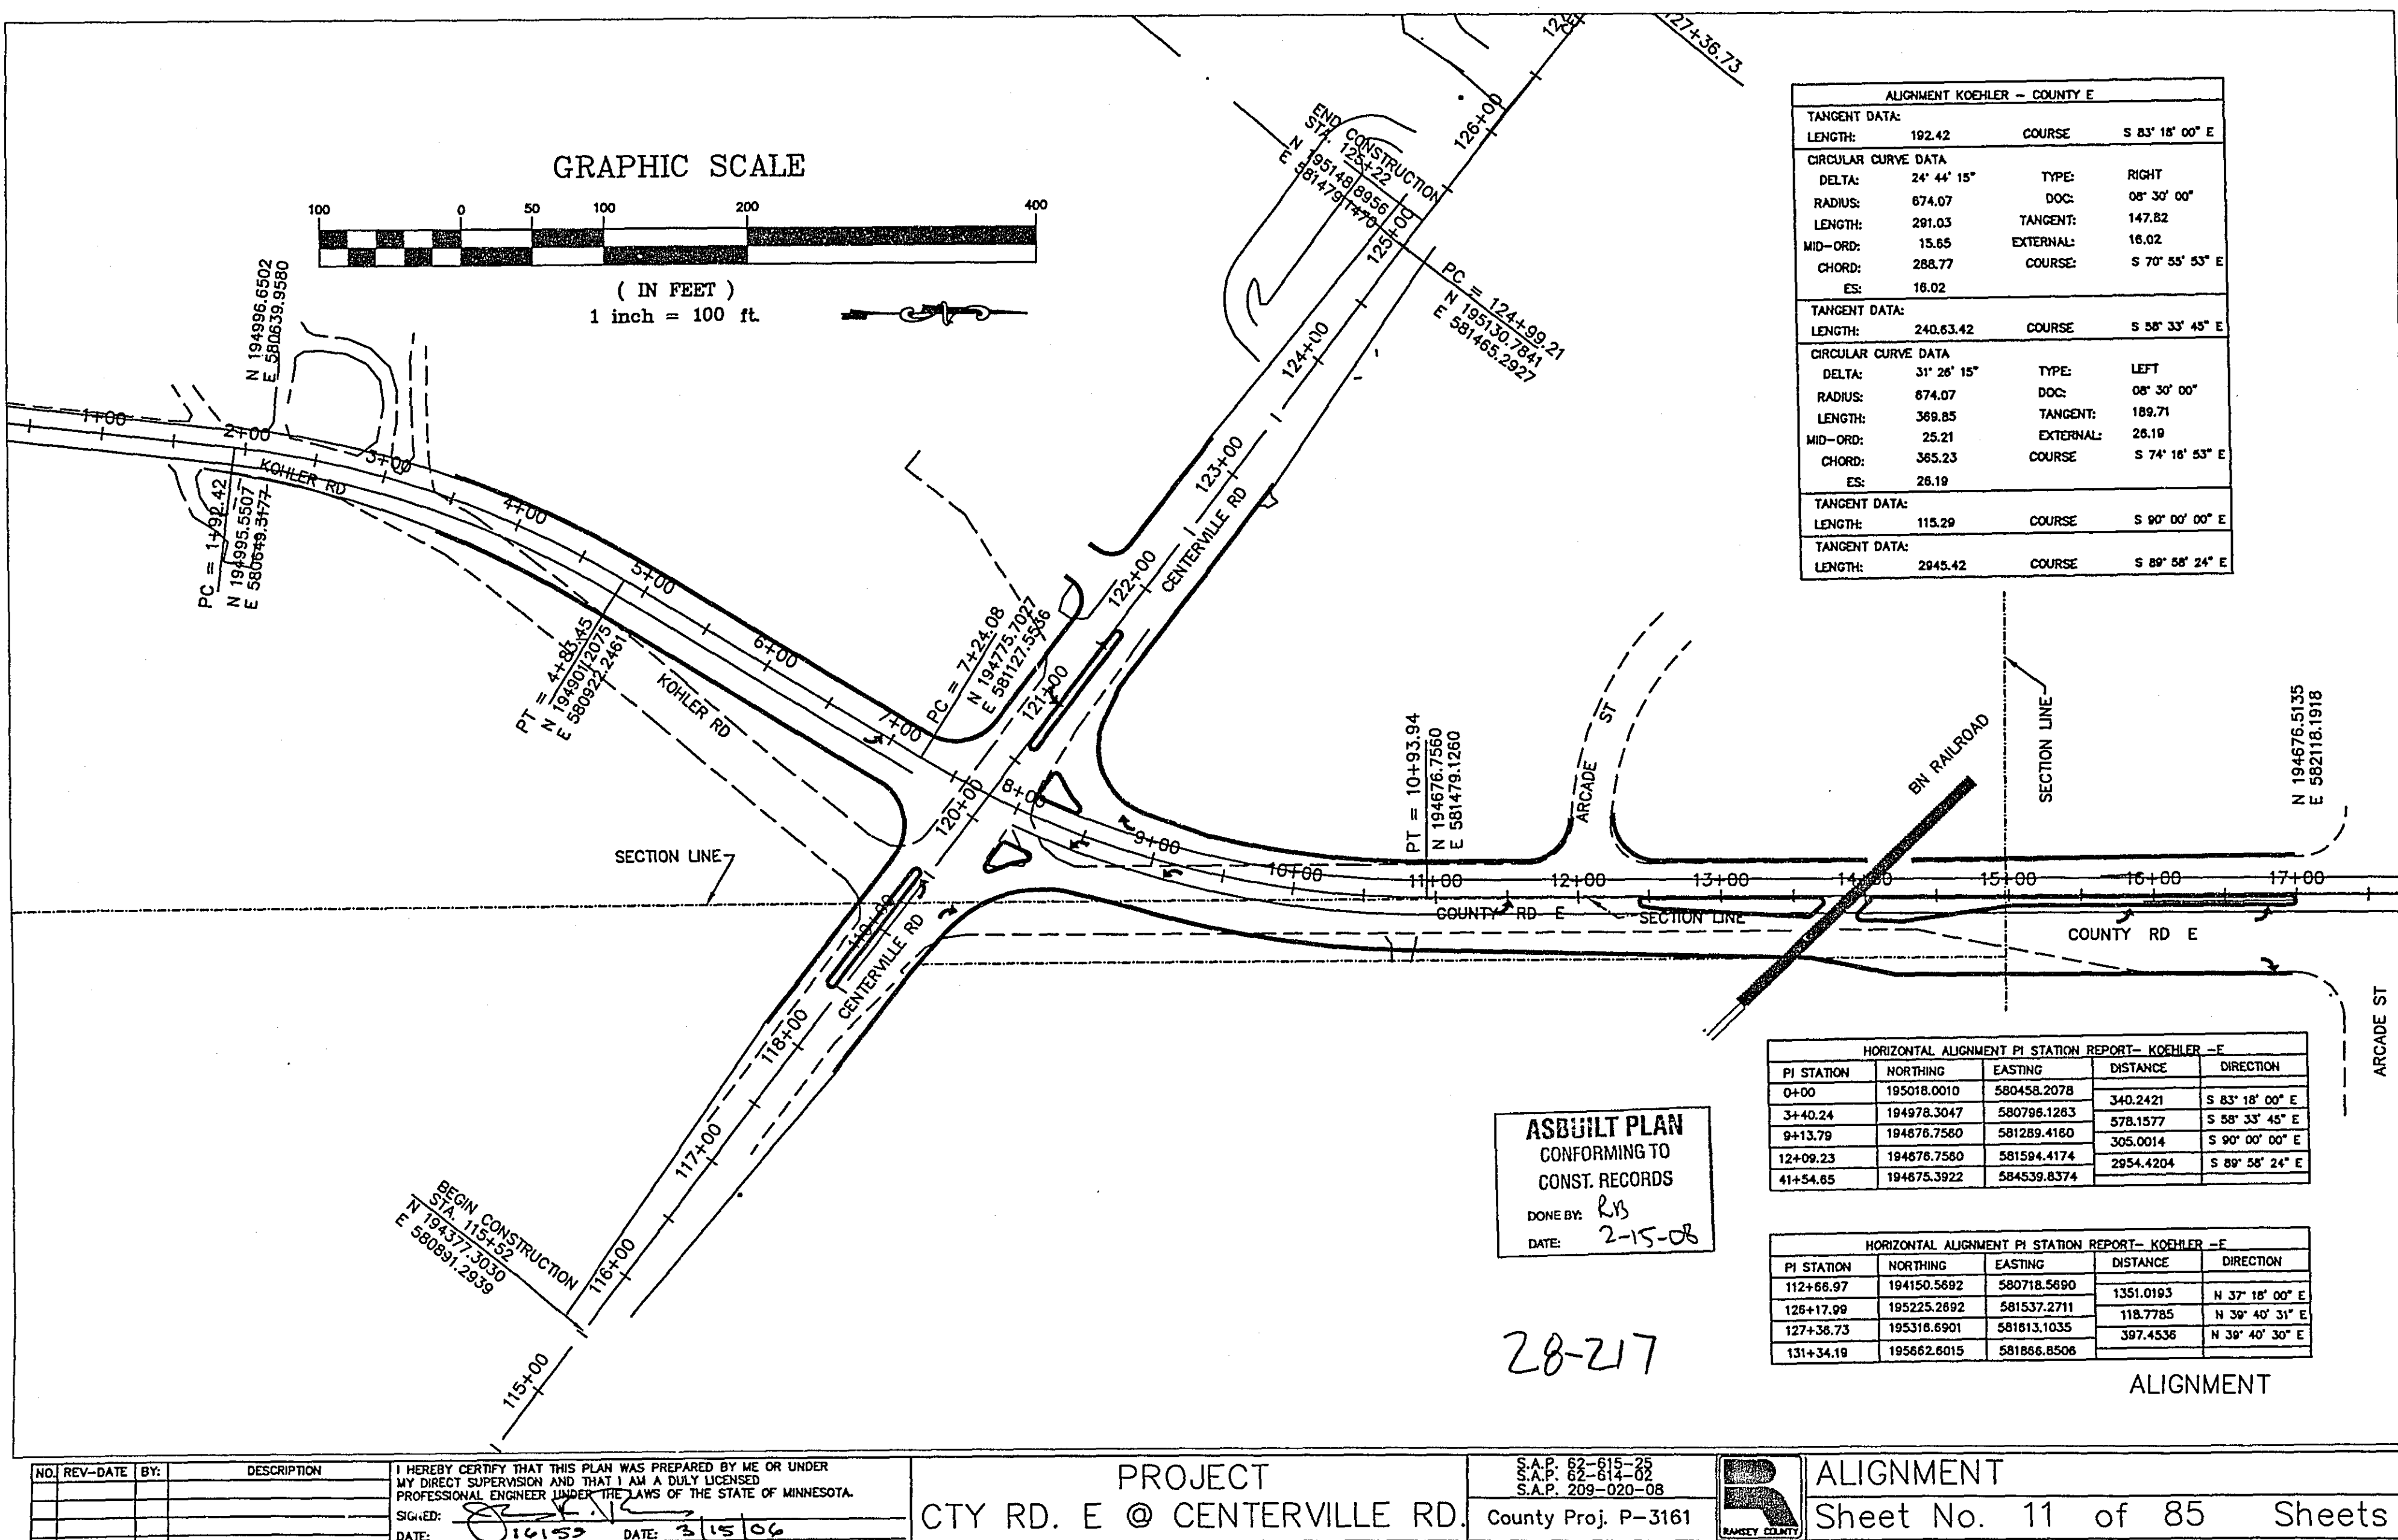

NO.	REV.	DATE	BY:	DESCRIPTION	PROJECT	S.A.P. 62-615-25 S.A.P. 62-614-02 S.A.P. 209-020-08	ALIGNMENT
1		2/15/08	RB	DATE: 2/15/08	CTY RD. E @ CENTERVILLE RD.	County Proj. P-3161	Sheet No. 11 of 85 Sheets

B MISCELLANEOUS REMOVALS									
STATION TO STATION	LOCATION	BIT. DRIVEWAY	BIT. WALK	BIT. CURB	CONC. CURB & GUTTER	CONC. WALK	CONC. DRIVEWAY	CONC. PVMT	
1+83 to 7+50	Koehler Road			56					
SW & NW of CENTERVILLE	Koehler Road								
SE & NE of CENTERVILLE	Koehler Road								
7+54 to 14+35	County Road E								
14+35 to 15+34	County Road E								
15+34 to 17+33	County Road E								
115+52 to 118+00 (MILL)	Centerville Road			496					
118+00 to 121+60	Centerville Road			101					
121+60 to 123+12	Centerville Road			210	100				
123+12 to 125+22 (MILL)	Centerville Road			77					
ARCADE STREET	ArCADE Street								
House #3562	Entrance	31							
House #3599	Entrance	25							
House #3580	Entrance								
House #3588	Entrance	47							
School (121+40 & 122+10)	Entrances	474							
School (North Entrance)	Entrance	52							
House #3630	Entrance	40							
House #3636	Entrance	39							
House #3644	Entrance	39							
2+25 Koehler	Entrance	31							
2+95 Koehler	Entrance	51							
3+25 Koehler	Entrance	60							
House #786	Entrance	64							
House #785	Entrance	18							
House #790	Entrance	53		109	22		27		
City Hall #800	Entrance				96		153		
8+10 to 17+33 LT	County Road E				959				
7+79 to 17+33 RT	County Road E				1025				
Pork Chop	County Road E				74				
15+93 to 17+00	County Road E				227	428			
122+25 to 123+25	Centerville Road				701				
10+60 RT	County Road E				30				
15+44 to 17+00	County Road E				1167				
TOTAL		1024		972	2580	2326	218	835	

NOTE: BITUMINOUS PAVEMENT REMOVAL IS INCIDENTAL TO COMMON EXCAVATION.

NOTE: EXCESS COMMON EXCAVATION SHALL BECOME THE PROPERTY OF THE CONTRACTOR. THE COST FOR DISPOSAL SHALL BE THE CONTRACTOR'S RESPONSIBILITY AND NO ADDITIONAL COMPENSATION WILL BE PAID OUTSIDE THE PRICE BID FOR COMMON EXCAVATION.

I HEREBY CERTIFY THAT THIS PLAN WAS PREPARED BY ME OR UNDER MY DIRECT SUPERVISION AND THAT I AM A DULY LICENSED PROFESSIONAL ENGINEER UNDER LAWS OF THE STATE OF MINNESOTA.

REG. NO. 16159 DATE 3/31/06

A CLEARING AND GRUBBING					
STATION TO STATION	LT or RT	LOCATION	CLEARING TREE	GRUBBING TREE	ACRE
1+83 to 4+50	LT 20'-30'	Koehler Road	3	0.06	3
1+83 to 4+50	RT 38'-50'	Koehler Road	9	0.01	9
8+50 to 12+00	LT 30'-55'	County Road E	6	0.03	6
8+50 to 12+00	RT 50'-100'	County Road E	1	0.06	1
15+00 to 16+50	LT 35'-45'	County Road E	9		9
117+00 to 118+50	LT 40'	Centerville Road	1		1
117+00 to 118+50	RT 35'-50'	Centerville Road	5		5
121+00 to 122+50	RT 25'-50'	Centerville Road	8		8
124+00 to 124+50	RT 30'-35'	Centerville Road	2		2
TOTAL			44	0.16	44

C RELOCATE MAILBOX		
HOUSE NO.	LT or RT	QUANTITY EACH
3562	RT	1
3574	RT	1
3580	RT	1
3588	RT	1
3599	LT	1
3605	LT	1
3630	RT	1
3636	RT	1
3644	RT	1
785	LT	1
786	LT	1
789	LT	1
790	RT	1
793	LT	1
TOTAL		14

D EARTHWORK SUMMARY		
COMMON EXCAVATION (C.Y.) (EV) (P)		TOTALS
KOEHLER RD	1857	
COUNTY RD E	5982	
CENTERVILLE ROAD	1557	9396 CY
COMMON BORROW (C.Y.) (LV) (P)		
KOEHLER RD	2196	
COUNTY RD E	124	
CENTERVILLE ROAD	119	2439 CY
SELECT GRANULAR BORROW (C.Y.) (LV) (P)		
KOEHLER RD	1625	
COUNTY RD E	2026	
CENTERVILLE ROAD	331	3982 CY

ASBUILT PLAN
CONFORMING TO
CONST. RECORDS
DONE BY: RB
DATE: 2-15-08

28-217

TABULATION CHARTS

E AGGREGATE & BITUMINOUS SUMMARY FOR ROADWAY & ENTRANCES									
STATION TO STATION	LOCATION	AGG. BASE CL. 7 SPEC. C.Y.	BITUMINOUS MIXTURE					TACK COAT GALLON	
			SPWEB440F 4" TON	Roadway		Entrances			
					SPNWB430B 3.5" TON	LVWE 35035B 2" TON	LVNW35035B 2" TON		
1+83 to 5+78	Koehler Road	313.10	410.30		359.01				1865
5+78 to 7+50	Koehler Road	163.40	185.02		161.89				841
7+50 to 8+25	Intersection	190.40	222.20		194.43				1010
8+25 to 10+94	County Road E	335.30	394.46		345.15				1793
10+94 to 12+40	County Road E	166.00	219.56		192.12				998
12+40 to 17+33 WB	County Road E	285.80	289.30		253.14				1315
12+40 to 14+23 EB	County Road E	124.70	172.00		115.50				606
14+23 to 17+33 EB	County Road E	27.30	310.64		271.81				1412
118+00 to 118+47	Centerville Road	55.10	64.24		56.21				292
118+47 to 119+49	Centerville Road	119.60	119.68		104.72				544
119+49 to 120+63 dup.	Intersection	above			above				above
120+63 to 121+66	Centerville Road	113.10	110.88		97.02				504
121+66 to 123+12	Centerville Road	160.30	185.68		162.47				844
115+92 to 118+00	Mill Centerville Road	119.40	268.64						1212
123+12 to 125+22	Mill Centerville Road	85.60	207.90						945
Arcade Street		25.68	30.36		26.57				138
Ho. #3562		4.83				3.19		3.19	14.5
Ho. #3574		4.83				3.19		3.19	14.4
Ho. #3599		2.67				1.76		1.76	8
Ho. #3580		1.67							
Ho. #3588		4.17				2.74		2.74	12.5
Ho. #3605		6.67				4.40		4.40	20
#3645 School		4.50				2.97		2.97	13.5
Ho. #3630		2.50				1.65		1.65	7.5
Ho. #3636		4.33				2.86		2.86	13
Ho. #3644		6.17				4.07		4.07	18.5
2+25 Koehler		6.17				4.07		4.07	18.5
2+95 Koehler		5.67				3.74		3.74	17
3+25 Koehler		5.50				3.63		3.63	16.5
Ho. #786		40.33				26.62		26.62	121
Ho. #785		3.67				1.10		1.10	5
Ho. #790		3.50				1.21		1.21	5.5
#600 City Hall		12.04							
TOTAL		2674.00	3188.86		2340.04	67.20		67.20	14618.40

ASBUILT PLAN
CONFORMING TO
CONST. RECORDS
DONE BY: RB
DATE: 2-15-08

I HEREBY CERTIFY THAT THIS PLAN WAS PREPARED BY ME OR UNDER MY DIRECT SUPERVISION AND THAT I AM A DULY REGISTERED PROFESSIONAL ENGINEER UNDER LAWS OF THE STATE OF MINNESOTA.

REG. NO. 16159 DATE: 3/31/06

28-217

S.A.P. 62-615-25, S.A.P. 62-614-02, S.A.P. 209-020-08

SHEET 13 of 85 SHEETS

F SAWCUT PAVEMENT					
STATION TO STATION	LOCATION	SAW BIT. P.V.M.T. LIN. FT.	SAW CONC. P.V.M.T. LIN. FT.	REMARKS	
1+83	Koehler Road	32		Begin Reconstruction	
17+33	County Road E	81		End Reconstruction	
115+52	Centerville Road	38		Begin Reconstruction	
125+22	Centerville Road	38		End Reconstruction	
Arcade Street		30			
House # 3562		17		Entrance	
House # 3599		11		Entrance	
House # 3580			23	Entrance	
House # 3588		21		Entrance	
School (121+40 & 122+10)		107		Entrance	
School (North Entrance)		20		Entrance	
House #3630		21		Entrance	
House #3636		19		Entrance	
House #3644		20		Entrance	
2+25 Koehler		10		Entrance	
2+95 Koehler		11		Entrance	
3+25 Koehler		11		Entrance	
House #786		40		Entrance	
House #785		17	6	Entrance C&G	
House #790		14		Entrance	
City Hall #800			32	Entrance C&G	
17+33 LT & RT			6	Curb & Gutter	
Arcade Street			6	Curb & Gutter	
TOTAL		558	73		

G WATERMAIN				
STATION	LOCATION	ITEM	OWNER	REMARKS
4+47 RT 65	Koehler Road	HYD	VH	Remove, Install
	Koehler Road	GV	VH	Install
7+08 RT 105	Koehler Road	HYD	VH	Remove, Install
7+15 RT 102	Koehler Road	GV	VH	Remove, Install
8+22 RT 5	County Road E	GV	VH	Adjust
9+10.88 RT 56	County Road E	WSO	VH	Adjust
10+45 RT 45	County Road E	WSO	VH	Adjust
11+45 LT 43	County Road E	WSO	VH	Adjust
11+72 LT 46	County Road E	HYD	VH	Adjust
12+02 LT 43	County Road E	GV	VH	Adjust
14+64 RT 39	County Road E	GV	VH	Salvage & Relocate
14+64 RT 45	County Road E	HYD	VH	Salvage & Relocate
17+62 RT 46	County Road E	GV	VH	OK
119+74 LT 28	Centerville Road	GV	VH	Adjust
121+70 RT 34	Centerville Road	WSO	VH	Adjust
122+80 LT 34	Centerville Road	HYD	VH	Adjust
123+35 RT 51	Centerville Road	WSO	VH	OK
123+75 LT 45	Centerville Road	GV	VH	OK
124+13 RT 51	Centerville Road	WSO	VH	OK
124+24 LT 33	Centerville Road	HYD	VH	OK

TABULATION CHARTS

S.A.P. 62-615-25, S.A.P. 62-614-02, S.A.P. 209-020-08

SHEET 13 of 85 SHEETS

H CONCRETE TABULATION											
STATION TO STATION	LOCATION	CURB & GUTTER				4" CONC. WALK SQ. FT.	6" DRIVEWAY P.V.M.T. SQ. YD.	MED NOSE EACH	PED CURB RAMP EACH		
		B624 LIN. FT.	B618 LIN. FT.	B612 LIN. FT.	S512 LIN. FT.						
118+50 to 119+46 Median	Centerville Road	205					384				
120+66 to 121+62 Median	Centerville Road	205					384				
12+46 to 17+00 Median	County Road E	872					3128				
8+20 to 17+28 RT	County Road E	873					8150				
8+32 to 11+90 LT	County Road E	358					2483				
12+28 to 17+28 LT	County Road E	458					3916				
Pork Chop LT	County Road E	81					272				
Pork Chop RT	County Road E	67					213				
NE, SE QUAD.	Centerville Road										
ARCADIE STREET	County Road E										
17+33 LT	County Road E										
115+94 to 119+46 LT	Centerville Road	176									
115+94 to 119+26 RT	Centerville Road	176									
120+65 to 123+12 LT	Centerville Road	274									
120+65 to 123+12 RT	Centerville Road	241									
3+47 to 7+20 LT	Koehler Road	403				1295					
3+47 to 7+20 RT	Koehler Road	385									
House #3580											
House #785							15				
House #786							30				
House #790							30				
City Hall							10				
TOTAL		4774	0	0	0	20225	157	14	13		

ASBUILT PLAN
CONFORMING TO
CONST. RECORDS
DONE BY: RB
DATE: 2-15-08

28-217

I HEREBY CERTIFY THAT THIS PLAN WAS PREPARED BY ME OR UNDER MY DIRECT SUPERVISION AND THAT I AM A DULY REGISTERED PROFESSIONAL ENGINEER UNDER LAWS OF THE STATE OF MINNESOTA.

REG. NO. 16159 DATE: 3/31/06

S.A.P. 62-615-25, S.A.P. 62-614-02, S.A.P. 209-020-08

TABULATIONS CHARTS
SHEET 14 of 85 SHEETS

EXISTING STORM SEWER AND CULVERT TABULATION																		
NO.	ROAD	STA.	OFFSET LT or RT	TYPE	CSTG ASSMBY TYPE	PROPOSED PROFILE ELEVATION	ORIGINAL GRATE OR RING	NEW GRATE OR RING	CB/MH, APRON INVERT	REMOVE CATCH BASIN	REMOVE MH	SALVAGE AP	RECON CB OR MH EACH	ADJ FRAME & RING CAST. EACH	REMOVE CONC. PIPE LF	SALVAGE CASTING ASSEM. EACH	DRAINS TO	REMARKS
1	County Road E	7+89	RT 51	MH-Storm	R-1733	923.54	923.16	923.15	923.96									
1A	County Road E	7+32	RT 26	MH-Storm	R-1733	923.14	920.23	922.57	909.23		1		1				1	27
2	County Road E	8+49	RT 43	MH-Storm	R-1733	922.97	922.46	922.37	909.66					1				26
2A	County Road E	8+43	LT 24	MH-Storm	R-1733	922.73	921.54	NA	918.54		1			1			1A	2
3	County Road E	10+49	LT 3	MH-Storm	R-1733	921.18	921.33	921.07	910.33					1				2
4	County Road E	10+48	LT 24	Catch Basin	LP-4	921.18	921.21	NA	917.01	1								2
5	County Road E	10+52	RT 30	Catch Basin	LP-4	921.18	921.15	NA	916.85									3
5A	County Road E	10+38	LT 101	Apron-Storm	-----	-----	-----	920.81	-----	1								4
6	County Road E	12+14	LT 20	MH-San	-----	922.00	921.53	921.55	905.13					1				5
7	County Road E	11+99	LT 77	Catch Basin, RC	R-3067	921.98	921.17	-----	918.37									6
8	County Road E	12+23	LT 71	Catch Basin, RC	R-3067	921.99	921.14	-----	918.14									8
9	County Road E	12+38	LT 4	MH-Storm	R-1733	921.92	922.11	921.79	910.91					1				9
10	County Road E	12+41	LT 25	Catch Basin, RC	R-3067	921.91	921.55	921.36	917.55	1								9
11	County Road E	13+51	LT 6	MH-Storm	R-1733	922.39	922.76	922.22	911.66									10
12	County Road E	13+98	LT 47	Apron-Storm	-----	922.58	-----	-----	920.09					1				11
13	County Road E	14+42	LT 5	MH-Storm	R-1733	922.25	922.62	922.10	911.82									11
14	County Road E	14+71	LT 37	SD-Storm	NOTE 1	921.74	921.05	921.32	917.05					1				12
15	County Road E	15+22	LT 21	MH-San	R-1642	920.31	921.64	919.84	906.44									13
16	County Road E	16+78	LT 6	MH-Storm	R-1733	920.81	920.76	920.64	912.26									13
17	County Road E	16+75	LT 31	Catch Basin	LP-4	920.83	920.81	-----	916.51				1	1				14
18	County Road E	16+76	RT 57	Catch Basin	LP-4	920.82	920.98	-----	917.78				1	1				16
18A	County Road E	17+01	RT 54	MH-Tel	X	920.66	919.85	910.75	-----				1	1				16
19	County Road E	17+78	LT 21	MH-San	R-1642	920.16	919.43	NA	907.8									16
20	Koehler Road	3+40	LT 2	MH-San	R-1642	914.50	914.74	914.41	886.34									15
24A	Koehler Road	+4+62	LT 140	MH-San	R-1642	914.66	908.95	NA	901.32									27
25	Koehler Road	+4+48	LT 24	Apron-Storm	-----	914.80	-----	-----	908.24			1						O.K.
26	Koehler Road	+4+54	LT 10	MH-San	A-7	914.95	912.33	914.71	908.13		1					10		O.K.
27	Koehler Road	+4+45	RT 12	MH-San	R-1642	914.73	912.65	914.45	X				2				25	RECONSTRUCT - CONVERT TO SP-2
30	Centerville Road	118+76	LT 14	MH-San	R-1642	922.80	922.27	922.47	914.90								1	RECONSTRUCT - CONVERT TO SP-2
30A	Centerville Road	123+39	LT 424	MH-San	R-1642	926.87	910.2	NA	904.50								X	ADJUST BY OTHERS
31	Centerville Road	123+70	RT 20	MH-San	R-1642	927.12	927.09	926.67	915.89			1						O.K.
32	Centerville Road	126+54	LT 17	MH-Tel	X	NA	928.43	NA	914.90								1	ADJUST BY OTHERS
33	Centerville Road	127+70	RT 20	MH-San	R-1642	NA	927.96	NA	918.76					1				31
34	Centerville Road	129+26	LT 45	MH, RC2	A-7	925.78	925.97	-----	920.57								1	CONVERT TO MH
35	Centerville Road	122+40	LT 51	MH-Storm	-----	925.90	924.79	-----	920.69				1					31
36	Centerville Road	123+76	LT 54	MH, RC2	A-7	926.76	926.76	-----	922.36								1	31 O.K. A-7
37	Centerville Road	124+14	LT 52	MH, RC2	A-7	927.46	926.7	-----	922.70									36 O.K. A-7
TOTAL										4	3	1	8	16	10	7		

