
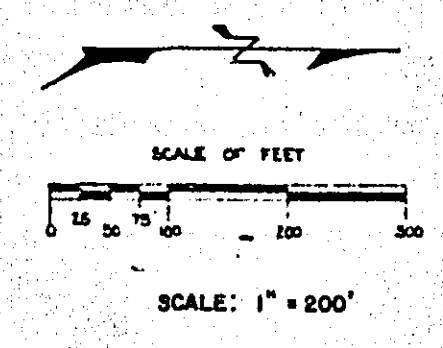


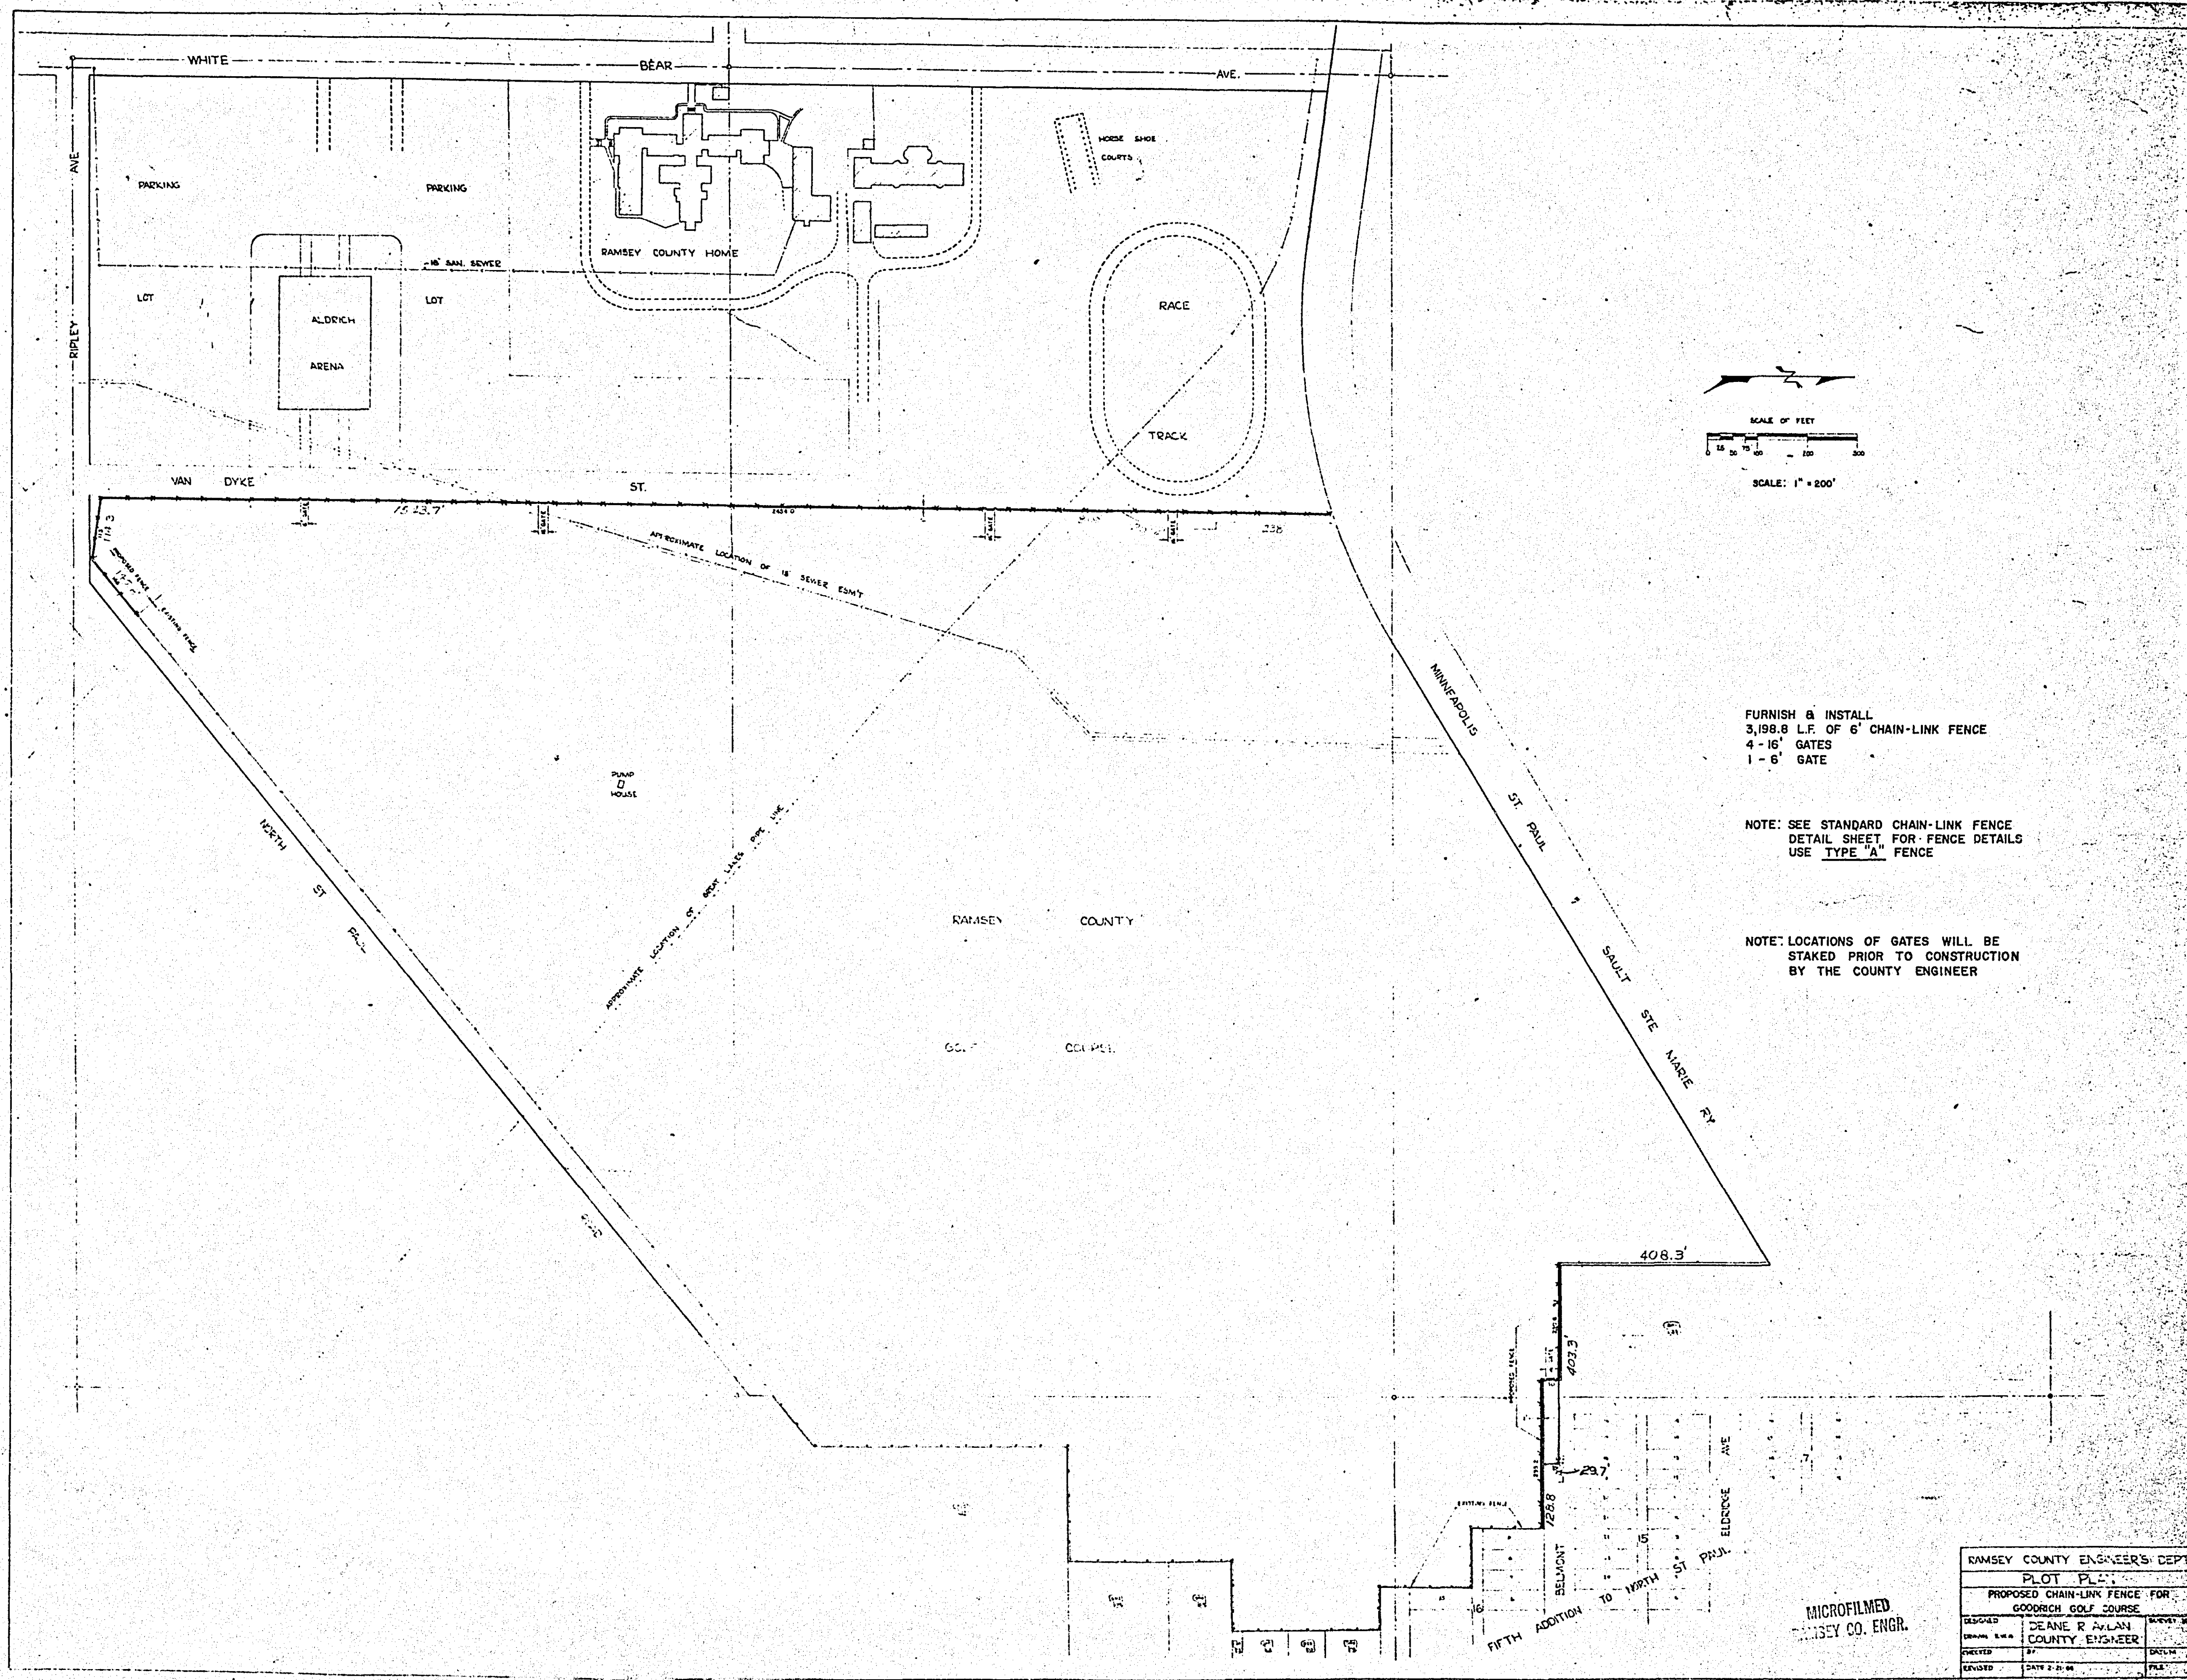


FURNISH & INSTALL
3,198.8 L.F. OF 6" CHAIN-LINK FENCE
4 - 16' GATES
1 - 6' GATE

NOTE: SEE STANDARD CHAIN-LINK FENCE
DETAIL SHEET FOR FENCE DETAILS
USE TYPE "A" FENCE

NOTE: LOCATIONS OF GATES WILL BE
STAKED PRIOR TO CONSTRUCTION
BY THE COUNTY ENGINEER

MICROFILMED
RAMSEY CO. ENGR.

RAMSEY COUNTY ENGINEER'S DEPT.		
PLOT PLAN		
PROPOSED CHAIN-LINK FENCE FOR		
GOODRICH GOLF COURSE		
DESIGNED	DEANE R. AVLAN	SURVEYED
DRAWN	RAMSEY COUNTY ENGINEER	CHECKED
REVIEWED		FILED
REVISED	DATE 2-21-64	

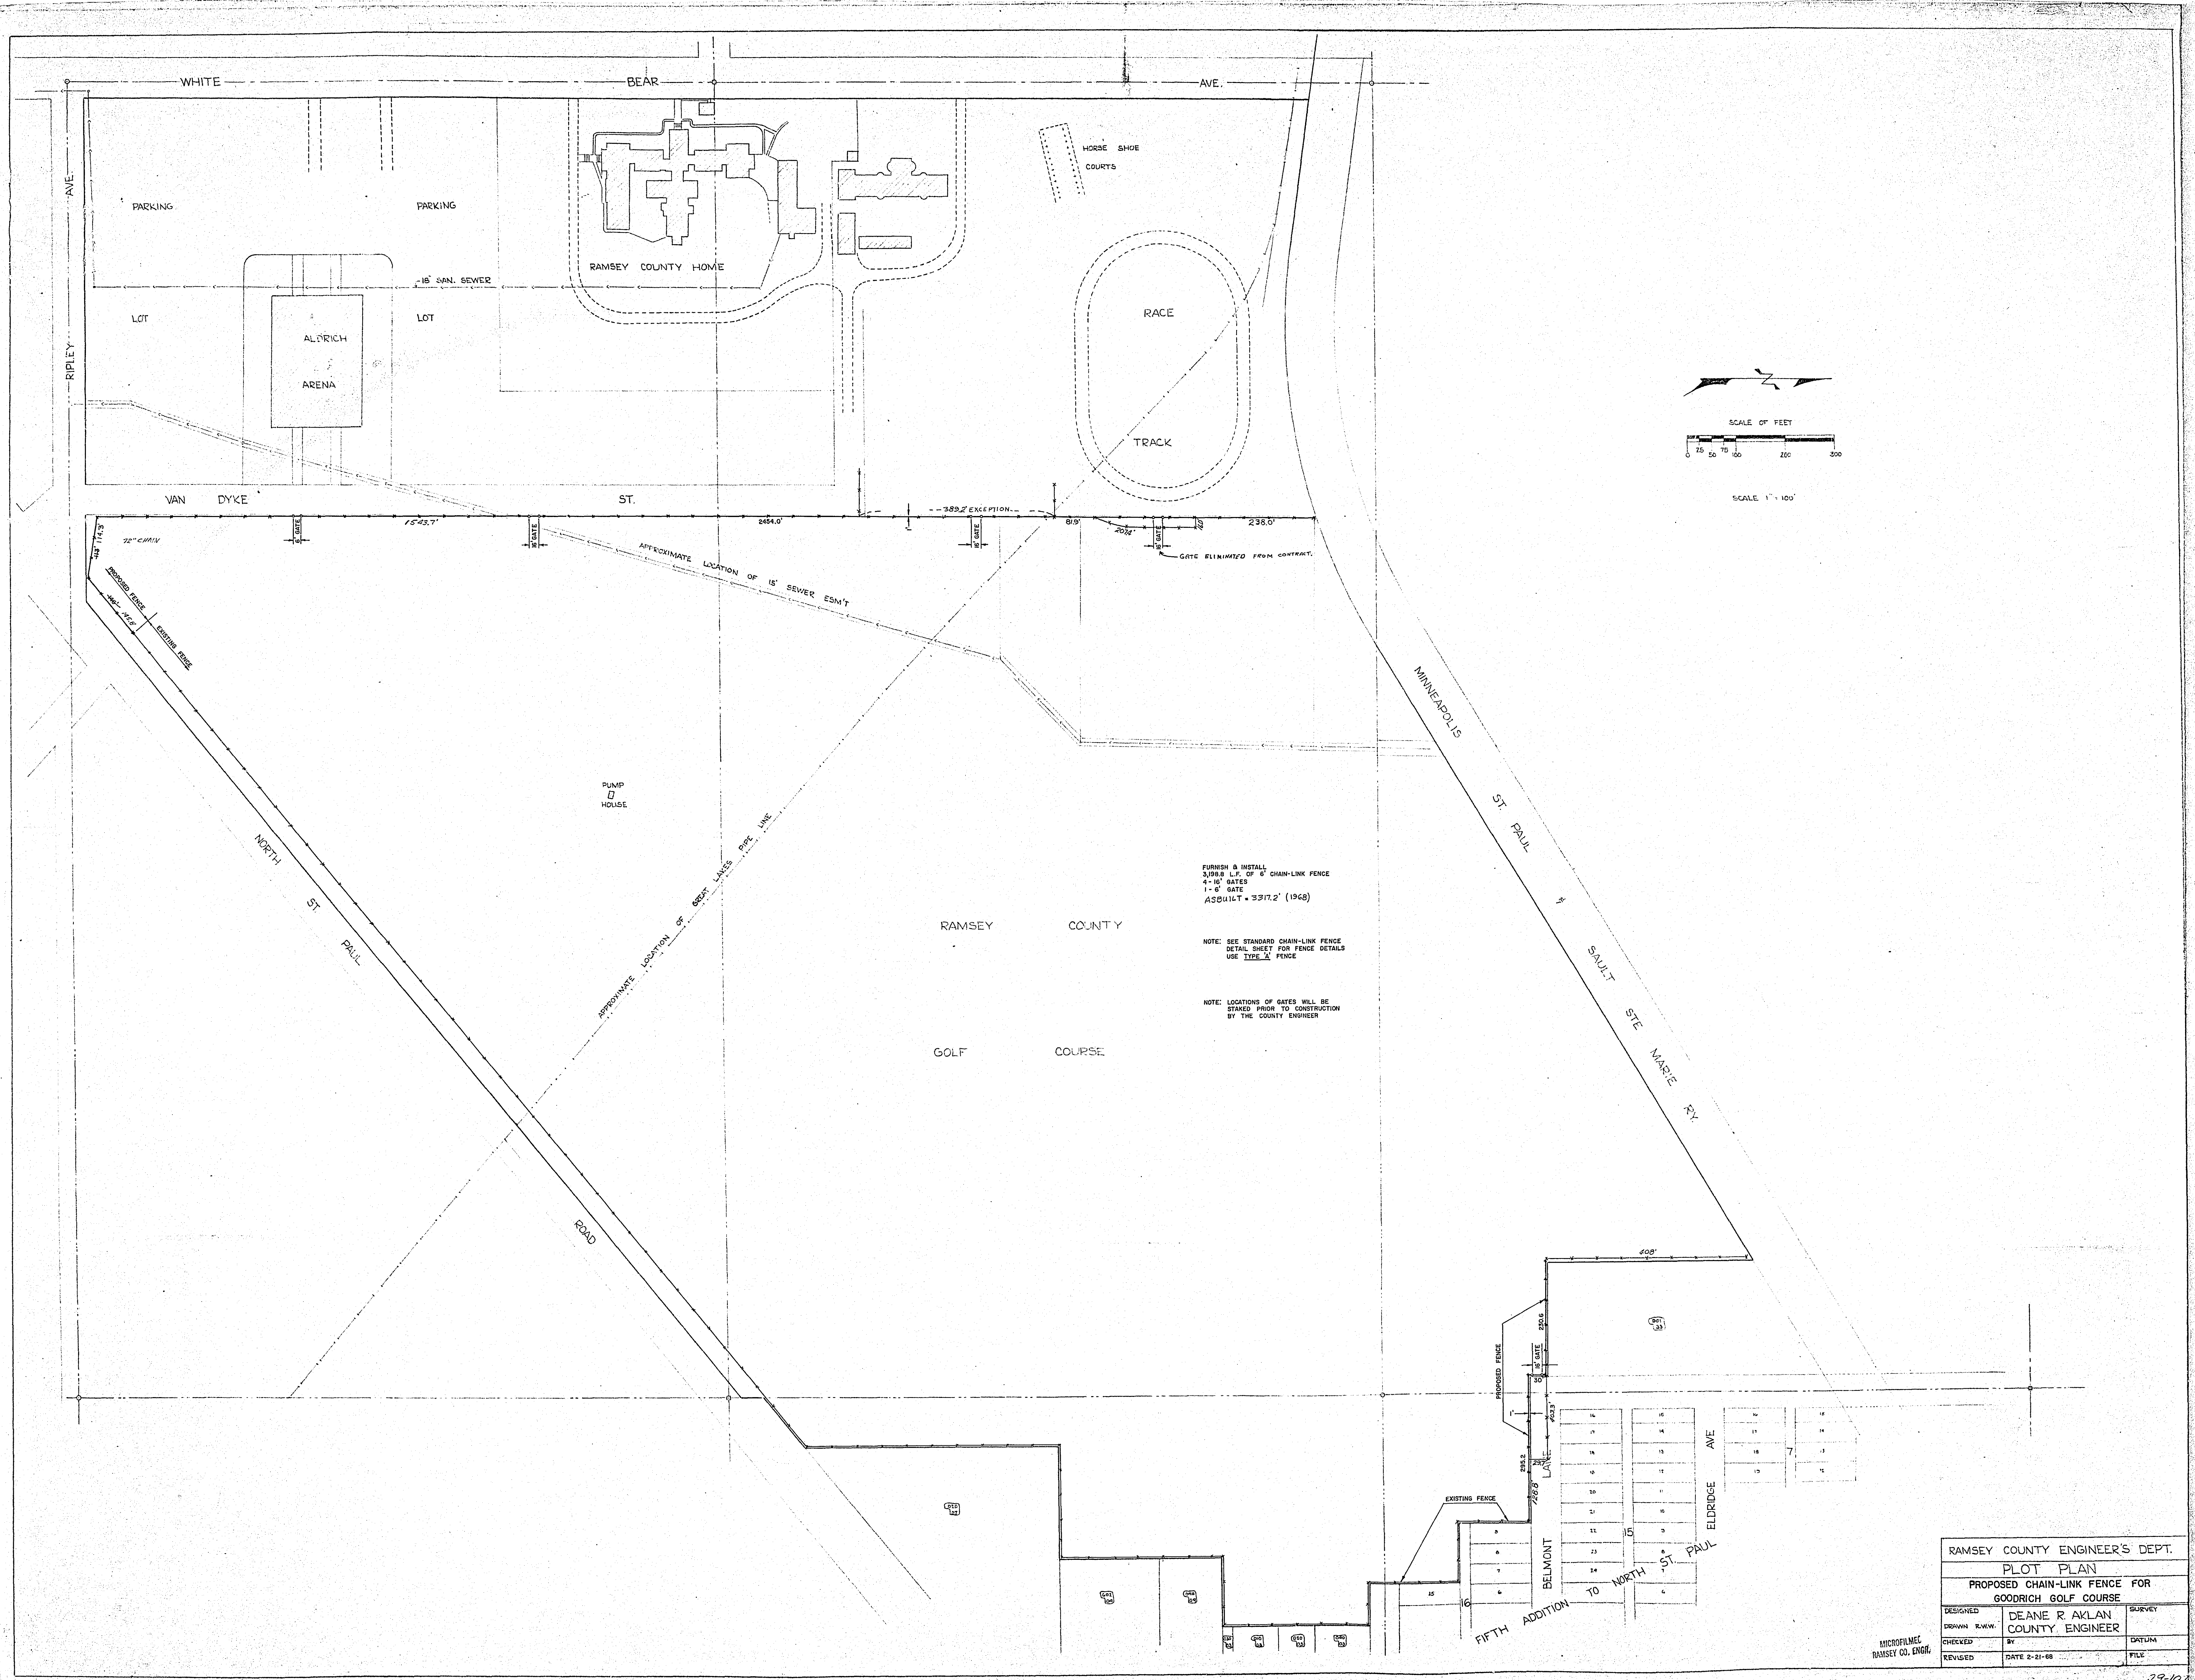

FURNISH & INSTALL
3,998.8 L.F. OF 6" CHAIN-LINK FENCE
4-16' GATES
1-8' GATE
ASBUILT = 3317.2' (1968)

NOTE: SEE STANDARD CHAIN-LINK FENCE
DETAIL SHEET FOR FENCE DETAILS
USE TYPE A FENCE

NOTE: LOCATIONS OF GATES WILL BE
STAKED PRIOR TO CONSTRUCTION
BY THE COUNTY ENGINEER

RAMSEY COUNTY ENGINEER'S DEPT.			
PLOT PLAN			
PROPOSED CHAIN-LINK FENCE FOR			
GOODRICH GOLF COURSE			
DESIGNED	DEANE R. AKLAN	SURVEY	
DRAWN R.M.W.	COUNTY ENGINEER	DATUM	
CHECKED	BY	FILE	
REVISED	DATE 2-21-68		

MICROFILMED
RAMSEY CO. ENGINEER