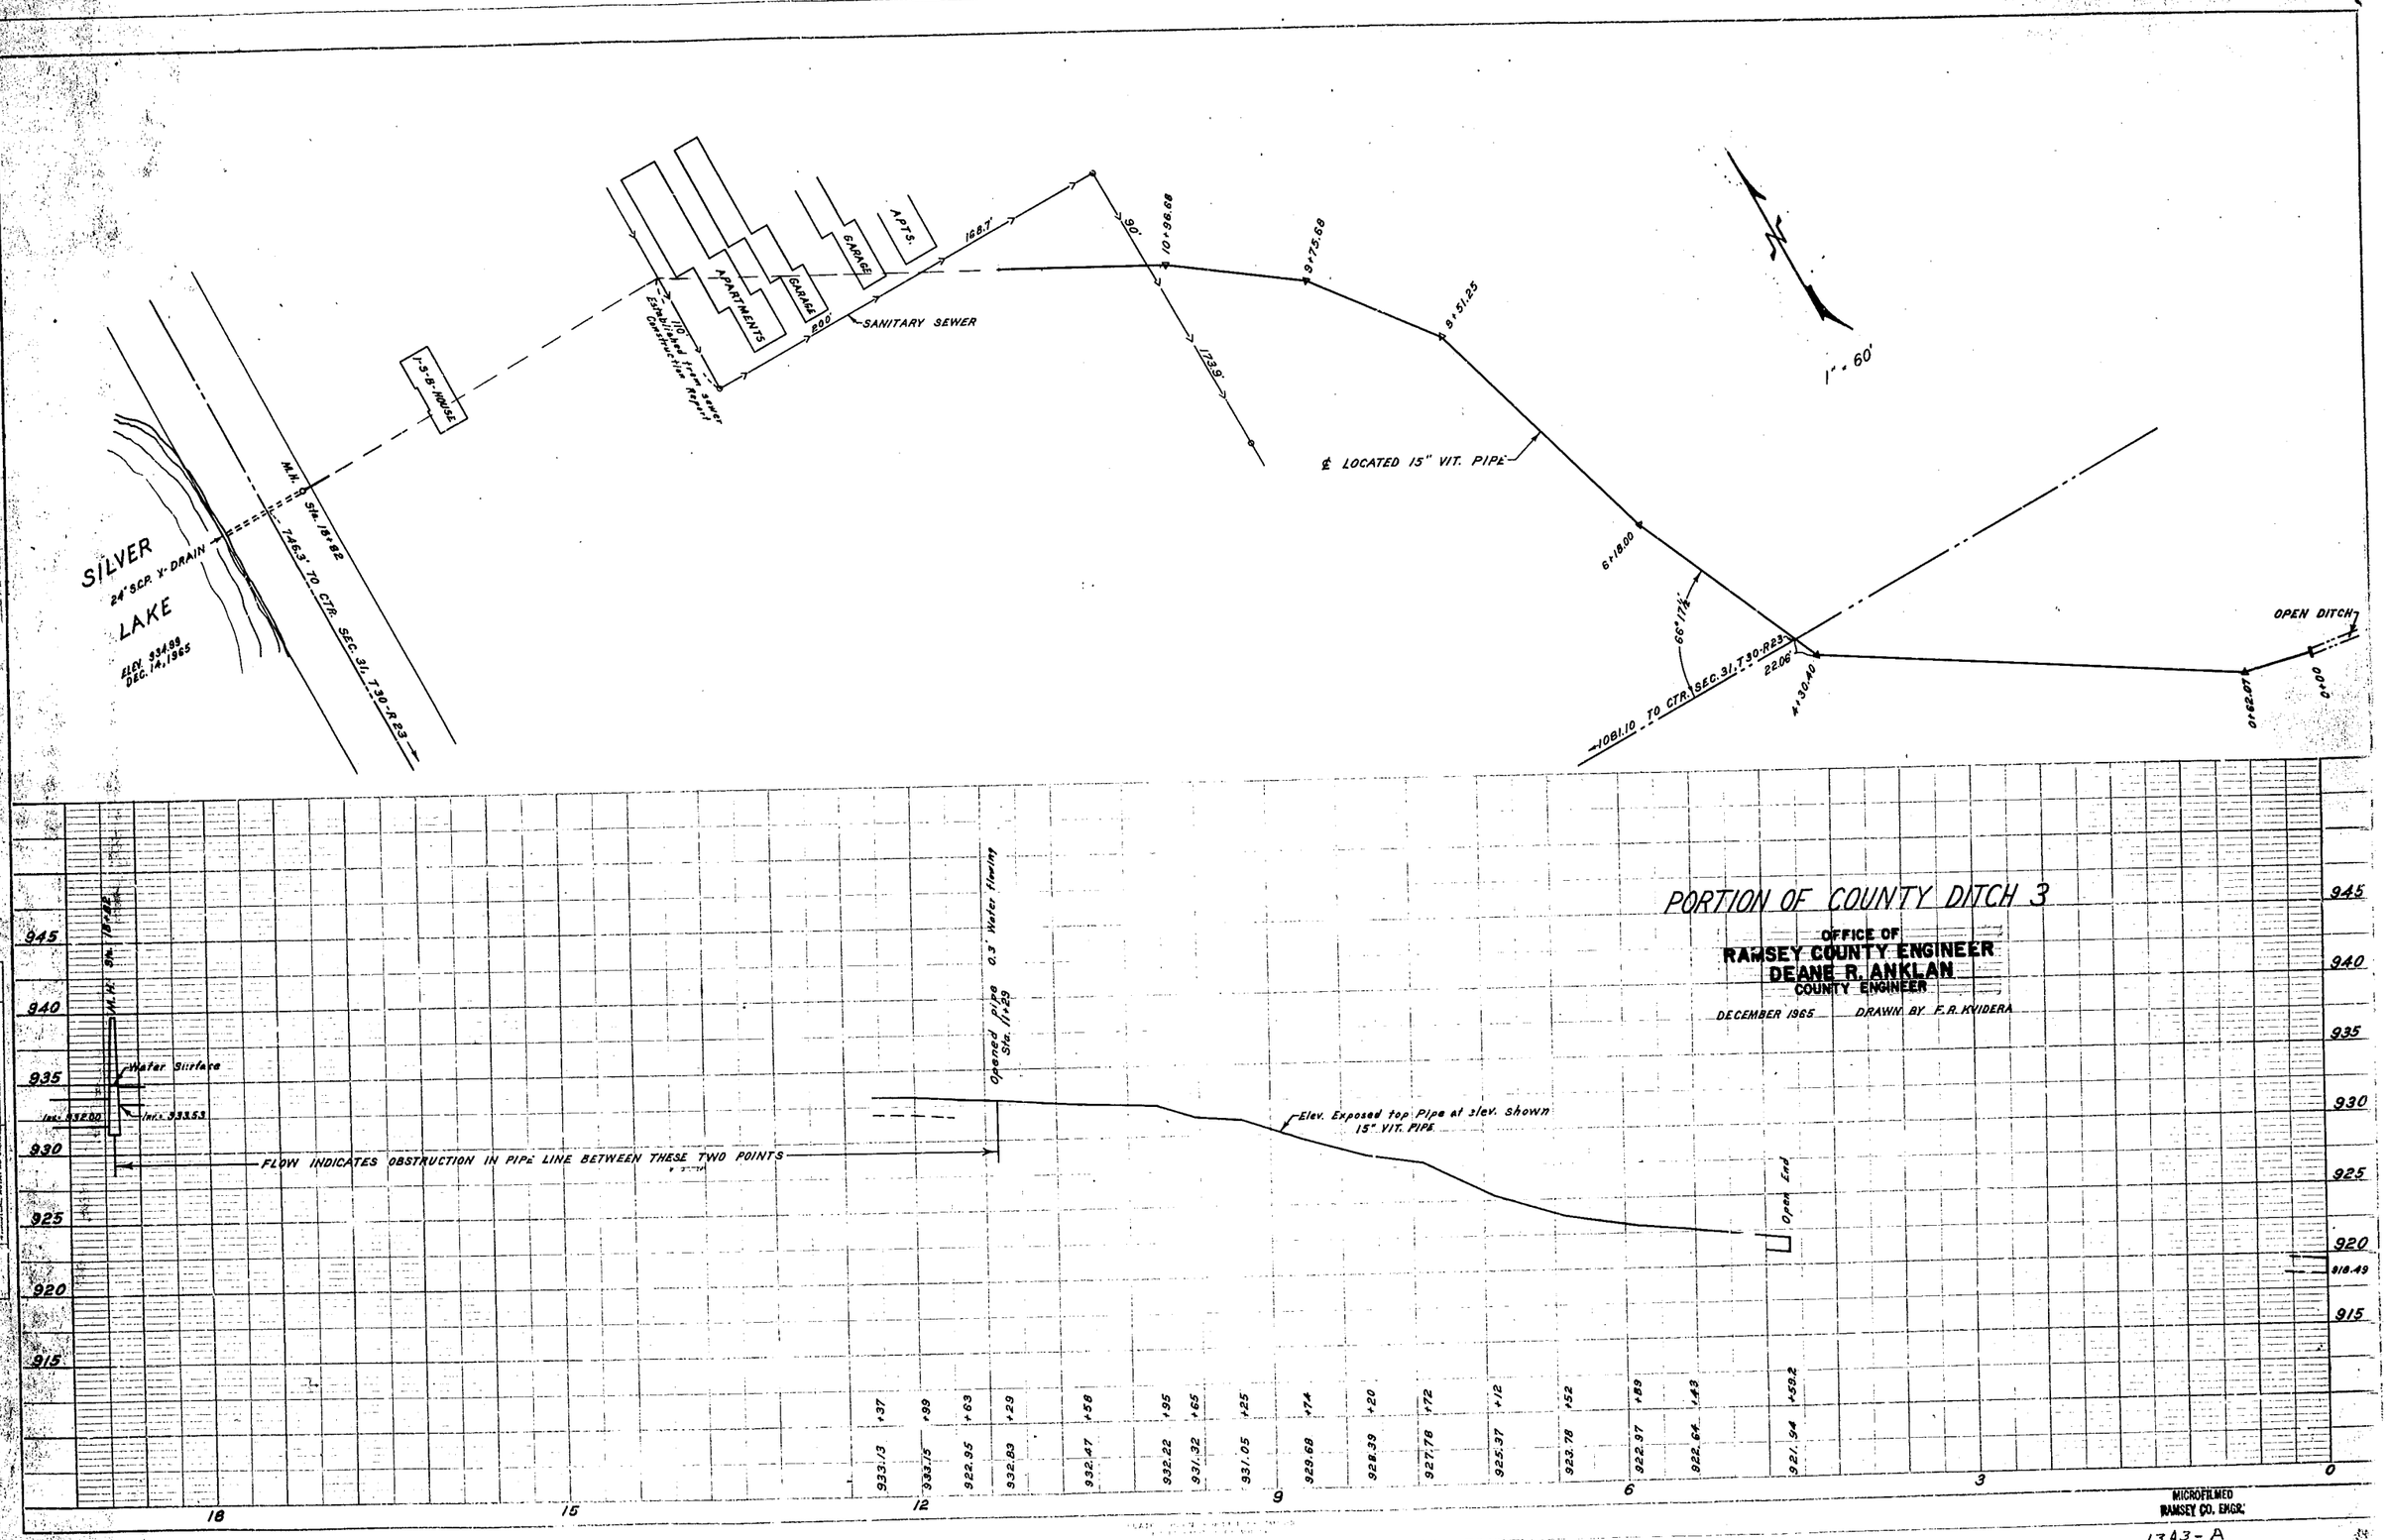

PORTION OF COUNTY DITCH 3
OFFICE OF
RAMSEY COUNTY ENGINEER
DEANE R. ANKLAN
COUNTY ENGINEER
DECEMBER 1965
DRAWN BY F.R. KVIDERA
SILVER LAKE
24" SCP. X-DRAIN
ELEV. 934.99
DEC. 14, 1965
M.H. Sta. 18+82
746.3' TO CTR. SEC. 31, T30-R23
1-5-B-HOUSE
APARTMENTS
GARAGE
APTS.
SANITARY SEWER
110' Established from sewer Construction Report
168.7'
200'
90'
173.9'
10+96.68
9+75.68
9+51.25
℄ LOCATED 15" VIT. PIPE
6+18.00
66°17½'
1081.10 TO CTR. SEC. 31, T30-R23
22.06'
4+30.40
0+62.07
0+00
OPEN DITCH
1" = 60'
Water Surface
Inv. 932.00
Inv. 933.53
FLOW INDICATES OBSTRUCTION IN PIPE LINE BETWEEN THESE TWO POINTS
Opened pipe 0.3' Water flowing Sta. 11+29
Elev. Exposed top Pipe at elev. shown 15" VIT. PIPE
Open End
945
940
935
930
925
920
915
918.49
933.13 +37
933.15 +99
922.95 +63
932.83 +29
932.47 +58
932.22 +95
931.32 +65
931.05 +25
929.68 +74
928.39 +20
927.78 +72
925.37 +12
923.78 +52
922.97 +89
922.64 +43
921.94 +59.2
18
15
12
9
6
3
0
PLAN
NOTE BOOK NO.
SURVEYED
PLOTTED
ALIGNMENT CHECKED
RT. OF WAY CHECKED
BY
DATE
PROFILE
NOTE BOOK NO.
SURVEYED
PLOTTED
GRADES CHECKED
R.R. & NOTED
STRUCTURE NOTATIONS CHKD.
BY
DATE
MICROFILMED
RAMSEY CO. ENGR.
1343-A