PROFILE & PLAN OF COUNTY DITCH No 4
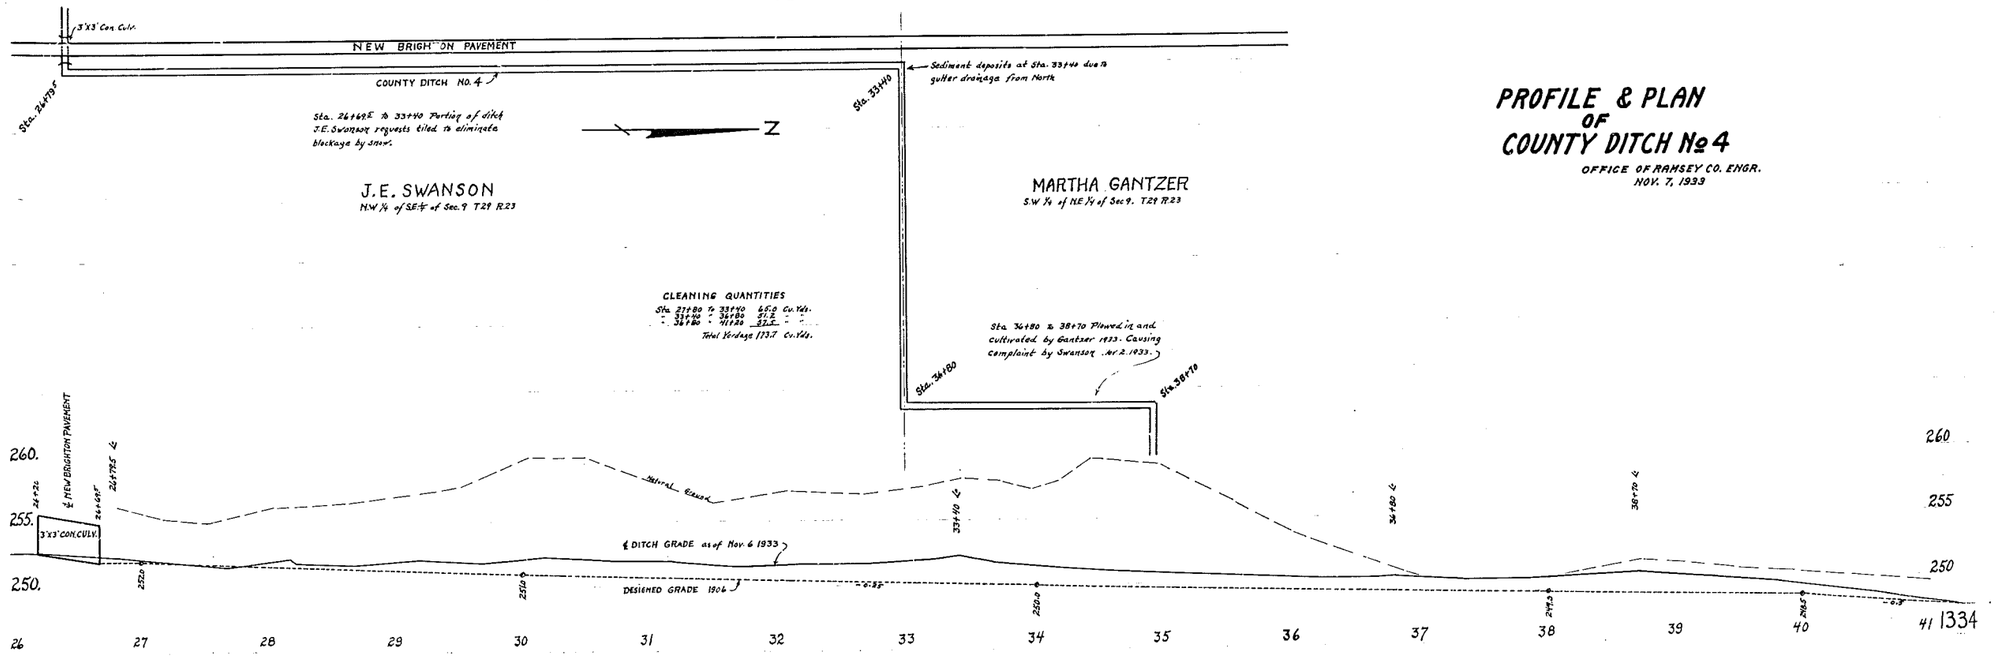
OFFICE OF RAMSEY CO. ENGR.
NOV. 7, 1933