



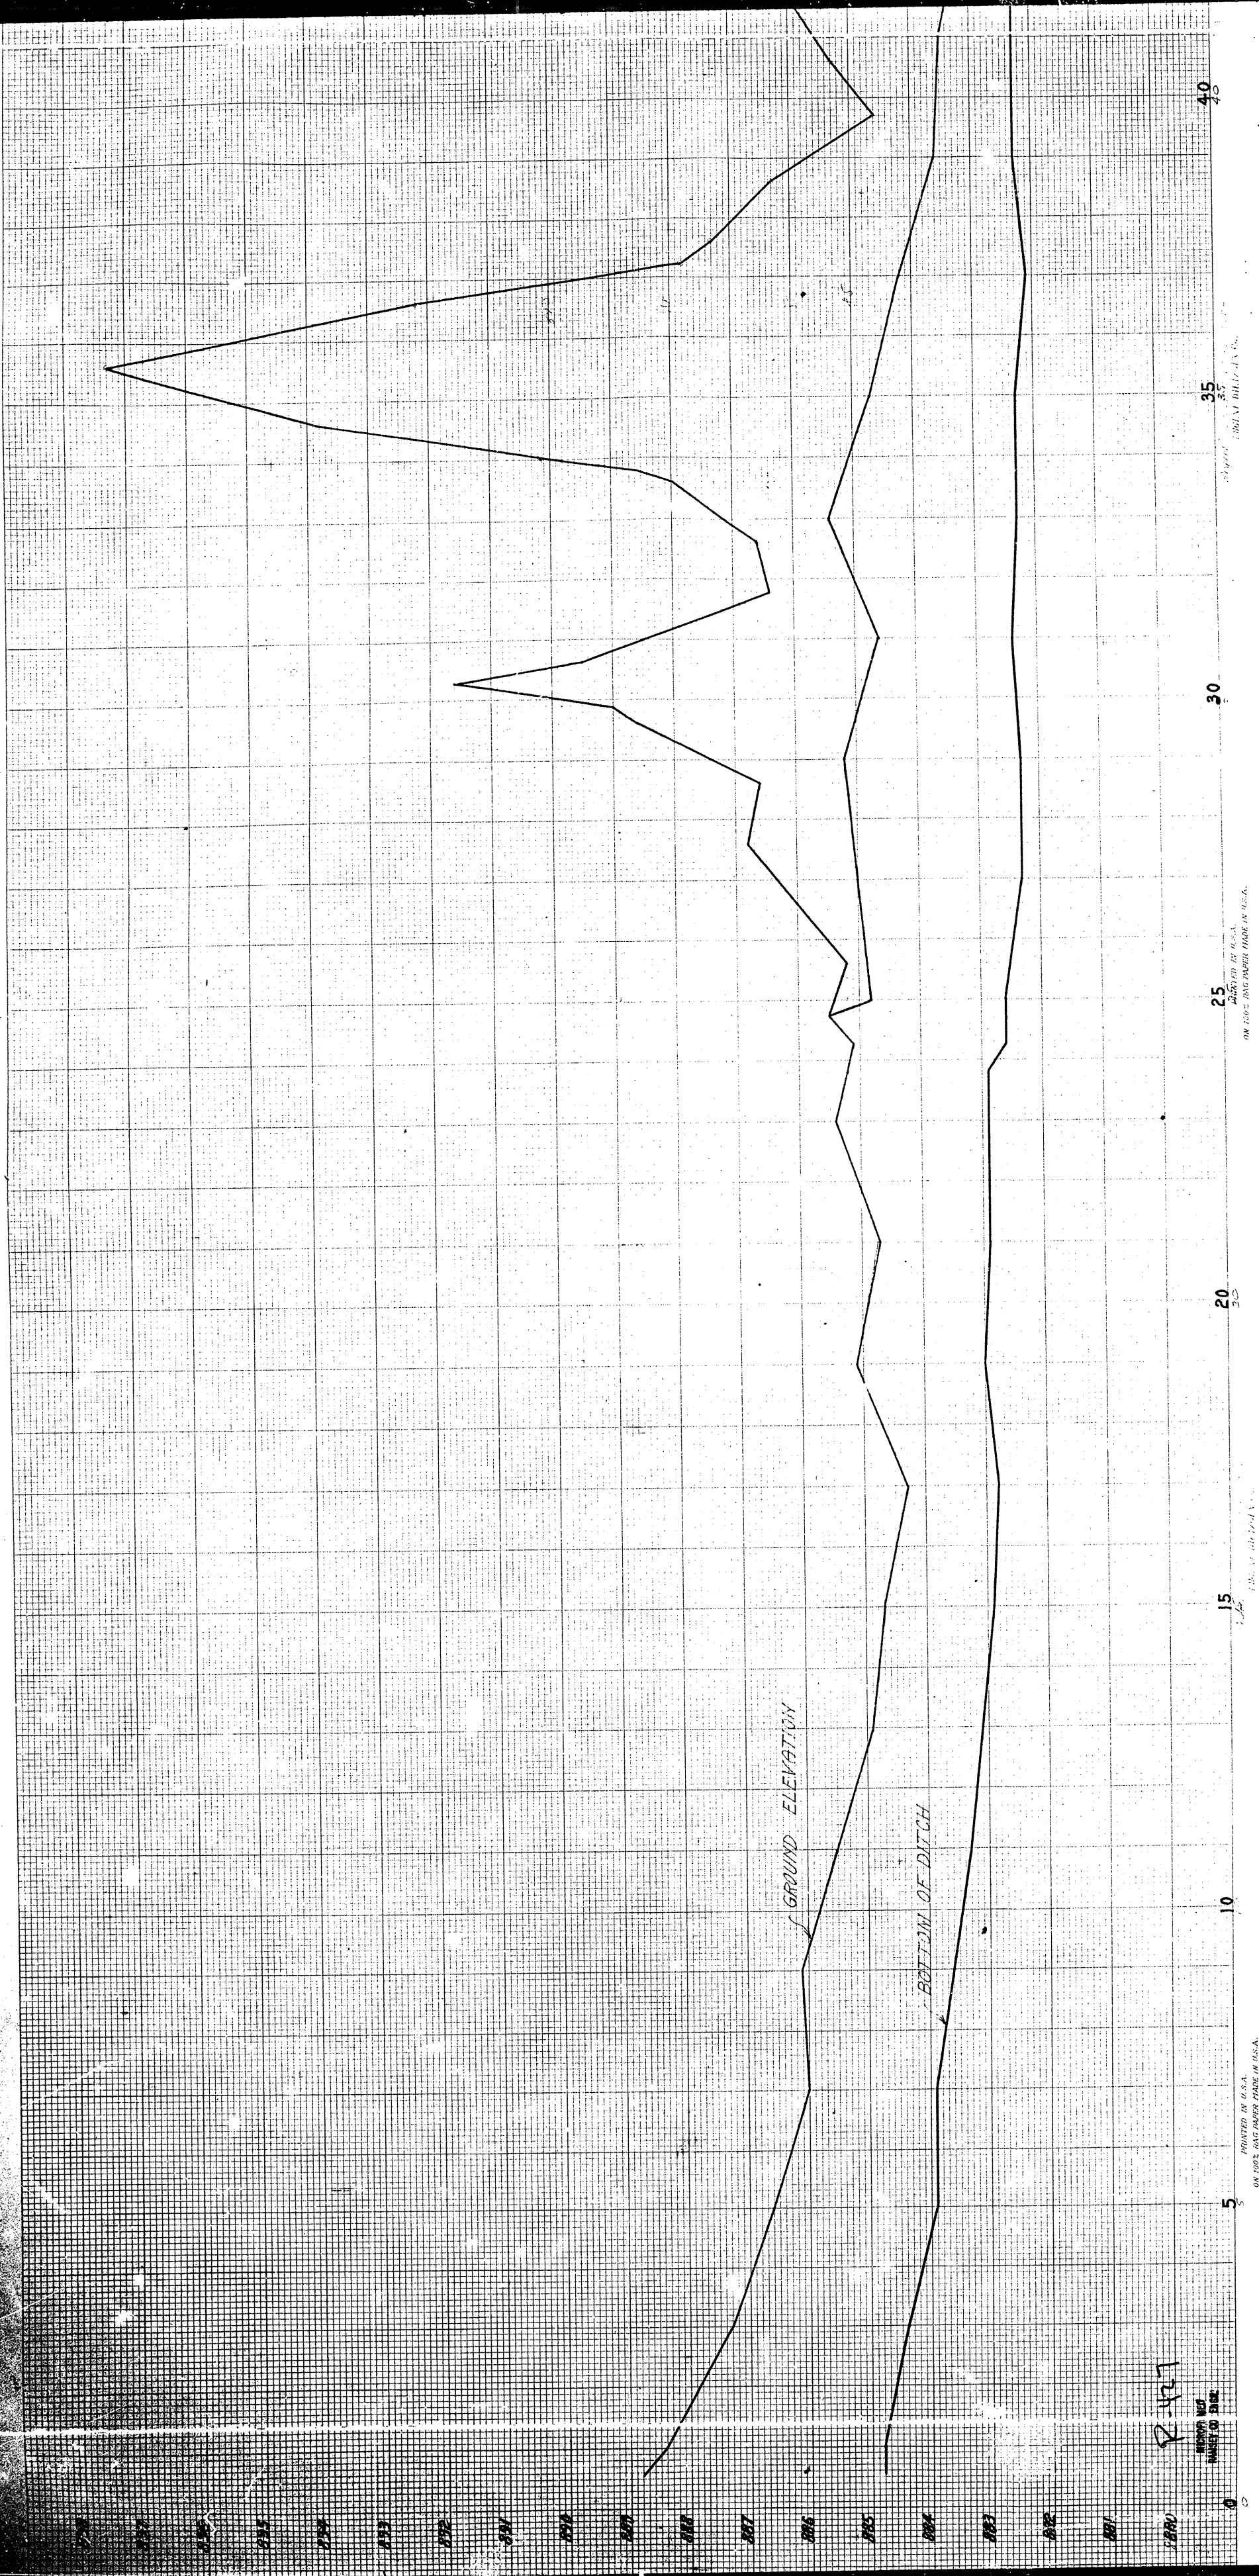


0 5 10 15 20 25 30 35 40

PRINTED IN U.S.A.
ON 10% RECYCLED PAPER MADE IN U.S.A.

8-127

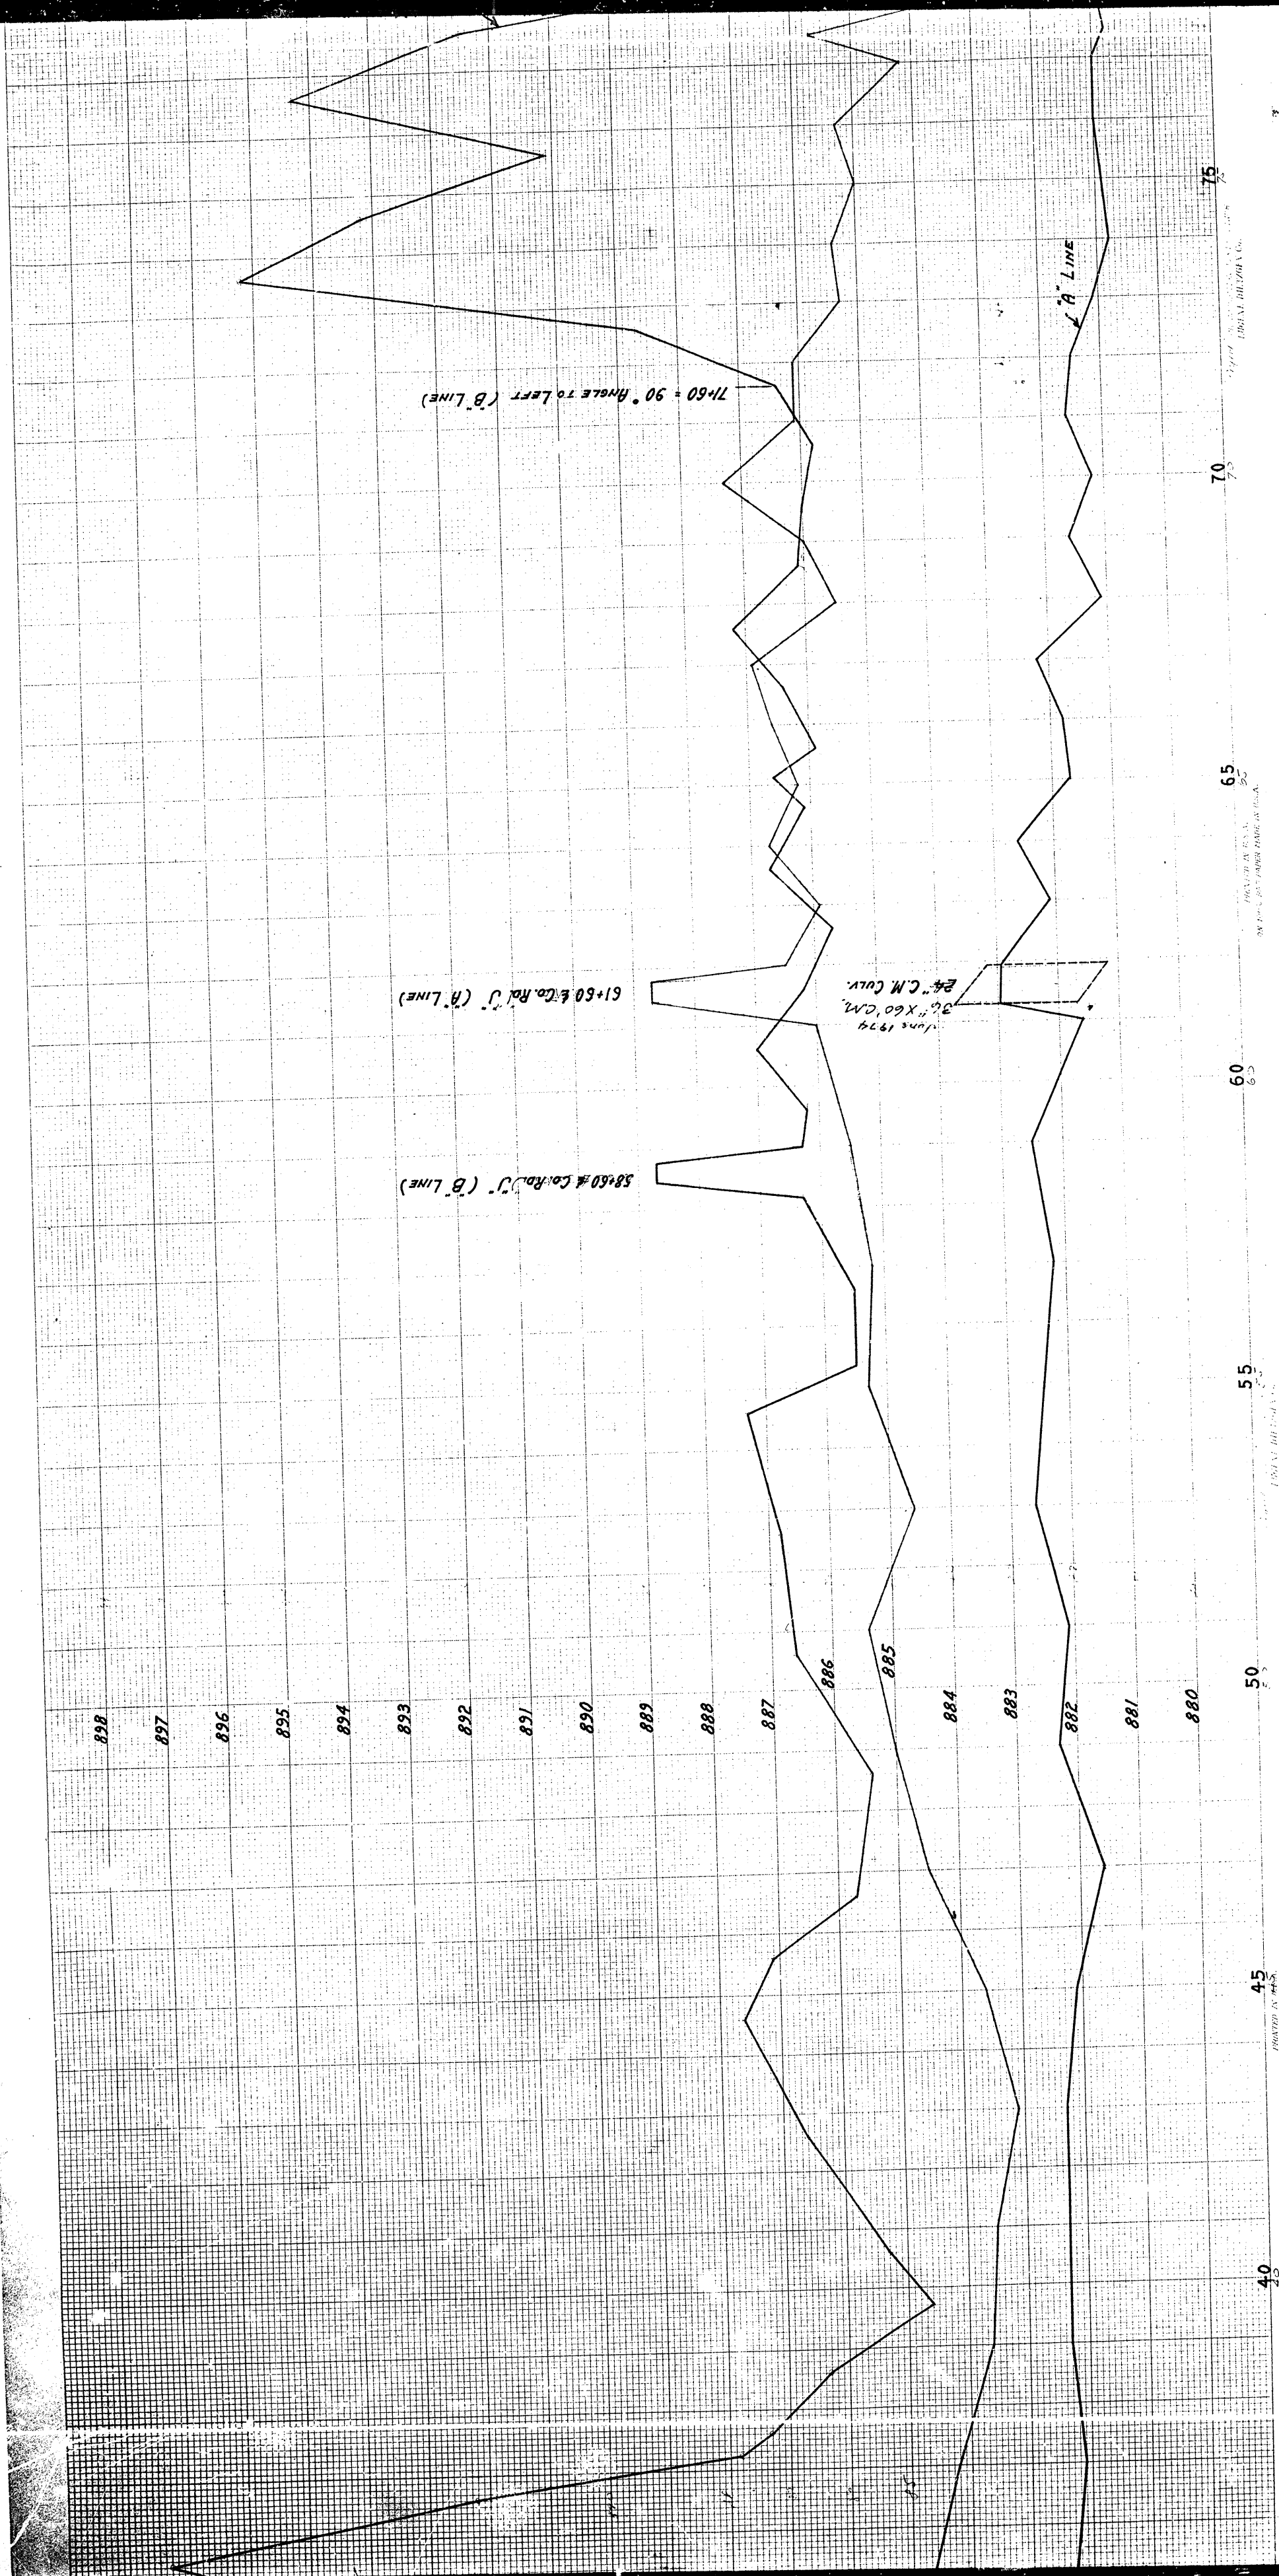

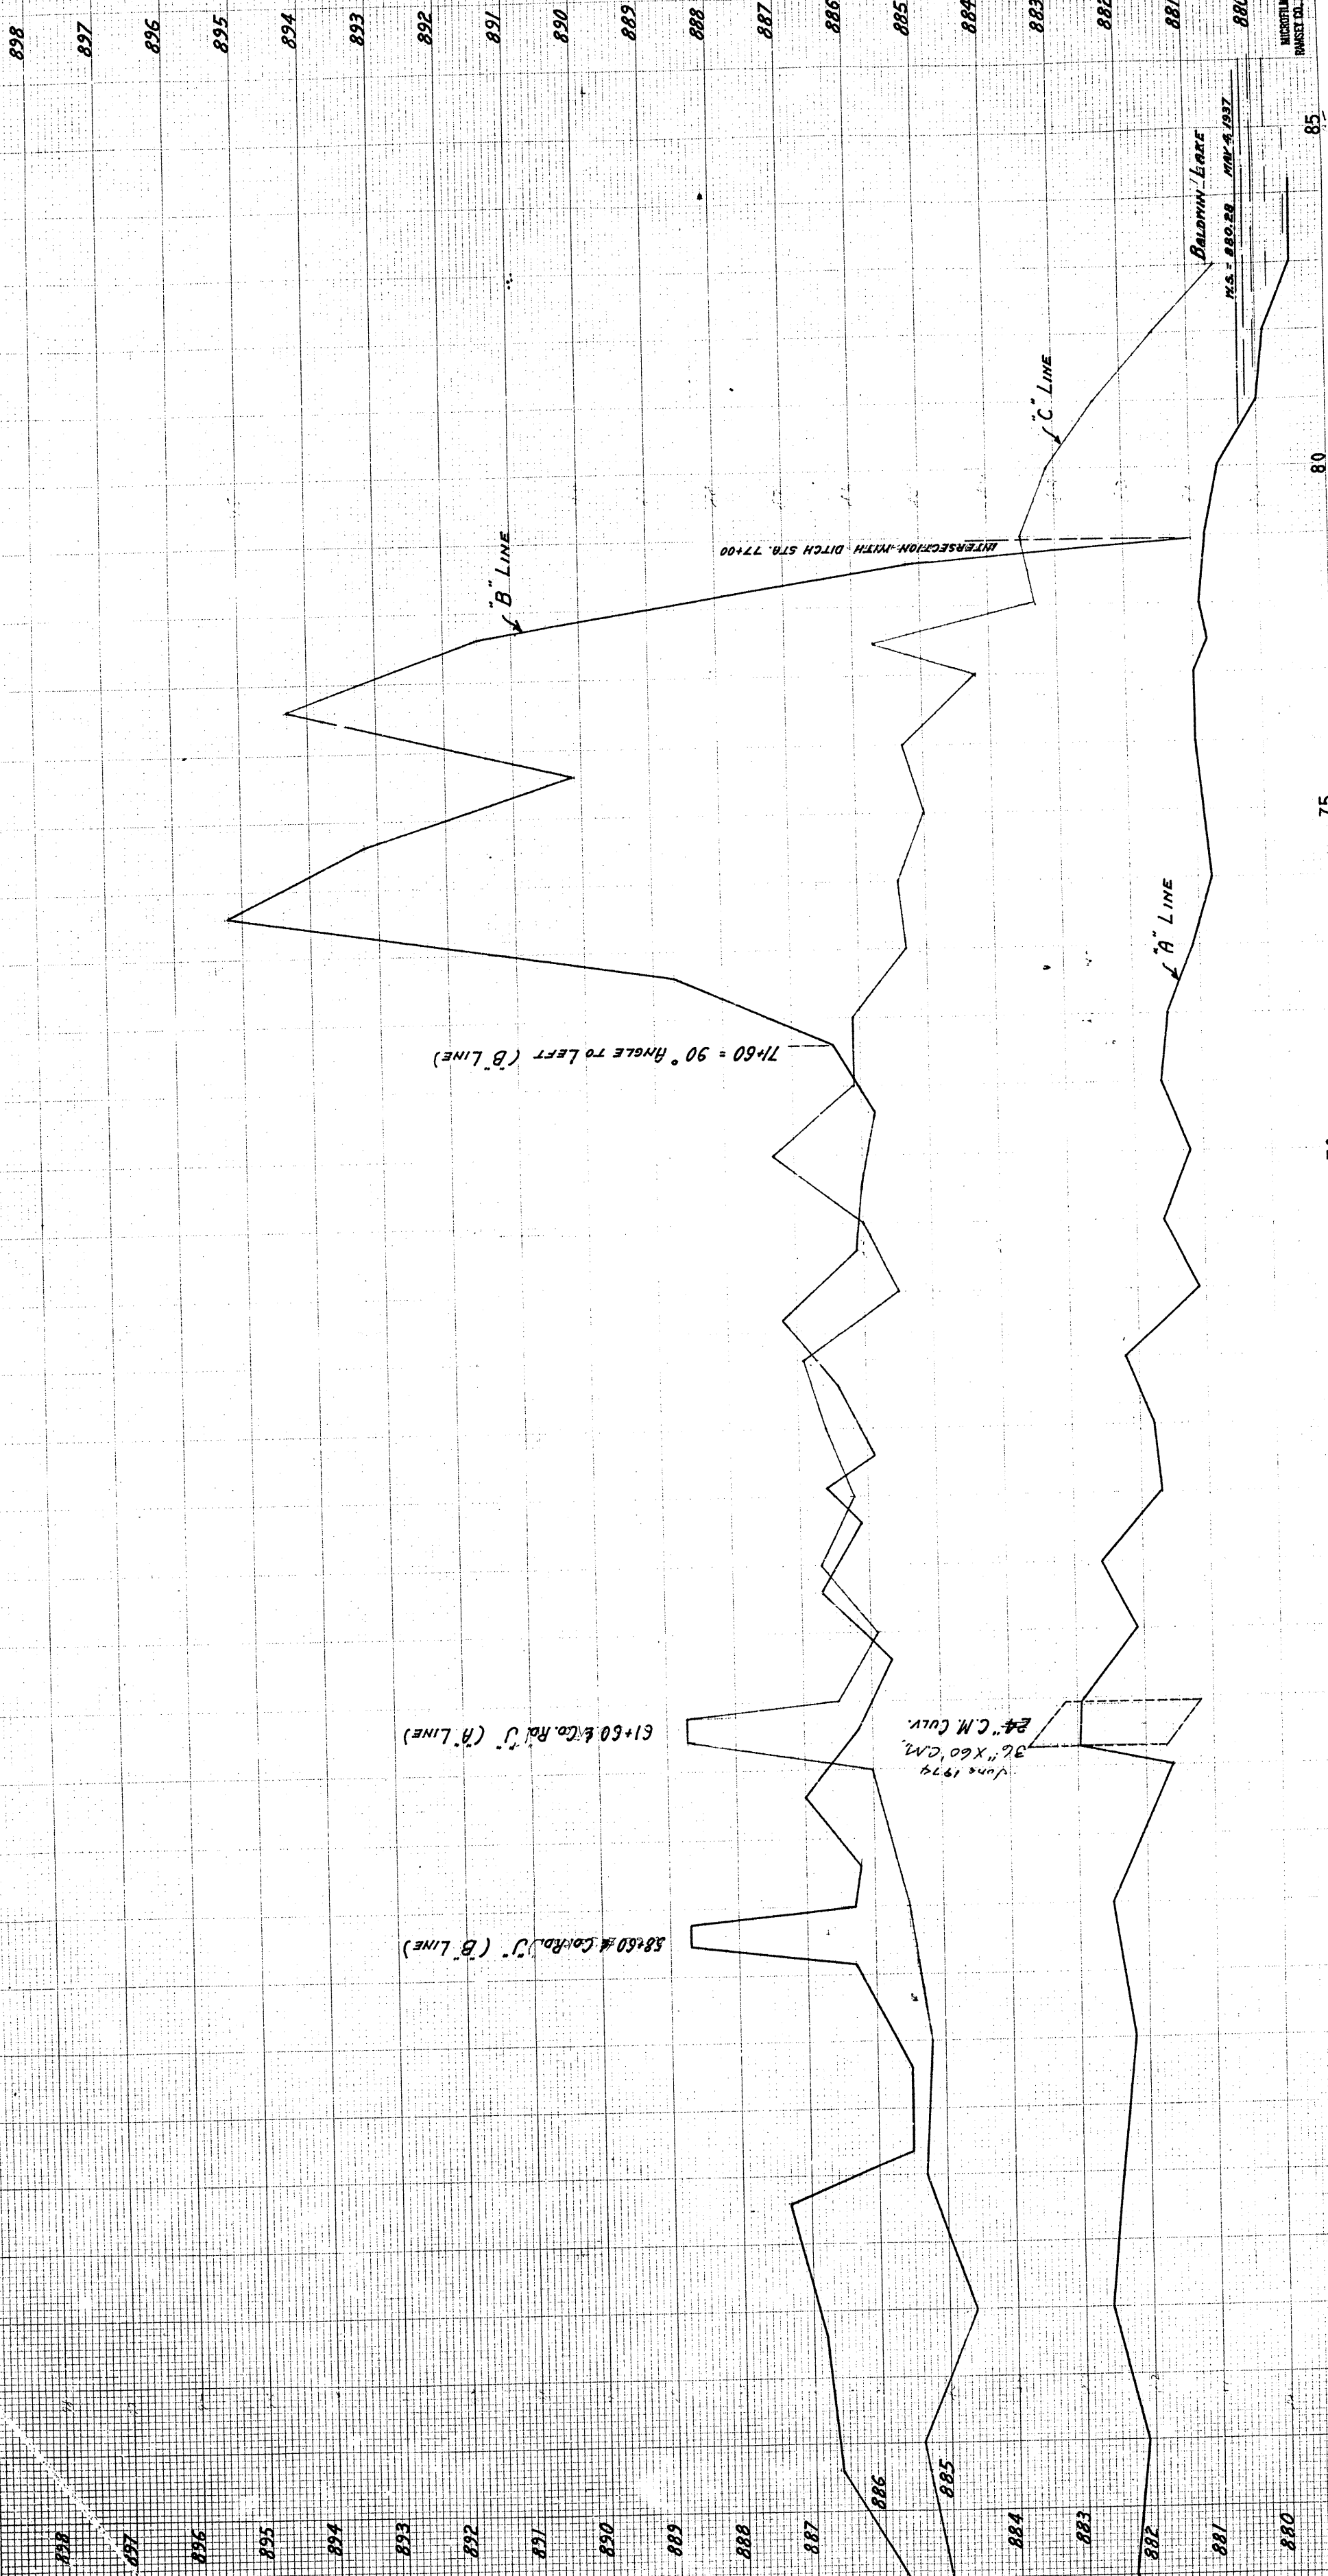

PRINTED IN U.S.A.
ON 10% HAT PAPER MADE IN U.S.A.
MICROFILMED
