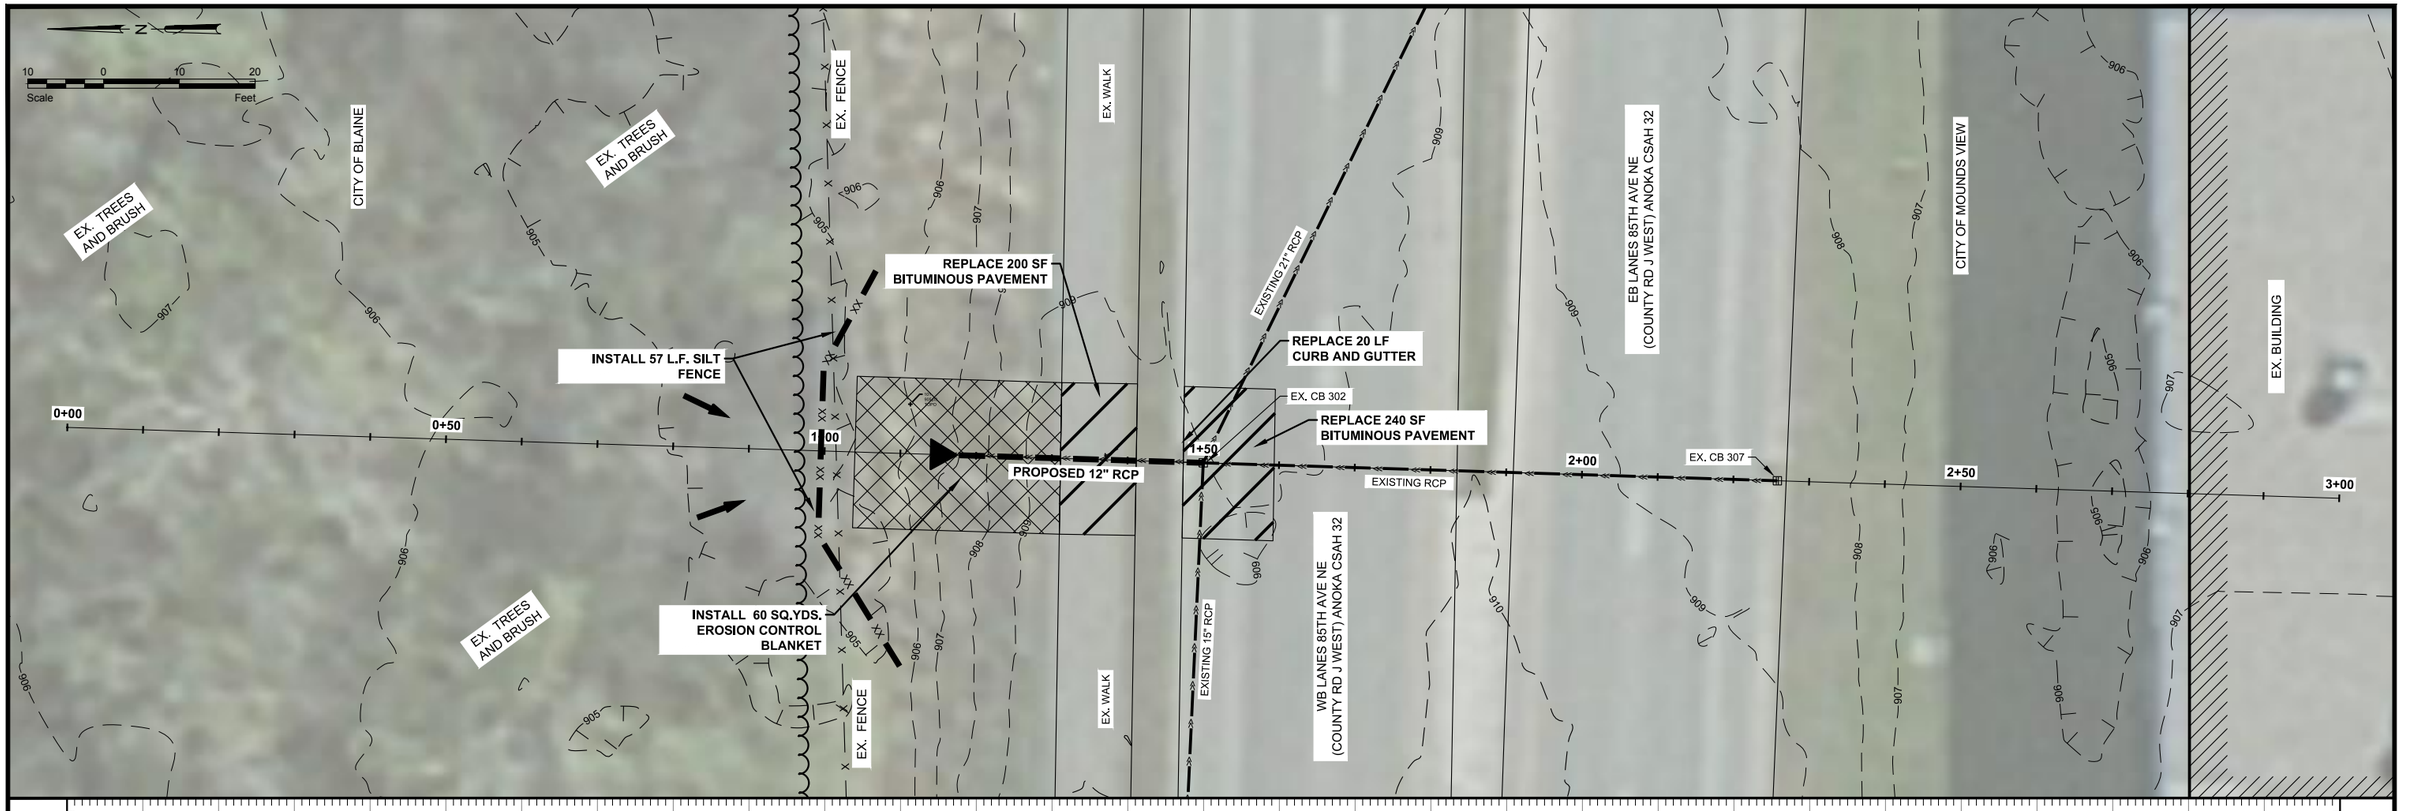

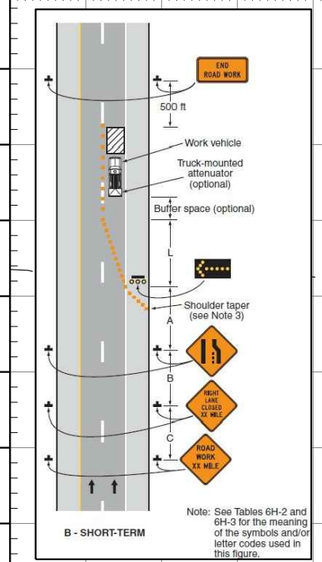

FIGURE 6H-33, STATIONARY LANE CLOSURE ON A DIVIDED HIGHWAY (TA-33)

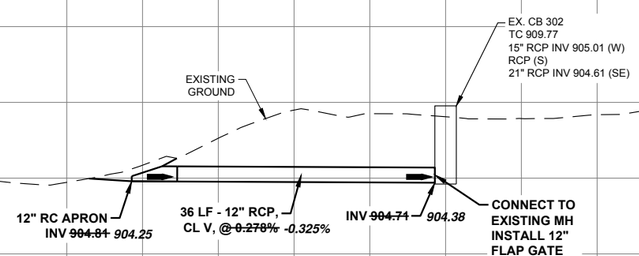

920	915	910	905	900	895	890	885

906.76	906.64	906.80	906.59	906.26	905.89	905.82	905.26	904.96	904.80	904.72	905.85	907.63	909.49	909.25	909.05	908.93	909.19	909.56	909.67	909.27	908.80	908.65	908.70	907.33	906.40	906.18	904.48	906.80	906.91	906.91

0+00	0+10	0+20	0+30	0+40	0+50	0+60	0+70	0+80	0+90	1+00	1+10	1+20	1+30	1+40	1+50	1+60	1+70	1+80	1+90	2+00	2+10	2+20	2+30	2+40	2+50	2+60	2+70	2+80	2+90	3+00

NOTES:

1. THE 2016 EDITION OF THE MINNESOTA DEPARTMENT OF TRANSPORTATION "STANDARD SPECIFICATIONS FOR CONSTRUCTION", SHALL GOVERN.
2. PRIOR TO ANY EXCAVATION WORK, THE CONTRACTOR IS RESPONSIBLE UNDER MINNESOTA STATE STATUTE 216D AND MINNESOTA RULES CHAPTER 7560 TO CONTACT GOPHER STATE ONE CALL FOR THE LOCATION OF UNDERGROUND UTILITY FACILITIES IN PROXIMITY TO THE EXCAVATION SITE.

   THE SUBSURFACE UTILITY INFORMATION IN THIS PLAN IS UTILITY QUALITY LEVEL D. THIS UTILITY QUALITY LEVEL WAS DETERMINED ACCORDING TO THE GUIDELINES OF CI/ASCE 38-02, ENTITLED "STANDARD GUIDELINE FOR THE COLLECTION AND DEPICTION OF EXISTING SUBSURFACE UTILITY DATA".
3. THE CONTRACTOR SHALL FURNISH, INSTALL AND MAINTAIN CONSTRUCTION SIGNING. CONSTRUCTION SIGNING SHALL INCLUDE ALL DAILY INSPECTIONS INCLUDING WEEKENDS AND HOLIDAYS.
4. TRAFFIC CONTROL DEVICES SHALL CONFORM TO AND BE MAINTAINED IN ACCORDANCE WITH THE REQUIREMENTS OF THE PROJECT SPECIFICATIONS AND THE MOST RECENT EDITION OF THE MINNESOTA MANUAL ON UNIFORM TRAFFIC CONTROL DEVICES (MN MUTCD) PART 6 A - J INCLUDING THE MOST RECENT EDITION OF THE MN MUTCD "FIELD MANUAL".
5. FOLLOW FIGURE 6H-33, STATIONARY LANE CLOSURE ON A DIVIDED HIGHWAY (TA-33) OF MUTCD.
6. THE CONTRACTOR SHALL SECURE ANY NECESSARY RIGHT-OF-WAY PERMITS FOR TRAFFIC CONTROL.

PROJECT INFORMATION

CONTRACTOR: JAY-CON CONSTRUCTION
PROJECT OBSERVER: ALEX SCHMIDT

NOTE:
RECORD DRAWING TEXT, DIMENSIONS AND ELEVATIONS ARE NOTED IN OBLIQUE TEXT

No.	Revision	Date	By
6	RECORD DRAWING	9/7/2016	WS

I hereby certify that this plan, specification, or report was prepared by me or under my direct supervision and that I am a duly Licensed Professional Engineer under the laws of the State of Minnesota.
Signature: Nancy Stowe Date: 2-10-2016
Printed Name: Nancy A. Stowe License #: 48259

Houston Engineering Inc.
Maple Grove
P: 763.493.4522
F: 763.493.5572

Drawn by: DJL | Date: 2-10-16
Checked by: NAS | Scale: AS SHOWN

ARJD 1 BRANCH 4 REPAIR PROJECT

BLAINE, MINNESOTA
RICE CREEK WATERSHED DISTRICT

PLAN AND PROFILE
PROJECT NO. 5555-244

SHEET 1

H:\Maple Grove\RCWD\BN\5555-244 ARJD1 Branch 4 Repair Memo\CAD\Plans\Br4 Repair Memo\5555244-br4 repair memo.dwg,Br4_repair_memo_PandP-9/7/2016 10:58 AM-(wspencer)