


BALD EAGLE LAKE  
DAM STRUCTURE  
ELEV: 909.91

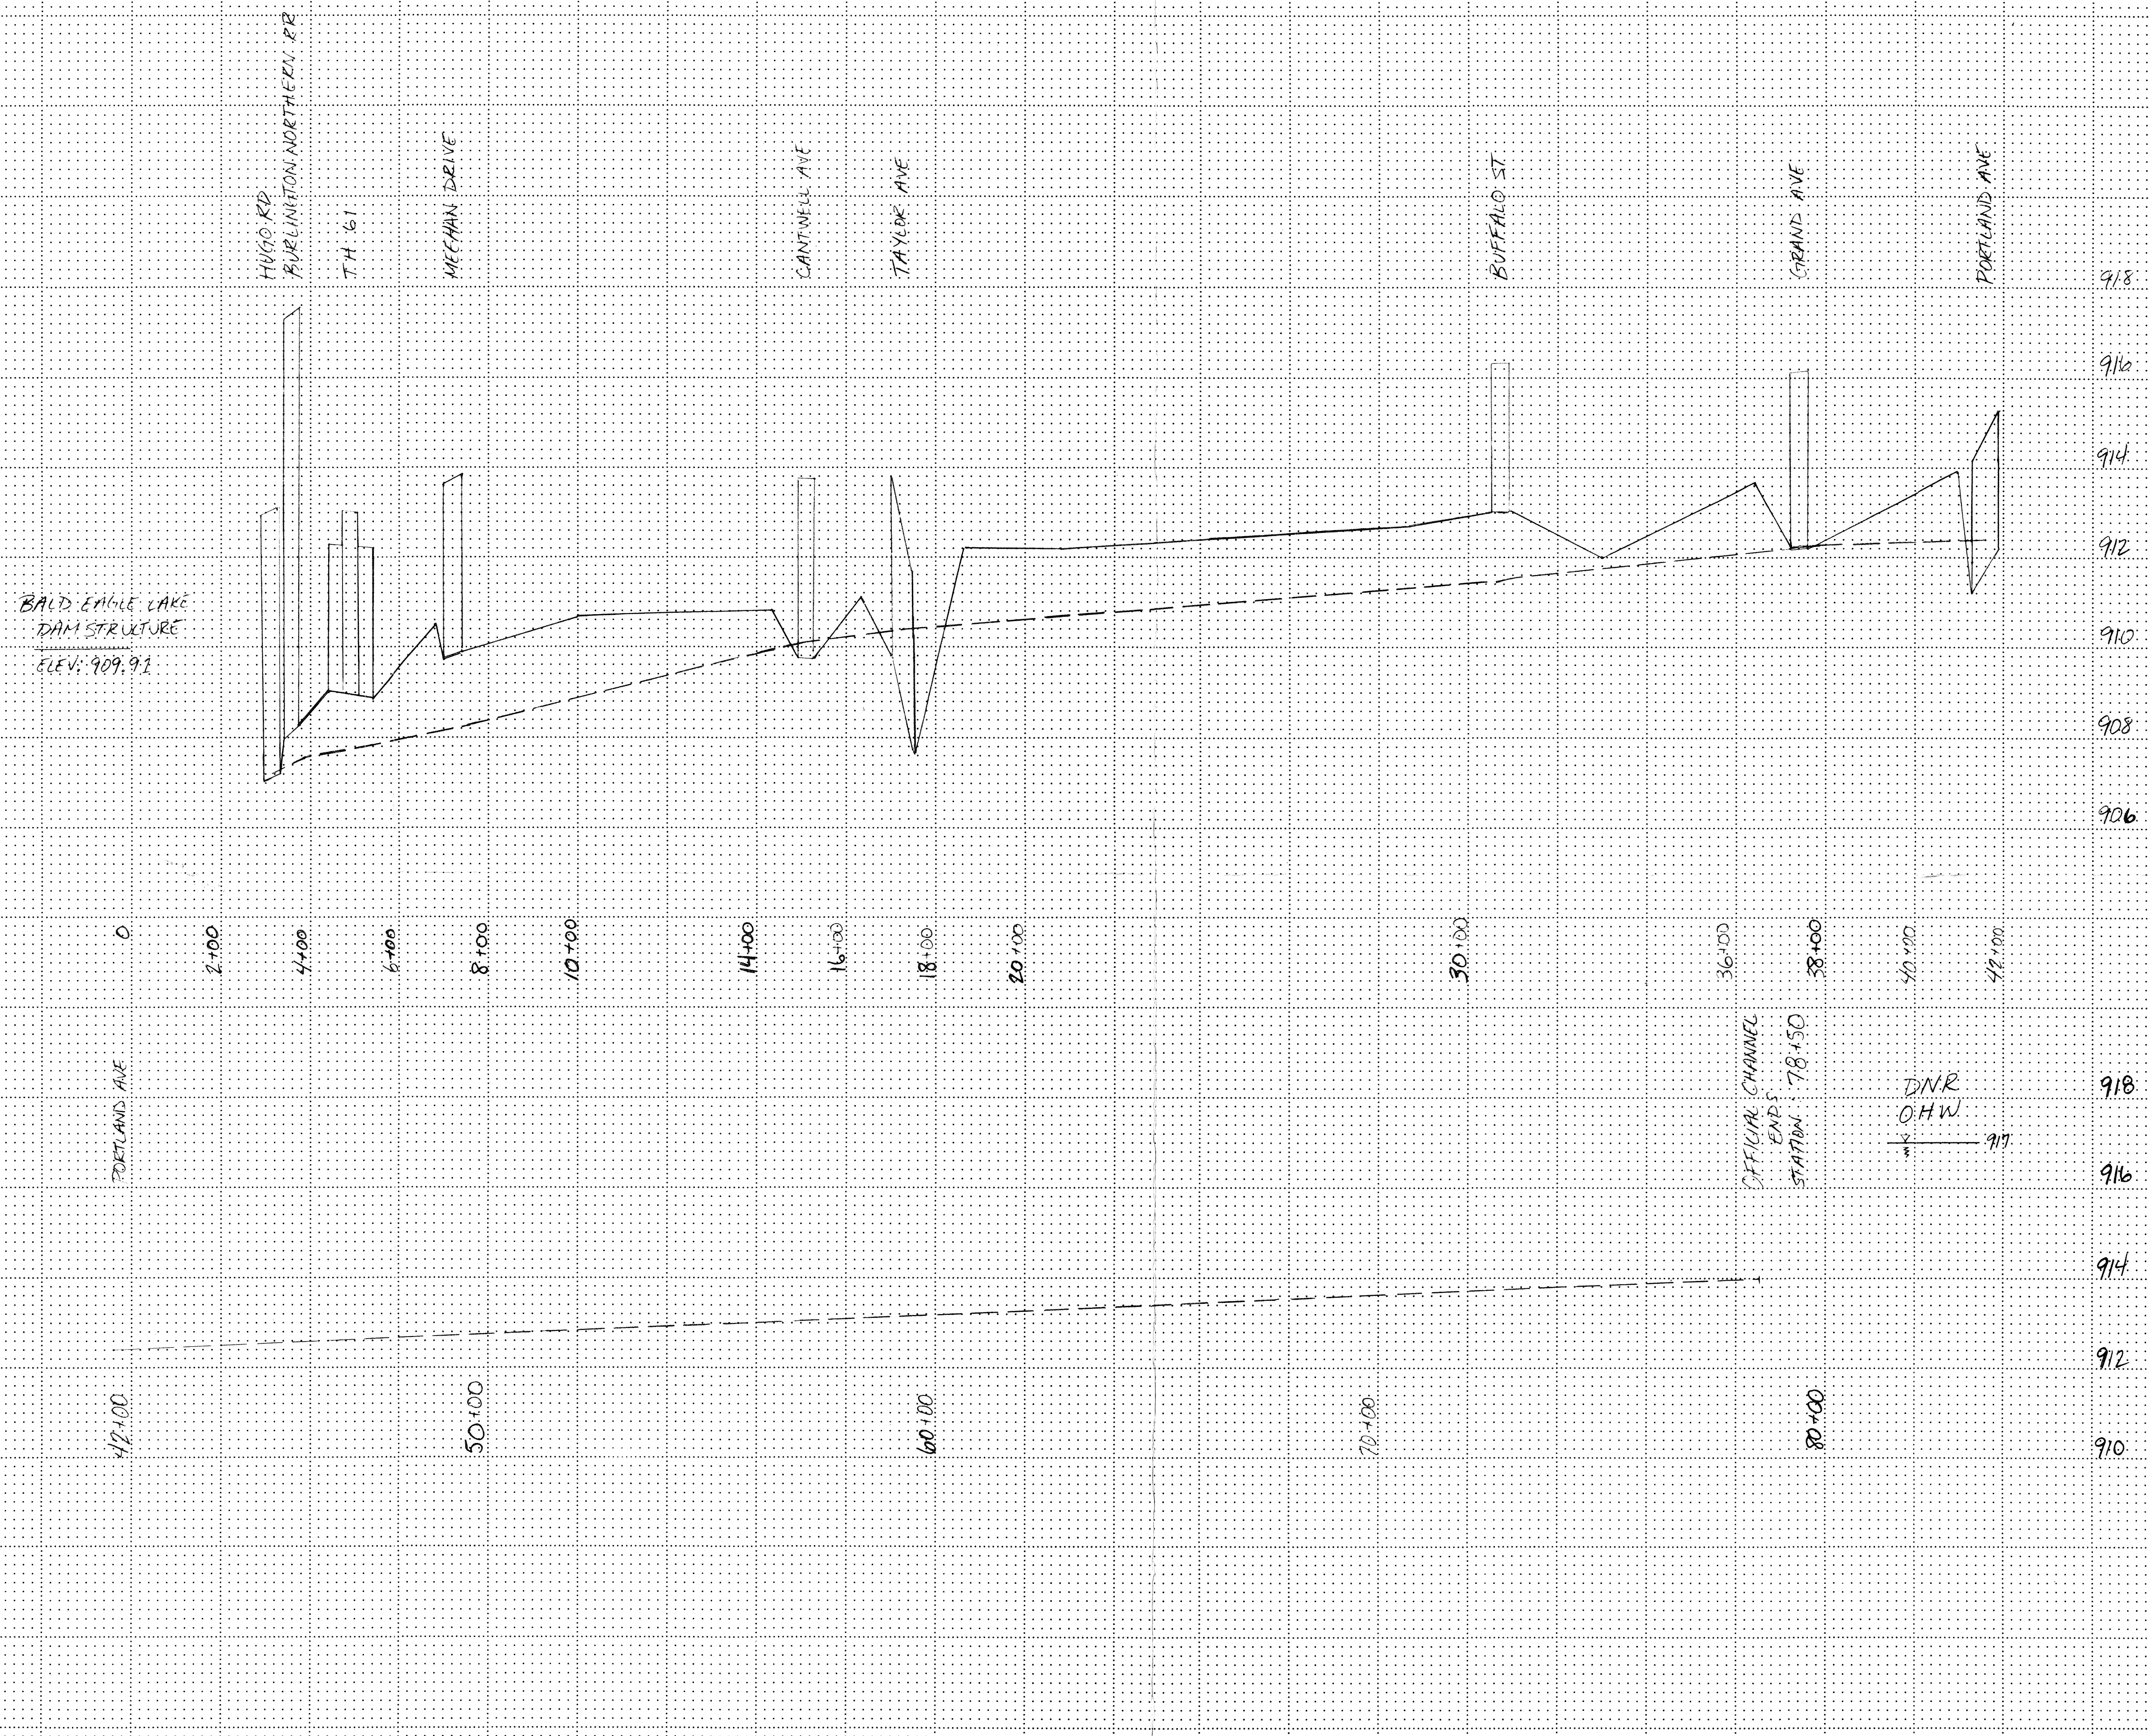

**RAMSEY / WASHINGTON COUNTY JUDICIAL DITCH #1**

SIMPLIFIED PROFILE DETERMINED FROM ELEVATIONS AT  
EXISTING CULVERT CROSSINGS

11-9-93

LEGEND  
OFFICIAL ———  
1980 PROFILE \* ———

SCALE  
HORIZONTAL 1" = 200 FEET  
VERTICAL 1" = 2 FEET

\* SOURCES: INTERMEDIATE GROUND POINTS FROM MONTGOMERY WATSON SURVEY OCTOBER, 1993; CULVERT INVERTS FROM TKDA 1980.