



SECTION I, T. 29, R. 23

TOWNSHIP 30 NORTH
TOWNSHIP 29 NORTH
NORTH VILLAGE LIMITS OF ROSEVILLE

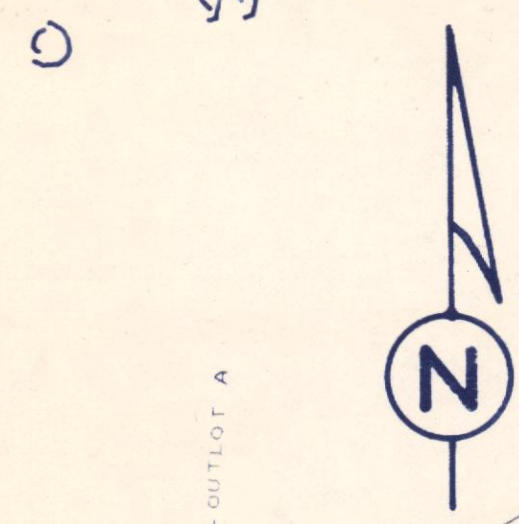

58-68-1
N1/2

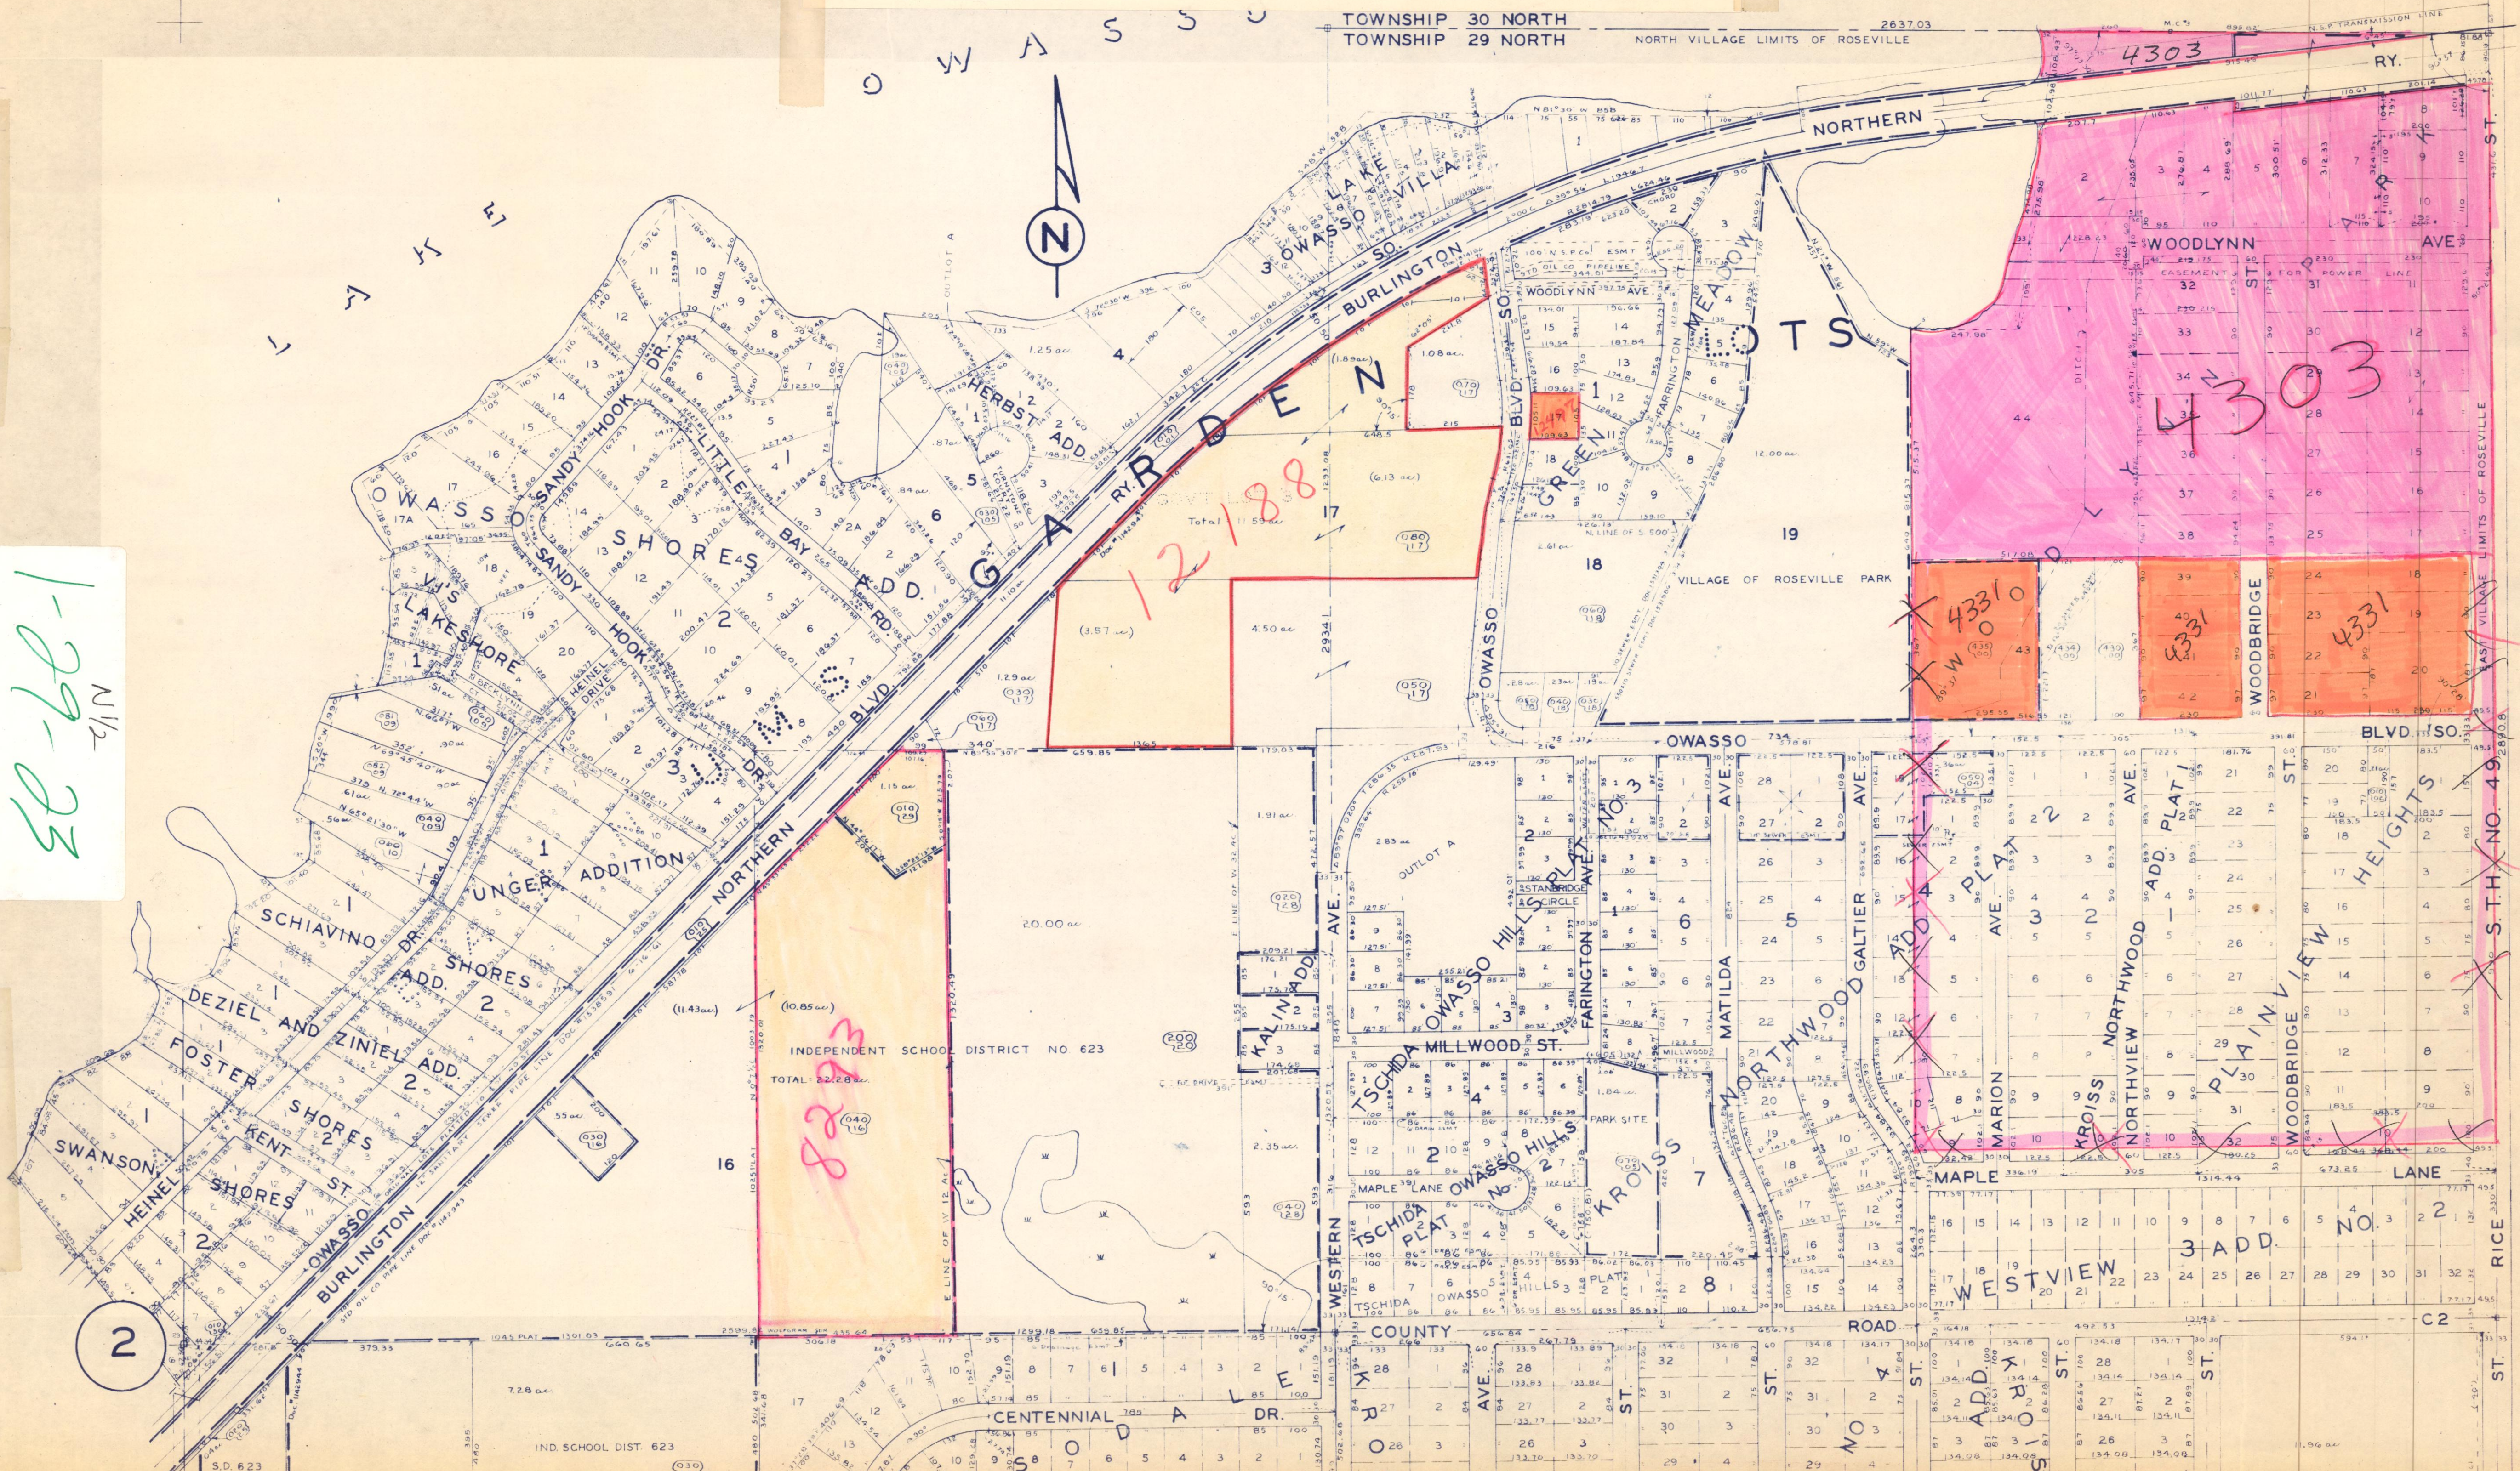

2

S.T.H. NO. 49