


# SECTION 12 T 30 R 22

97-9750  
S 300 FT  
N 650 FT  
①

12-30-22  
N/A

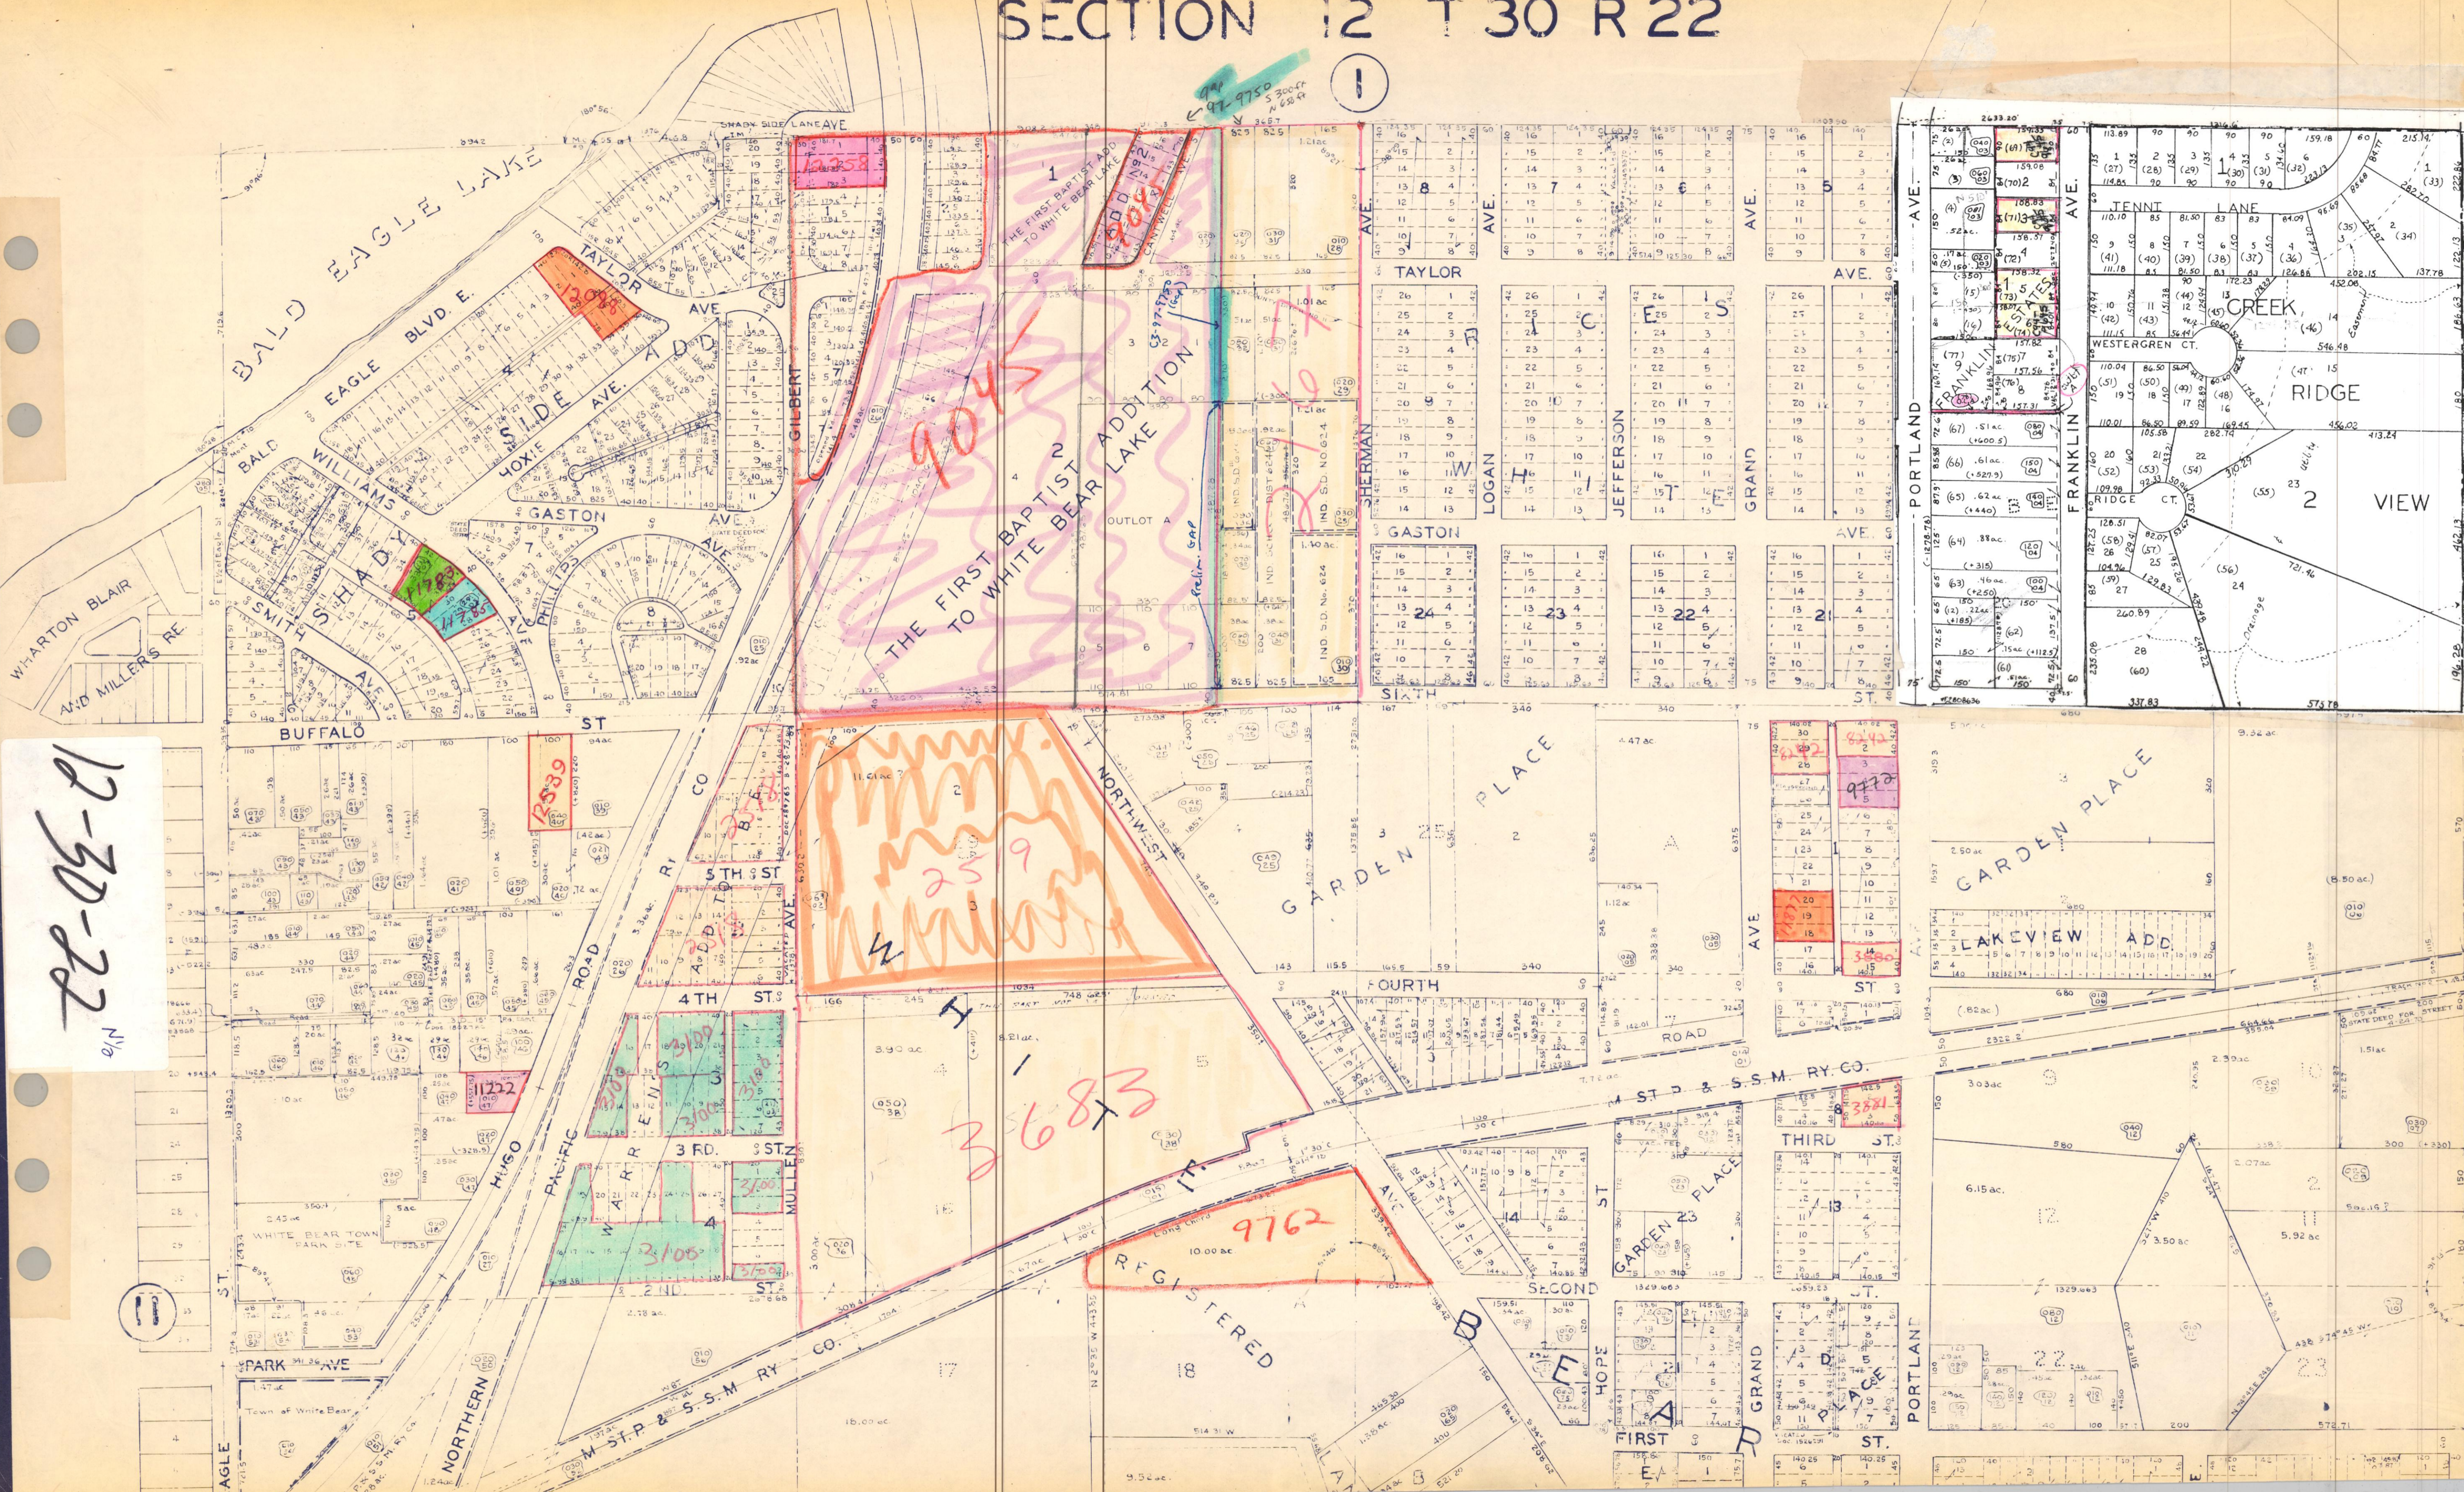

THE FIRST BAPTIST ADD TO WHITE BEAR LAKE  
904

259  
3683

9762  
REGISTERED

GARDEN PLACE  
LAKEVIEW ADD

PORTLAND  
FRANKLIN  
ST. & S-S-M RY. CO.