


SECTION 15 T.29.R.23

10

15-29-23
MIN

16

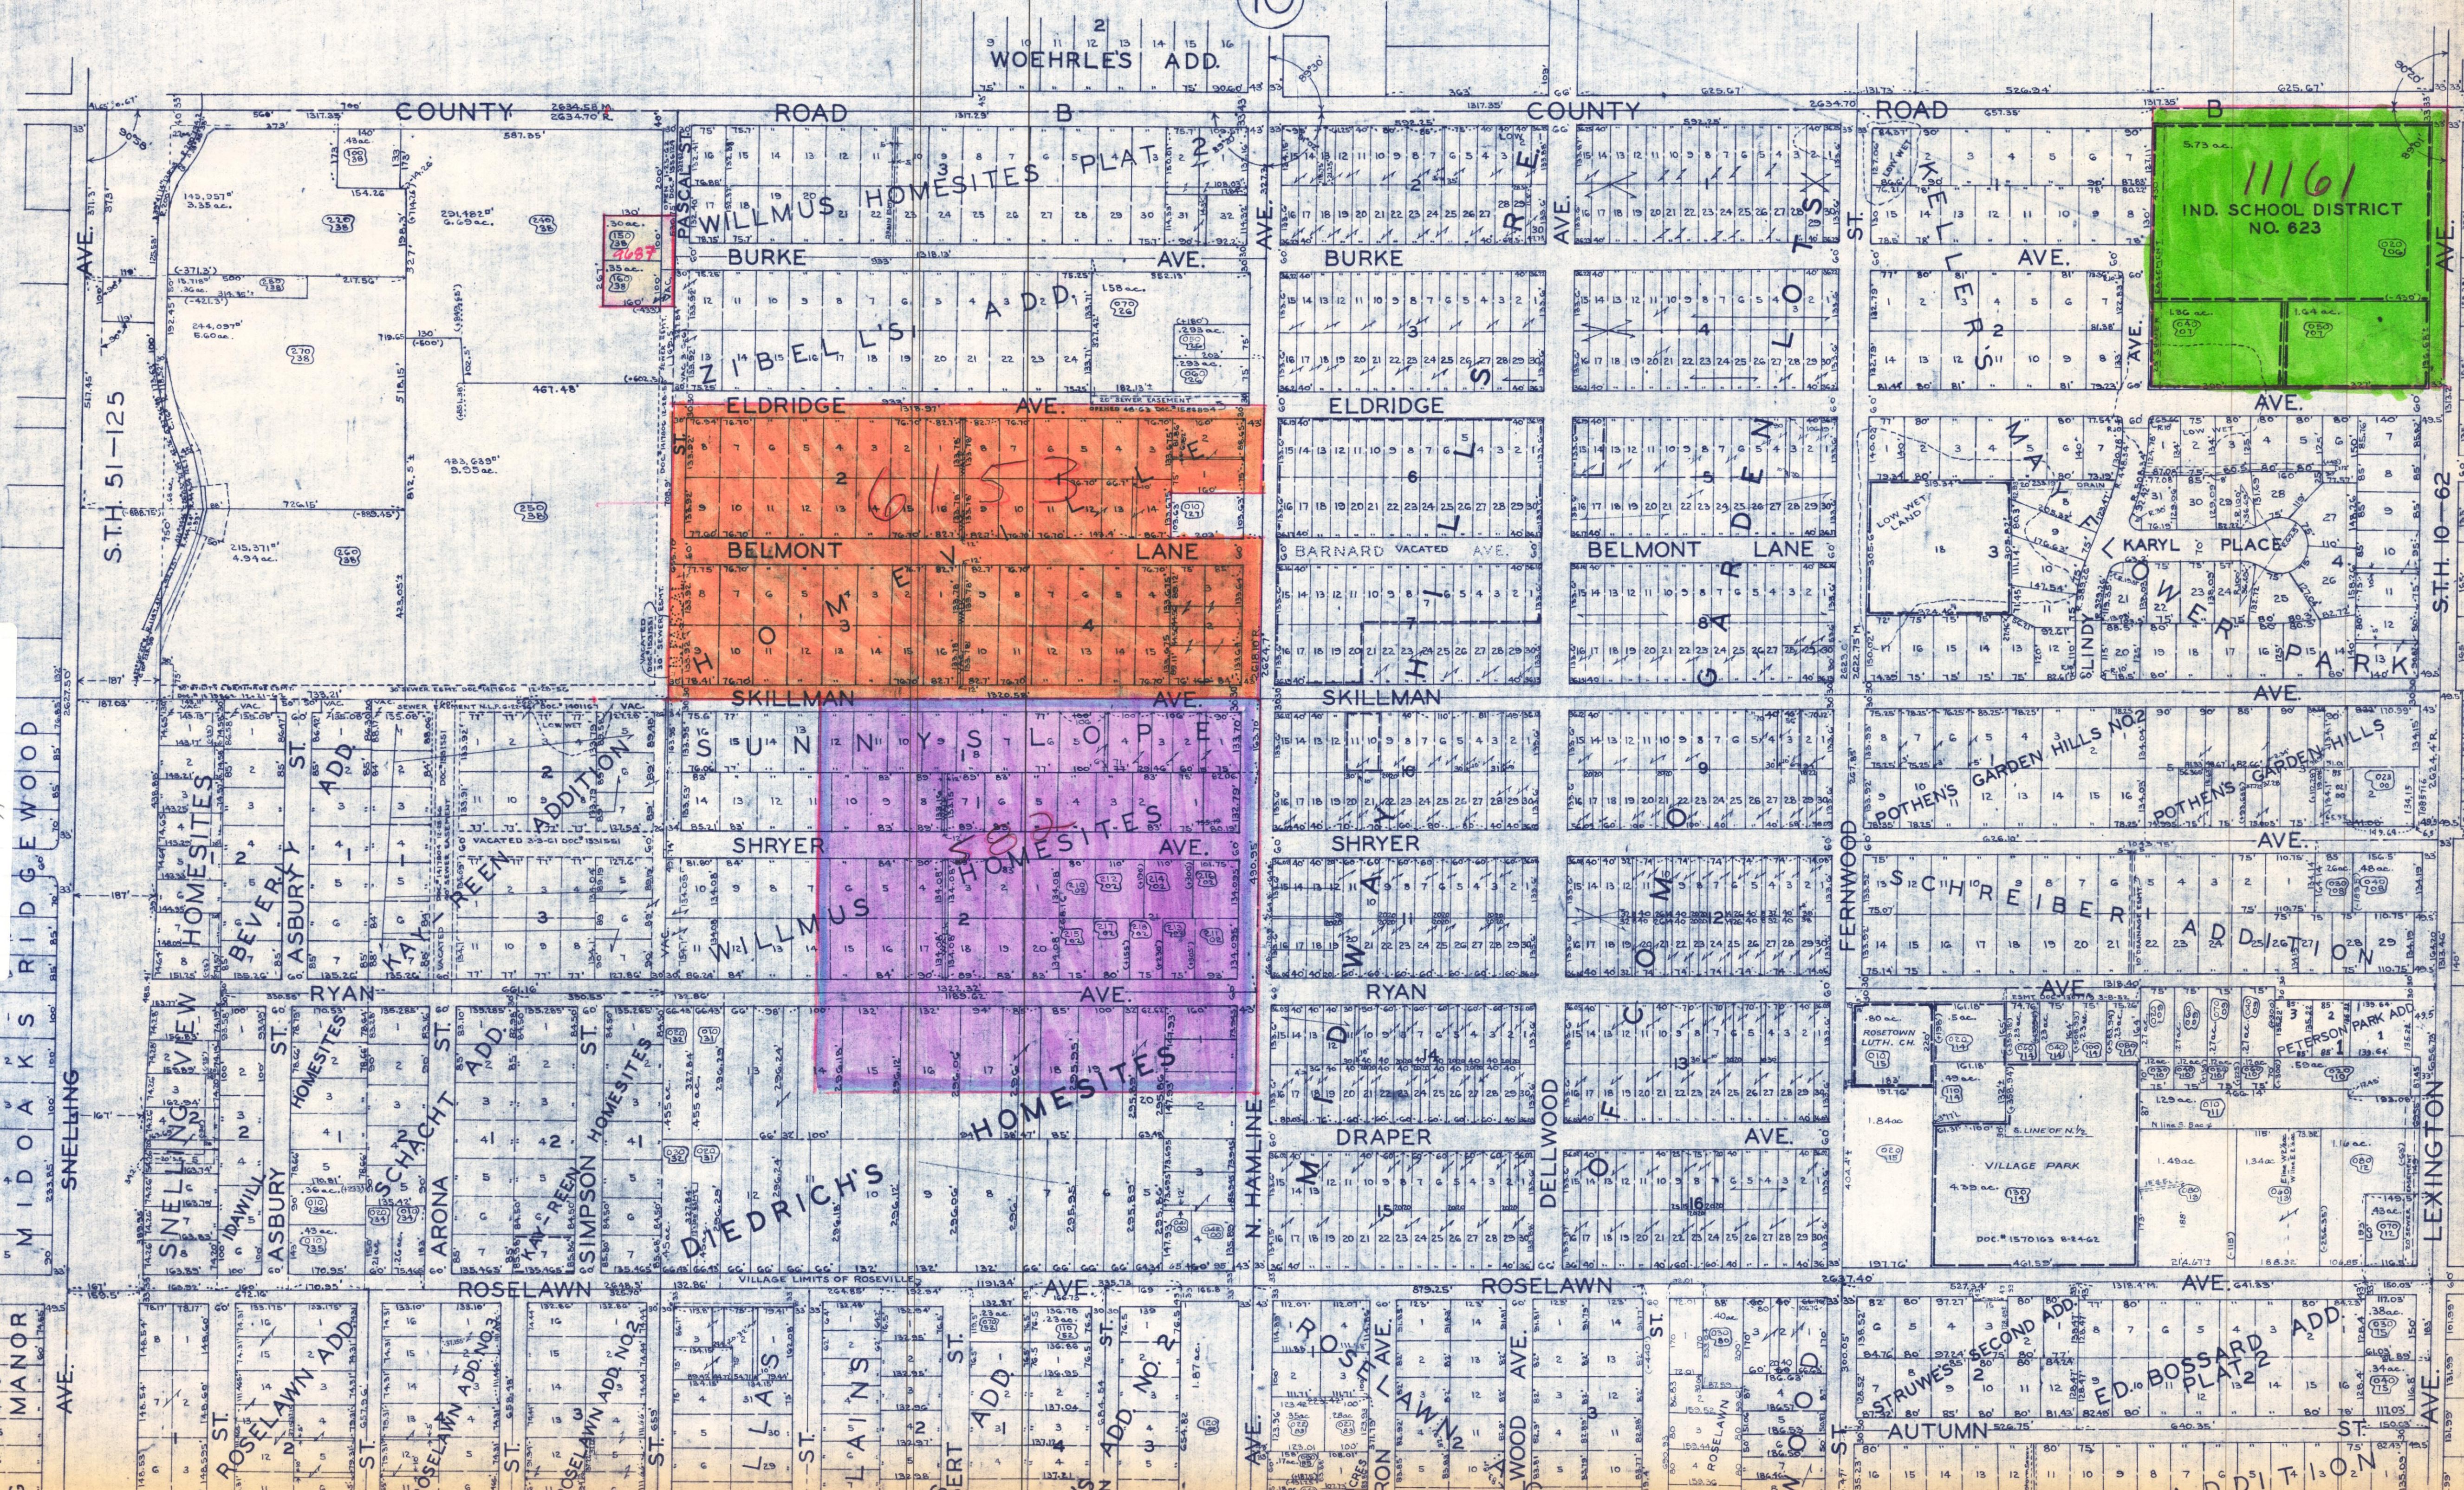

11161
IND. SCHOOL DISTRICT
NO. 623

ELDRIDGE AVE.
BELMONT LANE
HOMESITES

SHRYER AVE.
WILLMUS HOMESITES

RYAN AVE.
DRAPER AVE.
ROSELAWN AVE.

ROSELAWN AVE.
VILLAGE PARK
PETERSON PARK ADD.

LEXINGTON AVE.
BOSSARD ADD.