

SECTION 16, T.30, R.22.


9

16-30-22

17

91-14242

91-14242

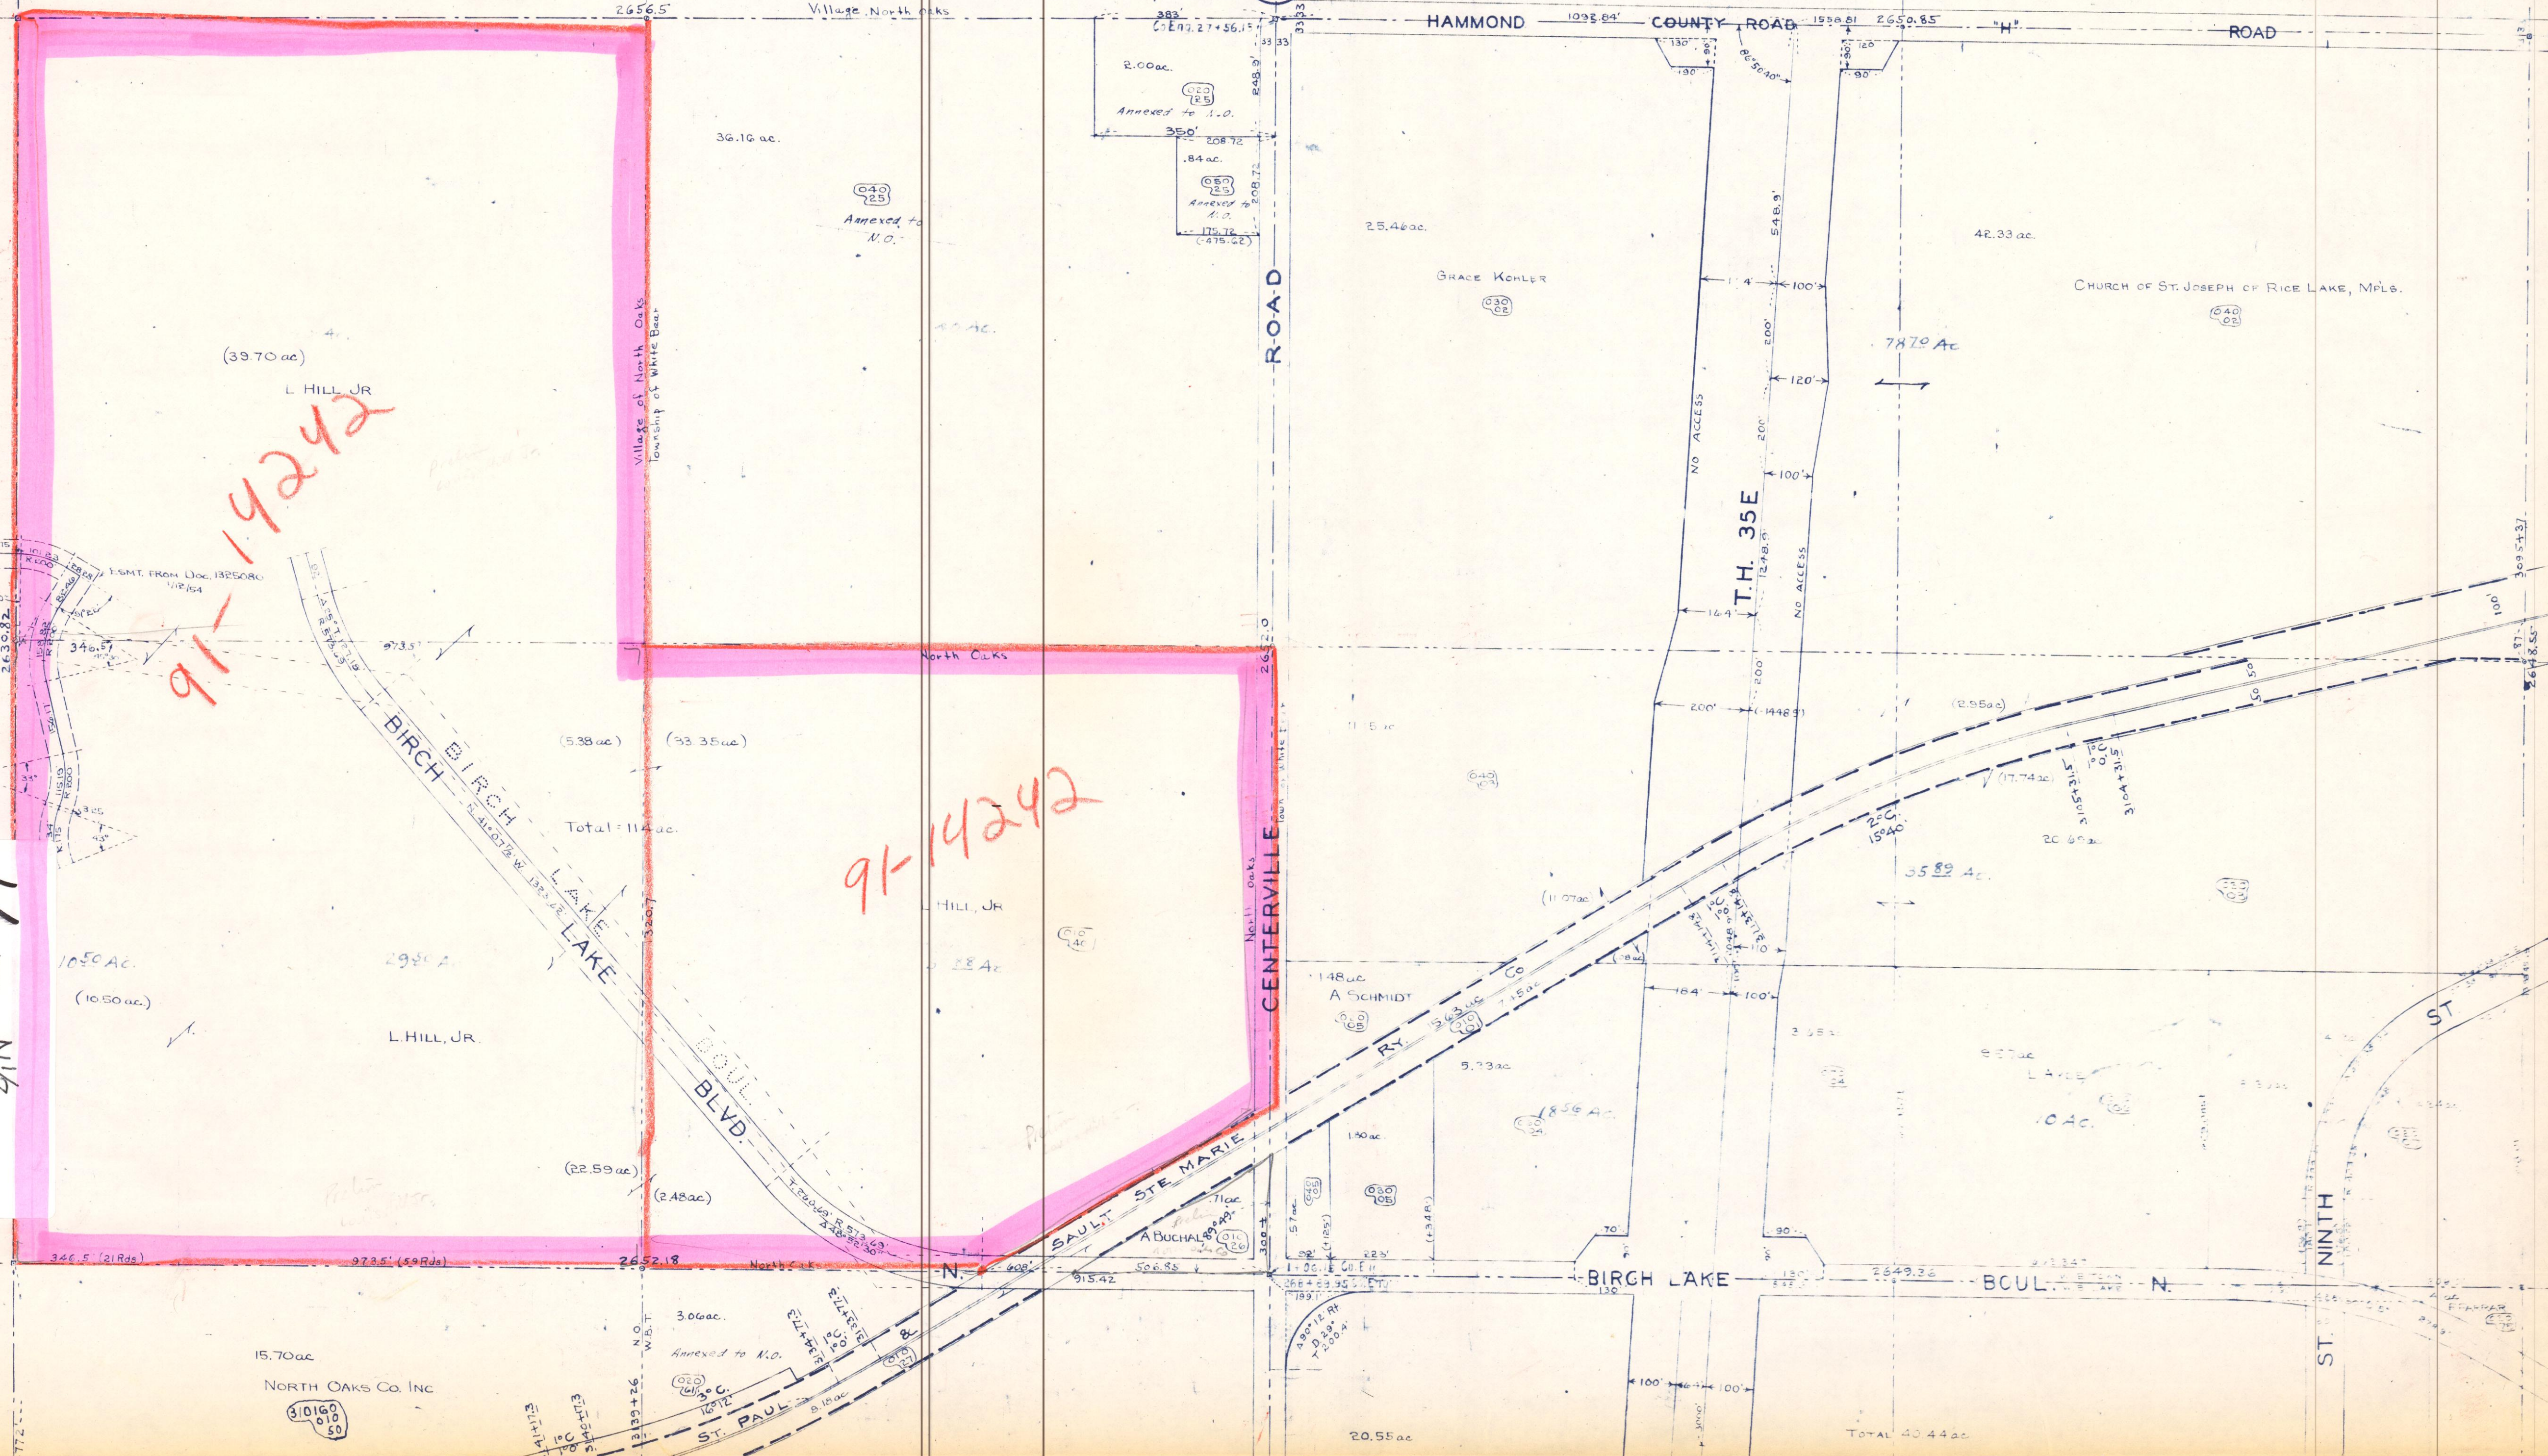

15