


# SECTION 20 T. 30 R. 23

17

20-30-23  
NW

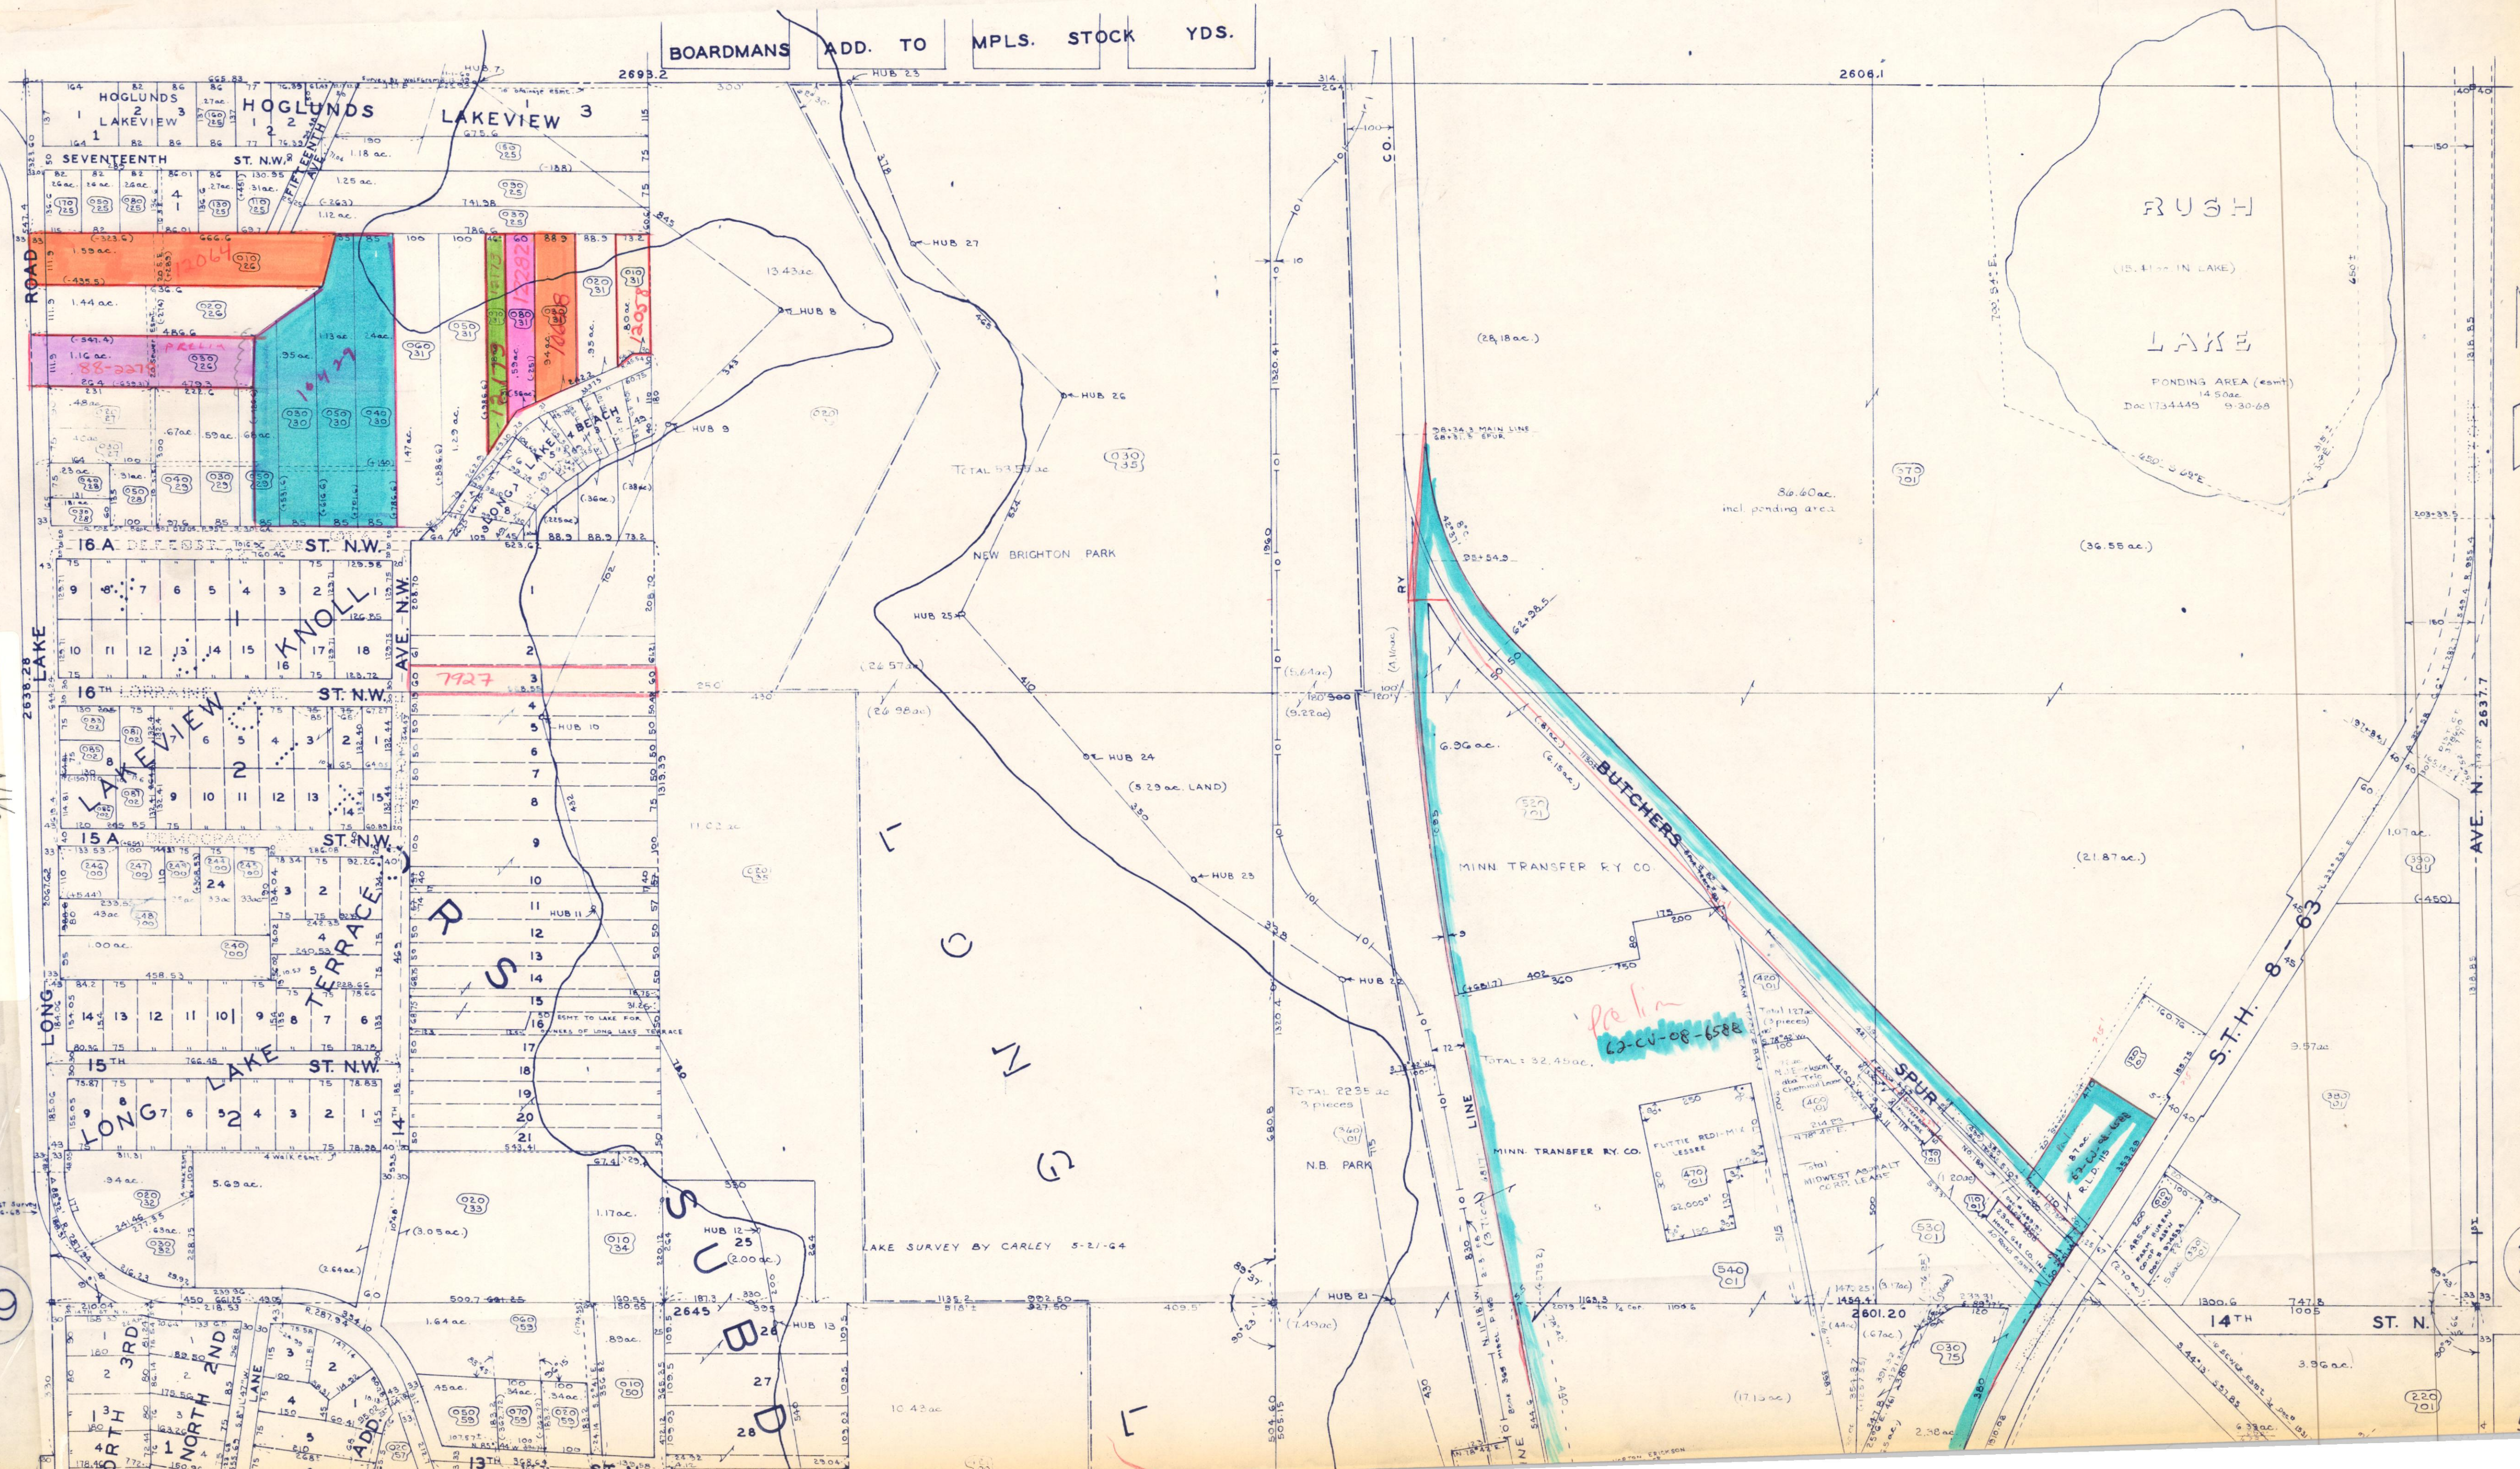

19

21

ERS  
T No. 1