


SECTION 23. T. 30. R. 22.

14

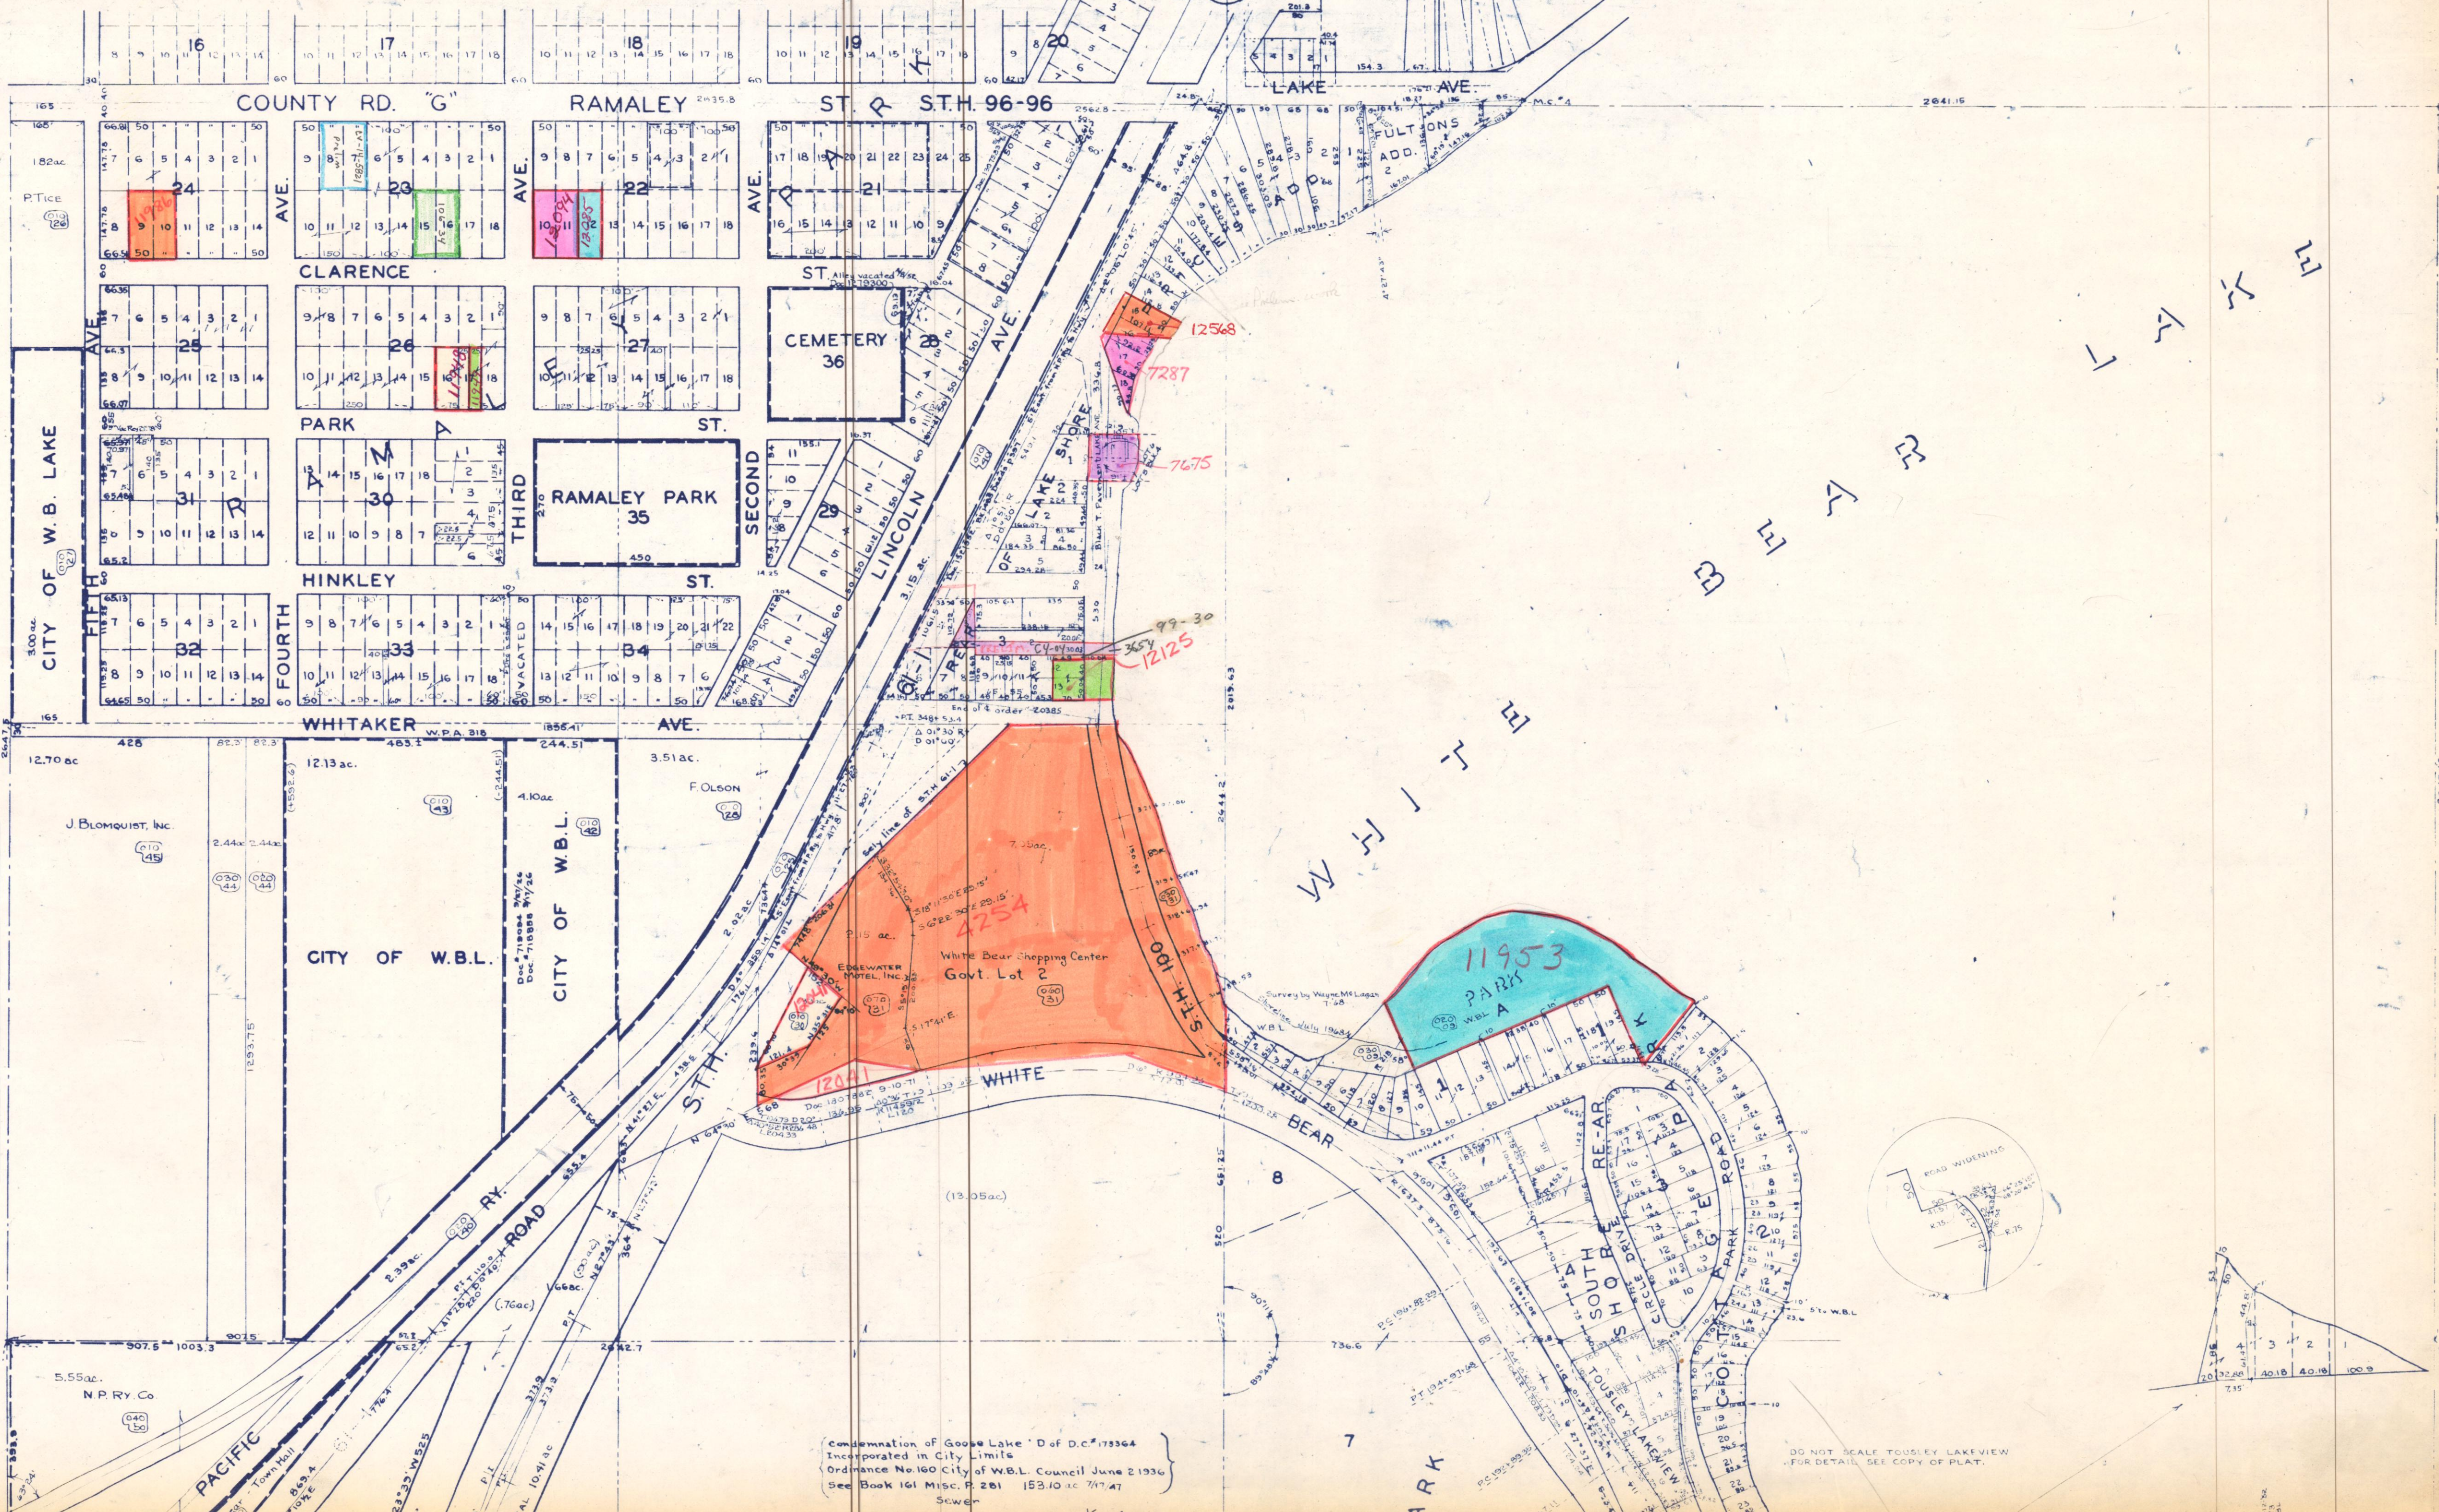

23-30-22  
N/S

22

24

Condemnation of Goose Lake 'D of D.C. 175364  
Incorporated in City Limits  
Ordinance No. 160 City of W.B.L. Council June 2 1936  
See Book 161 Misc. P. 261 153.10 ac 7/7/47  
Sewer

DO NOT SCALE TOUSLEY LAKEVIEW  
FOR DETAIL SEE COPY OF PLAT.

W H I T E B E A R

W H I T E B E A R

ARK