


L
A
K
E

24-30-22
N/A

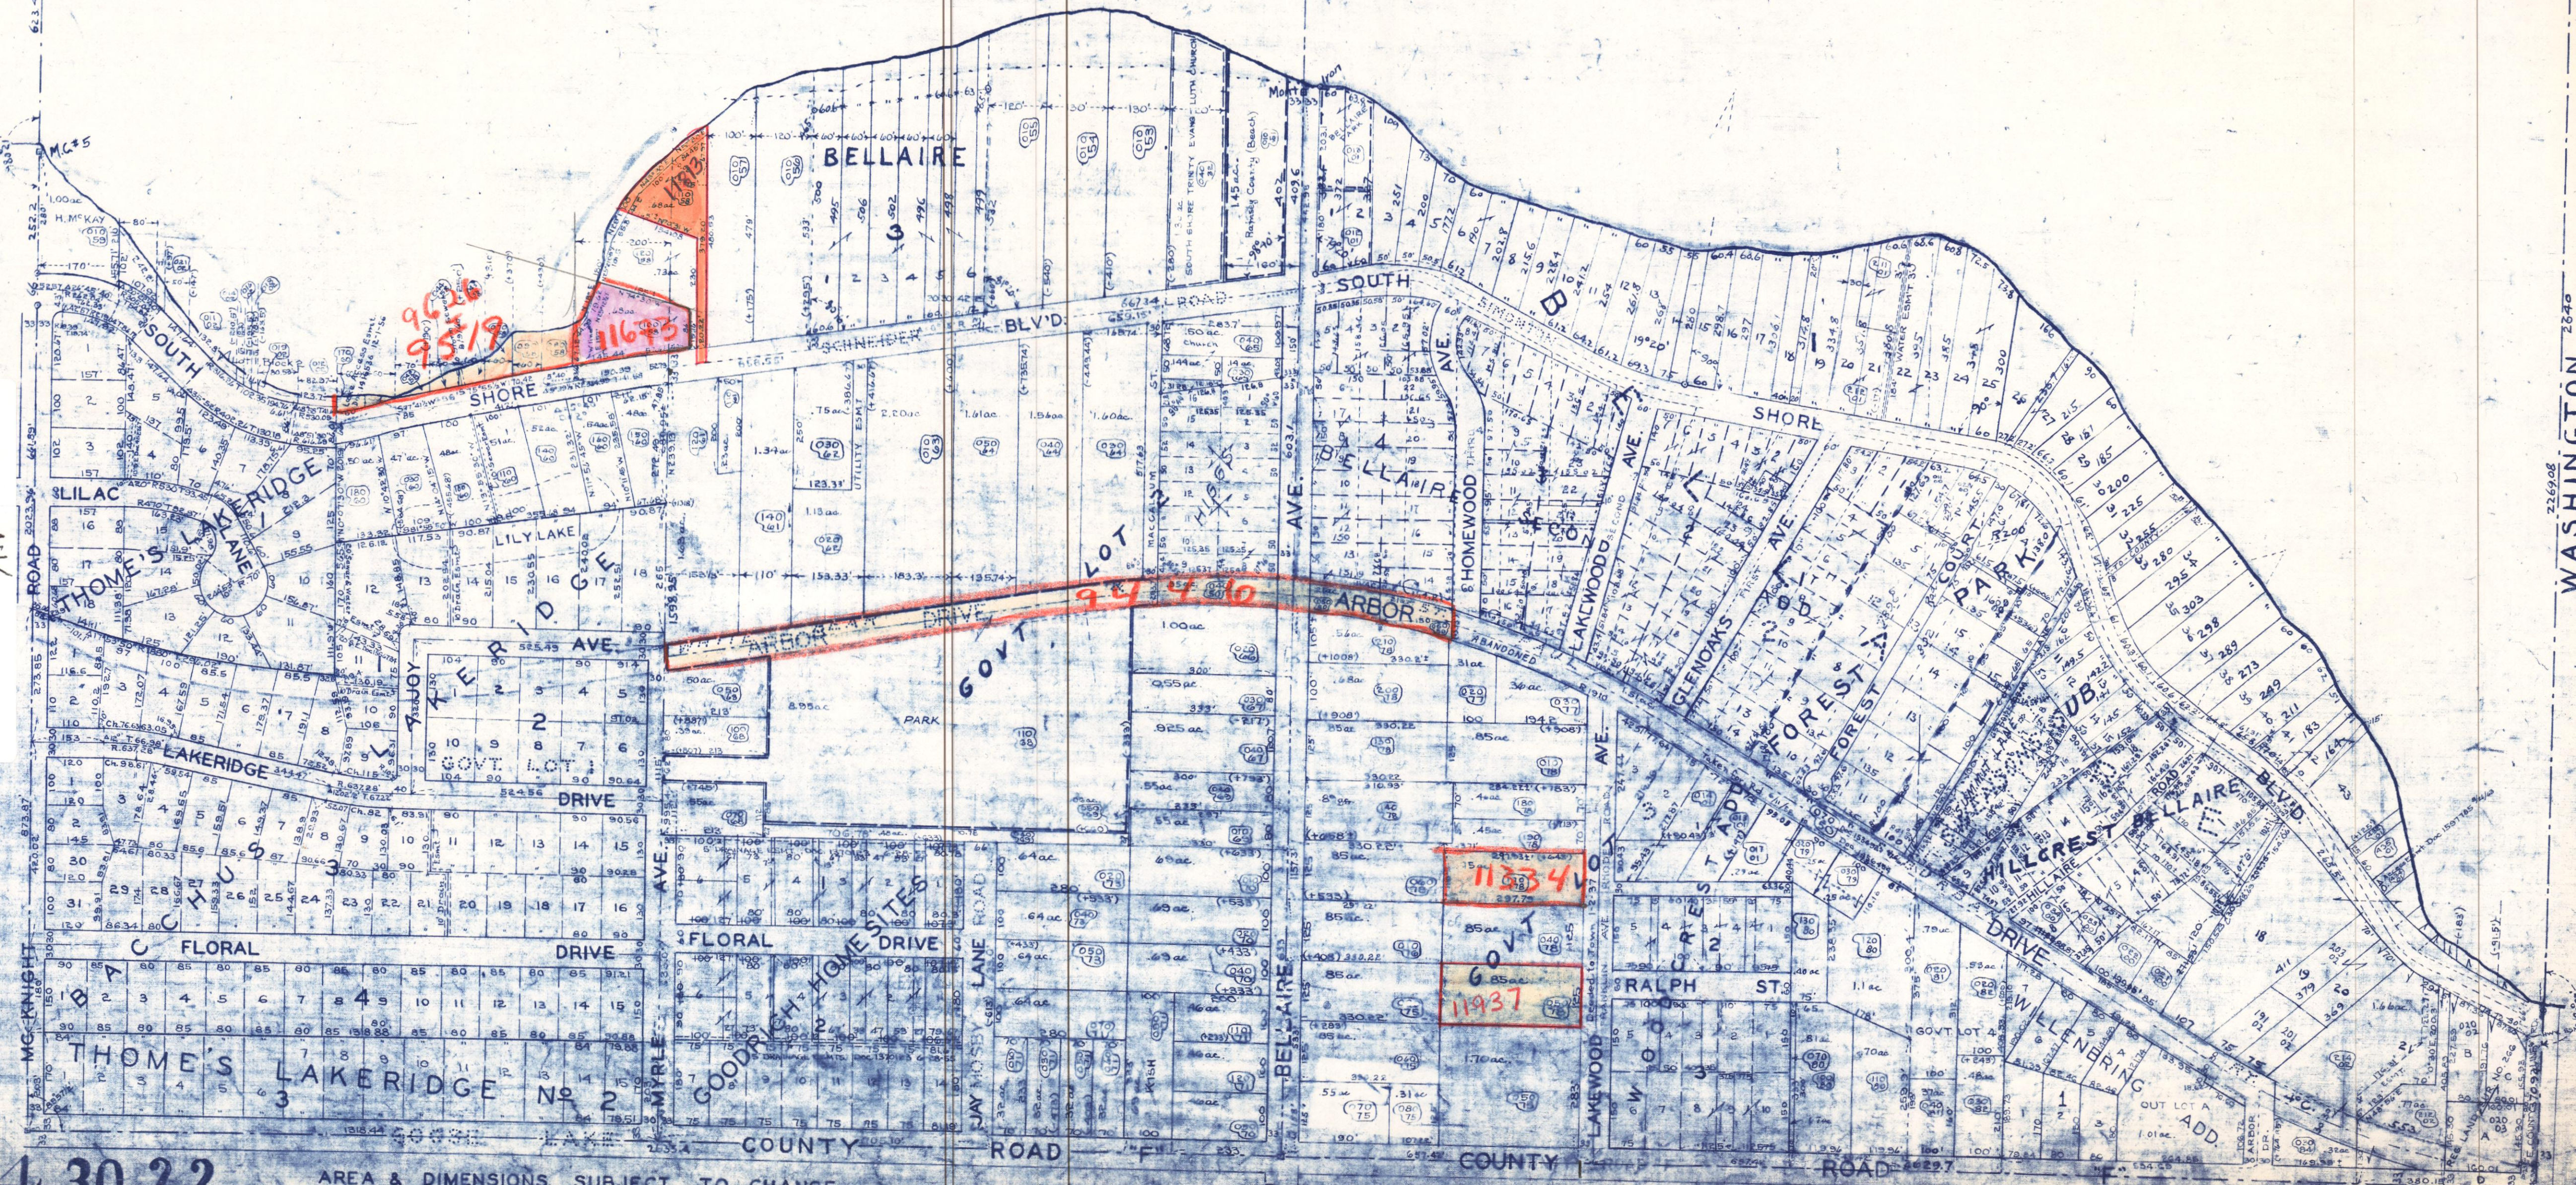

24-30-22
COUNTY ASSESSOR'S OFFICE

AREA & DIMENSIONS SUBJECT TO CHANGE