


SECTION 25, T.30, R.23.

24

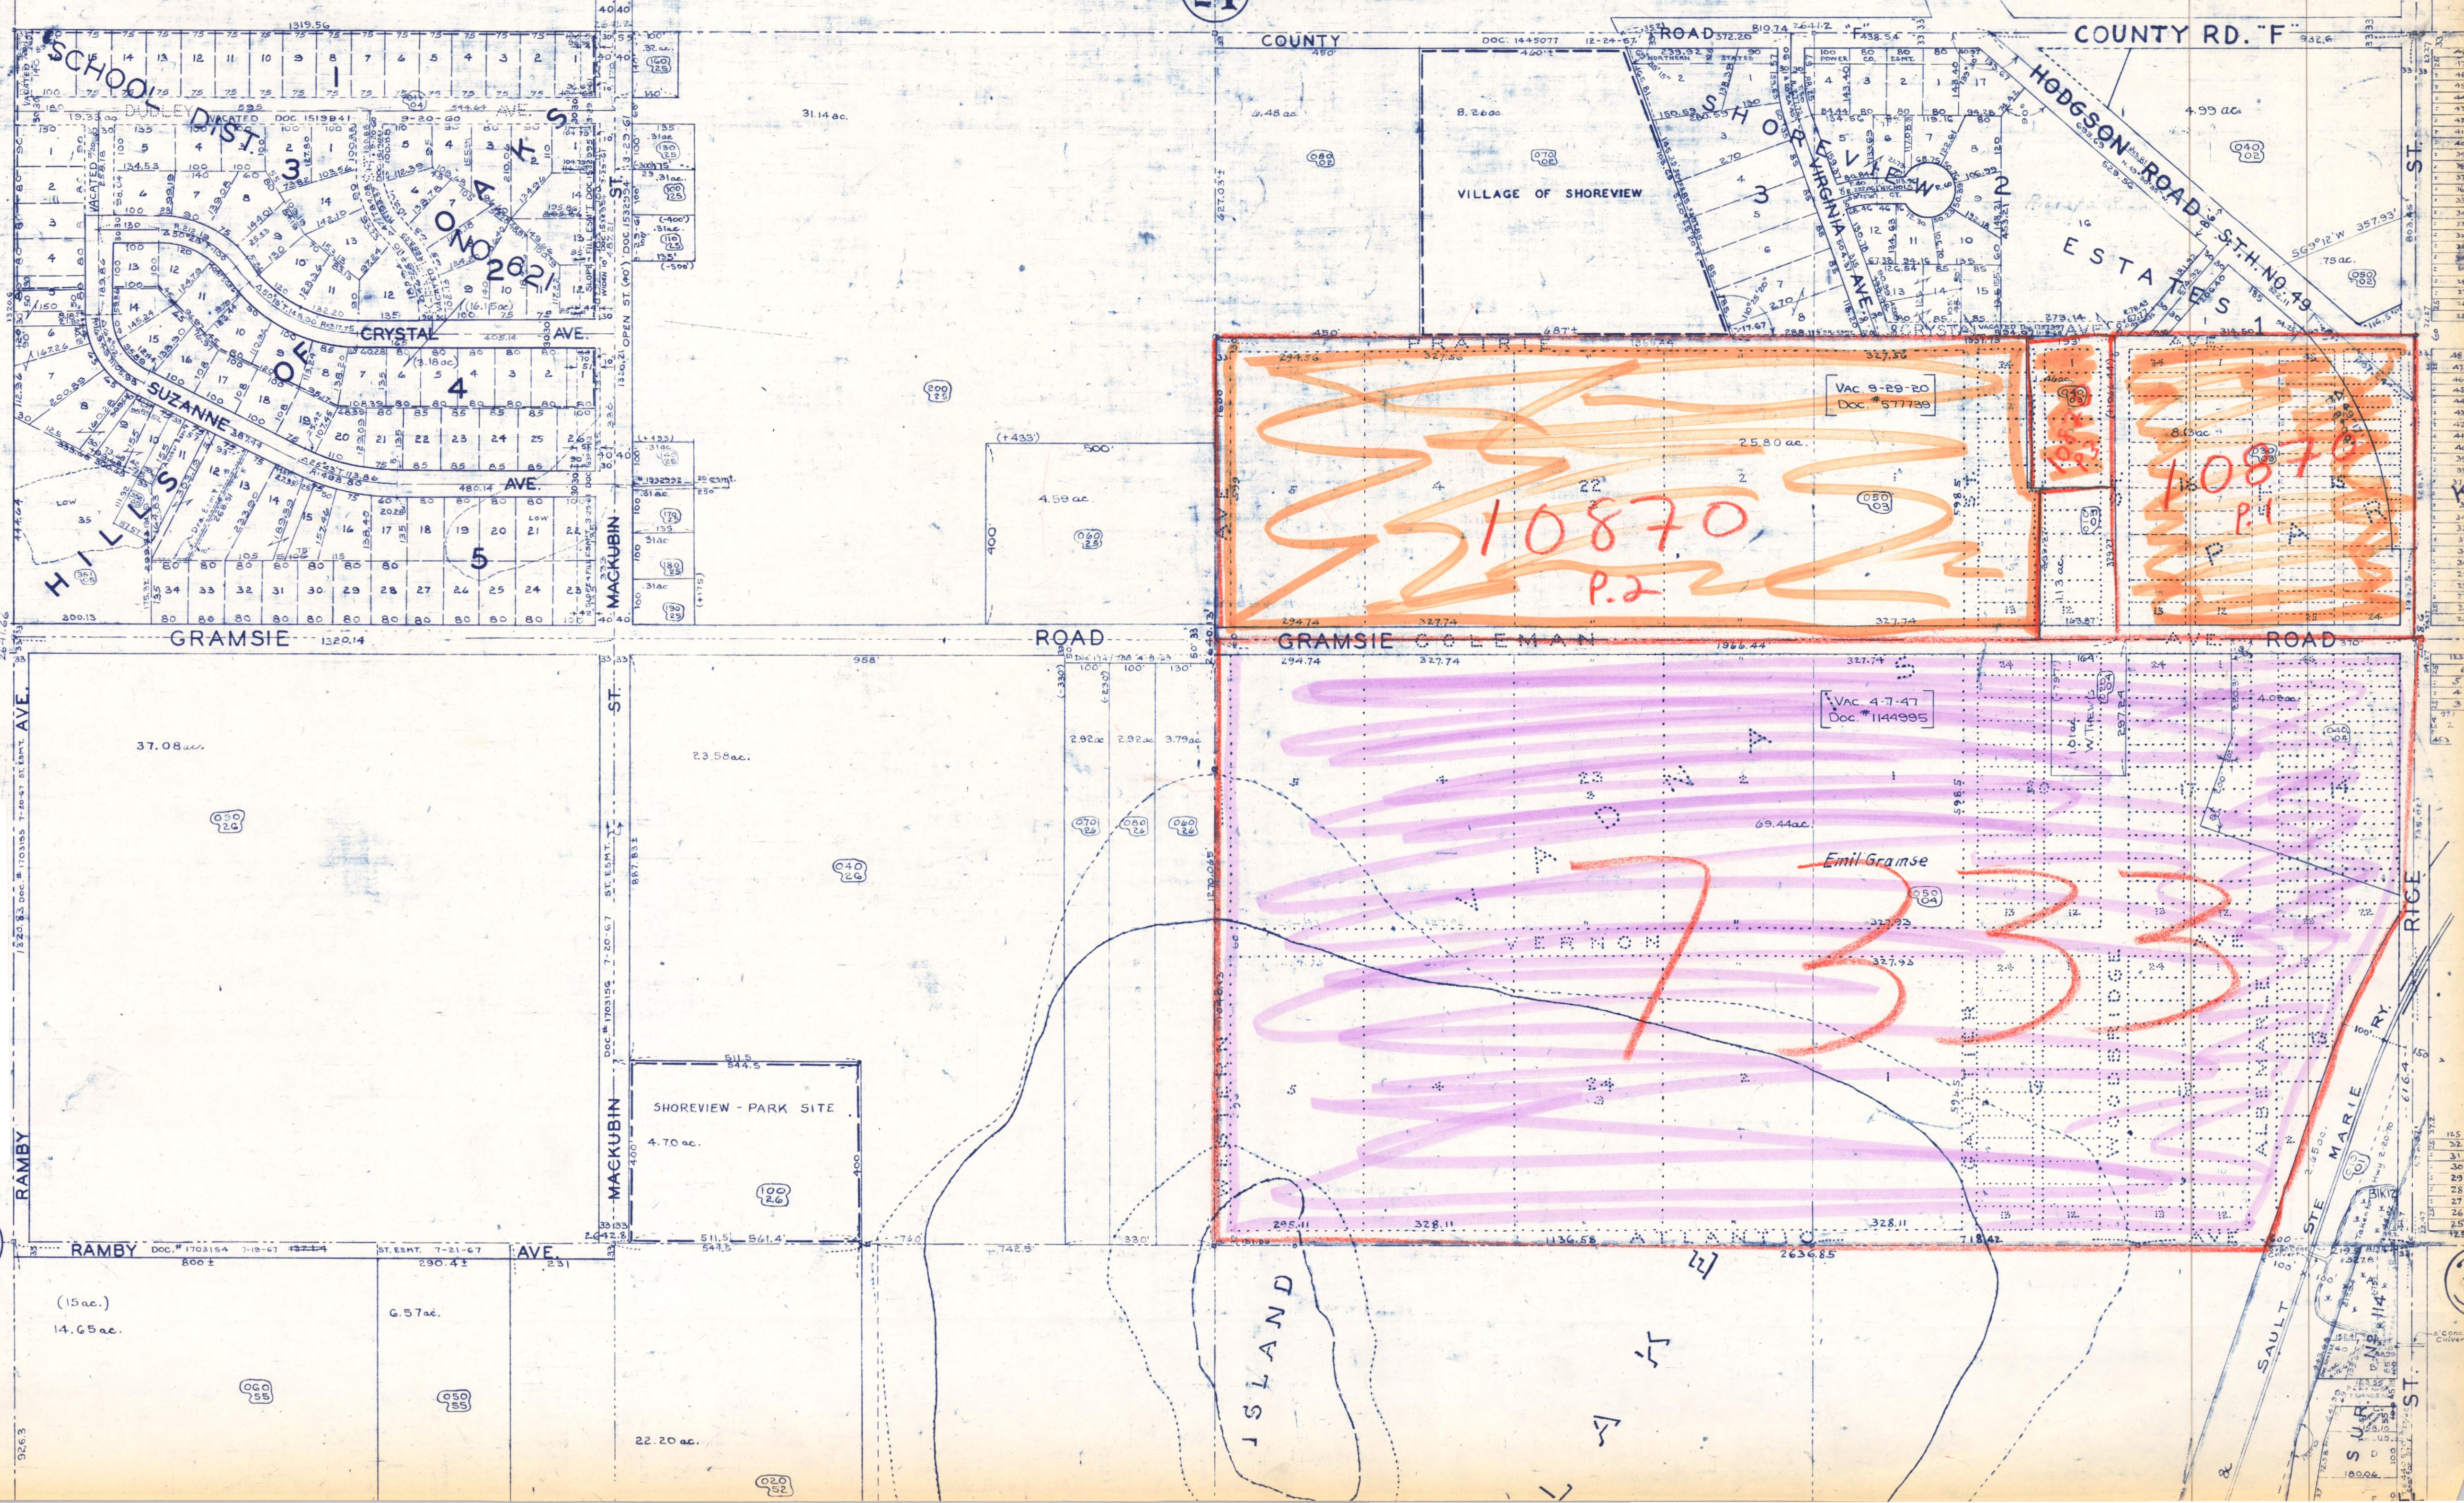

25-30-23
N 1/2

26