


SECTION 28 T.30R.22

21

28-30-22
N 1/2

29

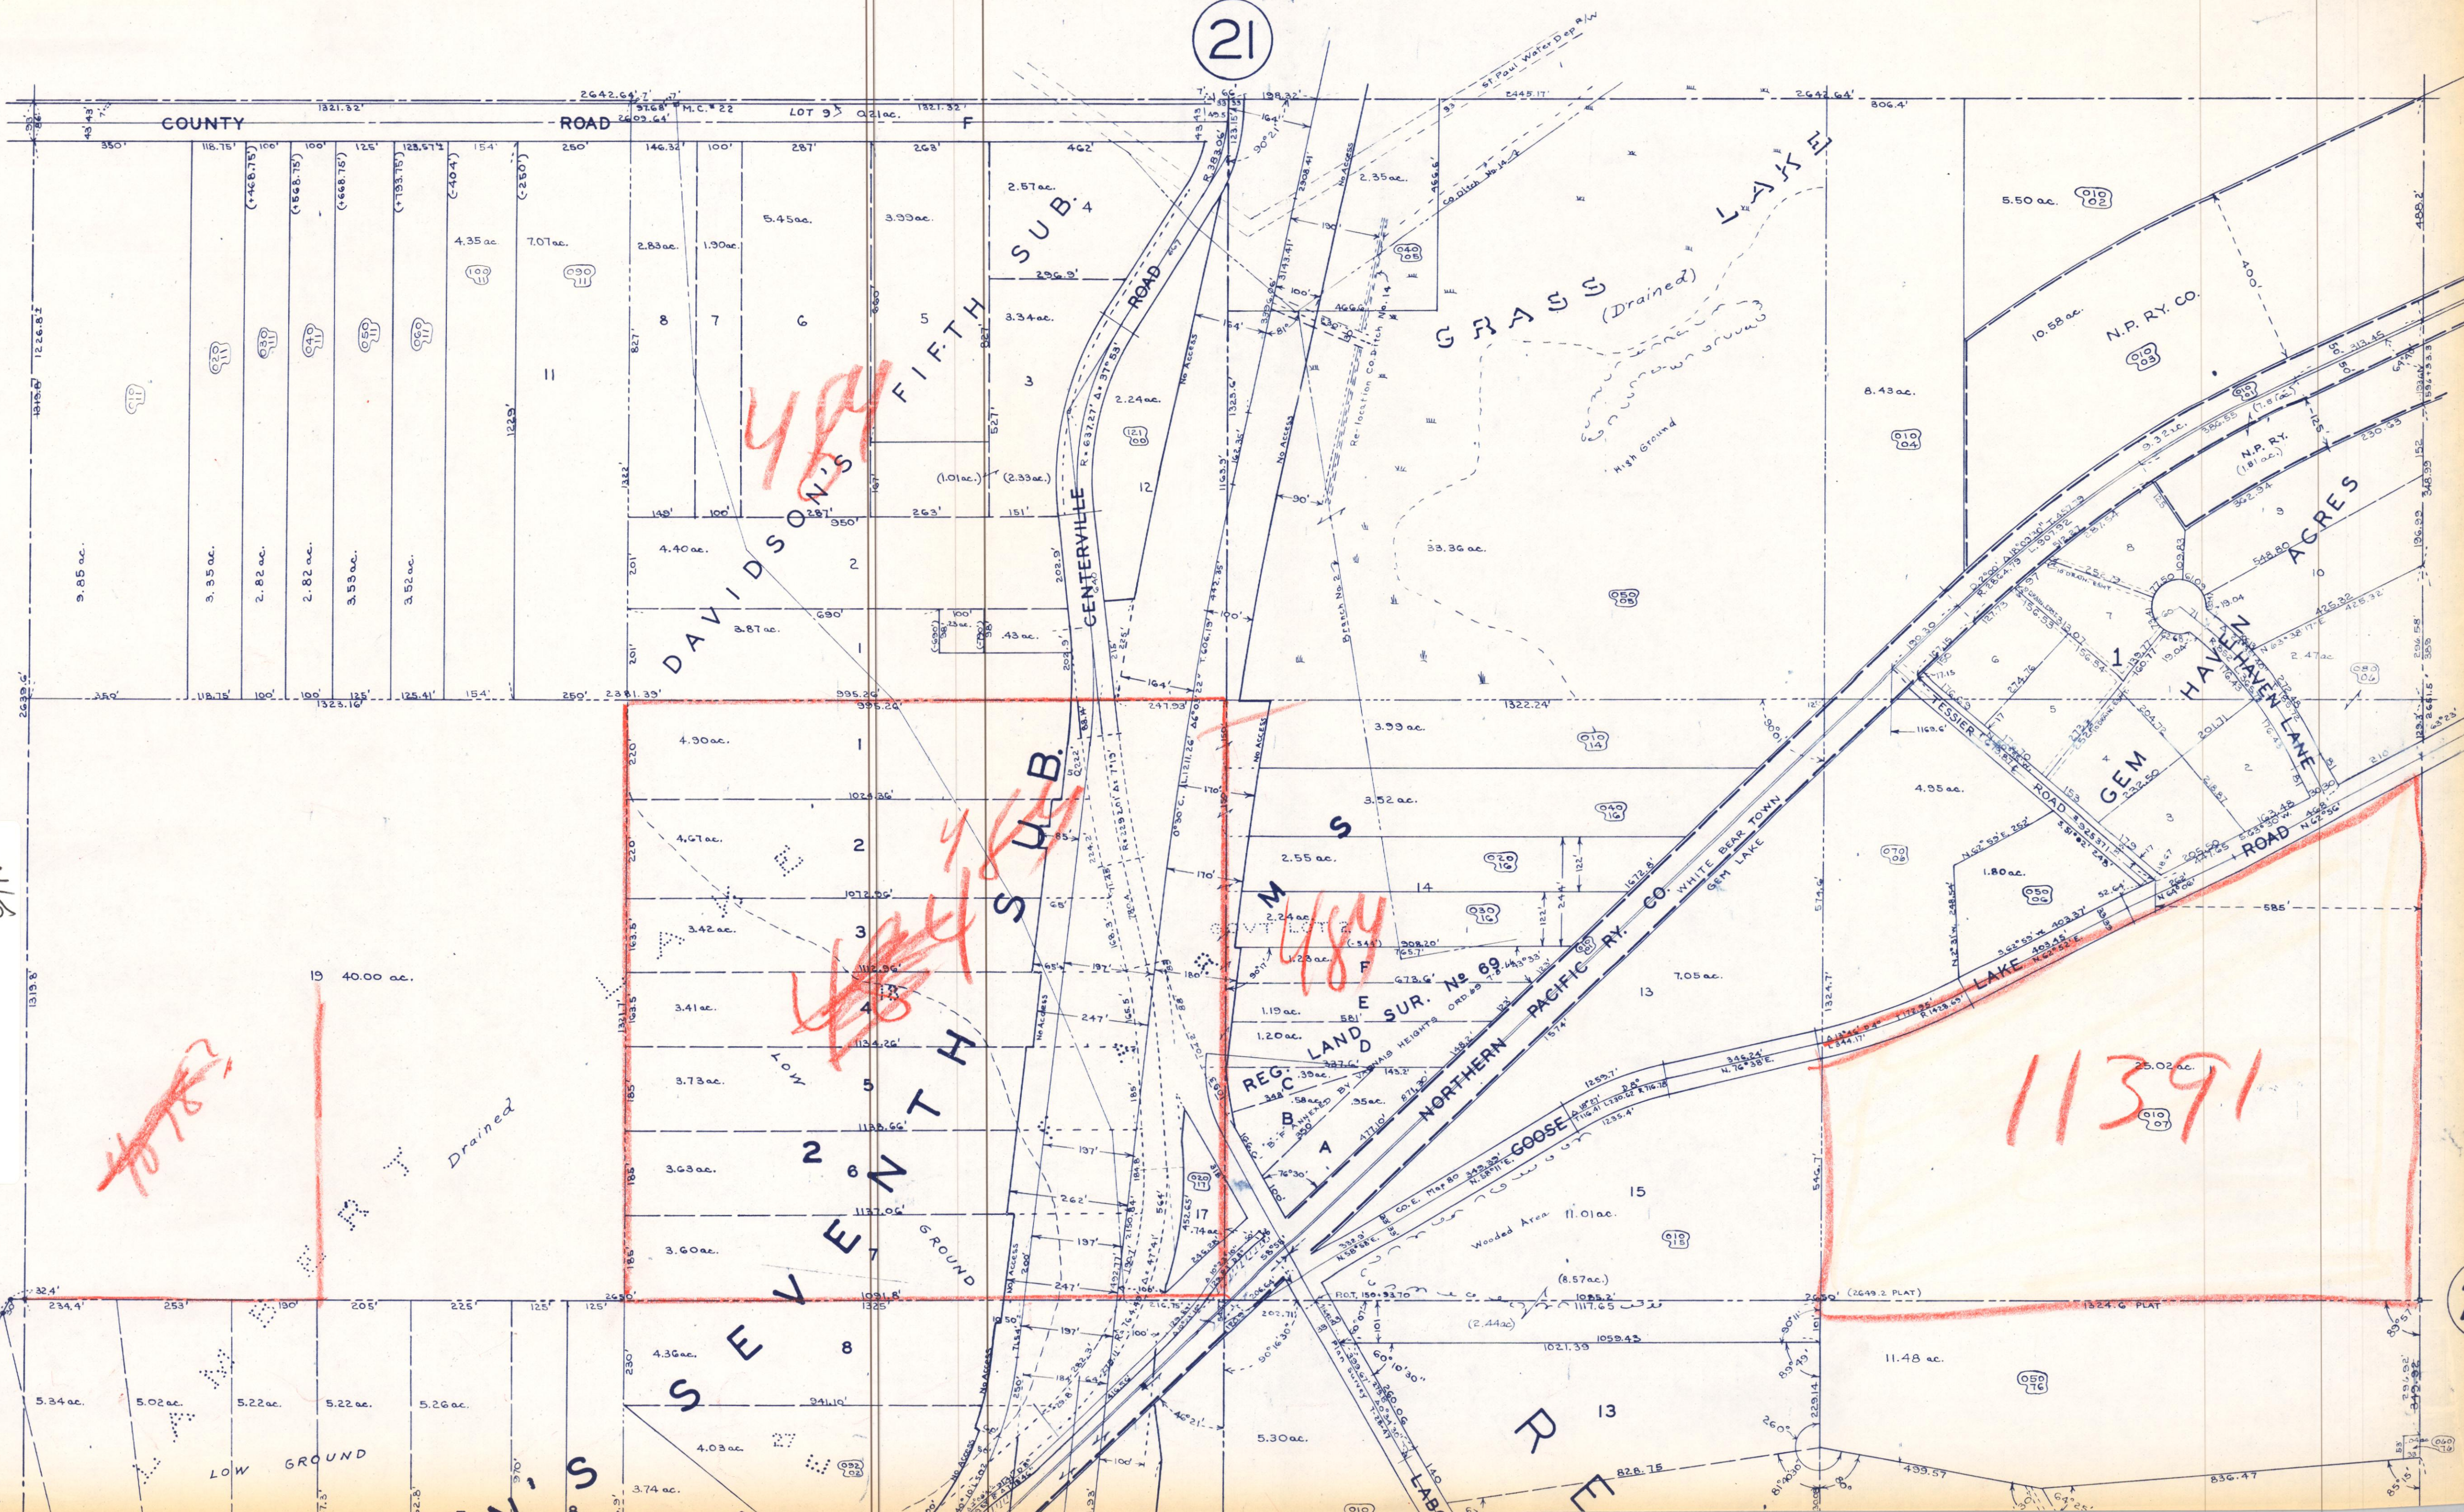

~~1078~~

484 N. 5

484 S. 4 B.

484

11391