


SECTION 35, T.30, R.23.

26

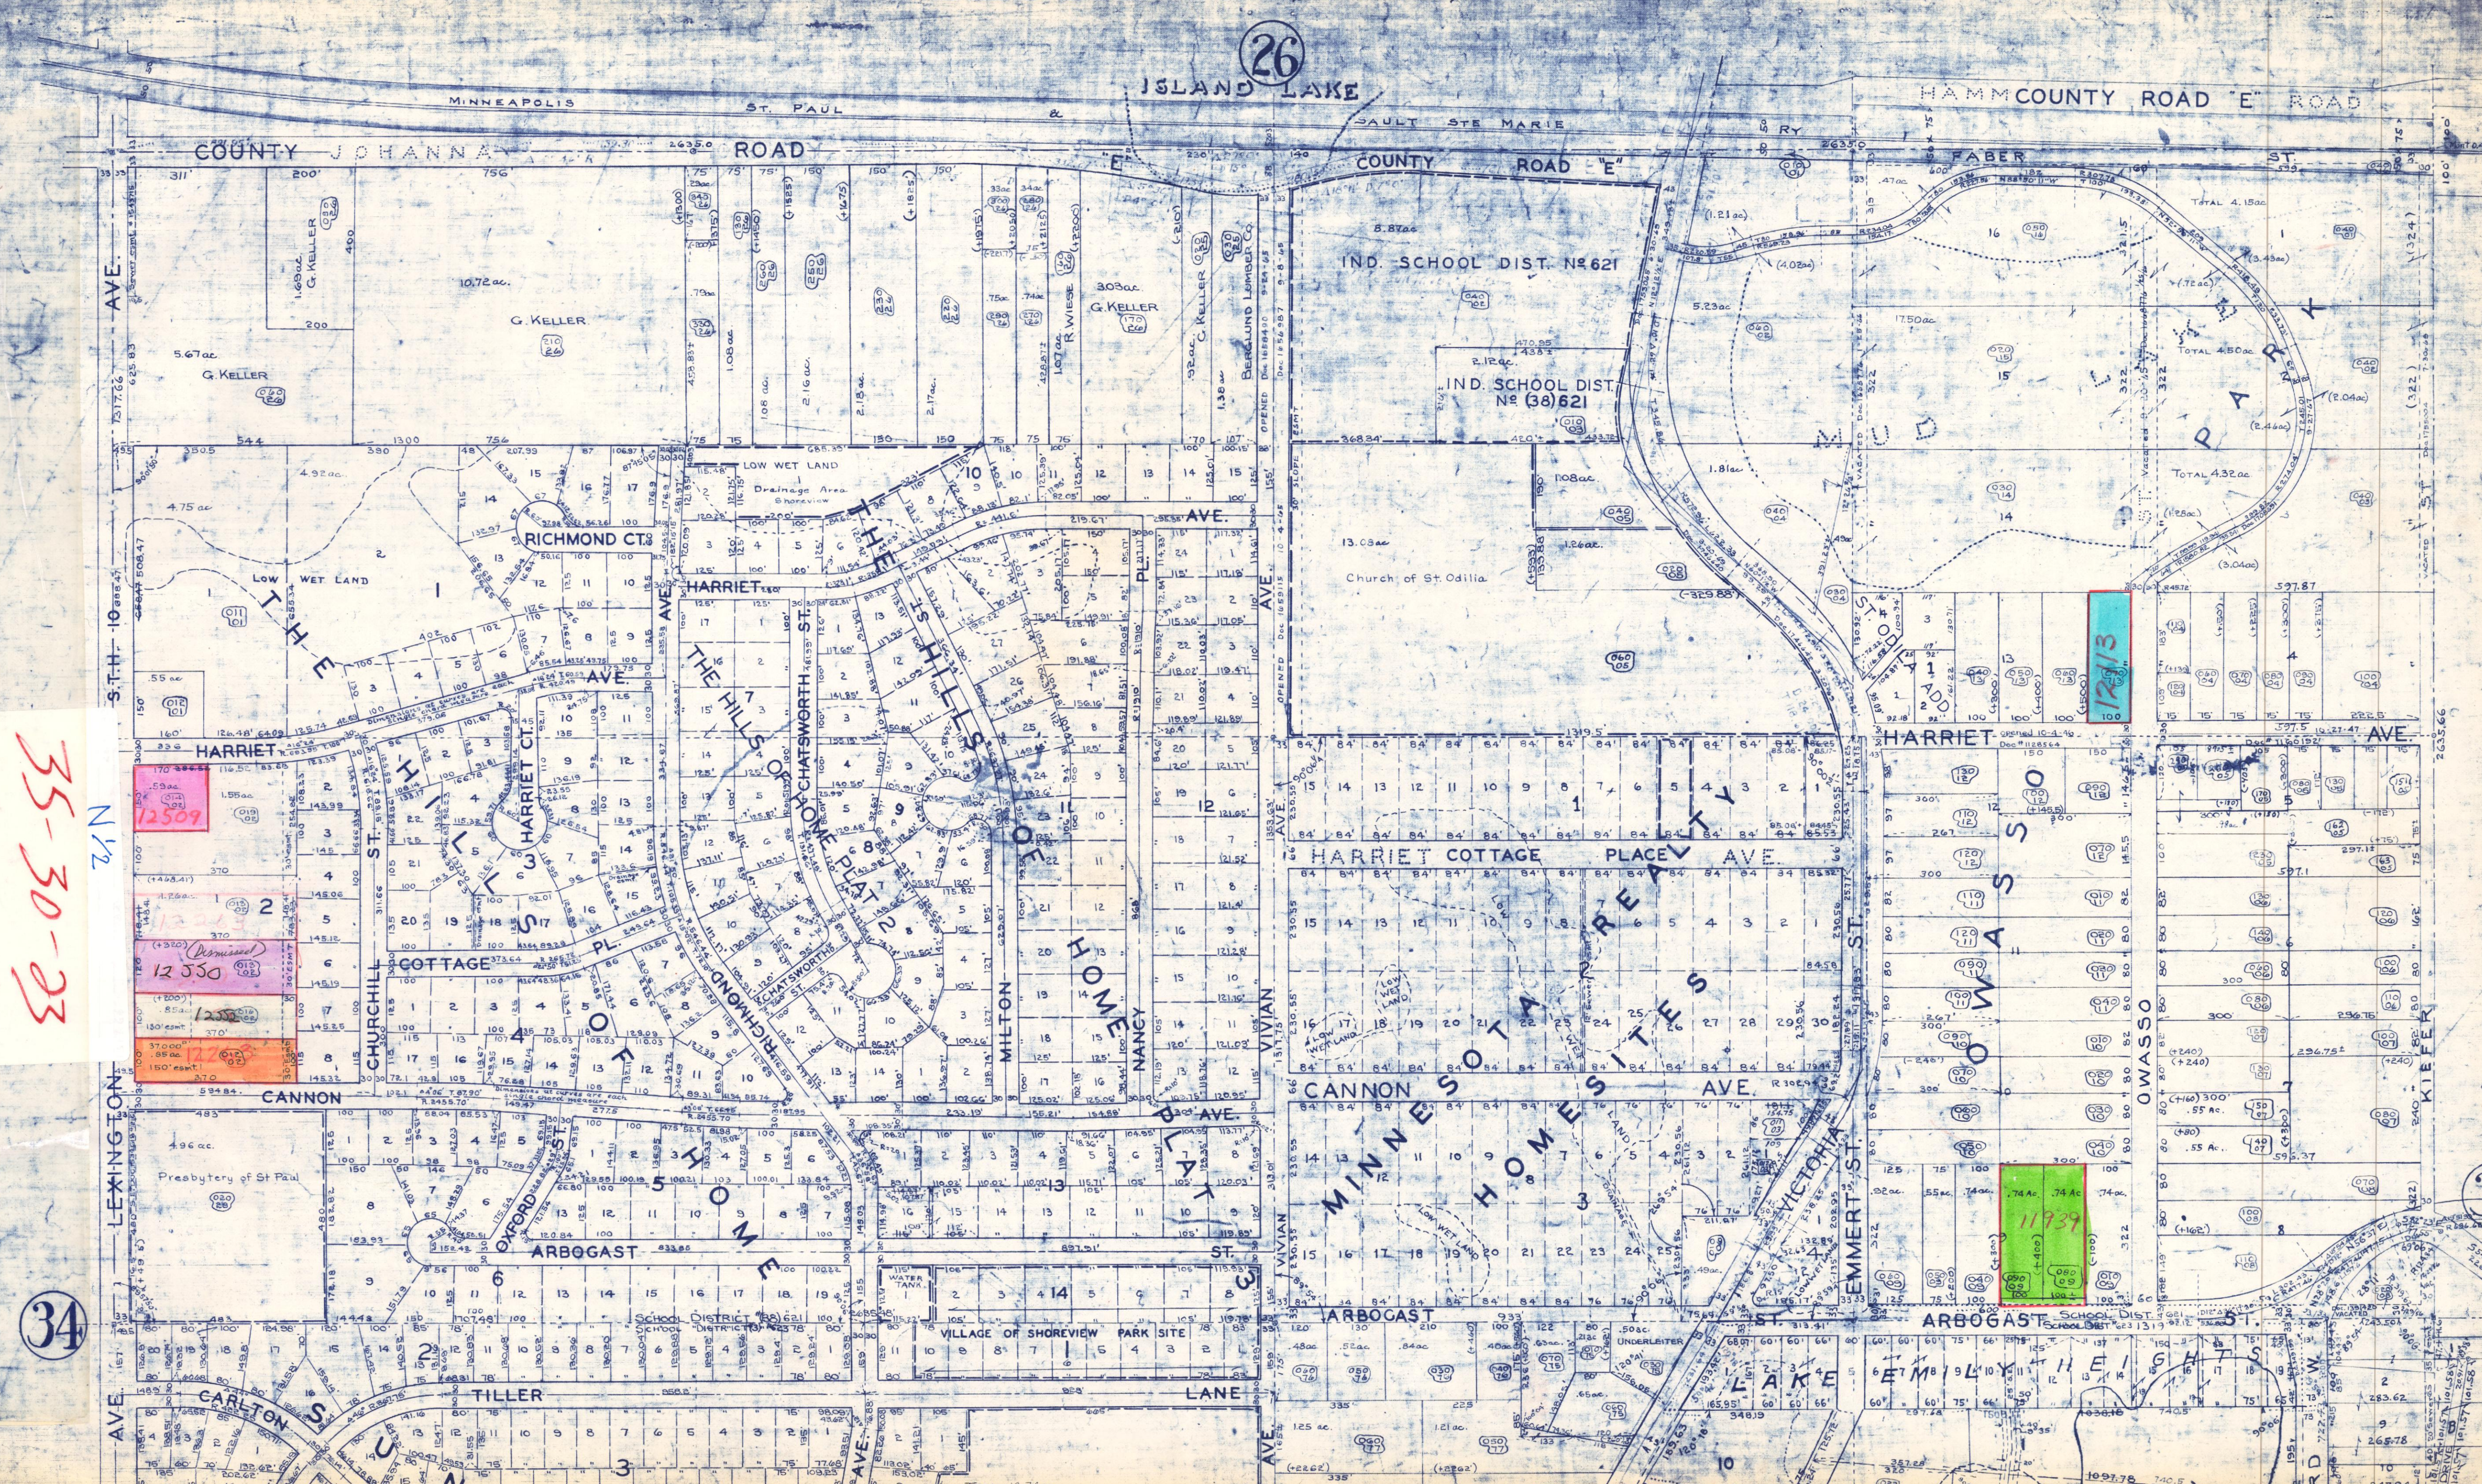

35-30-23
N1/2

12509

12550

12550

12550

11739

34

36