


N. E. 1/4 - SEC. 1 - T. 28 - R. 23

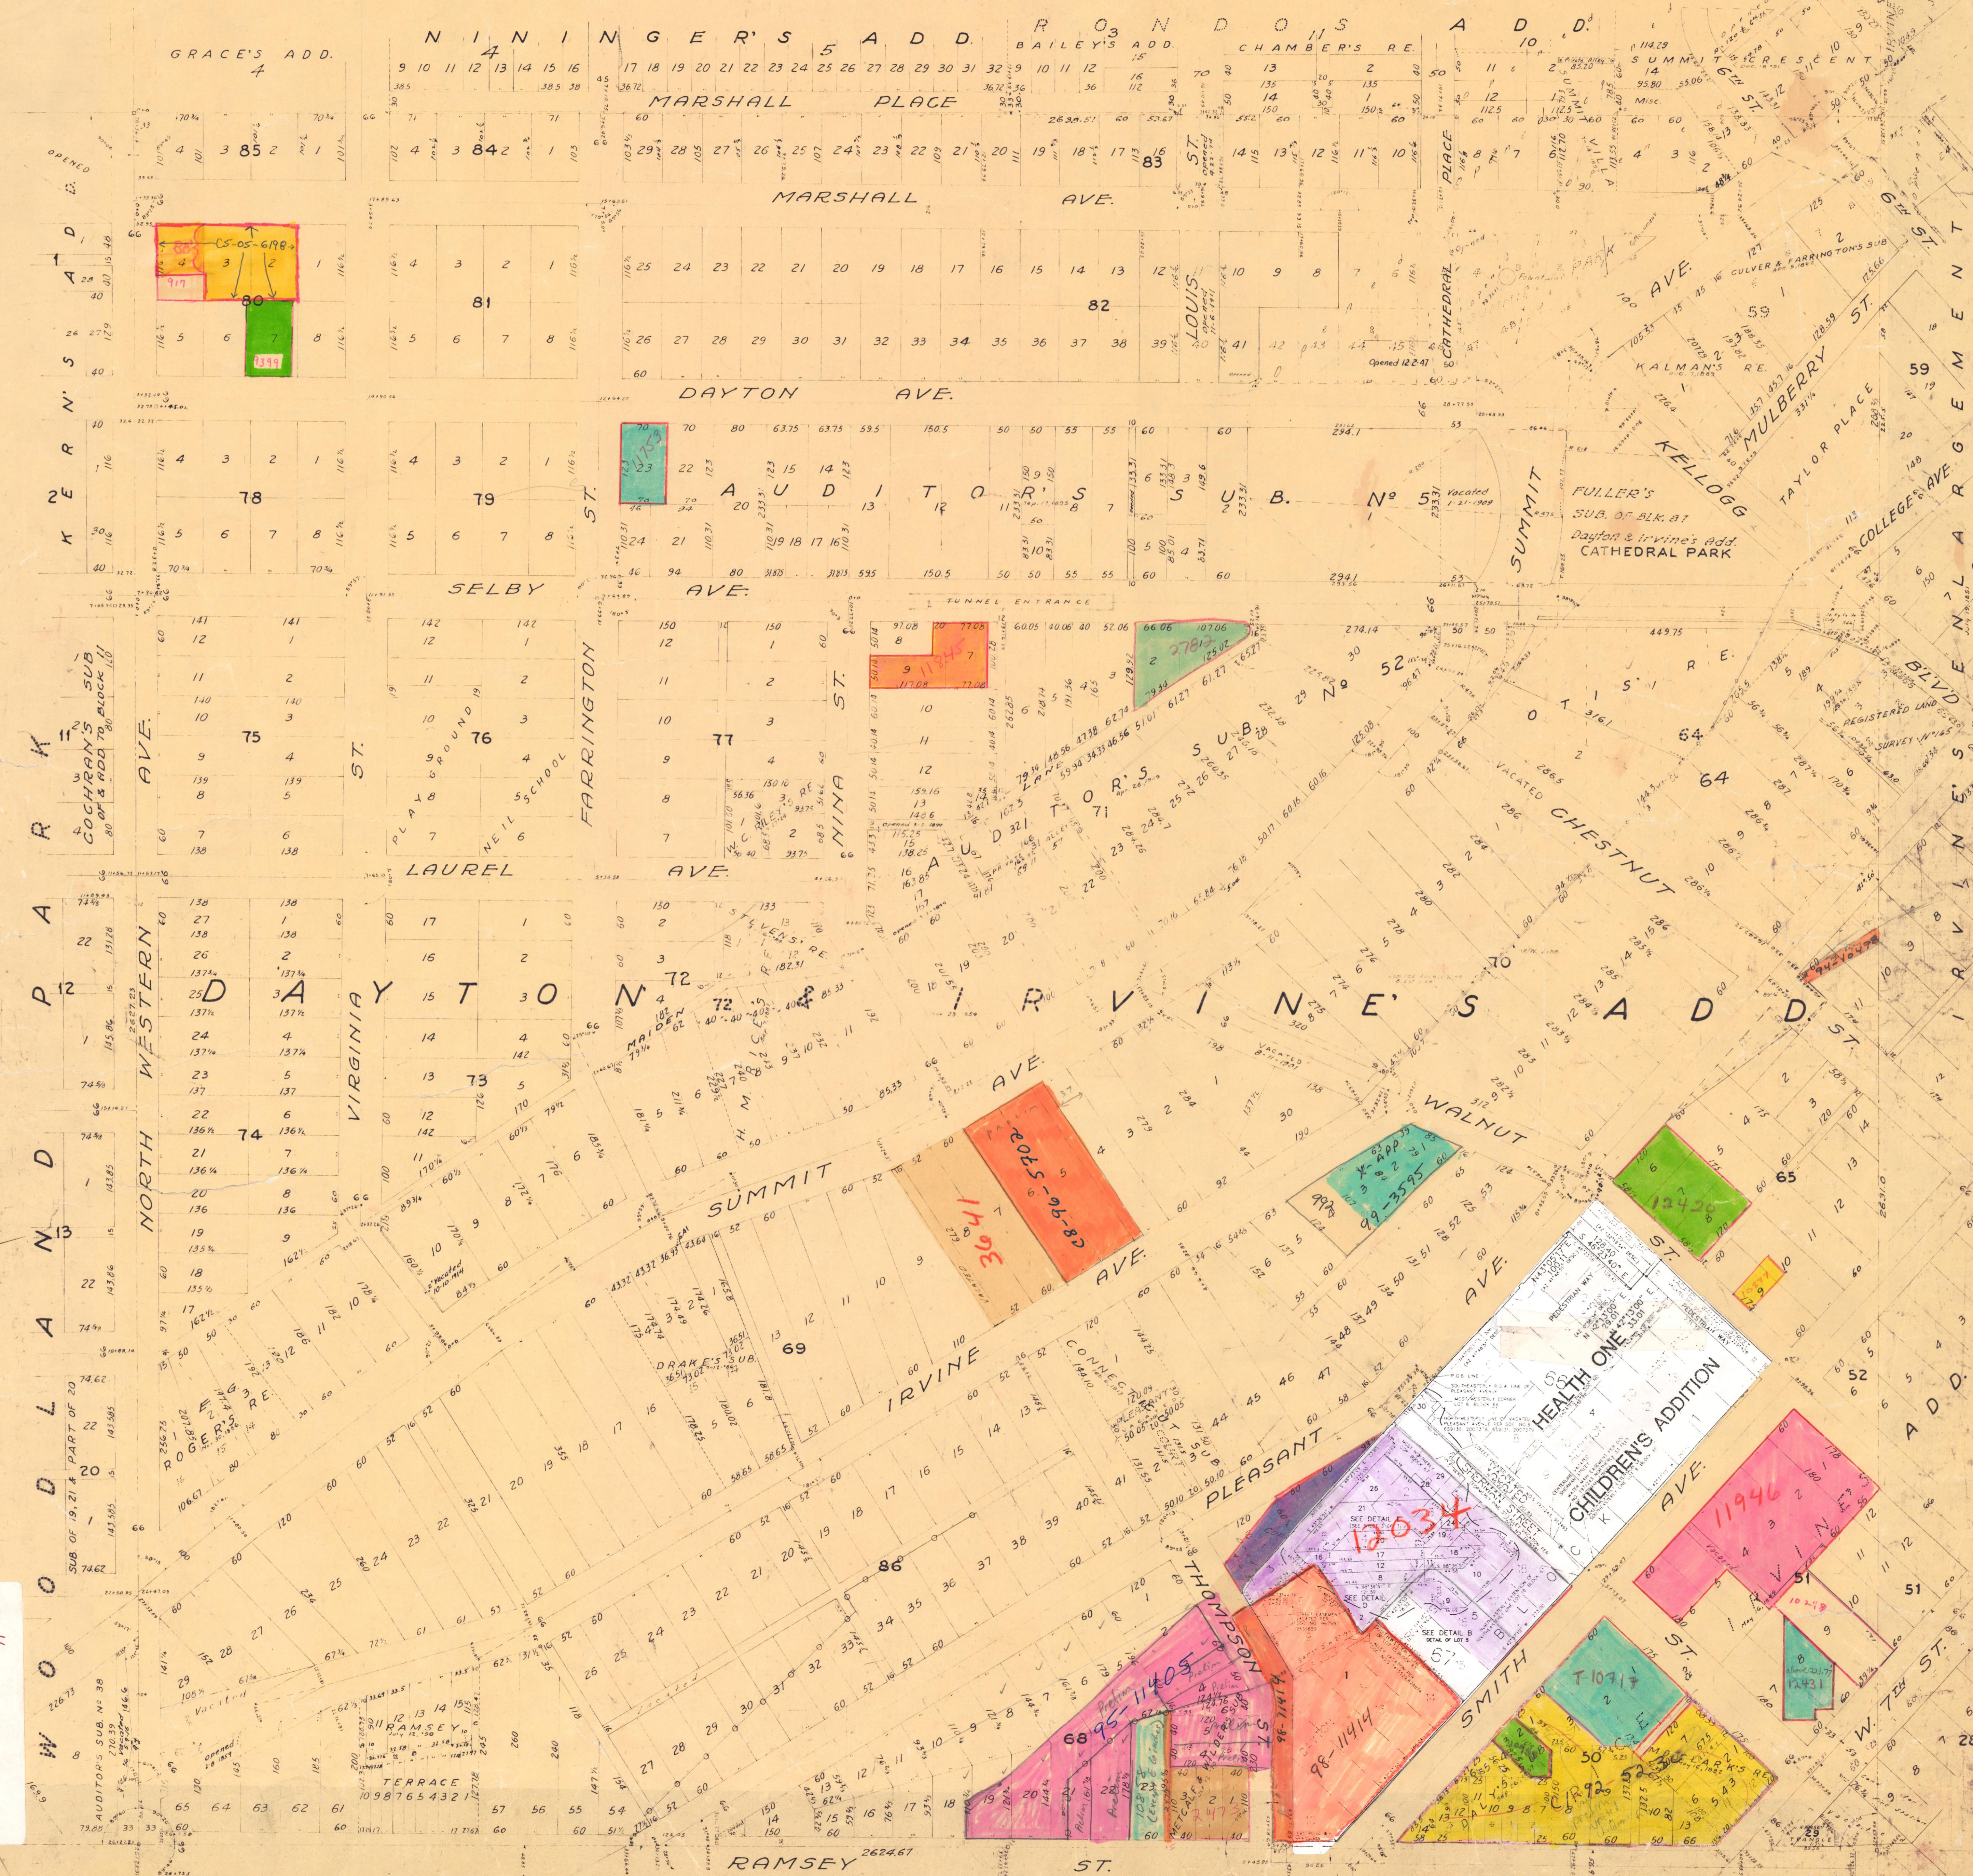

COCHRAN'S SUB
80' OF ADD TO BLOCK 101

SUB OF 19, 21 & PART OF 20
AUDITOR'S SUB. NO. 38
143,585
143,585
279.62

NE 1/4
1-28-23