


NE 1/4 SEC. 9-28-22

M i s s i s s i p p i R i v e r

LEVEE

LEVEE

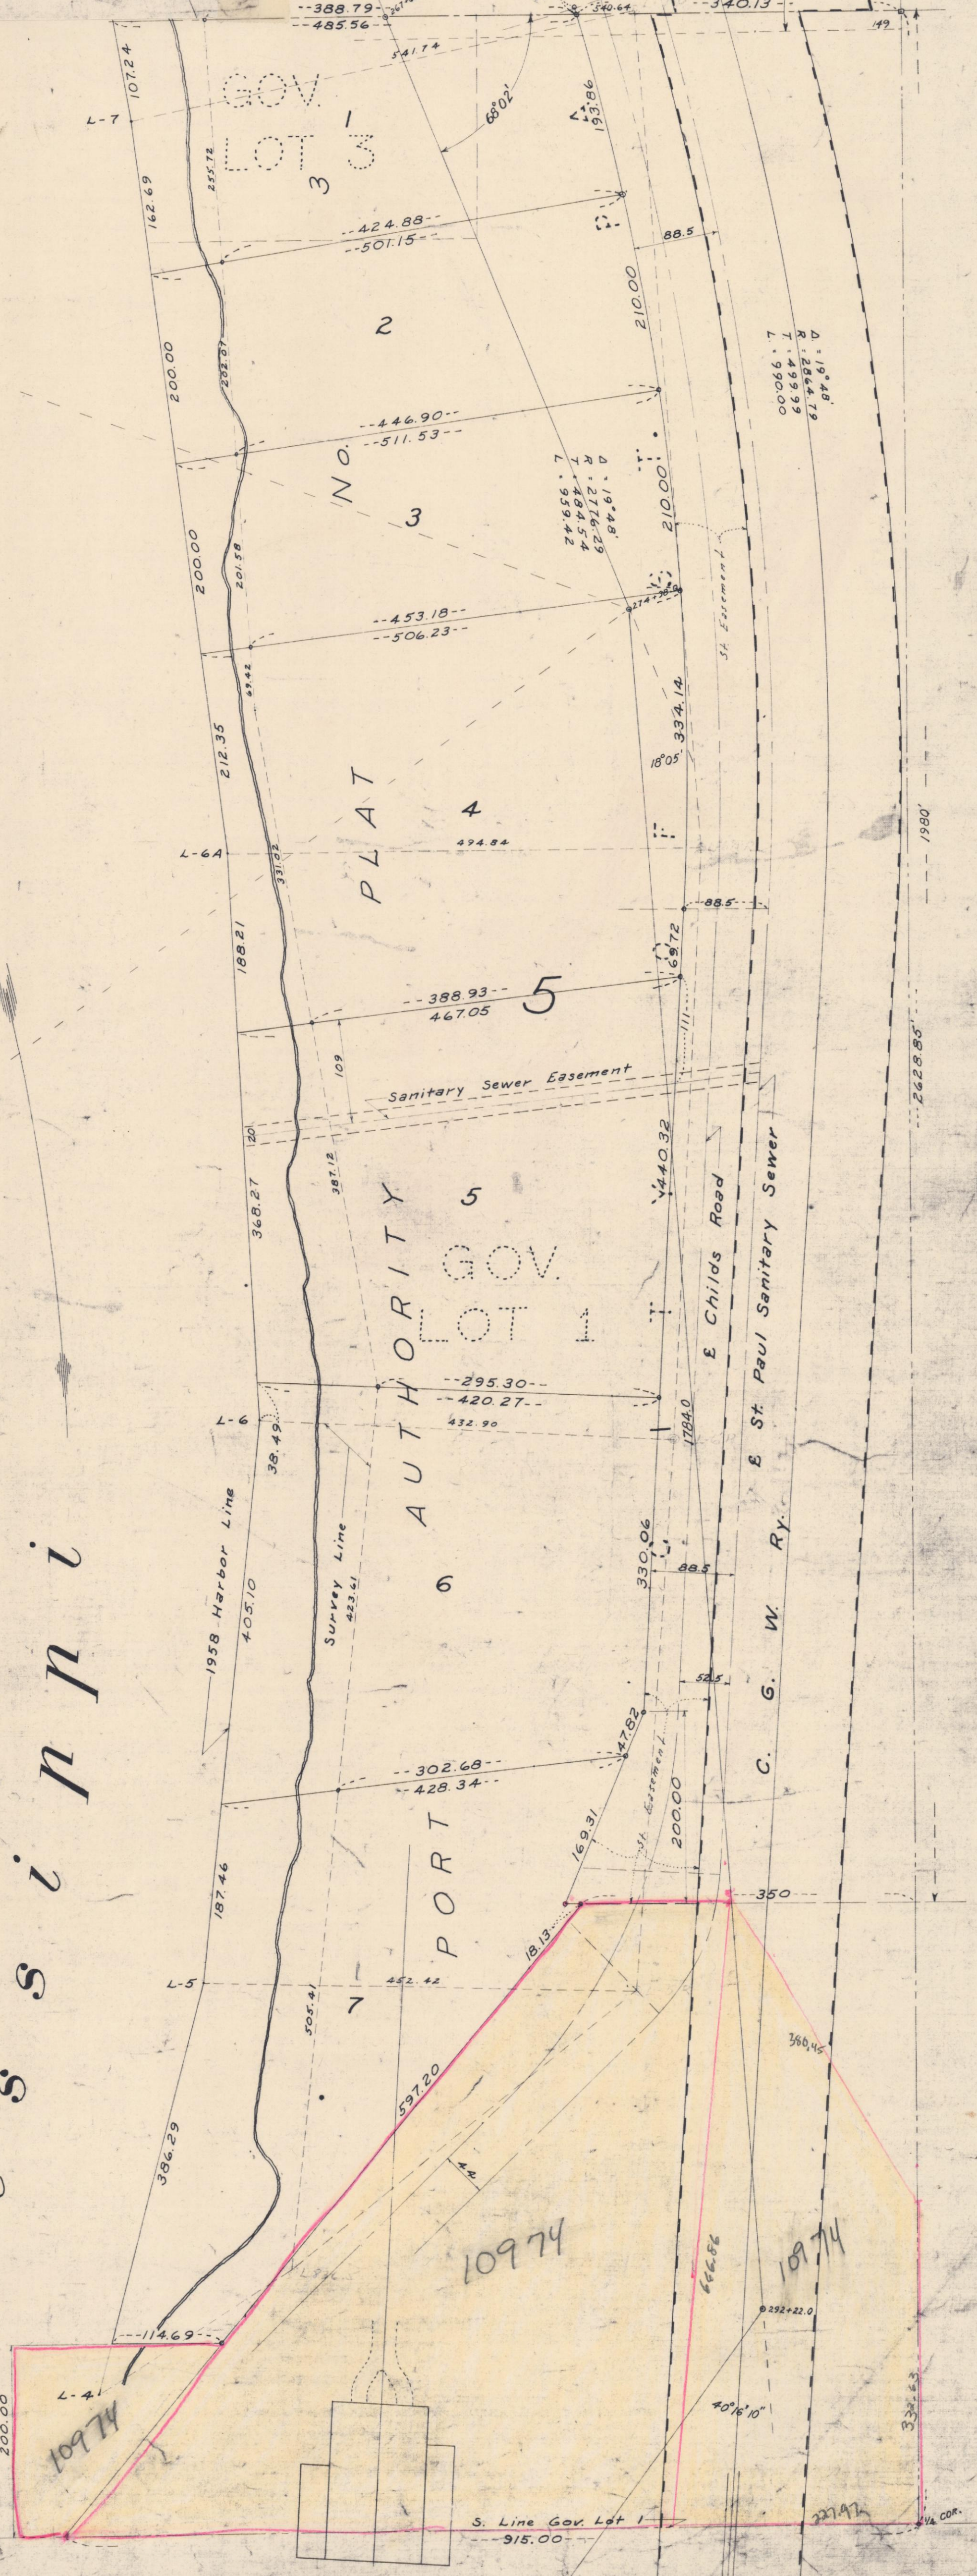

NE 1/4 9-28-22

NE 1/4 9-28-22