


N. E. 1/4 Sec. 23—28—22

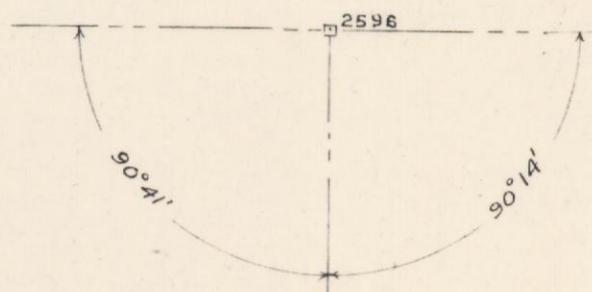


2601.19

C. M. STEEP R.R.
C. B. & Q. R.R.

POINT DOUGLAS ROAD

BOXWOOD AVE.

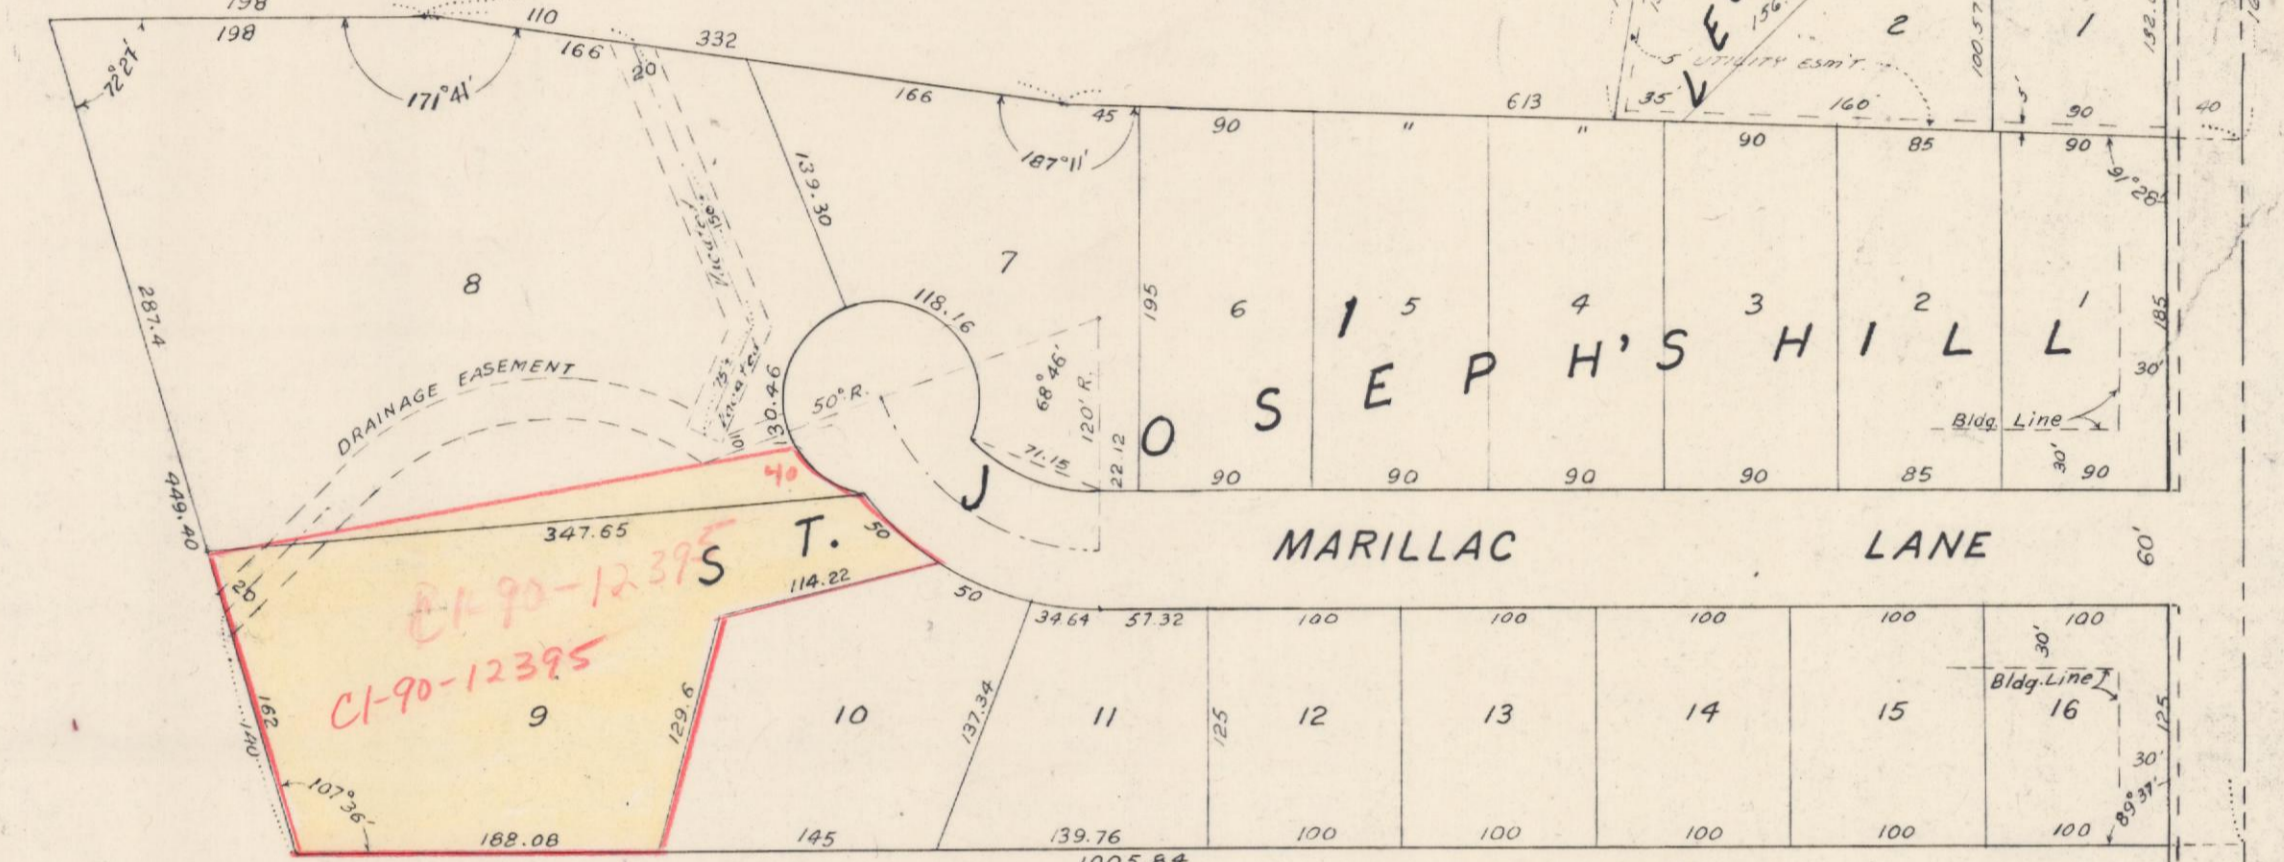

CARVER AVE.

21

GREENLAND AVE.

GREENLAND AVE.

BURG ST.

BIRCH ST.

MEKNIGHT RD.

N 1/4

23-28-22