


NE 1/4 SEC 28-29-23

S T A T E F A I R G R O U N D S

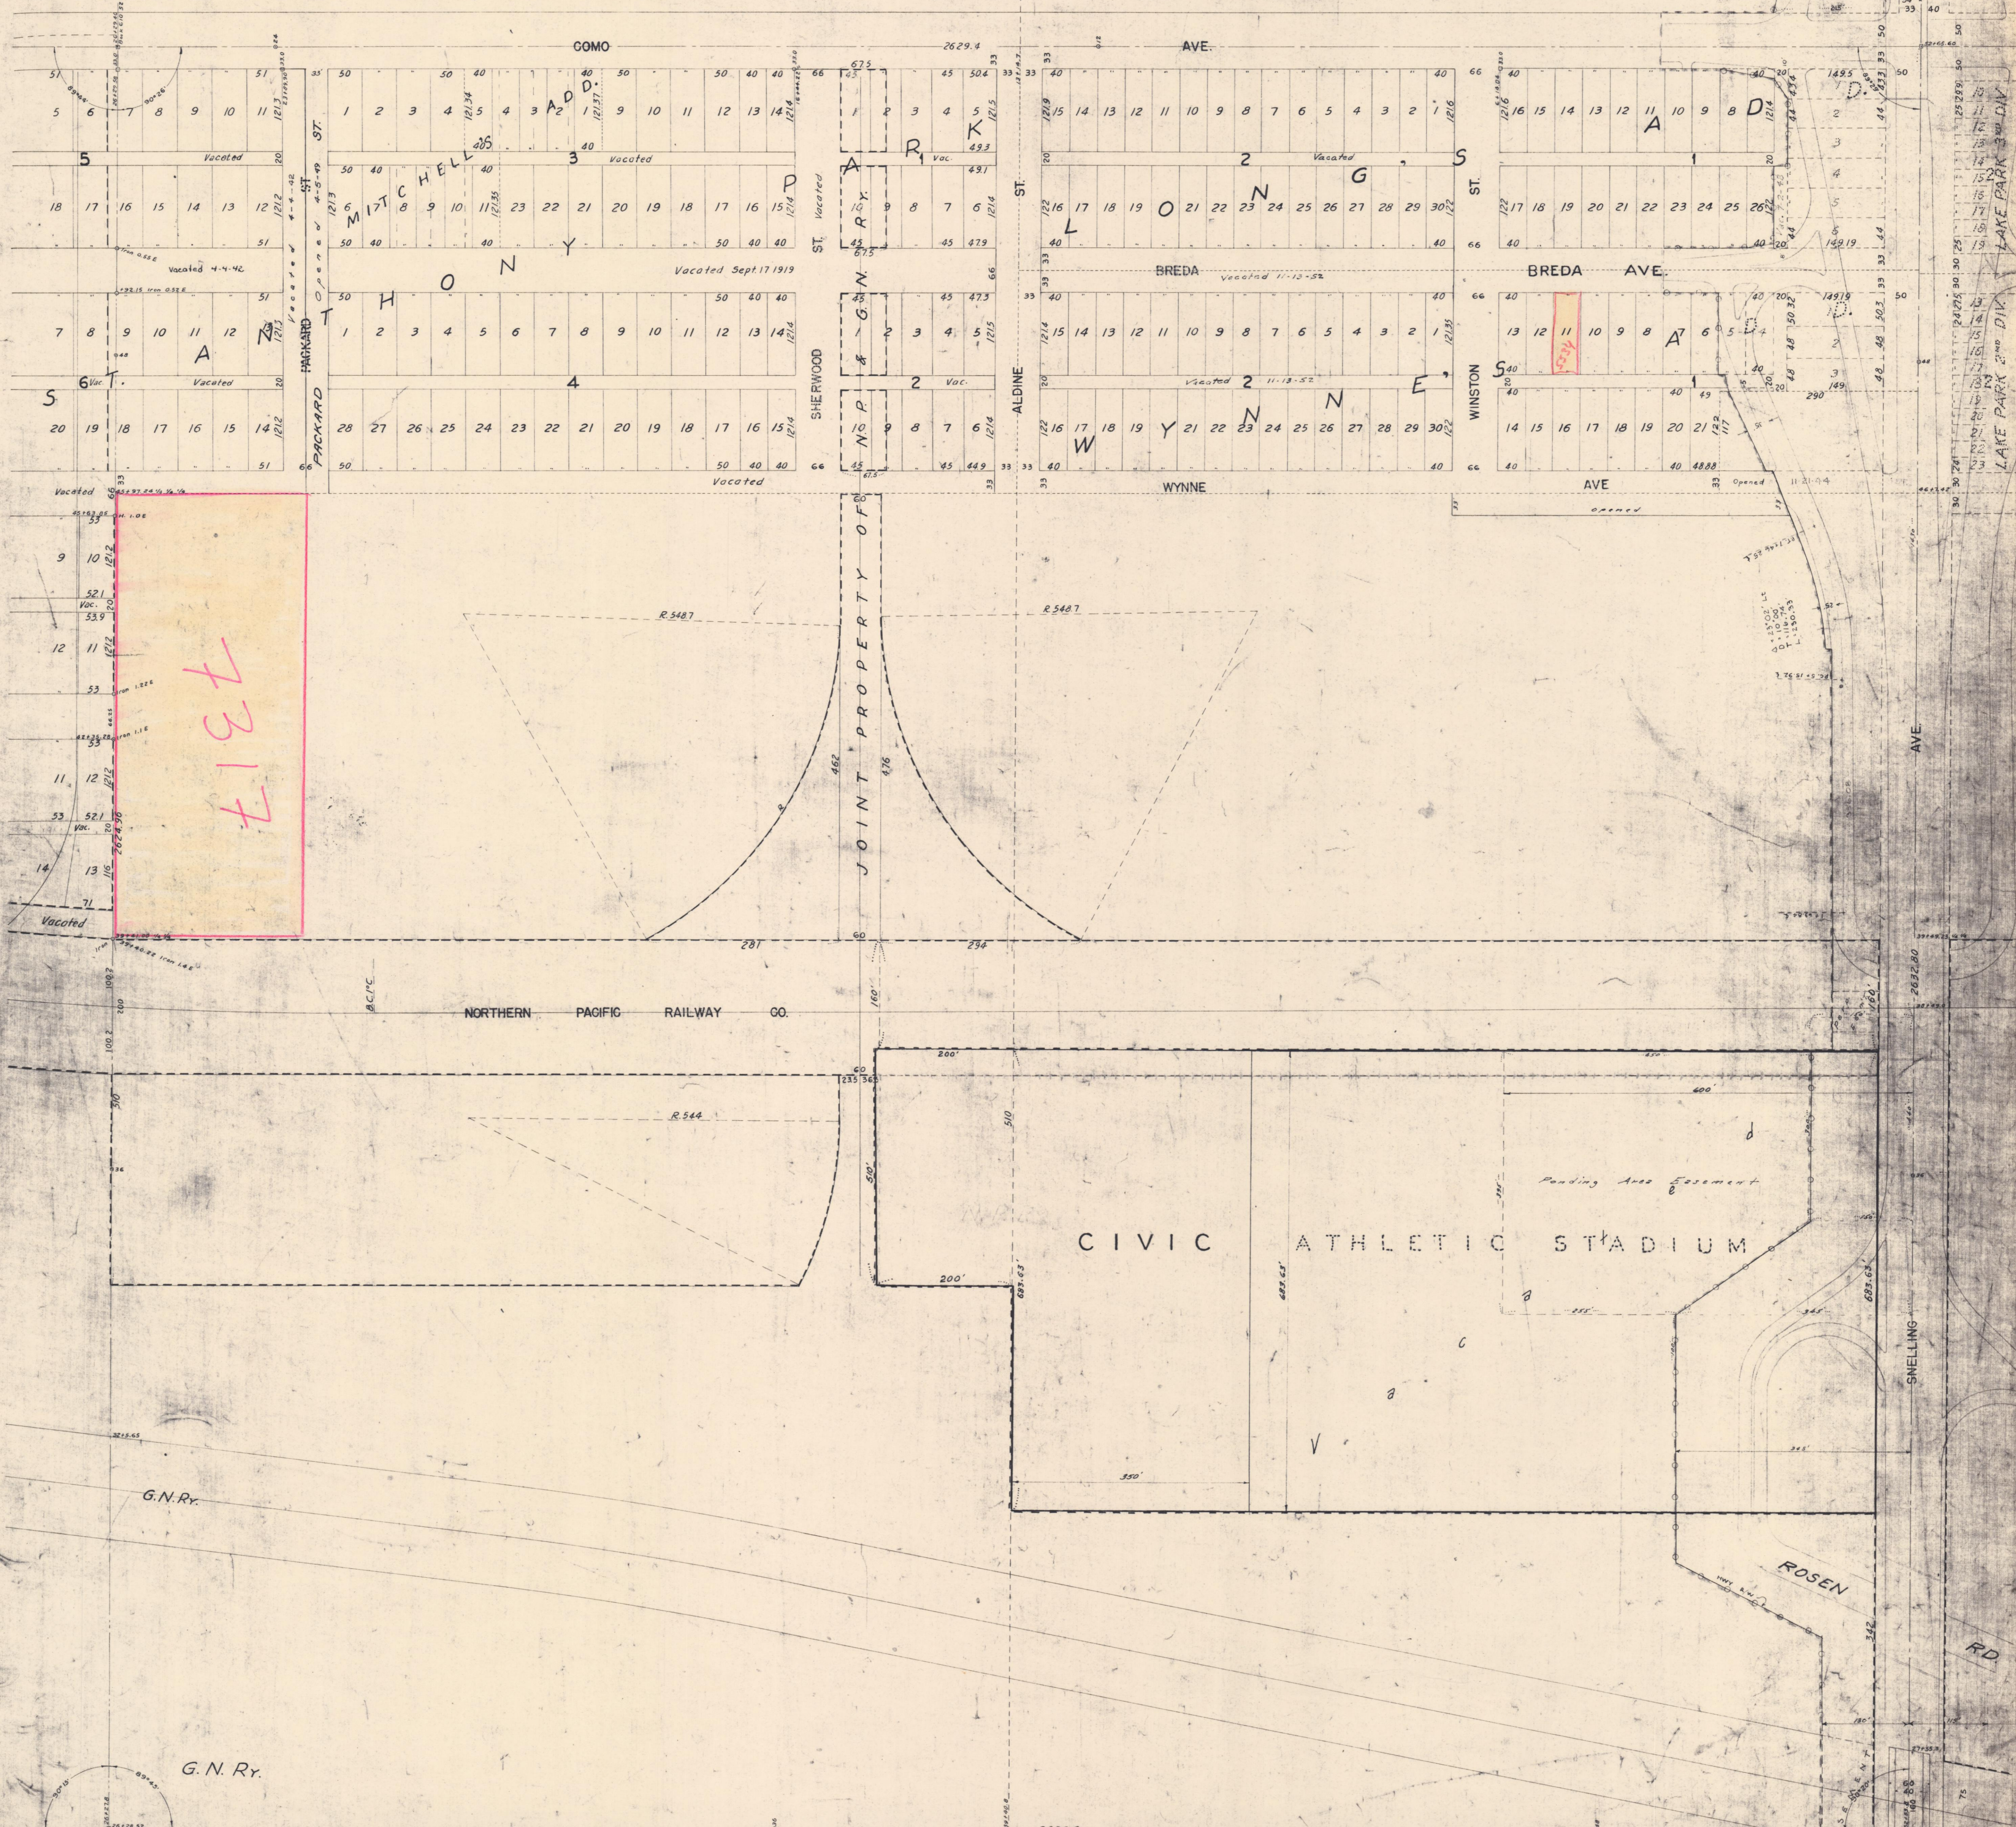

Books 169
335
610

NE 1/4 28-29-23