


N.W. 1/4 Sec. 11, 28, 23.

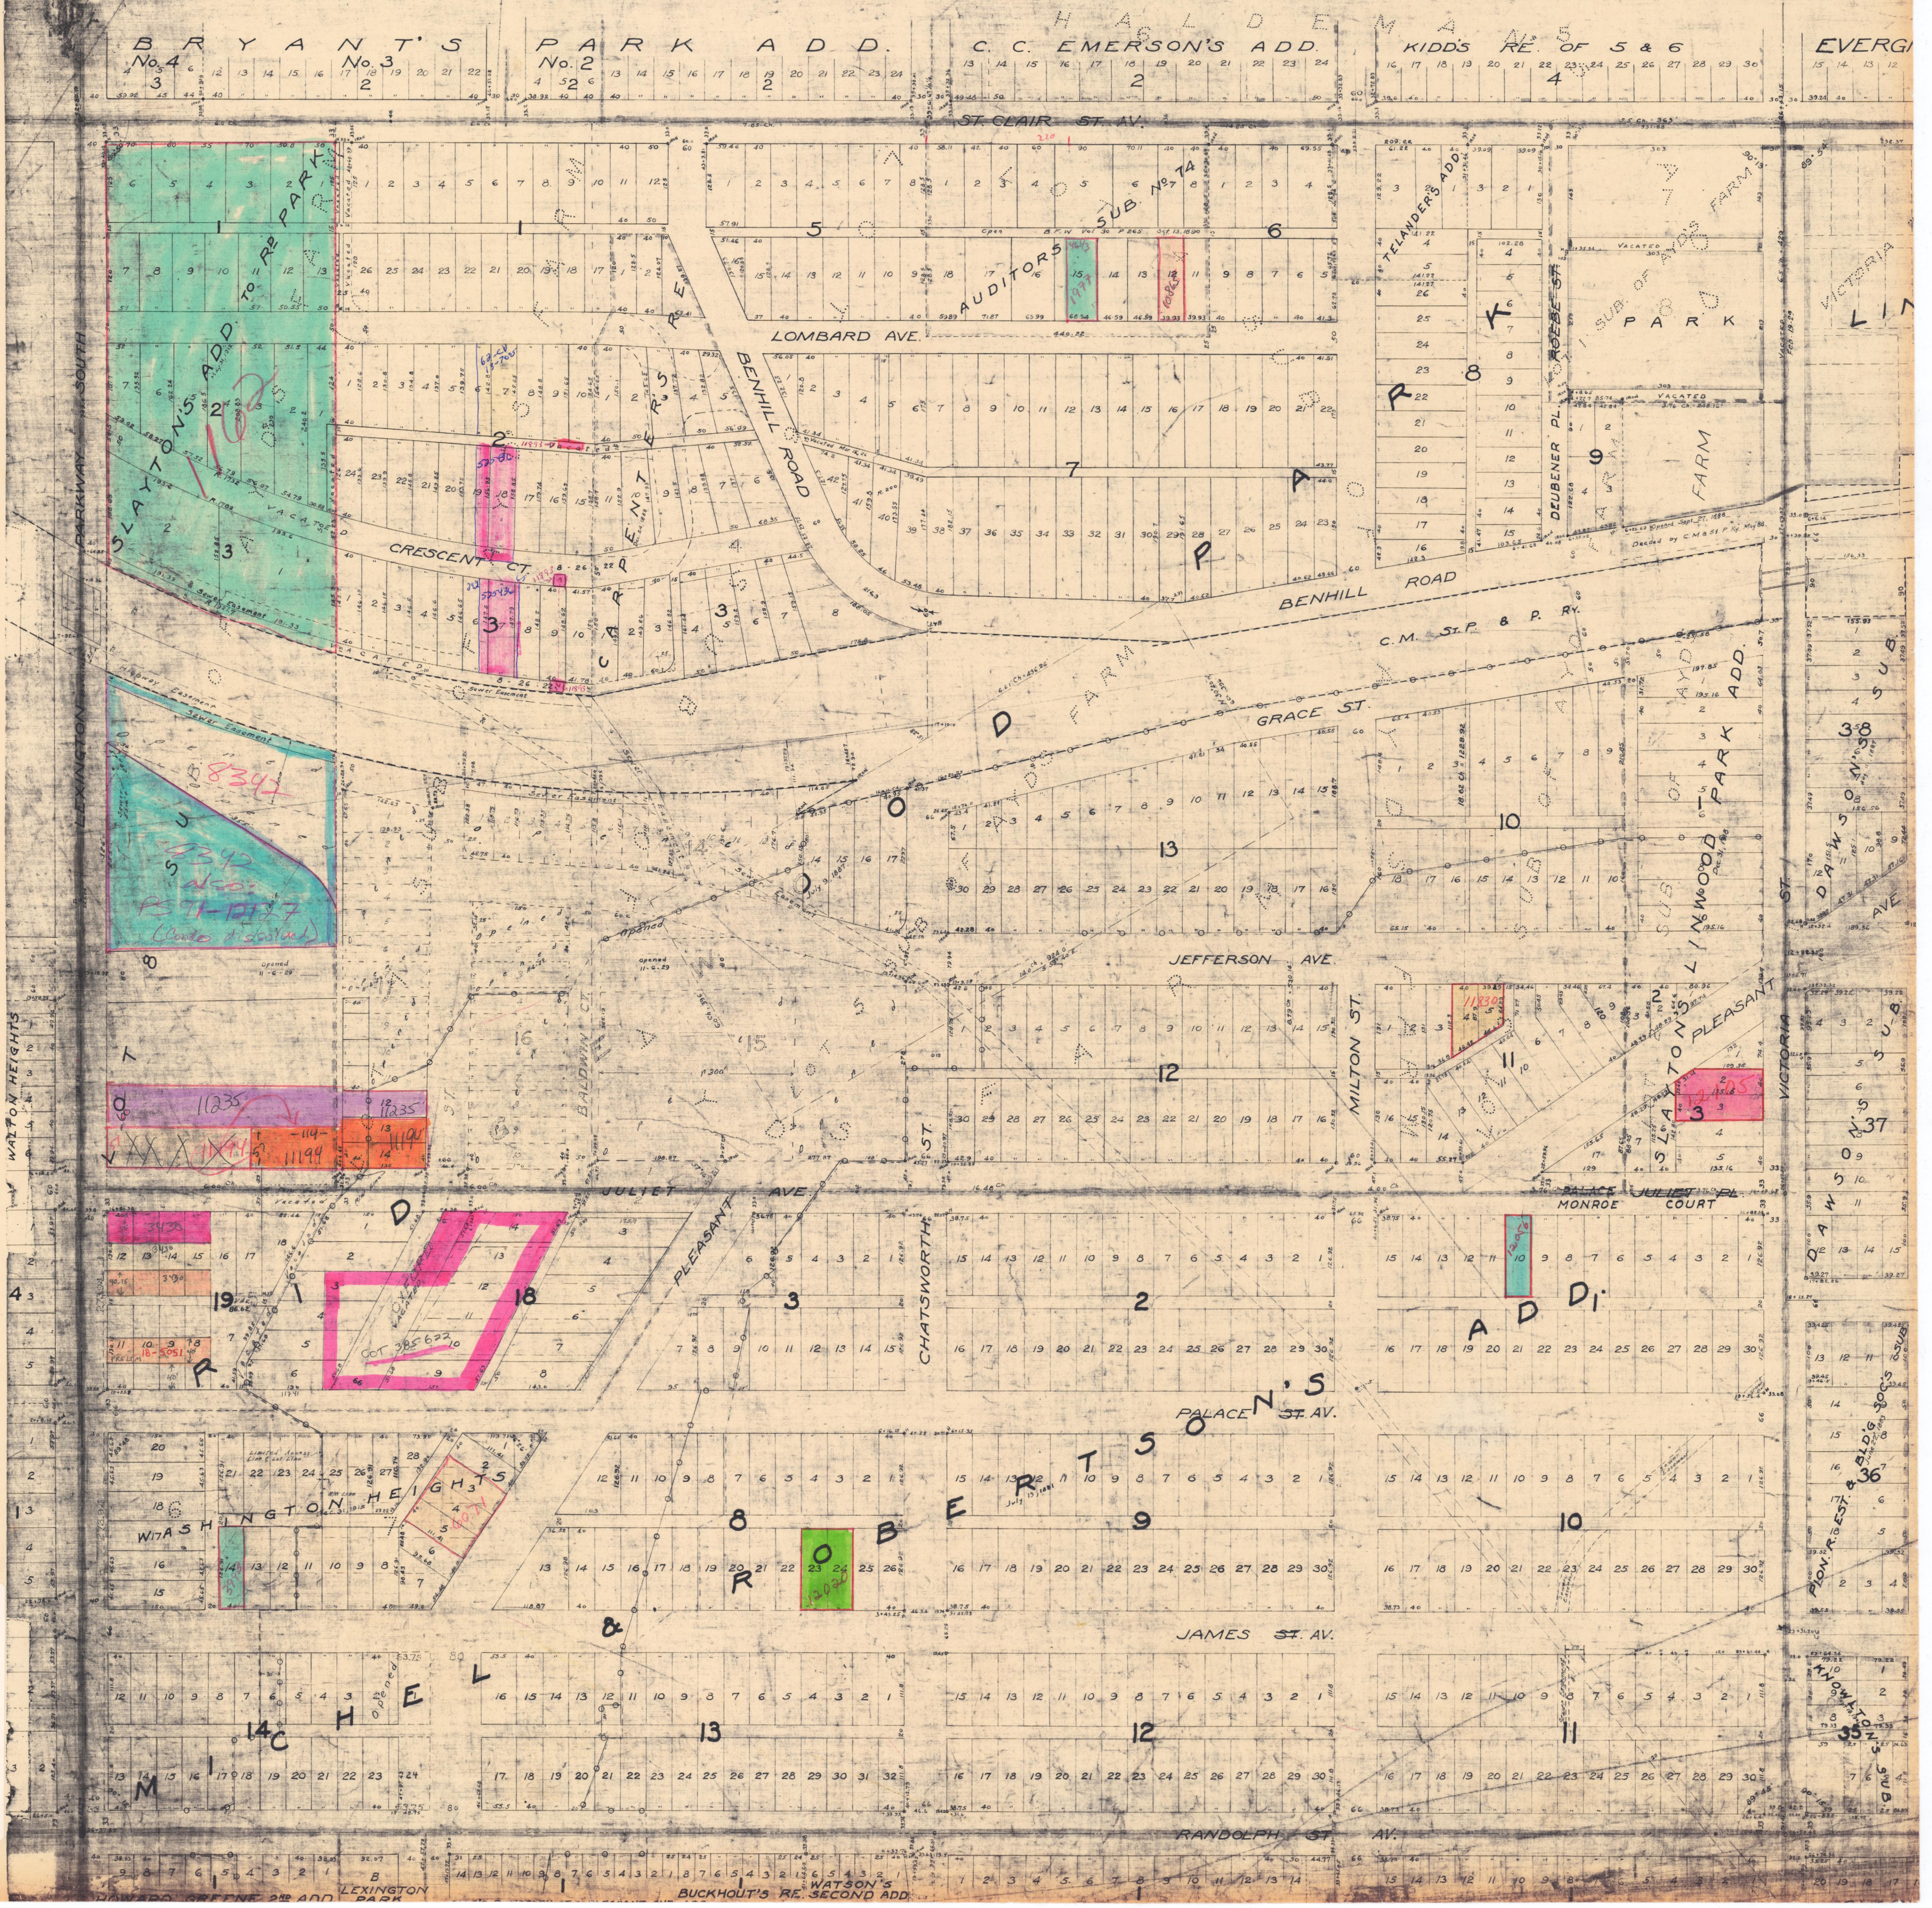

N.W. 1/4 11-28-23