


N.W. 1/4 SEC. 15-28-22

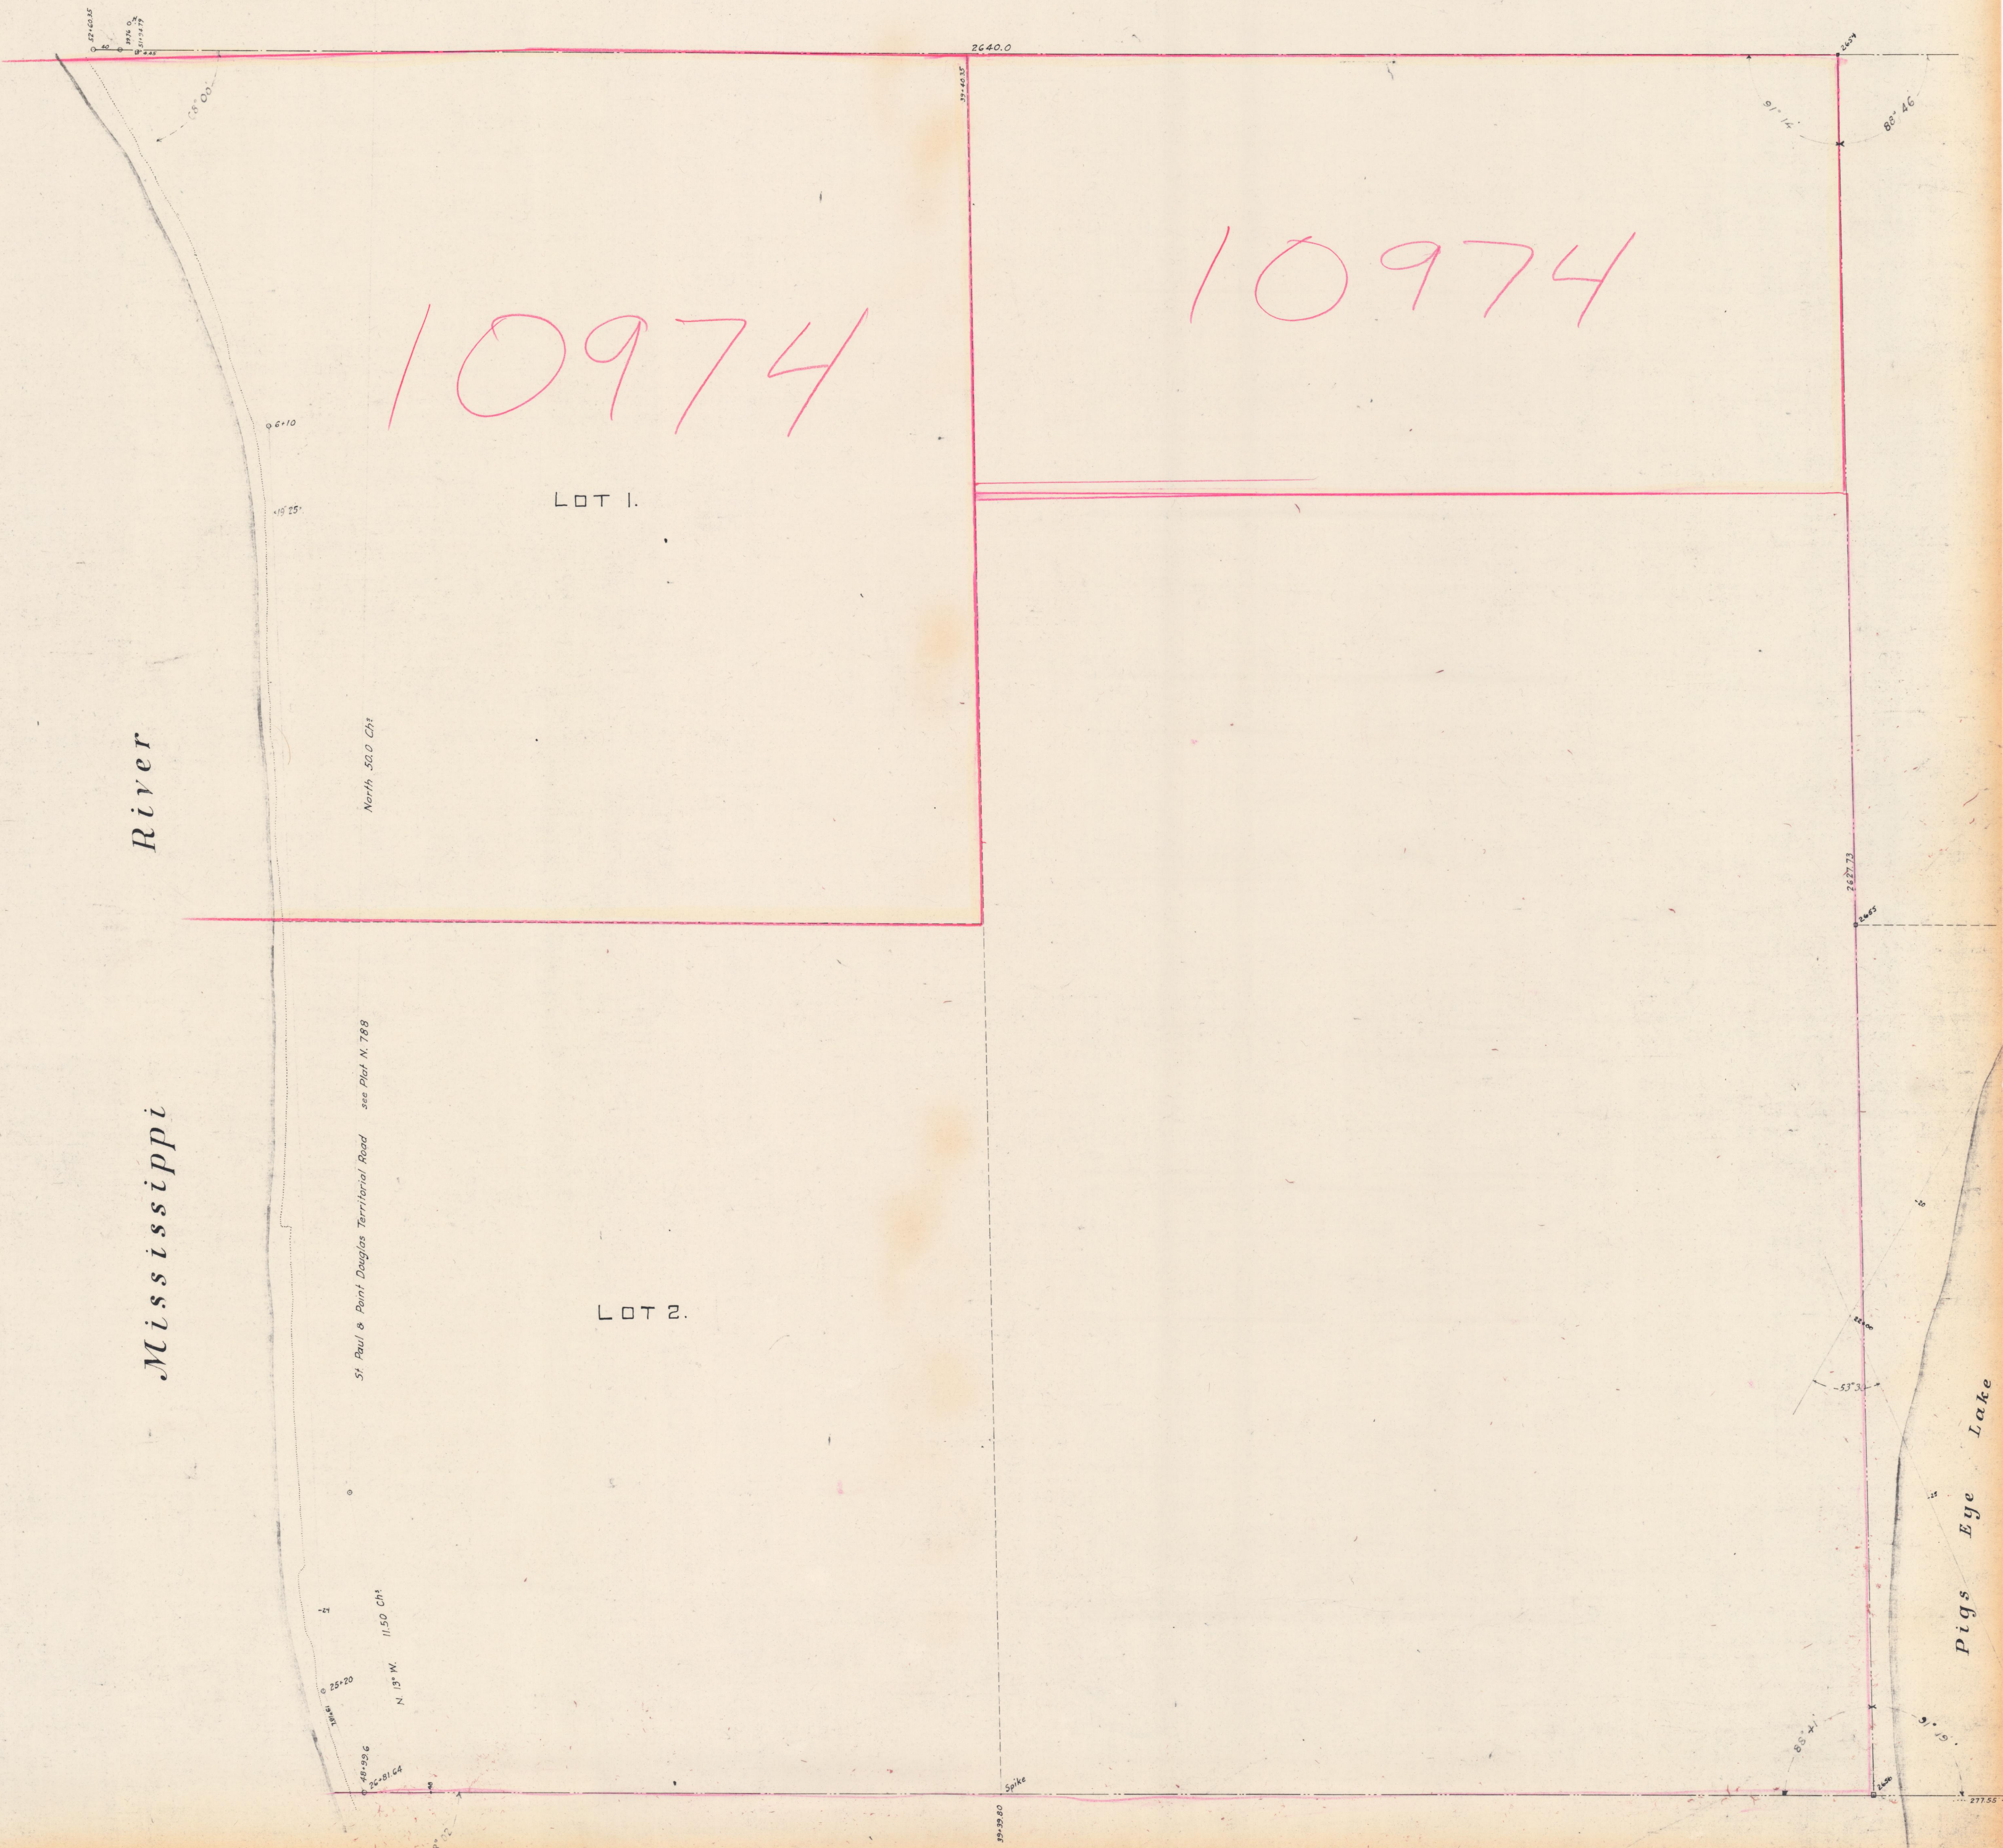

10974

LOT 1.

10974

LOT 2.

River

Mississippi

Pigs Eye Lake

N.W. 1/4
15-28-22