


DR 16

N. W. 1/4 Sec. 20—29—22

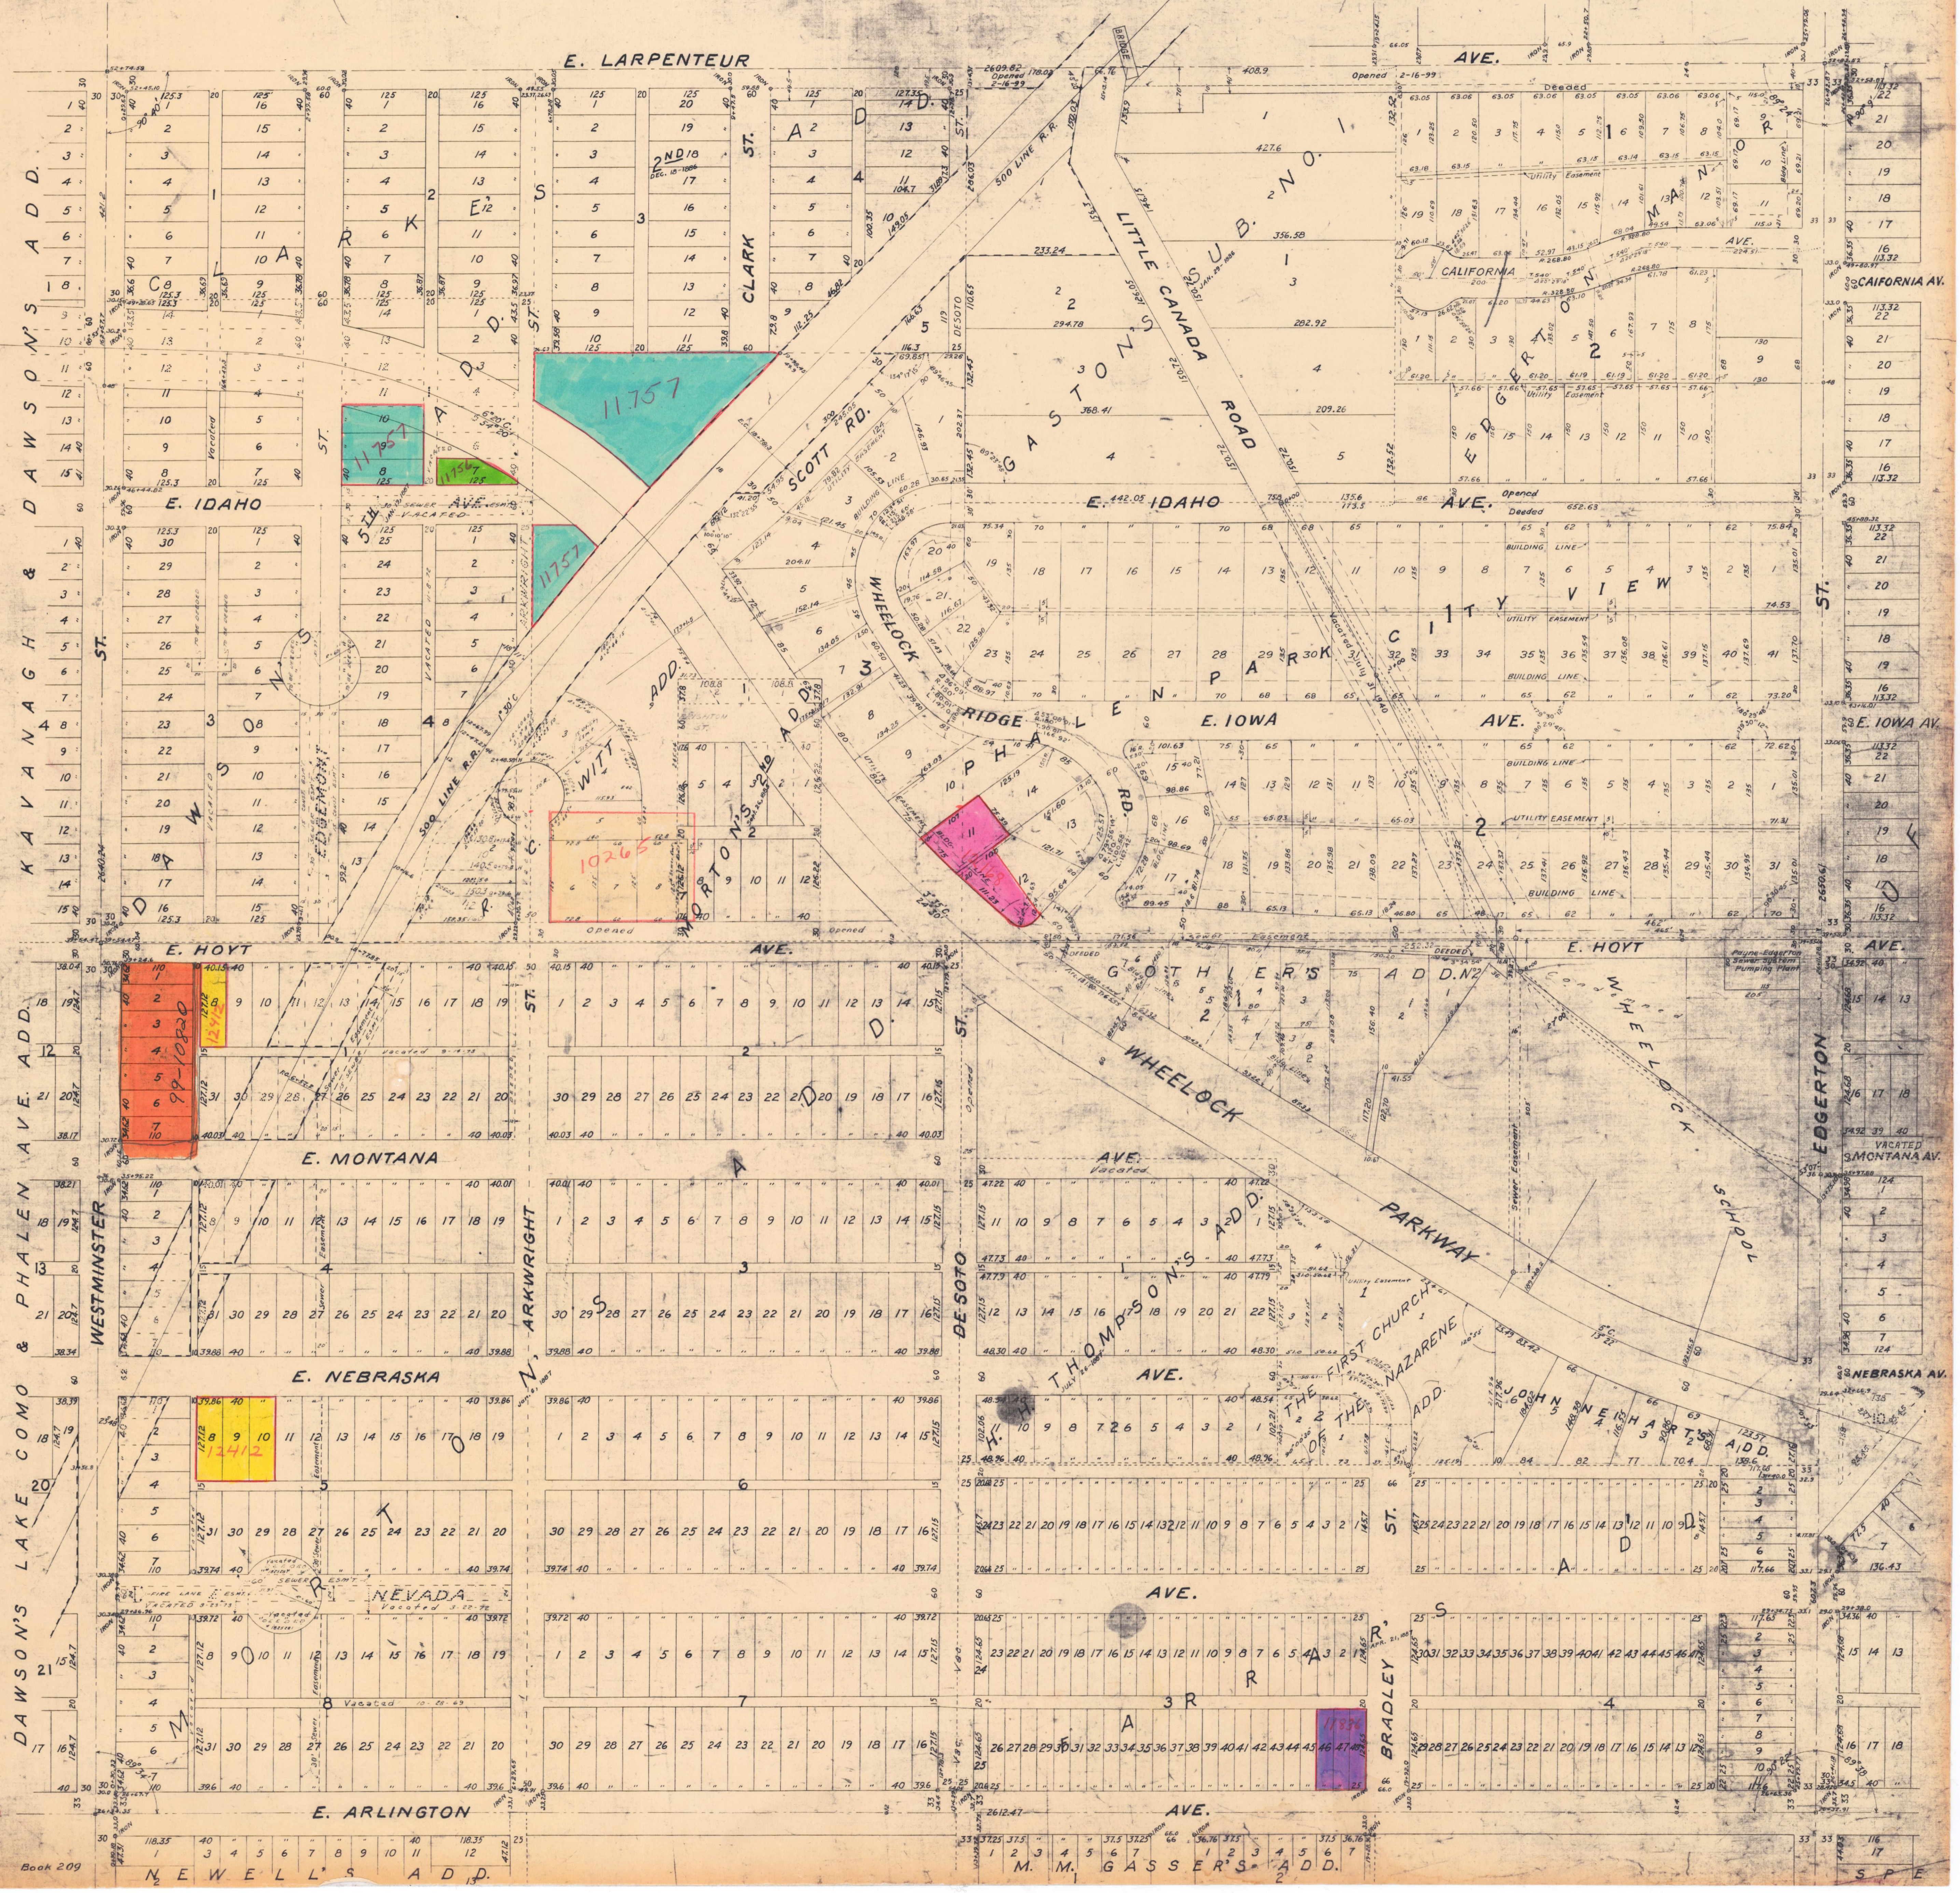

N.W. 1/4 20-29-22