

N.W. 1/4 SEC. 30-29.22

DR 15

W V F E L B U R G H I L L S D A W S O N ' S 4<sup>TH</sup> A D D.


BRAYTONS 2<sup>ND</sup> ADD

BARNEY, NORTON & KINGSLEY'S 2<sup>ND</sup> ADD

H A N D ' S A D D.

DAWSON & RICE'S ADD

A U E R B A C H

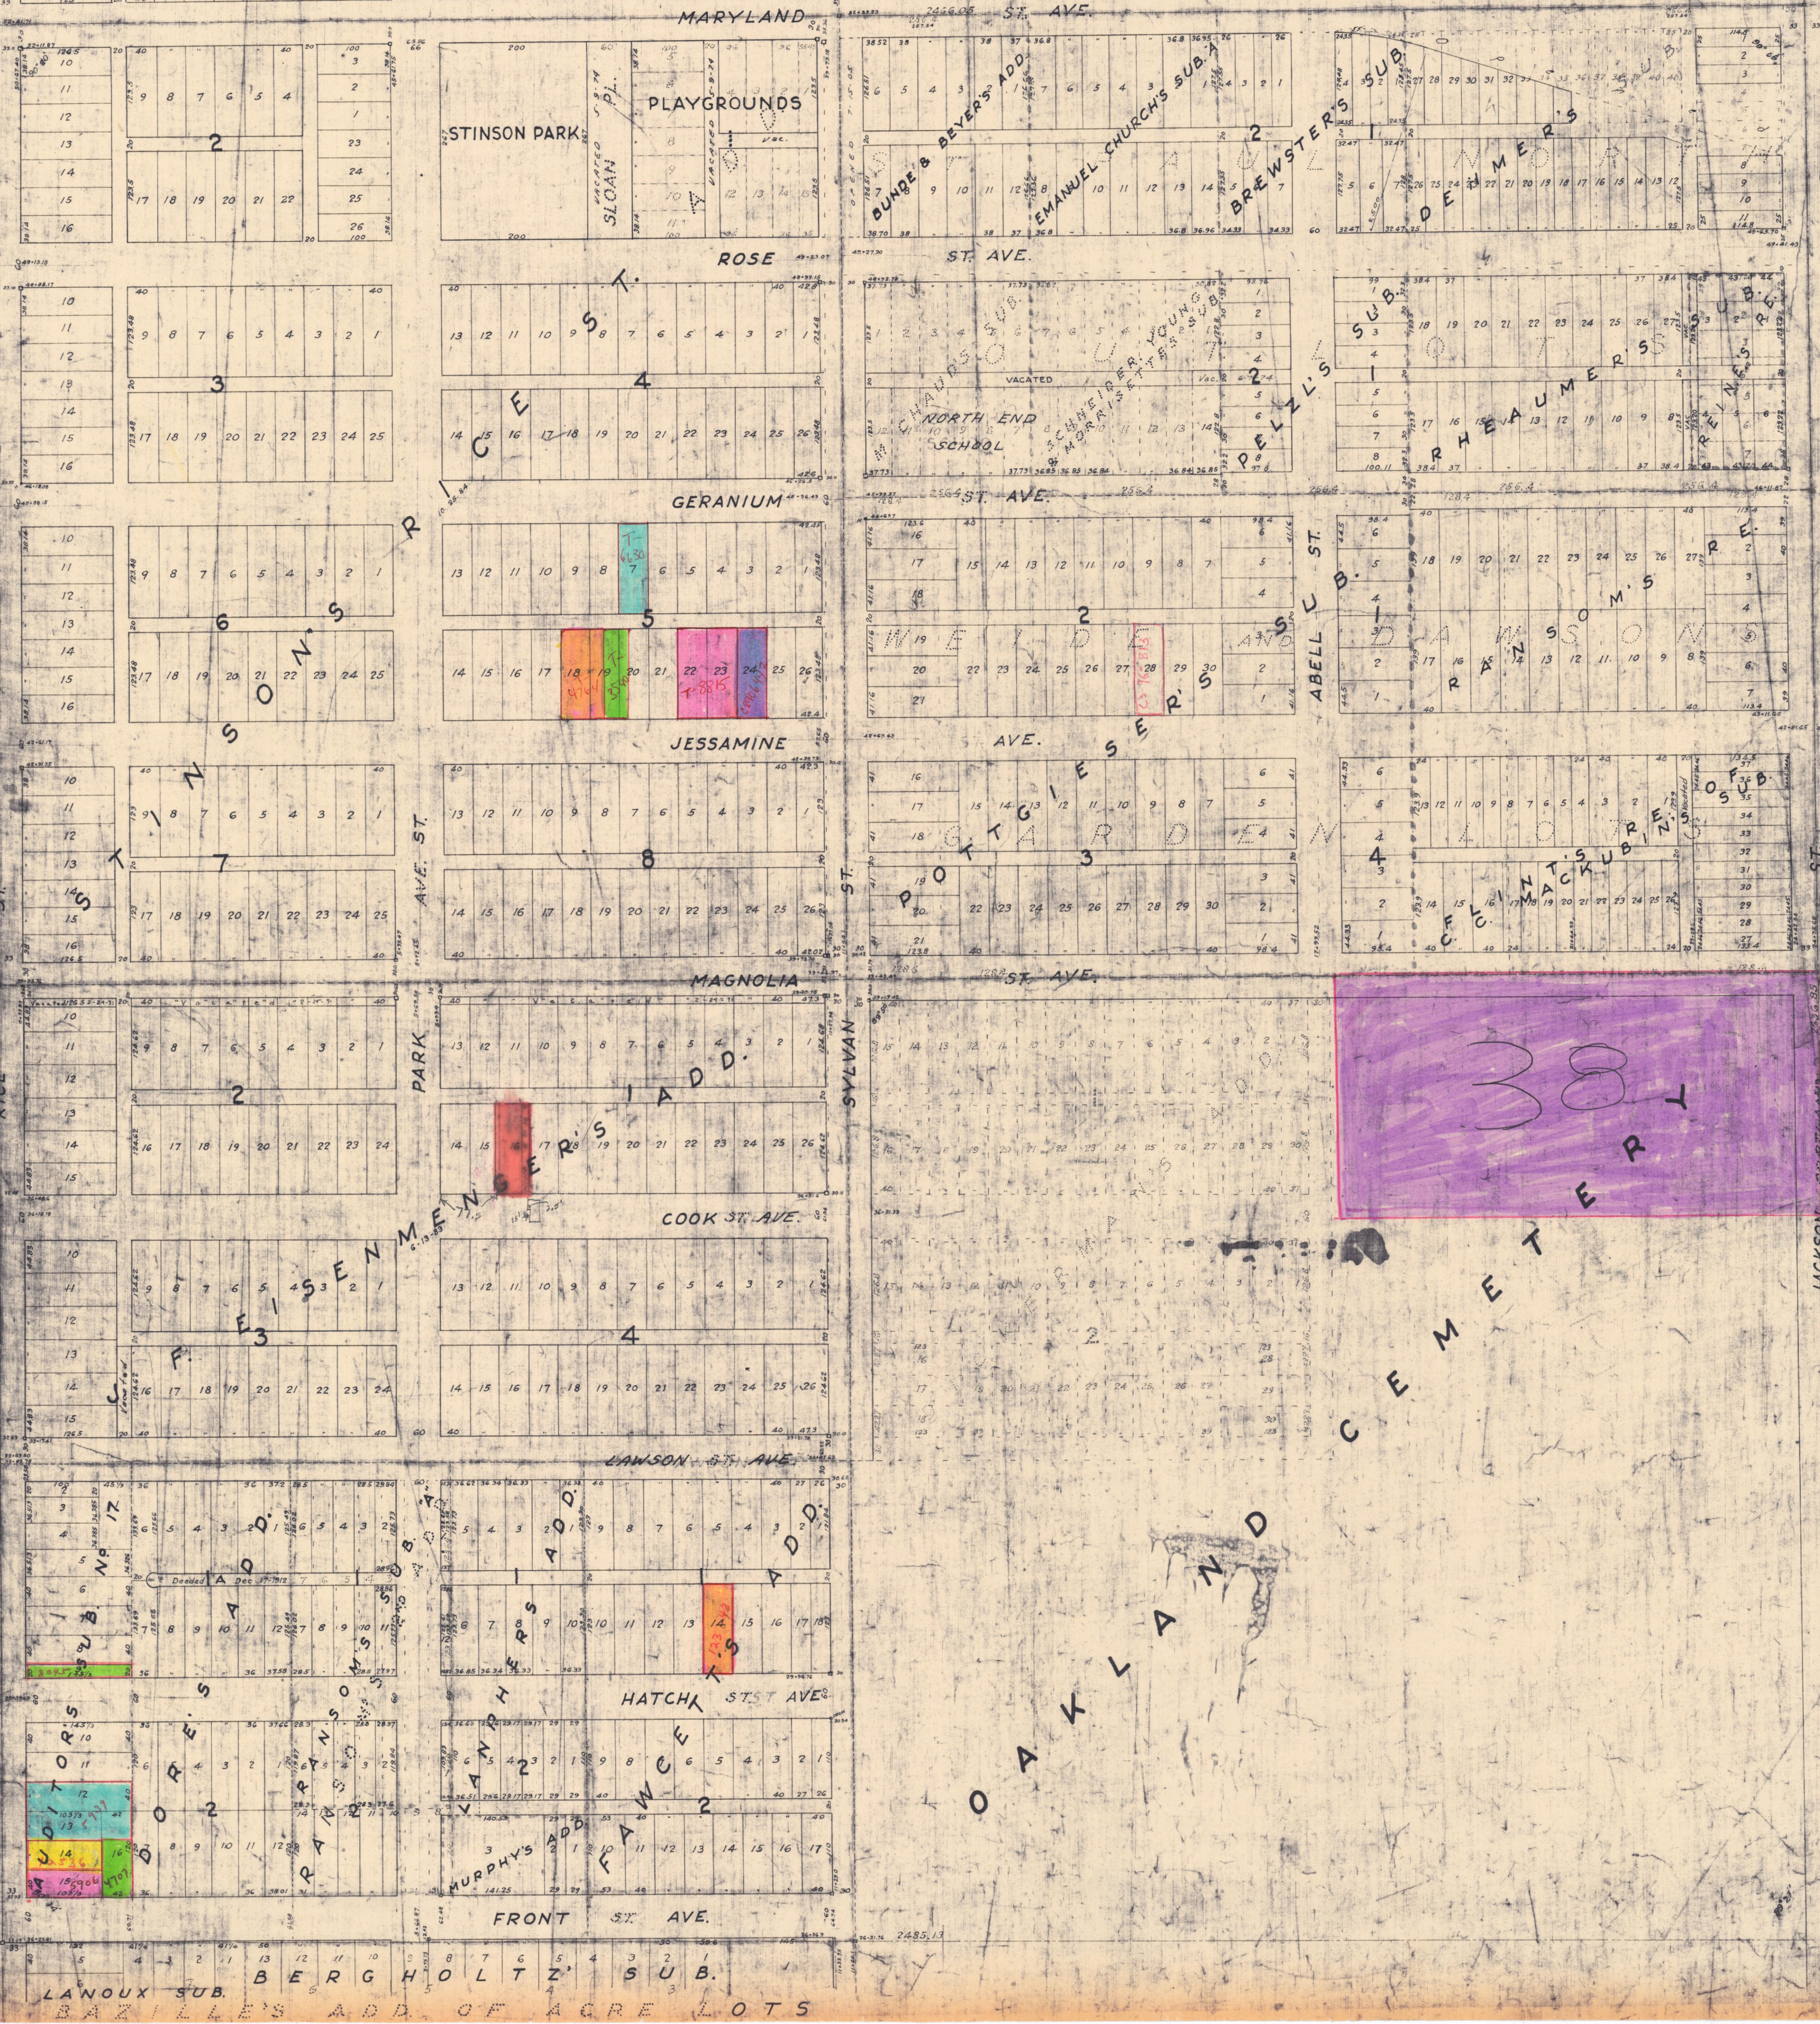

N.W. 1/4 30-29-22

