


1-29-22
SLA

2

6

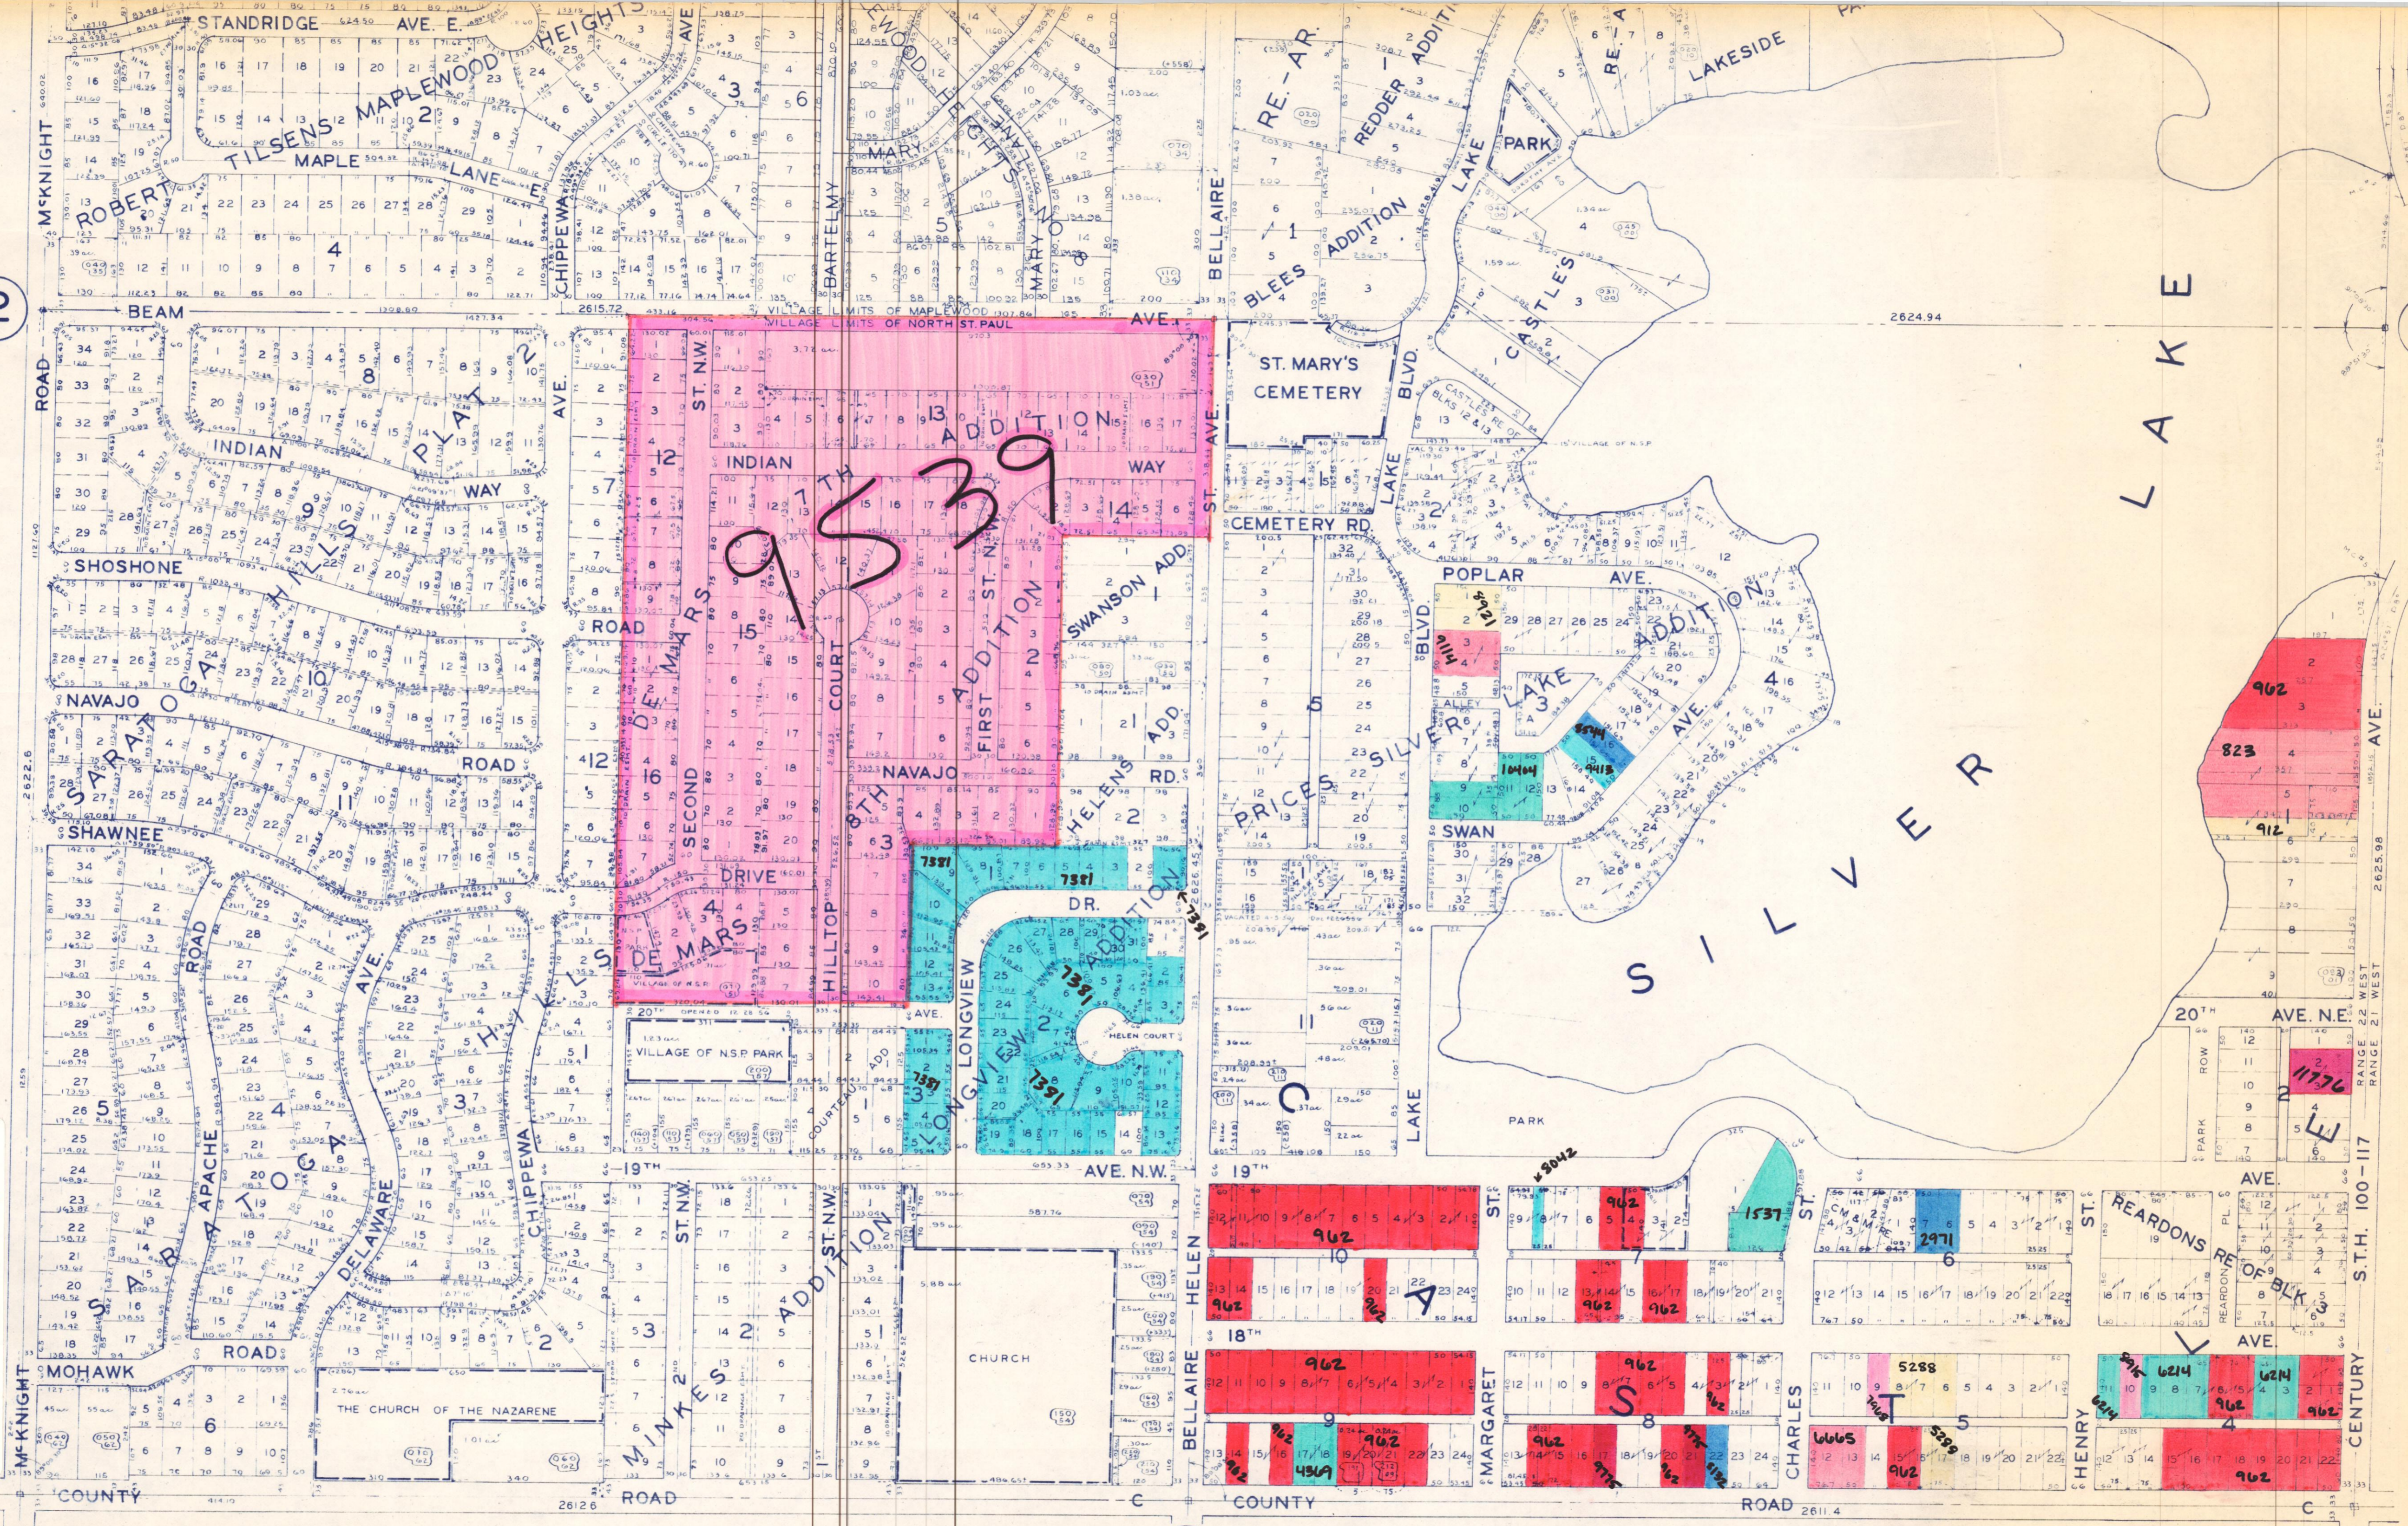

1-29-22

12