


S 1/2 SEC. 3 T. 29 R. 22

TY IS NOT RESPONSIBLE FOR ANY IN-ACCURACIES HEREIN CONTAINED.

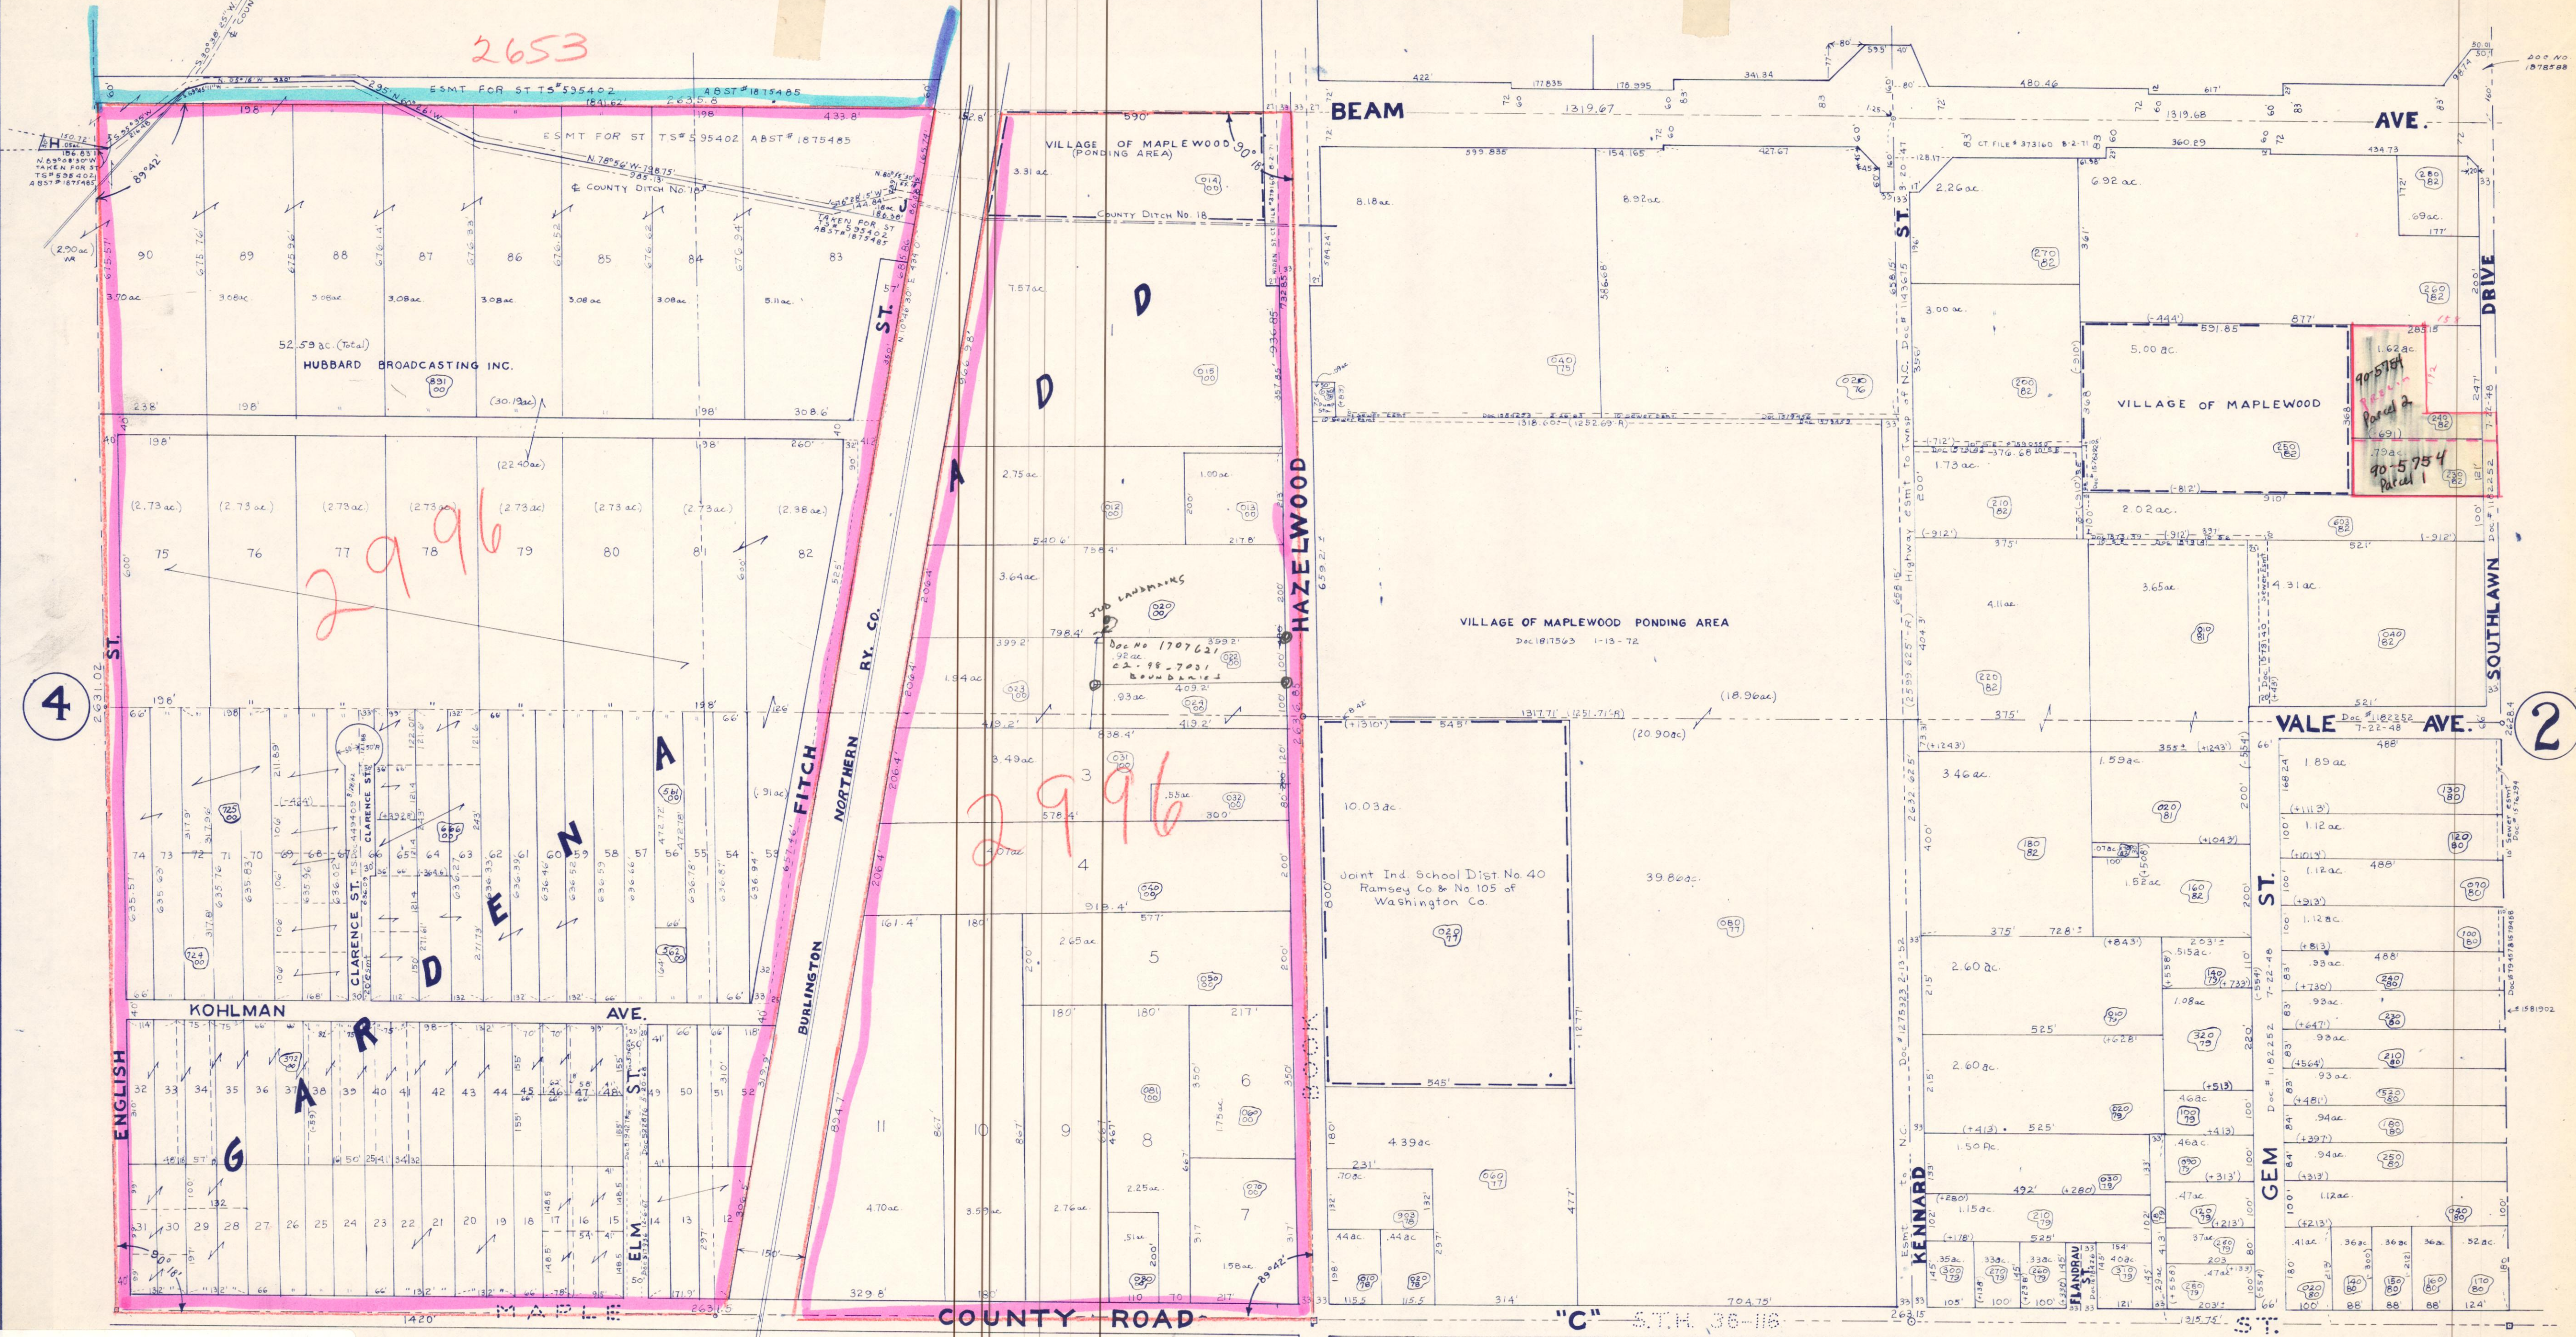

S 1/2 3-29-22

10