


S 1/2 SEC. 7 T. 30 R. 22

THIS IS A COMPILATION OF RECORDS. THEY APPEAR IN THE RAMSEY COUNTY OFFICES AFFECTING THE AREA SHOWN. THIS DRAWING IS TO BE USED ONLY FOR REFERENCE PURPOSES AND THE COUNTY IS NOT RESPONSIBLE FOR ANY INACCURACIES HEREIN CONTAINED.

12

8

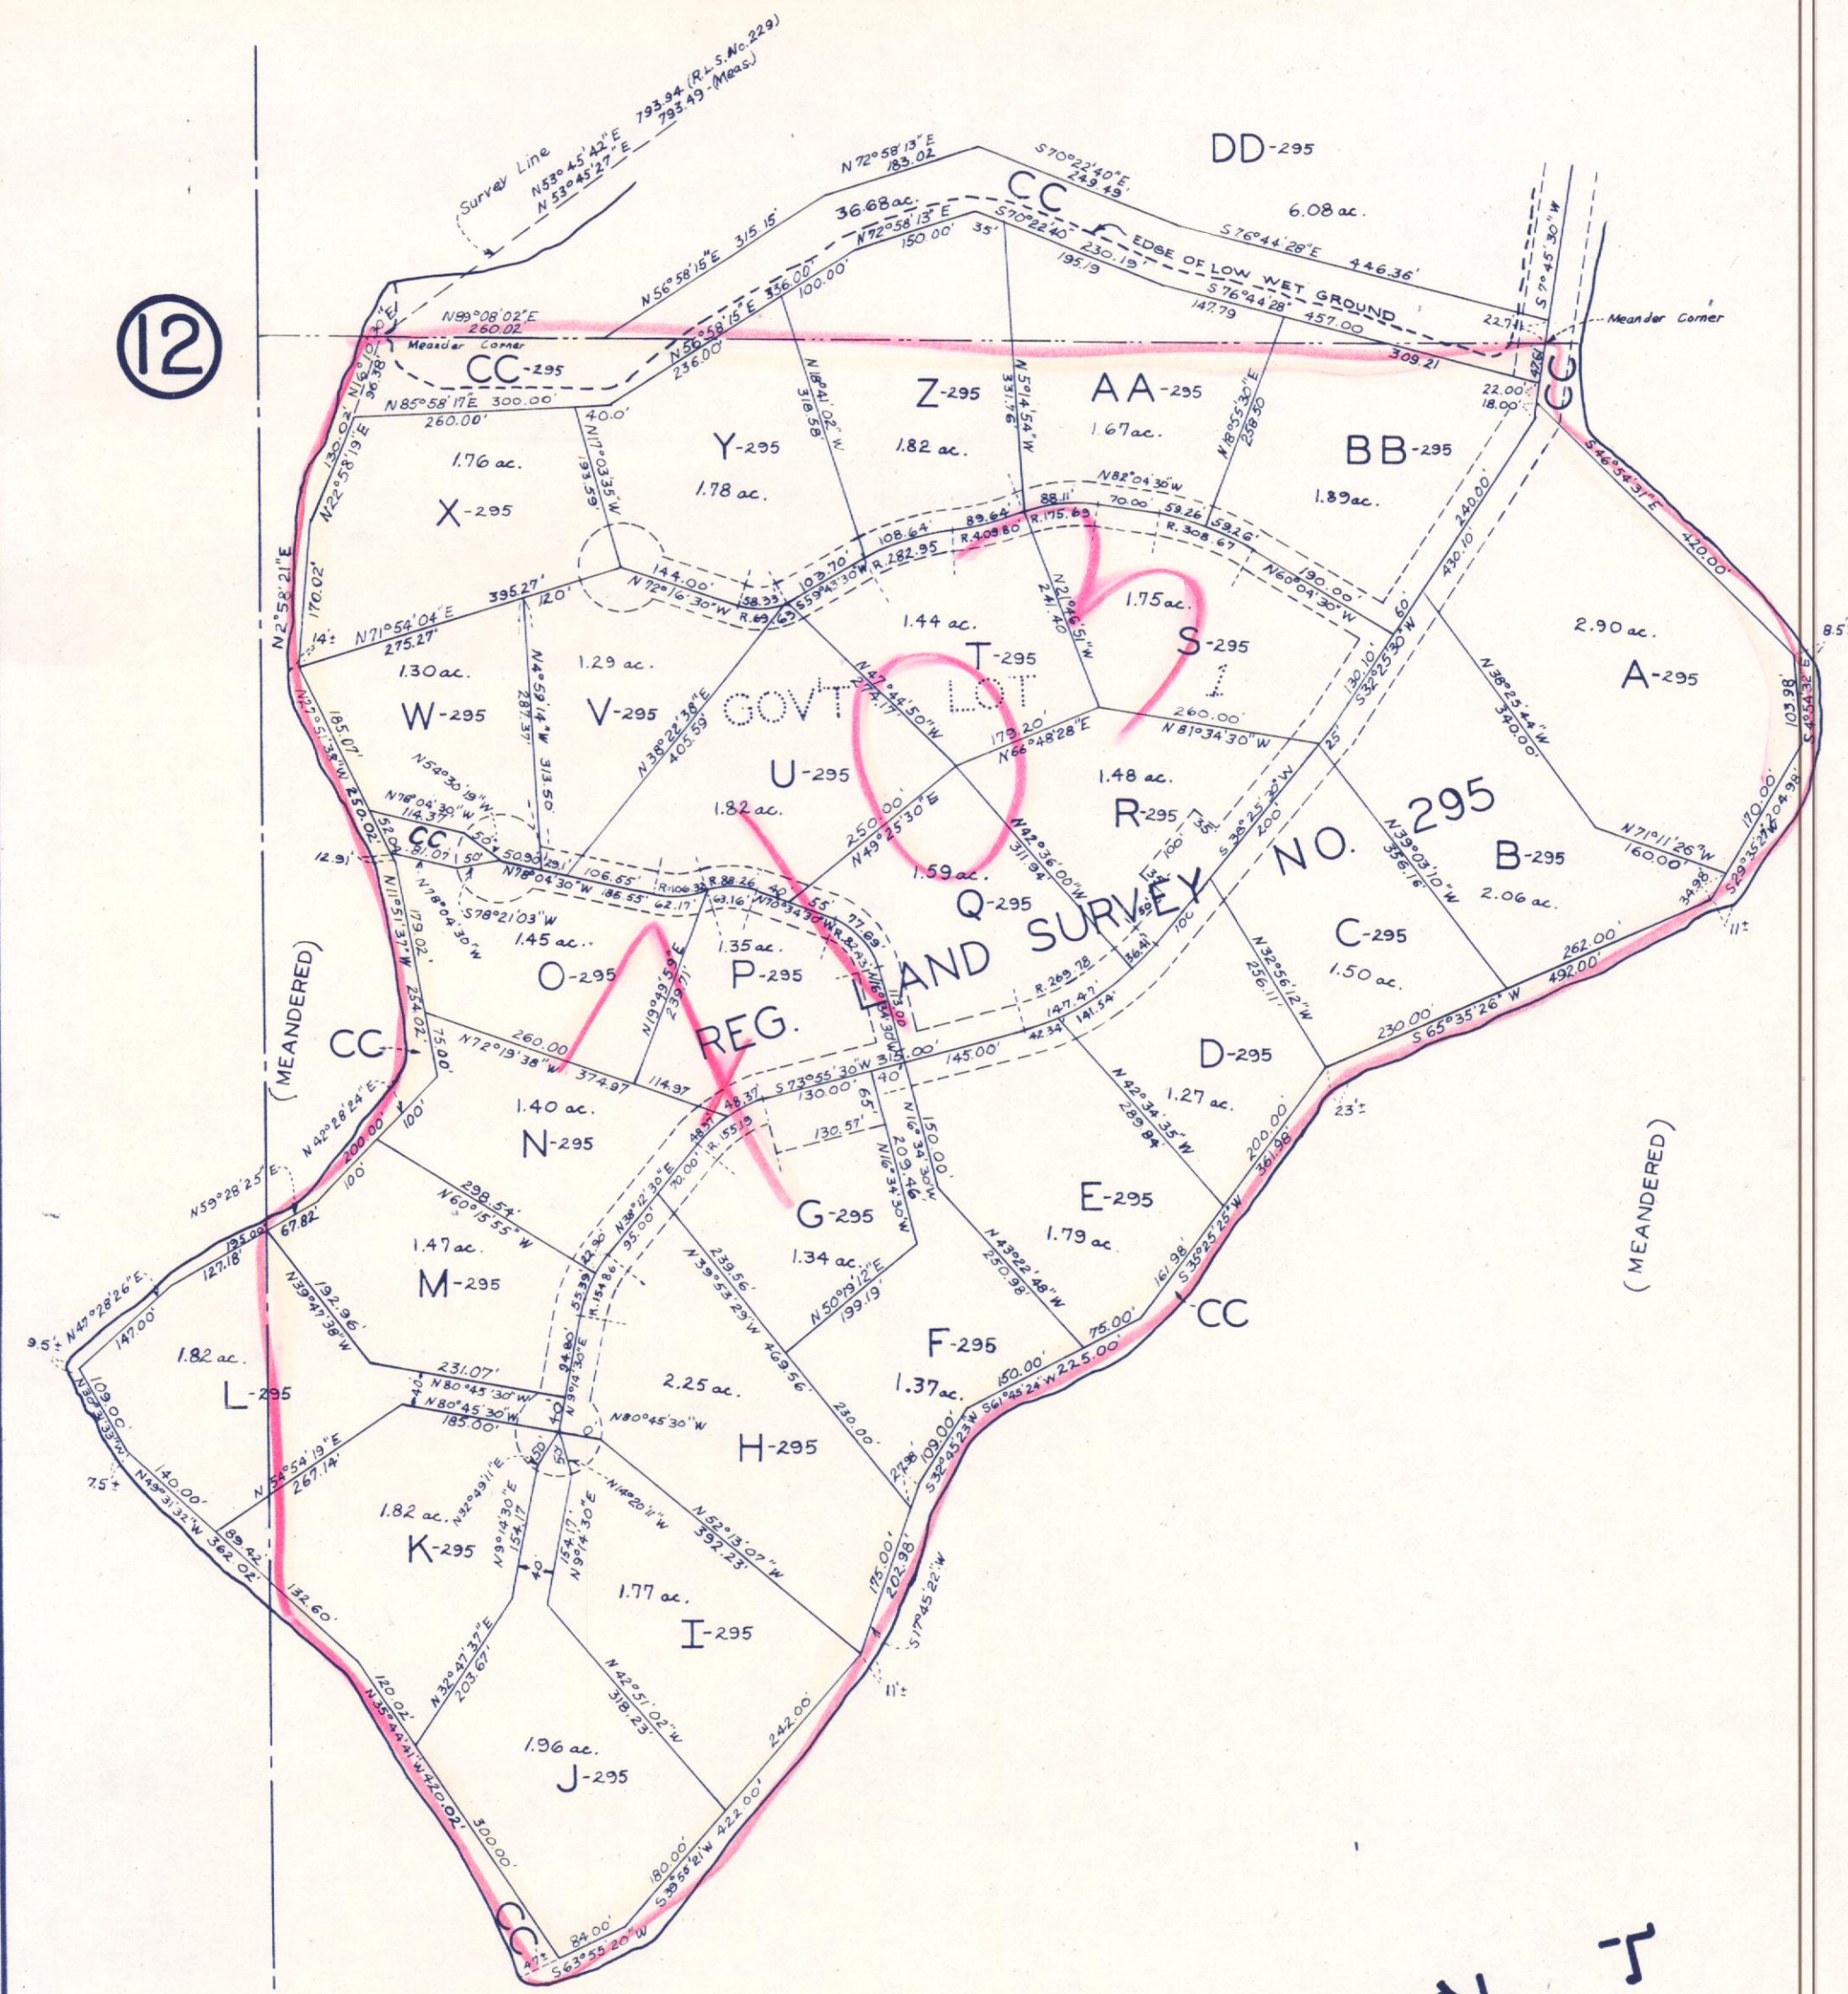


PLEASANT

S 1/2 7-30-22

L
A
S
E

18

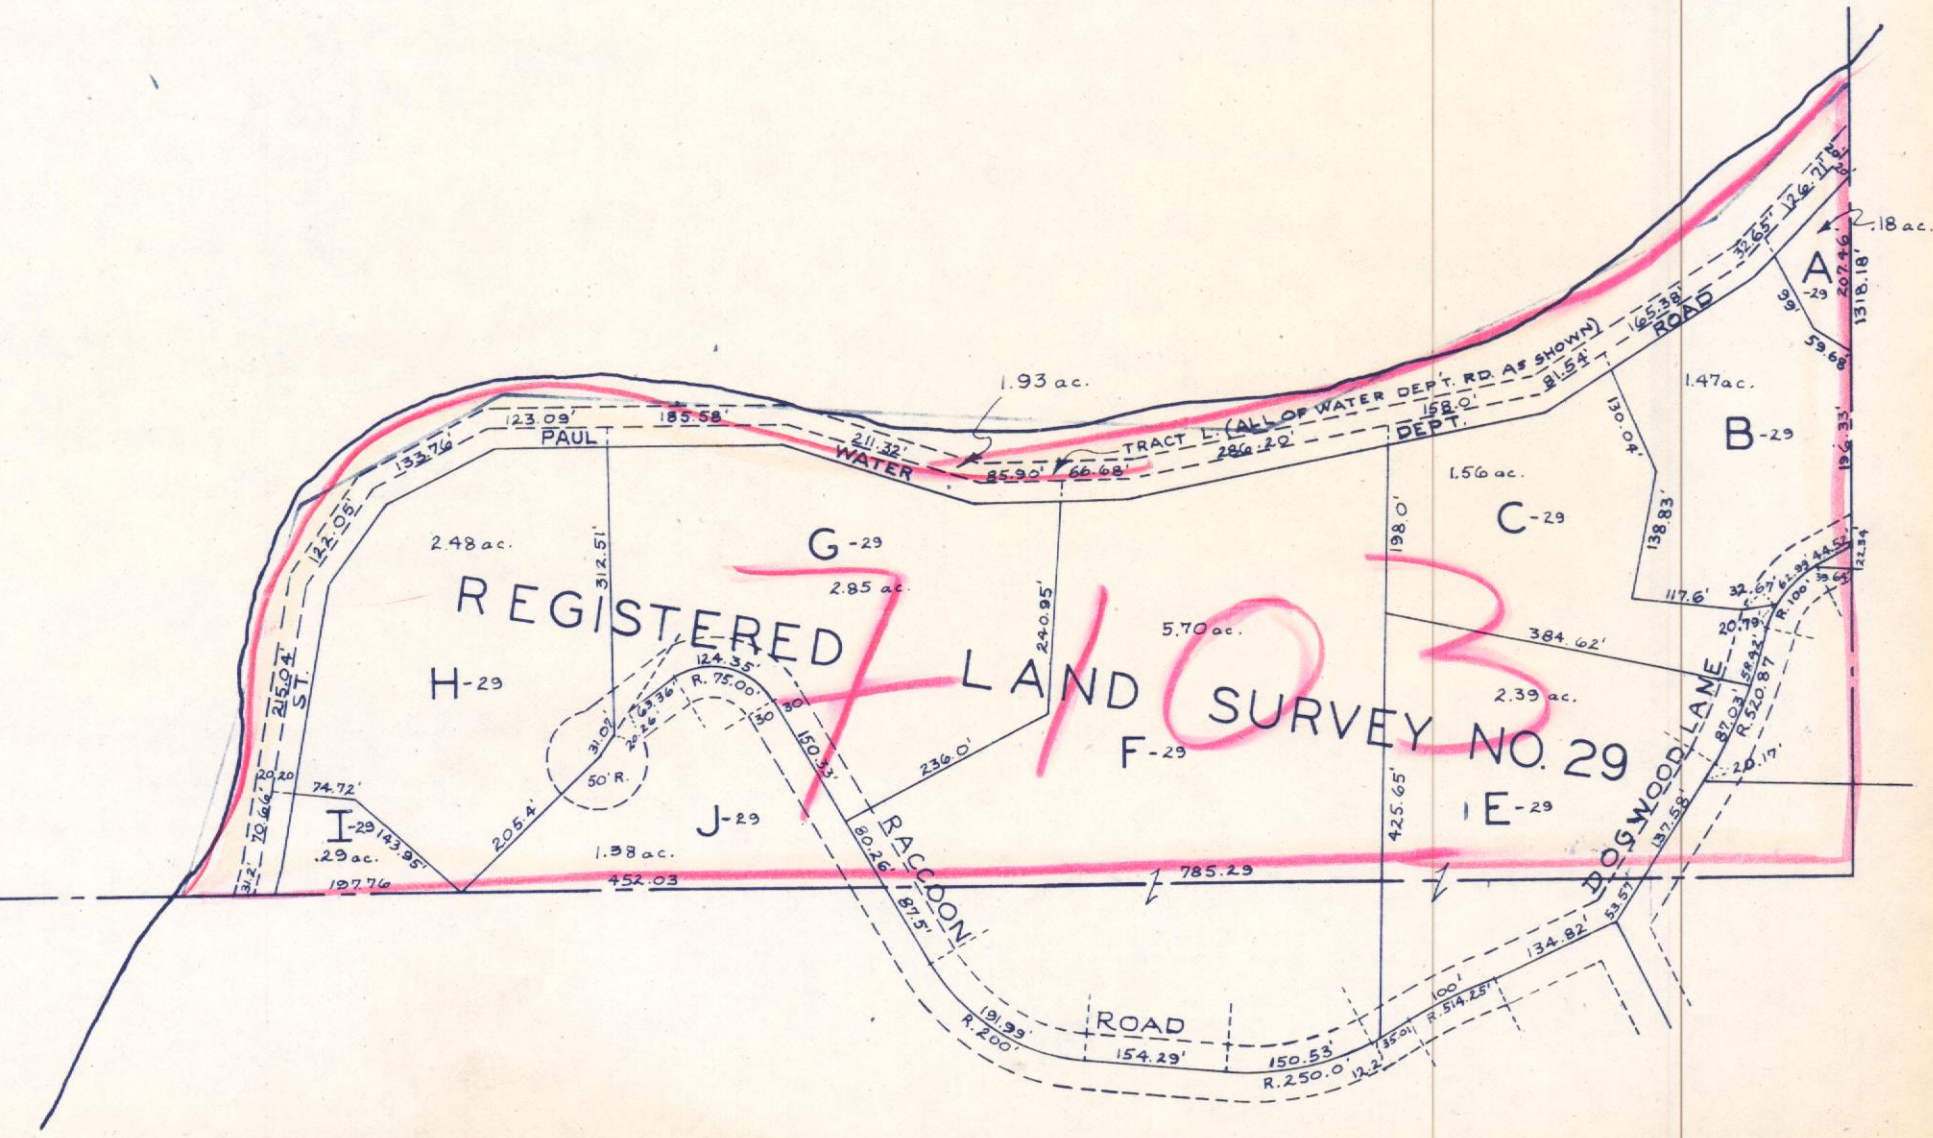

REGISTERED LAND SURVEY NO. 29

PLEASANT