
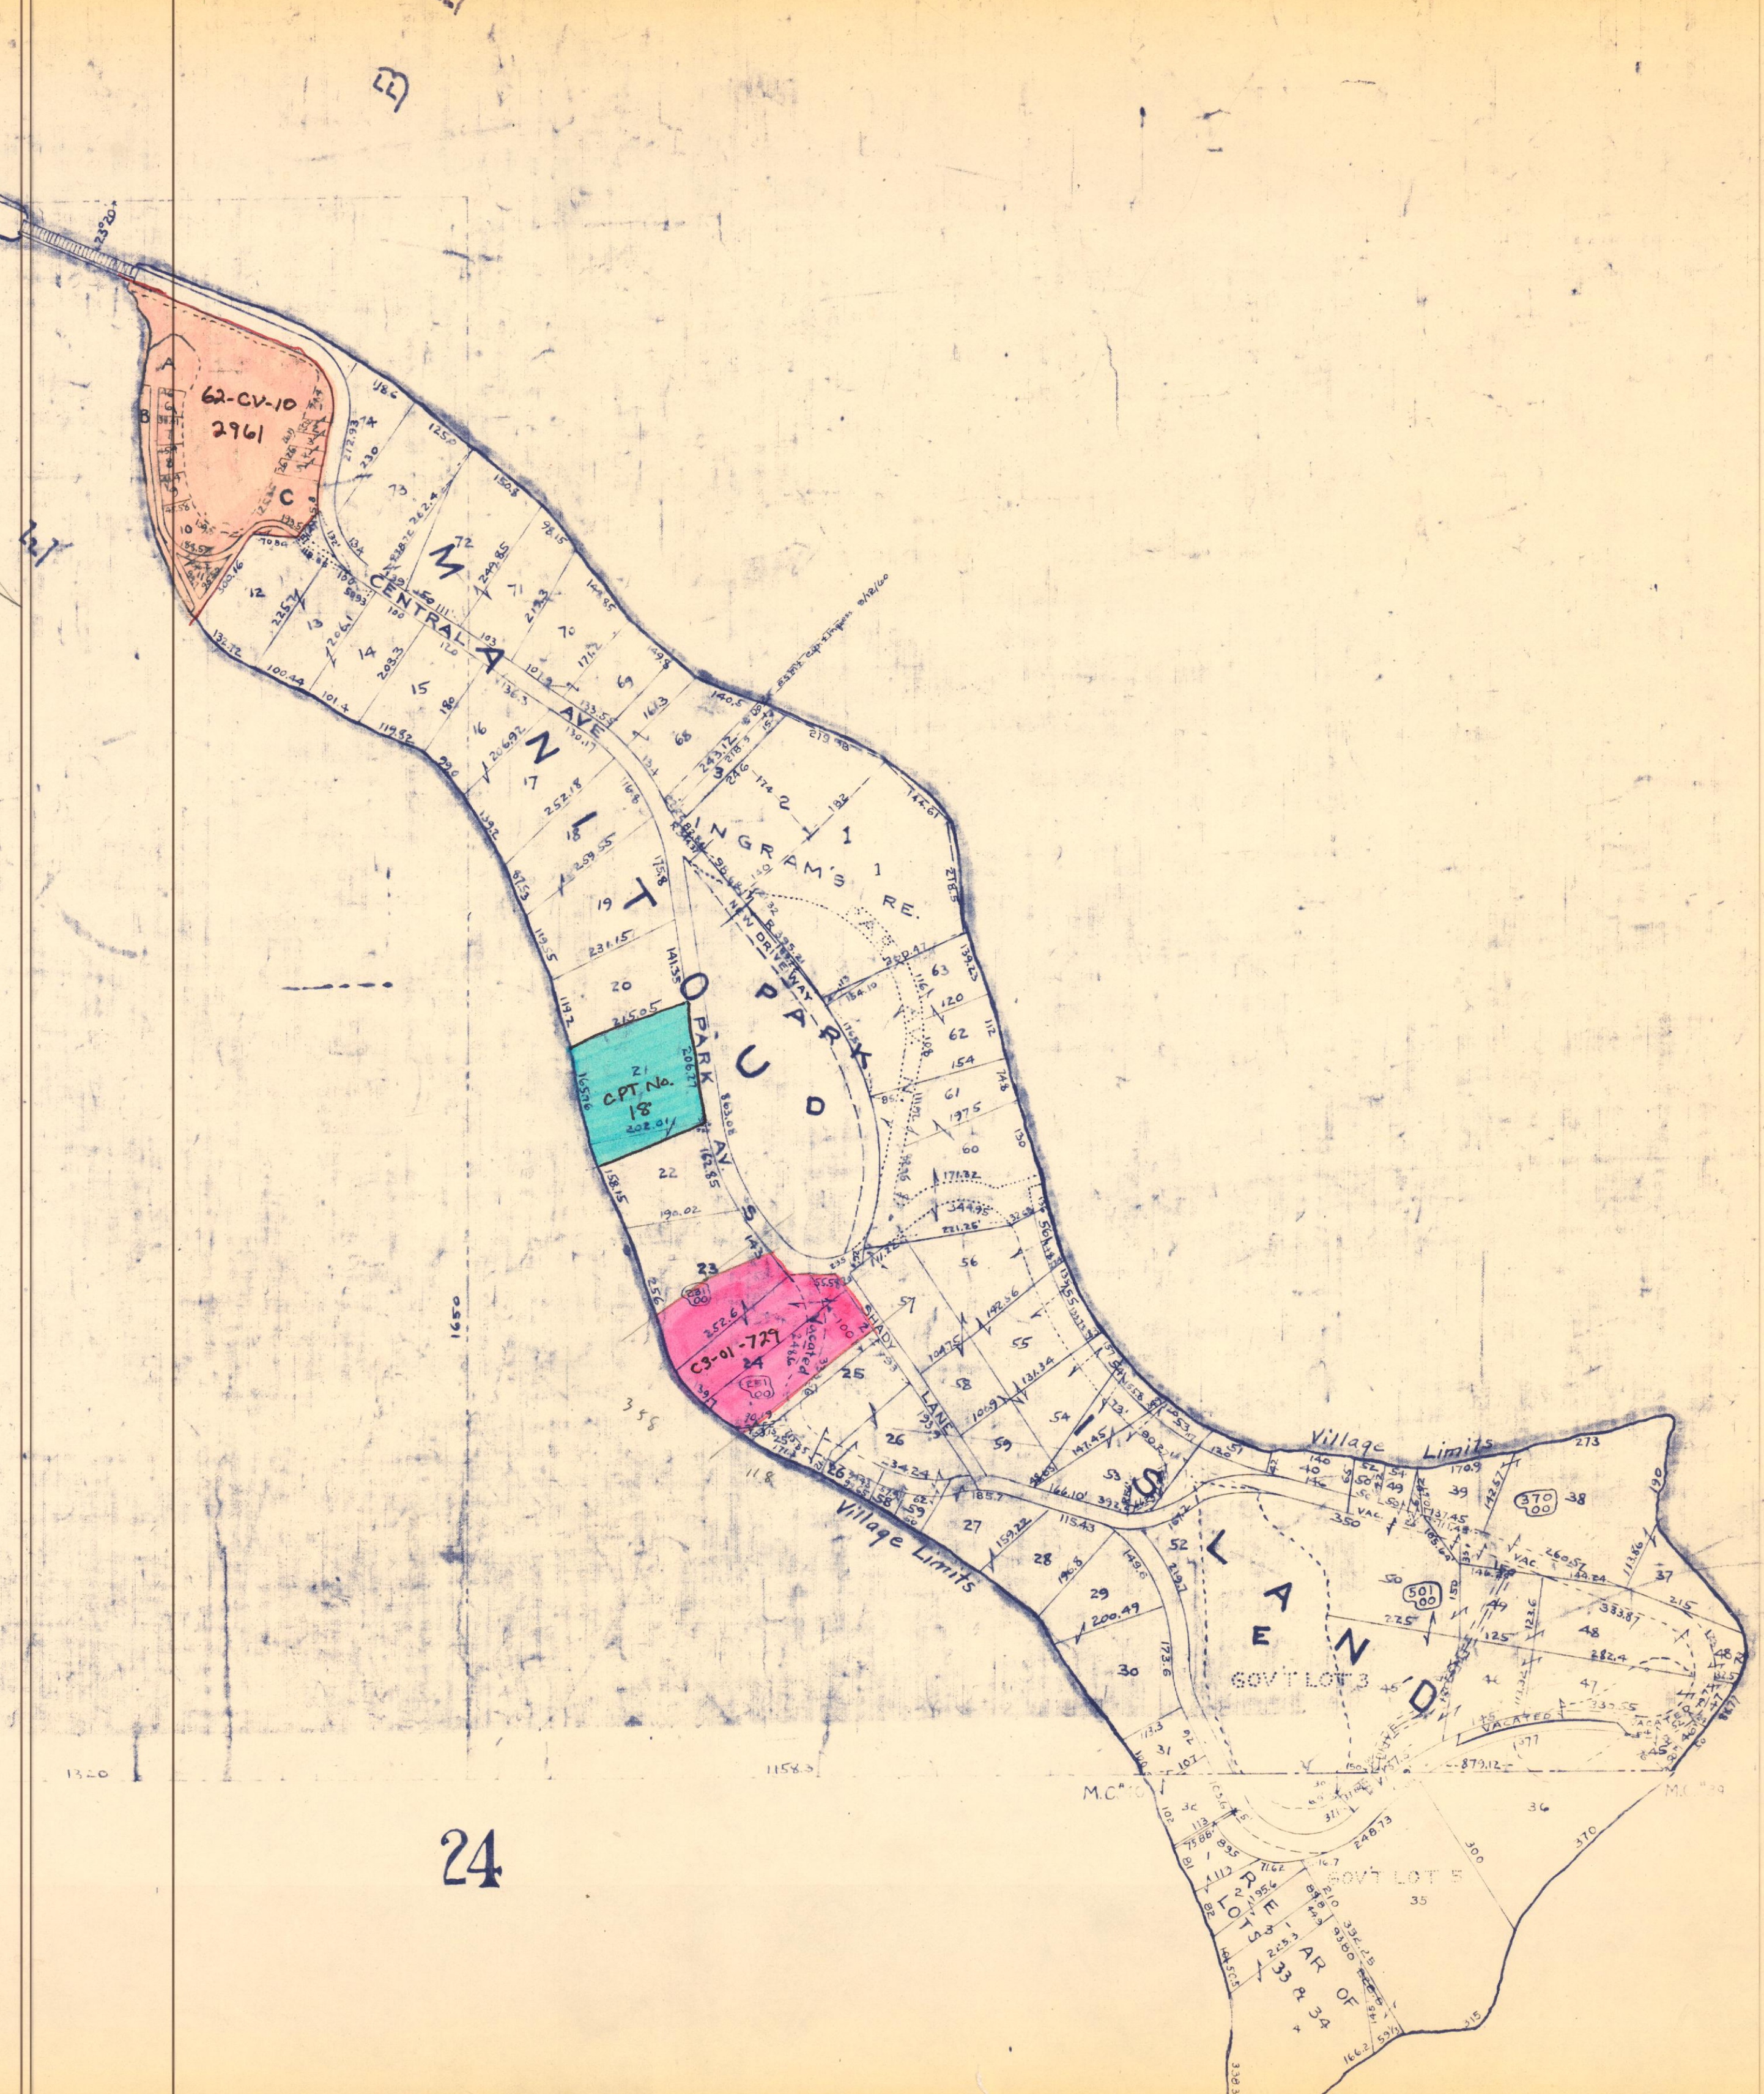


14

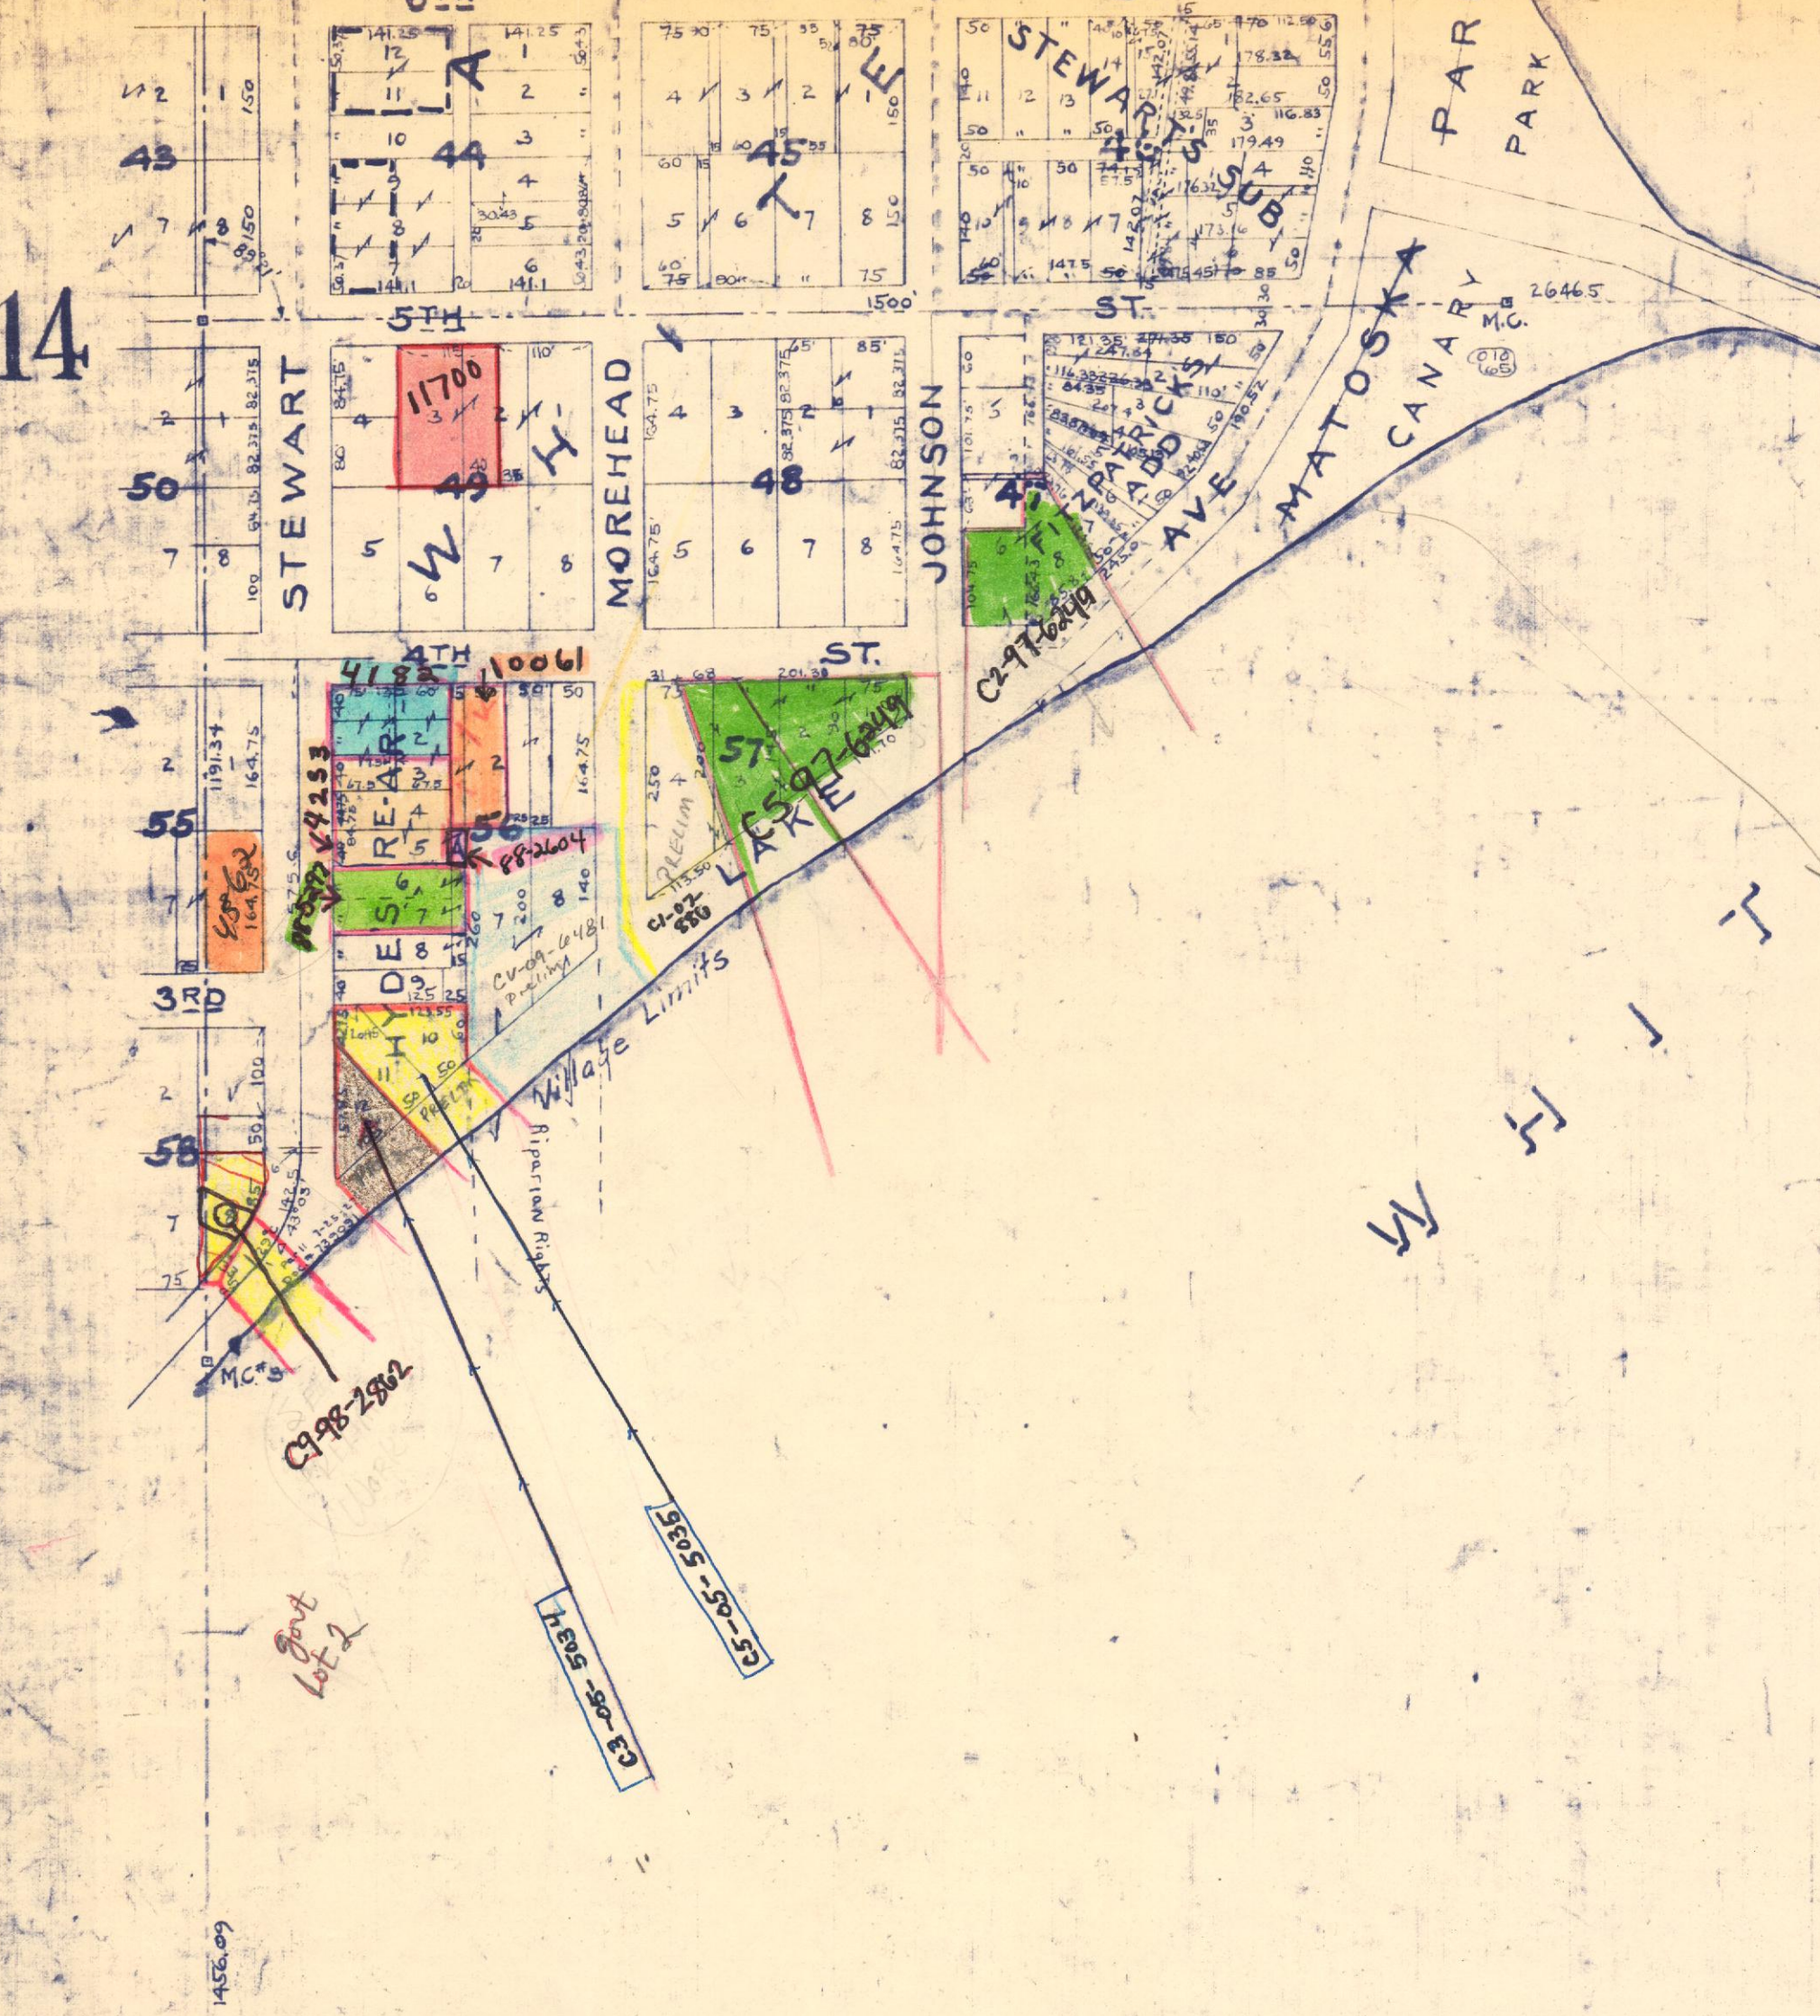

RANGE 22 WEST
 RANGE 21 WEST
 WASHINGTON

13-30-22
 South 1/2

13-30-22

24