


16

15-29-23  
S/S

22

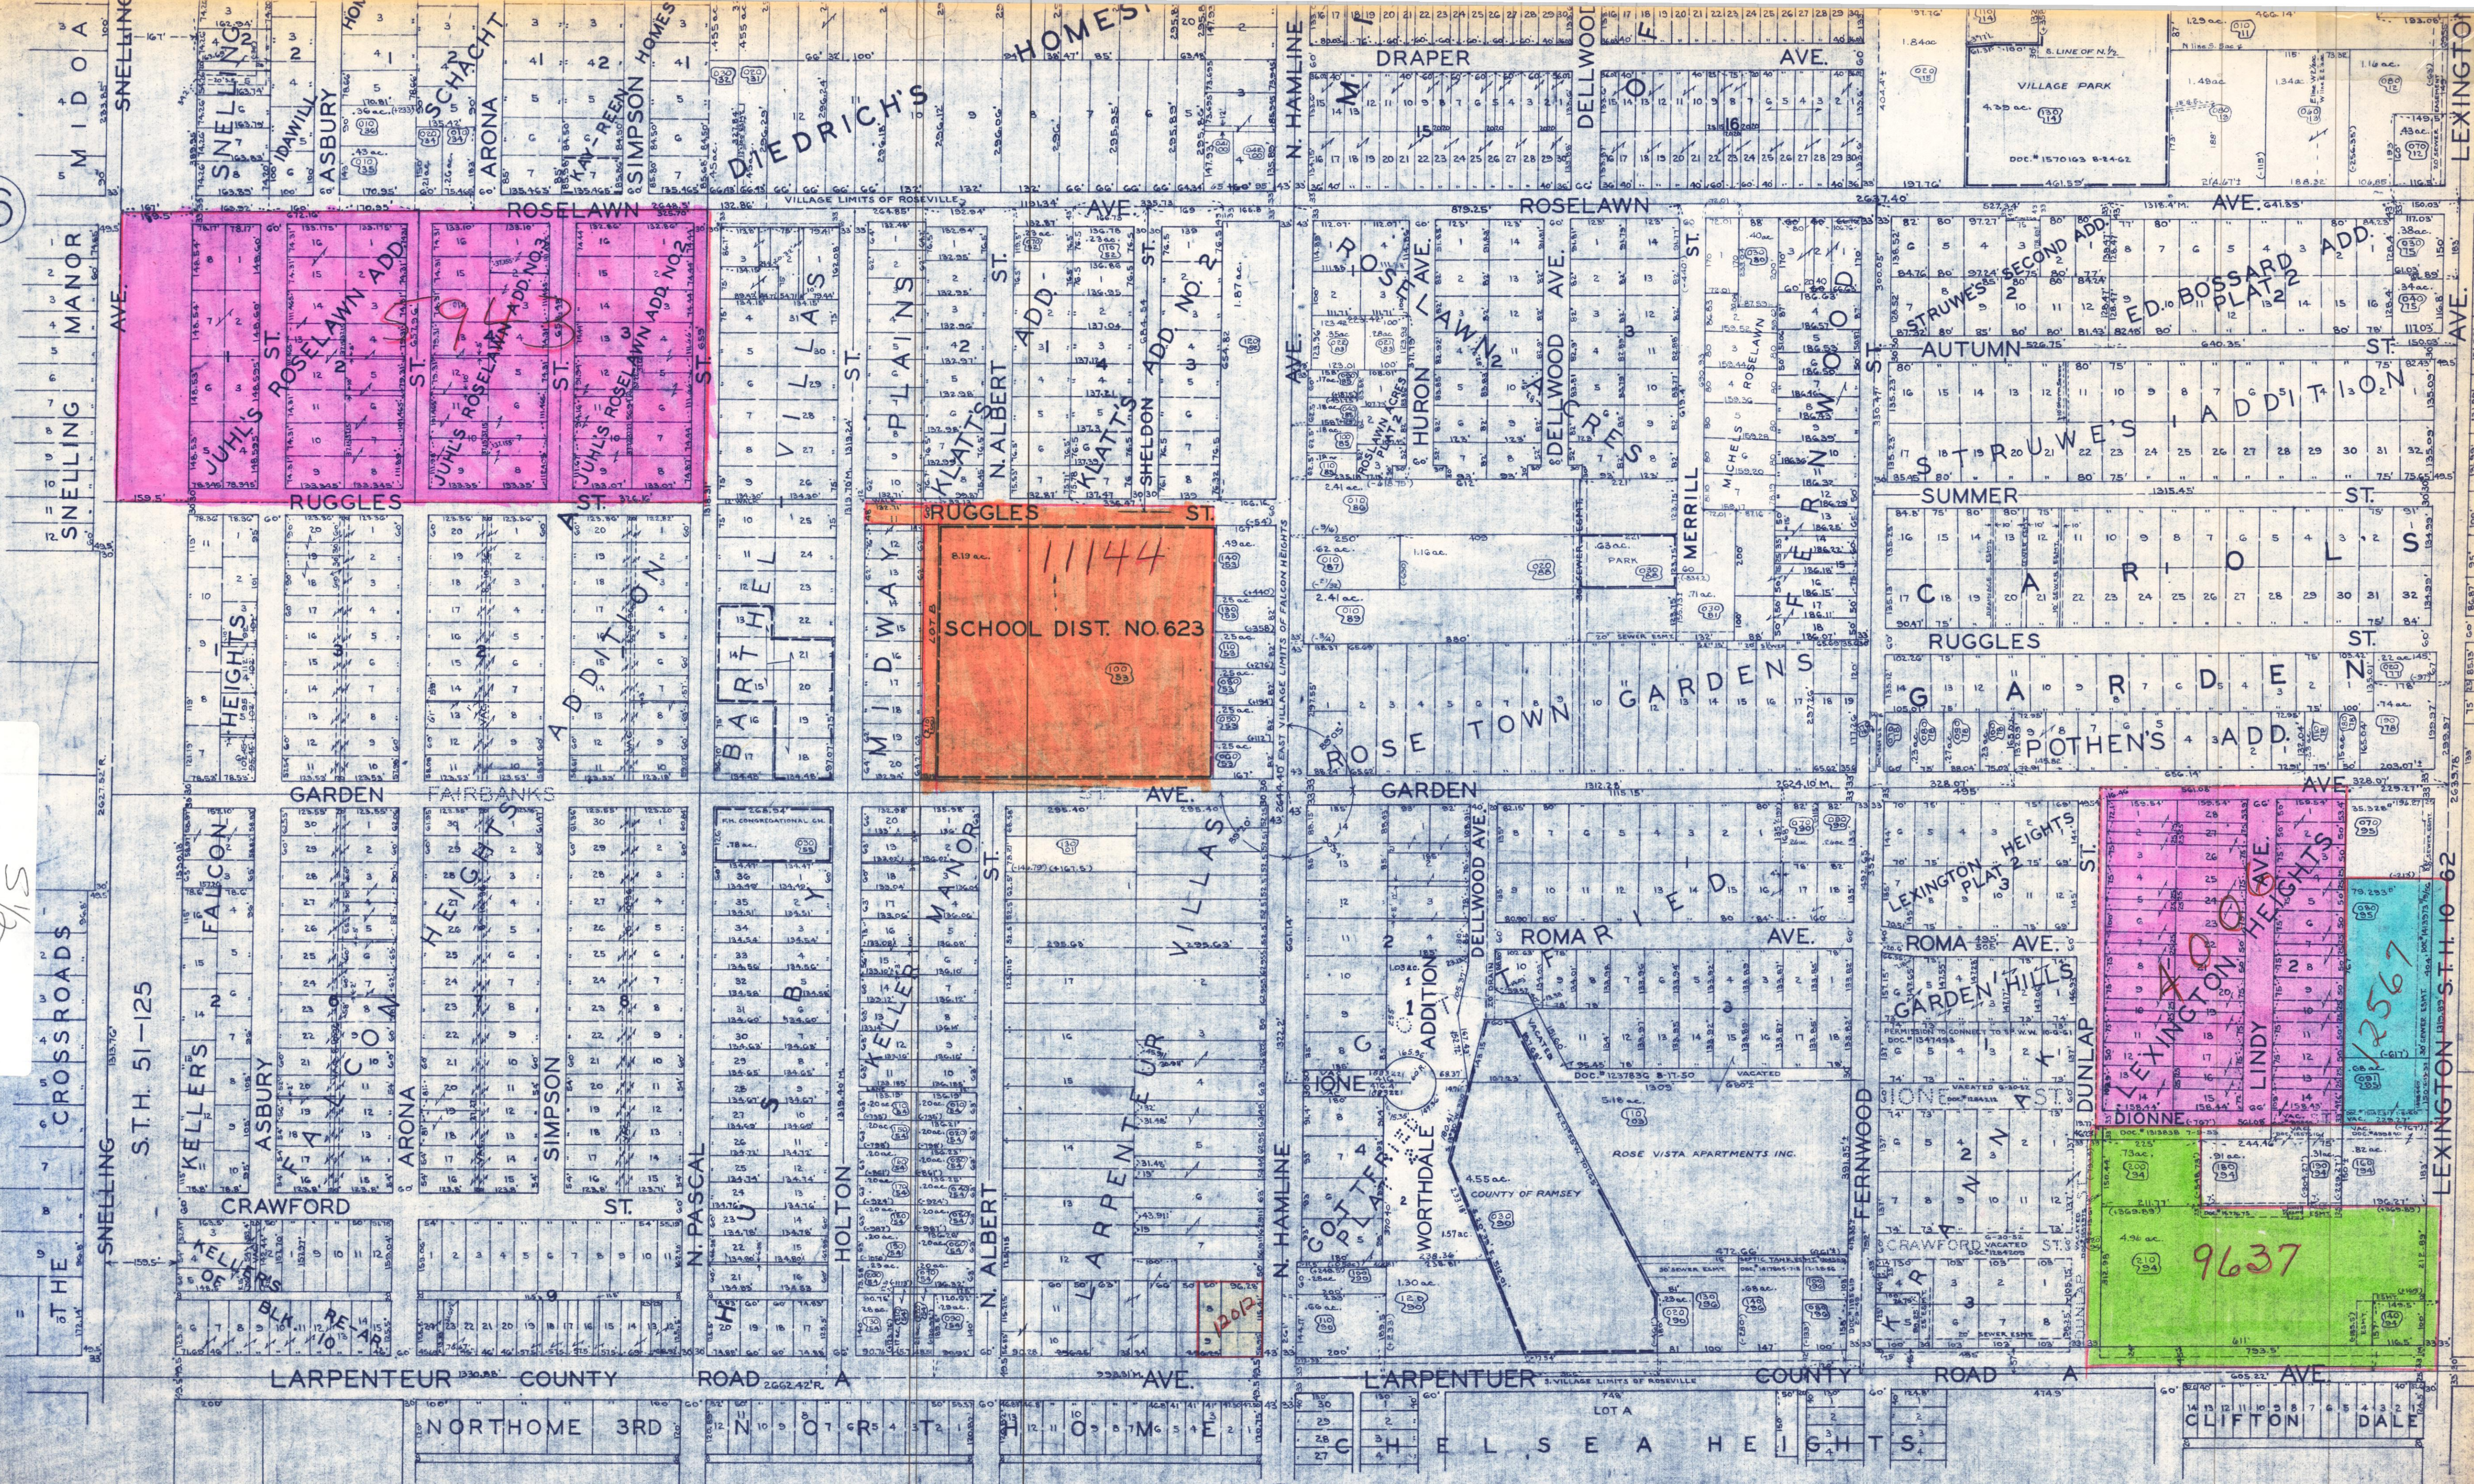

15-29-23