

17

1

16-30-22
S 1/2

7212

7212


91-14242

5606

21

16-30-22
COUNTY ASSESSOR'S OFFICE

AREA & DIMENSIONS SUBJECT TO CHANGE

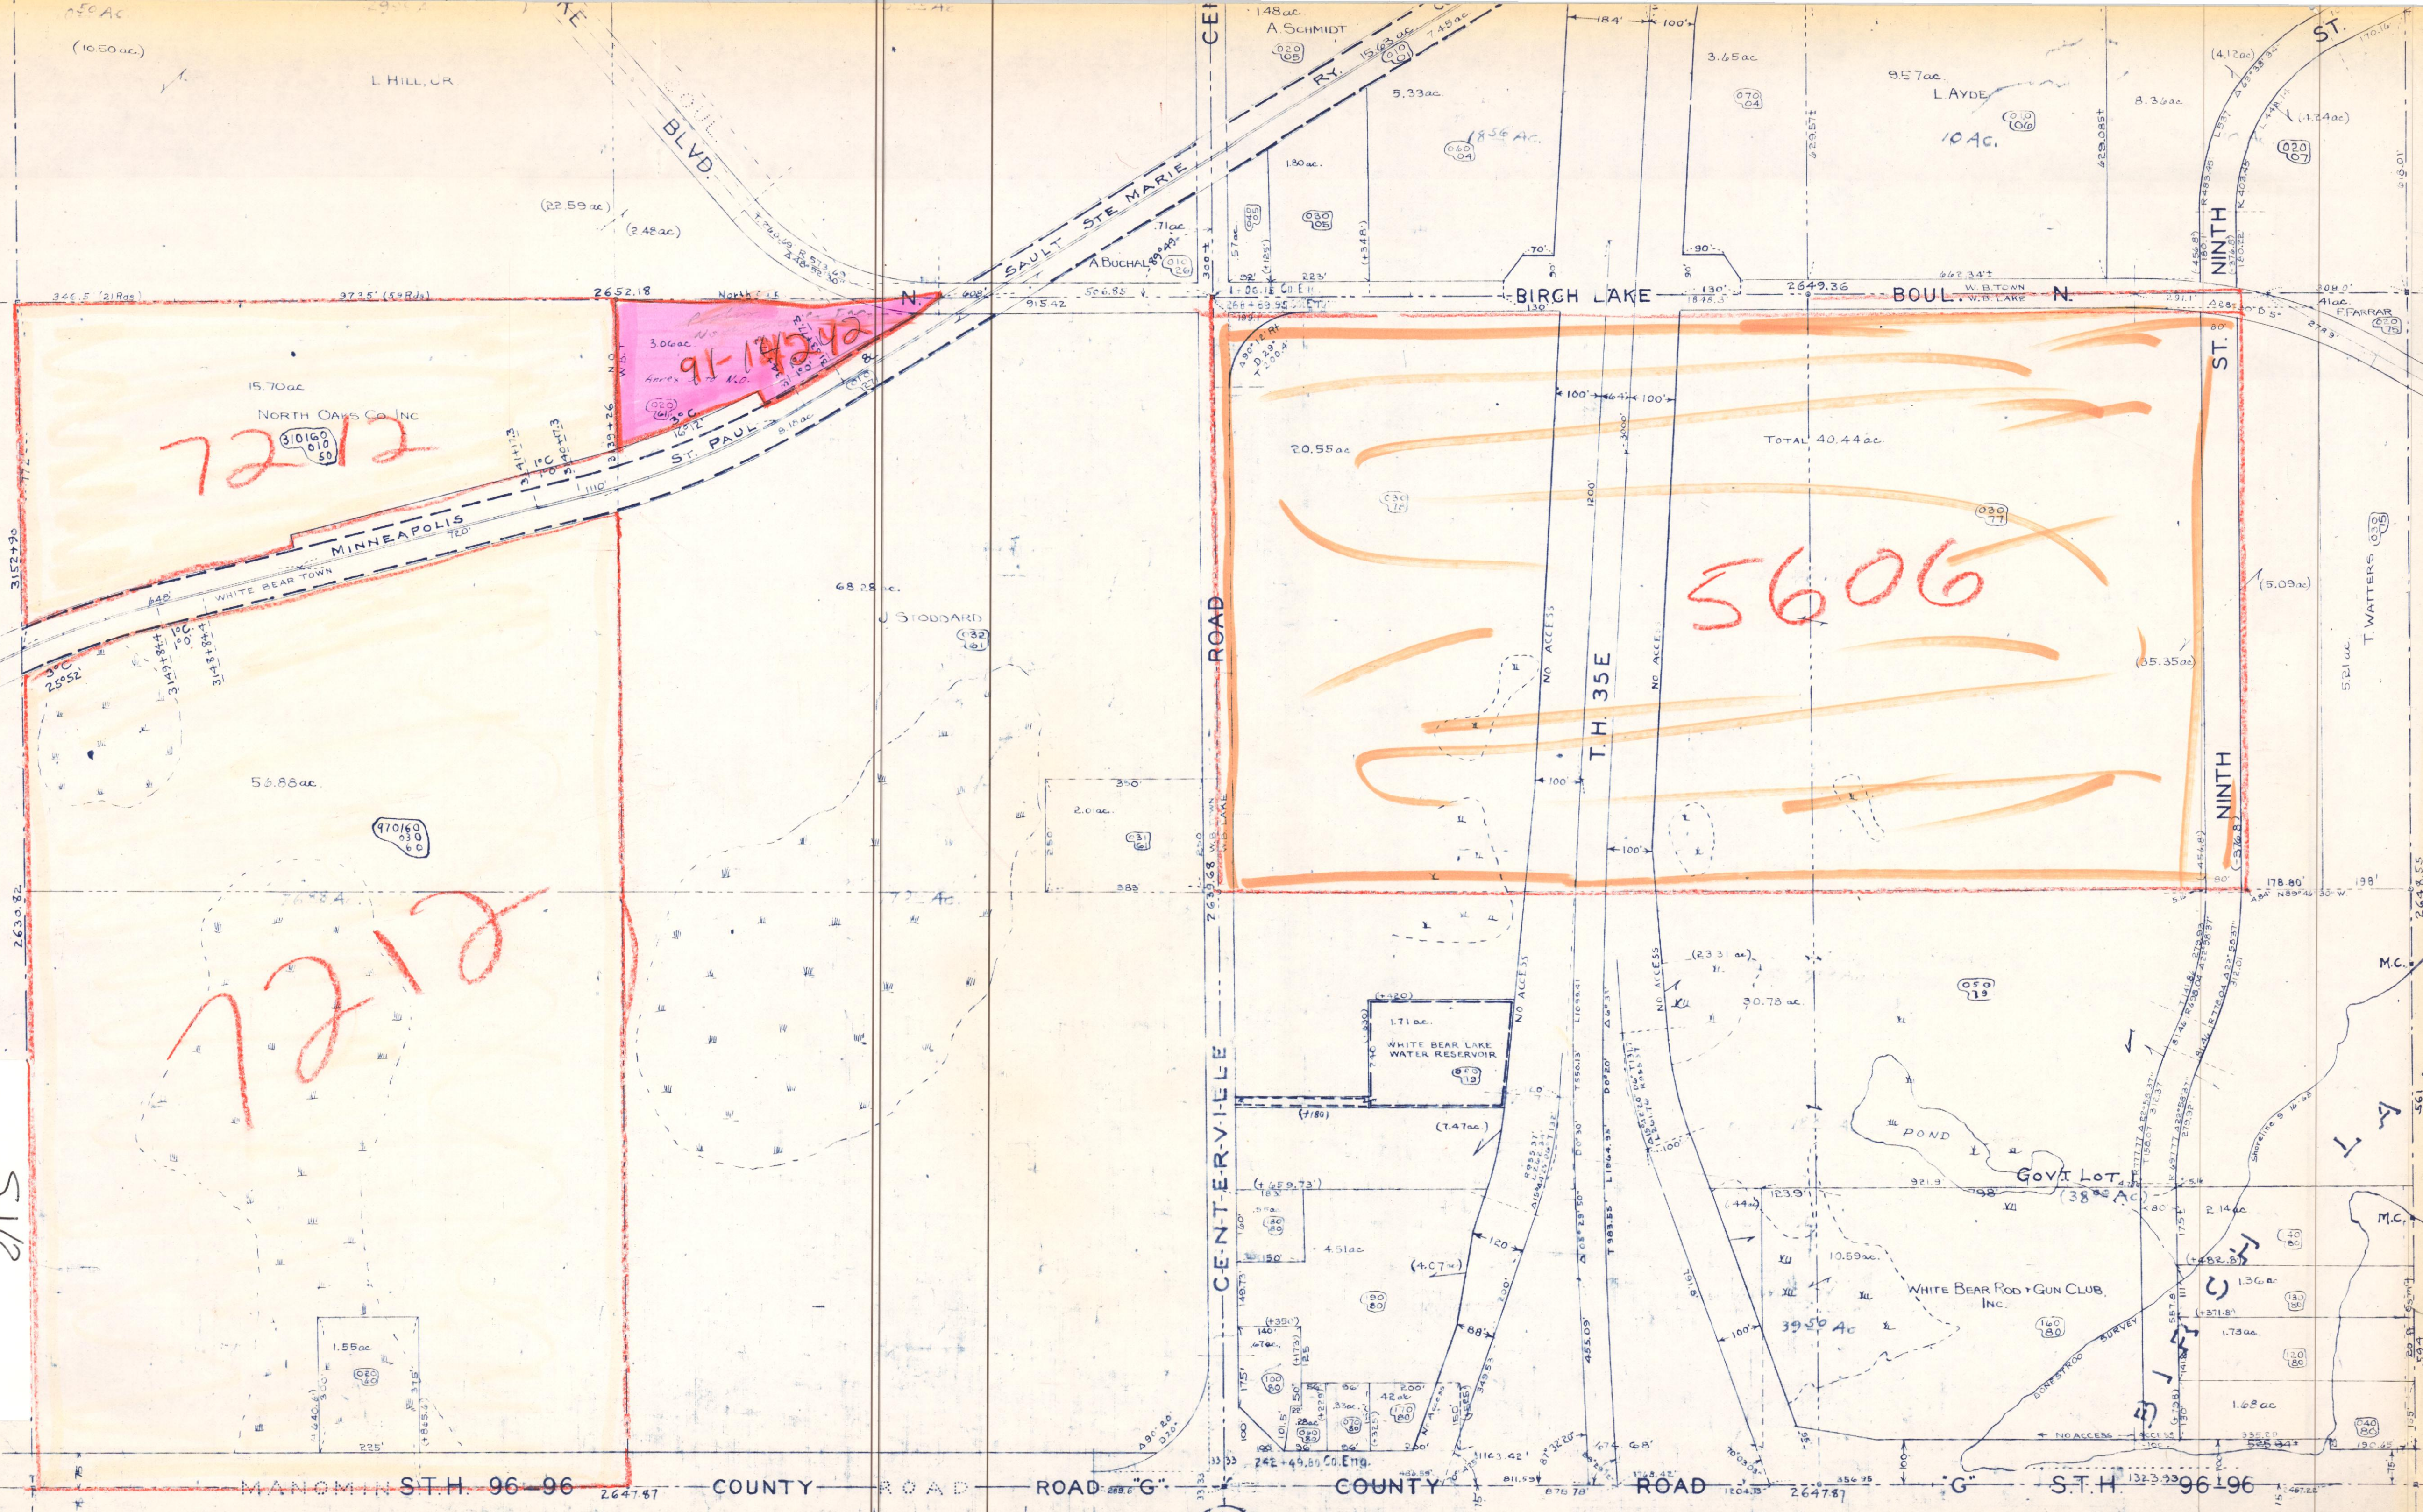

LAST CORR. TO BE