


21

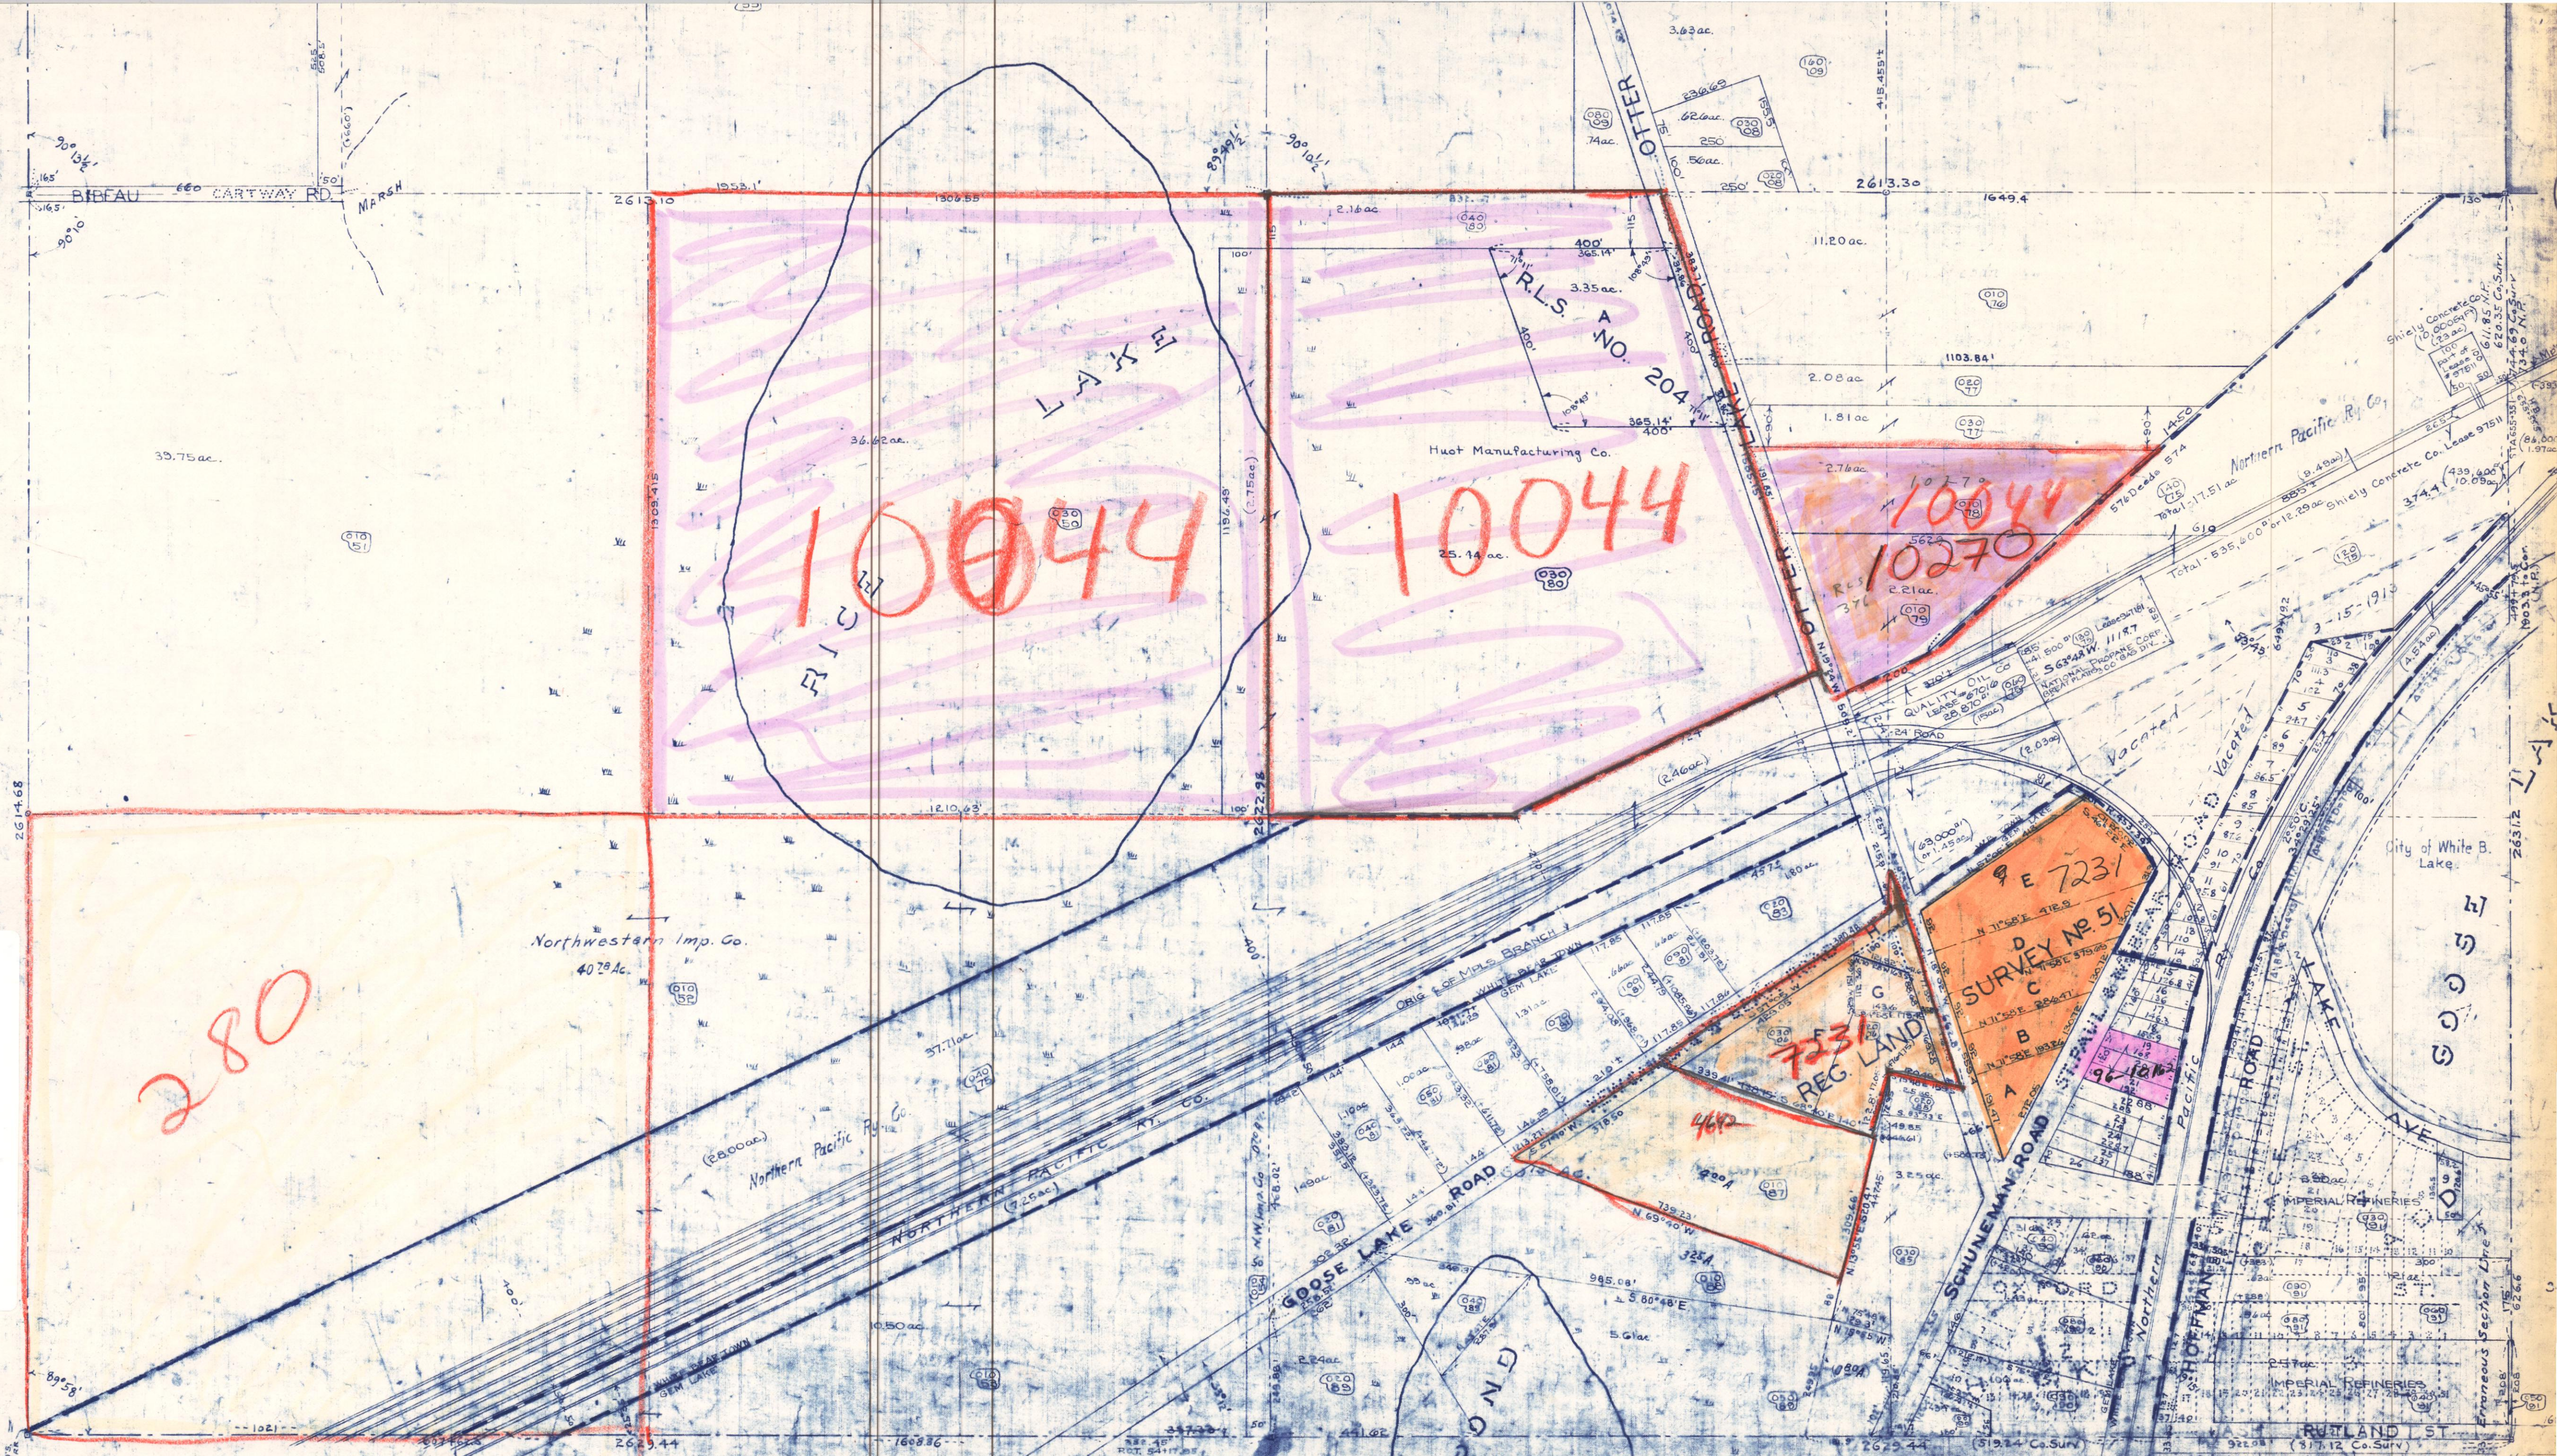

22-30-22  
COUNTY ASSESSOR'S OFFICE

27

AREAS & DIMENSIONS SUBJECT TO CHANGE

REAR OF WHITE BEAR