


26

25-30-22

S/S

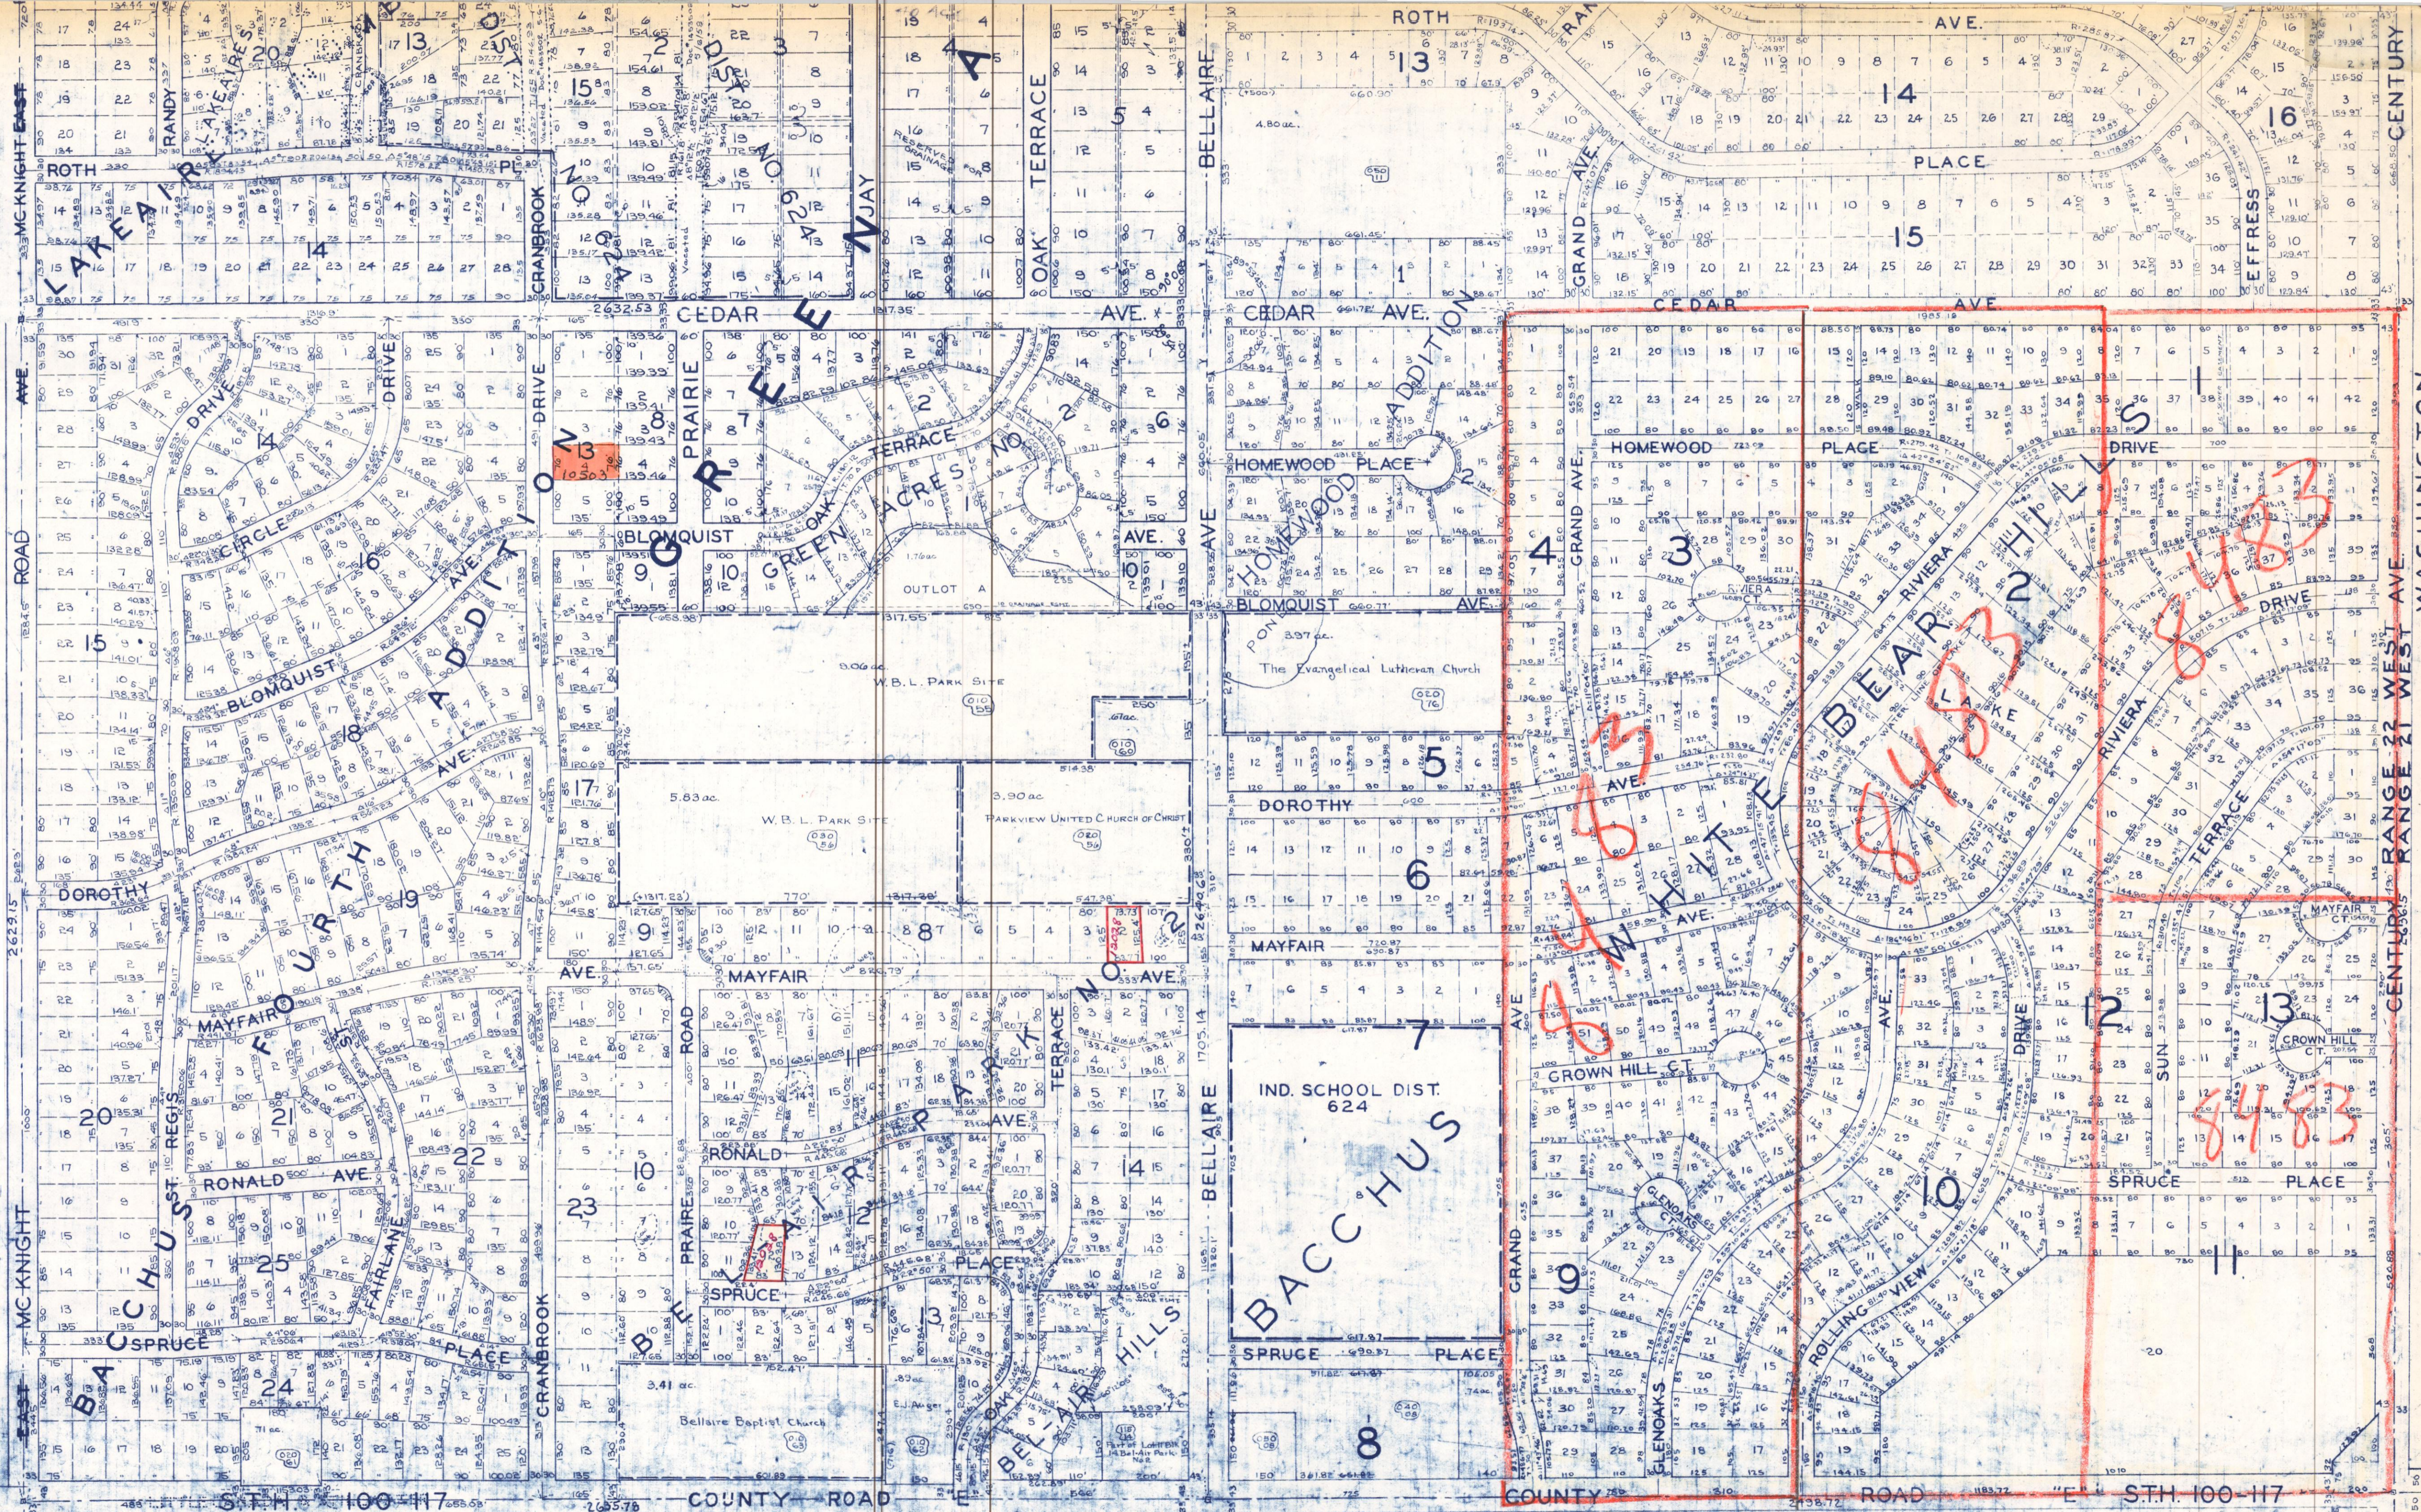

AREA & DIMENSIONS SUBJECT TO CHANGE

25-30-22
COUNTY ASSESSORS OFFICE

36

LAST CORR
11-16-72