

26


30

50-30-23

S 1/2

88-3746

25-30-23

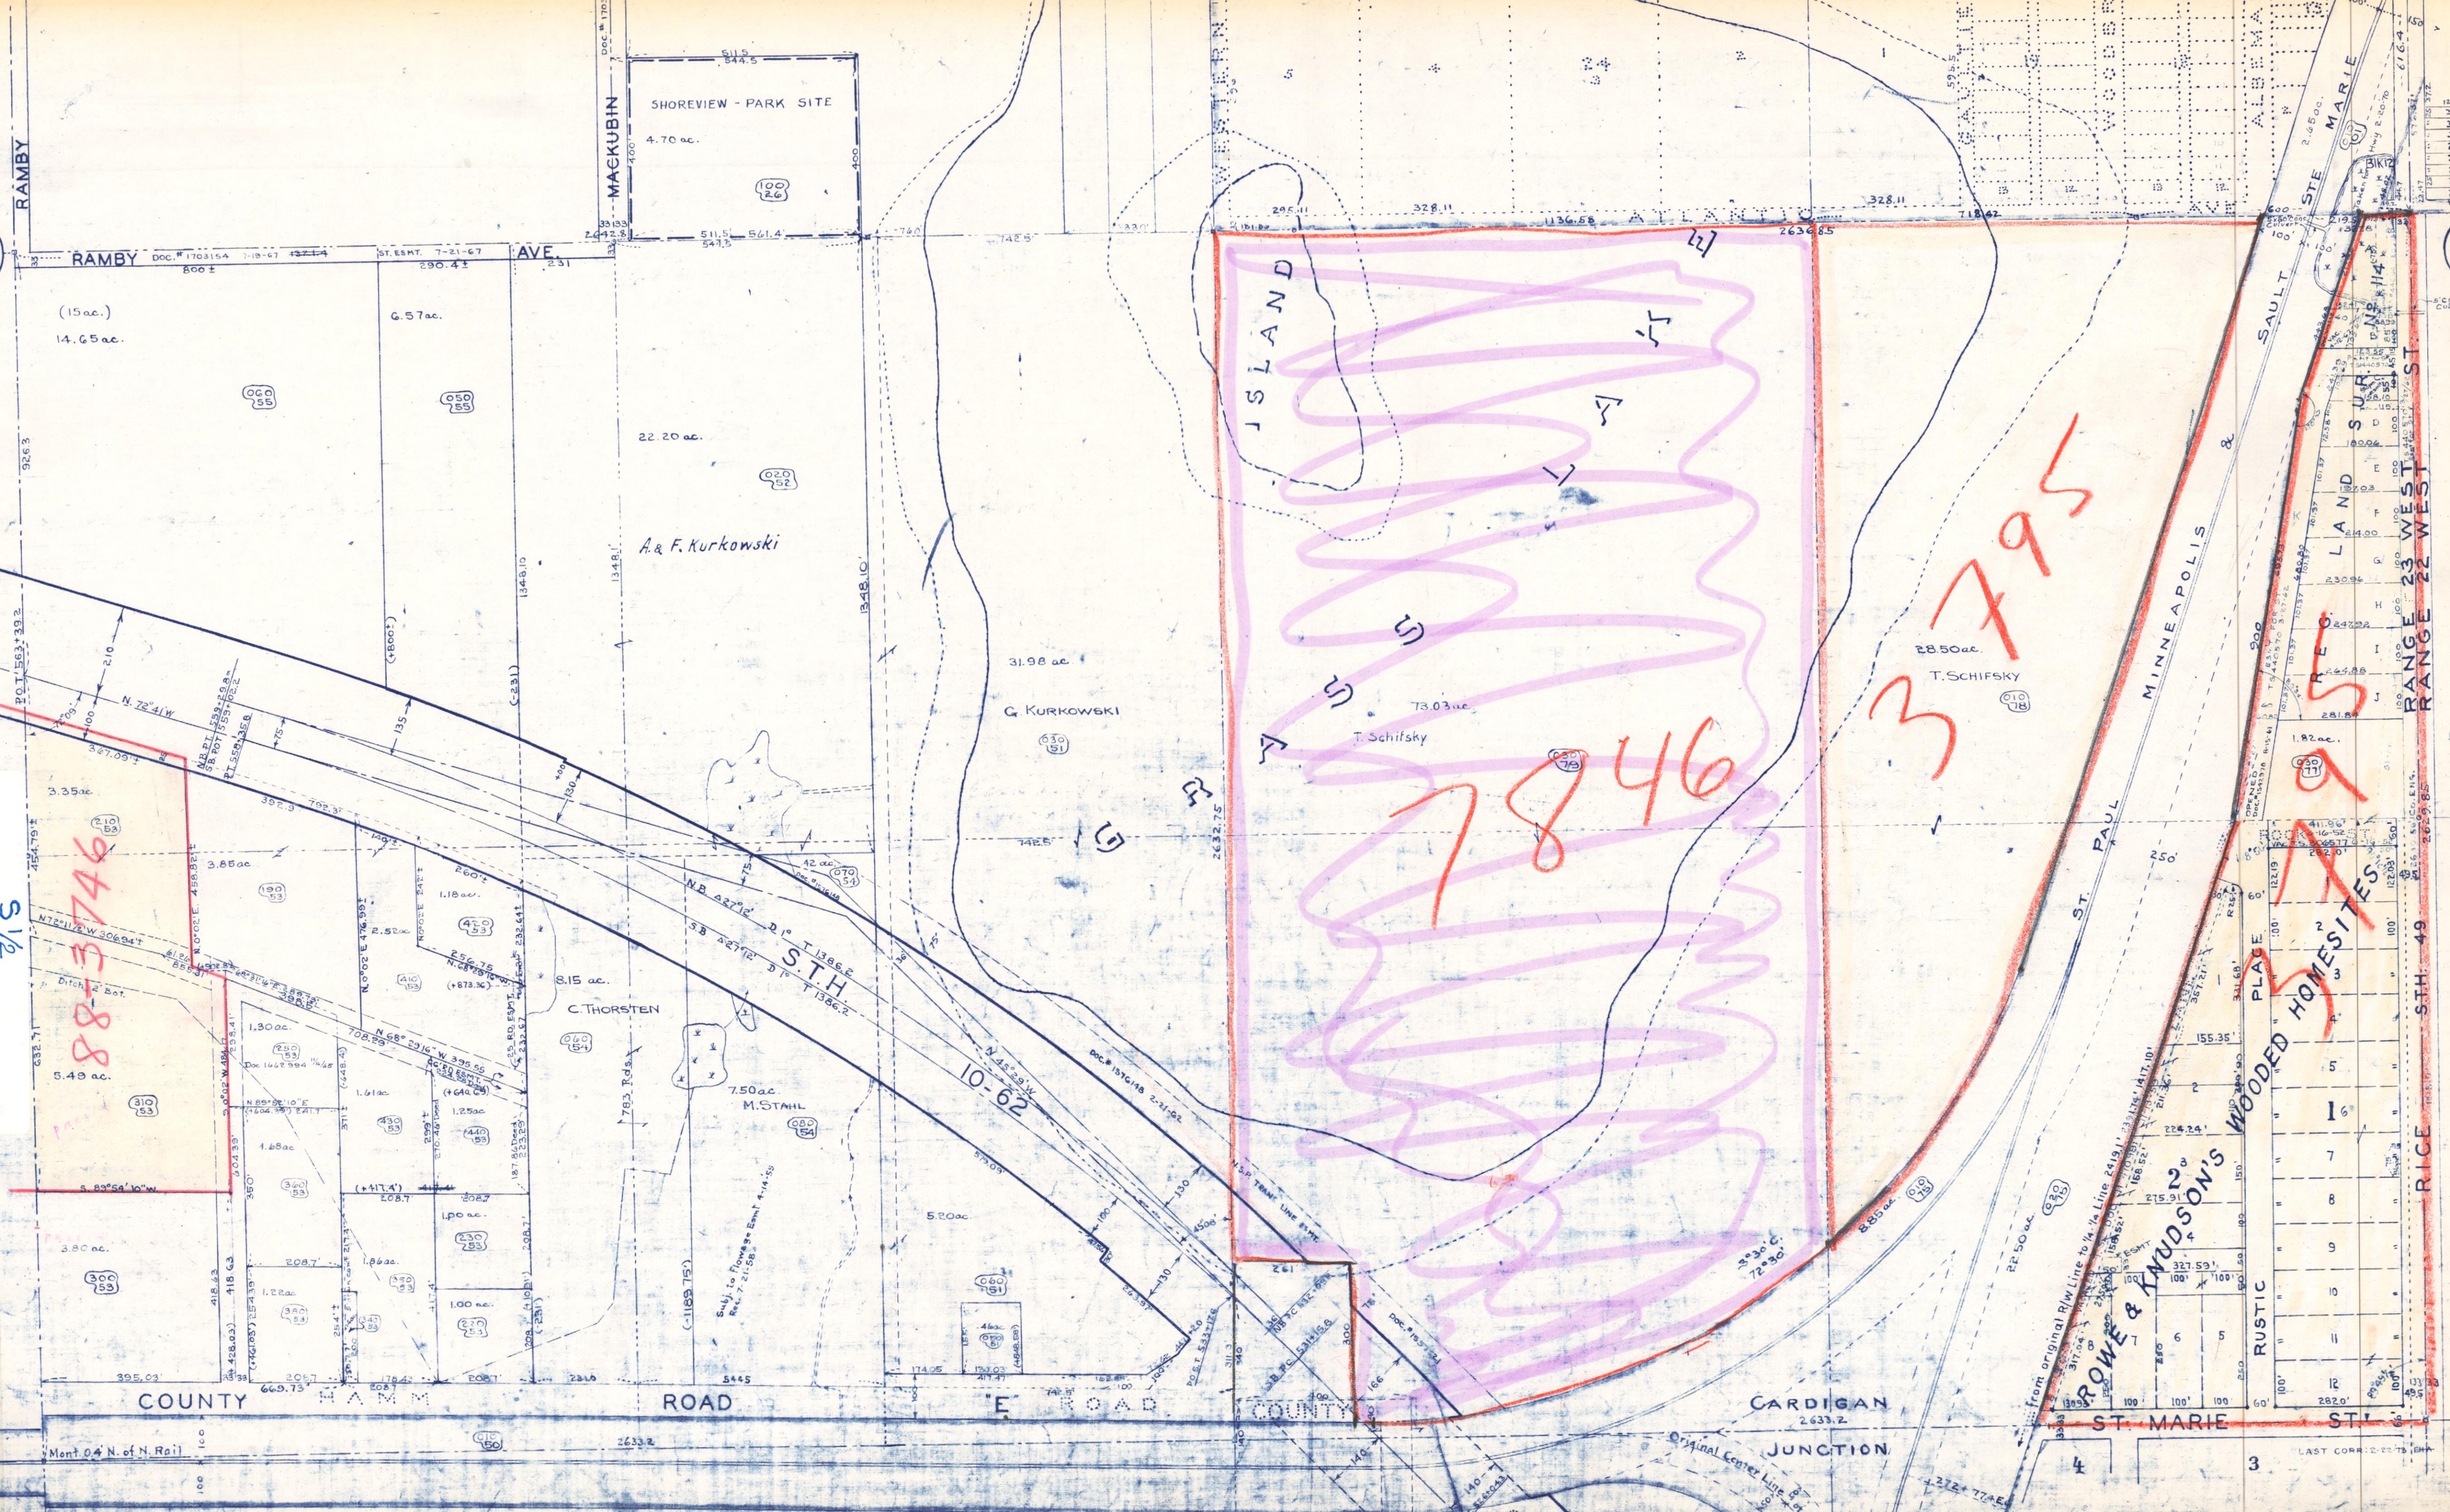

AREAS & DIMENSIONS SUBJECT TO CHANGE